



DEDICATED FREIGHT CORRIDOR CORPORATION OF INDIA LTD.
(A GOVERNMENT OF INDIA ENTERPRISE)

EASTERN DEDICATED FREIGHT CORRIDOR
SAHNEWAL TO PILKHANI SECTION
CONTRACT PACKAGE - 301

PLAN & PROFILE OF AS BUILT DRAWINGS FOR DFC MAIN LINE

IR CHAINAGE FROM 278.000 KM TO 283.000 KM
DFCC CHAINAGE FROM KM 1167.431 TO KM 1172.407

DESIGN CONSULTANT





ENGINEER



CONTRACTOR CLIENT
GIL - TPL JV



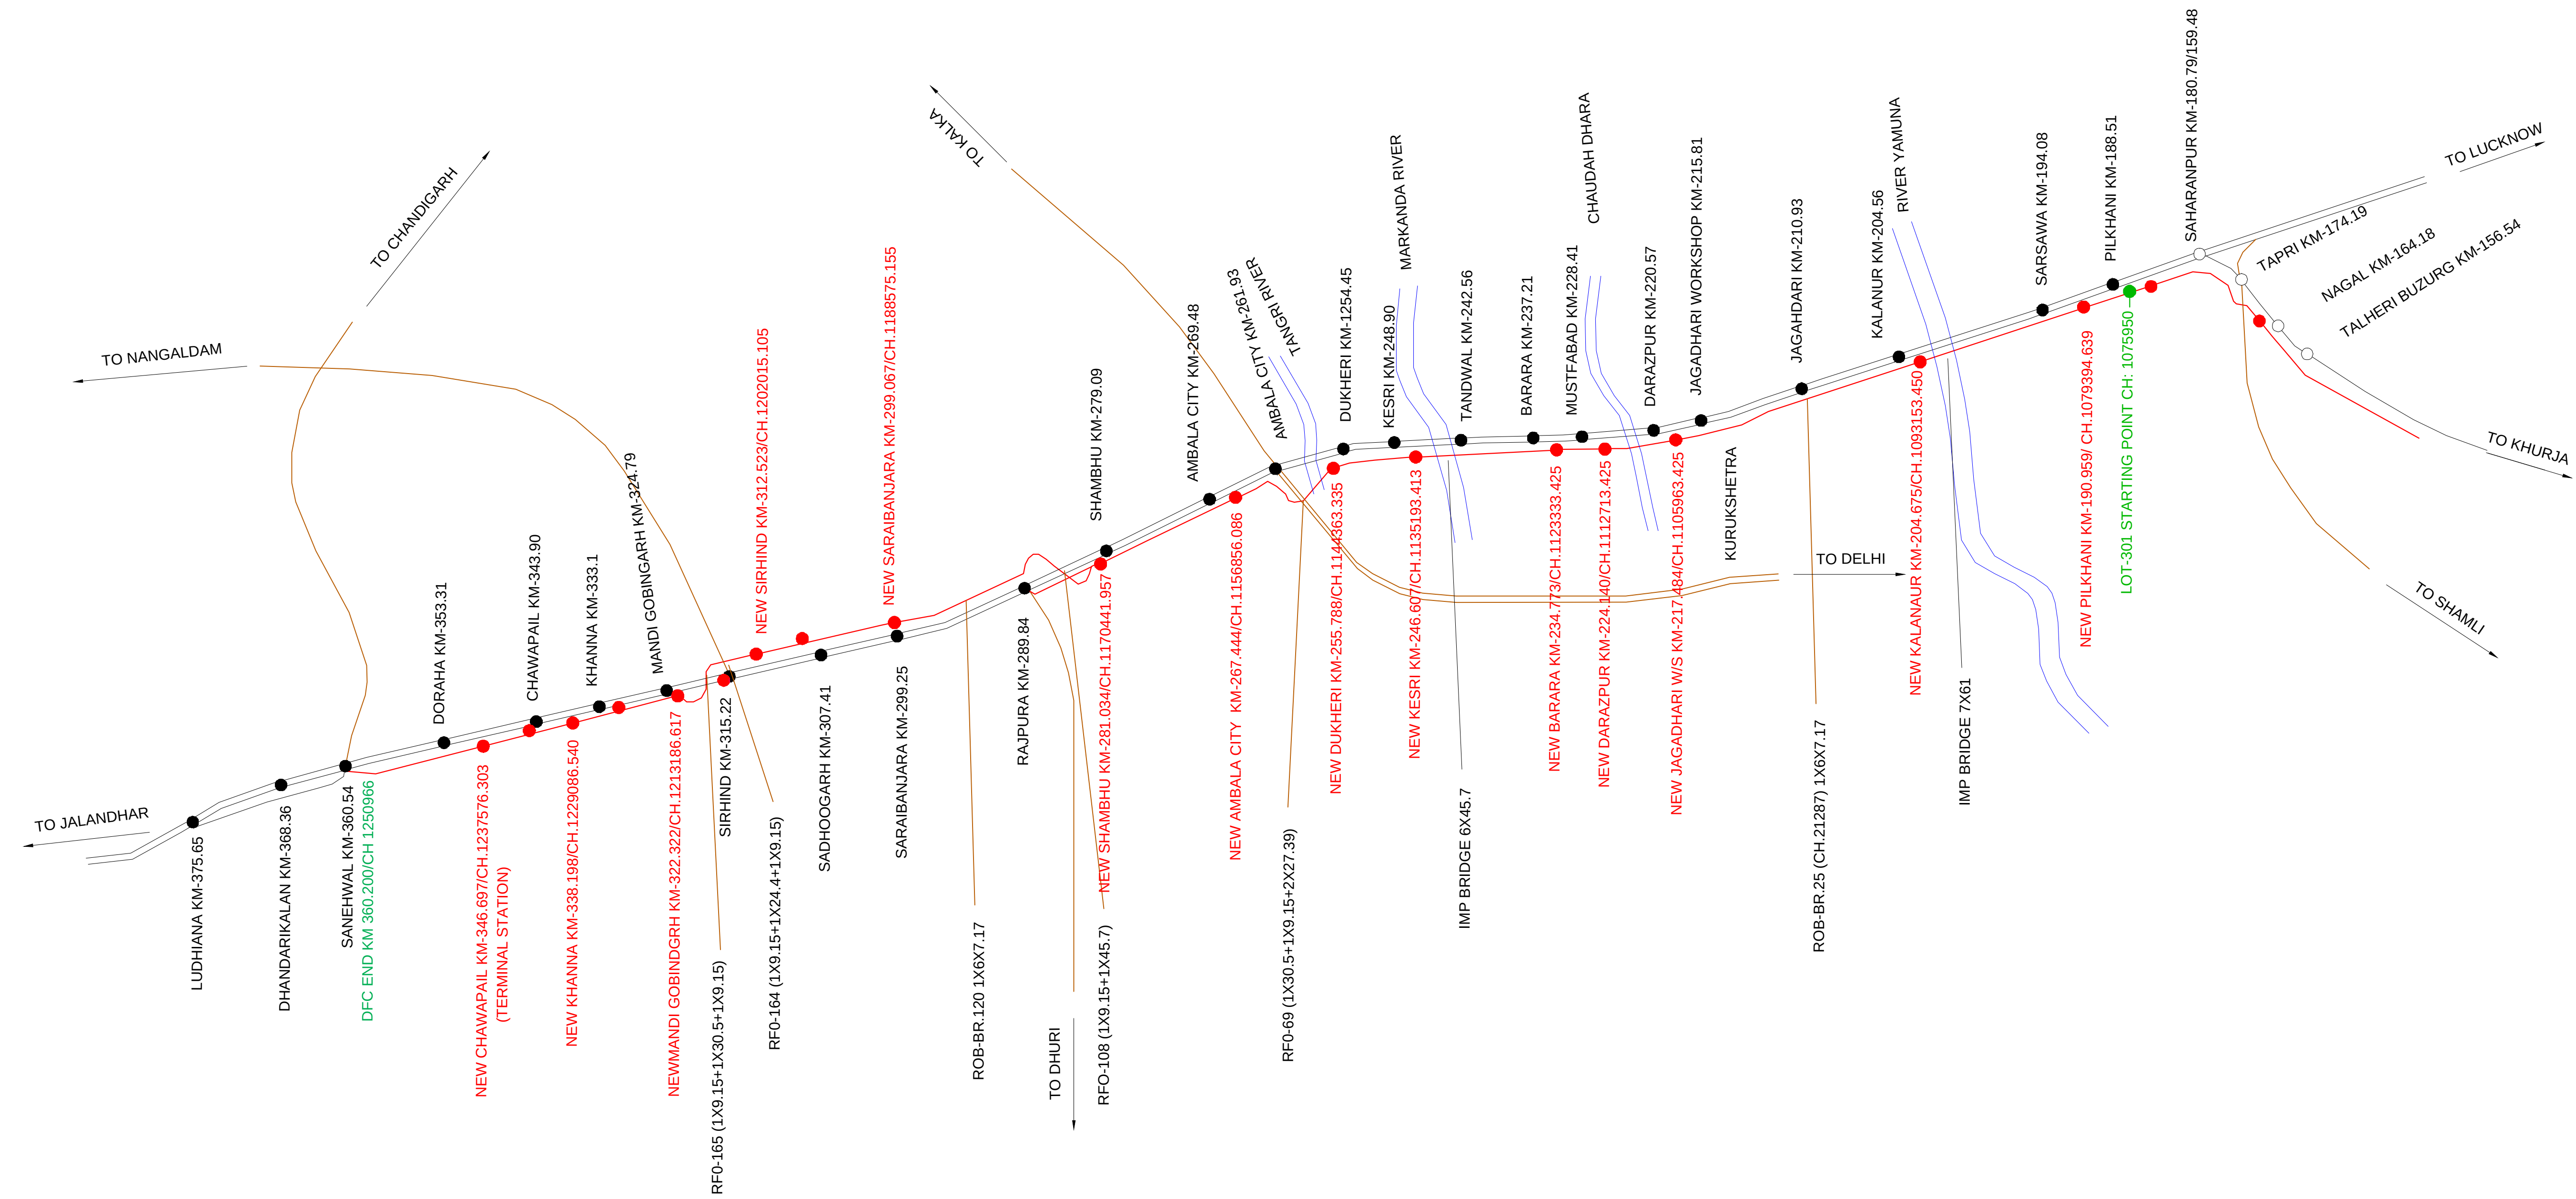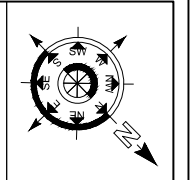


				SCALE	DESIGN CONSULTANT	CONTRACTOR	ENGINEER	OWNER	PROJECT	TITLE	DFCC APPR. NO. -		
				NOT TO SCALE					DEDICATED FREIGHT CORRIDOR CORPORATION OF INDIA LTD. (A GOVERNMENT OF INDIA ENTERPRISE) PROJECT OFFICE(AMBALA UNIT): OLD RAILWAY COLONY (NEAR ANAND MARKET),AMBALA CANTT-133001. CORPORATE IDENTITY NO. : U60232DL2006GOI155068	EASTERN DEDICATED FREIGHT CORRIDOR SAHNEWAL TO PILKHANI CONTRACT PACKAGE - 301	ENGG. APPR. NO. -		
											DRG. NO. : 301-2/AL/0001	REV. NO.	STATUS
REV.	DATE	REVISION DETAILS									PURPOSE OF ISSUE		
											DATE : 15-06-2024	0	A

LEGEND	
EXISTING IR TRACK	
DFC TRACK	
DFC FUTURE PROPOSALS	
IR PROPOSALS	
TOE LINE	
FORMATION CESS	
RETAINING WALL	
DRAIN CUM RETAINING WALL	
ROAD	
STREAM, DRAIN, NALA, CANAL.	
FENCE	
POWER LINES	
GPS POINTS	
ELECTRIC POLE/OHE MAST	
EXISTING RAILWAY BOUNDARY	
DFC BOUNDARY	
DISMANTLED WORKS	
IOCL PIPE LINE	
IOCL ROW	
SIGNALLING CABLE PIPE	

ABBREVIATIONS		
1.	BL	- BED LEVEL
2.	BVC	- BEGIN OF VERTICAL CURVE
3.	Ca	- APPLIED CANT
4.	CCL	- CIRCULAR CURVE LENGTH
5.	CTP1	- COMMON TANGENT POINT
6.	CTP2	- COMMON TANGENT POINT
7.	DEGREE	- DEGREE OF CURVE
8.	DE	- DEAD END
9.	ECL	- EXISTING CLEARANCE
10.	EFB	- EXISTING FREE BOARD
11.	EFL	- EXISTING FORMATION LEVEL
12.	ERL	- EXISTING RAIL LEVEL
13.	ESL	- EXISTING SOFFIT LEVEL
14.	EVC	- END OF VERTICAL CURVE
15.	EVCL	- EXISTING VERTICAL CLEARANCE
16.	F/CSB	- FROM CENTER LINE OF STN BLDG
17.	FM	- FOULING MARK
18.	FSL	- FULL SUPPLY LEVEL
19.	HFL	- HIGH FLOOD LEVEL
20.	L	- STRAIGHT LENGTH
21.	LH	- LEFT HANDED
22.	LHS	- LIMITED HEIGHT SUBWAY
23.	PCL	- PROPOSED CLEARANCE
24.	PFB	- PROPOSED FREE BOARD
25.	PFL	- PROPOSED FORMATION LEVEL
26.	PRL	- PROPOSED RAIL LEVEL
27.	PSL	- PROPOSED SOFFIT LEVEL
28.	PVCL	- PROPOSED VERTICAL CLEARANCE
29.	PVI	- POINT OF VERTICAL INTERSECTION
30.	R	- RADIUS
31.	REV.BL	- REVISED BED LEVEL
32.	RH	- RIGHT HANDED
33.	Rr	- RESULTANT RADIUS
34.	SE	- SUPER ELEVATION
35.	SRJ	- STOCK RAIL JOINT
36.	TS	- TRAP SWITCH
37.	TTL	- TOTAL TANGENT LENGTH
38.	TTP1	- TRANSITION TANGENT POINT
39.	TTP2	- TRANSITION TANGENT POINT
40.	TL	- TRANSITION LENGTH
41.	DELTA	- DEFLECTION ANGLE

				SCALE	DESIGN CONSULTANT	CONTRACTOR	ENGINEER	OWNER	PROJECT	TITLE	DFCC APPR. NO. -					
				NOT TO SCALE	 aarvee associates architects engineers & consultants pvt.ltd.	  GIL - TPL JV	 DB Engineering & Consulting GmbH	 मेडीकेटर फ्रेट कॉर्पोरेश	DEDICATED FREIGHT CORRIDOR CORPORATION OF INDIA LTD. (A GOVERNMENT OF INDIA ENTERPRISE) PROJECT OFFICE(AMBALA UNIT): OLD RAILWAY COLONY (NEAR ANAND MARKET),AMBALA CANTT-133001. CORPORATE IDENTITY NO. : U60232DL2006GOI155068	EASTERN DEDICATED FREIGHT CORRIDOR SAHNEWAL TO PILKHANI CONTRACT PACKAGE - 301	ALIGNMENT DRAWINGS LEGEND AND ABBREVIATIONS	ENG. APPR. NO. -				
																DRG. NO. - 301-2/AL/1000
REV.	DATE	REVISION DETAILS	PURPOSE OF ISSUE								SHEET NO. : 1 OF 1	REV. No.	STATUS			
											DATE : 15-06-2024	0	A			

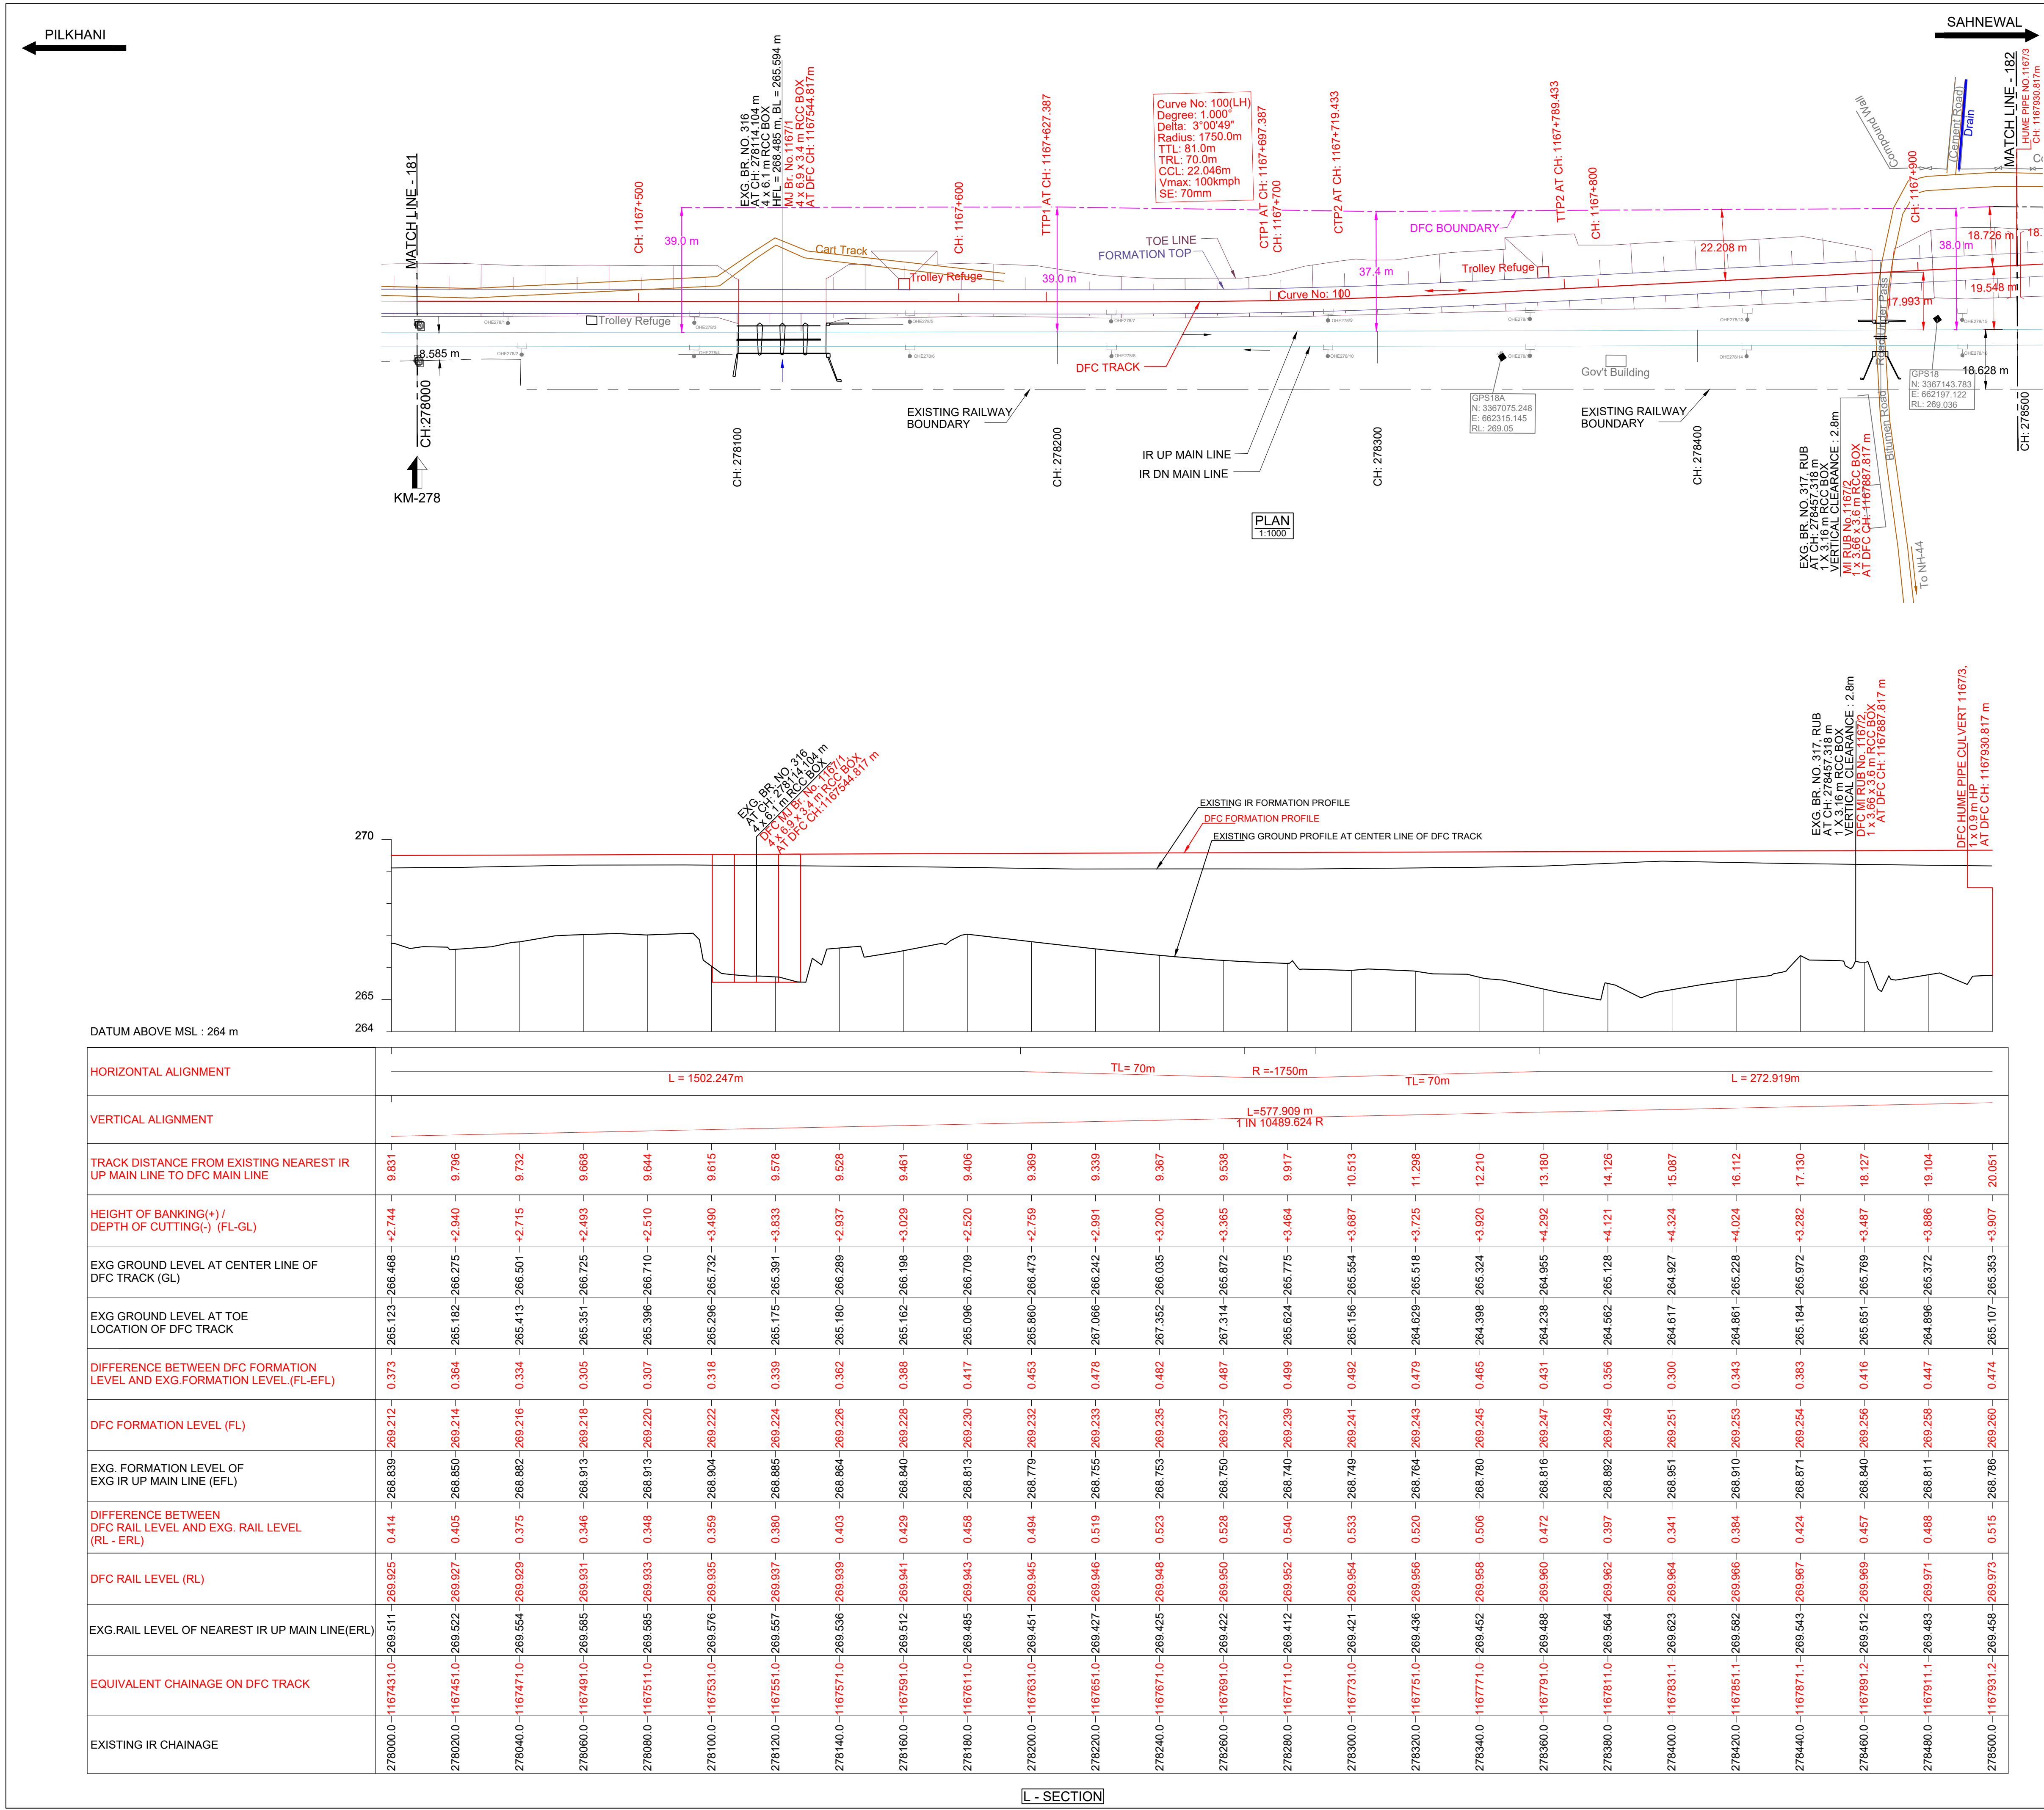

NOTE:-

- DFCC WORKS ARE SHOWN IN RED.
- IR NEW WORKS ARE SHOWN IN VIOLET.
- ALL DIMENSIONS ARE SHOWN IN METRES.
- THIS DRAWING IS PREPARED BASED ON LATEST SURVEY DATA HELD ON APRIL-2022. GTS BENCH MARK OF 261.850M CONSIDERED ON TOP OF CANAL BRIDGE ABUTMENT AT DORANA VILLAGE ALONG THE NH1.
- DFC NEW CHAINAGE OF 1075.950M IS WITH REFERENCE TO THE IR KM OF 187.500KM END OF KM OF CP-303(SECTION P-3 PILKHANI END) AGAINST THE EXISTING DFC CHAINAGE. 116277.742M ISSUED VIDE LETTER NO. COM/DFCC/UMS/SURVEY/2021-301-230116-011173.DT. 17.01.2023.
- BALLAST PROFILE HAS BEEN PROVIDED ACCORDING TO THE CLAUSE 1.11.3 OF STANDARD SCHEDULE OF DIMENSION(EASTERN CORRIDOR) & THE BALLAST CUSHION DIMENSION SHOWN IN 35CM ON GE-14 PARA 17. SPECIFICATIONS & RECOMMENDATIONS 2. TWO LAYER SYSTEM FIG.10.

REFERENCE DRAWINGS:-

- FOR KEY PLAN REFER DRAWING NO. 301-2/AL/0001
- FOR LEGEND AND ABBREVIATIONS REFER DRAWING NO. 301-2/AL/1000
- FOR TYPICAL SECTION OF BALLAST PROFILE (FL-RL) REFER DRG. NO. 301-2/TK/TFD/004 (TR.1952)

REVISIONS

REV.	DATE	REVISION DETAILS	PURPOSE OF ISSUE
0	02.09.2024	SUBMISSION OF AS-BUILT DRAWING	FOR APPROVAL

LEGEND:

- IR TRACK
- DFCC TRACK
- DFCC FUTURE PROPOSALS
- STRUCTURE / BUILDING
- DFCC TOE LINE
- DFCC FORMATION
- RETAINING WALL
- ROAD
- STREAM, DRAIN, NALA, CANAL.
- FENCE
- POWER LINES
- TBM
- ELECTRIC POLE/OHE MAST
- IR RAILWAY BOUNDARY
- DFCC BOUNDARY

SCALE

HOR - 1:1000

VER - 1:100

SHEET SIZE : A1

TYPICAL SECTION

TRACK STRUCTURE

RAIL SECTION: 60Kg/m (UIC 60Kg/m) DFC LINE: 60Kg/m (UIC 60Kg/m) IR MAIN LINE: 52Kg/m	Difference between FL- RL (Below Rail Seat)	
	IR Line	DFC
RUBBER PAD	172mm	172mm
SLEEPER DEPTH	6mm	10mm
BALLAST CUSHION	210mm	210mm
Total Depth (FL TO RL)	688mm	742mm

OWNER

DEDICATED FREIGHT CORRIDOR CORPORATION OF INDIA LTD.

(A GOVERNMENT OF INDIA ENTERPRISE)

PROJECT OFFICE(AMBALA UNIT): OLD RAILWAY COLONY (NEAR ANAND MARKET),AMBALA CANTT-133001.

CORPORATE IDENTITY NO. : U60232DL2006GGI155068

ENGINEER:

DB Engineering & Consulting GmbH

Deutsche Bahn Engineering & Consulting GmbH

CONTRACTOR:

GIL - TPL JV

GAR TATA

SUBMITTED BY

GIL - TPL JV

DATED

NAME

SIGNATURE

PREPARED BY

CHECKED BY

02.09.2024

VIJAY PRATAP

APPROVED BY

02.09.2024

PARASURAM KOTYADA

APPROVED BY

DEUTSCHE BAHN ENGINEERING & CONSULTING GMBH

DATED

NAME

SIGNATURE

Sr. DE./CHIEF ENGINEER

SURESH K.YALANGI

CHIEF TRACK ENGINEER

RAJ PAL SINGH

T.L.

H.D. VIDJAK

STAMP

AS-BUILT DRAWING

TR. Ref.:.....

ENGINEER Sign.:.....

EMPLOYER (DFCCIL):

DEDICATED FREIGHT CORRIDOR CORPORATION OF INDIA LTD.

AS BUILT DRAWING

TITLE

AS-BUILT PLAN AND PROFILE

DFCC APPR. NO. -

ENGG. APPR. NO. -

FROM IR KM: 278.000 TO 278.500



DFC KM: 1167.431 TO 1167.931

SHEET NO. : 1 OF 1

DATE : 02.09.2024

STATUS

A

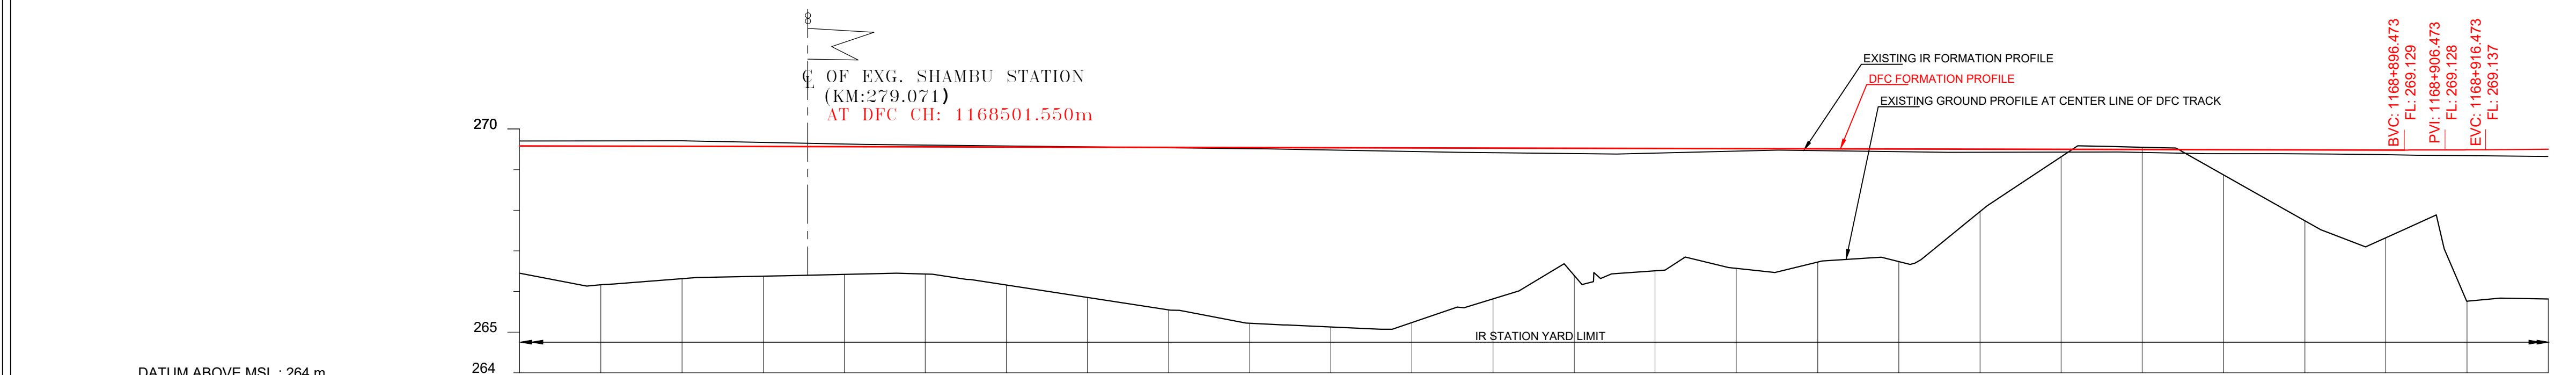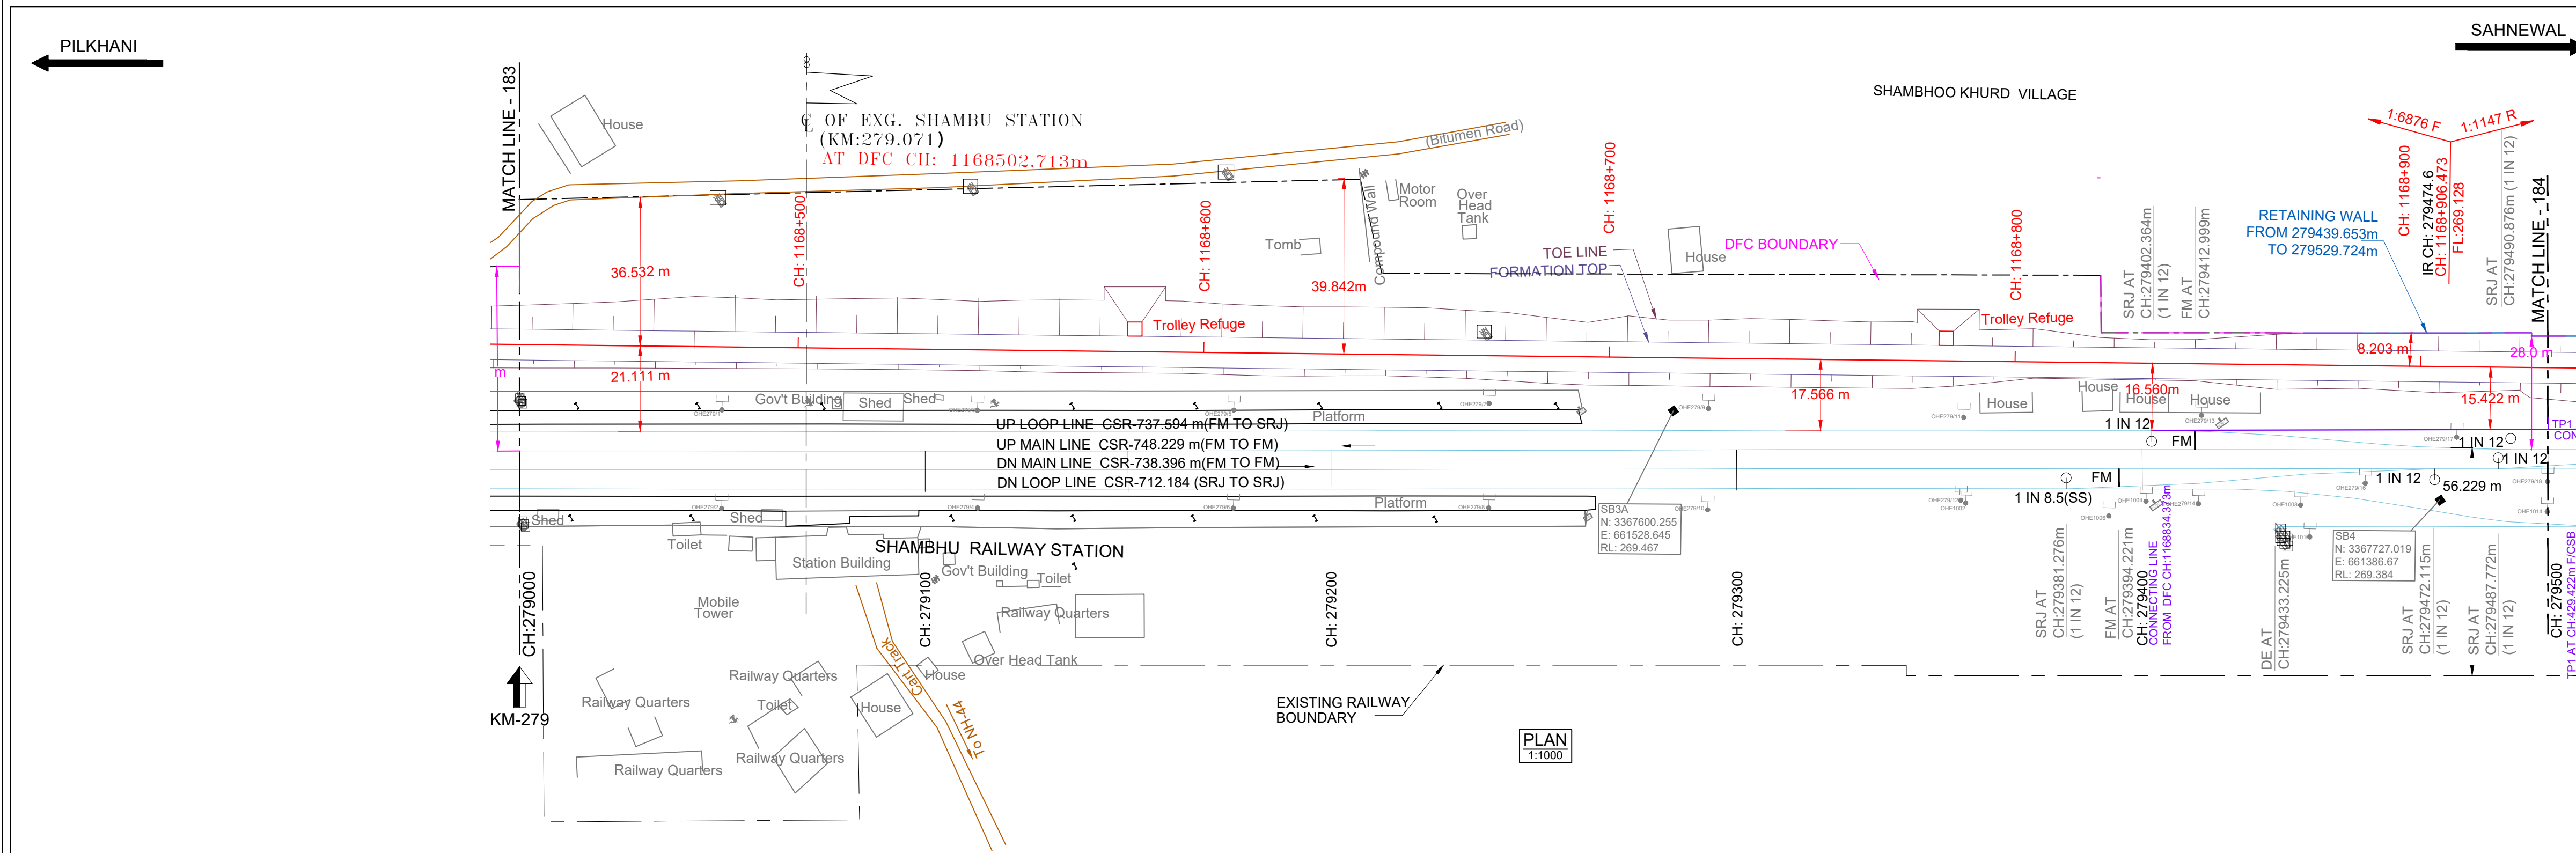

HORIZONTAL ALIGNMENT	L = 1219.90m																								
VERTICAL ALIGNMENT	L=915.112 m 1 IN 6875.824 F L=20.0 m R=19664.06 1 IN 1147.25 F L=748.66m 1 IN 1147.25 F																								
TRACK DISTANCE FROM EXISTING IR UP MAIN LINE TO DFC MAIN LINE	26.237																								
HEIGHT OF BANKING(+) / DEPTH OF CUTTING(-) (FL-GL)	+3.133																								
EXG GROUND LEVEL AT CENTER LINE OF DFC TRACK (GL)	266.064																								
EXG GROUND LEVEL AT TOE LOCATION OF DFC TRACK	266.210																								
DIFFERENCE BETWEEN DFC FORMATION LEVEL AND EXG FORMATION LEVEL (FL-EFL)	-0.140																								
DFC FORMATION LEVEL (FL)	269.197																								
EXG. FORMATION LEVEL OF EXG IR UP MAIN LINE (EFL)	269.337																								
DIFFERENCE BETWEEN DFC RAIL LEVEL AND EXG. RAIL LEVEL (RL - ERL)	-0.099																								
DFC RAIL LEVEL (RL)	269.910																								
EXG.RAIL LEVEL OF NEAREST IR UP MAIN LINE(ERL)	270.009																								
EQUIVALENT CHAINAGE ON DFC TRACK	1168431.5																								
EXISTING IR CHAINAGE	279000.0																								

L - SECTION

NOTE:-

- DFCC WORKS ARE SHOWN IN RED.
- IR NEW WORKS ARE SHOWN IN VIOLET.
- ALL DIMENSIONS ARE SHOWN IN METRES.
- THIS DRAWING IS PREPARED BASED ON LATEST SURVEY DATA HELD ON APRIL-2022. GTS BENCH MARK OF 261.850M CONSIDERED ON TOP OF CANAL BRIDGE ABUTMENT AT DORANA VILLAGE ALONG THE NH1.
- DFC NEW CHAINAGE OF 1075.950M IS WITH REFERENCE TO THE IR KM OF 187.500KM END OF KM OF CP-303(SECTION P-3 PILKHANI END) AGAINST THE EXISTING DFC CHAINAGE. 116277.742M ISSUED VIDE LETTER NO. COM/DFCC/UM/SURVEY/2021-301-230116-01173.DT. 17.01.2023.
- BALLAST PROFILE HAS BEEN PROVIDED ACCORDING TO THE CLAUSE 1.11.3 OF STANDARD SCHEDULE OF DIMENSION(EASTERN CORRIDOR) & THE BALLAST CUSHION DIMENSION SHOWN IN 35CM ON GE-14 PARA 17. SPECIFICATIONS & RECOMMENDATIONS 2. TWO LAYER SYSTEM FIG.10.

REFERENCE DRAWINGS:-

- FOR KEY PLAN REFER DRAWING NO. 301-2/AL/0001
- FOR LEGEND AND ABBREVIATIONS REFER DRAWING NO. 301-2/AL/1000
- FOR TYPICAL SECTION OF BALLAST PROFILE (FL-RL) REFER DRG. NO. 301-2/TK/TFD/-004 (TR.1952)

DRG NO.- 301-2/AL/A/1184

02.09.2024

SUBMISSION OF AS-BUILT DRAWING

FOR APPROVAL

REV. DATE REVISION DETAILS PURPOSE OF ISSUE

LEGEND:

IR TRACK
DFCC TRACK
DFCC FUTURE PROPOSALS
STRUCTURE / BUILDING
DFCC TOE LINE
DFCC FORMATION
RETAINING WALL
ROAD
STREAM, DRAIN, NALA, CANAL.
POWER LINES
TBM
ELECTRIC POLE/OHE MAST
IR RAILWAY BOUNDARY
DFCC BOUNDARY

SCALE

HOR - 1:1000

VER - 1:100

SHEET SIZE : A1

TYPICAL SECTION

TRACK STRUCTURE

RAIL SECTION: 60Kg/m (UIC 60Kg/m) DFC LINE: 60Kg/m (UIC 60Kg/m) IR MAIN LINE: 52Kg/m	Difference between FL- RL (Below Rail Seat)	
	IR Line	DFC
RUBBER PAD	172mm	172mm
SLEEPER DEPTH	6mm	10mm
BALLAST CUSHION	210mm	210mm
Total Depth (FL TO RL)	300mm	350mm

OWNER

DEDICATED FREIGHT CORRIDOR CORPORATION OF INDIA LTD.

(A GOVERNMENT OF INDIA ENTERPRISE)

PROJECT OFFICE(AMBALA UNIT): OLD RAILWAY COLONY (NEAR ANAND MARKET),AMBALA CANTT-133001.

CORPORATE IDENTITY NO. : U60232DL2006GGI155068

ENGINEER:

DB Engineering & Consulting GmbH

Deutsche Bahn Engineering & Consulting GmbH

CONTRACTOR:

GIL - TPL JV

GAR TATA

SUBMITTED BY

GIL - TPL JV

DATED

NAME

SIGNATURE

PREPARED BY

CHECKED BY

02.09.2024

VIJAY PRATAP

APPROVED BY

02.09.2024

PARASURAM KOTYADA

APPROVED BY

DEUTSCHE BAHN ENGINEERING & CONSULTING GMBH

DATED

NAME

SIGNATURE

Sr. DE./CHIEF ENGINEER

SURESH K.YALANGI

CHIEF TRACK ENGINEER

RAJ PAL SINGH

T.L.

H.D. VIDJAK

STAMP

AS-BUILT DRAWING

TR. Ref.....

ENGINEER Sign.:

EMPLOYER (DFCCIL):

DEDICATED FREIGHT CORRIDOR CORPORATION OF INDIA LTD.

AS BUILT DRAWING

TITLE

AS-BUILT PLAN AND PROFILE

DFCC APPR. NO. -

ENG. APPR. NO. -

FROM IR KM: 279.000 TO 279.500

DRG. NO. - 301-2/AL/A/1184


DFC KM: 1168.431 TO 1168.931

SHEET NO. : 1 OF 1

DATE : 02.09.2024

STATUS


A

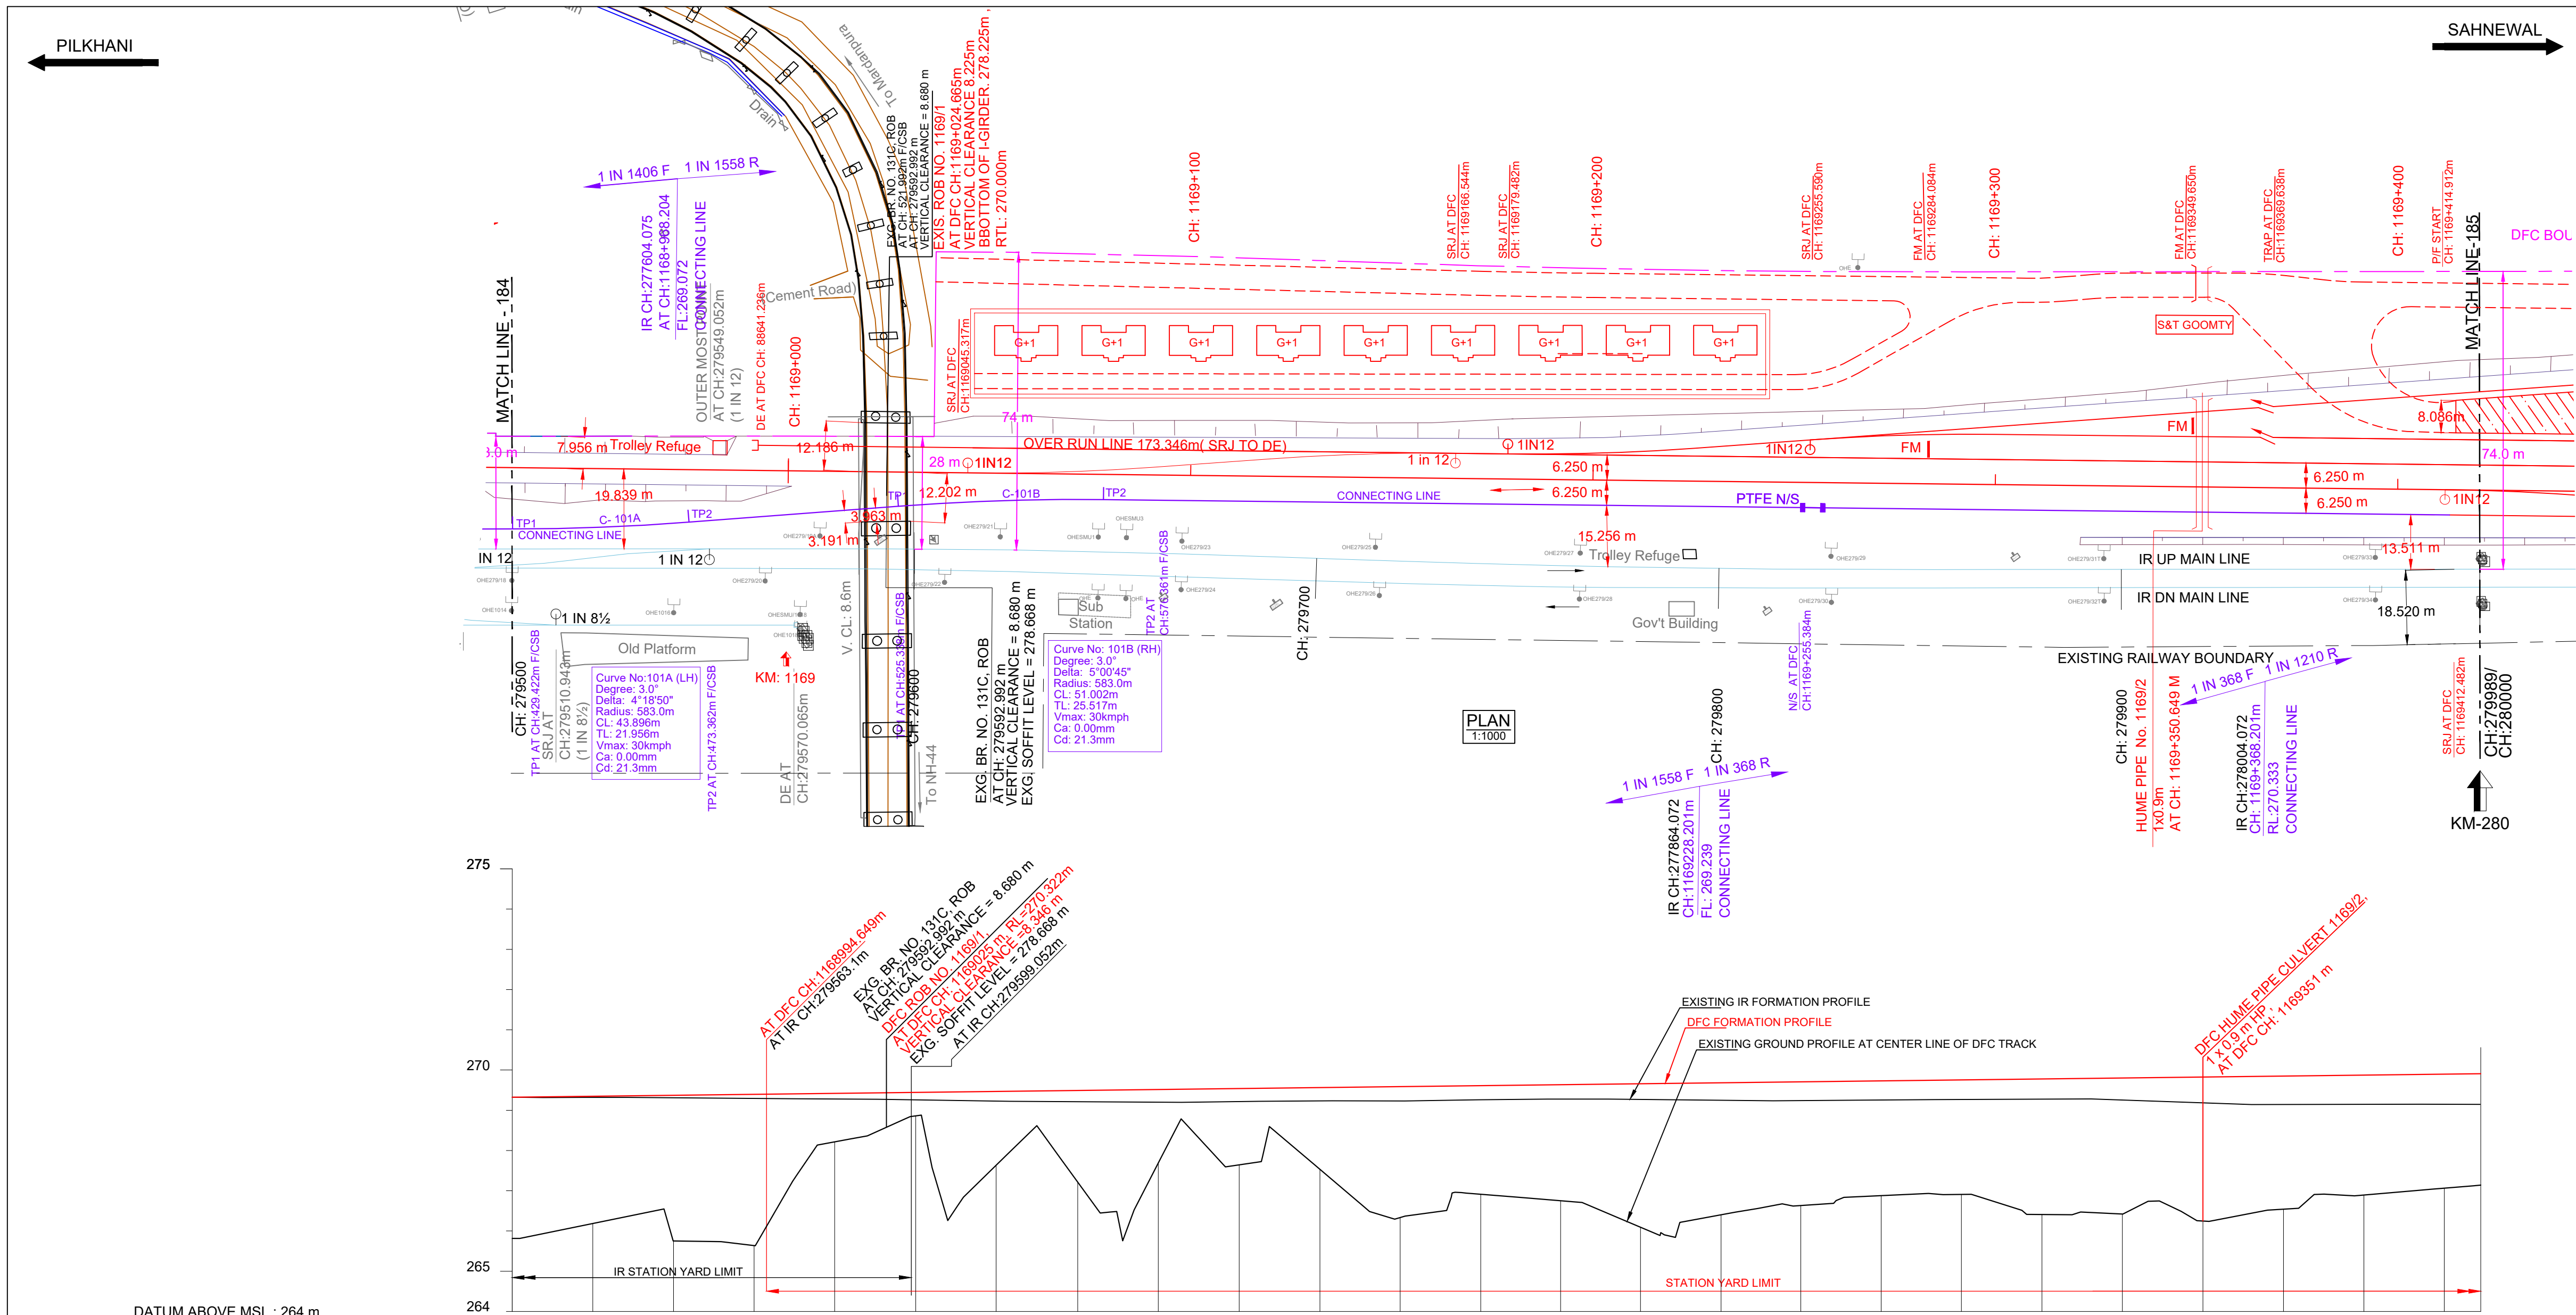

HORIZONTAL ALIGNMENT	L = 1219.90m																		
VERTICAL ALIGNMENT	L=748.66m 1 IN:1147.25R																		
TRACK DISTANCE FROM EXISTING IR UP MAIN LINE TO DFC MAIN LINE	20.196																		
HEIGHT OF BANKING(+) / DEPTH OF CUTTING(-) (FL-GL)	+3.126																		
EXG GROUND LEVEL AT CENTER LINE OF DFC TRACK (GL)	266.024																		
EXG GROUND LEVEL AT TOE LOCATION OF DFC TRACK	-265.686																		
DIFFERENCE BETWEEN DFC FORMATION LEVEL AND EXG.FORMATION LEVEL (FL-EFL)	0.161																		
DFC FORMATION LEVEL (FL)	269.150																		
EXG. FORMATION LEVEL OF EXG IR UP MAIN LINE (EFL)	269.988																		
DIFFERENCE BETWEEN DFC RAIL LEVEL AND EXG. RAIL LEVEL (RL - ERL)	0.202																		
DFC RAIL LEVEL (RL)	269.863																		
EXG.RAIL LEVEL OF NEAREST IR UP MAIN LINE(ERL)	269.660																		
EQUIVALENT CHAINAGE ON DFC TRACK	116931.5																		
EXISTING IR CHAINAGE	279500.0																		

L - SECTION

SAHNEWAL

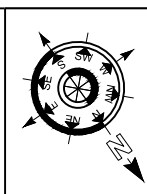

- NOTE:-
- DFCC WORKS ARE SHOWN IN RED.
 - IR NEW WORKS ARE SHOWN IN VIOLET.
 - ALL DIMENSIONS ARE SHOWN IN METRES.
 - THIS DRAWING IS PREPARED BASED ON LATEST SURVEY DATA HELD ON APRIL-2022. GTS BENCH MARK OF 261.850M CONSIDERED ON TOP OF CANAL BRIDGE ABUTMENT AT DORANA VILLAGE ALONG THE NH1.
 - DFC NEW CHAINAGE OF 1075.950M IS WITH REFERENCE TO THE IR KM OF 187.500KM END OF KM OF CP-303(SECTION P-3 PILKHANI END) AGAINST THE EXISTING DFC CHAINAGE. 116277.742M ISSUED VIDE LETTER NO. GOM/DFCC/COMB/SURVEY/2021-301-2301/16-11/173 DT. 17.01.2023.
 - BALLAST PROFILE HAS BEEN PROVIDED ACCORDING TO THE CLAUSE 1.11.3 OF STANDARD SCHEDULE OF DIMENSION(EASTERN CORRIDOR) & THE BALLAST CUSHION DIMENSION SHOWN IN 35CM ON GE-14 PARA 17. SPECIFICATIONS & RECOMMENDATIONS 2. TWO LAYER SYSTEM FIG.10.

- REFERENCE DRAWINGS:-
- FOR KEY PLAN REFER DRAWING NO. 301-2/AL/0001
 - FOR LEGEND AND ABBREVIATIONS REFER DRAWING NO. 301-2/AL/1000
 - FOR TYPICAL SECTION OF BALLAST PROFILE (FL-RL) REFER DRG. NO. 301-2/TK/TFDI-004 (TR.1952)

REV.	DATE	REVISION DETAILS	PURPOSE OF ISSUE
0	02.09.2024	SUBMISSION OF AS-BUILT DRAWING	FOR APPROVAL

LEGEND:

SCALE

HOR - 1:1000

VER - 1:100

SHEET SIZE : A1

IR TRACK

DFCC TRACK

DFCC FUTURE PROPOSALS

STRUCTURE / BUILDING

DFCC TOE LINE

DFCC FORMATION

RETAINING WALL

ROAD

STREAM, DRAIN, NALA, CANAL


POWER LINES

TBM

ELECTRIC POLE/OHE MAST

IR RAILWAY BOUNDARY

DFCC BOUNDARY

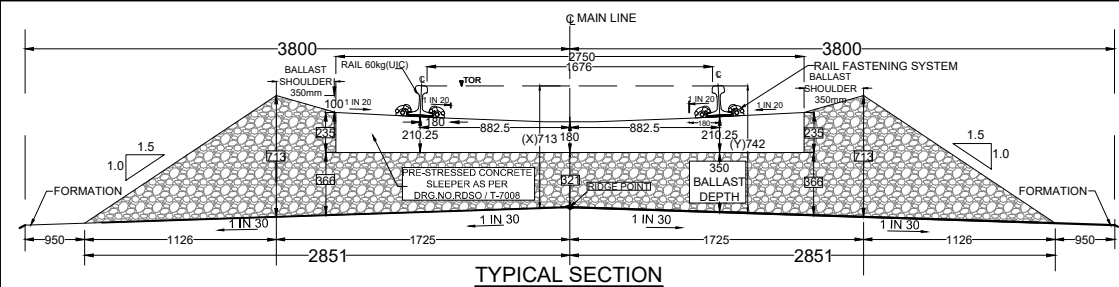

TRACK STRUCTURE		
RAIL SECTION: 60Kg/m (UIC 60Kg/m) DFC LINE: 60Kg/m (UIC 60Kg/m) IR MAIN LINE: 52Kg/m	Difference between FL- RL (Below Rail Seat)	
	IR Line	DFC
RUBBER PAD	172mm	172mm
SLEEPER DEPTH	6mm	10mm
BALLAST CUSHION	210mm	210mm
Total Depth (FL TO RL)	300mm	350mm

OWNER

DEDICATED FREIGHT CORRIDOR CORPORATION OF INDIA LTD.

(A GOVERNMENT OF INDIA ENTERPRISE)

PROJECT OFFICE(AMBALA UNIT): OLD RAILWAY COLONY (NEAR ANAND MARKET),AMBALA CANTT-133001.

CORPORATE IDENTITY NO. : U60232DL20060G01155068

ENGINEER:

DB Engineering & Consulting GmbH

Deutsche Bahn Engineering & Consulting GmbH

CONTRACTOR:



GIL - TPL JV

GAR TATA

SUBMITTED BY	GIL - TPL JV		
	DATED	NAME	SIGNATURE
PREPARED BY			
CHECKED BY	02.09.2024	VIJAY PRATAP	
APPROVED BY	02.09.2024	PARASURAM KOTYADA	
APPROVED BY	DEUTSCHE BAHN ENGINEERING & CONSULTING GMBH		
	DATED	NAME	SIGNATURE
Sr. DE./CHIEF ENGINEER		SURESH K.YALANGI	
CHIEF TRACK ENGINEER		RAJ PAL SINGH	
T.L.		H.D. VIDJAK	

STAMP	A AS-BUILT DRAWING TR. Ref.:..... ENGINEER Sign.:.		
EMPLOYER (DFCCIL):	DEDICATED FREIGHT CORRIDOR CORPORATION OF INDIA LTD.		

AS BUILT DRAWING			
TITLE		DFCC APPR. NO. -	
AS-BUILT PLAN AND PROFILE		ENGG. APPR. NO. -	
FROM IR KM: 279.500 TO 280.000		DRG. NO. - 301-2/AL/A/1185	
DFC KM: 1168.931 TO 1169.421		SHEET NO. : 1 OF 1	
		DATE : 02.09.2024	
		STATUS	
		A	

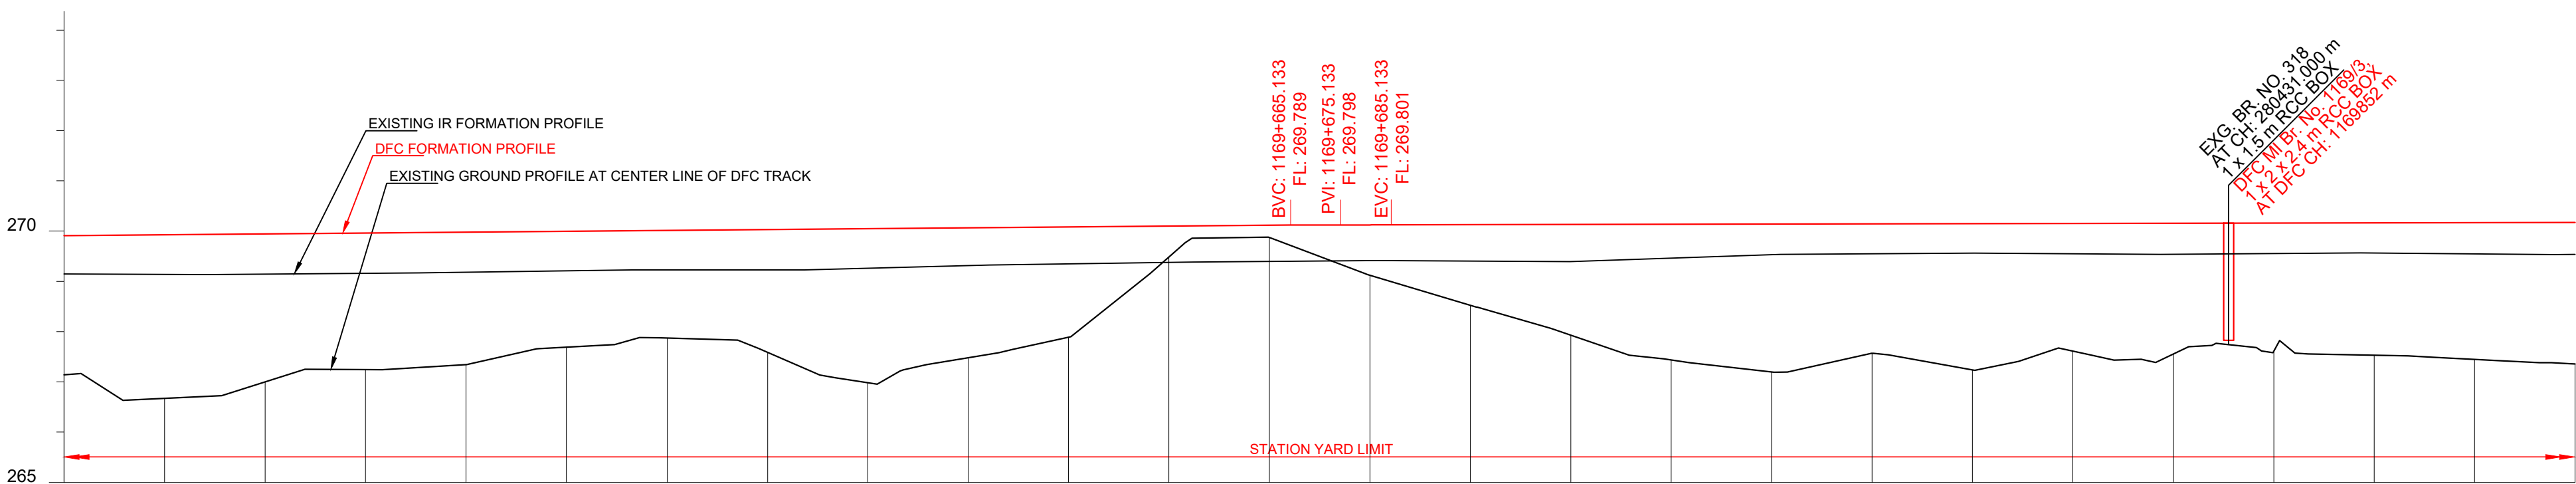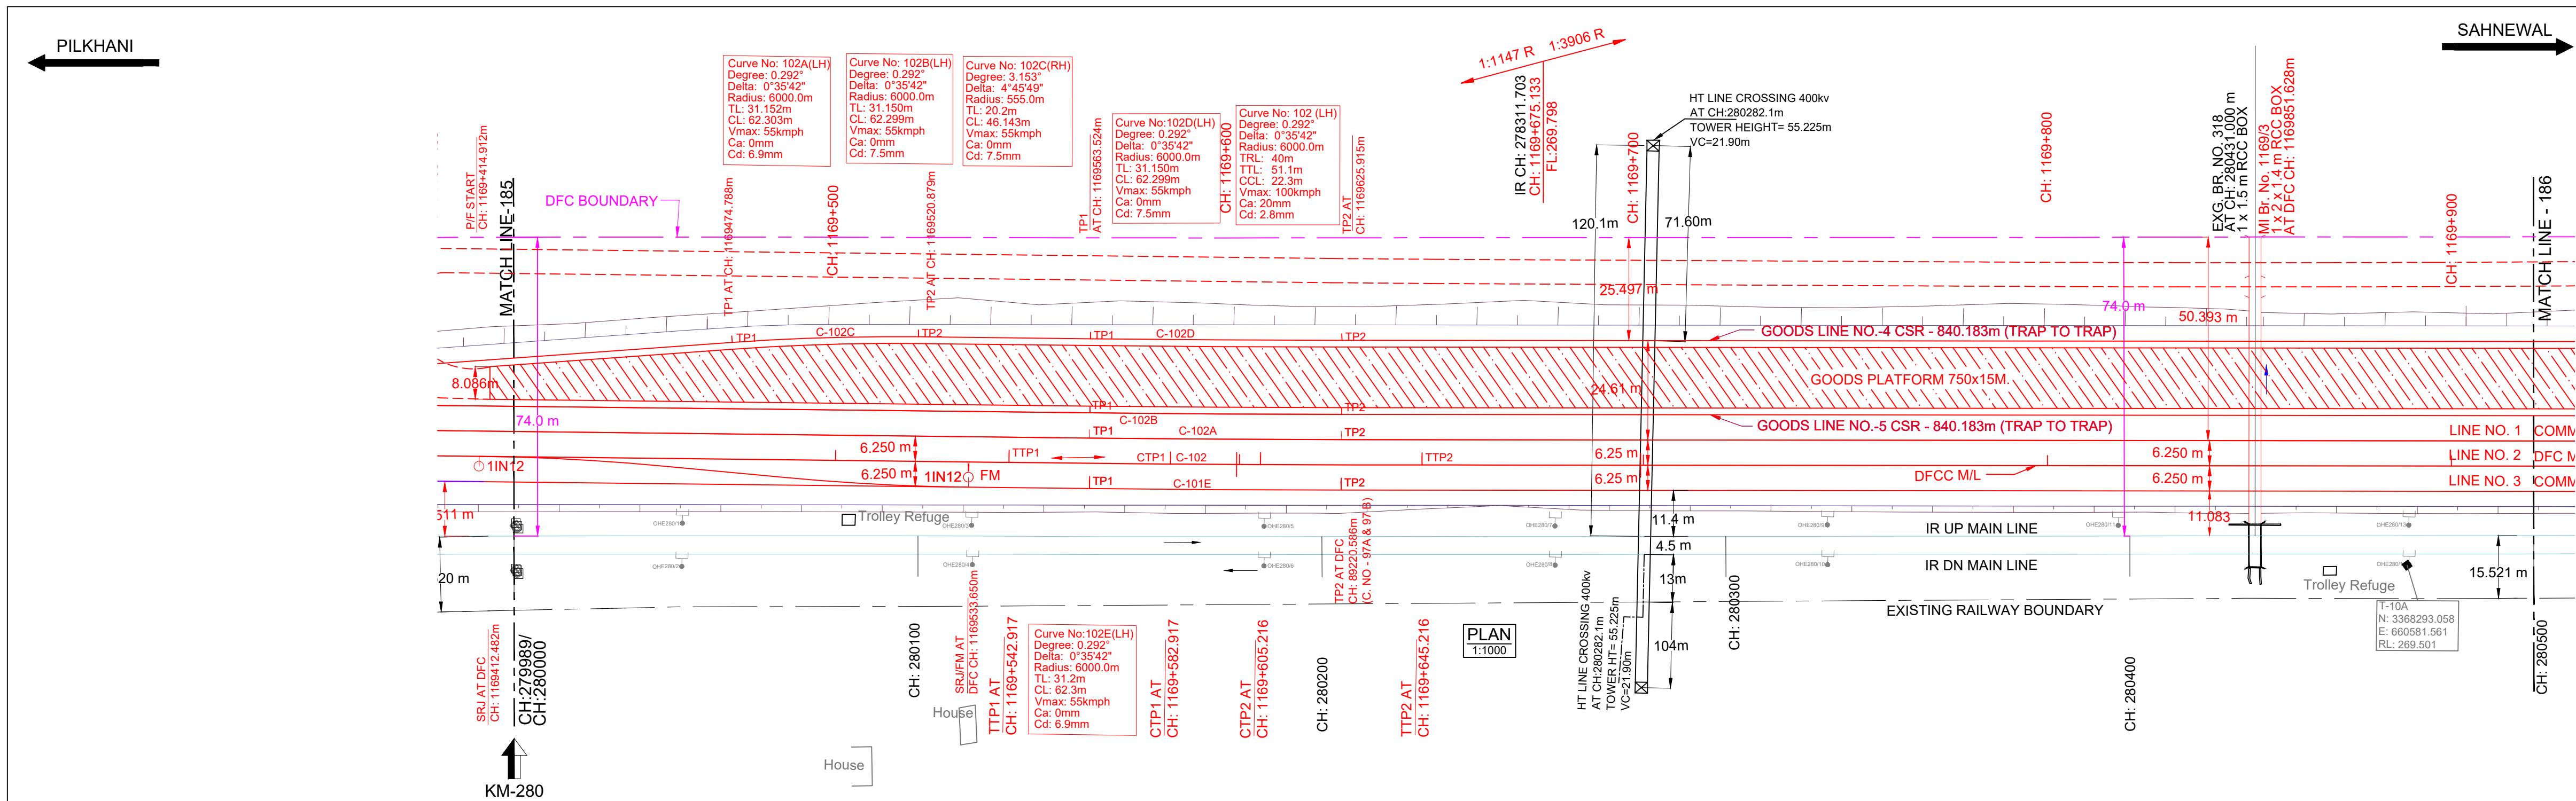

HORIZONTAL ALIGNMENT	L = 1219.90m TL = 40m R = -6000m TL = 40m L = 2649.978m																			
VERTICAL ALIGNMENT	L=748.86m 1 IN:1147.25R L=20.0m R=32486.19 L=1772.700m 1 IN:3905.664 R																			
TRACK DISTANCE FROM EXISTING IR UP MAIN LINE TO DFC MAIN LINE	19.650	19.650	19.650	19.650	19.650	19.650	19.650	19.650	19.650	19.650	19.650	19.650	19.650	19.650	19.650	19.650	19.650	19.650	19.650	19.650
HEIGHT OF BANKING(+) / DEPTH OF CUTTING(-) (FL-GL)	+2.772	+2.772	+2.772	+2.772	+2.772	+2.772	+2.772	+2.772	+2.772	+2.772	+2.772	+2.772	+2.772	+2.772	+2.772	+2.772	+2.772	+2.772	+2.772	+2.772
EXG GROUND LEVEL AT CENTER LINE OF DFC TRACK (GL)	266.804	266.804	266.804	266.804	266.804	266.804	266.804	266.804	266.804	266.804	266.804	266.804	266.804	266.804	266.804	266.804	266.804	266.804	266.804	266.804
EXG GROUND LEVEL AT TOE LOCATION OF DFC TRACK	266.968	266.968	266.968	266.968	266.968	266.968	266.968	266.968	266.968	266.968	266.968	266.968	266.968	266.968	266.968	266.968	266.968	266.968	266.968	266.968
DIFFERENCE BETWEEN DFC FORMATION LEVEL AND EXG.FORMATION LEVEL (FL-EFL)	0.749	0.749	0.749	0.749	0.749	0.749	0.749	0.749	0.749	0.749	0.749	0.749	0.749	0.749	0.749	0.749	0.749	0.749	0.749	0.749
DFC FORMATION LEVEL (FL)	269.576	269.576	269.576	269.576	269.576	269.576	269.576	269.576	269.576	269.576	269.576	269.576	269.576	269.576	269.576	269.576	269.576	269.576	269.576	269.576
EXG. FORMATION LEVEL OF EXG IR UP MAIN LINE (EFL)	268.827	268.827	268.827	268.827	268.827	268.827	268.827	268.827	268.827	268.827	268.827	268.827	268.827	268.827	268.827	268.827	268.827	268.827	268.827	268.827
DIFFERENCE BETWEEN DFC RAIL LEVEL AND EXG. RAIL LEVEL (RL - ERL)	0.790	0.790	0.790	0.790	0.790	0.790	0.790	0.790	0.790	0.790	0.790	0.790	0.790	0.790	0.790	0.790	0.790	0.790	0.790	0.790
DFC RAIL LEVEL (RL)	270.289	270.289	270.289	270.289	270.289	270.289	270.289	270.289	270.289	270.289	270.289	270.289	270.289	270.289	270.289	270.289	270.289	270.289	270.289	270.289
EXG.RAIL LEVEL OF NEAREST IR UP MAIN LINE(ERL)	269.499	269.499	269.499	269.499	269.499	269.499	269.499	269.499	269.499	269.499	269.499	269.499	269.499	269.499	269.499	269.499	269.499	269.499	269.499	269.499
EQUIVALENT CHAINAGE ON DFC TRACK	1169420.6	1169420.6	1169420.6	1169420.6	1169420.6	1169420.6	1169420.6	1169420.6	1169420.6	1169420.6	1169420.6	1169420.6	1169420.6	1169420.6	1169420.6	1169420.6	1169420.6	1169420.6	1169420.6	1169420.6
EXISTING IR CHAINAGE	279989.17	280000.0	280020.0	280040.0	280060.0	280080.0	280100.0	280120.0	280140.0	280160.0	280180.0	280200.0	280220.0	280240.0	280260.0	280280.0	280300.0	280320.0	280340.0	280360.0

L - SECTION

NOTE:-

- DFCC WORKS ARE SHOWN IN RED.
- IR NEW WORKS ARE SHOWN IN VIOLET.
- ALL DIMENSIONS ARE SHOWN IN METRES.
- THIS DRAWING IS PREPARED BASED ON LATEST SURVEY DATA HELD ON APRIL-2022. GTS BENCH MARK OF 261.850M CONSIDERED ON TOP OF CANAL BRIDGE ABUTMENT AT DORANA VILLAGE ALONG THE NH1.
- DFC NEW CHAINAGE OF 1075.950M IS WITH REFERENCE TO THE IR KM OF 187.500KM END OF KM OF CP-303(SECTION P-3 PILKHANI END) AGAINST THE EXISTING DFC CHAINAGE. 116277.742M ISSUED VIDE LETTER NO. COM/DFCC/UM/SURVEY/2021-301-230116-011173 DT. 17.01.2023.
- BALLAST PROFILE HAS BEEN PROVIDED ACCORDING TO THE CLAUSE 1.11.3 OF STANDARD SCHEDULE OF DIMENSION(EASTERN CORRIDOR) & THE BALLAST CUSHION DIMENSION SHOWN IN 35CM ON GE-14 PARA 17. SPECIFICATIONS & RECOMMENDATIONS 2. TWO LAYER SYSTEM FIG.10.

REFERENCE DRAWINGS :-

- FOR KEY PLAN REFER DRAWING NO. 301-2/AL/0001
- FOR LEGEND AND ABBREVIATIONS REFER DRAWING NO. 301-2/AL/1000
- FOR TYPICAL SECTION OF BALLAST PROFILE (FL-RL) REFER DRG. NO. 301-2/TK/TFDI-004 (TR.1952)

LEGEND:

IR TRACK
DFCC TRACK
DFCC FUTURE PROPOSALS
STRUCTURE / BUILDING
DFCC TOE LINE
DFCC FORMATION
RETAINING WALL
ROAD
STREAM, DRAIN, NALA, CANAL.
FENCE
POWER LINES
TBM
ELECTRIC POLE/OHE MAST
IR RAILWAY BOUNDARY
DFCC BOUNDARY

SCALE

HOR - 1:1000
VER - 1:100
SHEET SIZE : A1

TYPICAL SECTION

TRACK STRUCTURE		
RAIL SECTION: 60Kg/m (UIC 60Kg/m) DFC LINE: 60Kg/m (UIC 60Kg/m) IR MAIN LINE: 52Kg/m	Difference between FL- RL (Below Rail Seat)	
	IR Line	DFC
	172mm	172mm
RUBBER PAD	6mm	10mm
SLEEPER DEPTH	210mm	210mm
BALLAST CUSHION	300mm	350mm
Total Depth (FL TO RL)	688mm	742mm

OWNER: DEDICATED FREIGHT CORRIDOR CORPORATION OF INDIA LTD. (A GOVERNMENT OF INDIA ENTERPRISE)
PROJECT OFFICE(AMBALA UNIT): OLD RAILWAY COLONY (NEAR ANAND MARKET),AMBALA CANTT-133001.
CORPORATE IDENTITY NO. : U60323DL2006GG01155068

ENGINEER: DB Engineering & Consulting GmbH
Deutsche Bahn Engineering & Consulting GmbH

CONTRACTOR: GIL - TPL JV

SUBMITTED BY: GIL - TPL JV

DATED: NAME: SIGNATURE:

PREPARED BY:

CHECKED BY: 02.09.2024 VIJAY PRATAP

APPROVED BY: 02.09.2024 PARASURAM KOTYADA

APPROVED BY: DEUTSCHE BAHN ENGINEERING & CONSULTING GMBH

DATED: NAME: SIGNATURE:

Sr. DE./CHIEF ENGINEER: SURESH K.YALANGI

CHIEF TRACK ENGINEER: RAJ PAL SINGH

T.L.: H.D. VIDJAK

STAMP: AS-BUILT DRAWING
TR. Ref.:.....
ENGINEER Sign.: A



EMPLOYER (DFCCIL): DEDICATED FREIGHT CORRIDOR CORPORATION OF INDIA LTD.

AS BUILT DRAWING

TITLE: AS-BUILT PLAN AND PROFILE
FROM IR KM: 280.000 TO 280.500
DFC KM: 1169.421 TO 1169.921

DFCC APPR. NO. -
ENGG. APPR. NO. -
DRG. NO. - 301-2/AL/A/1186
SHEET NO. : 1 OF 1
DATE : 02.09.2024

STATUS: A

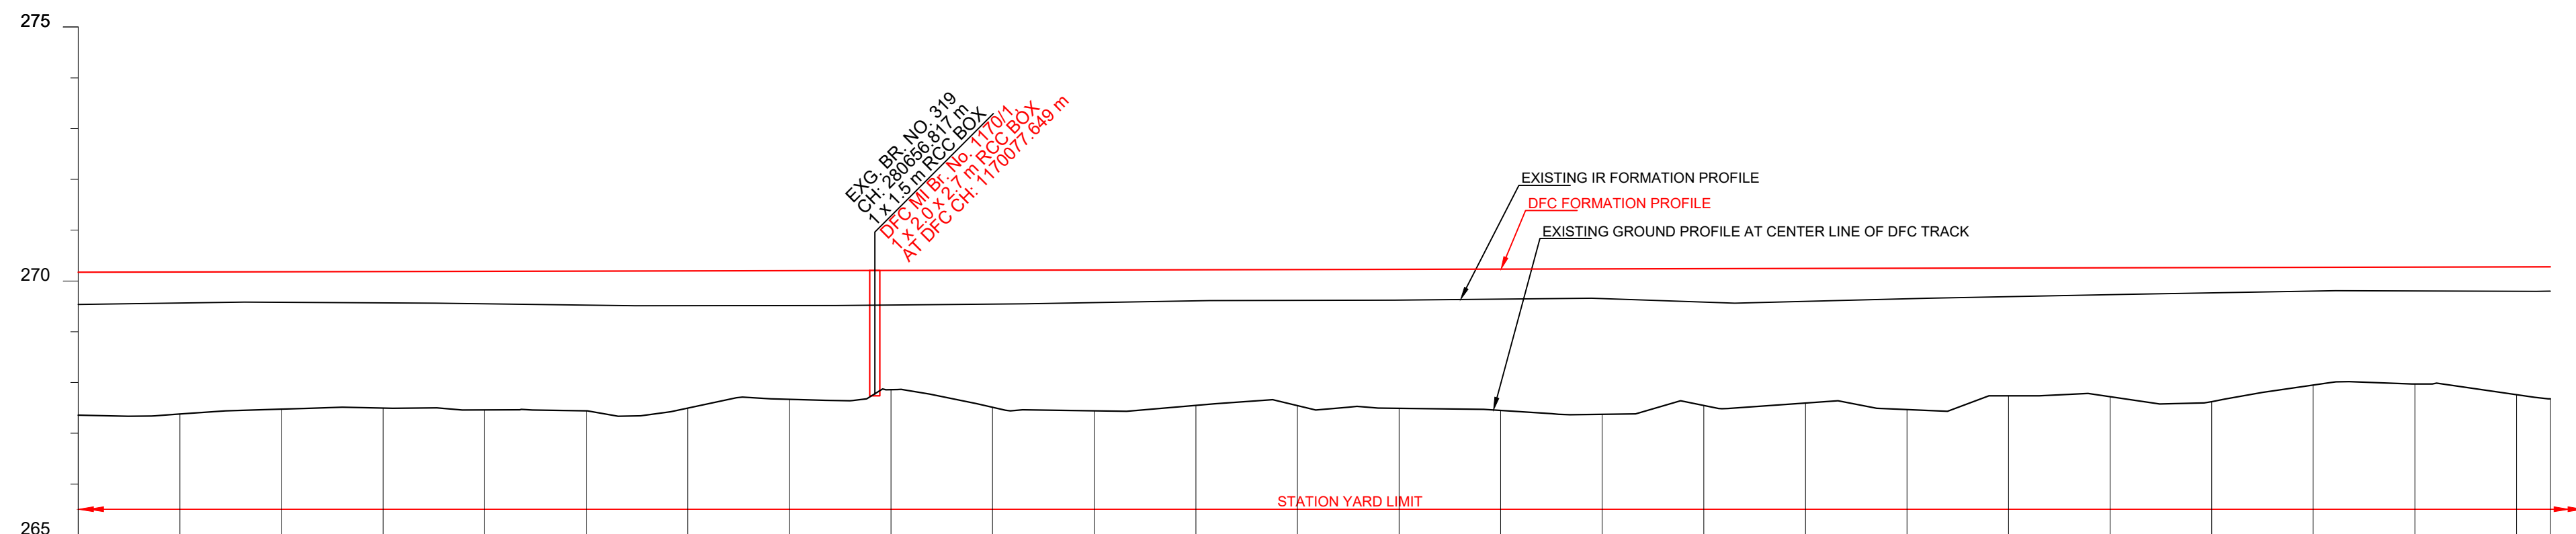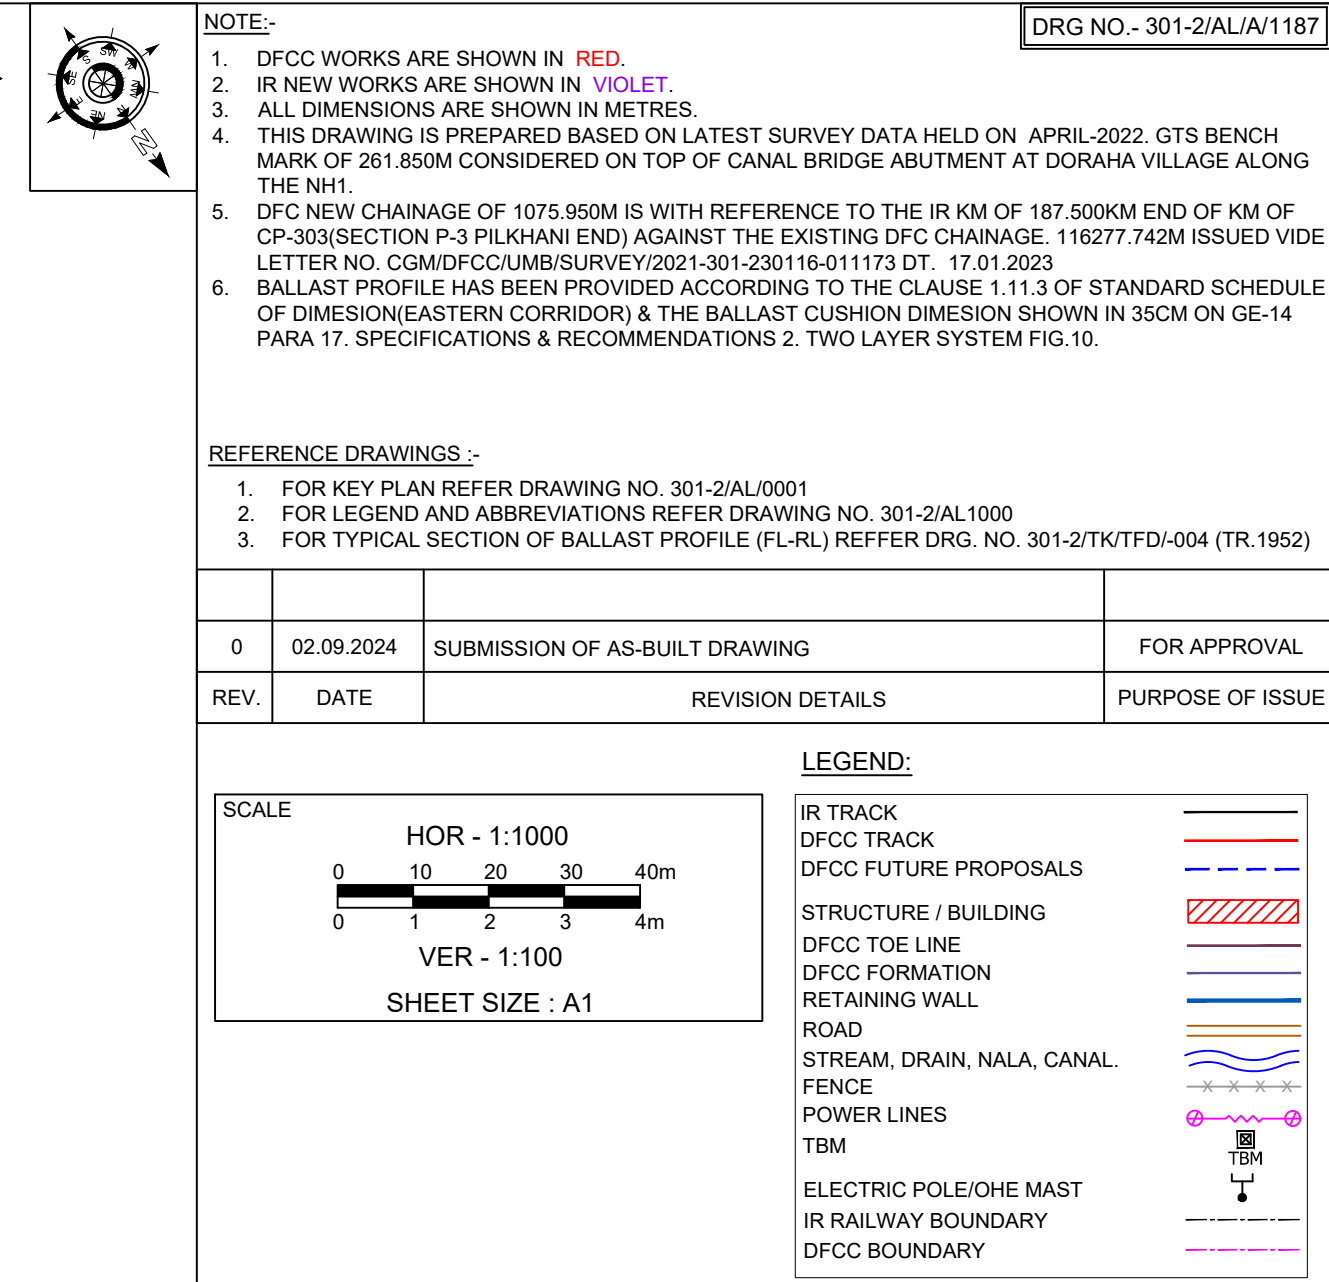

TRACK STRUCTURE		
RAIL SECTION: 60Kg/m (UIC 60Kg/m) DFC LINE: 60Kg/m (UIC 60Kg/m) IR MAIN LINE: 52Kg/m	Difference between FL- RL (Below Rail Seat)	
	IR Line	DFC
	172mm	172mm
RUBBER PAD	6mm	10mm
SLEEPER DEPTH	210mm	210mm
BALLAST CUSHION	300mm	350mm
Total Depth (FL TO RL)	688mm	742mm

ENGINEER:

 DB Engineering &
Consulting GmbH
Deutsche Bahn Engineering & Consulting GmbH


SUBMITTED BY	GIL - TPL JV		
	DATED	NAME	SIGNATURE
PREPARED BY			
CHECKED BY	02.09.2024	VIJAY PRATAP	
APPROVED BY	02.09.2024	PARASURAM KOTYADA	

STAMP			

EMPLOYER (DFCCIL):	DEDICATED FREIGHT CORRIDOR CORPORATION OF INDIA LTD.
--------------------	--

--	--	--	--

AS BUILT DRAWING	
TITLE AS-BUILT PLAN AND PROFILE FROM IR KM: 280.500 TO 281.000 DFC KM: 1169.921 TO 1170.407	DFCC APPR. NO. - ENGG. APPR. NO. - DRG. NO. - 301-2/AL/A/1187 SHEET NO. : 1 OF 1 DATE : 02.09.2024 STATUS A

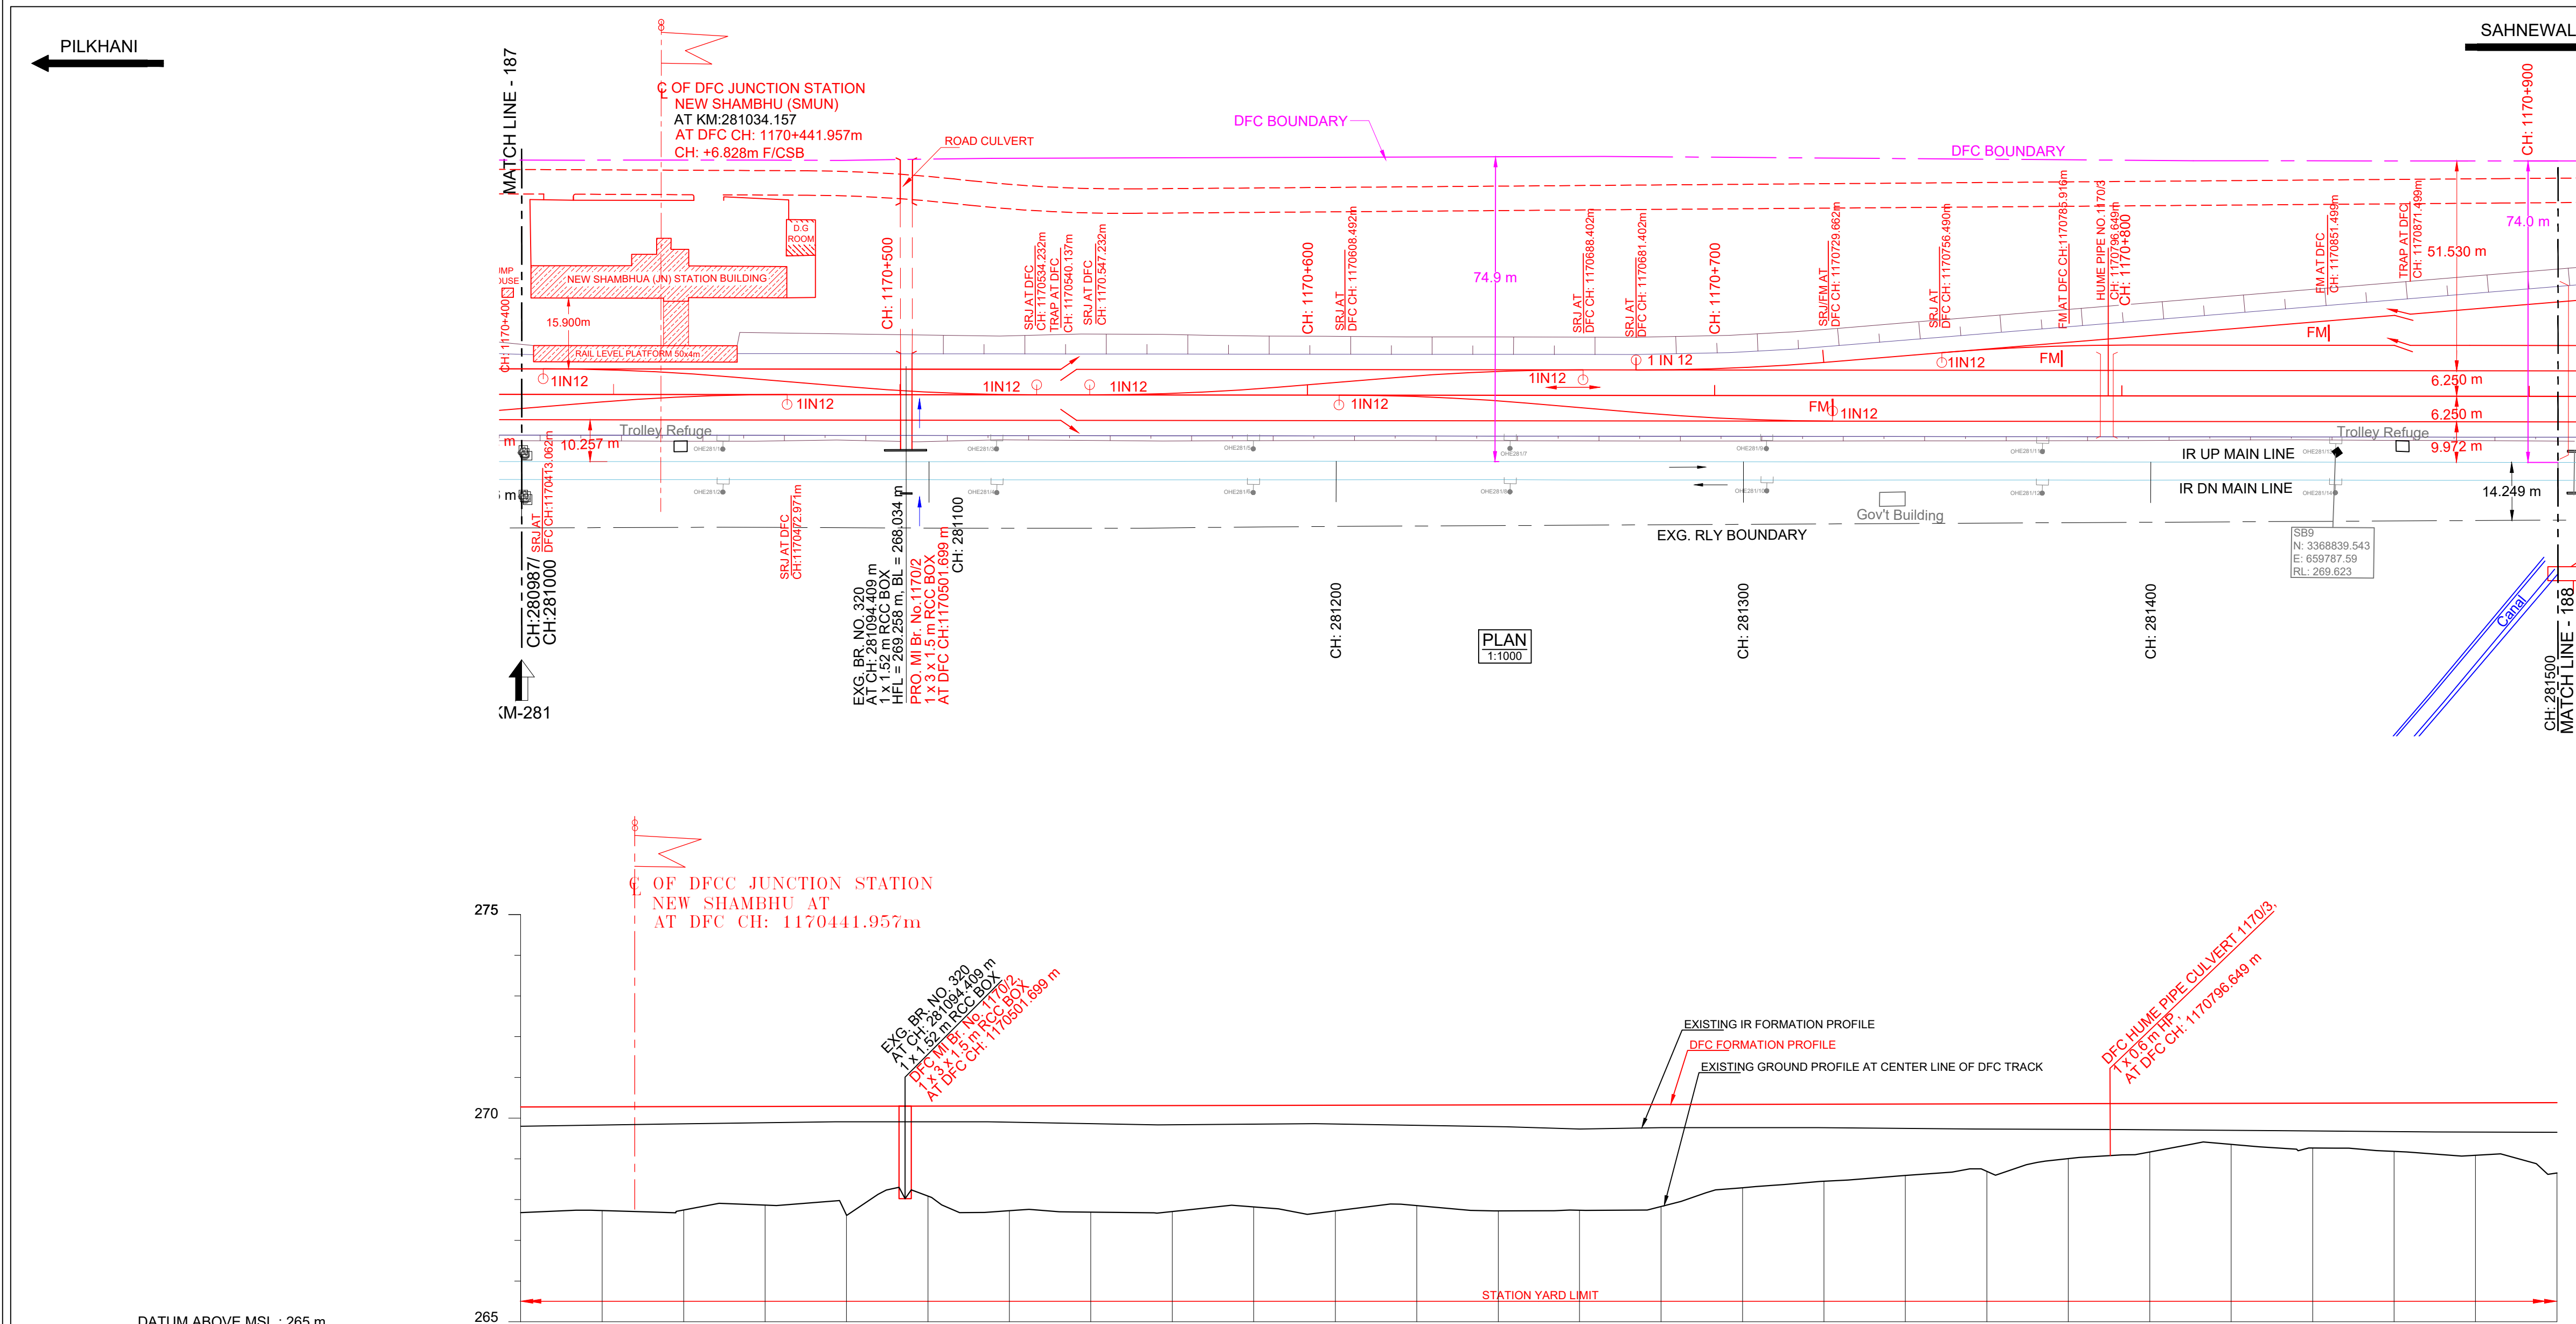

HORIZONTAL ALIGNMENT	L=2649.978m									
VERTICAL ALIGNMENT	L=1772.700 m 1 IN 3905.664 R									
TRACK DISTANCE FROM EXISTING IR UP MAIN LINE TO DFC MAIN LINE	16.530	16.508	16.489	16.483	16.475	16.446	16.410	16.354	16.302	16.264
HEIGHT OF BANKING(+) / DEPTH OF CUTTING(-) (FL-GL)	+2.598	+2.550	+2.541	+2.424	+2.674	+2.210	+2.575	+2.614	+2.604	+2.493
EXG GROUND LEVEL AT CENTER LINE OF DFC TRACK (GL)	267.388	267.441	267.454	267.577	267.332	267.801	267.441	267.407	267.423	267.538
EXG GROUND LEVEL AT TOE LOCATION OF DFC TRACK	267.578	267.406	267.026	265.832	265.602	265.814	267.679	267.460	267.518	267.691
DIFFERENCE BETWEEN DFC FORMATION LEVEL AND EXG.FORMATION LEVEL (FL-EFL)	0.460	0.434	0.410	0.386	0.366	0.371	0.384	0.425	0.455	0.444
DFC FORMATION LEVEL (FL)	269.985	269.991	269.996	270.001	270.006	270.011	270.016	270.021	270.026	270.032
EXG. FORMATION LEVEL OF EXG IR UP MAIN LINE (EFL)	269.526	269.556	269.586	269.615	269.640	269.640	269.632	269.596	269.571	269.588
DIFFERENCE BETWEEN DFC RAIL LEVEL AND EXG. RAIL LEVEL (RL - ERL)	0.501	0.475	0.451	0.427	0.407	0.412	0.425	0.466	0.496	0.485
DFC RAIL LEVEL (RL)	270.696	270.704	270.709	270.714	270.719	270.724	270.729	270.734	270.739	270.745
EXG.RAIL LEVEL OF NEAREST IR UP MAIN LINE(ERL)	270.198	270.228	270.258	270.287	270.312	270.312	270.304	270.268	270.243	270.260
EQUIVALENT CHAINAGE ON DFC TRACK	28098.7	281000.0	281020.0	281040.0	281060.0	281080.0	281100.0	281120.0	281140.0	281160.0
EXISTING IR CHAINAGE	28098.7	281000.0	281020.0	281040.0	281060.0	281080.0	281100.0	281120.0	281140.0	281160.0

L - SECTION

NOTE:-

- DFCC WORKS ARE SHOWN IN RED.
- IR NEW WORKS ARE SHOWN IN VIOLET.
- ALL DIMENSIONS ARE SHOWN IN METRES.
- THIS DRAWING IS PREPARED BASED ON LATEST SURVEY DATA HELD ON APRIL-2022. GTS BENCH MARK OF 261.850M CONSIDERED ON TOP OF CANAL BRIDGE ABUTMENT AT DORANA VILLAGE ALONG THE NH1.
- DFC NEW CHAINAGE OF 1075.950M IS WITH REFERENCE TO THE IR KM OF 187.500KM END OF KM OF CP-303(SECTION P-3 PILKHANI END) AGAINST THE EXISTING DFC CHAINAGE. 116277.742M ISSUED VIDE LETTER NO. COM/DFCC/UMS/SURVEY/2021-301-28016-01173 DT. 17.01.2023.
- BALLAST PROFILE HAS BEEN PROVIDED ACCORDING TO THE CLAUSE 1.11.3 OF STANDARD SCHEDULE OF DIMENSION(EASTERN CORRIDOR) & THE BALLAST CUSHION DIMENSION SHOWN IN 35CM ON GE-14 PARA 17. SPECIFICATIONS & RECOMMENDATIONS 2. TWO LAYER SYSTEM FIG.10.

REFERENCE DRAWINGS :-

- FOR KEY PLAN REFER DRAWING NO. 301-2/AL/0001
- FOR LEGEND AND ABBREVIATIONS REFER DRAWING NO. 301-2/AL/1000
- FOR TYPICAL SECTION OF BALLAST PROFILE (FL-RL) REFER DRG. NO. 301-2/TK/TFD/004 (TR.1952)

DRG NO. - 301-2/AL/A/1188

0	02.09.2024	SUBMISSION OF AS-BUILT DRAWING	FOR APPROVAL
REV.	DATE	REVISION DETAILS	PURPOSE OF ISSUE

LEGEND:

SCALE

HOR - 1:1000

VER - 1:100

SHEET SIZE : A1

IR TRACK

DFCC TRACK

DFCC FUTURE PROPOSALS

STRUCTURE / BUILDING

DFCC TOE LINE

DFCC FORMATION

RETAINING WALL

ROAD

STREAM, DRAIN, NALA, CANAL.

FENCE

POWER LINES

TBM

ELECTRIC POLE/OHE MAST

IR RAILWAY BOUNDARY

DFCC BOUNDARY

TYPICAL SECTION

TRACK STRUCTURE		
RAIL SECTION: 60Kg/m (UIC 60Kg/m)	Difference between FL- RL (Below Rail Seat)	
DFC LINE: 60Kg/m (UIC 60Kg/m)	IR Line	DFC
IR MAIN LINE: 52Kg/m	172mm	172mm
RUBBER PAD	6mm	10mm
SLEEPER DEPTH	210mm	210mm
BALLAST CUSHION	300mm	350mm
Total Depth (FL TO RL)	688mm	742mm

OWNER

DEDICATED FREIGHT CORRIDOR CORPORATION OF INDIA LTD.

(A GOVERNMENT OF INDIA ENTERPRISE)

PROJECT OFFICE (AMBALA UNIT): OLD RAILWAY COLONY (NEAR ANAND MARKET), AMBALA CANTT-133001.

CORPORATE IDENTITY NO. : U60232DL2006GGI155068

ENGINEER:

DB Engineering & Consulting GmbH

Deutsche Bahn Engineering & Consulting GmbH

CONTRACTOR:

GIL - TPL JV

GAR TATA

SUBMITTED BY	GIL - TPL JV		
	DATED	NAME	SIGNATURE
PREPARED BY			
CHECKED BY	02.09.2024	VIJAY PRATAP	
APPROVED BY	02.09.2024	PARASURAM KOTYADA	
APPROVED BY	DEUTSCHE BAHN ENGINEERING & CONSULTING GMBH		
	DATED	NAME	SIGNATURE
Sr. DE./CHIEF ENGINEER		SURESH K.YALANGI	
CHIEF TRACK ENGINEER		RAJ PAL SINGH	
T.L.		H.D. VIDJAK	

STAMP

A AS-BUILT DRAWING TR. Ref.:..... ENGINEER Sign.:.

EMPLOYER (DFCCIL): DEDICATED FREIGHT CORRIDOR CORPORATION OF INDIA LTD.

--	--	--

AS BUILT DRAWING

TITLE

AS-BUILT PLAN AND PROFILE

DFCC APPR. NO. -

ENGG. APPR. NO. -

DRG. NO. - 301-2/AL/A/1188

FROM IR KM: 281.000 TO 281.500

DFC KM: 1170.407 TO 1170.907



SHEET NO. : 1 OF 1

DATE : 02.09.2024

STATUS

A

TR.5126-R0

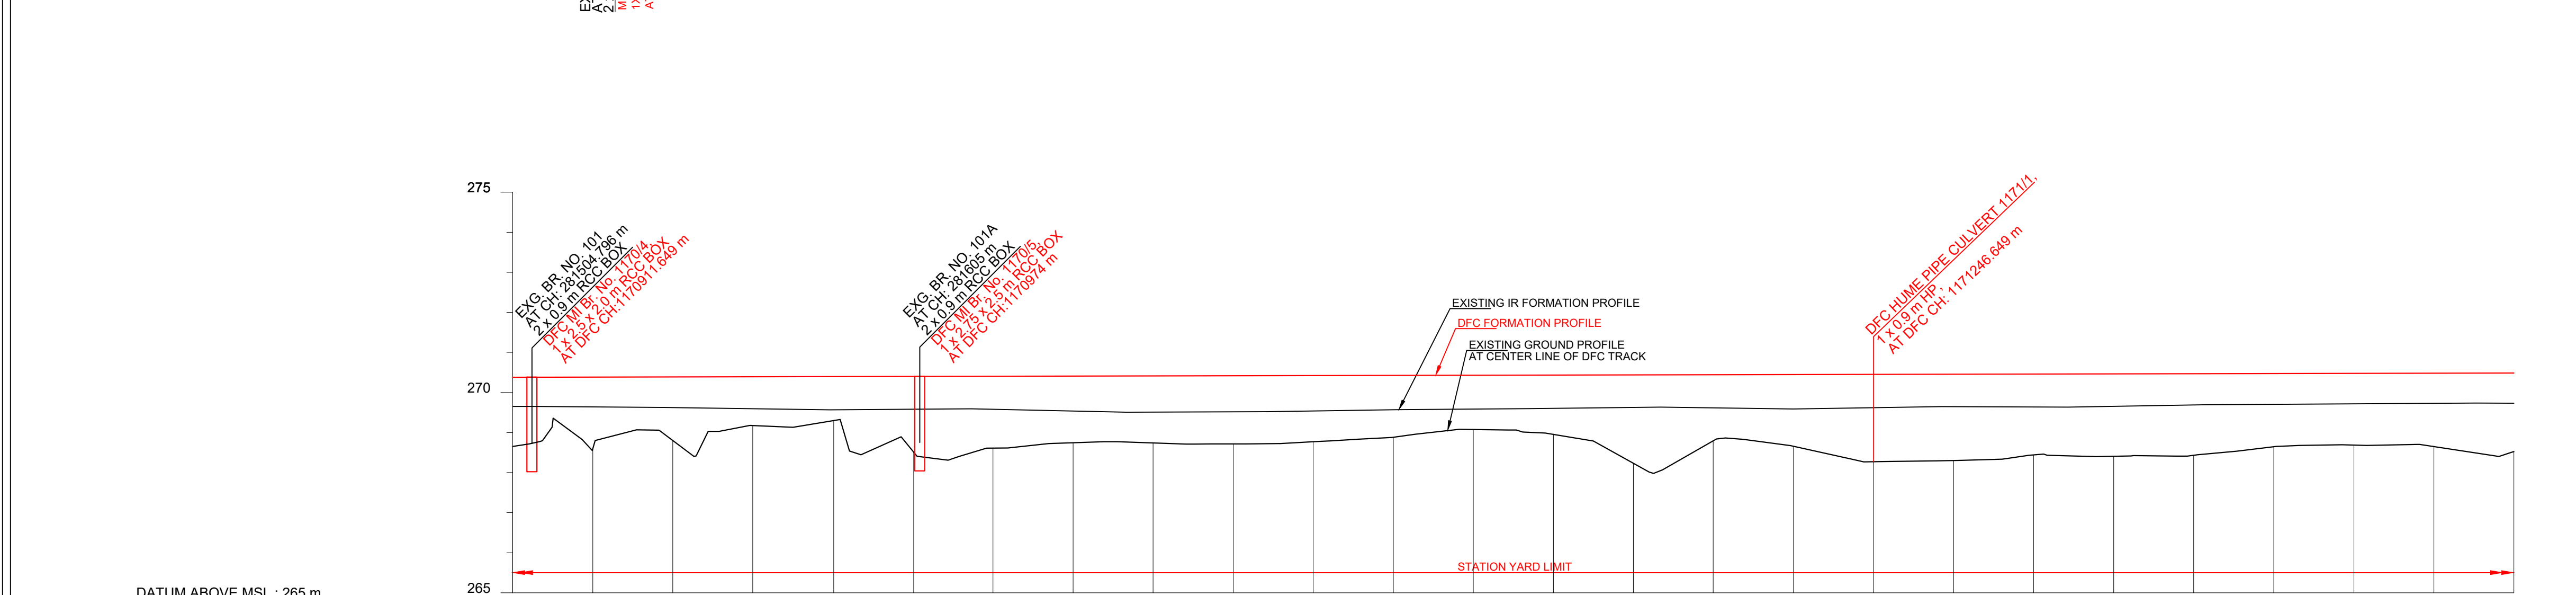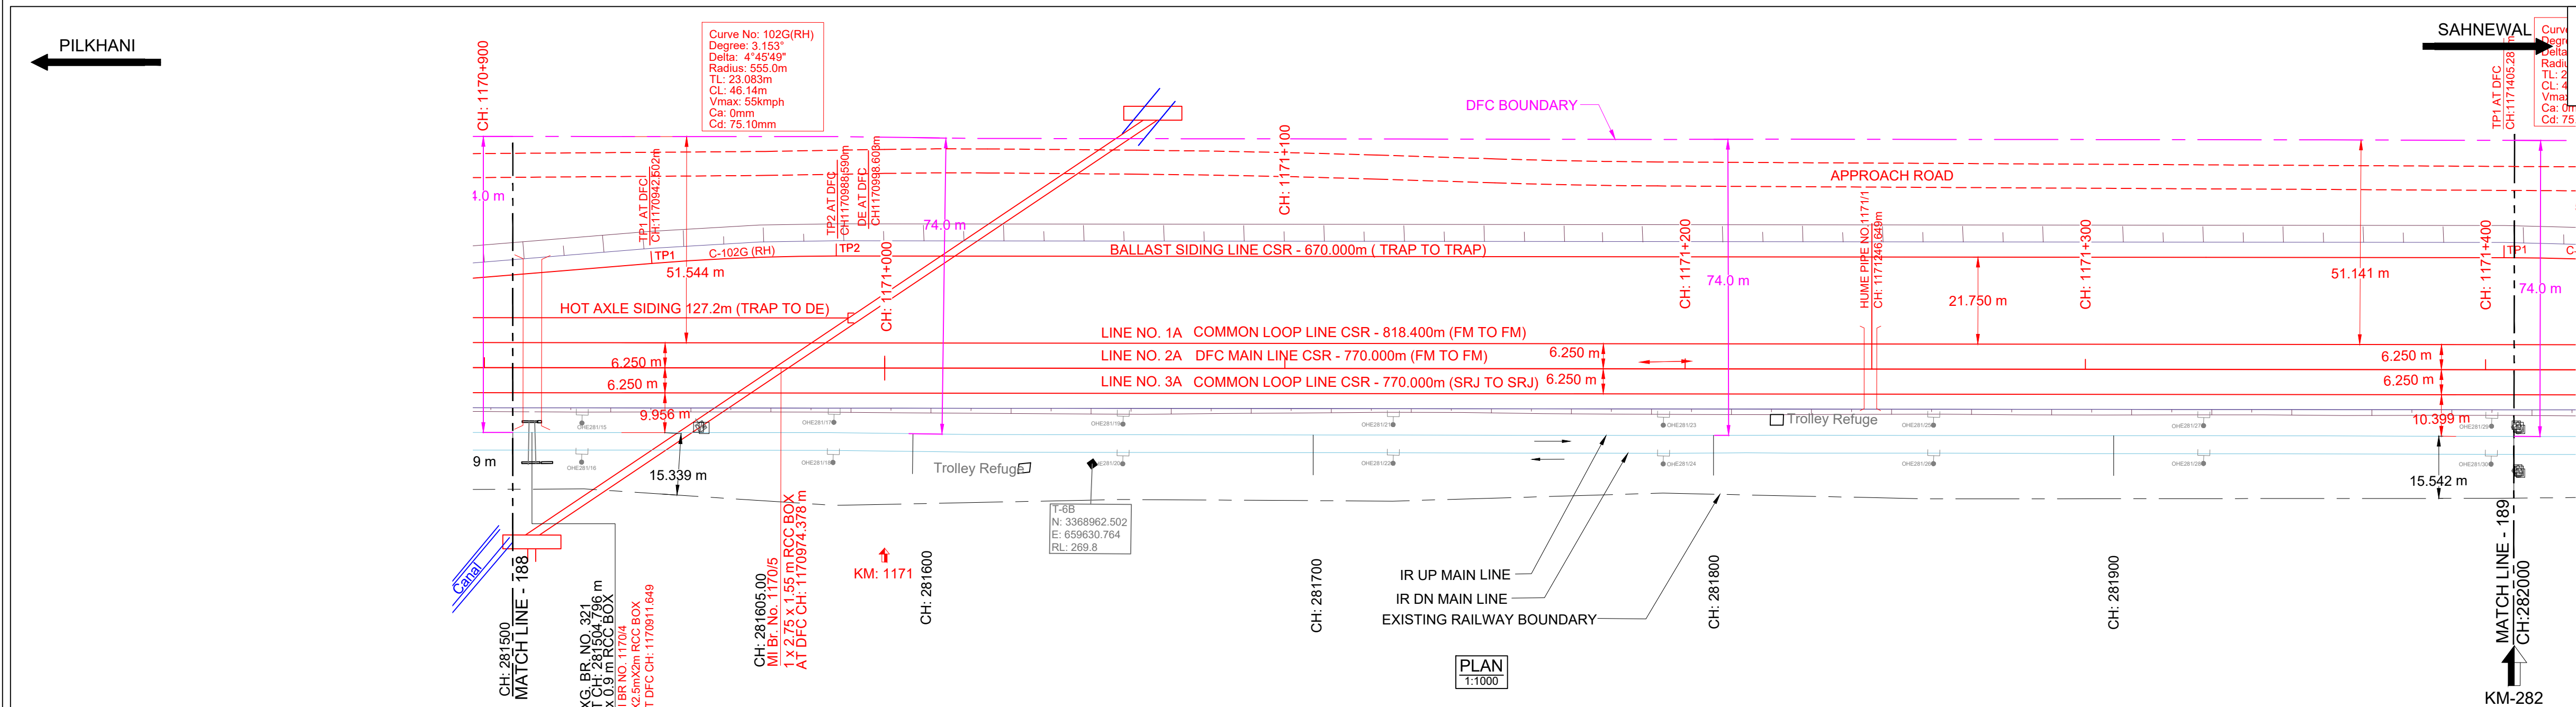

HORIZONTAL ALIGNMENT	L=2649.978m																			
VERTICAL ALIGNMENT	L=1772.700 m 1 IN 3905.664 R																			
TRACK DISTANCE FROM EXISTING IR UP MAIN LINE TO DFC MAIN LINE	16.202	16.203	16.207	16.176	16.158	16.405	16.586	16.594	16.600	16.600	16.608	16.618	16.637	16.652	16.658	16.616	16.550	16.575	16.594	16.583
HEIGHT OF BANKING(+) / DEPTH OF CUTTING(-) (FL-GL)	+1.730	+1.789	+1.588	+1.221	+1.101	+1.894	+1.795	+1.666	+1.674	+1.703	+1.651	+1.544	+1.356	+1.485	+2.209	+1.653	+1.794	+2.183	+2.157	+2.019
EXG GROUND LEVEL AT CENTER LINE OF DFC TRACK (GL)	268.384	268.330	268.536	268.908	269.033	268.245	268.349	268.483	268.480	268.456	268.513	268.626	268.819	268.695	267.976	268.537	268.065	267.823	267.883	268.192
EXG GROUND LEVEL AT TOE LOCATION OF DFC TRACK	268.711	268.662	268.762	268.771	268.676	268.792	268.450	268.512	268.496	268.484	268.523	268.617	268.747	268.597	268.230	268.169	268.085	267.823	267.883	267.984
DIFFERENCE BETWEEN DFC FORMATION LEVEL AND EXG.FORMATION LEVEL (FL-EFL)	0.713	0.730	0.750	0.782	0.814	0.805	0.812	0.859	0.889	0.886	0.869	0.844	0.831	0.817	0.797	0.812	0.846	0.819	0.797	0.809
DFC FORMATION LEVEL (FL)	270.113	270.119	270.124	270.129	270.134	270.139	270.144	270.149	270.154	270.160	270.165	270.170	270.175	270.180	270.185	270.190	270.195	270.201	270.206	270.211
EXG. FORMATION LEVEL OF EXG IR UP MAIN LINE (EFL)	269.400	269.389	269.374	269.347	269.320	269.334	269.332	269.290	269.265	269.274	269.295	269.326	269.344	269.363	269.388	269.378	269.350	269.382	269.409	269.402
DIFFERENCE BETWEEN DFC RAIL LEVEL AND EXG. RAIL LEVEL (RL - ERL)	0.754	0.771	0.791	0.823	0.855	0.846	0.853	0.900	0.930	0.927	0.910	0.885	0.872	0.858	0.838	0.853	0.887	0.860	0.838	0.850
DFC RAIL LEVEL (RL)	270.826	270.832	270.837	270.842	270.847	270.852	270.857	270.862	270.867	270.873	270.878	270.883	270.888	270.893	270.898	270.903	270.908	270.914	270.919	270.924
EXG.RAIL LEVEL OF NEAREST IR UP MAIN LINE(ERL)	270.072	270.061	270.046	270.019	269.992	270.006	270.004	269.962	269.937	269.946	269.967	269.998	270.016	270.035	270.060	270.050	270.022	270.054	270.081	270.074
EQUIVALENT CHAINAGE ON DFC TRACK	1170907.3	1170927.3	1170947.3	1170967.3	1170987.5	1171007.5	1171027.3	1171047.3	1171067.3	1171087.3	1171107.3	1171127.3	1171147.3	1171167.3	1171187.3	1171207.2	1171227.3	1171247.3	1171267.3	1171287.3
EXISTING IR CHAINAGE	281500.0	281520.0	281540.0	281560.0	281580.0	281600.0	281620.0	281640.0	281660.0	281680.0	281700.0	281720.0	281740.0	281760.0	281780.0	281800.0	281820.0	281840.0	281860.0	281880.0

NOTE:-

- DFCC WORKS ARE SHOWN IN RED.
- IR NEW WORKS ARE SHOWN IN VIOLET.
- ALL DIMENSIONS ARE SHOWN IN METRES.
- THIS DRAWING IS PREPARED BASED ON LATEST SURVEY DATA HELD ON APRIL-2022. GTS BENCH MARK OF 261.850M CONSIDERED ON TOP OF CANAL BRIDGE ABUTMENT AT DORANA VILLAGE ALONG THE NH1.
- DFC NEW CHAINAGE OF 1075.950M IS WITH REFERENCE TO THE IR KM OF 187.500KM END OF KM OF CP-303(SECTION P-3 PILKHANI END) AGAINST THE EXISTING DFC CHAINAGE. 116277.742M ISSUED VIDE LETTER NO. COM/DFCC/MB/SURVEY/2021-301-230116-011173 DT. 17.01.2023.
- BALLAST PROFILE HAS BEEN PROVIDED ACCORDING TO THE CLAUSE 1.11.3 OF STANDARD SCHEDULE OF DIMENSION(EASTERN CORRIDOR) & THE BALLAST CUSHION DIMENSION SHOWN IN 35CM ON GE-14 PARA 17. SPECIFICATIONS & RECOMMENDATIONS 2. TWO LAYER SYSTEM FIG.10.

REFERENCE DRAWINGS :-

- FOR KEY PLAN REFER DRAWING NO. 301-2/AL/0001
- FOR LEGEND AND ABBREVIATIONS REFER DRAWING NO. 301-2/AL/1000
- FOR TYPICAL SECTION OF BALLAST PROFILE (FL-RL) REFER DRG. NO. 301-2/TK/TFDI-004 (TR.1952)

LEGEND:

IR TRACK
DFCC TRACK
DFCC FUTURE PROPOSALS
STRUCTURE / BUILDING
DFCC TOE LINE
DFCC FORMATION
RETAINING WALL
ROAD
STREAM, DRAIN, NALA, CANAL.
FENCE
POWER LINES
TBM
ELECTRIC POLE/OHE MAST
IR RAILWAY BOUNDARY
DFCC BOUNDARY

SCALE

HOR - 1:1000
VER - 1:100
SHEET SIZE : A1

TYPICAL SECTION

TRACK STRUCTURE	
RAIL SECTION: 60Kg/m (UIC 60Kg/m) DFC LINE: 60Kg/m (UIC 60Kg/m) IR MAIN LINE: 52Kg/m	Difference between FL- RL (Below Rail Seat)
	IR Line DFC
RUBBER PAD	172mm 172mm
SLEEPER DEPTH	6mm 10mm
BALLAST CUSHION	210mm 210mm
Total Depth (FL TO RL)	300mm 350mm

OWNER

DEDICATED FREIGHT CORRIDOR CORPORATION OF INDIA LTD.
(A GOVERNMENT OF INDIA ENTERPRISE)
PROJECT OFFICE(AMBALA UNIT): OLD RAILWAY COLONY (NEAR ANAND MARKET),AMBALA CANTT-133001.
CORPORATE IDENTITY NO. : U60232DL2006GGI155068

ENGINEER:

DB Engineering & Consulting GmbH
Deutsche Bahn Engineering & Consulting GmbH

CONTRACTOR:

GIL - TPL JV
GAR TATA

SUBMITTED BY	GIL - TPL JV		
	DATED	NAME	SIGNATURE
PREPARED BY			
CHECKED BY	02.09.2024	VIJAY PRATAP	
APPROVED BY	02.09.2024	PARASURAM KOTYADA	

APPROVED BY

DEUTSCHE BAHN ENGINEERING & CONSULTING GMBH

	DATED	NAME	SIGNATURE
Sr. DE./CHIEF ENGINEER		SURESH K.YALANGI	
CHIEF TRACK ENGINEER		RAJ PAL SINGH	
T.L.		H.D. VIDJAK	

STAMP

A AS-BUILT DRAWING
TR. Ref.:.....
ENGINEER Sign.:.....

EMPLOYER (DFCCIL):

DEDICATED FREIGHT CORRIDOR CORPORATION OF INDIA LTD.

AS BUILT DRAWING



TITLE

AS-BUILT PLAN AND PROFILE

FROM IR KM: 281.500 TO 282.000
DFC KM: 1170.907 TO 1171.407

DFCC APPR. NO. -
ENGG. APPR. NO. -
DRG. NO. - 301-2/AL/A/1189
SHEET NO. : 1 OF 1
DATE : 02.09.2024

STATUS
A

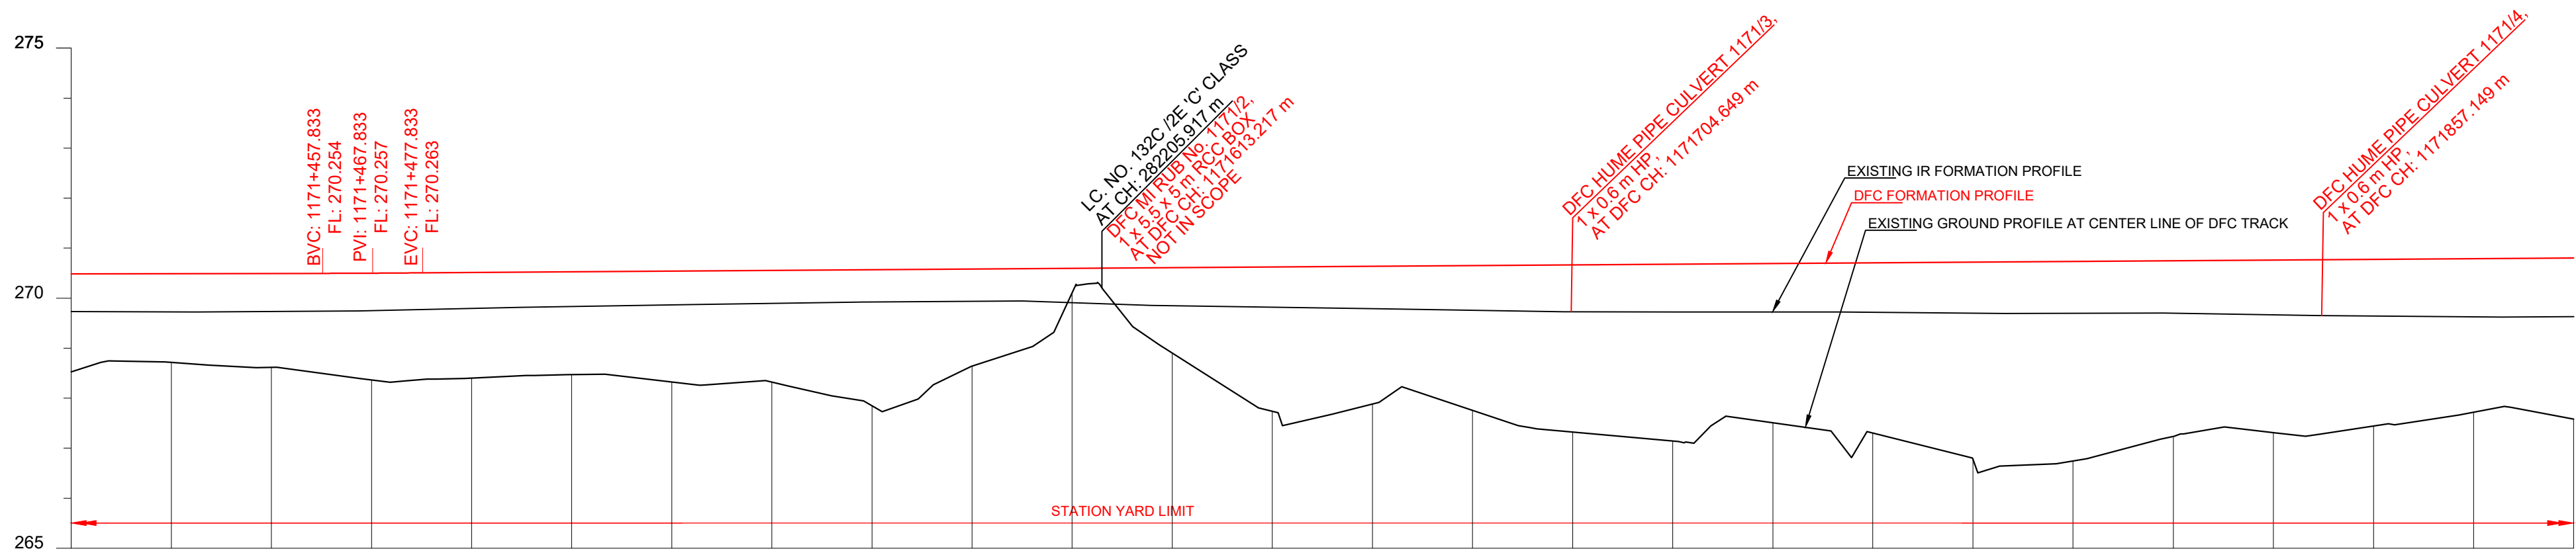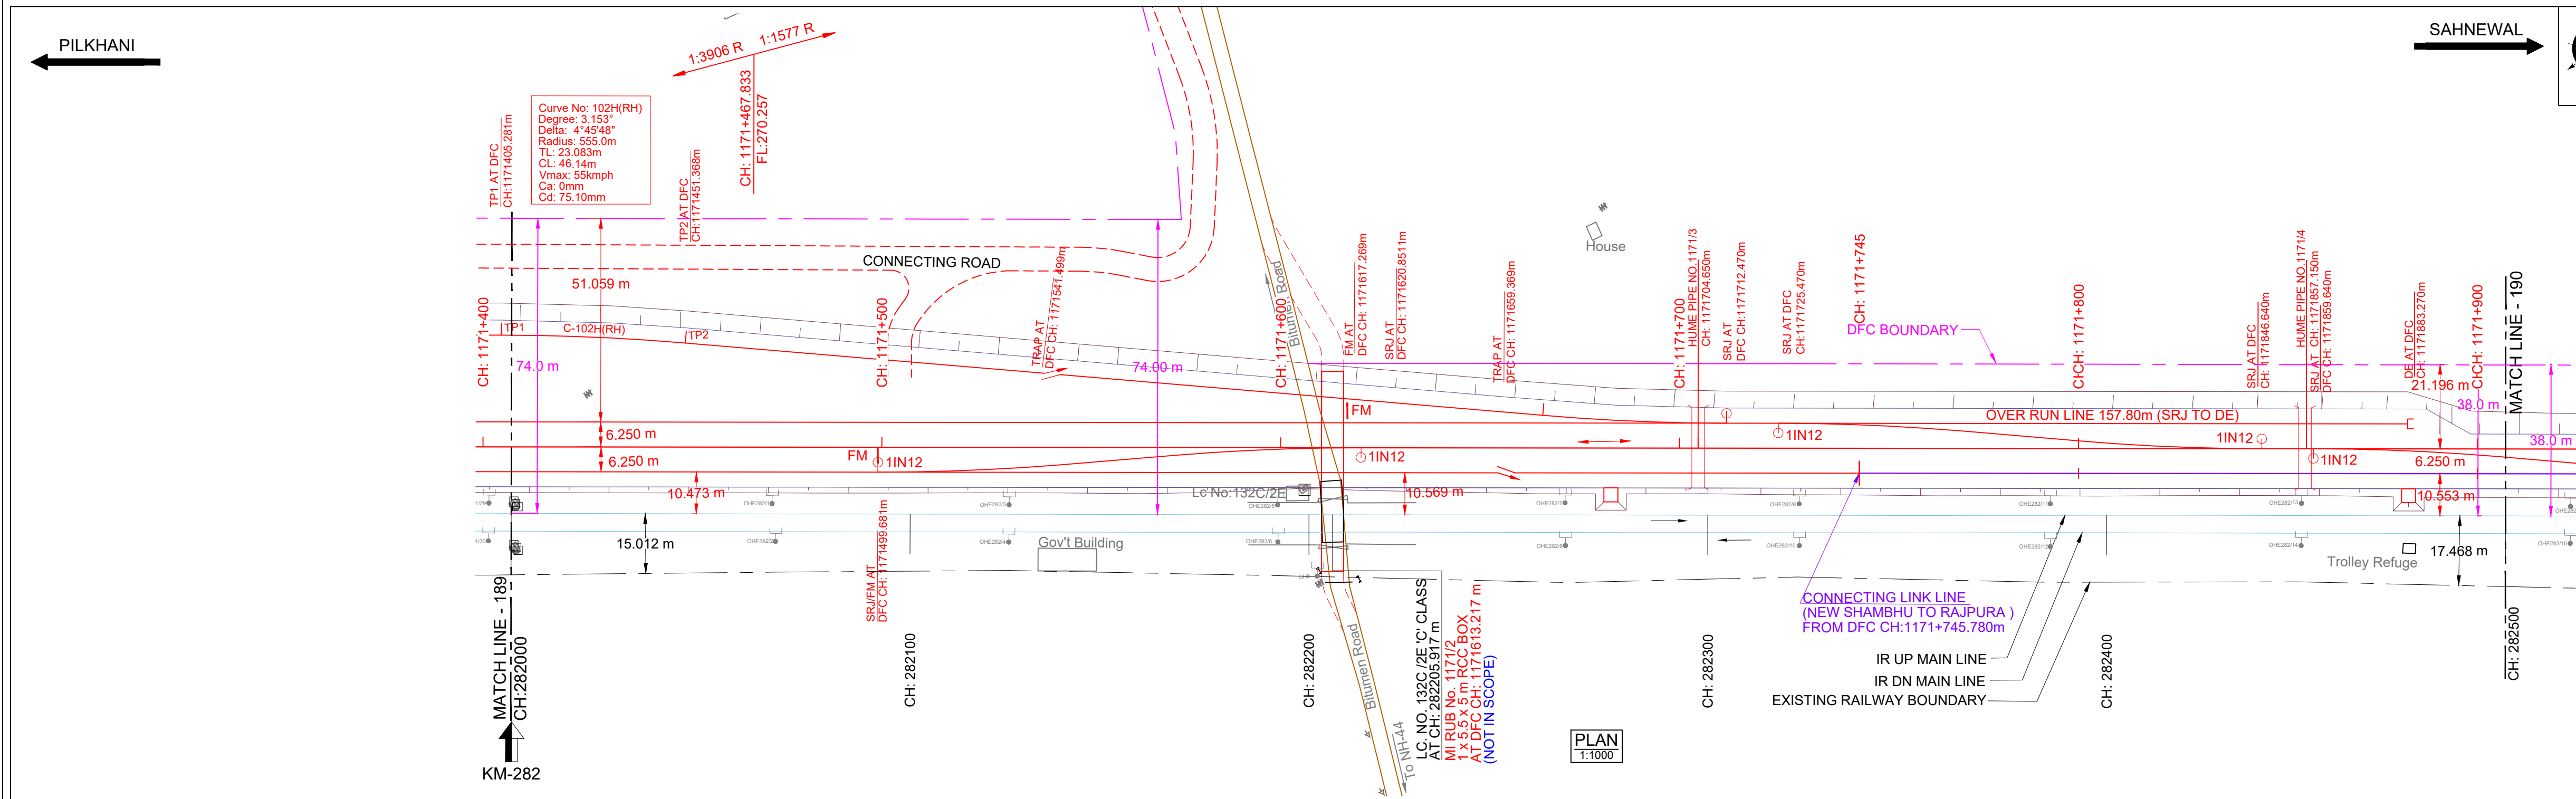

DATUM ABOVE MSL : 265 m

HORIZONTAL ALIGNMENT	L=2649.978m																			
VERTICAL ALIGNMENT	L=1772.700 m 1 IN 3805.664 R L=20.0m R=52912.41 L=527.300 m 1 IN 1577.233 R																			
TRACK DISTANCE FROM EXISTING IR UP MAIN LINE TO DFC MAIN LINE	16.669	16.669	16.695	16.717	16.739	16.762	16.773	16.773	16.791	16.814	16.829	16.830	16.820	16.816	16.813	16.816	16.820	16.822	16.847	16.848
HEIGHT OF BANKING(+) / DEPTH OF CUTTING(-) (FL-GL)	+1.962	+1.962	+1.775	+1.879	+2.136	+2.112	+2.055	+2.217	+2.232	+2.721	+1.940	+0.492	+1.705	+2.887	+2.756	+2.896	+3.342	+3.537	+3.185	+3.402
EXG GROUND LEVEL AT CENTER LINE OF DFC TRACK (GL)	268.280	268.280	268.472	268.373	268.121	268.157	268.227	268.078	268.075	267.599	268.393	269.853	268.653	267.484	267.627	267.501	267.006	266.884	266.249	266.045
EXG GROUND LEVEL AT TOE LOCATION OF DFC TRACK	268.359	268.359	268.339	268.205	268.072	268.184	268.333	268.330	268.199	267.979	268.276	269.206	267.947	267.530	267.424	267.336	267.006	266.648	266.659	266.591
DIFFERENCE BETWEEN DFC FORMATION LEVEL AND EXG.FORMATION LEVEL (FL-EFL)	0.739	0.739	0.750	0.747	0.735	0.705	0.679	0.660	0.644	0.630	0.631	0.672	0.747	0.790	0.832	0.877	0.921	0.941	0.954	0.974
DFC FORMATION LEVEL (FL)	270.242	270.242	270.247	270.252	270.257	270.269	270.282	270.295	270.307	270.320	270.333	270.345	270.358	270.371	270.383	270.396	270.409	270.421	270.434	270.447
EXG. FORMATION LEVEL OF EXG IR UP MAIN LINE (EFL)	269.502	269.502	269.496	269.505	269.522	269.565	269.603	269.634	269.663	269.690	269.701	269.673	269.611	269.581	269.551	269.519	269.487	269.481	269.480	269.473
DIFFERENCE BETWEEN DFC RAIL LEVEL AND EXG. RAIL LEVEL (RL - ERL)	0.780	0.780	0.791	0.788	0.776	0.746	0.720	0.701	0.685	0.671	0.672	0.713	0.788	0.831	0.873	0.918	0.962	0.982	0.995	1.015
DFC RAIL LEVEL (RL)	270.955	270.955	270.960	270.955	270.970	270.982	270.995	271.008	271.020	271.033	271.046	271.058	271.071	271.084	271.096	271.109	271.122	271.134	271.147	271.159
EXG.RAIL LEVEL OF NEAREST IR UP MAIN LINE(ERL)	270.174	270.174	270.168	270.177	270.194	270.237	270.275	270.306	270.335	270.362	270.373	270.345	270.283	270.253	270.223	270.191	270.159	270.153	270.152	270.126
EQUIVALENT CHAINAGE ON DFC TRACK	1171.407.3	1171.407.3	1171.427.3	1171.447.3	1171.467.3	1171.487.3	1171.507.3	1171.527.3	1171.547.3	1171.567.3	1171.587.3	1171.607.3	1171.627.3	1171.647.3	1171.667.3	1171.687.3	1171.707.3	1171.727.3	1171.747.3	1171.767.2
EXISTING IR CHAINAGE	282000.0	282000.0	282020.0	282040.0	282060.0	282080.0	282100.0	282120.0	282140.0	282160.0	282180.0	282200.0	282220.0	282240.0	282260.0	282280.0	282300.0	282320.0	282340.0	282360.0

L - SECTION

- NOTE:-
1. DFC WORKS ARE SHOWN IN RED.
 2. IR NEW WORKS ARE SHOWN IN VIOLET.
 3. ALL DIMENSIONS ARE SHOWN IN METRES.
 4. THIS DRAWING IS PREPARED BASED ON LATEST SURVEY DATA HELD ON APRIL-2022. GTS BENCH MARK OF 261.850M CONSIDERED ON TOP OF CANAL BRIDGE ABUTMENT AT DORAH VILLAGE ALONG THE NH1.
 5. DFC NEW CHAINAGE OF 1075.950M IS WITH REFERENCE TO THE IR KM OF 187.500KM END OF KM OF CP-303(SECTION P-3 PILKHANI END) AGAINST THE EXISTING DFC CHAINAGE. 116277.742M ISSUED VIDE LETTER NO. COM/DFCC/MB/SURVEY/2021-301-230116-011173 DT. 17.01.2023.
 6. BALLAST PROFILE HAS BEEN PROVIDED ACCORDING TO THE CLAUSE 1.11.3 OF STANDARD SCHEDULE OF DIMENSION(EASTERN CORRIDOR) & THE BALLAST CUSHION DIMENSION SHOWN IN 35CM ON GE-14 PARA 17. SPECIFICATIONS & RECOMMENDATIONS 2. TWO LAYER SYSTEM FIG.10.


- REFERENCE DRAWINGS :-
1. FOR KEY PLAN REFER DRAWING NO. 301-2/AL/0001
 2. FOR LEGEND AND ABBREVIATIONS REFER DRAWING NO. 301-2/AL/1000
 3. FOR TYPICAL SECTION OF BALLAST PROFILE (FL-RL) REFER DRG. NO. 301-2/TK/TFD/004 (TR. 1952)

REV.	DATE	REVISION DETAILS	PURPOSE OF ISSUE
0	02.09.2024	SUBMISSION OF AS-BUILT DRAWING	FOR APPROVAL

LEGEND:

IR TRACK
DFCC TRACK
DFCC FUTURE PROPOSALS
STRUCTURE / BUILDING
DFCC TOE LINE
DFCC FORMATION
RETAINING WALL
ROAD
STREAM, DRAIN, NALA, CANAL.
FENCE
POWER LINES
TBM
ELECTRIC POLE/OHE MAST
IR RAILWAY BOUNDARY
DFCC BOUNDARY

SCALE
HOR - 1:1000
VER - 1:100
SHEET SIZE : A1

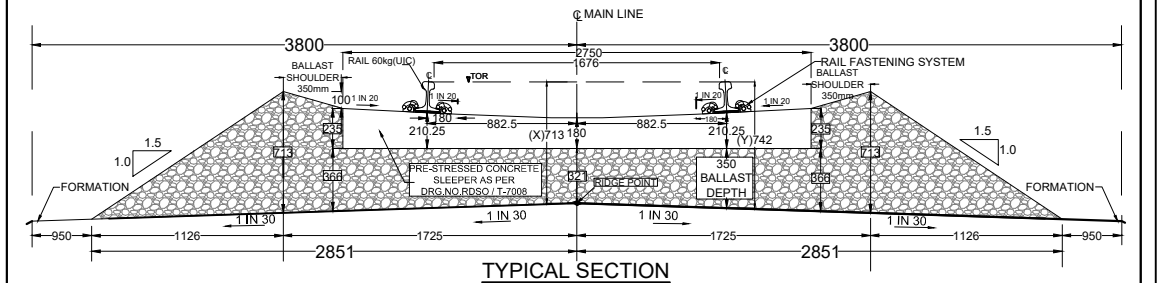

TRACK STRUCTURE		
RAIL SECTION: 60Kg/m (UIC 60Kg/m) DFC LINE: 60Kg/m (UIC 60Kg/m) IR MAIN LINE: 52Kg/m	Difference between FL- RL (Below Rail Seat)	
	IR Line	DFC
RUBBER PAD	172mm	172mm
SLEEPER DEPTH	6mm	10mm
BALLAST CUSHION	210mm	210mm
	300mm	350mm
Total Depth (FL TO RL)	688mm	742mm

OWNER
DEDICATED FREIGHT CORRIDOR CORPORATION OF INDIA LTD.
(A GOVERNMENT OF INDIA ENTERPRISE)
PROJECT OFFICE (AMBALA UNIT): OLD RAILWAY COLONY (NEAR ANAND MARKET), AMBALA CANTT-133001.
CORPORATE IDENTITY NO. : U60323DL2006GGI155068

ENGINEER:
DB Engineering & Consulting GmbH
Deutsche Bahn Engineering & Consulting GmbH



CONTRACTOR:
GIL - TPL JV
GAR TATA

SUBMITTED BY	GIL - TPL JV		
	DATED	NAME	SIGNATURE
PREPARED BY			
CHECKED BY	02.09.2024	VIJAY PRATAP	
APPROVED BY	02.09.2024	PARASURAM KOTYADA	

APPROVED BY	DEUTSCHE BAHN ENGINEERING & CONSULTING GMBH		
	DATED	NAME	SIGNATURE
Sr. DE./CHIEF ENGINEER		SURESH K.YALANGI	
CHIEF TRACK ENGINEER		RAJ PAL SINGH	
T.L.		H.D. VIDJAK	

STAMP	A AS-BUILT DRAWING TR. Ref.:..... ENGINEER Sign.:.....		
EMPLOYER (DFCCIL):	DEDICATED FREIGHT CORRIDOR CORPORATION OF INDIA LTD.		

AS BUILT DRAWING			
TITLE AS-BUILT PLAN AND PROFILE FROM IR KM: 282.000 TO 282.500 DFC KM: 1171.407 TO 1171.907		DFCC APPR. NO. - ENGG. APPR. NO. - DRG. NO. - 301-2/AL/A/1190 SHEET NO. : 1 OF 1 DATE : 02.09.2024	
		STATUS A	

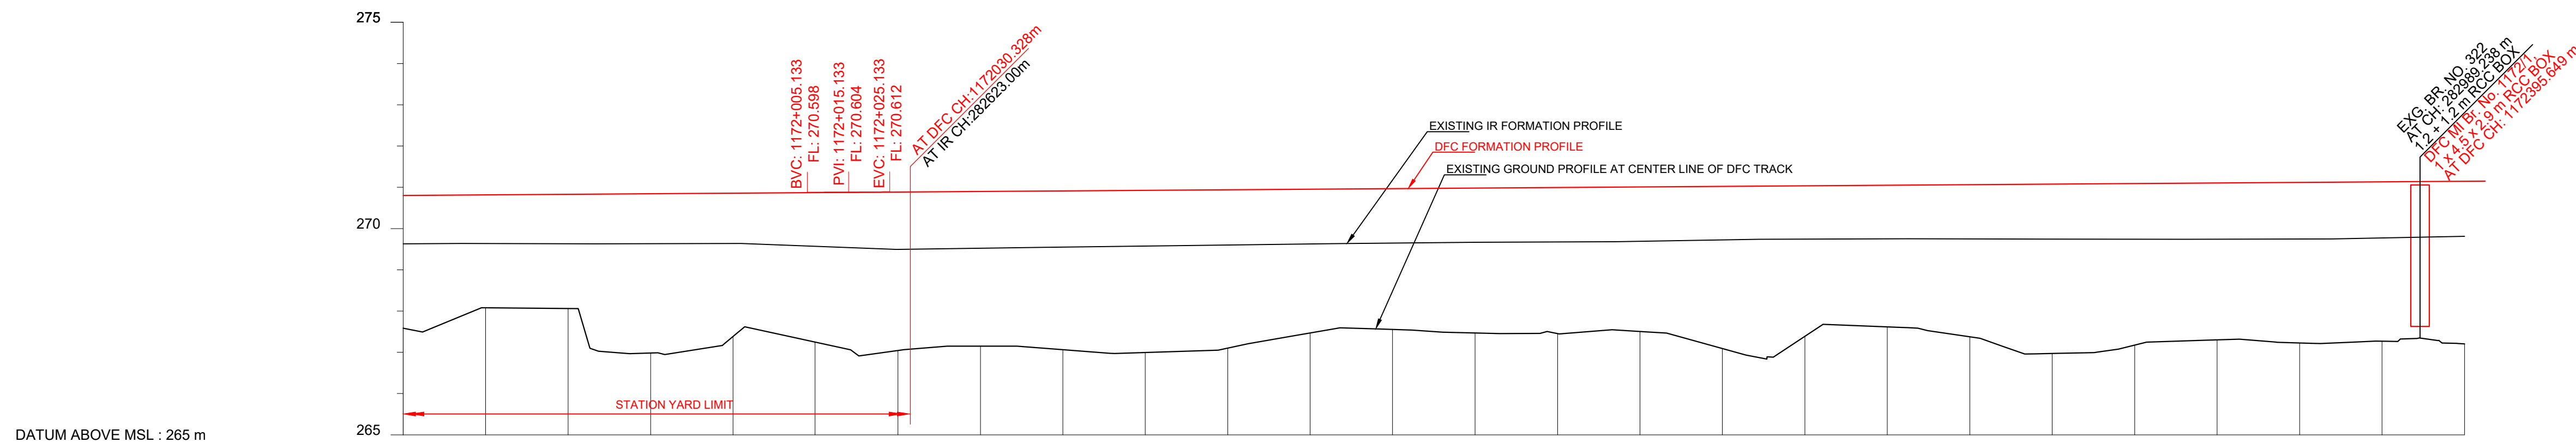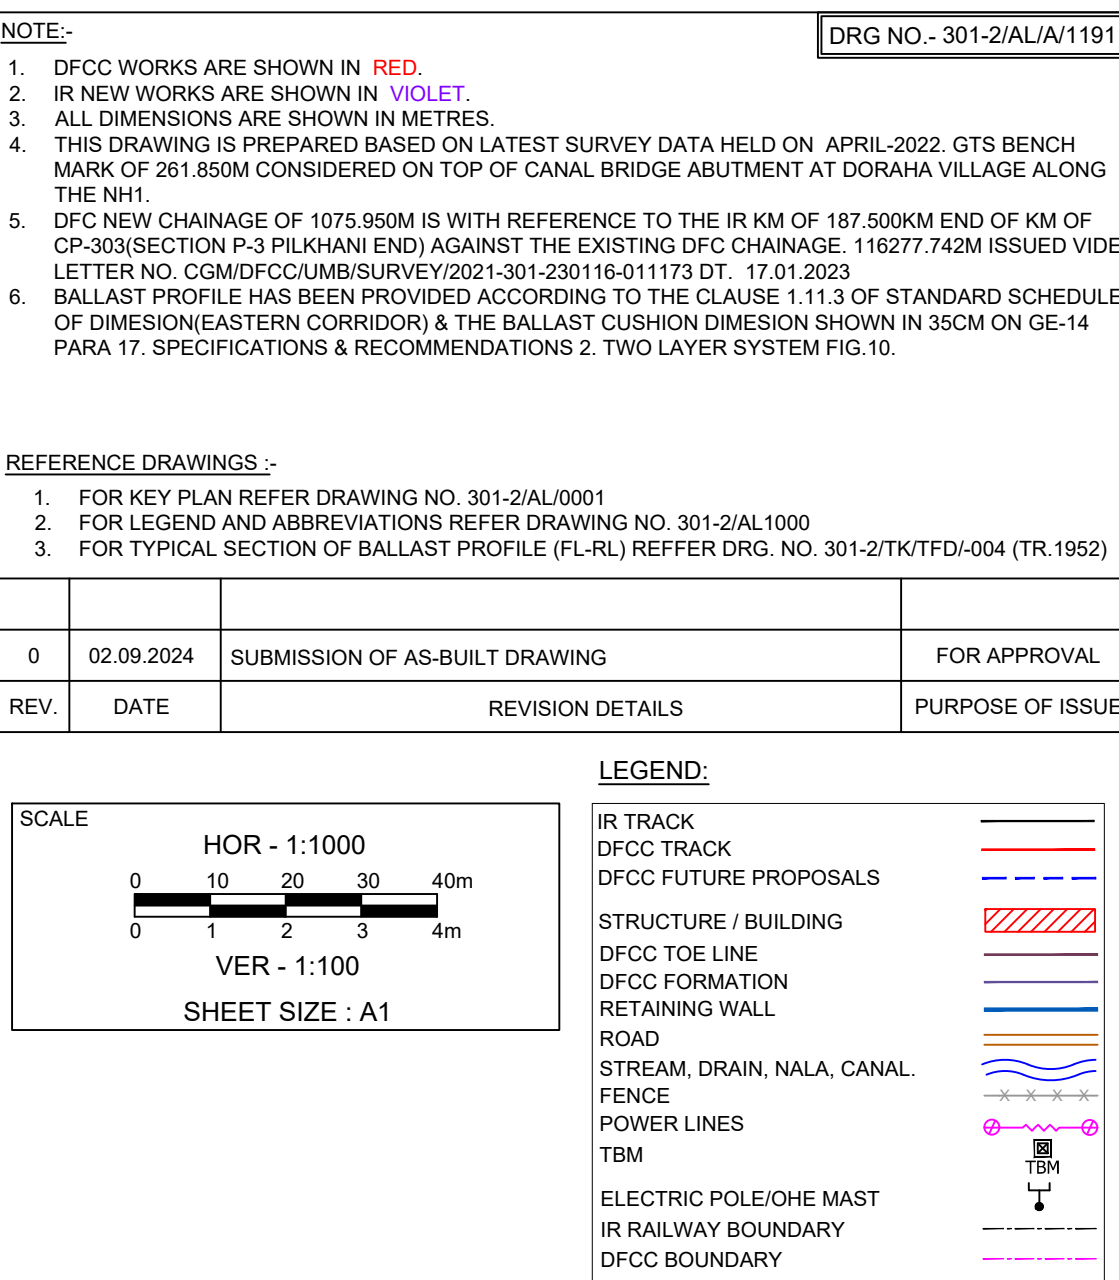[illegible]

TRACK STRUCTURE		
RAIL SECTION: 60Kg/m (UIC 60Kg/m) DFC LINE: 60Kg/m (UIC 60Kg/m) IR MAIN LINE: 52Kg/m	Difference between FL- RL (Below Rail Seat)	
	IR Line	DFC
	172mm	172mm
RUBBER PAD	6mm	10mm
SLEEPER DEPTH	210mm	210mm
BALLAST CUSHION	300mm	350mm
Total Depth (FL TO RL)	688mm	742mm

OWNER



डिडीकेड फ्रीट कोरिडोर

DEDICATED FREIGHT CORRIDOR CORPORATION OF INDIA LTD.
(A GOVERNMENT OF INDIA ENTERPRISE)
PROJECT OFFICE (AMBALA UNIT): OLD RAILWAY COLONY (NEAR
ANAND MARKET), AMBALA CANTT-133001.
CORPORATE IDENTITY NO. : U60232DL2006GOI155068

ENGINEER:

 DB Engineering &
Consulting GmbH
Deutsche Bahn Engineering & Consulting GmbH

CONTRACTOR: GIL - TPL JV

SUBMITTED BY	GIL - TPL JV		
	DATED	NAME	SIGNATURE
PREPARED BY			
CHECKED BY	02.09.2024	VIJAY PRATAP	
APPROVED BY	02.09.2024	PARASURAM KOTYADA	
APPROVED BY	DEUTSCHE BAHN ENGINEERING & CONSULTING GMBH		
	DATED	NAME	SIGNATURE
Sr. DE./CHIEF ENGINEER		SURESH K.YALANGI	
CHIEF TRACK ENGINEER		RAJ PAL SINGH	
T.L.		H.D. VIDJAK	

STAMP	A AS-BUILT DRAWING TR. Ref..... ENGINEER Sign.:		
	EMPLOYER (DFCCIL): DEDICATED FREIGHT CORRIDOR CORPORATION OF INDIA LTD		

AS BUILT DRAWING	
TITLE AS-BUILT PLAN AND PROFILE FROM IR KM: 282.500 TO 283.000 DFC KM: 1171.907 TO 1172.407	DFCC APPR. NO. -
	ENGG. APPR. NO. -
	DRG. NO. - 301-2/AL/A/1191
	SHEET NO. : 1 OF 1
	DATE : 02.09.2024
	STATUS A