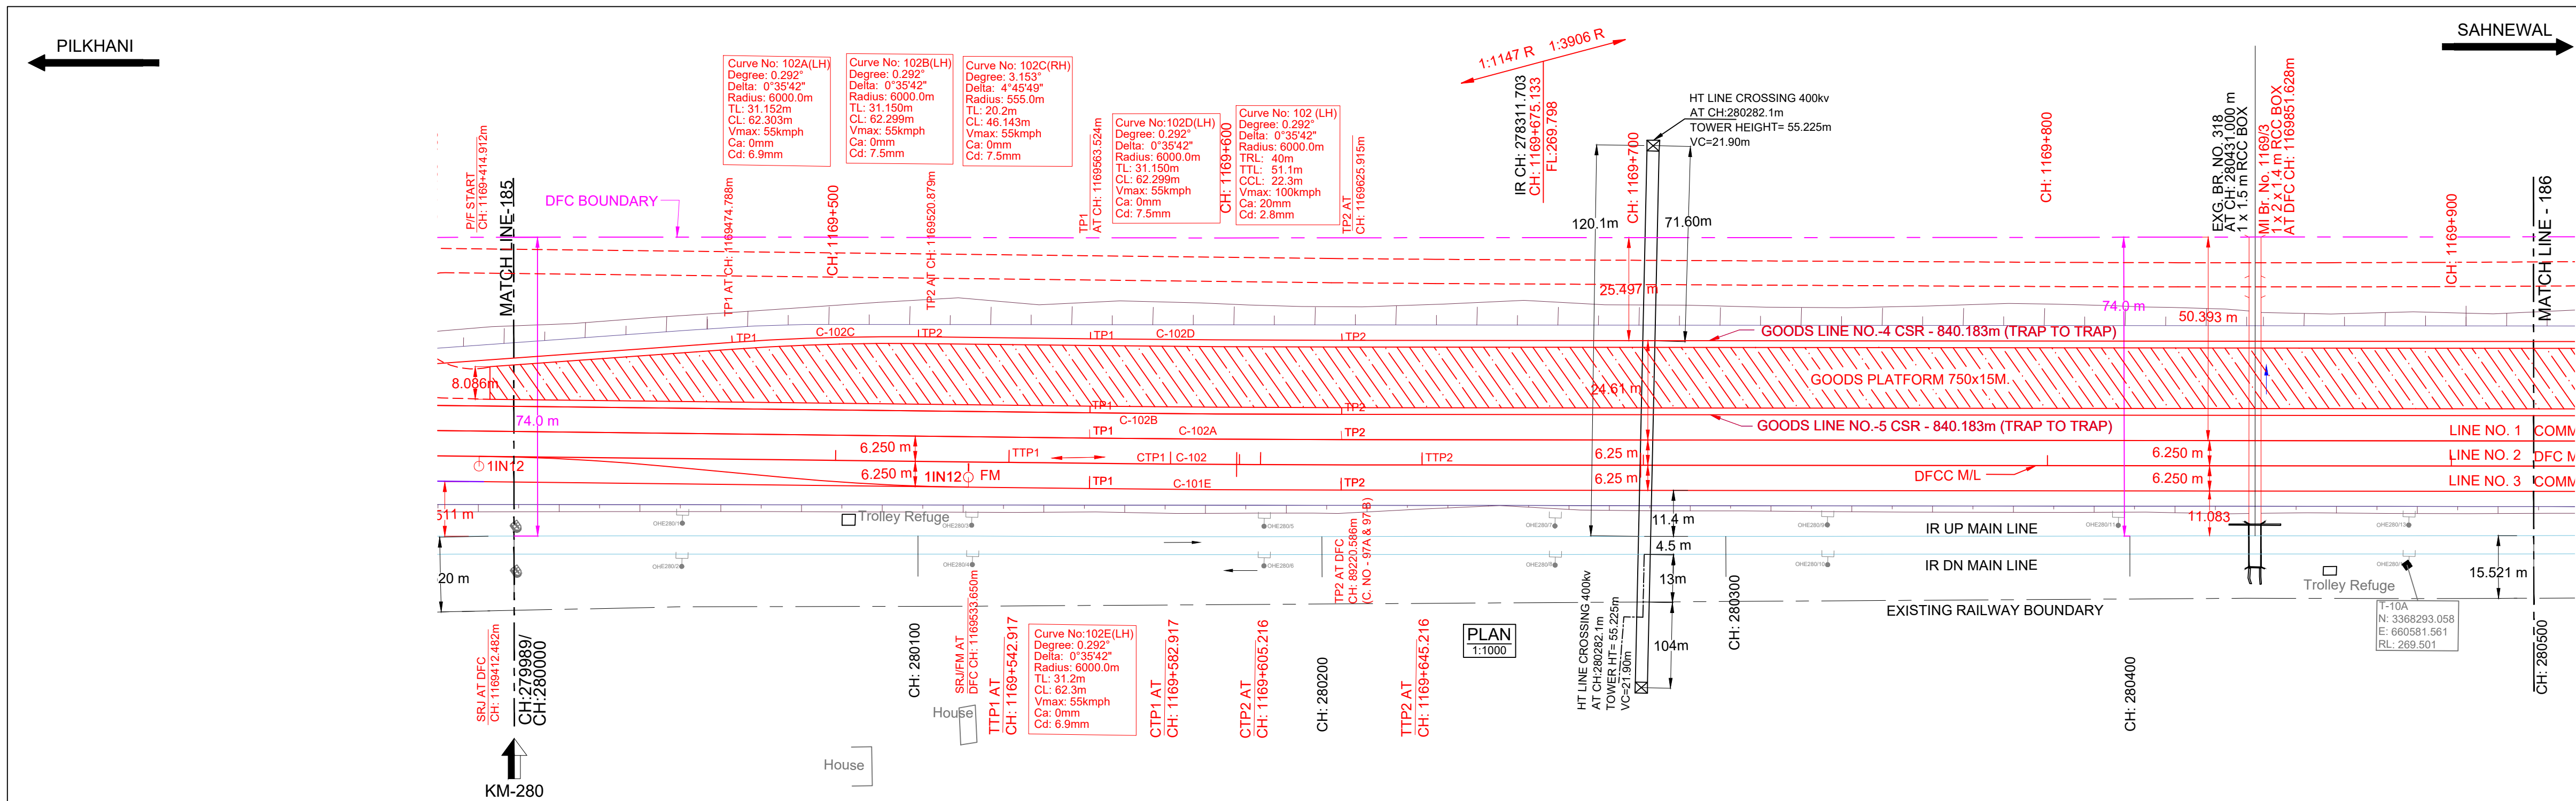


HORIZONTAL ALIGNMENT	L = 1219.90m TL = 40m R = -6000m TL = 40m L = 2649.978m																			
VERTICAL ALIGNMENT	L=748.86m 1 IN:1147.25R L=20.0m R=32486.19 L=1772.700m 1 IN:3905.664 R																			
TRACK DISTANCE FROM EXISTING IR UP MAIN LINE TO DFC MAIN LINE	19.650	19.650	19.650	19.650	19.650	19.650	19.650	19.650	19.650	19.650	19.650	19.650	19.650	19.650	19.650	19.650	19.650	19.650	19.650	19.650
HEIGHT OF BANKING(+) / DEPTH OF CUTTING(-) (FL-GL)	+2.772	+2.772	+2.772	+2.772	+2.772	+2.772	+2.772	+2.772	+2.772	+2.772	+2.772	+2.772	+2.772	+2.772	+2.772	+2.772	+2.772	+2.772	+2.772	+2.772
EXG GROUND LEVEL AT CENTER LINE OF DFC TRACK (GL)	266.804	266.804	266.804	266.804	266.804	266.804	266.804	266.804	266.804	266.804	266.804	266.804	266.804	266.804	266.804	266.804	266.804	266.804	266.804	266.804
EXG GROUND LEVEL AT TOE LOCATION OF DFC TRACK	266.968	266.968	266.968	266.968	266.968	266.968	266.968	266.968	266.968	266.968	266.968	266.968	266.968	266.968	266.968	266.968	266.968	266.968	266.968	266.968
DIFFERENCE BETWEEN DFC FORMATION LEVEL AND EXG.FORMATION LEVEL (FL-EFL)	0.749	0.749	0.749	0.749	0.749	0.749	0.749	0.749	0.749	0.749	0.749	0.749	0.749	0.749	0.749	0.749	0.749	0.749	0.749	0.749
DFC FORMATION LEVEL (FL)	269.576	269.576	269.576	269.576	269.576	269.576	269.576	269.576	269.576	269.576	269.576	269.576	269.576	269.576	269.576	269.576	269.576	269.576	269.576	269.576
EXG. FORMATION LEVEL OF EXG IR UP MAIN LINE (EFL)	269.827	269.827	269.827	269.827	269.827	269.827	269.827	269.827	269.827	269.827	269.827	269.827	269.827	269.827	269.827	269.827	269.827	269.827	269.827	269.827
DIFFERENCE BETWEEN DFC RAIL LEVEL AND EXG. RAIL LEVEL (RL - ERL)	0.790	0.790	0.790	0.790	0.790	0.790	0.790	0.790	0.790	0.790	0.790	0.790	0.790	0.790	0.790	0.790	0.790	0.790	0.790	0.790
DFC RAIL LEVEL (RL)	270.289	270.289	270.289	270.289	270.289	270.289	270.289	270.289	270.289	270.289	270.289	270.289	270.289	270.289	270.289	270.289	270.289	270.289	270.289	270.289
EXG.RAIL LEVEL OF NEAREST IR UP MAIN LINE(ERL)	269.499	269.499	269.499	269.499	269.499	269.499	269.499	269.499	269.499	269.499	269.499	269.499	269.499	269.499	269.499	269.499	269.499	269.499	269.499	269.499
EQUIVALENT CHAINAGE ON DFC TRACK	1169420.6	1169420.6	1169420.6	1169420.6	1169420.6	1169420.6	1169420.6	1169420.6	1169420.6	1169420.6	1169420.6	1169420.6	1169420.6	1169420.6	1169420.6	1169420.6	1169420.6	1169420.6	1169420.6	1169420.6
EXISTING IR CHAINAGE	279989.17	280000.0	280020.0	280040.0	280060.0	280080.0	280100.0	280120.0	280140.0	280160.0	280180.0	280200.0	280220.0	280240.0	280260.0	280280.0	280300.0	280320.0	280340.0	280360.0

L - SECTION

NOTE:-

- DFCC WORKS ARE SHOWN IN RED.
- IR NEW WORKS ARE SHOWN IN VIOLET.
- ALL DIMENSIONS ARE SHOWN IN METRES.
- THIS DRAWING IS PREPARED BASED ON LATEST SURVEY DATA HELD ON APRIL-2022. GTS BENCH MARK OF 261.850M CONSIDERED ON TOP OF CANAL BRIDGE ABUTMENT AT DORANA VILLAGE ALONG THE NH1.
- DFC NEW CHAINAGE OF 1075.950M IS WITH REFERENCE TO THE IR KM OF 187.500KM END OF KM OF CP-303(SECTION P-3 PILKHANI END) AGAINST THE EXISTING DFC CHAINAGE. 116277.742M ISSUED VIDE LETTER NO. COM/DFCC/UM/SURVEY/2021-301-230116-011173 DT. 17.01.2023.
- BALLAST PROFILE HAS BEEN PROVIDED ACCORDING TO THE CLAUSE 1.11.3 OF STANDARD SCHEDULE OF DIMENSION(EASTERN CORRIDOR) & THE BALLAST CUSHION DIMENSION SHOWN IN 35CM ON GE-14 PARA 17. SPECIFICATIONS & RECOMMENDATIONS 2. TWO LAYER SYSTEM FIG.10.

REFERENCE DRAWINGS :-

- FOR KEY PLAN REFER DRAWING NO. 301-2/AL/0001
- FOR LEGEND AND ABBREVIATIONS REFER DRAWING NO. 301-2/AL/1000
- FOR TYPICAL SECTION OF BALLAST PROFILE (FL-RL) REFER DRG. NO. 301-2/TK/TFDI-004 (TR.1952)

SCALE

HOR - 1:1000

VER - 1:100

SHEET SIZE : A1

LEGEND:

IR TRACK
DFCC TRACK
DFCC FUTURE PROPOSALS
STRUCTURE / BUILDING
DFCC TOE LINE
DFCC FORMATION
RETAINING WALL
ROAD
STREAM, DRAIN, NALA, CANAL.
FENCE
POWER LINES
TBM
ELECTRIC POLE/OHE MAST
IR RAILWAY BOUNDARY
DFCC BOUNDARY

TYPICAL SECTION

TRACK STRUCTURE		
RAIL SECTION: 60Kg/m (UIC 60Kg/m) DFC LINE: 60Kg/m (UIC 60Kg/m) IR MAIN LINE: 52Kg/m	Difference between FL- RL (Below Rail Seat)	
	IR Line	DFC
	172mm	172mm
RUBBER PAD	6mm	10mm
SLEEPER DEPTH	210mm	210mm
BALLAST CUSHION	300mm	350mm
Total Depth (FL TO RL)	688mm	742mm

OWNER

DEDICATED FREIGHT CORRIDOR CORPORATION OF INDIA LTD.

(A GOVERNMENT OF INDIA ENTERPRISE)

PROJECT OFFICE(AMBALA UNIT): OLD RAILWAY COLONY (NEAR ANAND MARKET),AMBALA CANTT-133001.

CORPORATE IDENTITY NO. : U60323DL2006GGI155068

ENGINEER:

DB Engineering & Consulting GmbH

Deutsche Bahn Engineering & Consulting GmbH

CONTRACTOR:

GIL - TPL JV

GAR TATA

SUBMITTED BY	GIL - TPL JV		
	DATED	NAME	SIGNATURE
PREPARED BY			
CHECKED BY	02.09.2024	VIJAY PRATAP	
APPROVED BY	02.09.2024	PARASURAM KOTYADA	

APPROVED BY	DEUTSCHE BAHN ENGINEERING & CONSULTING GMBH		
	DATED	NAME	SIGNATURE
Sr. DE./CHIEF ENGINEER		SURESH K.YALANGI	
CHIEF TRACK ENGINEER		RAJ PAL SINGH	
T.L.		H.D. VIDJAK	

STAMP

AS-BUILT DRAWING

TR. Ref.....

ENGINEER Sign.:

EMPLOYER (DFCCIL): DEDICATED FREIGHT CORRIDOR CORPORATION OF INDIA LTD.

AS BUILT DRAWING	
TITLE	AS-BUILT PLAN AND PROFILE
DFCC APPR. NO. -	
ENGG. APPR. NO. -	
DRG. NO. -	301-2/AL/A/1186
SHEET NO. : 1 OF 1	
DATE : 02.09.2024	
STATUS	A