
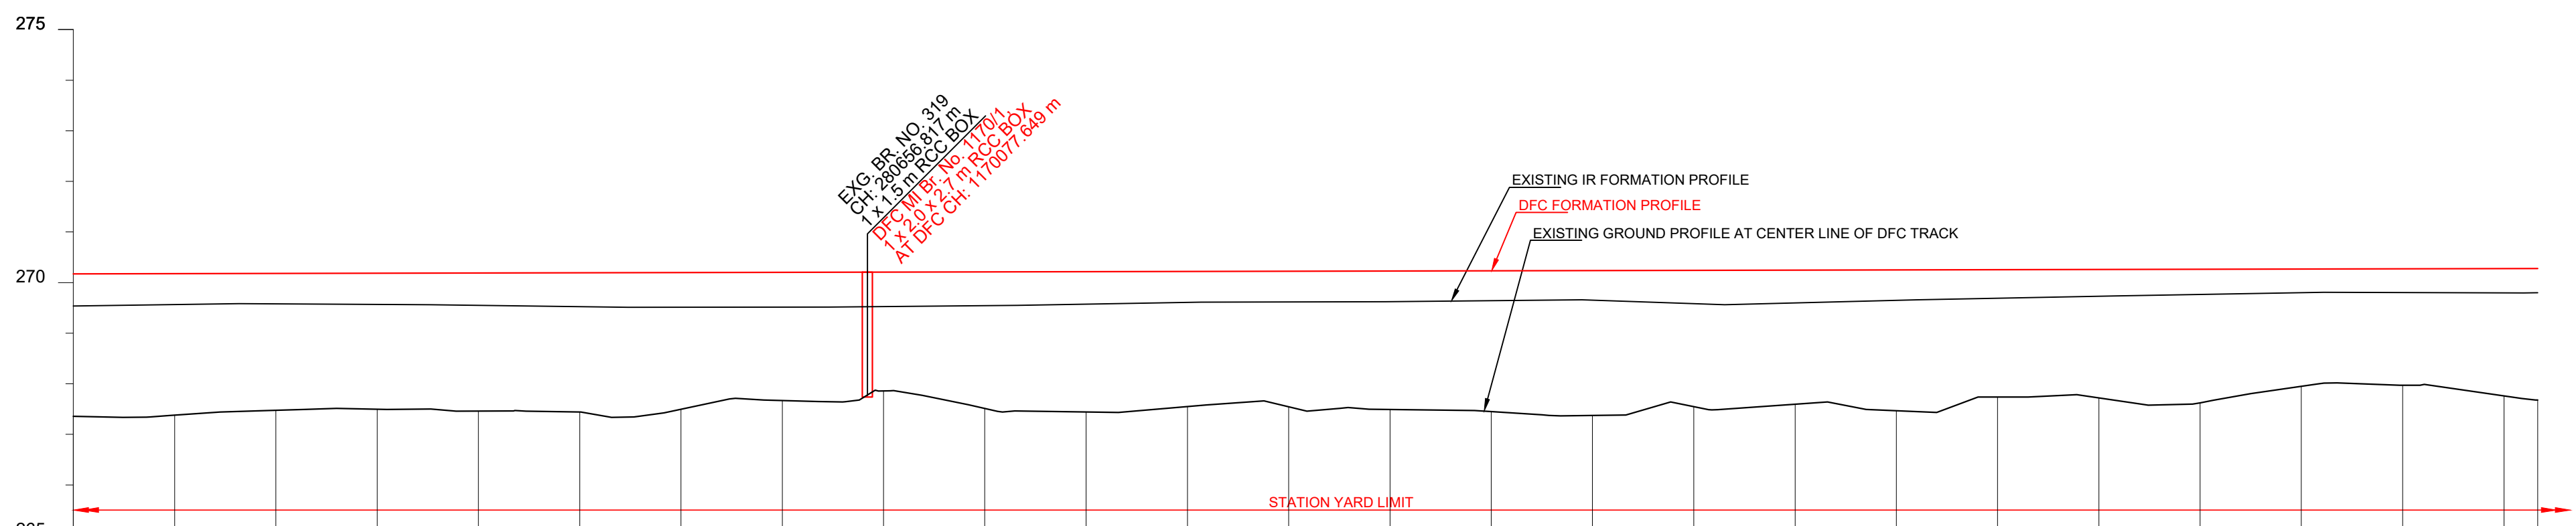


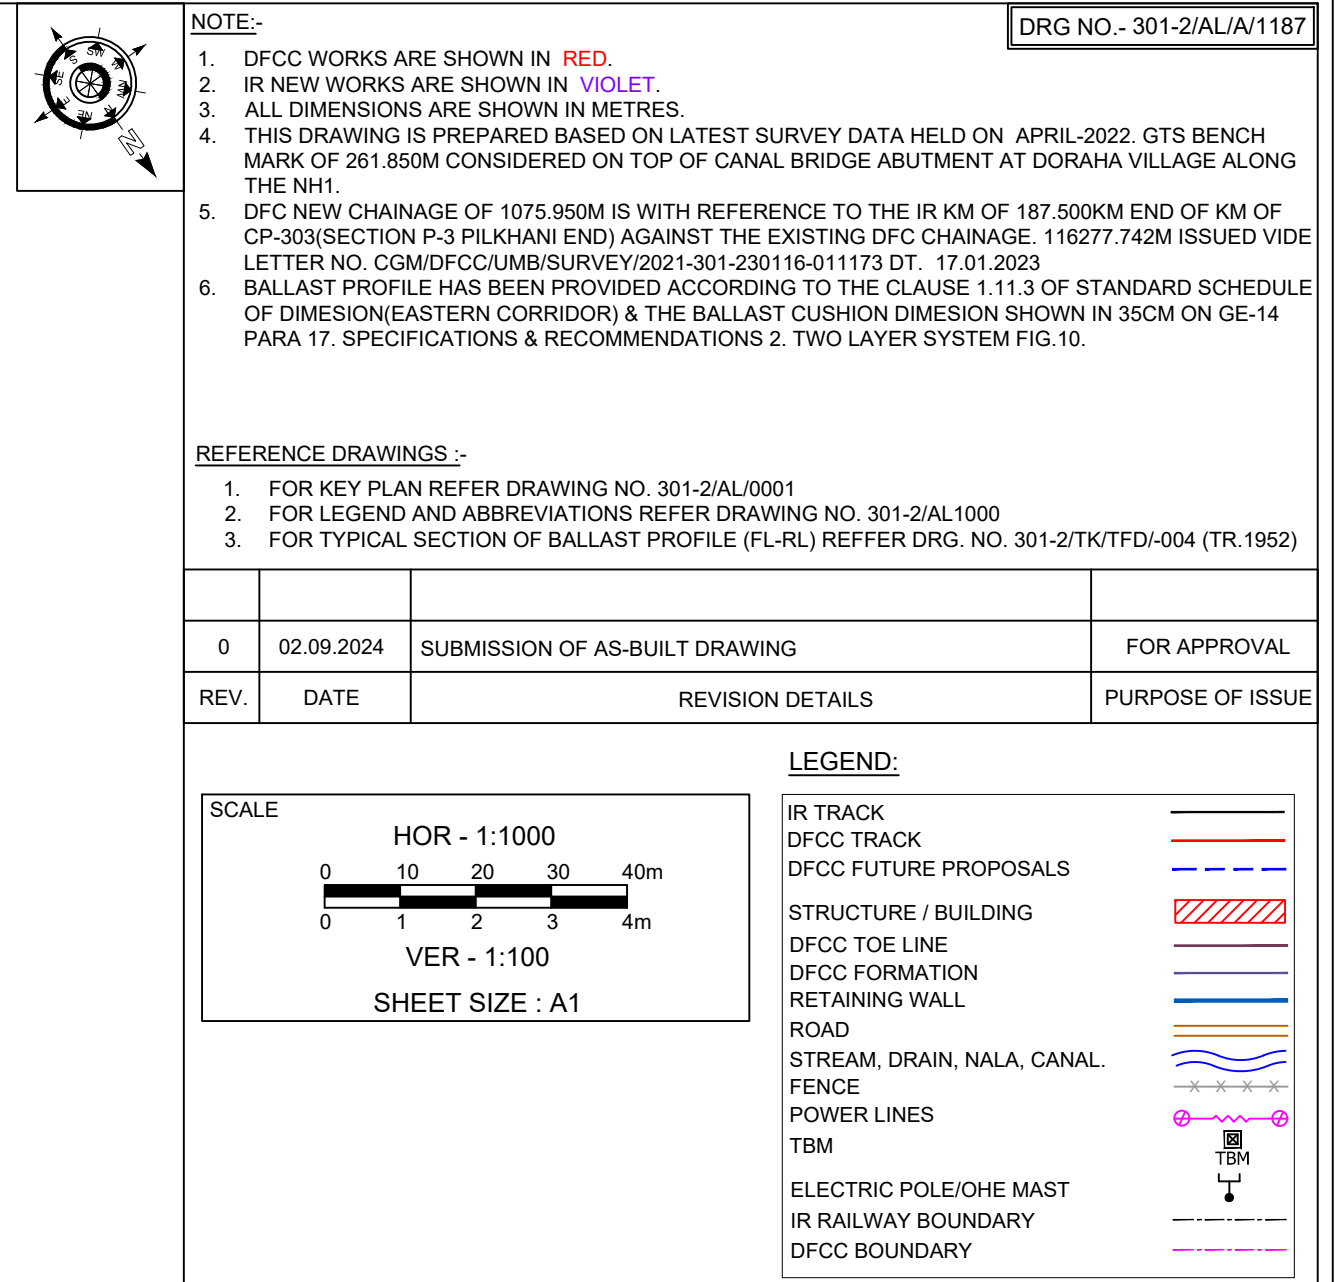

DATUM ABOVE MSL : 265 m		265	
HORIZONTAL ALIGNMENT			
VERTICAL ALIGNMENT			
TRACK DISTANCE FROM EXISTING IR UP MAIN LINE TO DFC MAIN LINE	17.213		
HEIGHT OF BANKING(+) / DEPTH OF CUTTING(-) (FL-GL)	+2.816		
EXG GROUND LEVEL AT CENTER LINE OF DFC TRACK (GL)	267.045		
EXG GROUND LEVEL AT TOE LOCATION OF DFC TRACK	267.080		
DIFFERENCE BETWEEN DFC FORMATION LEVEL AND EXG.FORMATION LEVEL.(FL-EFL)	0.619		
DFC FORMATION LEVEL (FL)	269.861		
EXG. FORMATION LEVEL OF EXG IR UP MAIN LINE (EFL)	269.241		
DIFFERENCE BETWEEN DFC RAIL LEVEL AND EXG. RAIL LEVEL (RL - ERL)	0.660		
DFC RAIL LEVEL (RL)	270.574		
EXG.RAIL LEVEL OF NEAREST IR UP MAIN LINE(ERL)	269.913		
EQUIVALENT CHAINAGE ON DFC TRACK	1169920.6		
EXISTING IR CHAINAGE	2805000.0		
	2805020.0		
	2805040.0		
	2805060.0		
	2805080.0		
	2806000.0		
	2806020.0		
	2806040.0		
	2806060.0		
	2806080.0		
	2807000.0		
	2807020.0		
	2807040.0		
	2807060.0		
	2807080.0		
	2808000.0		
	2808020.0		
	2808040.0		
	2808060.0		
	2808080.0		
	2809000.0		
	2809020.0		
	2809040.0		
	2809060.0		
	2809080.0		
	2809095.71		
	2810000.0		

TRACK STRUCTURE		
RAIL SECTION: 60Kg/m (UIC 60Kg/m) DFC LINE: 60Kg/m (UIC 60Kg/m) IR MAIN LINE:52Kg/m	Difference between FL- RL (Below Rail Seat)	
	IR Line	DFC
	172mm	172mm
RUBBER PAD	6mm	10mm
SLEEPER DEPTH	210mm	210mm
BALLAST CUSHION	300mm	350mm
Total Depth (FL TO RL)	688mm	742mm

OWNER	DEDICATED FREIGHT CORRIDOR CORPORATION OF INDIA LTD. (A GOVERNMENT OF INDIA ENTERPRISE) PROJECT OFFICE/AMBALA UNIT: OLD RAILWAY COLONY (NEAR ANAND MARKET),AMBALA CANTT-133001. CORPORATE IDENTITY NO. : U60232DL2006GOI155068
-------	---

ENGINEER:  DB Engineering & Consulting GmbH
Deutsche Bahn Engineering & Consulting GmbH

CONTRACTOR: GIL - TPL JV

SUBMITTED BY	GIL - TPL JV		
	DATED	NAME	SIGNATURE
PREPARED BY			
CHECKED BY	02.09.2024	VIJAY PRATAP	
APPROVED BY	02.09.2024	PARASURAM KOTYADA	
APPROVED BY	DEUTSCHE BAHN ENGINEERING & CONSULTING GMBH		
	DATED	NAME	SIGNATURE
Sr. DE./CHIEF ENGINEER		SURESH K.YALANGI	
CHIEF TRACK ENGINEER		RAJ PAL SINGH	
T.L.		H.D. VIDJAK	

STAMP			
EMPLOYER (DFCCIL):	DEDICATED FREIGHT CORRIDOR CORPORATION OF INDIA LTD.		

AS BUILT DRAWING	
TITLE AS-BUILT PLAN AND PROFILE FROM IR KM: 280.500 TO 281.000 DFC KM: 1169.921 TO 1170.407	DFCC APPR. NO. - ENGG. APPR. NO. - DRG. NO. - 301-2/AL/A/1187 SHEET NO. : 1 OF 1 DATE : 02.09.2024
	STATUS A