
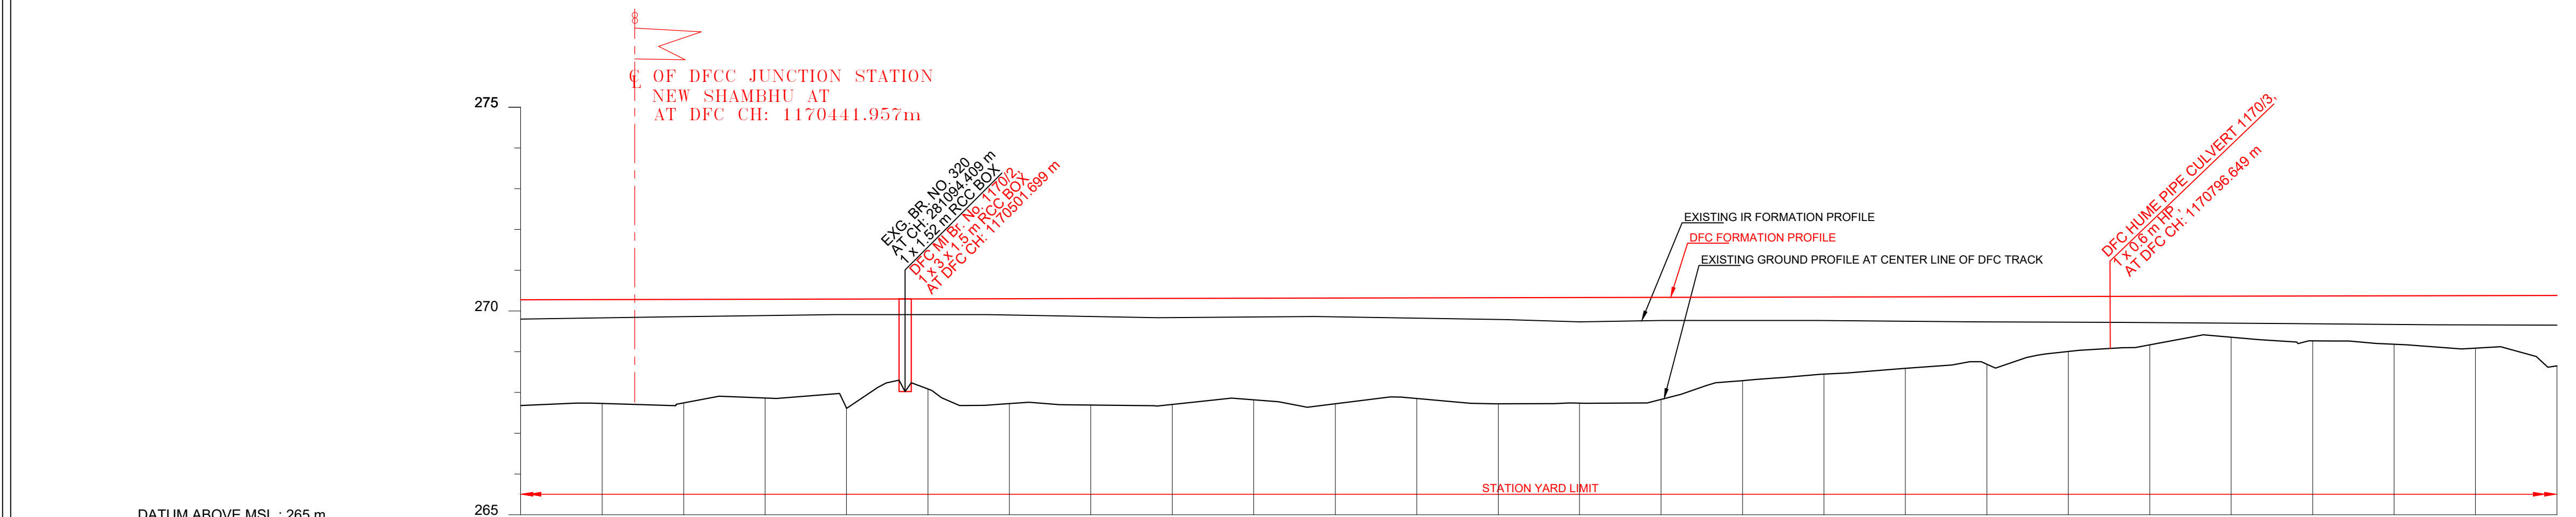


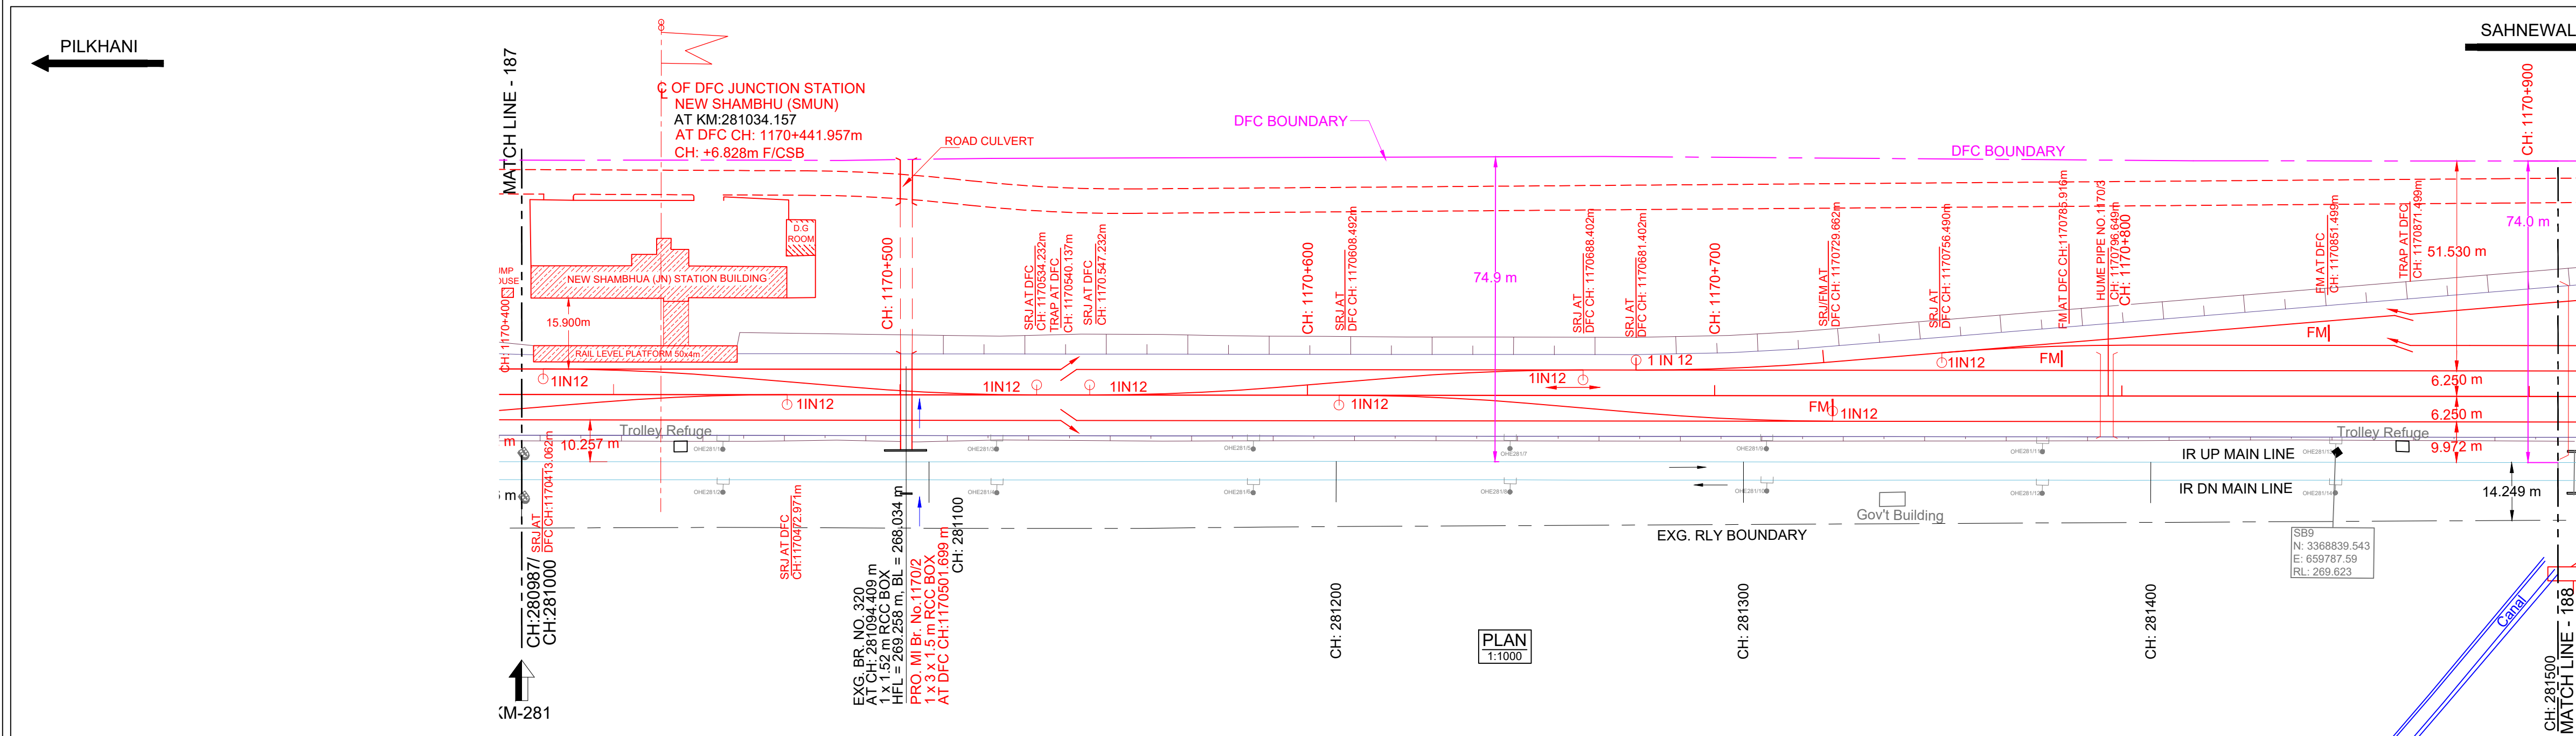

HORIZONTAL ALIGNMENT	L=2649.978m																			
VERTICAL ALIGNMENT	L=1772.700 m 1 IN 3905.664 R																			
TRACK DISTANCE FROM EXISTING IR UP MAIN LINE TO DFC MAIN LINE	16.530																			
HEIGHT OF BANKING(+) / DEPTH OF CUTTING(-) (FL-GL)	+2.598																			
EXG GROUND LEVEL AT CENTER LINE OF DFC TRACK (GL)	-267.388	-267.441	-267.454	-267.477	-267.500	-267.523	-267.546	-267.569	-267.592	-267.615	-267.638	-267.661	-267.684	-267.707	-267.730	-267.753	-267.776	-267.799	-267.822	-267.845
EXG GROUND LEVEL AT TOE LOCATION OF DFC TRACK	-267.578	-267.406	-267.026	-266.832	-266.602	-266.332	-266.034	-265.714	-265.378	-265.030	-264.674	-264.306	-263.929	-263.547	-263.161	-262.771	-262.378	-261.982	-261.584	-261.183
DIFFERENCE BETWEEN DFC FORMATION LEVEL AND EXG.FORMATION LEVEL (FL-EFL)	0.480	0.434	0.410	0.386	0.366	0.341	0.311	0.276	0.236	0.191	0.141	0.086	0.026	-0.039	-0.109	-0.184	-0.264	-0.349	-0.439	-0.534
DFC FORMATION LEVEL (FL)	-269.985	-269.991	-269.996	-270.001	-270.006	-270.011	-270.016	-270.021	-270.026	-270.031	-270.036	-270.041	-270.046	-270.051	-270.056	-270.061	-270.066	-270.071	-270.076	-270.081
EXG. FORMATION LEVEL OF EXG IR UP MAIN LINE (EFL)	-269.526	-269.556	-269.586	-269.615	-269.640	-269.664	-269.688	-269.712	-269.736	-269.760	-269.784	-269.808	-269.832	-269.856	-269.880	-269.904	-269.928	-269.952	-269.976	-270.000
DIFFERENCE BETWEEN DFC RAIL LEVEL AND EXG. RAIL LEVEL (RL - ERL)	0.501	0.475	0.451	0.427	0.407	0.382	0.352	0.317	0.277	0.232	0.182	0.127	0.067	0.002	-0.068	-0.143	-0.223	-0.308	-0.398	-0.493
DFC RAIL LEVEL (RL)	-270.696	-270.704	-270.709	-270.714	-270.719	-270.724	-270.729	-270.734	-270.739	-270.744	-270.749	-270.754	-270.759	-270.764	-270.769	-270.774	-270.779	-270.784	-270.789	-270.794
EXG.RAIL LEVEL OF NEAREST IR UP MAIN LINE(ERL)	-270.198	-270.228	-270.258	-270.287	-270.312	-270.332	-270.352	-270.372	-270.392	-270.412	-270.432	-270.452	-270.472	-270.492	-270.512	-270.532	-270.552	-270.572	-270.592	-270.612
EQUIVALENT CHAINAGE ON DFC TRACK	28098.7	28100.0	281020.0	281040.0	281060.0	281080.0	281100.0	281120.0	281140.0	281160.0	281180.0	281200.0	281220.0	281240.0	281260.0	281280.0	281300.0	281320.0	281340.0	281360.0
EXISTING IR CHAINAGE	28098.7	281000.0	281020.0	281040.0	281060.0	281080.0	281100.0	281120.0	281140.0	281160.0	281180.0	281200.0	281220.0	281240.0	281260.0	281280.0	281300.0	281320.0	281340.0	281360.0

L - SECTION

NOTE:-

- DFCC WORKS ARE SHOWN IN RED.
- IR NEW WORKS ARE SHOWN IN VIOLET.
- ALL DIMENSIONS ARE SHOWN IN METRES.
- THIS DRAWING IS PREPARED BASED ON LATEST SURVEY DATA HELD ON APRIL-2022. GTS BENCH MARK OF 261.850M CONSIDERED ON TOP OF CANAL BRIDGE ABUTMENT AT DORANA VILLAGE ALONG THE NH1.
- DFC NEW CHAINAGE OF 1075.950M IS WITH REFERENCE TO THE IR KM OF 187.500KM END OF KM OF CP-303(SECTION P-3 PILKHANI END) AGAINST THE EXISTING DFC CHAINAGE. 116277.742M ISSUED VIDE LETTER NO. COM/DFCC/CHAINSURVEY/2021-301-28016-01173 DT. 17.01.2023.
- BALLAST PROFILE HAS BEEN PROVIDED ACCORDING TO THE CLAUSE 1.11.3 OF STANDARD SCHEDULE OF DIMENSION(EASTERN CORRIDOR) & THE BALLAST CUSHION DIMENSION SHOWN IN 35CM ON GE-14 PARA 17. SPECIFICATIONS & RECOMMENDATIONS 2. TWO LAYER SYSTEM FIG.10.

REFERENCE DRAWINGS:-

- FOR KEY PLAN REFER DRAWING NO. 301-2/AL/0001
- FOR LEGEND AND ABBREVIATIONS REFER DRAWING NO. 301-2/AL/1000
- FOR TYPICAL SECTION OF BALLAST PROFILE (FL-RL) REFER DRG. NO. 301-2/TK/TFD/004 (TR.1952)

DRG NO. - 301-2/AL/A/1188

0	02.09.2024	SUBMISSION OF AS-BUILT DRAWING	FOR APPROVAL
REV.	DATE	REVISION DETAILS	PURPOSE OF ISSUE

SCALE

HOR - 1:1000

VER - 1:100

SHEET SIZE : A1

LEGEND:

IR TRACK

DFCC TRACK

DFCC FUTURE PROPOSALS

STRUCTURE / BUILDING

DFCC TOE LINE

DFCC FORMATION

RETAINING WALL

ROAD

STREAM, DRAIN, NALA, CANAL.

FENCE

POWER LINES

TBM

ELECTRIC POLE/OHE MAST

IR RAILWAY BOUNDARY

DFCC BOUNDARY

TYPICAL SECTION

TRACK STRUCTURE		
RAIL SECTION: 60Kg/m (UIC 60Kg/m) DFC LINE: 60Kg/m (UIC 60Kg/m) IR MAIN LINE: 52Kg/m	Difference between FL- RL (Below Rail Seat)	
	IR Line	DFC
RUBBER PAD	172mm	172mm
SLEEPER DEPTH	6mm	10mm
BALLAST CUSHION	210mm	210mm
Total Depth (FL TO RL)	300mm	350mm

OWNER

DEDICATED FREIGHT CORRIDOR CORPORATION OF INDIA LTD.

(A GOVERNMENT OF INDIA ENTERPRISE)

PROJECT OFFICE (AMBALA UNIT): OLD RAILWAY COLONY (NEAR ANAND MARKET), AMBALA CANTT-133001.

CORPORATE IDENTITY NO. : U60232DL2006GGI155068

ENGINEER:

DB Engineering & Consulting GmbH

Deutsche Bahn Engineering & Consulting GmbH

CONTRACTOR:

GIL - TPL JV

GAR TATA

SUBMITTED BY	GIL - TPL JV		
	DATED	NAME	SIGNATURE
PREPARED BY			
CHECKED BY	02.09.2024	VIJAY PRATAP	
APPROVED BY	02.09.2024	PARASURAM KOTYADA	
APPROVED BY	DEUTSCHE BAHN ENGINEERING & CONSULTING GMBH		
	DATED	NAME	SIGNATURE
Sr. DE./CHIEF ENGINEER		SURESH K.YALANGI	
CHIEF TRACK ENGINEER		RAJ PAL SINGH	
T.L.		H.D. VIDJAK	

STAMP

A AS-BUILT DRAWING

TR. Ref.:.....

ENGINEER Sign.:.....

EMPLOYER (DFCCIL):	DEDICATED FREIGHT CORRIDOR CORPORATION OF INDIA LTD.		

AS BUILT DRAWING

TITLE

AS-BUILT PLAN AND PROFILE

FROM IR KM: 281.000 TO 281.500

DFC KM: 1170.407 TO 1170.907

DFCC APPR. NO. -

ENGG. APPR. NO. -

DRG. NO. - 301-2/AL/A/1188

SHEET NO. : 1 OF 1

DATE : 02.09.2024

STATUS

A

TR.5126-R0