


TRACK STRUCTURE		
RAIL SECTION: 60Kg/m (UIC 60Kg/m) DFC LINE: 60Kg/m (UIC 60Kg/m) IR MAIN LINE: 52Kg/m	Difference between FL- RL (Below Rail Seat)	
	IR Line	DFC
	172mm	172mm
RUBBER PAD	6mm	10mm
SLEEPER DEPTH	210mm	210mm
BALLAST CUSHION	300mm	350mm
Total Depth (FL TO RL)	688mm	742mm

OWNER

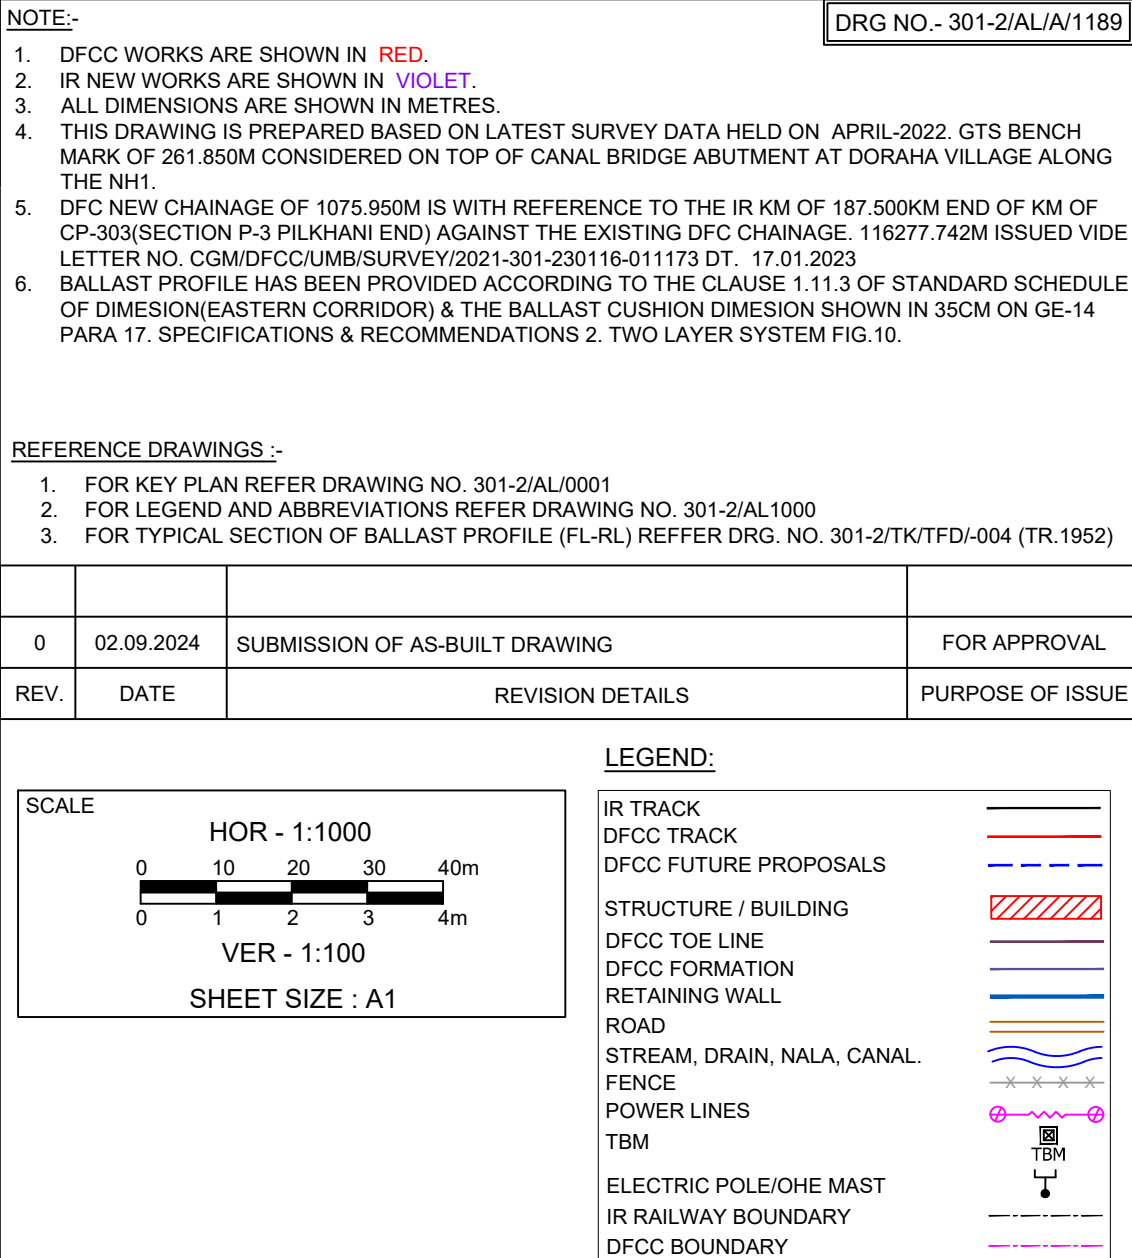

डेडीकेटेड फ्रीट कोरिडोर

DEDICATED FREIGHT CORRIDOR CORPORATION OF INDIA LTD.
(A GOVERNMENT OF INDIA ENTERPRISE)
PROJECT OFFICE (AMBALA UNIT): OLD RAILWAY COLONY (NEAR
ANAND MARKET), AMBALA CANTT-133001.
CORPORATE IDENTITY NO. : U60232DL2006GOI155068

ENGINEER:

 DB Engineering & Consulting GmbH
Deutsche Bahn Engineering & Consulting GmbH

CONTRACTOR: GIL - TPL JV

SUBMITTED BY	GIL - TPL JV		
	DATED	NAME	SIGNATURE
PREPARED BY			
CHECKED BY	02.09.2024	VIJAY PRATAP	
APPROVED BY	02.09.2024	PARASURAM KOTYADA	


APPROVED BY	DEUTSCHE BAHN ENGINEERING & CONSULTING GMBH		
	DATED	NAME	SIGNATURE
Sr. DE./CHIEF ENGINEER		SURESH K.YALANGI	
CHIEF TRACK ENGINEER		RAJ PAL SINGH	
T.L.		H.D. VIDJAK	

STAMP	

EMPLOYER (DFCCIL): DEDICATED FREIGHT CORRIDOR CORPORATION OF INDIA LTD.

--	--	--	--

AS BUILT DRAWING	
TITLE AS-BUILT PLAN AND PROFILE FROM IR KM: 281.500 TO 282.000 DFC KM: 1170.907 TO 1171.407	DFCC APPR. NO. -
	ENGG. APPR. NO. -
	DRG. NO. - 301-2/AL/A/1189
	SHEET NO. : 1 OF 1
DATE : 02.09.2024	STATUS A

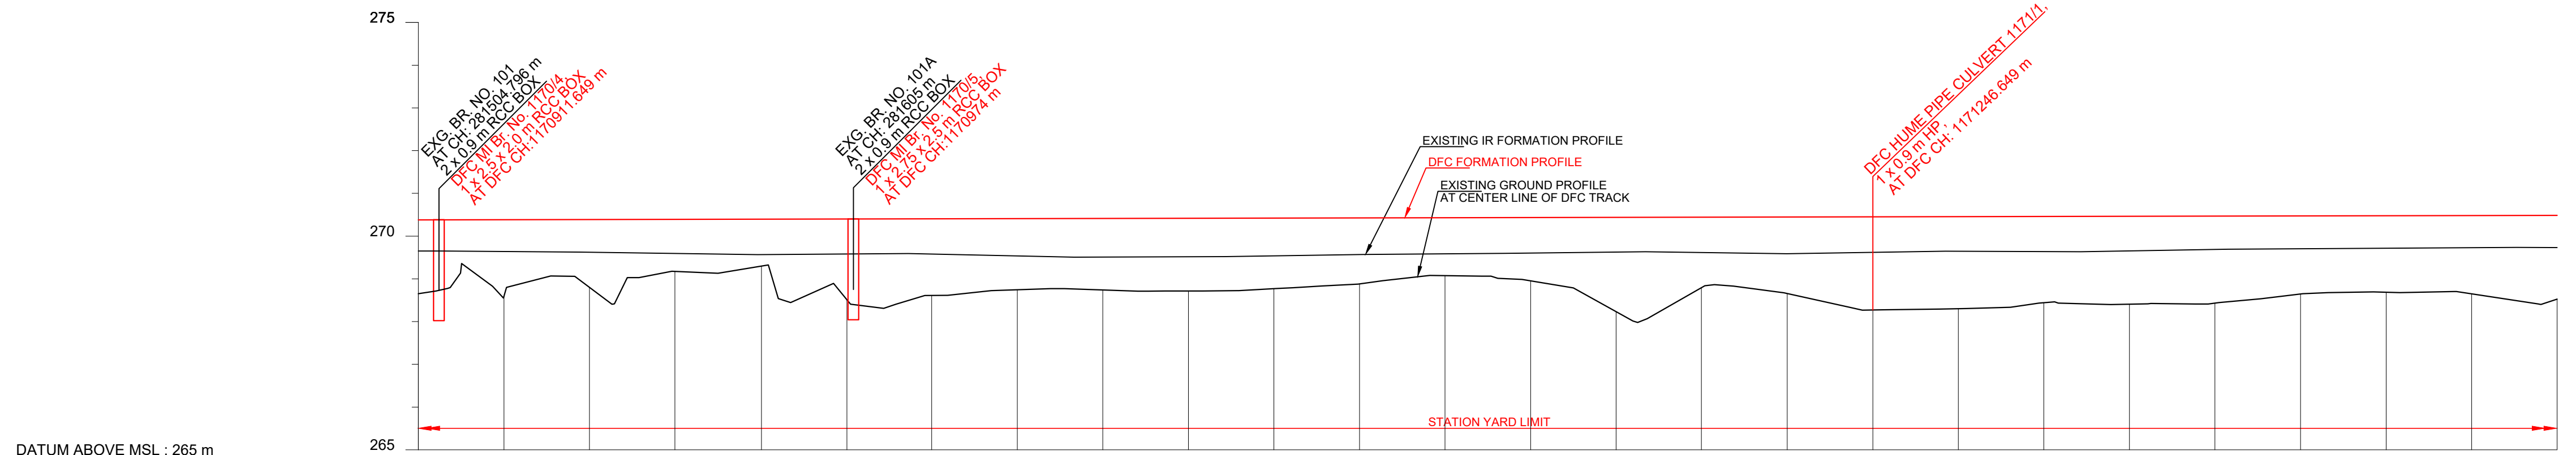

HORIZONTAL ALIGNMENT										
VERTICAL ALIGNMENT	L=2649.978m L=1772.700 m 1 IN 3905.664 R									
TRACK DISTANCE FROM EXISTING IR UP MAIN LINE TO DFC MAIN LINE	-16.202-									
HEIGHT OF BANKING(+) / DEPTH OF CUTTING(-) (FL-GL)	+1.730-									
EXG GROUND LEVEL AT CENTER LINE OF DFC TRACK (GL)	-268.384-									
EXG GROUND LEVEL AT TOE LOCATION OF DFC TRACK	-268.711-									
DIFFERENCE BETWEEN DFC FORMATION LEVEL AND EXG.FORMATION LEVEL.(FL-EFL)	0.713-									
DFC FORMATION LEVEL (FL)	-270.113-									
EXG. FORMATION LEVEL OF EXG IR UP MAIN LINE (EFL)	-269.400-									
DIFFERENCE BETWEEN DFC RAIL LEVEL AND EXG. RAIL LEVEL (RL - ERL)	0.754-									
DFC RAIL LEVEL (RL)	-270.826-									
EXG.RAIL LEVEL OF NEAREST IR UP MAIN LINE(ERL)	-270.072-									
EQUIVALENT CHAINAGE ON DFC TRACK	-1170807.3-									
EXISTING IR CHAINAGE	-281500.0	-1170807.3-	-270.072-	-270.826-	0.754-	-269.400-	-270.113-	0.713-	-268.711-	-268.384-
	-281520.0	-1170827.3-	-270.061-	-270.832-	0.771-	-269.389-	-270.110-	0.730-	-269.662-	-268.330-
	-281540.0	-1170847.3-	-270.046-	-270.837-	0.791-	-269.374-	-270.124-	0.750-	-269.762-	-268.536-
	-281560.0	-1170867.3-	-270.019-	-270.842-	0.823-	-269.347-	-270.129-	0.782-	-269.771-	-268.908-
	-281580.0	-1170887.5-	-269.992-	-270.847-	0.855-	-269.320-	-270.134-	0.814-	-269.676-	-269.033-
	-281600.0	-1171007.5-	-270.006-	-270.852-	0.846-	-269.334-	-270.139-	0.805-	-268.792-	-268.245-
	-281620.0	-1171027.3-	-270.004-	-270.857-	0.853-	-269.332-	-270.144-	0.812-	-268.450-	-268.349-
	-281640.0	-1171047.3-	-269.992-	-270.862-	0.900-	-269.290-	-270.149-	0.859-	-268.512-	-268.463-
	-281660.0	-1171067.3-	-269.937-	-270.867-	0.930-	-269.265-	-270.154-	0.889-	-268.496-	-268.480-
	-281680.0	-1171087.3-	-269.946-	-270.873-	0.927-	-269.274-	-270.160-	0.886-	-268.484-	-268.456-
	-281700.0	-1171107.3-	-269.967-	-270.878-	0.910-	-269.295-	-270.165-	0.869-	-268.523-	-268.513-
	-281720.0	-1171127.3-	-269.998-	-270.883-	0.895-	-269.326-	-270.170-	0.844-	-268.617-	-268.626-
	-281740.0	-1171147.3-	-270.016-	-270.888-	0.872-	-269.344-	-270.175-	0.831-	-268.747-	-268.819-
	-281760.0	-1171167.3-	-270.035-	-270.893-	0.858-	-269.363-	-270.180-	0.817-	-268.597-	-268.695-
	-281780.0	-1171187.3-	-270.060-	-270.898-	0.838-	-269.388-	-270.185-	0.797-	-268.230-	-267.976-
	-281800.0	-1171207.2-	-270.050-	-270.903-	0.853-	-269.378-	-270.190-	0.812-	-268.169-	-268.537-
	-281820.0	-1171227.3-	-270.022-	-270.908-	0.887-	-269.350-	-270.195-	0.846-	-268.065-	-268.402-
	-281840.0	-1171247.3-	-270.054-	-270.914-	0.860-	-269.382-	-270.201-	0.819-	-267.923-	-268.018-
	-281860.0	-1171267.3-	-270.081-	-270.919-	0.838-	-269.409-	-270.206-	0.797-	-267.883-	-268.049-
	-281880.0	-1171287.3-	-270.074-	-270.924-	0.850-	-269.402-	-270.211-	0.809-	-267.984-	-268.192-
	-281900.0	-1171307.3-	-270.092-	-270.929-	0.837-	-269.420-	-270.216-	0.796-	-268.126-	-268.158-
	-281920.0	-1171327.3-	-270.129-	-270.934-	0.805-	-269.457-	-270.221-	0.764-	-268.382-	-268.183-
	-281940.0	-1171347.3-	-270.144-	-270.939-	0.795-	-269.472-	-270.226-	0.754-	-268.454-	-268.397-
	-281960.0	-1171367.3-	-270.158-	-270.944-	0.787-	-269.486-	-270.231-	0.746-	-268.432-	-268.439-
	-281980.0	-1171387.3-	-270.170-	-270.949-	0.779-	-269.498-	-270.236-	0.738-	-268.446-	-268.402-
	-292000.0	-1171407.3-	-270.174-	-270.955-	0.780-	-269.502-	-270.242-	0.739-	-268.359-	-268.280-

L - SECTION