
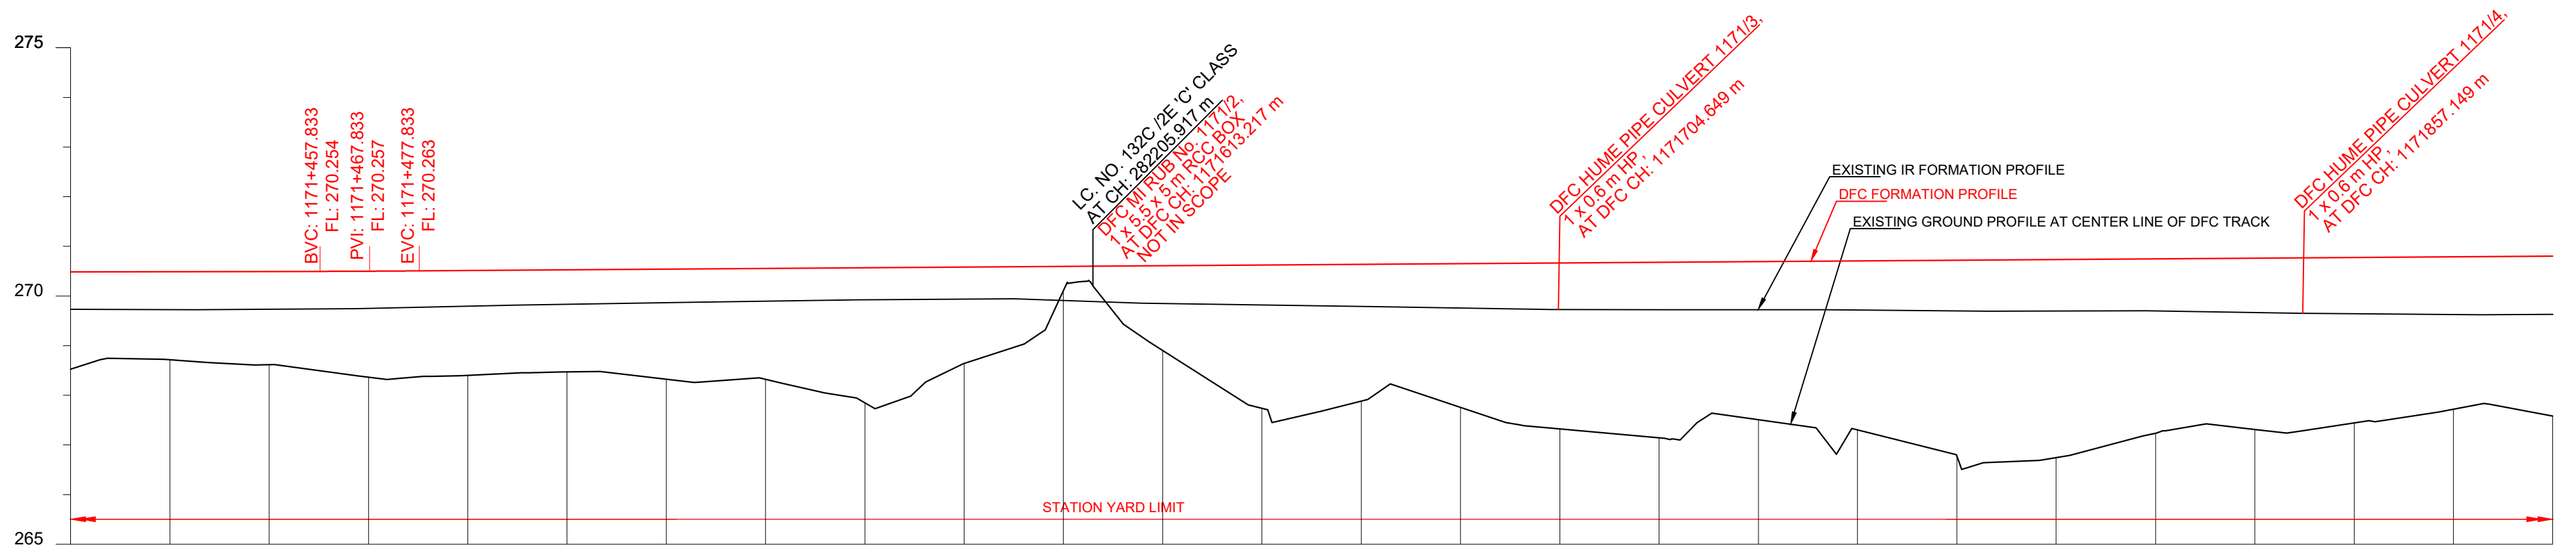


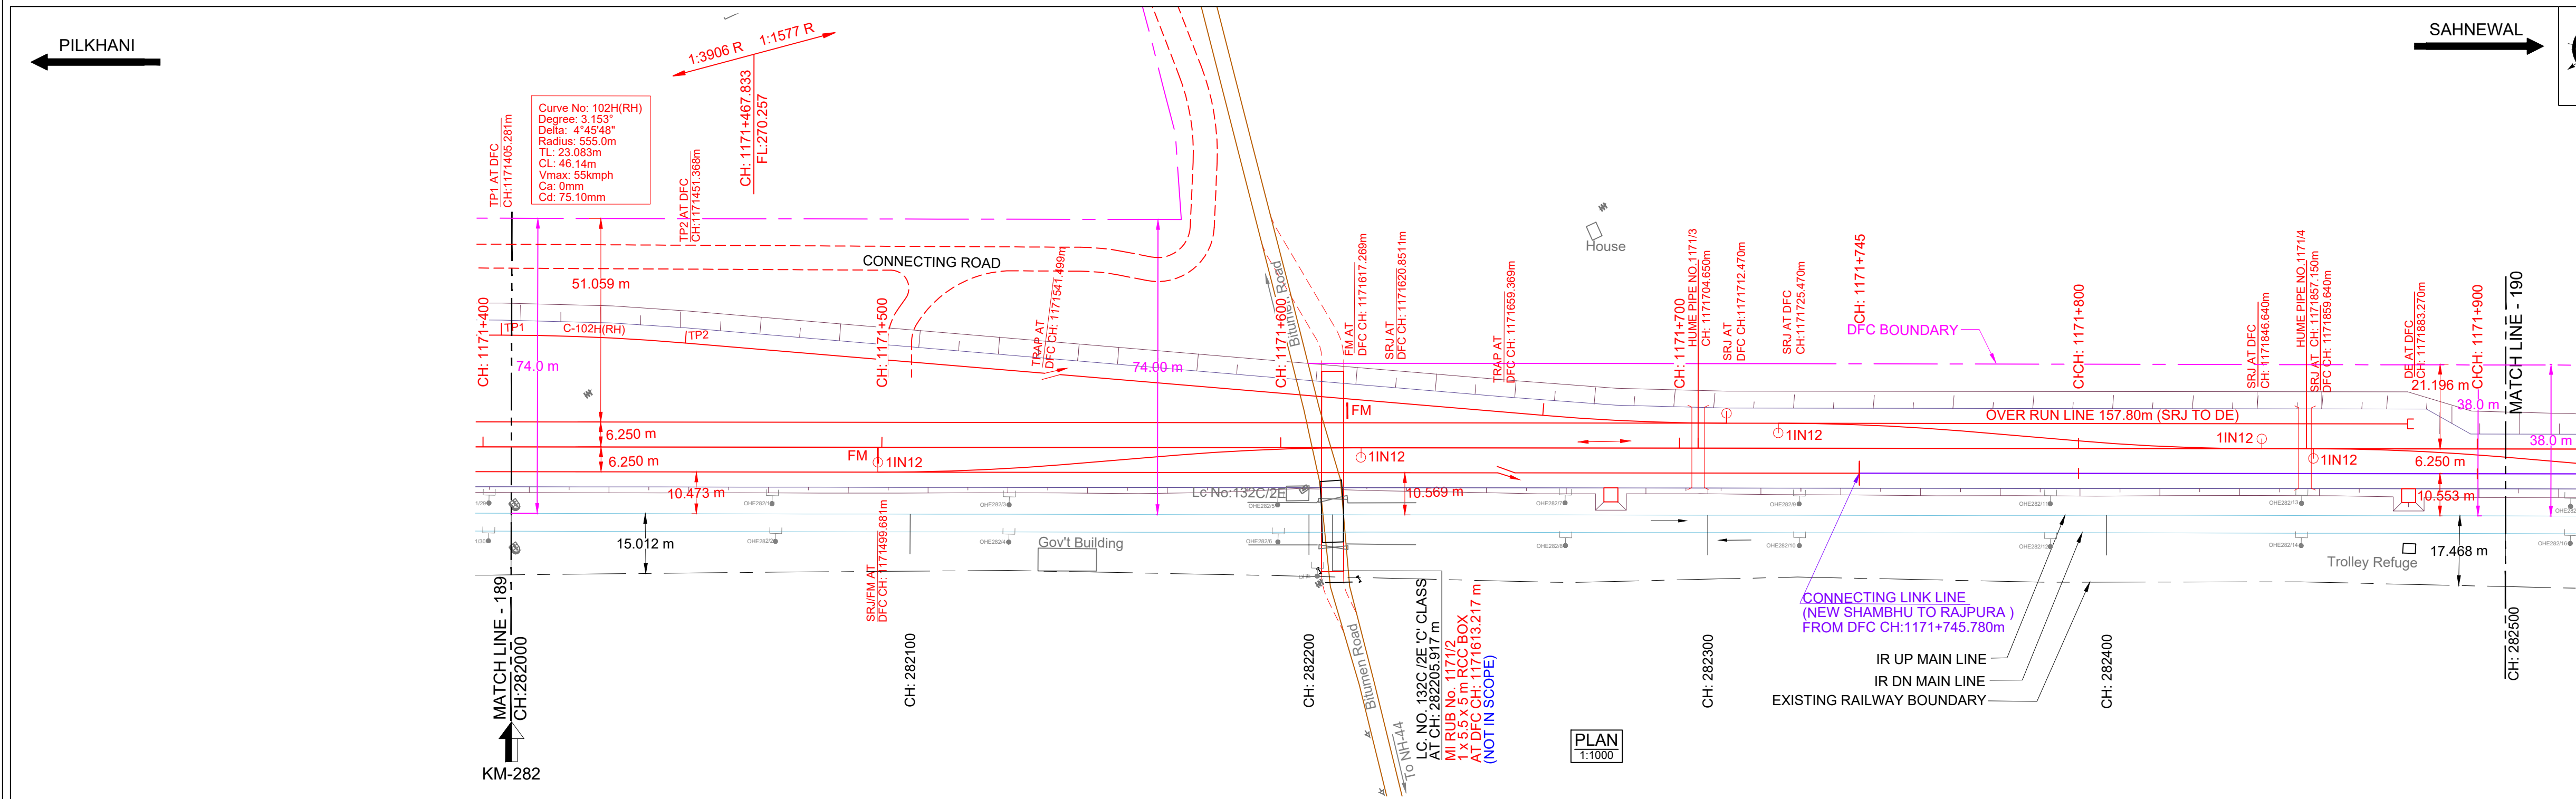

HORIZONTAL ALIGNMENT	L=2649.978m																			
VERTICAL ALIGNMENT	L=1772.700 m 1 IN 3905.664 R L=20.0m R=52912.41 L=527.300 m 1 IN 1577.233 R																			
TRACK DISTANCE FROM EXISTING IR UP MAIN LINE TO DFC MAIN LINE	16.669	16.669	16.695	16.717	16.739	16.762	16.773	16.773	16.791	16.814	16.829	16.830	16.820	16.816	16.813	16.816	16.820	16.822	16.847	16.848
HEIGHT OF BANKING(+) / DEPTH OF CUTTING(-) (FL-GL)	+1.962	+1.962	+1.775	+1.879	+2.136	+2.112	+2.055	+2.217	+2.232	+2.721	+1.940	+0.492	+1.705	+2.887	+2.756	+2.896	+3.342	+3.537	+3.185	+3.402
EXG GROUND LEVEL AT CENTER LINE OF DFC TRACK (GL)	268.280	268.280	268.472	268.373	268.121	268.157	268.227	268.078	268.075	267.599	268.393	269.853	268.653	267.484	267.627	267.501	267.006	266.884	266.249	266.045
EXG GROUND LEVEL AT TOE LOCATION OF DFC TRACK	268.359	268.359	268.339	268.205	268.072	268.184	268.333	268.330	268.199	267.979	268.276	269.206	267.947	267.530	267.424	267.336	267.006	266.648	266.659	266.591
DIFFERENCE BETWEEN DFC FORMATION LEVEL AND EXG.FORMATION LEVEL (FL-EFL)	0.739	0.739	0.750	0.747	0.735	0.705	0.679	0.660	0.644	0.630	0.631	0.672	0.747	0.790	0.832	0.877	0.921	0.941	0.954	0.974
DFC FORMATION LEVEL (FL)	270.242	270.242	270.247	270.252	270.257	270.269	270.282	270.295	270.307	270.320	270.333	270.345	270.358	270.371	270.383	270.396	270.409	270.421	270.434	270.447
EXG. FORMATION LEVEL OF EXG IR UP MAIN LINE (EFL)	269.502	269.502	269.496	269.505	269.522	269.565	269.603	269.634	269.663	269.690	269.701	269.673	269.611	269.581	269.551	269.519	269.487	269.481	269.480	269.473
DIFFERENCE BETWEEN DFC RAIL LEVEL AND EXG. RAIL LEVEL (RL - ERL)	0.780	0.780	0.791	0.788	0.776	0.746	0.720	0.701	0.685	0.671	0.672	0.713	0.788	0.831	0.873	0.918	0.962	0.982	0.995	1.015
DFC RAIL LEVEL (RL)	270.955	270.955	270.960	270.955	270.970	270.982	270.995	271.008	271.020	271.033	271.046	271.058	271.071	271.084	271.096	271.109	271.122	271.134	271.147	271.159
EXG.RAIL LEVEL OF NEAREST IR UP MAIN LINE(ERL)	270.174	270.174	270.168	270.177	270.194	270.237	270.275	270.306	270.335	270.362	270.373	270.345	270.283	270.253	270.223	270.191	270.159	270.153	270.152	270.126
EQUIVALENT CHAINAGE ON DFC TRACK	1171.407.3	1171.407.3	1171.427.3	1171.447.3	1171.467.3	1171.487.3	1171.507.3	1171.527.3	1171.547.3	1171.567.3	1171.587.3	1171.607.3	1171.627.3	1171.647.3	1171.667.3	1171.687.3	1171.707.3	1171.727.3	1171.747.3	1171.767.2
EXISTING IR CHAINAGE	282000.0	282000.0	282020.0	282040.0	282060.0	282080.0	282100.0	282120.0	282140.0	282160.0	282180.0	282200.0	282220.0	282240.0	282260.0	282280.0	282300.0	282320.0	282340.0	282360.0

L - SECTION

- NOTE:-
1. DFC WORKS ARE SHOWN IN RED.
 2. IR NEW WORKS ARE SHOWN IN VIOLET.
 3. ALL DIMENSIONS ARE SHOWN IN METRES.
 4. THIS DRAWING IS PREPARED BASED ON LATEST SURVEY DATA HELD ON APRIL-2022. GTS BENCH MARK OF 261.850M CONSIDERED ON TOP OF CANAL BRIDGE ABUTMENT AT DORAH VILLAGE ALONG THE NH1.
 5. DFC NEW CHAINAGE OF 1075.950M IS WITH REFERENCE TO THE IR KM OF 187.500KM END OF KM OF CP-303(SECTION P-3 PILKHANI END) AGAINST THE EXISTING DFC CHAINAGE. 116277.742M ISSUED VIDE LETTER NO. COM/DFCC/MB/SURVEY/2021-301-230116-011173.DT. 17.01.2023.
 6. BALLAST PROFILE HAS BEEN PROVIDED ACCORDING TO THE CLAUSE 1.11.3 OF STANDARD SCHEDULE OF DIMENSION(EASTERN CORRIDOR) & THE BALLAST CUSHION DIMENSION SHOWN IN 35CM ON GE-14 PARA 17. SPECIFICATIONS & RECOMMENDATIONS 2. TWO LAYER SYSTEM FIG.10.

- REFERENCE DRAWINGS :-
1. FOR KEY PLAN REFER DRAWING NO. 301-2/AL/0001
 2. FOR LEGEND AND ABBREVIATIONS REFER DRAWING NO. 301-2/AL/1000
 3. FOR TYPICAL SECTION OF BALLAST PROFILE (FL-RL) REFER DRG. NO. 301-2/TK/TFD/004 (TR. 1952)

0	02.09.2024	SUBMISSION OF AS-BUILT DRAWING	FOR APPROVAL
REV.	DATE	REVISION DETAILS	PURPOSE OF ISSUE

LEGEND:


SCALE

HOR - 1:1000

VER - 1:100

SHEET SIZE : A1

IR TRACK
DFCC TRACK
DFCC FUTURE PROPOSALS
STRUCTURE / BUILDING
DFCC TOE LINE
DFCC FORMATION
RETAINING WALL
ROAD
STREAM, DRAIN, NALA, CANAL.
FENCE
POWER LINES
TBM
ELECTRIC POLE/OHE MAST
IR RAILWAY BOUNDARY
DFCC BOUNDARY

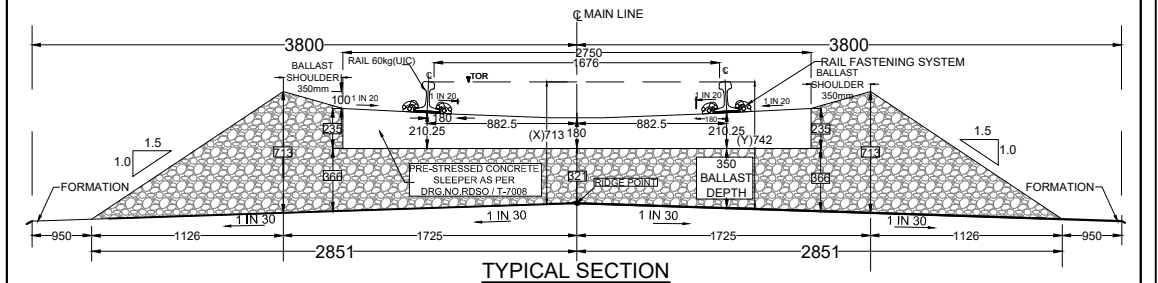

TRACK STRUCTURE		
RAIL SECTION: 60Kg/m (UIC 60Kg/m) DFC LINE: 60Kg/m (UIC 60Kg/m) IR MAIN LINE: 52Kg/m	Difference between FL- RL (Below Rail Seat)	
	IR Line	DFC
RUBBER PAD	172mm	172mm
SLEEPER DEPTH	6mm	10mm
BALLAST CUSHION	210mm	210mm
Total Depth (FL TO RL)	300mm	350mm
	688mm	742mm

OWNER

DEDICATED FREIGHT CORRIDOR CORPORATION OF INDIA LTD.

(A GOVERNMENT OF INDIA ENTERPRISE)

PROJECT OFFICE(AMBALA UNIT): OLD RAILWAY COLONY (NEAR ANAND MARKET),AMBALA CANTT-133001.

CORPORATE IDENTITY NO. : U60232DL2006GGI155068

ENGINEER:

DB Engineering & Consulting GmbH

Deutsche Bahn Engineering & Consulting GmbH

CONTRACTOR:

GIL - TPL JV

GAR TATA

SUBMITTED BY	GIL - TPL JV		
	DATED	NAME	SIGNATURE
PREPARED BY			
CHECKED BY	02.09.2024	VIJAY PRATAP	
APPROVED BY	02.09.2024	PARASURAM KOTYADA	

APPROVED BY	DEUTSCHE BAHN ENGINEERING & CONSULTING GMBH		
	DATED	NAME	SIGNATURE
Sr. DE./CHIEF ENGINEER		SURESH K.YALANGI	
CHIEF TRACK ENGINEER		RAJ PAL SINGH	
T.L.		H.D. VIDJAK	

STAMP

A AS-BUILT DRAWING

TR. Ref.:.....

ENGINEER Sign.:.....

EMPLOYER (DFCCIL):	DEDICATED FREIGHT CORRIDOR CORPORATION OF INDIA LTD.		

AS BUILT DRAWING

TITLE

AS-BUILT PLAN AND PROFILE

FROM IR KM: 282.000 TO 282.500

DFC KM: 1171.407 TO 1171.907

DFCC APPR. NO. -

ENGG. APPR. NO. -

DRG. NO. - 301-2/AL/A/1190

SHEET NO. : 1 OF 1

DATE : 02.09.2024

STATUS

A