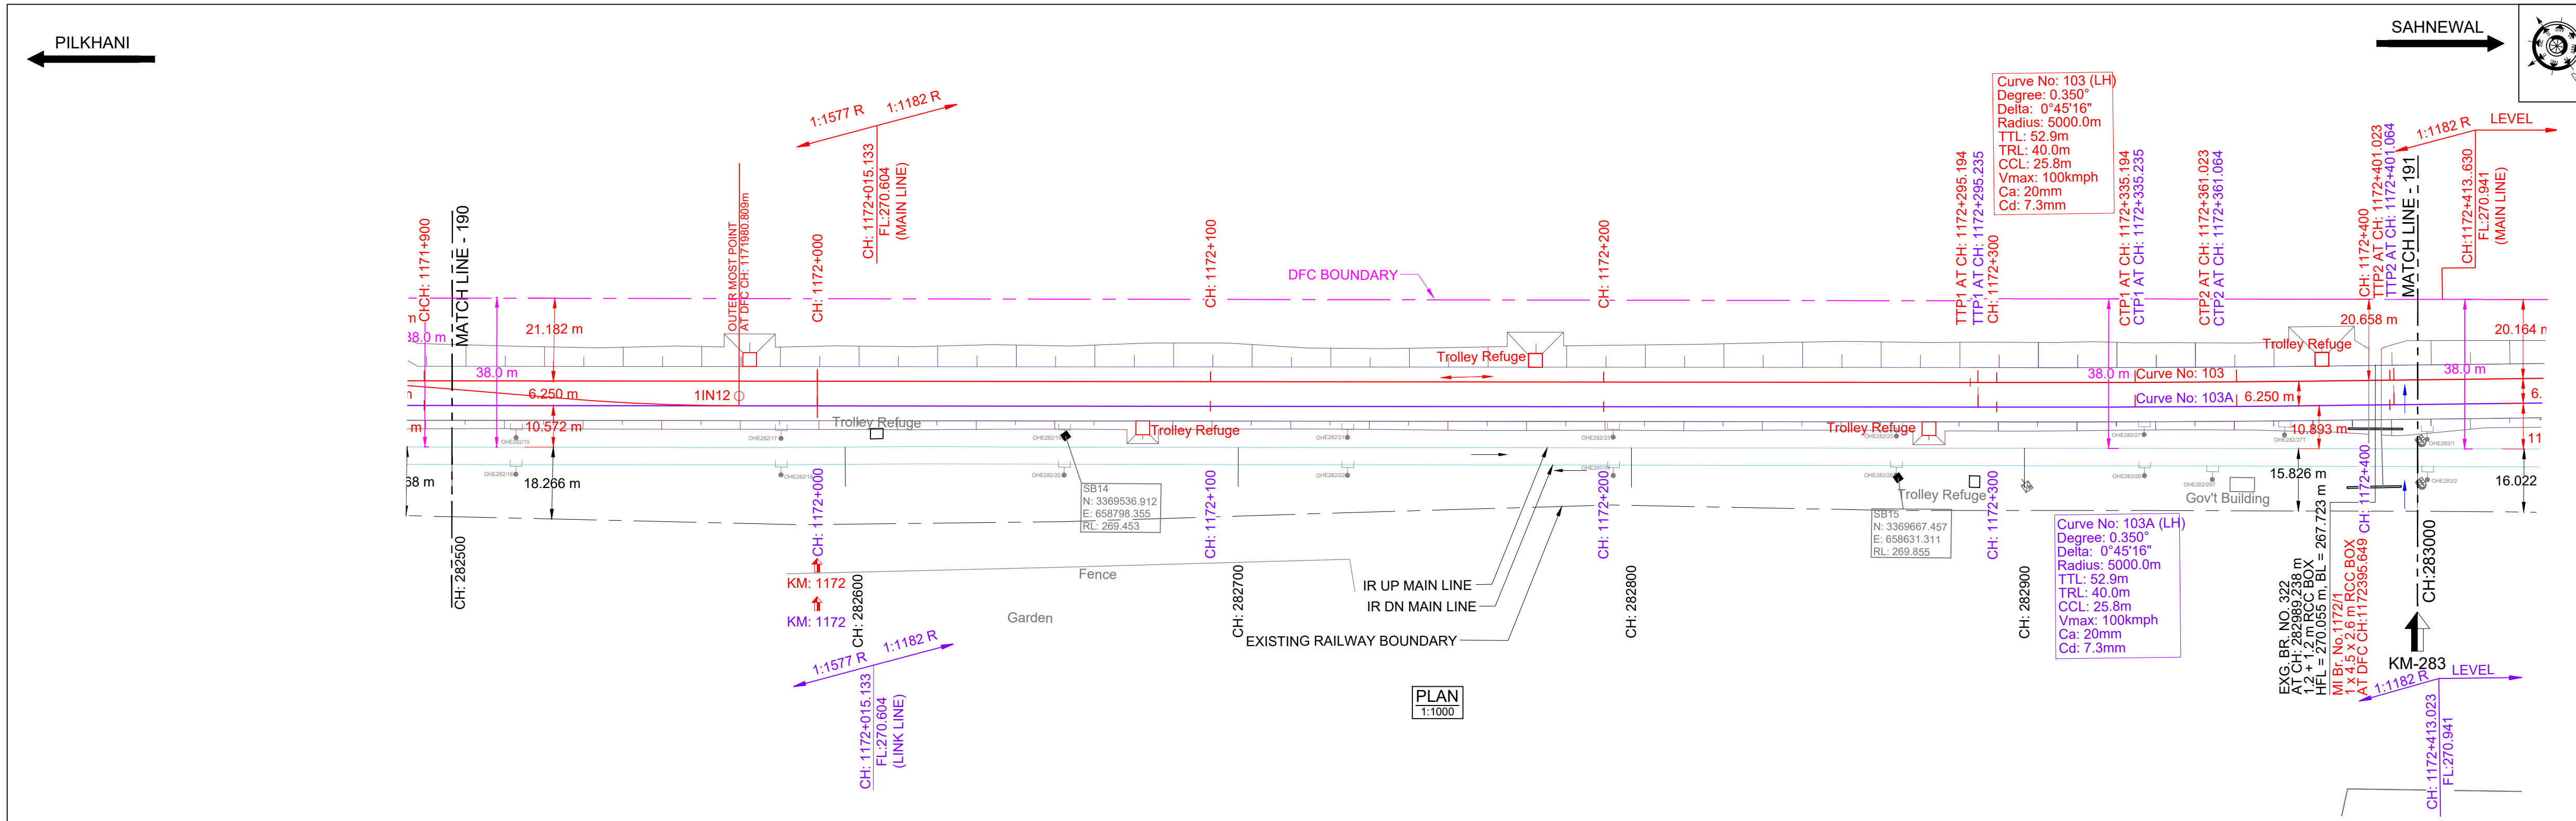


HORIZONTAL ALIGNMENT	L=2649.978m TL=40m R=5000m TL=40m L=166.547m																			
VERTICAL ALIGNMENT	L=527.300m 1 IN 1577.233 R L=20.0m R=94495.76 L=378.500m 1 IN 1182.493 R																			
TRACK DISTANCE FROM EXISTING IR UP MAIN LINE TO DFC MAIN LINE	16.814	16.822	16.818	16.829	16.847	16.720	16.581	16.630	16.672	16.675	16.688	16.708	16.707	16.698	16.712	16.723	16.723	16.727	16.753	17.540
HEIGHT OF BANKING(+) / DEPTH OF CUTTING(-) (FL-GL)	+3.220	+2.737	+2.770	+3.860	+3.475	+3.624	+3.843	+3.750	+3.840	+3.934	+3.840	+3.485	+3.414	+3.513	+3.545	+3.504	+3.932	+3.649	+3.881	+3.850
EXG GROUND LEVEL AT CENTER LINE OF DFC TRACK (GL)	267.316	267.811	267.791	266.714	267.111	266.975	266.772	266.881	266.789	266.731	266.585	266.214	267.302	267.220	267.205	267.828	267.669	267.151	267.132	267.086
EXG GROUND LEVEL AT TOE LOCATION OF DFC TRACK	267.605	267.866	268.021	267.845	268.007	267.816	267.887	267.712	267.813	267.487	267.585	268.162	267.222	268.063	267.909	267.828	267.702	267.490	267.643	267.734
DIFFERENCE BETWEEN DFC FORMATION LEVEL AND EXG FORMATION LEVEL (FL-EFL)	1.156	1.163	1.182	1.195	1.205	1.288	1.376	1.363	1.349	1.337	1.325	1.312	1.305	1.299	1.304	1.302	1.282	1.276	1.299	1.226
DFC FORMATION LEVEL (FL)	270.536	270.548	270.561	270.574	270.586	270.599	270.614	270.631	270.648	270.665	270.682	270.699	270.716	270.733	270.750	270.766	270.783	270.800	270.885	270.936
EXG. FORMATION LEVEL OF EXG IR UP MAIN LINE (EFL)	269.379	269.386	269.379	269.379	269.381	269.311	269.238	269.268	269.299	269.328	269.357	269.387	269.411	269.434	269.446	269.465	269.502	269.524	269.558	269.710
DIFFERENCE BETWEEN DFC RAIL LEVEL AND EXG. RAIL LEVEL (RL - ERL)	1.197	1.204	1.223	1.236	1.246	1.329	1.417	1.404	1.390	1.378	1.366	1.353	1.346	1.340	1.345	1.343	1.323	1.317	1.334	1.267
DFC RAIL LEVEL (RL)	271.249	271.261	271.274	271.287	271.299	271.312	271.327	271.344	271.361	271.378	271.395	271.412	271.429	271.446	271.463	271.479	271.496	271.513	271.564	271.632
EXG. RAIL LEVEL OF NEAREST IR UP MAIN LINE (ERL)	270.051	270.058	270.051	270.051	270.053	269.983	269.910	269.940	269.971	270.000	270.029	270.059	270.083	270.106	270.118	270.137	270.174	270.196	270.230	270.324
EQUIVALENT CHAINAGE ON DFC TRACK	1171907.3	1171927.3	1171947.3	1171967.3	1171987.3	1172007.2	1172027.3	1172047.3	1172067.3	1172087.3	1172107.3	1172127.3	1172147.3	1172167.3	1172187.3	1172207.3	1172227.3	1172247.3	1172267.3	1172287.3
EXISTING IR CHAINAGE	282500.0	282520.0	282540.0	282560.0	282580.0	282600.0	282620.0	282640.0	282660.0	282680.0	282700.0	282720.0	282740.0	282760.0	282780.0	282800.0	282820.0	282840.0	282860.0	282880.0

NOTE:-

- DFCC WORKS ARE SHOWN IN RED.
- IR NEW WORKS ARE SHOWN IN VIOLET.
- ALL DIMENSIONS ARE SHOWN IN METRES.
- THIS DRAWING IS PREPARED BASED ON LATEST SURVEY DATA HELD ON APRIL-2022. GTS BENCH MARK OF 261.850M CONSIDERED ON TOP OF CANAL BRIDGE ABUTMENT AT DORANA VILLAGE ALONG THE NH1.
- DFC NEW CHAINAGE OF 1075.950M IS WITH REFERENCE TO THE IR KM OF 187.500KM END OF KM OF CP-303(SECTION P-3 PILKHANI END) AGAINST THE EXISTING DFC CHAINAGE. 116277.742M ISSUED VIDE LETTER NO. COM/DFCC/CH/MS/SURVEY/2021-301-2301/16-01/173 DT. 17.01.2023.
- BALLAST PROFILE HAS BEEN PROVIDED ACCORDING TO THE CLAUSE 1.11.3 OF STANDARD SCHEDULE OF DIMENSION (EASTERN CORRIDOR) & THE BALLAST CUSHION DIMENSION SHOWN IN 35CM ON GE-14 PARA 17. SPECIFICATIONS & RECOMMENDATIONS 2. TWO LAYER SYSTEM FIG. 10.

REFERENCE DRAWINGS:-

- FOR KEY PLAN REFER DRAWING NO. 301-2/AL/0001
- FOR LEGEND AND ABBREVIATIONS REFER DRAWING NO. 301-2/AL/1000
- FOR TYPICAL SECTION OF BALLAST PROFILE (FL-RL) REFER DRG. NO. 301-2/TK/TFD/004 (TR. 1952)

DRG NO. - 301-2/AL/A/1191

0	02.09.2024	SUBMISSION OF AS-BUILT DRAWING	FOR APPROVAL
REV.	DATE	REVISION DETAILS	PURPOSE OF ISSUE

LEGEND:

IR TRACK
DFCC TRACK
DFCC FUTURE PROPOSALS
STRUCTURE / BUILDING
DFCC TOE LINE
DFCC FORMATION
RETAINING WALL
ROAD
STREAM, DRAIN, NALA, CANAL.
FENCE
POWER LINES
TBM
ELECTRIC POLE/OHE MAST
IR RAILWAY BOUNDARY
DFCC BOUNDARY

SCALE
HOR - 1:1000
VER - 1:100
SHEET SIZE : A1

TYPICAL SECTION

TRACK STRUCTURE	
RAIL SECTION: 60Kg/m (UIC 60Kg/m) DFC LINE: 60Kg/m (UIC 60Kg/m) IR MAIN LINE: 52Kg/m	Difference between FL- RL (Below Rail Seat)
	IR Line DFC
RUBBER PAD	172mm 172mm
SLEEPER DEPTH	6mm 10mm
BALLAST CUSHION	210mm 210mm
Total Depth (FL TO RL)	300mm 350mm
	688mm 742mm

OWNER
DEDICATED FREIGHT CORRIDOR CORPORATION OF INDIA LTD.
(A GOVERNMENT OF INDIA ENTERPRISE)
PROJECT OFFICE (AMBALA UNIT): OLD RAILWAY COLONY (NEAR ANAND MARKET), AMBALA CANTT-133001.
CORPORATE IDENTITY NO. : U60232DL2006GGI155068

ENGINEER:
DB Engineering & Consulting GmbH
Deutsche Bahn Engineering & Consulting GmbH

CONTRACTOR:
GIL - TPL JV
GAR TATA

SUBMITTED BY	GIL - TPL JV		
	DATED	NAME	SIGNATURE
PREPARED BY			
CHECKED BY	02.09.2024	VIJAY PRATAP	
APPROVED BY	02.09.2024	PARASURAM KOTYADA	
APPROVED BY	DEUTSCHE BAHN ENGINEERING & CONSULTING GMBH		
	DATED	NAME	SIGNATURE
Sr. DE./CHIEF ENGINEER		SURESH K.YALANGI	
CHIEF TRACK ENGINEER		RAJ PAL SINGH	
T.L.		H.D. VIDJAK	

STAMP
A AS-BUILT DRAWING TR. Ref.: ENGINEER Sign.:

EMPLOYER (DFCCIL): DEDICATED FREIGHT CORRIDOR CORPORATION OF INDIA LTD.

AS BUILT DRAWING	
TITLE AS-BUILT PLAN AND PROFILE FROM IR KM: 282.500 TO 283.000 DFC KM: 1171.907 TO 1172.407	DFCC APPR. NO. - ENGG. APPR. NO. - DRG. NO. - 301-2/AL/A/1191 SHEET NO. : 1 OF 1 DATE : 02.09.2024
	STATUS A

TR.5126-R0