




DEDICATED FREIGHT CORRIDOR CORPORATION OF INDIA LTD.
(A GOVERNMENT OF INDIA ENTERPRISE)

EASTERN DEDICATED FREIGHT CORRIDOR
SAHNEWAL TO PILKHANI SECTION
CONTRACT PACKAGE - 301

PLAN & PROFILE OF AS BUILT DRAWINGS OF DFC LINK LINE

IR CHAINAGE FROM KM 282.353 TO KM 289.037
DFCC CHAINAGE FROM KM 1171.661 TO KM 1178.448 (LINKED LINE)

DESIGN CONSULTANT


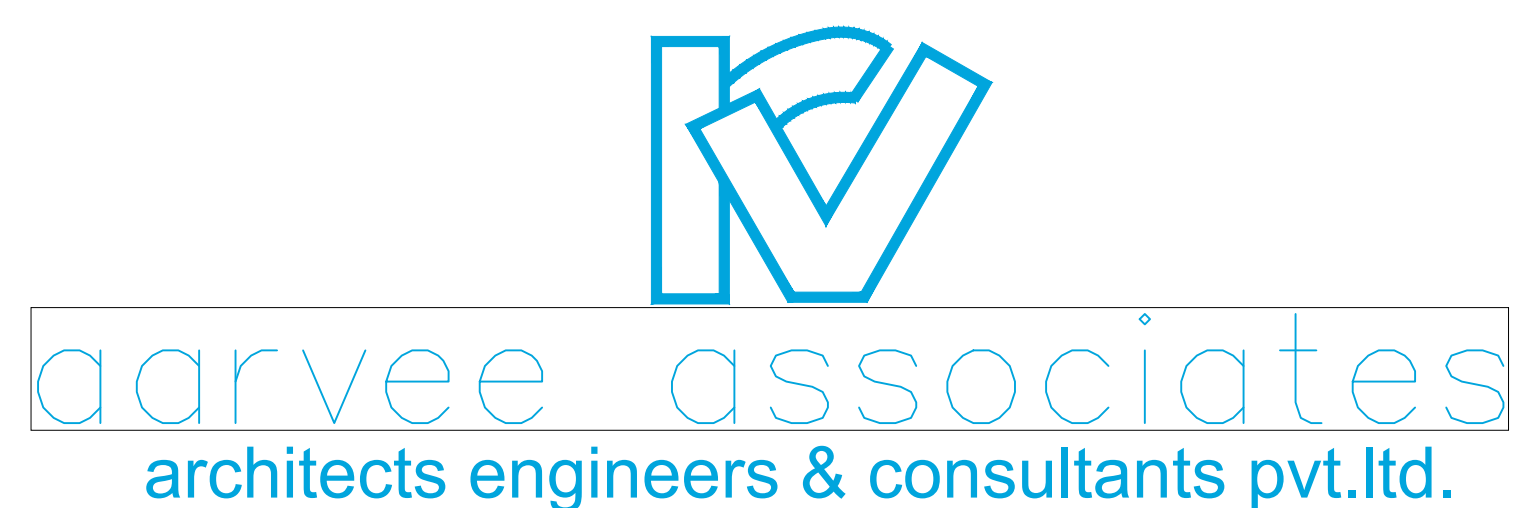


ENGINEER



CONTRACTOR CLIENT
GIL - TPL JV



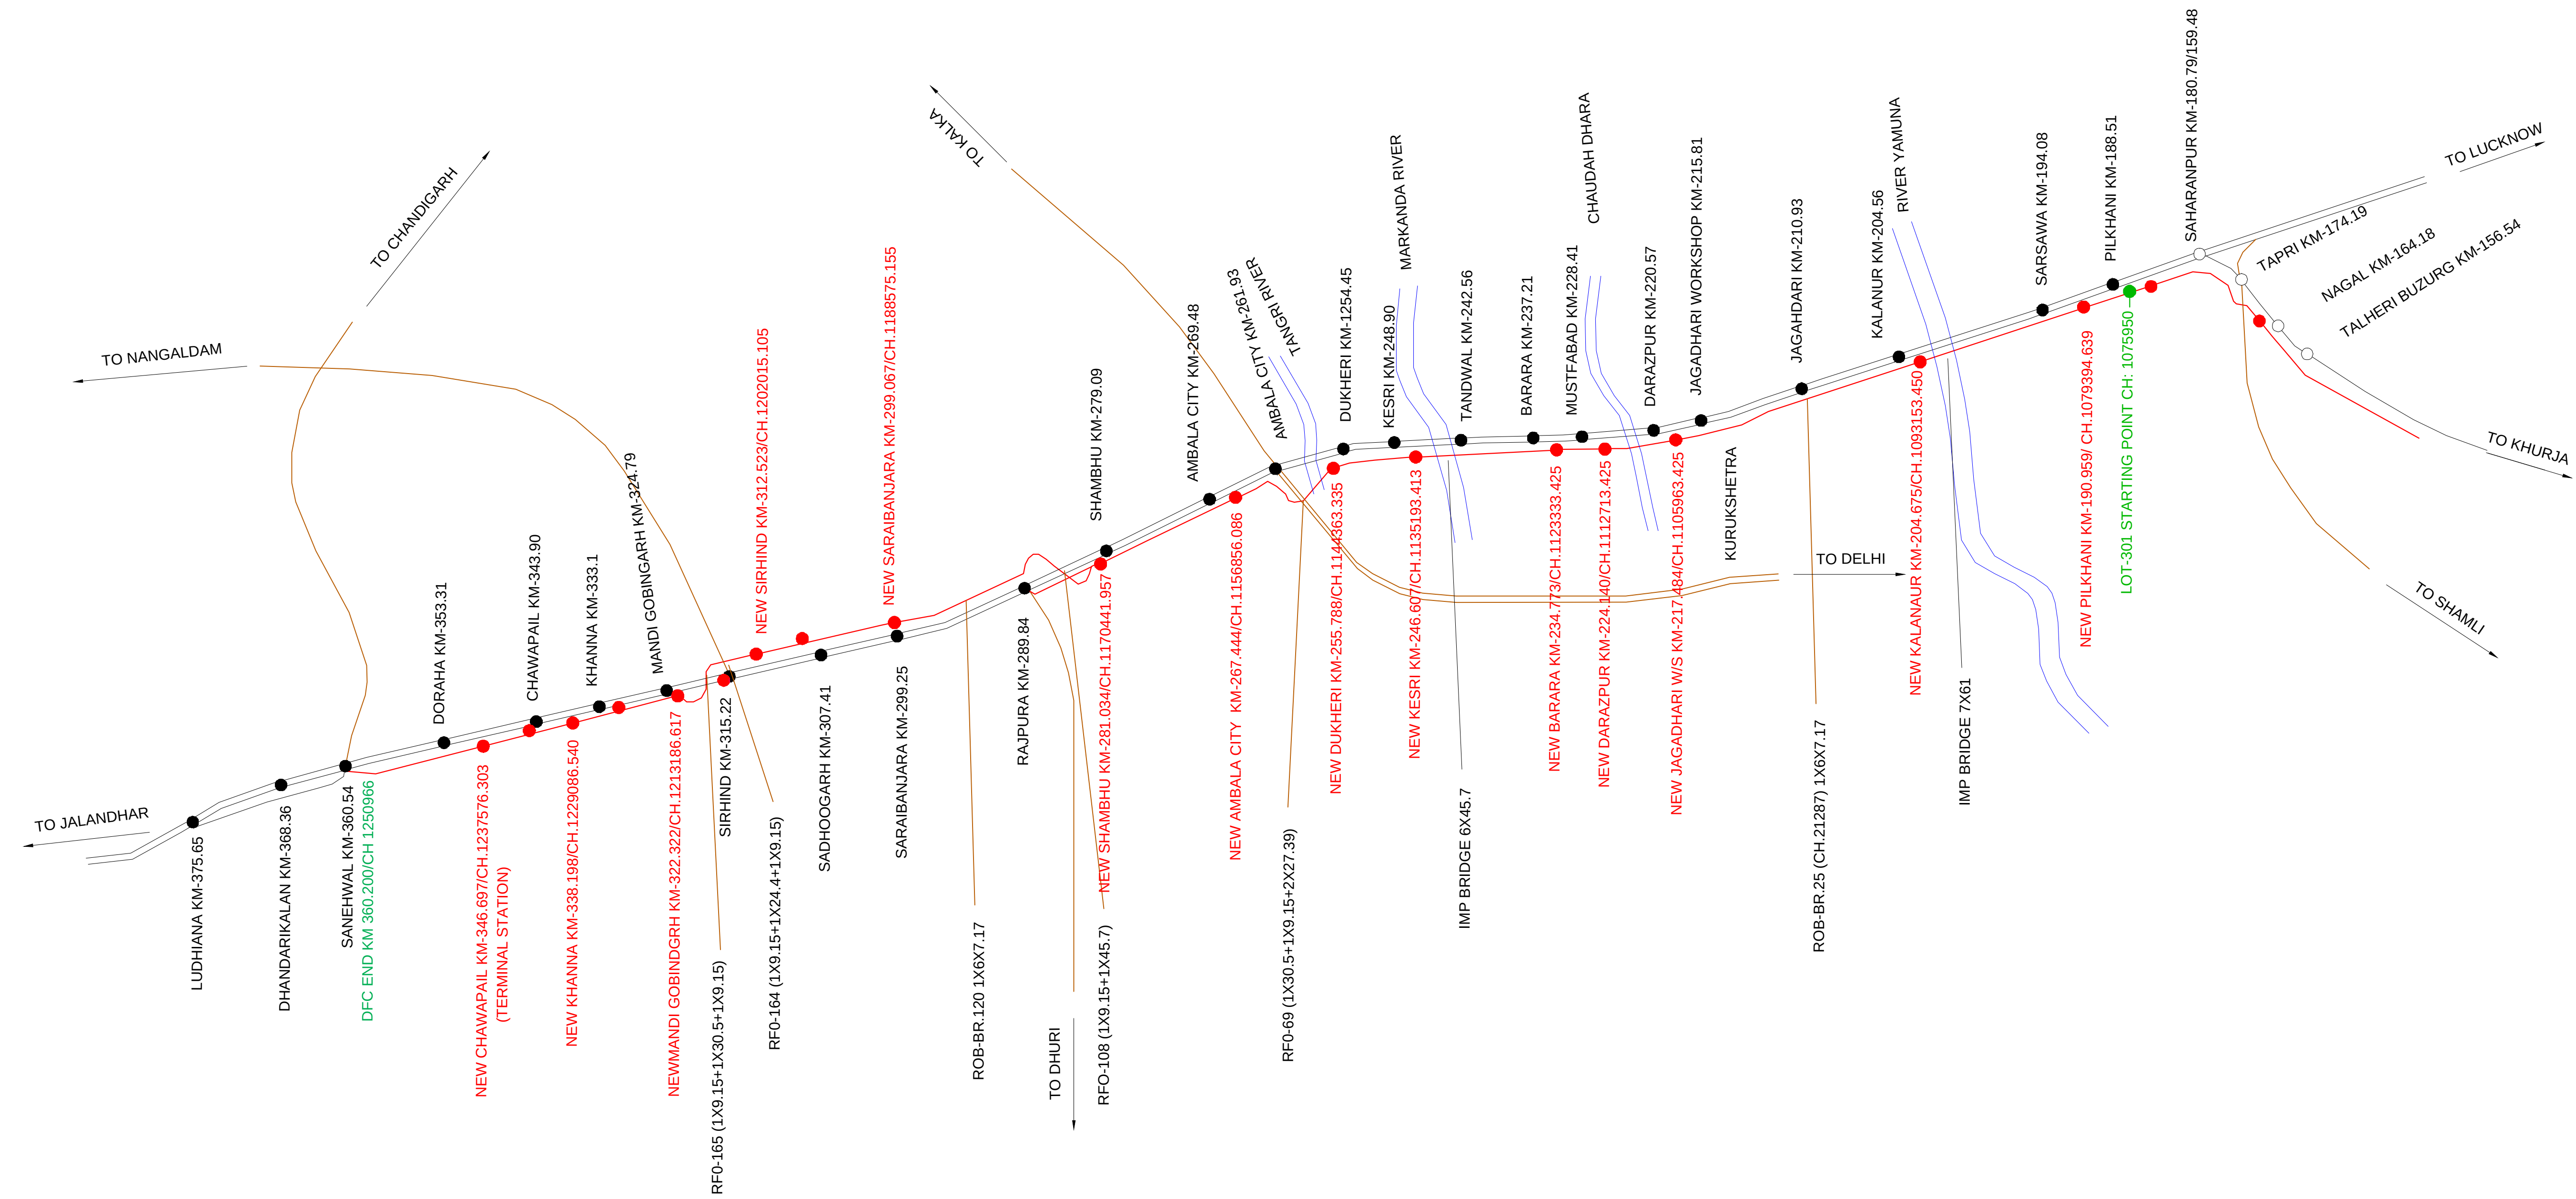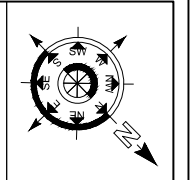


				SCALE	DESIGN CONSULTANT	CONTRACTOR	ENGINEER	OWNER	PROJECT	TITLE	DFCC APPR. NO. -			
				NOT TO SCALE	 aarvee associates architects engineers & consultants Pvt.Ltd.	 GIL - TPL JV	 DB Engineering & Consulting GmbH	 महामार्ग विकास निगम	DEDICATED FREIGHT CORRIDOR CORPORATION OF INDIA LTD. (A GOVERNMENT OF INDIA ENTERPRISE) PROJECT OFFICE(AMBALA UNIT) : OLD RAILWAY COLONY (NEAR ANAND MARKET),AMBALA CANTT-133001. CORPORATE IDENTITY NO. : U60232DL2006GOI155068	EASTERN DEDICATED FREIGHT CORRIDOR SAHNEWAL TO PILKHANI CONTRACT PACKAGE - 301	ALIGNMENT DRAWINGS KEY PLAN	ENGG. APPR. NO. -		
												DRG. NO. :- 301-2/AL/0001		
												SHEET NO. : 1 OF 1		
REV.	DATE	REVISION DETAILS		PURPOSE OF ISSUE								DATE: 15-06-2024	REV. NO. 0	STATUS A

LEGEND	
EXISTING IR TRACK	
DFC TRACK	
DFC FUTURE PROPOSALS	
IR PROPOSALS	
TOE LINE	
FORMATION CESS	
RETAINING WALL	
DRAIN CUM RETAINING WALL	
ROAD	
STREAM, DRAIN, NALA, CANAL.	
FENCE	
POWER LINES	
GPS POINTS	
ELECTRIC POLE/OHE MAST	
EXISTING RAILWAY BOUNDARY	
DFC BOUNDARY	
DISMANTLED WORKS	
IOCL PIPE LINE	
IOCL ROW	
SIGNALLING CABLE PIPE	

ABBREVIATIONS		
1.	BL	- BED LEVEL
2.	BVC	- BEGIN OF VERTICAL CURVE
3.	Ca	- APPLIED CANT
4.	CCL	- CIRCULAR CURVE LENGTH
5.	CTP1	- COMMON TANGENT POINT
6.	CTP2	- COMMON TANGENT POINT
7.	DEGREE	- DEGREE OF CURVE
8.	DE	- DEAD END
9.	ECL	- EXISTING CLEARANCE
10.	EFB	- EXISTING FREE BOARD
11.	EFL	- EXISTING FORMATION LEVEL
12.	ERL	- EXISTING RAIL LEVEL
13.	ESL	- EXISTING SOFFIT LEVEL
14.	EVC	- END OF VERTICAL CURVE
15.	EVCL	- EXISTING VERTICAL CLEARANCE
16.	F/CSB	- FROM CENTER LINE OF STN BLDG
17.	FM	- FOULING MARK
18.	FSL	- FULL SUPPLY LEVEL
19.	HFL	- HIGH FLOOD LEVEL
20.	L	- STRAIGHT LENGTH
21.	LH	- LEFT HANDED
22.	LHS	- LIMITED HEIGHT SUBWAY
23.	PCL	- PROPOSED CLEARANCE
24.	PFB	- PROPOSED FREE BOARD
25.	PFL	- PROPOSED FORMATION LEVEL
26.	PRL	- PROPOSED RAIL LEVEL
27.	PSL	- PROPOSED SOFFIT LEVEL
28.	PVCL	- PROPOSED VERTICAL CLEARANCE
29.	PVI	- POINT OF VERTICAL INTERSECTION
30.	R	- RADIUS
31.	REV.BL	- REVISED BED LEVEL
32.	RH	- RIGHT HANDED
33.	Rr	- RESULTANT RADIUS
34.	SE	- SUPER ELEVATION
35.	SRJ	- STOCK RAIL JOINT
36.	TS	- TRAP SWITCH
37.	TTL	- TOTAL TANGENT LENGTH
38.	TTP1	- TRANSITION TANGENT POINT
39.	TTP2	- TRANSITION TANGENT POINT
40.	TL	- TRANSITION LENGTH
41.	DELTA	- DEFLECTION ANGLE

					SCALE	DESIGN CONSULTANT	CONTRACTOR	ENGINEER	OWNER	PROJECT	TITLE	DFCC APPR. NO. -			
					NOT TO SCALE	 aarvee associates architects engineers & consultants pvt.ltd.	  GIL - TPL JV	 DB Engineering & Consulting GmbH	 मेडीकेटर फ्रेट कॉर्पोरेश	DEDICATED FREIGHT CORRIDOR CORPORATION OF INDIA LTD. (A GOVERNMENT OF INDIA ENTERPRISE) PROJECT OFFICE(AMBALA UNIT): OLD RAILWAY COLONY (NEAR ANAND MARKET),AMBALA CANTT-133001. CORPORATE IDENTITY NO. : U60232DL2006GOI155068	EASTERN DEDICATED FREIGHT CORRIDOR SAHNEWAL TO PILKHANI CONTRACT PACKAGE - 301	ALIGNMENT DRAWINGS LEGEND AND ABBREVIATIONS	ENG. APPR. NO. -		
															DRG. NO. - 301-2/AL/1000
															SHEET NO. : 1 OF 1
REV.	DATE		REVISION DETAILS	PURPOSE OF ISSUE								DATE : 15-06-2024	0	A	

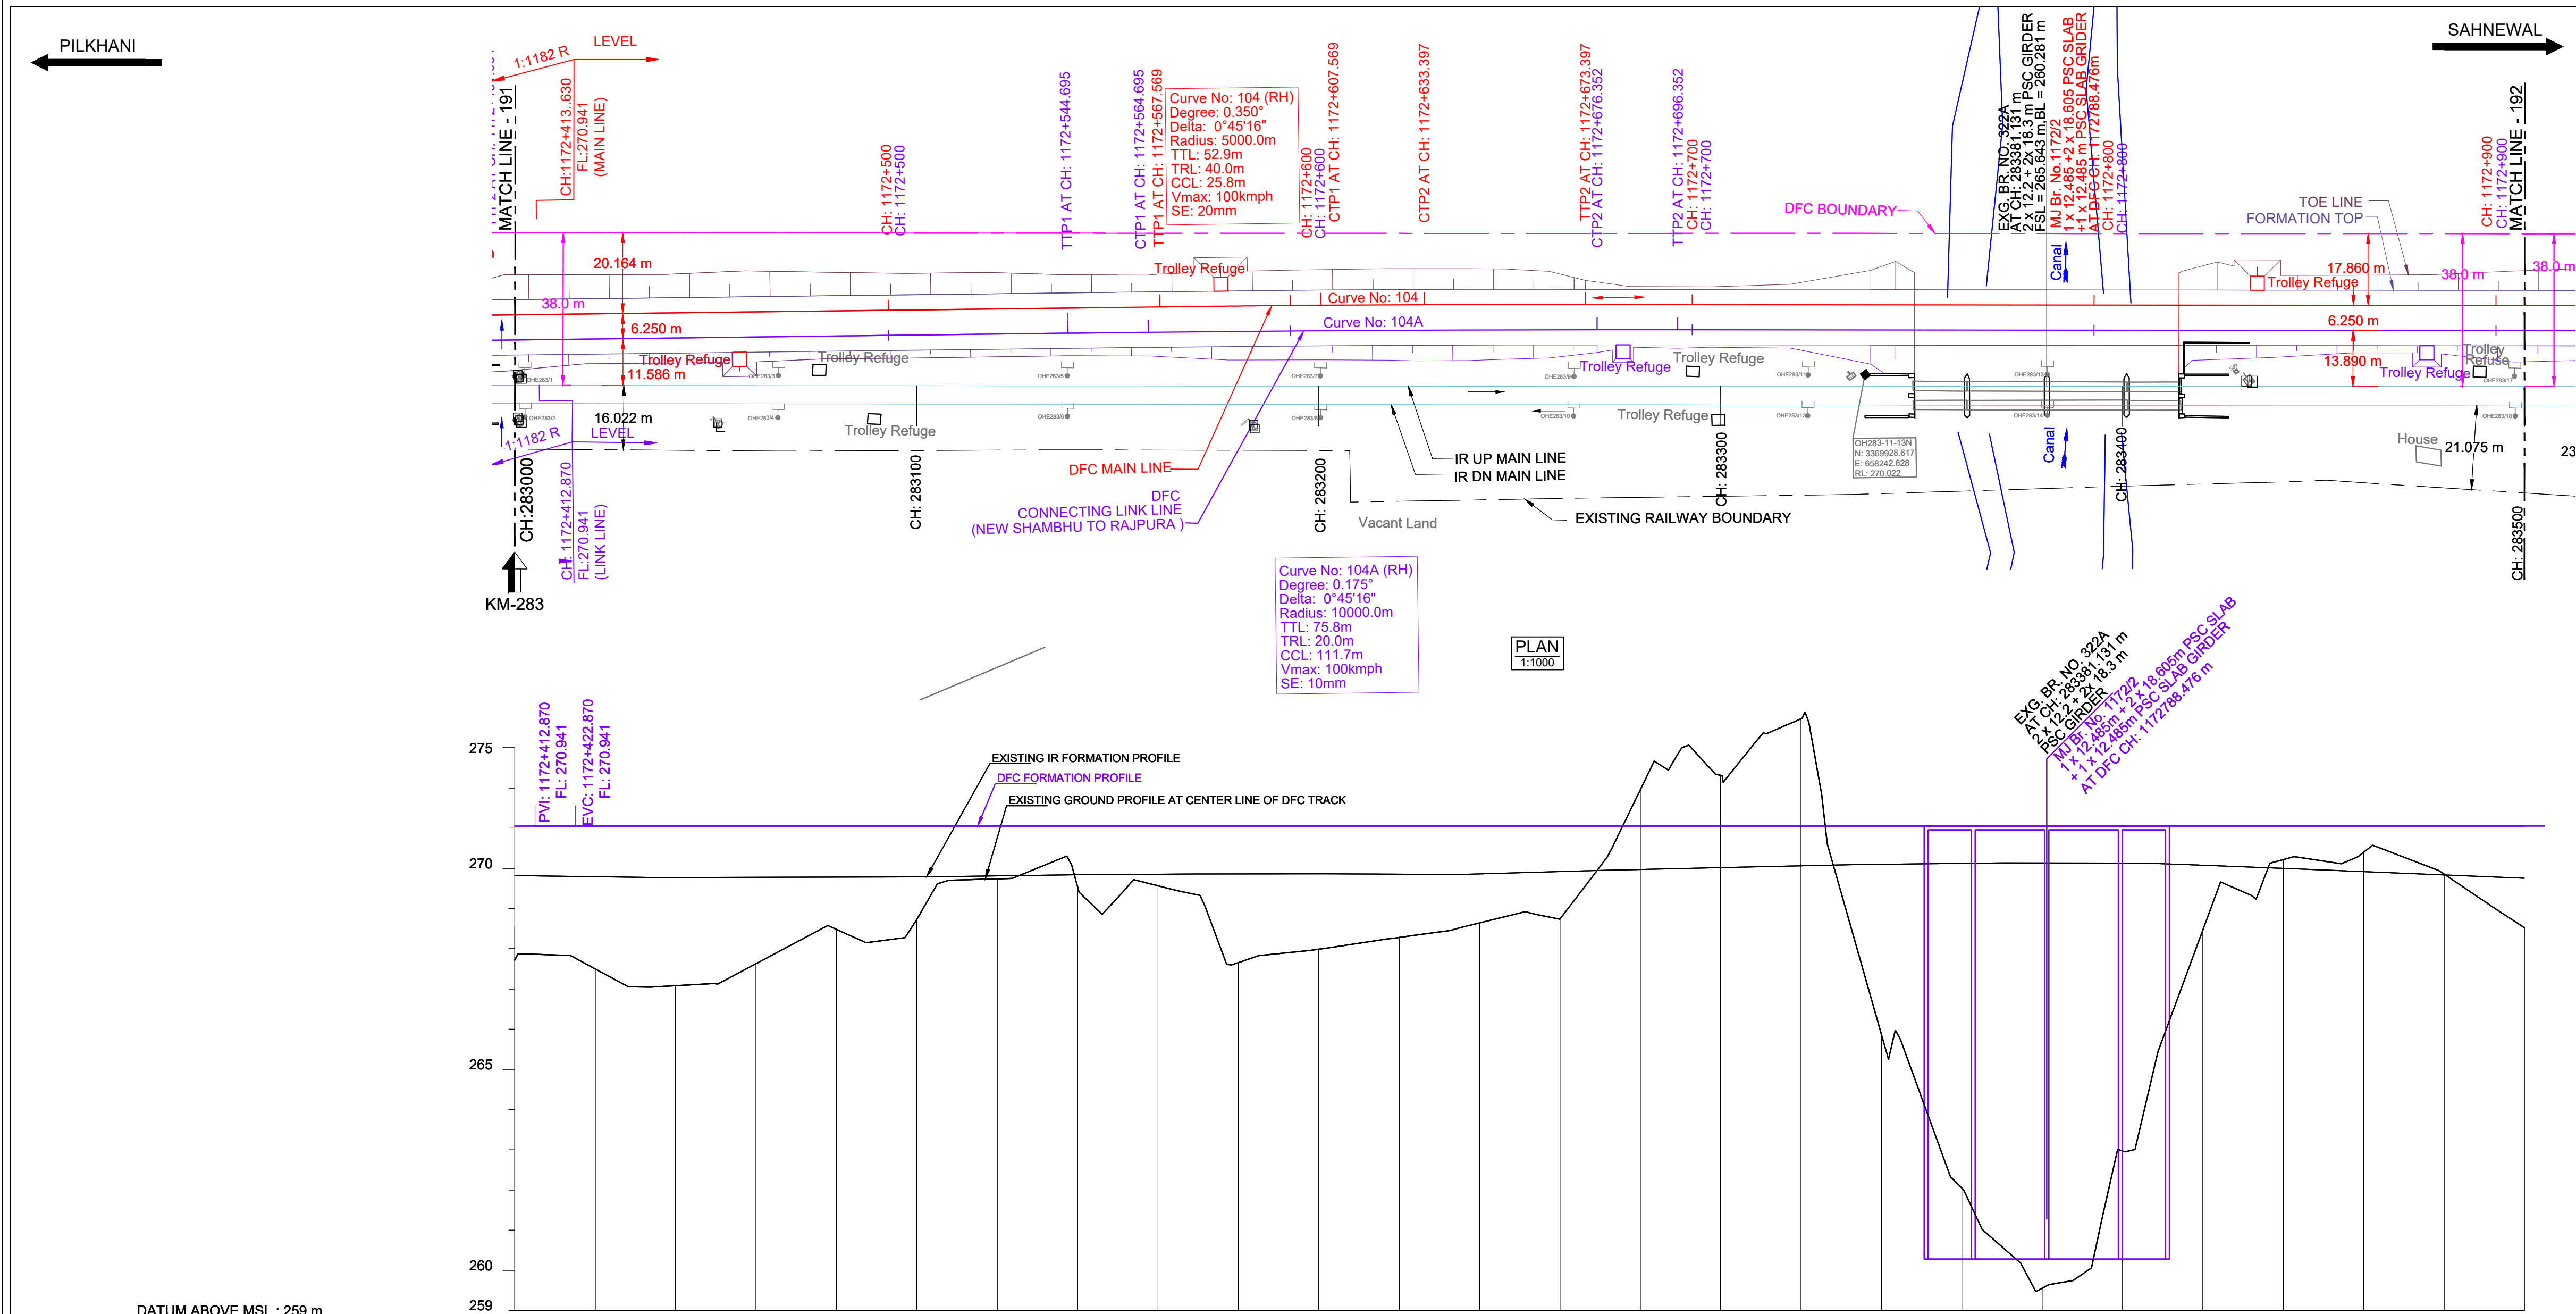

DATUM ABOVE MSL : 259 m

HORIZONTAL ALIGNMENT	L = 143.631m TL= 20m R =10000m TL= 20m L = 234.666m																											
VERTICAL ALIGNMENT	L=20.0 m R=23650 m L=620.095 m LEVEL																											
TRACK DISTANCE FROM EXISTING NEAREST IR UP MAIN LINE TO DFC LINKED LINE	-11.289	-11.289	-11.566	-11.841	-12.111	-12.370	-12.620	-12.880	-13.140	-13.394	-13.602	-13.762	-13.896	-13.986	-14.021	-14.014	-13.985	-13.963	-13.950	-13.956	-13.951	-13.934	-13.926	-13.902	-13.891	-13.884	-13.877	
HEIGHT OF BANKING(+) / DEPTH OF CUTTING(-) (PFL-GL)	+3.335	+3.335	+3.557	+3.975	+3.429	+2.573	+2.329	+1.317	+1.505	+1.486	+3.400	+3.065	+2.774	+2.412	+2.319	-0.890	-1.260	-2.662	+5.177	-13.950	-13.956	-13.951	-13.934	-13.926	-13.891	-13.884	-13.877	
EXG GROUND LEVEL AT CENTER LINE OF DFC TRACK (GL)	267.376	267.601	267.384	267.417	266.932	267.512	268.529	268.612	269.043	269.624	268.753	269.436	268.008	267.876	268.984	268.622	271.754	271.631	267.451	266.764	262.136	261.941	259.098	259.440	262.351	262.866	267.050	266.342
EXG GROUND LEVEL AT TOE LOCATION OF DFC TRACK	267.376	267.601	267.384	267.417	266.932	267.512	268.529	268.612	269.043	269.624	268.753	269.436	268.008	267.876	268.984	268.622	271.754	271.631	267.451	266.764	262.136	261.941	259.098	259.440	262.351	262.866	267.050	266.342
DIFFERENCE BETWEEN DFC FORMATION LEVEL AND EXG.FORMATION LEVEL (PFL-EFL)	1.242	1.242	1.264	1.283	1.277	1.272	1.267	1.241	1.213	1.199	1.192	1.192	1.200	1.192	1.133	1.082	1.036	0.992	0.955	0.931	0.920	0.924	0.976	1.056	1.137	1.218	1.299	
DFC FORMATION LEVEL (PFL)	270.936	270.936	270.941	270.941	EXG. FORMATION LEVEL OF EXG IR UP MAIN LINE (EFL)	269.695	269.695	269.677	269.658	269.664	269.669	269.674	269.700	269.728	269.742	269.749	269.749	269.741	269.749	269.808	269.808	269.859	269.905	269.986	269.986	270.010	270.010	270.021	270.021	270.017	269.985	269.885	269.804
DIFFERENCE BETWEEN DFC RAIL LEVEL AND EXG. RAIL LEVEL (PRL - ERL)	1.267	1.267	1.289	1.308	1.302	1.297	1.292	1.266	1.238	1.224	1.217	1.217	1.225	1.217	1.158	1.107	1.081	1.017	0.980	0.956	0.945	0.949	1.001	1.081	1.162	1.243	1.324	
DFC RAIL LEVEL (PRL)	271.649	271.649	271.654	271.654	EXG.RAIL LEVEL OF NEAREST IR UP MAIN LINE(ERL)	270.383	270.383	270.365	270.346	270.352	270.357	270.362	270.388	270.416	270.430	270.437	270.437	270.429	270.437	270.496	270.547	270.547	270.593	270.637	270.674	270.674	270.698	270.709	270.709	270.705	270.653	270.411	270.330
EQUIVALENT CHAINAGE ON DFC TRACK	1172407.3	1172407.3	1172427.3	1172447.3	1172467.3	1172487.3	1172507.3	1172527.3	1172547.3	1172567.3	1172587.3	1172607.3	1172627.3	1172647.3	1172667.3	1172687.3	1172687.3	1172707.3	1172727.3	1172747.3	1172767.3	1172787.3	1172807.3	1172827.3	1172847.3	1172867.3	1172887.3	1172907.3
EXISTING IR CHAINAGE	283000.0	283000.0	283020.0	283040.0	283060.0	283080.0	283100.0	283120.0	283140.0	283160.0	283180.0	283200.0	283220.0	283240.0	283260.0	283280.0	283300.0	283320.0	283340.0	283360.0	283380.0	283400.0	283420.0	283440.0	283460.0	283480.0	283500.0	283520.0

L - SECTION

- NOTE:-
- DFCC WORKS ARE SHOWN IN RED.
 - DFC LINK LINE WORKS ARE SHOWN IN VIOLET.
 - ALL DIMENSIONS ARE SHOWN IN METRES.
 - THIS DRAWING IS PREPARED BASED ON LATEST SURVEY DATA HELD ON APRIL-2022. GTS BENCH MARK OF 261.850M CONSIDERED ON TOP OF CANAL BRIDGE ABUTMENT AT DORANA VILLAGE ALONG THE NH1.
 - DFC NEW CHAINAGE OF 1075.950M IS WITH REFERENCE TO THE IR KM OF 187.500KM END OF KM OF CP-303(SECTION P-3 PILKHANI END) AGAINST THE EXISTING DFC CHAINAGE. 116277.742M ISSUED VIDE LETTER NO. GOM/DFCC/UM/SURVEY/2021-301-230116-011173.DT. 17.01.2023.
 - BALLAST PROFILE HAS BEEN PROVIDED ACCORDING TO THE CLAUSE 1.11.3 OF STANDARD SCHEDULE OF DIMENSION(EASTERN CORRIDOR) & THE BALLAST CUSHION DIMENSION SHOWN IN 35CM ON GE-14 PARA 17. SPECIFICATIONS & RECOMMENDATIONS 2. TWO LAYER SYSTEM FIG.10.

- REFERENCE DRAWINGS :-
- FOR KEY PLAN REFER DRAWING NO. 301-2/AL/0001
 - FOR LEGEND AND ABBREVIATIONS REFER DRAWING NO. 301-2/AL/1000
 - FOR TYPICAL SECTION OF BALLAST PROFILE (FL-RL) REFER DRG. NO. 301-2/TK/TFD/004 (TR.1952)

0	30.10.2024	SUBMISSION OF AS-BUILT DRAWING	FOR APPROVAL
REV.	DATE	REVISION DETAILS	PURPOSE OF ISSUE

LEGEND:


SCALE

HOR - 1:1000

VER - 1:100

SHEET SIZE : A1

IR TRACK
DFCC TRACK
LINK LINE (SMUN-RP-J)
DFCC FUTURE PROPOSALS
STRUCTURE / BUILDING
DFCC TOE LINE
DFCC FORMATION
RETAINING WALL
ROAD
STREAM, DRAIN, NALA, CANAL.
FENCE
POWER LINES
TBM
ELECTRIC POLE/OHE MAST
IR RAILWAY BOUNDARY
DFCC BOUNDARY

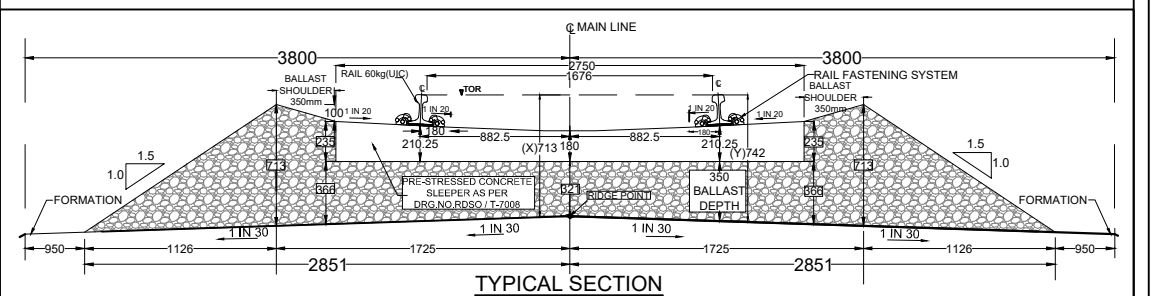

TRACK STRUCTURE		
RAIL SECTION: 60Kg/m (UIC 60Kg/m)	Difference between FL- RL (Below Rail Seat)	
DFC LINE: 60Kg/m (UIC 60Kg/m)	IR Line	DFC
IR MAIN LINE: 52Kg/m	172mm	172mm
RUBBER PAD	6mm	10mm
SLEEPER DEPTH	210mm	210mm
BALLAST CUSHION	300mm	350mm
Total Depth (FL TO RL)	688mm	742mm

OWNER

DEDICATED FREIGHT CORRIDOR CORPORATION OF INDIA LTD.

(A GOVERNMENT OF INDIA ENTERPRISE)

PROJECT OFFICE (AMBALA UNIT): OLD RAILWAY COLONY (NEAR ANAND MARKET), AMBALA CANTT-133001.

CORPORATE IDENTITY NO. : U60232DL2006GGI155068

ENGINEER:

DB Engineering & Consulting GmbH

Deutsche Bahn Engineering & Consulting GmbH

CONTRACTOR:

GIL - TPL JV

GAR TATA


SUBMITTED BY	GIL - TPL JV		
	DATED	NAME	SIGNATURE
PREPARED BY			
CHECKED BY	30.10.2024	VIJAY PRATAP	
APPROVED BY	30.10.2024	PARASURAM KOTYADA	

APPROVED BY	DEUTSCHE BAHN ENGINEERING & CONSULTING GMBH		
	DATED	NAME	SIGNATURE
Sr. DE./CHIEF ENGINEER		SURESH K.YALANGI	
CHIEF TRACK ENGINEER		RAJ PAL SINGH	
T.L.		H.D. VIDJAK	

STAMP	A AS-BUILT DRAWING TR. Ref.:..... ENGINEER Sign.:.....		
EMPLOYER (DFCCIL):	DEDICATED FREIGHT CORRIDOR CORPORATION OF INDIA LTD.		

AS BUILT DRAWING			
TITLE	AS-BUILT PLAN AND PROFILE DFC LINK LINE		
FROM IR KM: 283.000 TO 283.500	DFC KM: 1172.407 TO 1172.907		
DFCC APPR. NO. -	ENGG. APPR. NO. -		
DRG. NO. - 301-2/AL/A/1192A	SHEET NO. : 1 OF 1		
DATE : 30.10.2024	STATUS A		

TR.

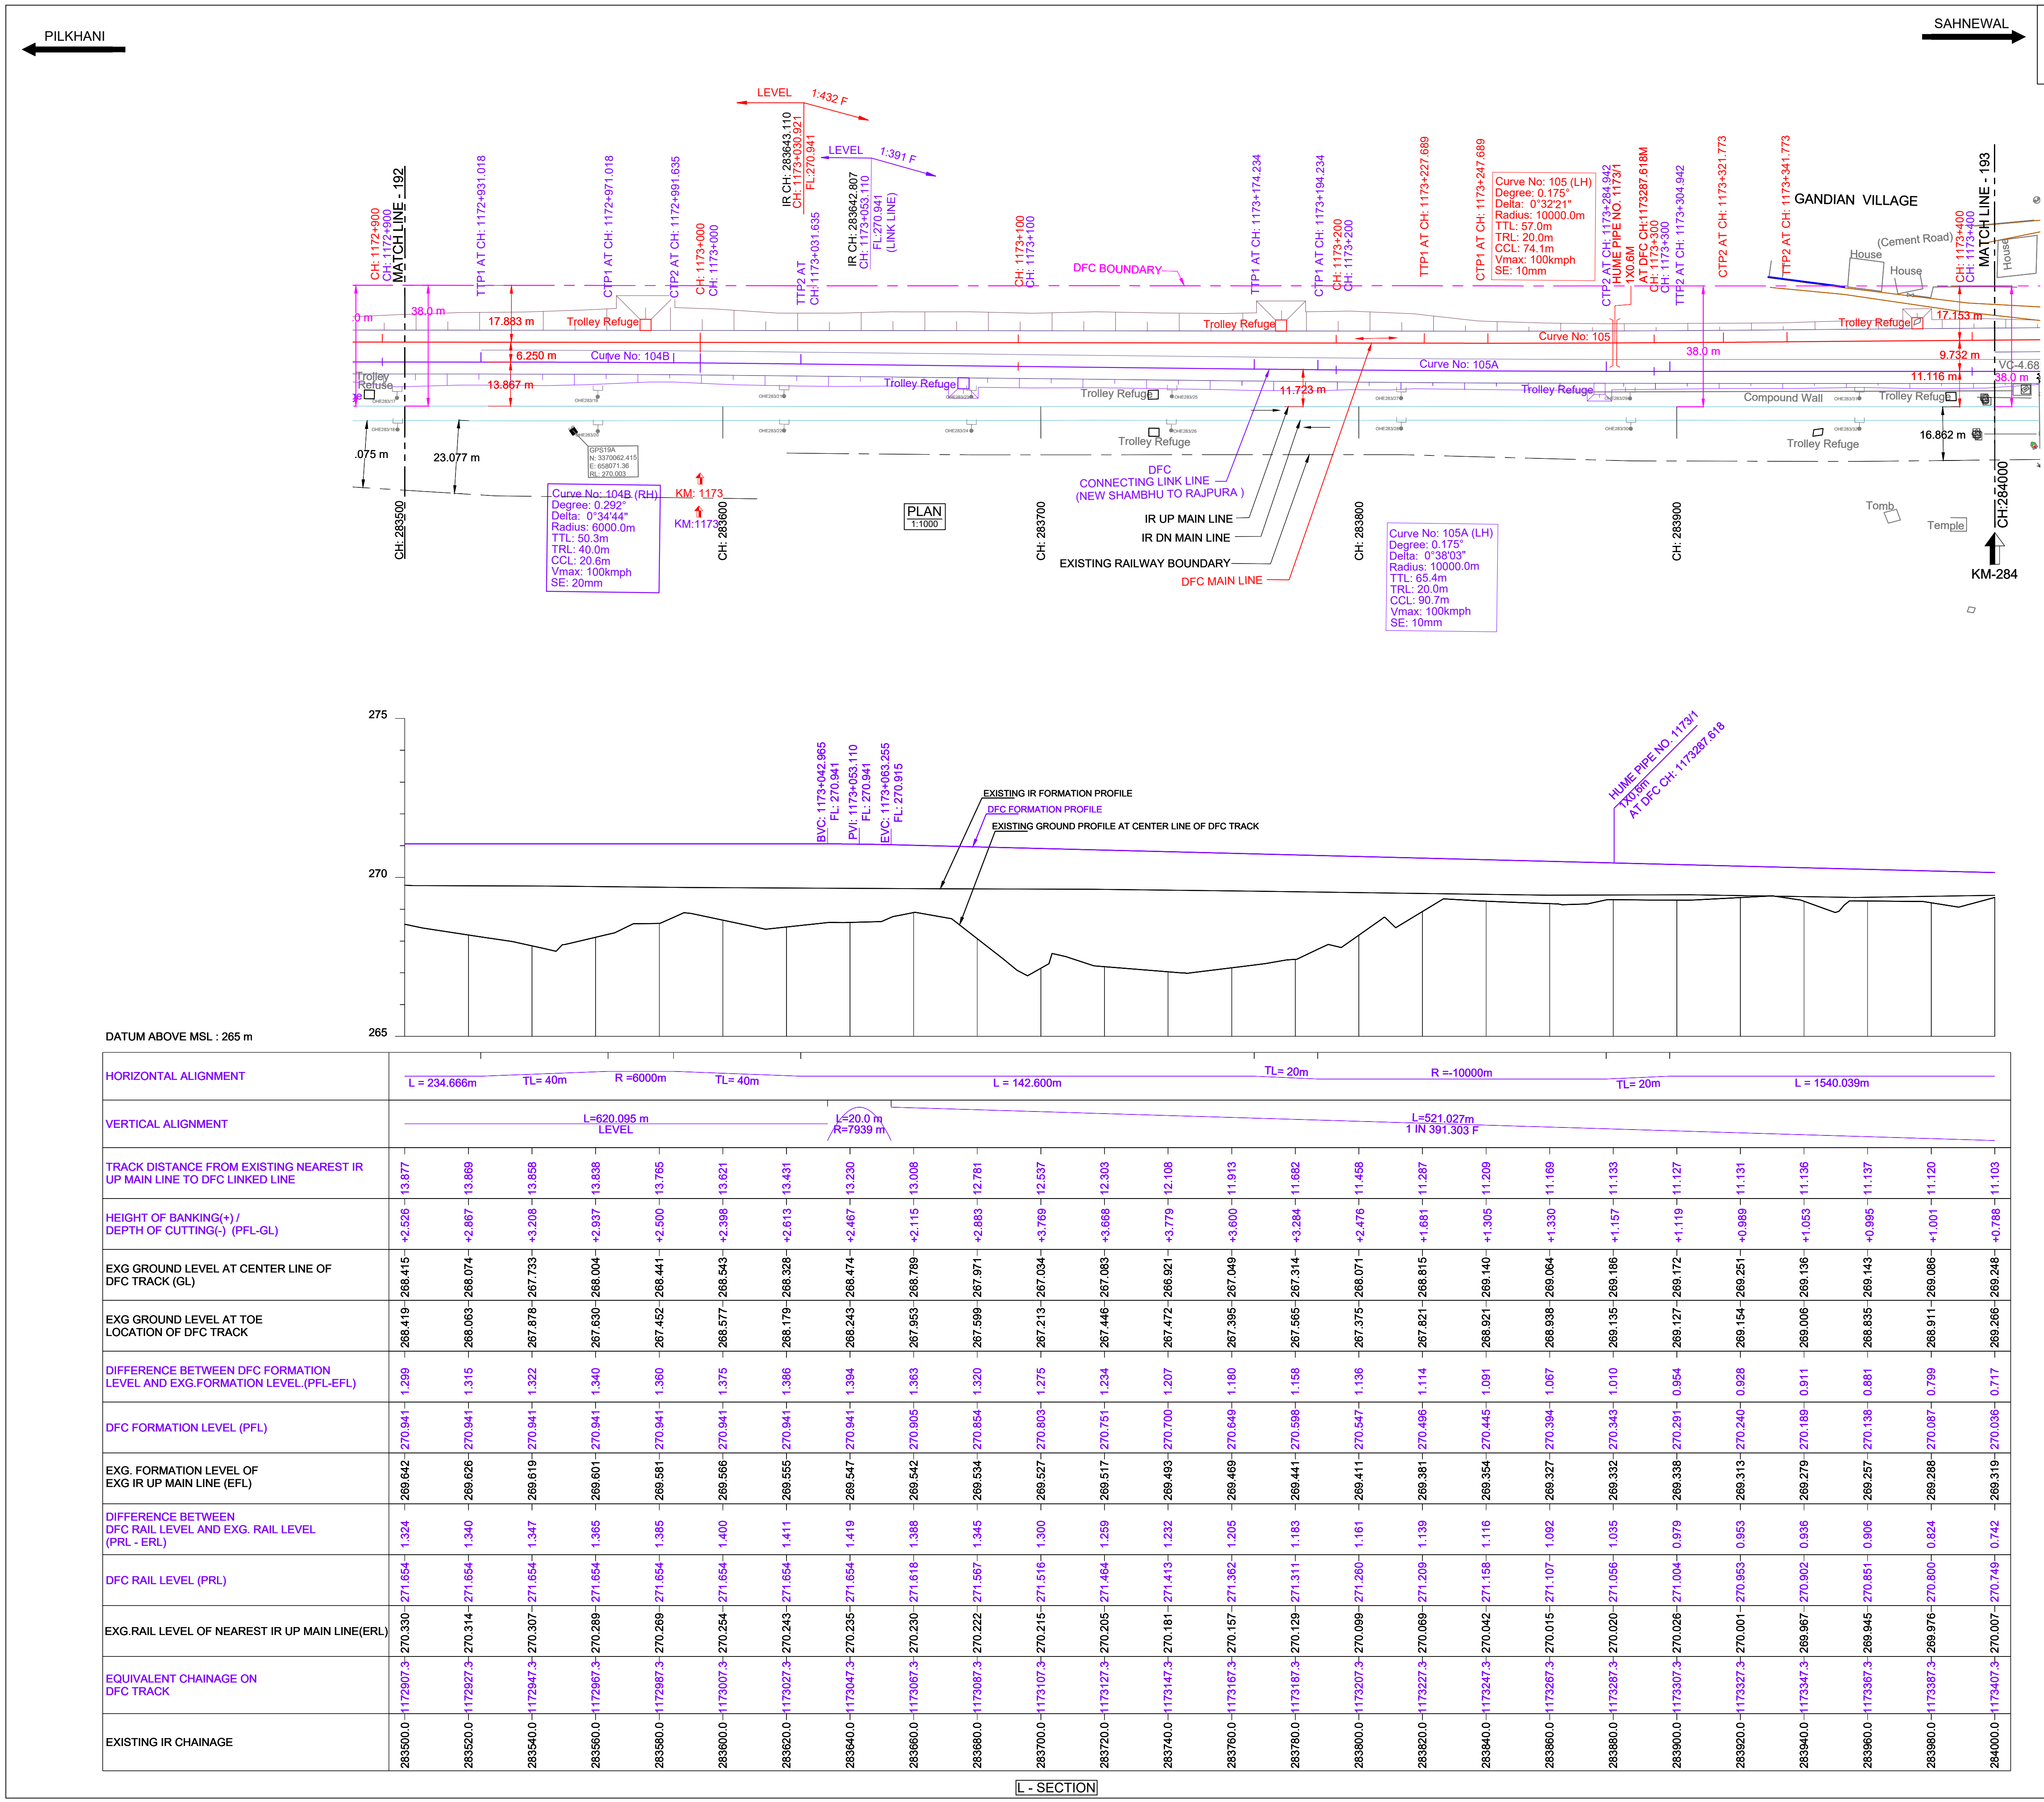

NOTE:-

- DFCC WORKS ARE SHOWN IN RED.
- DFCC LINK LINE WORKS ARE SHOWN IN VIOLET.
- ALL DIMENSIONS ARE SHOWN IN METRES.
- THIS DRAWING IS PREPARED BASED ON LATEST SURVEY DATA HELD ON APRIL-2022. GTS BENCH MARK OF 261.850M CONSIDERED ON TOP OF CANAL BRIDGE ABUTMENT AT DORANA VILLAGE ALONG THE NH1.
- DFCC NEW CHAINAGE OF 1075.950M IS WITH REFERENCE TO THE IR KM OF 187.500KM END OF KM OF CP-303(SECTION P-3 PILKHANI END) AGAINST THE EXISTING DFC CHAINAGE. 116277.742M ISSUED VIDE LETTER NO. COM/DFCC/CH/MS/SURVEY/2021-301-2301/16-11/173.DT. 17.01.2023.
- BALLAST PROFILE HAS BEEN PROVIDED ACCORDING TO THE CLAUSE 1.11.3 OF STANDARD SCHEDULE OF DIMENSION(EASTERN CORRIDOR) & THE BALLAST CUSHION DIMENSION SHOWN IN 35CM ON GE-14 PARA 17. SPECIFICATIONS & RECOMMENDATIONS 2. TWO LAYER SYSTEM FIG.10.

REFERENCE DRAWINGS:-

- FOR KEY PLAN REFER DRAWING NO. 301-2/AL/0001
- FOR LEGEND AND ABBREVIATIONS REFER DRAWING NO. 301-2/AL/1000
- FOR TYPICAL SECTION OF BALLAST PROFILE (FL-RL) REFER DRG. NO. 301-2/TK/TFD/004 (TR.1952)

REVISIONS:

REV.	DATE	REVISION DETAILS	PURPOSE OF ISSUE
0	30.10.2024	SUBMISSION OF AS-BUILT DRAWING	FOR APPROVAL

LEGEND:

IR TRACK
DFCC TRACK
LINK LINE (SMUN-RP-J)
DFCC FUTURE PROPOSALS
STRUCTURE / BUILDING
DFCC TOE LINE
DFCC FORMATION
RETAINING WALL
ROAD
STREAM, DRAIN, NALA, CANAL
FENCE
POWER LINES
TBM
ELECTRIC POLE/OHE MAST
IR RAILWAY BOUNDARY
DFCC BOUNDARY

OWNER: DEDICATED FREIGHT CORRIDOR CORPORATION OF INDIA LTD. (A GOVERNMENT OF INDIA ENTERPRISE)
PROJECT OFFICE (AMBALA UNIT): OLD RAILWAY COLONY (NEAR ANAND MARKET), AMBALA CANTT-133001.
CORPORATE IDENTITY NO.: U60232DL2006GGI155068

ENGINEER: DB Engineering & Consulting GmbH
Deutsche Bahn Engineering & Consulting GmbH

CONTRACTOR: GIL - TPL JV
GAR TATA

SUBMITTED BY: GIL - TPL JV

DATED: 30.10.2024
NAME: VIJAY PRATAP
SIGNATURE:

APPROVED BY: DEUTSCHE BAHN ENGINEERING & CONSULTING GMBH
DATED: 30.10.2024
NAME: PARASURAM KOTYADA
SIGNATURE:

STAMP: AS-BUILT DRAWING
TR. Ref.:
ENGINEER Sign.:



EMPLOYER (DFCCIL): DEDICATED FREIGHT CORRIDOR CORPORATION OF INDIA LTD.

AS BUILT DRAWING

TITLE: AS-BUILT PLAN AND PROFILE
DFCC LINK LINE
FROM IR KM: 283.500 TO 284.000
DFC KM: 1172.907 TO 1173.407

DFCC APPR. NO.:
ENGG. APPR. NO.:
DRG. NO.: 301-2/AL/A/1193A
SHEET NO.: 1 OF 1
DATE: 30.10.2024
STATUS: A

TR.

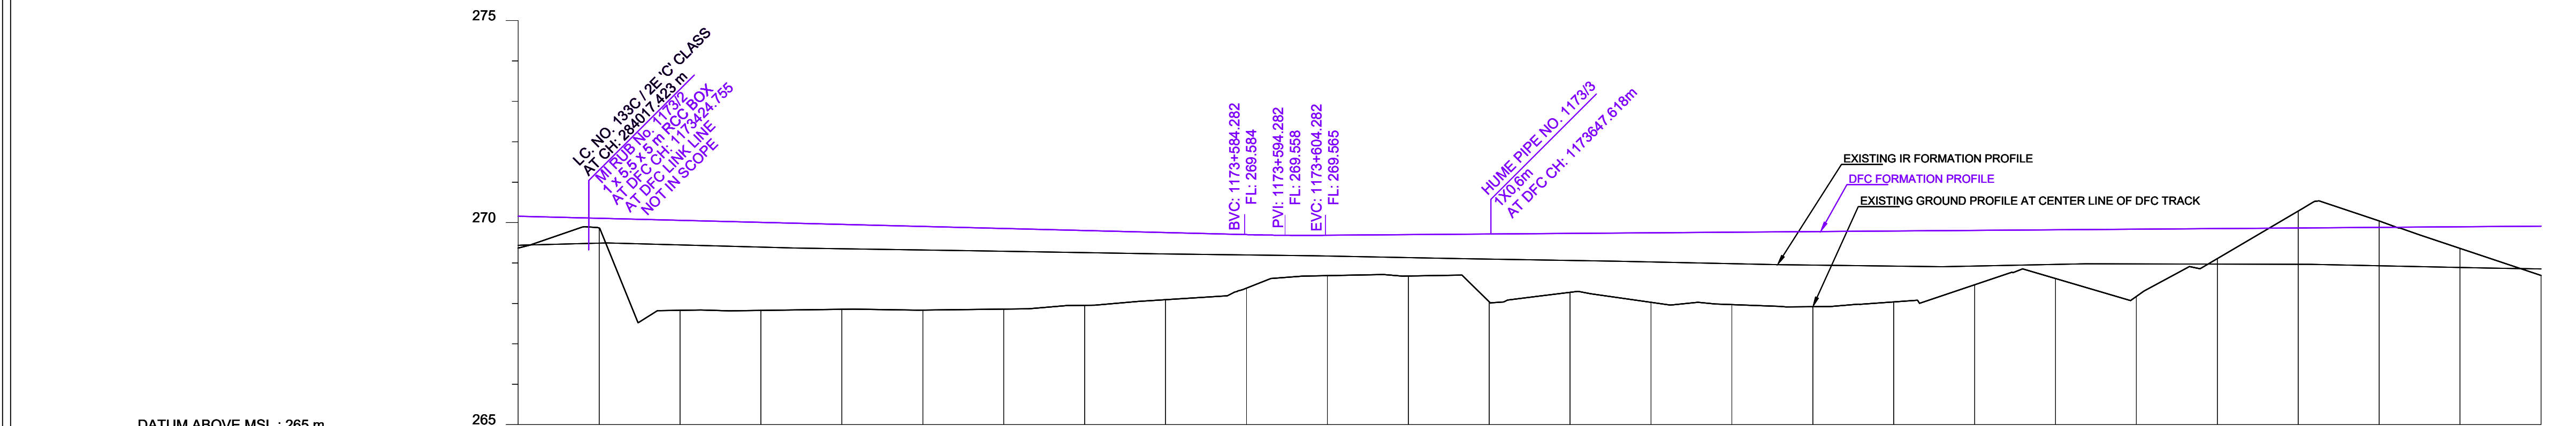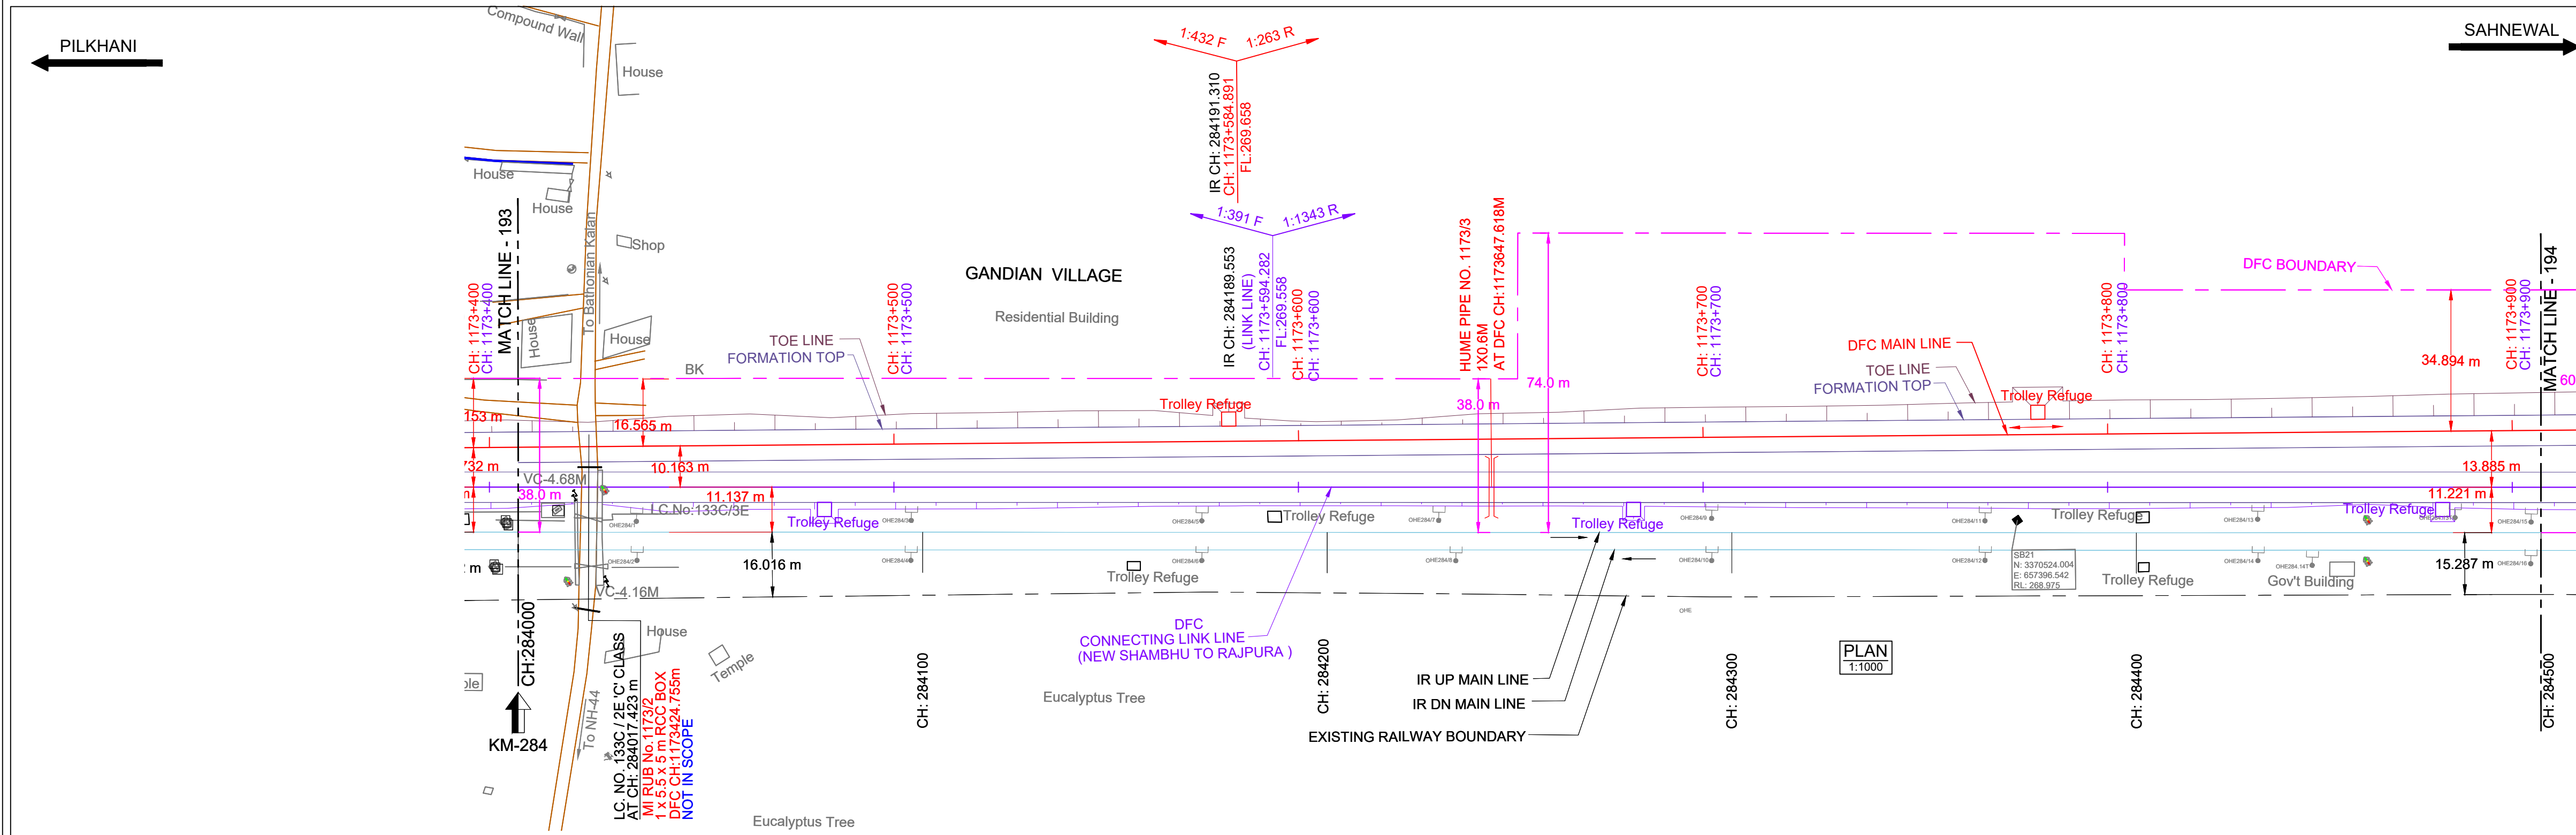

HORIZONTAL ALIGNMENT	L = 1540.039m														
VERTICAL ALIGNMENT	L=521.027m 1 IN 391.303 F														
TRACK DISTANCE FROM EXISTING NEAREST IR UP MAIN LINE TO DFC LINKED LINE	-11.103	-11.103	-11.103	-11.103	-11.103	-11.103	-11.103	-11.103	-11.103	-11.103	-11.103	-11.103	-11.103	-11.103	-11.103
HEIGHT OF BANKING(+) / DEPTH OF CUTTING(-) (PFL-GL)	+0.788	+0.788	+0.788	+0.788	+0.788	+0.788	+0.788	+0.788	+0.788	+0.788	+0.788	+0.788	+0.788	+0.788	+0.788
EXG GROUND LEVEL AT CENTER LINE OF DFC TRACK (GL)	269.246	269.246	269.246	269.246	269.246	269.246	269.246	269.246	269.246	269.246	269.246	269.246	269.246	269.246	269.246
EXG GROUND LEVEL AT TOE LOCATION OF DFC TRACK	269.266	269.266	269.266	269.266	269.266	269.266	269.266	269.266	269.266	269.266	269.266	269.266	269.266	269.266	269.266
DIFFERENCE BETWEEN DFC FORMATION LEVEL AND EXG.FORMATION LEVEL (PFL-EFL)	0.717	0.717	0.717	0.717	0.717	0.717	0.717	0.717	0.717	0.717	0.717	0.717	0.717	0.717	0.717
DFC FORMATION LEVEL (PFL)	270.036	270.036	270.036	270.036	270.036	270.036	270.036	270.036	270.036	270.036	270.036	270.036	270.036	270.036	270.036
EXG. FORMATION LEVEL OF EXG IR UP MAIN LINE (EFL)	269.319	269.319	269.319	269.319	269.319	269.319	269.319	269.319	269.319	269.319	269.319	269.319	269.319	269.319	269.319
DIFFERENCE BETWEEN DFC RAIL LEVEL AND EXG. RAIL LEVEL (PRL - ERL)	0.742	0.742	0.742	0.742	0.742	0.742	0.742	0.742	0.742	0.742	0.742	0.742	0.742	0.742	0.742
DFC RAIL LEVEL (PRL)	270.749	270.749	270.749	270.749	270.749	270.749	270.749	270.749	270.749	270.749	270.749	270.749	270.749	270.749	270.749
EXG.RAIL LEVEL OF NEAREST IR UP MAIN LINE(ERL)	270.007	270.007	270.007	270.007	270.007	270.007	270.007	270.007	270.007	270.007	270.007	270.007	270.007	270.007	270.007
EQUIVALENT CHAINAGE ON DFC TRACK	284000.0	284000.0	284000.0	284000.0	284000.0	284000.0	284000.0	284000.0	284000.0	284000.0	284000.0	284000.0	284000.0	284000.0	284000.0
EXISTING IR CHAINAGE	284000.0	284000.0	284000.0	284000.0	284000.0	284000.0	284000.0	284000.0	284000.0	284000.0	284000.0	284000.0	284000.0	284000.0	284000.0

L - SECTION

NOTE:-

- DFCC WORKS ARE SHOWN IN RED.
- DFC LINK LINE WORKS ARE SHOWN IN VIOLET.
- ALL DIMENSIONS ARE SHOWN IN METRES.
- THIS DRAWING IS PREPARED BASED ON LATEST SURVEY DATA HELD ON APRIL-2022. GTS BENCH MARK OF 261.850M CONSIDERED ON TOP OF CANAL BRIDGE ABUTMENT AT DORAH VILLAGE ALONG THE NH1.
- DFC NEW CHAINAGE OF 1075.950M IS WITH REFERENCE TO THE IR KM OF 187.500KM END OF KM OF CP-303(SECTION P-3 PILKHANI END) AGAINST THE EXISTING DFC CHAINAGE. 116277.742M ISSUED VIDE LETTER NO. GOM/DFCC/UMS/SURVEY/2021-301-2301/16-01/173 DT. 17.01.2023.
- BALLAST PROFILE HAS BEEN PROVIDED ACCORDING TO THE CLAUSE 1.11.3 OF STANDARD SCHEDULE OF DIMENSION(EASTERN CORRIDOR) & THE BALLAST CUSHION DIMENSION SHOWN IN 35CM ON GE-14 PARA 17. SPECIFICATIONS & RECOMMENDATIONS 2. TWO LAYER SYSTEM FIG.10.

REFERENCE DRAWINGS :-

- FOR KEY PLAN REFER DRAWING NO. 301-2/AL/0001
- FOR LEGEND AND ABBREVIATIONS REFER DRAWING NO. 301-2/AL/1000
- FOR TYPICAL SECTION OF BALLAST PROFILE (FL-RL) REFER DRG. NO. 301-2/TK/TFD/004 (TR.1952)

LEGEND:

IR TRACK
DFCC TRACK
LINK LINE (SMUN-RP-J)
DFCC FUTURE PROPOSALS
STRUCTURE / BUILDING
DFCC TOE LINE
DFCC FORMATION
RETAINING WALL
ROAD
STREAM, DRAIN, NALA, CANAL.
FENCE
POWER LINES
TBM
ELECTRIC POLE/OHE MAST
IR RAILWAY BOUNDARY
DFCC BOUNDARY

SCALE

HOR - 1:1000
VER - 1:100
SHEET SIZE : A1

TYPICAL SECTION

TRACK STRUCTURE		
RAIL SECTION: 60Kg/m (UIC 60Kg/m) DFC LINE: 60Kg/m (UIC 60Kg/m) IR MAIN LINE: 52Kg/m	Difference between FL- RL (Below Rail Seat)	
	IR Line	DFC
RUBBER PAD	172mm	172mm
SLEEPER DEPTH	210mm	210mm
BALLAST CUSHION	300mm	350mm
Total Depth (FL TO RL)	688mm	742mm

OWNER: DEDICATED FREIGHT CORRIDOR CORPORATION OF INDIA LTD. (A GOVERNMENT OF INDIA ENTERPRISE)
PROJECT OFFICE (AMBALA UNIT): OLD RAILWAY COLONY (NEAR ANAND MARKET), AMBALA CANTT-133001.
CORPORATE IDENTITY NO. : U60232DL2006060155068

ENGINEER: DB Engineering & Consulting GmbH
Deutsche Bahn Engineering & Consulting GmbH

CONTRACTOR: GIL - TPL JV
GAR TATA

SUBMITTED BY	GIL - TPL JV		
	DATED	NAME	SIGNATURE
PREPARED BY			
CHECKED BY	30.10.2024	VIJAY PRATAP	
APPROVED BY	30.10.2024	PARASURAM KOTYADA	

APPROVED BY: DEUTSCHE BAHN ENGINEERING & CONSULTING GMBH

	DATED	NAME	SIGNATURE
Sr. DE./CHIEF ENGINEER		SURESH K.YALANGI	
CHIEF TRACK ENGINEER		RAJ PAL SINGH	
T.L.		H.D. VIDJAK	

STAMP: A AS-BUILT DRAWING TR. Ref.: ENGINEER Sign.:

EMPLOYER (DFCCIL): DEDICATED FREIGHT CORRIDOR CORPORATION OF INDIA LTD.



AS BUILT DRAWING

TITLE: AS-BUILT PLAN AND PROFILE DFC LINK LINE
FROM IR KM: 284.000 TO 284.500
DFC KM: 1173.407 TO 1173.907

DFCC APPR. NO. -
ENGG. APPR. NO. -
DRG. NO. - 301-2/AL/A/1194A
SHEET NO. : 1 OF 1
DATE : 30.10.2024

STATUS: A

TR.

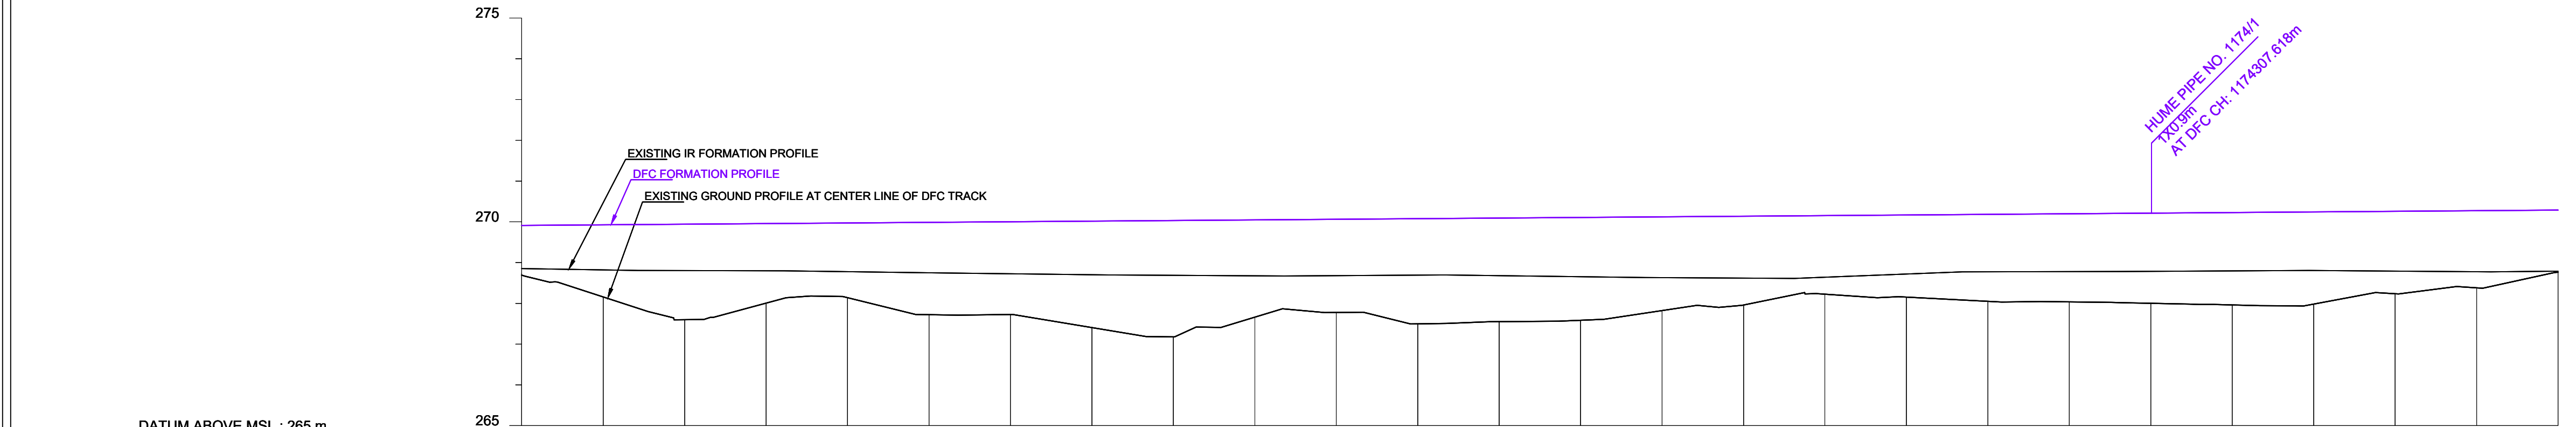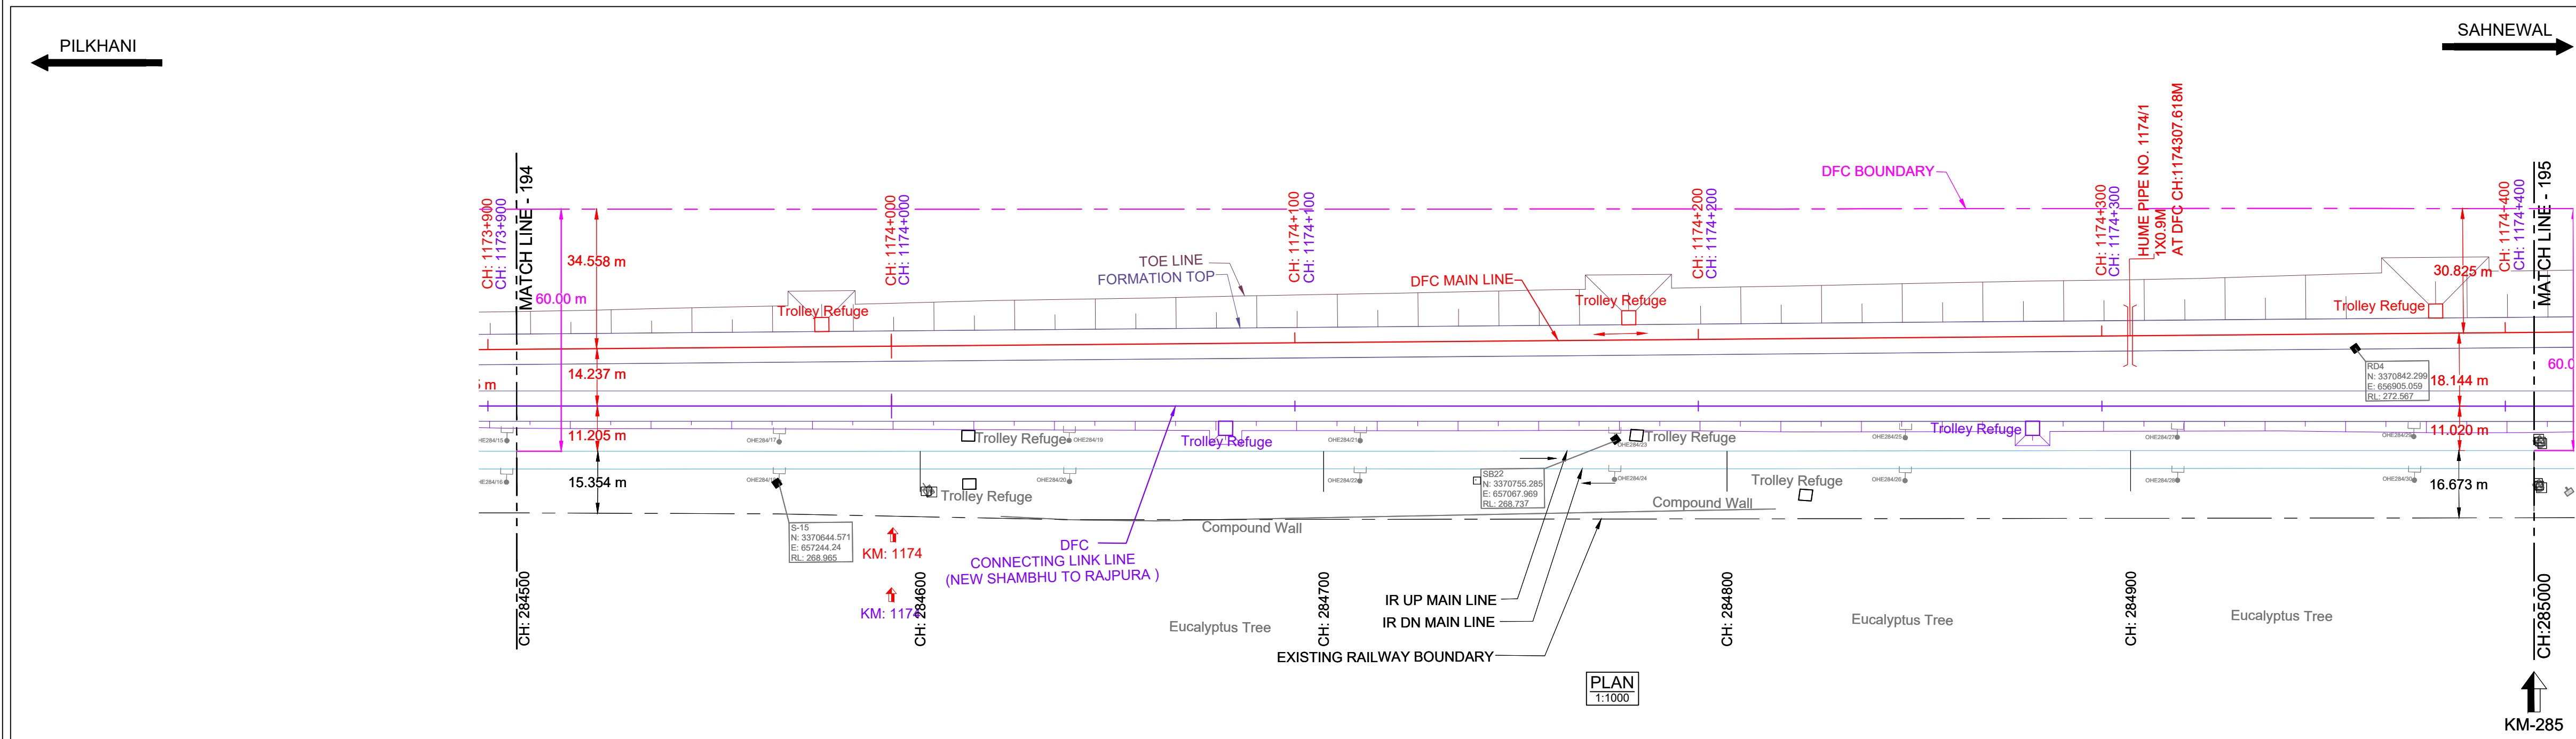

HORIZONTAL ALIGNMENT	L = 1540.039m																			
VERTICAL ALIGNMENT	L=1503.383 m 1 IN 1343.475 R																			
TRACK DISTANCE FROM EXISTING NEAREST IR UP MAIN LINE TO DFC LINKED LINE	-11.214	-11.205	-11.212	-11.232	-11.227	-11.214	-11.208	-11.202	-11.194	-11.184	-11.178	-11.172	-11.159	-11.141	-11.130	-11.145	-11.136	-11.087	-11.022	-11.018
HEIGHT OF BANKING(+) / DEPTH OF CUTTING(-) (PFL-GL)	+1.218	+1.768	+2.343	+1.951	+1.832	+2.285	+2.274	+2.611	+2.855	+2.387	+2.287	+2.581	+2.540	+2.523	+2.301	+2.178	+1.928	+2.016	+2.213	+1.525
EXG GROUND LEVEL AT CENTER LINE OF DFC TRACK (GL)	268.573	268.038	267.477	267.885	268.019	267.601	267.606	267.285	267.055	267.538	267.653	267.374	267.430	267.462	267.699	267.636	268.101	268.028	267.875	268.638
EXG GROUND LEVEL AT TOE LOCATION OF DFC TRACK	268.044	267.981	267.670	267.594	267.568	267.385	267.280	267.050	266.987	267.027	266.952	266.935	266.823	266.713	266.761	267.185	266.955	267.406	266.998	268.592
DIFFERENCE BETWEEN DFC FORMATION LEVEL AND EXG.FORMATION LEVEL.(PFL-EFL)	1.060	1.108	1.139	1.159	1.195	1.237	1.276	1.316	1.345	1.370	1.381	1.384	1.412	1.453	1.491	1.519	1.513	1.450	1.428	1.498
DFC FORMATION LEVEL (PFL)	268.731	268.791	268.821	268.836	268.851	268.829	268.880	268.579	268.365	268.925	268.940	268.571	268.967	268.531	268.508	268.495	268.516	268.594	268.861	268.872
EXG. FORMATION LEVEL OF EXG IR UP MAIN LINE (EFL)	268.731	268.698	268.681	268.677	268.655	268.629	268.604	268.579	268.565	268.555	268.559	268.571	268.558	268.531	268.508	268.495	268.516	268.594	268.861	268.872
DIFFERENCE BETWEEN DFC RAIL LEVEL AND EXG. RAIL LEVEL (PRL - ERL)	1.085	1.133	1.164	1.184	1.220	1.262	1.301	1.341	1.370	1.395	1.406	1.409	1.437	1.478	1.516	1.544	1.538	1.475	1.453	1.523
DFC RAIL LEVEL (PRL)	270.504	270.519	270.534	270.549	270.564	270.578	270.593	270.608	270.623	270.638	270.653	270.668	270.683	270.698	270.712	270.727	270.742	270.757	270.802	270.817
EXG.RAIL LEVEL OF NEAREST IR UP MAIN LINE(ERL)	269.419	269.386	269.369	269.365	269.343	269.317	269.292	269.267	269.253	269.243	269.247	269.259	269.246	269.219	269.196	269.183	269.204	269.282	269.349	269.360
EQUIVALENT CHAINAGE ON DFC TRACK	1173907.3	1173927.3	1173947.3	1173967.3	1173987.3	1174007.3	1174027.3	1174047.3	1174067.3	1174087.3	1174107.3	1174127.3	1174147.3	1174167.3	1174187.3	1174207.3	1174227.3	1174247.3	1174267.3	1174287.3
EXISTING IR CHAINAGE	284500.0	284520.0	284540.0	284560.0	284580.0	284600.0	284620.0	284640.0	284660.0	284680.0	284700.0	284720.0	284740.0	284760.0	284780.0	284800.0	284820.0	284840.0	284860.0	284880.0

L - SECTION

NOTE:-

- DFCC WORKS ARE SHOWN IN RED.
- DFC LINK LINE WORKS ARE SHOWN IN VIOLET.
- ALL DIMENSIONS ARE SHOWN IN METRES.
- THIS DRAWING IS PREPARED BASED ON LATEST SURVEY DATA HELD ON APRIL-2022. GTS BENCH MARK OF 261.850M CONSIDERED ON TOP OF CANAL BRIDGE ABUTMENT AT DORANA VILLAGE ALONG THE NH1.
- DFC NEW CHAINAGE OF 1075.950M IS WITH REFERENCE TO THE IR KM OF 187.500KM END OF KM OF CP-303(SECTION P-3 PILKHANI END) AGAINST THE EXISTING DFC CHAINAGE. 116277.742M ISSUED VIDE LETTER NO. COM/DFCC/UMS/SURVEY/2021-301-230116-011173 DT. 17.01.2023.
- BALLAST PROFILE HAS BEEN PROVIDED ACCORDING TO THE CLAUSE 1.11.3 OF STANDARD SCHEDULE OF DIMENSION(EASTERN CORRIDOR) & THE BALLAST CUSHION DIMENSION SHOWN IN 35CM ON GE-14 PARA 17. SPECIFICATIONS & RECOMMENDATIONS 2. TWO LAYER SYSTEM FIG.10.

REFERENCE DRAWINGS:-

- FOR KEY PLAN REFER DRAWING NO. 301-2/AL/0001
- FOR LEGEND AND ABBREVIATIONS REFER DRAWING NO. 301-2/AL/1000
- FOR TYPICAL SECTION OF BALLAST PROFILE (FL-RL) REFER DRG. NO. 301-2/TK/TFD/-004 (TR.1952)

DRG NO.-301-2/AL/A/1195A

0	30.10.2024	SUBMISSION OF AS-BUILT DRAWING	FOR APPROVAL
REV.	DATE	REVISION DETAILS	PURPOSE OF ISSUE

LEGEND:

SCALE

HOR - 1:1000

VER - 1:100

SHEET SIZE : A1

IR TRACK
DFCC TRACK
LINK LINE (SMUN-RP-J)
DFCC FUTURE PROPOSALS
STRUCTURE / BUILDING
DFCC TOE LINE
DFCC FORMATION
RETAINING WALL
ROAD
STREAM, DRAIN, NALA, CANAL.
FENCE
POWER LINES
TBM
ELECTRIC POLE/OHE MAST
IR RAILWAY BOUNDARY
DFCC BOUNDARY

TYPICAL SECTION

TRACK STRUCTURE		
RAIL SECTION: 60Kg/m (UIC 60Kg/m) DFC LINE: 60Kg/m (UIC 60Kg/m) IR MAIN LINE: 52Kg/m	Difference between FL- RL (Below Rail Seat)	
	IR Line	DFC
RUBBER PAD	172mm	172mm
SLEEPER DEPTH	210mm	210mm
BALLAST CUSHION	300mm	350mm
Total Depth (FL TO RL)	688mm	742mm

OWNER

DEDICATED FREIGHT CORRIDOR CORPORATION OF INDIA LTD.

(A GOVERNMENT OF INDIA ENTERPRISE)

PROJECT OFFICE(AMBALA UNIT): OLD RAILWAY COLONY (NEAR ANAND MARKET),AMBALA CANTT-133001.

CORPORATE IDENTITY NO. : U60232DL2006GGI155068

ENGINEER:

DB Engineering & Consulting GmbH

Deutsche Bahn Engineering & Consulting GmbH

CONTRACTOR:

GIL - TPL JV

GAR TATA

SUBMITTED BY	GIL - TPL JV		
	DATED	NAME	SIGNATURE
PREPARED BY			
CHECKED BY	30.10.2024	VIJAY PRATAP	
APPROVED BY	30.10.2024	PARASURAM KOTYADA	
APPROVED BY	DEUTSCHE BAHN ENGINEERING & CONSULTING GMBH		
	DATED	NAME	SIGNATURE
Sr. DE./CHIEF ENGINEER		SURESH K.YALANGI	
CHIEF TRACK ENGINEER		RAJ PAL SINGH	
T.L.		H.D. VIDJAK	

STAMP

A AS-BUILT DRAWING
TR. Ref.:.....
ENGINEER Sign.:.....

EMPLOYER (DFCCIL):

DEDICATED FREIGHT CORRIDOR CORPORATION OF INDIA LTD.

AS BUILT DRAWING



TITLE

AS-BUILT PLAN AND PROFILE
DFC LINK LINE
FROM IR KM: 284.500 TO 285.000
DFC KM: 1173.907 TO 1174.407

DFCC APPR. NO. -
ENGG. APPR. NO. -
DRG. NO. - 301-2/AL/A/1195A
SHEET NO. : 1 OF 1
DATE : 30.10.2024

STATUS
A

TR.

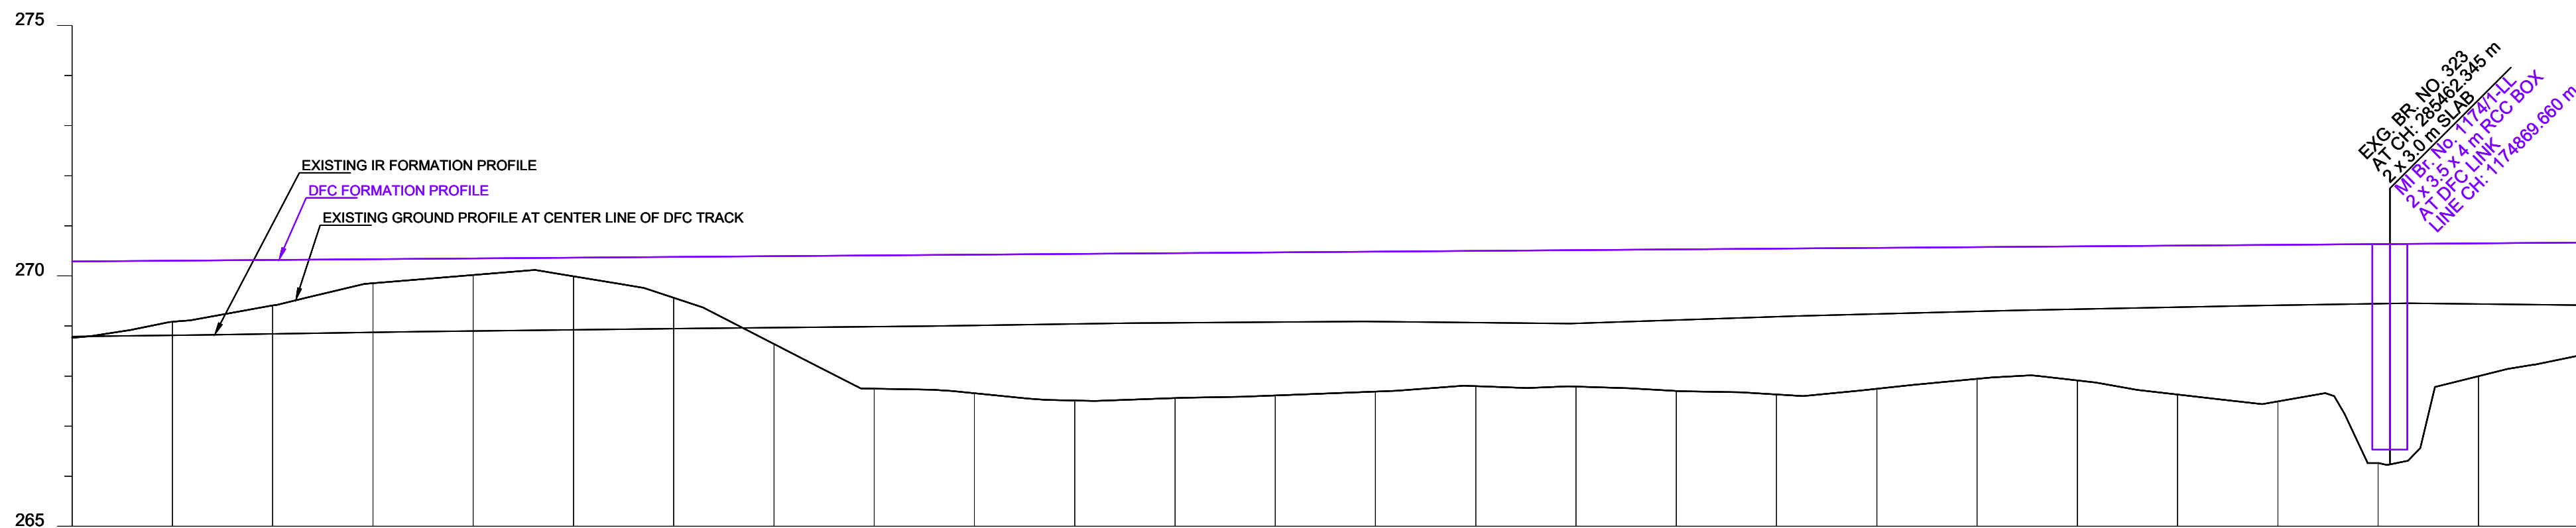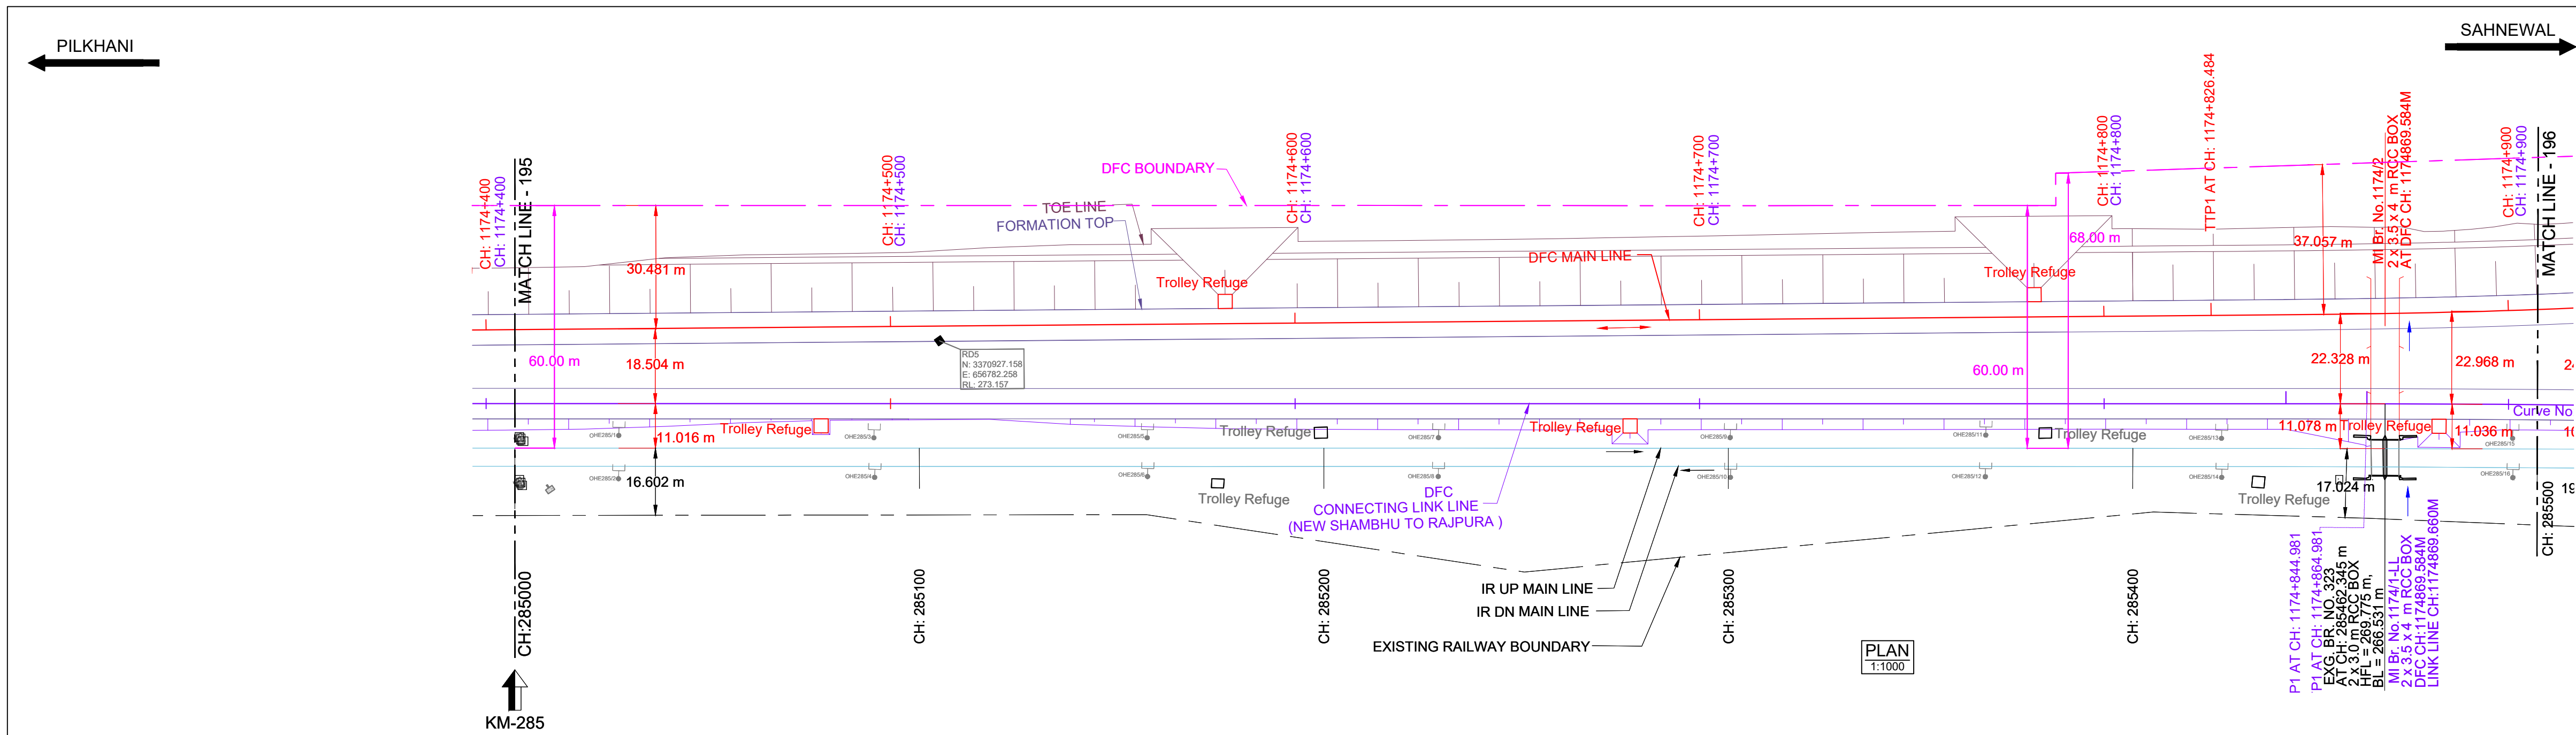

HORIZONTAL ALIGNMENT	L = 1540.039m TL= 20m R=6000m																		
VERTICAL ALIGNMENT	L=1503.383 m 1 IN 1343.475 R																		
TRACK DISTANCE FROM EXISTING NEAREST IR UP MAIN LINE TO DFC LINKED LINE	11.018	11.016	11.017	11.018	11.014	11.004	10.995	10.995	10.996	10.994	10.988	10.983	10.983	10.983	10.983	10.983	10.983	10.983	10.975
HEIGHT OF BANKING(+) / DEPTH OF CUTTING(-) (PFL-GL)	+1.525	+1.220	+0.908	+0.479	+0.330	+0.371	+0.817	+1.752	+2.662	+2.769	+2.929	+2.892	+2.856	+2.795	+2.813	+2.629	+3.127	+4.373	+2.258
EXG GROUND LEVEL AT CENTER LINE OF DFC TRACK (GL)	268.638	268.958	269.285	269.729	269.893	269.866	269.435	268.515	267.621	267.529	267.363	267.434	267.486	267.562	267.618	267.817	267.963	268.133	268.277
EXG GROUND LEVEL AT TOE LOCATION OF DFC TRACK	268.592	268.076	268.396	268.580	268.151	268.541	267.491	266.720	266.657	266.829	266.661	266.673	266.713	266.842	266.987	267.172	267.508	268.050	268.978
DIFFERENCE BETWEEN DFC FORMATION LEVEL AND EXG.FORMATION LEVEL.(PFL-EFL)	1.498	1.490	1.476	1.461	1.449	1.441	1.432	1.427	1.422	1.413	1.398	1.390	1.391	1.396	1.321	1.285	1.208	1.191	1.251
DFC FORMATION LEVEL (PFL)	270.163	270.178	270.193	270.208	270.223	270.238	270.252	270.267	270.282	270.297	270.312	270.327	270.342	270.357	270.431	270.446	270.491	270.506	270.535
EXG. FORMATION LEVEL OF EXG IR UP MAIN LINE (EFL)	268.665	268.688	268.716	268.747	268.773	268.797	268.821	268.841	268.860	268.884	268.914	268.937	268.951	268.960	269.110	269.161	269.263	269.315	269.284
DIFFERENCE BETWEEN DFC RAIL LEVEL AND EXG. RAIL LEVEL (PRL - ERL)	1.523	1.515	1.501	1.486	1.474	1.466	1.457	1.452	1.447	1.438	1.423	1.415	1.416	1.421	1.346	1.310	1.233	1.216	1.276
DFC RAIL LEVEL (PRL)	270.876	270.891	270.906	270.921	270.936	270.951	270.965	270.980	270.995	271.010	271.025	271.04	271.055	271.070	271.144	271.159	271.204	271.219	271.248
EXG.RAIL LEVEL OF NEAREST IR UP MAIN LINE(ERL)	269.353	269.376	269.404	269.435	269.461	269.485	269.509	269.529	269.548	269.572	269.602	269.625	269.639	269.648	269.798	269.849	269.971	269.996	269.972
EQUIVALENT CHAINAGE ON DFC TRACK	1174407.3	1174427.3	1174447.3	1174467.3	1174487.3	1174507.3	1174527.3	1174547.3	1174567.3	1174587.3	1174607.3	1174627.3	1174647.3	1174667.3	1174727.3	1174747.3	1174807.3	1174827.3	1174907.3
EXISTING IR CHAINAGE	285000.0	285020.0	285040.0	285060.0	285080.0	285100.0	285120.0	285140.0	285160.0	285180.0	285200.0	285220.0	285240.0	285260.0	285280.0	285300.0	285320.0	285340.0	285360.0

NOTE:-

- DFCC WORKS ARE SHOWN IN RED.
- DFC LINK LINE WORKS ARE SHOWN IN VIOLET.
- ALL DIMENSIONS ARE SHOWN IN METRES.
- THIS DRAWING IS PREPARED BASED ON LATEST SURVEY DATA HELD ON APRIL-2022. GTS BENCH MARK OF 261.850M CONSIDERED ON TOP OF CANAL BRIDGE ABUTMENT AT DORANA VILLAGE ALONG THE NH1.
- DFC NEW CHAINAGE OF 1075.950M IS WITH REFERENCE TO THE IR KM OF 187.500KM END OF KM OF CP-303(SECTION P-3 PILKHANI END) AGAINST THE EXISTING DFC CHAINAGE. 116277.742M ISSUED VIDE LETTER NO. COM/DFCC/UM/SURVEY/2021-301-230116-011173 DT. 17.01.2023.
- BALLAST PROFILE HAS BEEN PROVIDED ACCORDING TO THE CLAUSE 1.11.3 OF STANDARD SCHEDULE OF DIMENSION(EASTERN CORRIDOR) & THE BALLAST CUSHION DIMENSION SHOWN IN 35CM ON GE-14 PARA 17. SPECIFICATIONS & RECOMMENDATIONS 2. TWO LAYER SYSTEM FIG.10.

REFERENCE DRAWINGS :-

- FOR KEY PLAN REFER DRAWING NO. 301-2/AL/0001
- FOR LEGEND AND ABBREVIATIONS REFER DRAWING NO. 301-2/AL/1000
- FOR TYPICAL SECTION OF BALLAST PROFILE (FL-RL) REFER DRG. NO. 301-2/TK/TFD/004 (TR.1952)

SCALE

HOR - 1:1000

VER - 1:100

SHEET SIZE : A1

LEGEND:

IR TRACK
DFCC TRACK
LINK LINE (SMUN-RP-J)
DFCC FUTURE PROPOSALS
STRUCTURE / BUILDING
DFCC TOE LINE
DFCC FORMATION
RETAINING WALL
ROAD
STREAM, DRAIN, NALA, CANAL.
FENCE
POWER LINES
TBM
ELECTRIC POLE/OHE MAST
IR RAILWAY BOUNDARY
DFCC BOUNDARY

TYPICAL SECTION

TRACK STRUCTURE

RAIL SECTION: 60Kg/m (UIC 60Kg/m) DFC LINE: 60Kg/m (UIC 60Kg/m) IR MAIN LINE: 52Kg/m	Difference between FL- RL (Below Rail Seat)	
	IR Line	DFC
RUBBER PAD	172mm	172mm
SLEEPER DEPTH	6mm	10mm
BALLAST CUSHION	210mm	210mm
Total Depth (FL TO RL)	300mm	350mm

OWNER

DEDICATED FREIGHT CORRIDOR CORPORATION OF INDIA LTD.

(A GOVERNMENT OF INDIA ENTERPRISE)

PROJECT OFFICE(AMBALA UNIT): OLD RAILWAY COLONY (NEAR ANAND MARKET),AMBALA CANTT.-133001.

CORPORATE IDENTITY NO. : U60232DL20060G01155068

ENGINEER:

DB Engineering & Consulting GmbH

Deutsche Bahn Engineering & Consulting GmbH

CONTRACTOR:

GIL - TPL JV

GAR TATA

SUBMITTED BY

GIL - TPL JV

DATED

NAME

SIGNATURE

PREPARED BY

CHECKED BY

30.10.2024

VIJAY PRATAP

APPROVED BY

30.10.2024

PARASURAM KOTYADA

APPROVED BY

DEUTSCHE BAHN ENGINEERING & CONSULTING GMBH

DATED

NAME

SIGNATURE

Sr. DE./CHIEF ENGINEER

SURESH K.YALANGI

CHIEF TRACK ENGINEER

RAJ PAL SINGH

T.L.

H.D. VIDJAK

STAMP

AS-BUILT DRAWING

TR. Ref.:.....

ENGINEER Sign.:.....

EMPLOYER (DFCCIL):

DEDICATED FREIGHT CORRIDOR CORPORATION OF INDIA LTD.

AS BUILT DRAWING

AS-BUILT PLAN AND PROFILE

DFCC LINK LINE

FROM IR KM: 285.000 TO 285.500

DFC KM: 1174.407 TO 1174.907

DFCC APPR. NO. -

ENGG. APPR. NO. -


DRG. NO. - 301-2/AL/A/1196A

SHEET NO. : 1 OF 1

DATE : 30.10.2024

STATUS

A

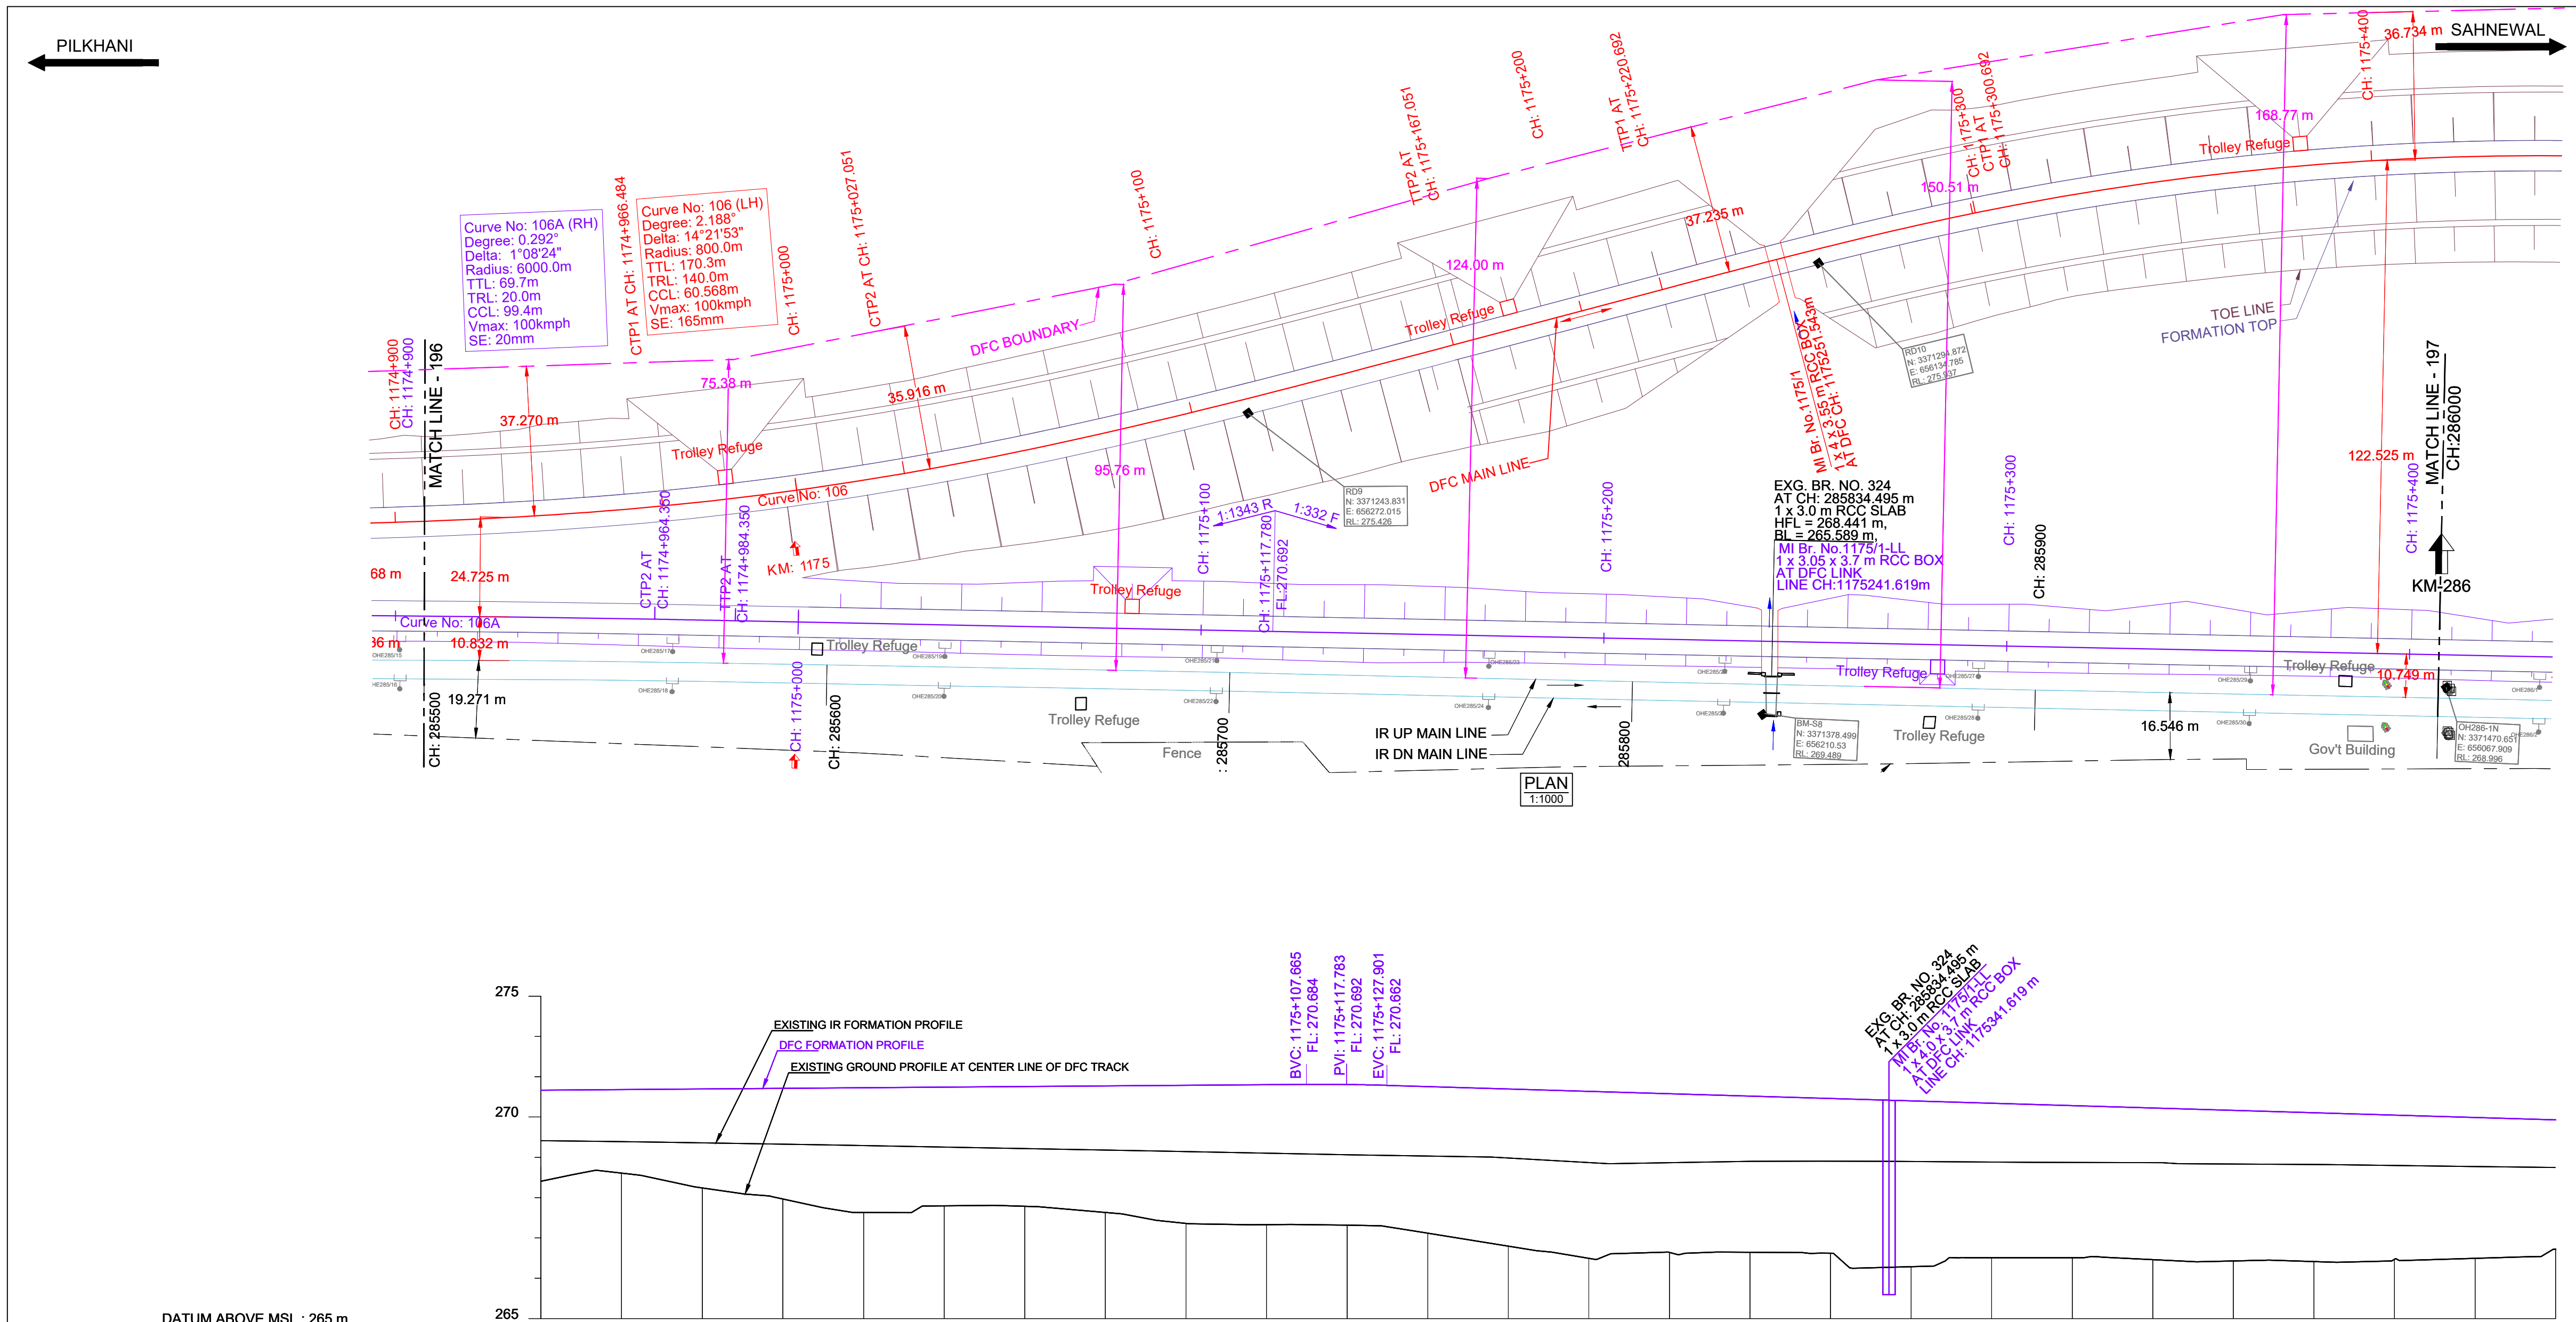

DATUM ABOVE MSL : 265 m

HORIZONTAL ALIGNMENT	R = 6000m TL = 20m L = 719.667m																									
VERTICAL ALIGNMENT	L = 1503.383 m 1 IN 1343.475 R L = 20.0 m R = 5391 m L = 782.011m 1 IN 332.288 F																									
TRACK DISTANCE FROM EXISTING NEAREST IR UP MAIN LINE TO DFC LINKED LINE	-10.975	-10.840	-10.745	-10.660	-10.561	-10.509	-10.465	-10.433	-10.409	-10.403	-10.397	-10.443	-10.495	-10.555	-10.601	-10.642	-10.676	-10.701	-10.706	-10.720	-10.744	-10.745	-10.739	-10.740	-10.742	-10.755
HEIGHT OF BANKING(+) / DEPTH OF CUTTING(-) (PFL-GL)	+2.258	+2.074	+2.454	+2.743	+3.097	+2.944	+2.972	+3.141	+3.428	+3.471	+3.490	+3.641	+3.904	+4.145	+3.939	+3.876	+3.842	+4.116	+3.932	+3.736	+3.736	+3.694	+3.572	+3.494	+3.210	
EXG GROUND LEVEL AT CENTER LINE OF DFC TRACK (GL)	268.277	268.477	268.111	267.837	267.498	267.666	267.653	267.499	267.227	267.199	267.194	267.022	266.699	266.398	266.543	266.873	266.545	266.185	266.409	266.325	266.325	266.306	266.369	266.387	266.611	
EXG GROUND LEVEL AT TOE LOCATION OF DFC TRACK	266.978	267.373	267.244	267.093	266.806	267.006	267.339	267.199	266.676	266.431	266.395	266.516	266.323	266.450	266.777	266.803	266.873	266.898	266.182	266.729	266.729	266.731	266.705	266.690	266.683	266.316
DIFFERENCE BETWEEN DFC FORMATION LEVEL AND EXG.FORMATION LEVEL (PFL-EFL)	1.251	1.290	1.335	1.385	1.435	1.485	1.537	1.590	1.643	1.697	1.742	1.724	1.713	1.768	1.713	1.619	1.555	1.505	1.459	1.332	1.332	1.285	1.250	1.217	1.181	
DFC FORMATION LEVEL (PFL)	270.535	270.550	270.565	270.580	270.595	270.610	270.625	270.640	270.655	270.669	270.684	270.693	270.602	270.542	270.602	270.422	270.382	270.302	270.241	270.241	270.061	270.121	269.940	269.880	269.820	
EXG. FORMATION LEVEL OF EXG IR UP MAIN LINE (EFL)	269.284	269.260	269.230	269.186	269.160	269.124	269.088	269.050	269.012	268.973	268.943	268.939	268.890	268.774	268.769	268.802	268.807	268.797	268.782	268.729	268.729	268.715	268.690	268.663	268.639	
DIFFERENCE BETWEEN DFC RAIL LEVEL AND EXG. RAIL LEVEL (PRL - ERL)	1.276	1.315	1.360	1.410	1.460	1.510	1.562	1.615	1.668	1.722	1.767	1.749	1.738	1.793	1.738	1.644	1.580	1.530	1.484	1.357	1.357	1.310	1.275	1.242	1.206	
DFC RAIL LEVEL (PRL)	271.248	271.263	271.278	271.293	271.308	271.323	271.338	271.353	271.368	271.382	271.397	271.376	271.315	271.255	271.195	271.135	271.075	271.015	270.954	270.774	270.774	270.714	270.653	270.593	270.533	
EXG.RAIL LEVEL OF NEAREST IR UP MAIN LINE(ERL)	269.972	269.948	269.918	269.884	269.848	269.812	269.776	269.738	269.700	269.661	269.631	269.627	269.578	269.482	269.457	269.490	269.495	269.485	269.470	269.417	269.417	269.403	269.378	269.351	269.327	
EQUIVALENT CHAINAGE ON DFC TRACK	1174807.3	1174927.4	1174947.4	1174967.4	1174987.5	1175007.5	1175027.5	1175047.5	1175067.5	1175087.5	1175107.5	1175127.5	1175147.5	1175167.5	1175187.5	1175207.5	1175227.5	1175247.5	1175267.5	1175287.5	1175307.5	1175327.5	1175347.5	1175367.5	1175387.5	1175407.5
EXISTING IR CHAINAGE	285500.0	285520.0	285540.0	285560.0	285580.0	285600.0	285620.0	285640.0	285660.0	285680.0	285700.0	285720.0	285740.0	285760.0	285780.0	285800.0	285820.0	285840.0	285860.0	285880.0	285900.0	285920.0	285940.0	285960.0	285980.0	286000.0

L - SECTION

NOTE:-

- DFCC WORKS ARE SHOWN IN RED.
- DFC LINK LINE WORKS ARE SHOWN IN VIOLET.
- ALL DIMENSIONS ARE SHOWN IN METRES.
- THIS DRAWING IS PREPARED BASED ON LATEST SURVEY DATA HELD ON APRIL-2022. GTS BENCH MARK OF 261.850M CONSIDERED ON TOP OF CANAL BRIDGE ABUTMENT AT DORANA VILLAGE ALONG THE NH1.
- DFC NEW CHAINAGE OF 1075.950M IS WITH REFERENCE TO THE IR KM OF 187.500KM END OF KM OF CP-303(SECTION P-3 PILKHANI END) AGAINST THE EXISTING DFC CHAINAGE. 116277.742M ISSUED VIDE LETTER NO. COM/DFCC/MB/SURVEY/2021-301-230116-011173.DT. 17.01.2023.
- BALLAST PROFILE HAS BEEN PROVIDED ACCORDING TO THE CLAUSE 1.11.3 OF STANDARD SCHEDULE OF DIMENSION(EASTERN CORRIDOR) & THE BALLAST CUSHION DIMENSION SHOWN IN 35CM ON GE-14 PARA 17. SPECIFICATIONS & RECOMMENDATIONS 2. TWO LAYER SYSTEM FIG.10.

REFERENCE DRAWINGS :-

- FOR KEY PLAN REFER DRAWING NO. 301-2/AL/0001
- FOR LEGEND AND ABBREVIATIONS REFER DRAWING NO. 301-2/AL/1000
- FOR TYPICAL SECTION OF BALLAST PROFILE (FL-RL) REFER DRG. NO. 301-2/TK/TFD/004 (TR.1952)

030.10.2024SUBMISSION OF AS-BUILT DRAWINGFOR APPROVAL

REV. DATE REVISION DETAILS PURPOSE OF ISSUE

SCALE
HOR - 1:1000
VER - 1:100
SHEET SIZE : A1

LEGEND:
IR TRACK
DFCC TRACK
LINK LINE (SMUN-RP-J)
DFCC FUTURE PROPOSALS
STRUCTURE / BUILDING
DFCC TOE LINE
DFCC FORMATION
RETAINING WALL
ROAD
STREAM, DRAIN, NALA, CANAL.
FENCE
POWER LINES
TBM
ELECTRIC POLE/OHE MAST
IR RAILWAY BOUNDARY
DFCC BOUNDARY

TRACK STRUCTURE

RAIL SECTION: 60Kg/m (UIC 60Kg/m) DFC LINE: 60Kg/m (UIC 60Kg/m) IR MAIN LINE: 52Kg/m	Difference between FL- RL (Below Rail Seat)
	IR LineDFC
RUBBER PAD	172mm172mm
SLEEPER DEPTH	6mm10mm
BALLAST CUSHION	210mm210mm
	300mm350mm
Total Depth (FL TO RL)	688mm742mm

OWNER
DEDICATED FREIGHT CORRIDOR CORPORATION OF INDIA LTD.
(A GOVERNMENT OF INDIA ENTERPRISE)
PROJECT OFFICE(AMBALA UNIT): OLD RAILWAY COLONY (NEAR ANAND MARKET),AMBALA CANTT.-133001.
CORPORATE IDENTITY NO. : U60232DL2006GGI155068

ENGINEER:
DB Engineering & Consulting GmbH
Deutsche Bahn Engineering & Consulting GmbH

CONTRACTOR:
GIL - TPL JV
GAR TATA

SUBMITTED BY	GIL - TPL JV		
	DATED	NAME	SIGNATURE
PREPARED BY			
CHECKED BY	30.10.2024	VIJAY PRATAP	
APPROVED BY	30.10.2024	PARASURAM KOTYADA	
APPROVED BY	DEUTSCHE BAHN ENGINEERING & CONSULTING GMBH		
	DATED	NAME	SIGNATURE
Sr. DE./CHIEF ENGINEER		SURESH K.YALANGI	
CHIEF TRACK ENGINEER		RAJ PAL SINGH	
T.L.		H.D. VIDJAK	

STAMP
A
AS-BUILT DRAWING
Tr. Ref.:.....
ENGINEER Sign.:.....

EMPLOYER (DFCCIL): DEDICATED FREIGHT CORRIDOR CORPORATION OF INDIA LTD.



AS BUILT DRAWING

TITLE
AS-BUILT PLAN AND PROFILE
DFC LINK LINE
FROM IR KM: 285.500 TO 286.000
DFC KM: 1174.907 TO 1175.407



DFCC APPR. NO. -
ENGG. APPR. NO. -
DRG. NO. - 301-2/AL/A/1197A
SHEET NO. : 1 OF 1
DATE : 30.10.2024

STATUS
A

TR.

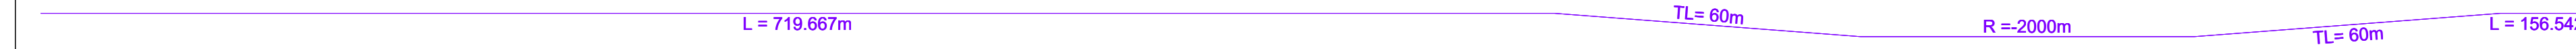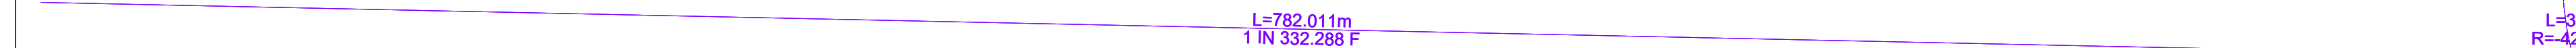ATUM ABOVE MSL : 265 m		265																													
HORIZONTAL ALIGNMENT																															
VERTICAL ALIGNMENT																															
TRACK DISTANCE FROM EXISTING NEAREST IR UP MAIN LINE TO DFC LINKED LINE			-10.755	-10.755	-10.767	-10.767	-10.775	-10.782	-10.781	-10.775	-10.730	-10.687	-10.687	-10.729	-10.729	-10.725	-10.725	-10.751	-10.653	-10.475	-10.210	-9.906	-9.639	-9.461	-9.442	-9.423	-9.468	-9.517	-9.522	-9.429	
HEIGHT OF BANKING(+) / DEPTH OF CUTTING(-) (PFL-GL)			+3.210	+3.210	+3.281	+3.281	+3.359	+3.223	+2.678	+2.092	+1.672	+2.198	+2.918	+2.912	+3.000	+2.860	+2.550	+2.292	+2.148	+1.966	+1.997	+2.410	+2.519	+2.617	+2.237	+1.243	+1.684	+1.190	+1.684		
EXG GROUND LEVEL AT CENTER LINE OF DFC TRACK (GL)			266.611	266.611	266.479	266.479	266.341	266.417	266.902	267.427	267.787	267.201	266.419	266.386	266.219	266.298	266.548	266.695	266.773	266.892	266.800	266.328	266.158	266.001	266.320	267.183	267.194	267.187	266.633		
EXG GROUND LEVEL AT TOE LOCATION OF DFC TRACK			266.316	266.316	267.270	267.270	268.277	268.196	268.040	268.816	266.985	268.476	265.618	265.257	265.295	265.416	265.665	265.693	265.671	265.836	265.826	265.671	265.309	265.171	265.469	265.563	265.680	265.841	264.980		
DIFFERENCE BETWEEN DFC FORMATION LEVEL AND EXG.FORMATION LEVEL (PFL-EFL)			1.181	1.181	1.145	1.145	1.109	1.072	1.039	1.008	0.983	0.960	0.920	0.875	0.829	0.784	0.724	0.596	0.541	0.508	0.501	0.489	0.451	0.424	0.376	0.317	0.231	0.134	0.052		
DFC FORMATION LEVEL (PFL)			269.820	269.820	269.760	269.760	269.700	269.639	269.579	269.519	269.459	269.399	269.338	269.276	269.218	269.158	269.096	268.976	268.918	268.850	268.796	268.738	268.677	268.617	268.557	268.497	268.437	268.377	268.317		
EXG. FORMATION LEVEL OF EXG IR UP MAIN LINE (EFL)			268.639	268.639	268.614	268.614	268.591	268.568	268.540	268.511	268.476	268.439	268.419	268.404	268.389	268.374	268.374	268.382	268.377	268.350	268.297	268.249	268.227	268.193	268.181	268.180	268.207	268.243	268.285		
DIFFERENCE BETWEEN DFC RAIL LEVEL AND EXG. RAIL LEVEL (PRL - ERL)			1.206	1.206	1.170	1.170	1.134	1.097	1.064	1.033	1.008	0.985	0.945	0.900	0.854	0.809	0.749	0.621	0.566	0.533	0.526	0.514	0.476	0.449	0.401	0.342	0.256	0.159	0.077		
DFC RAIL LEVEL (PRL)			270.533	270.533	270.473	270.473	270.413	270.352	270.292	270.232	270.172	270.112	270.051	269.991	269.931	269.871	269.811	269.691	269.631	269.571	269.511	269.451	269.390	269.330	269.270	269.210	269.150	269.090	269.030		
EXG.RAIL LEVEL OF NEAREST IR UP MAIN LINE(ERL)			269.327	269.327	269.302	269.302	269.279	269.256	269.228	269.199	269.164	269.127	269.107	269.092	269.077	269.062	269.062	269.070	269.065	269.038	268.985	268.937	268.915	268.881	268.869	268.868	268.888	268.895	268.931	268.953	
EQUIVALENT CHAINAGE ON DFC TRACK			1175407.5	1175407.5	1175427.5	1175427.5	1175447.5	1175467.5	1175487.5	1175507.5	1175527.5	1175547.5	1175567.5	1175587.5	1175607.5	1175627.5	1175647.5	1175667.5	1175687.5	1175707.5	1175727.3	1175747.3	1175767.2	1175787.2	1175807.2	1175827.2	1175847.2	1175866.9	1175886.8	1175906.8	
EXISTING IR CHAINAGE			286000.0	286000.0	286020.0	286020.0	286040.0	286040.0	286060.0	286060.0	286080.0	286080.0	286100.0	286100.0	286120.0	286120.0	286140.0	286140.0	286160.0	286160.0	286180.0	286180.0	286200.0	286200.0	286220.0	286220.0	286240.0	286240.0	286260.0	286260.0	286280.0

L - SECTION

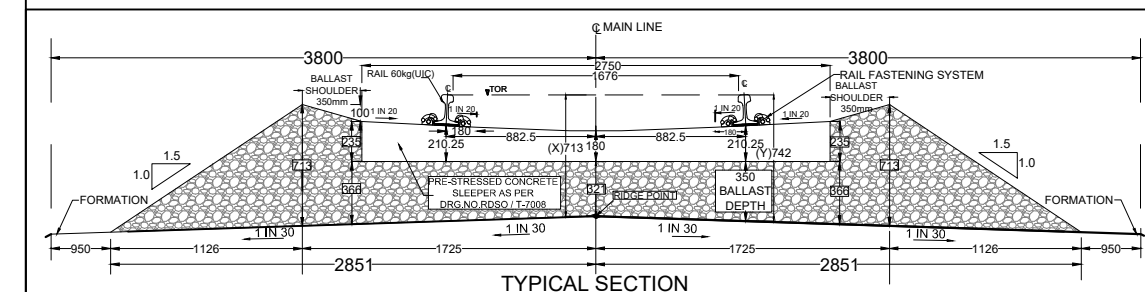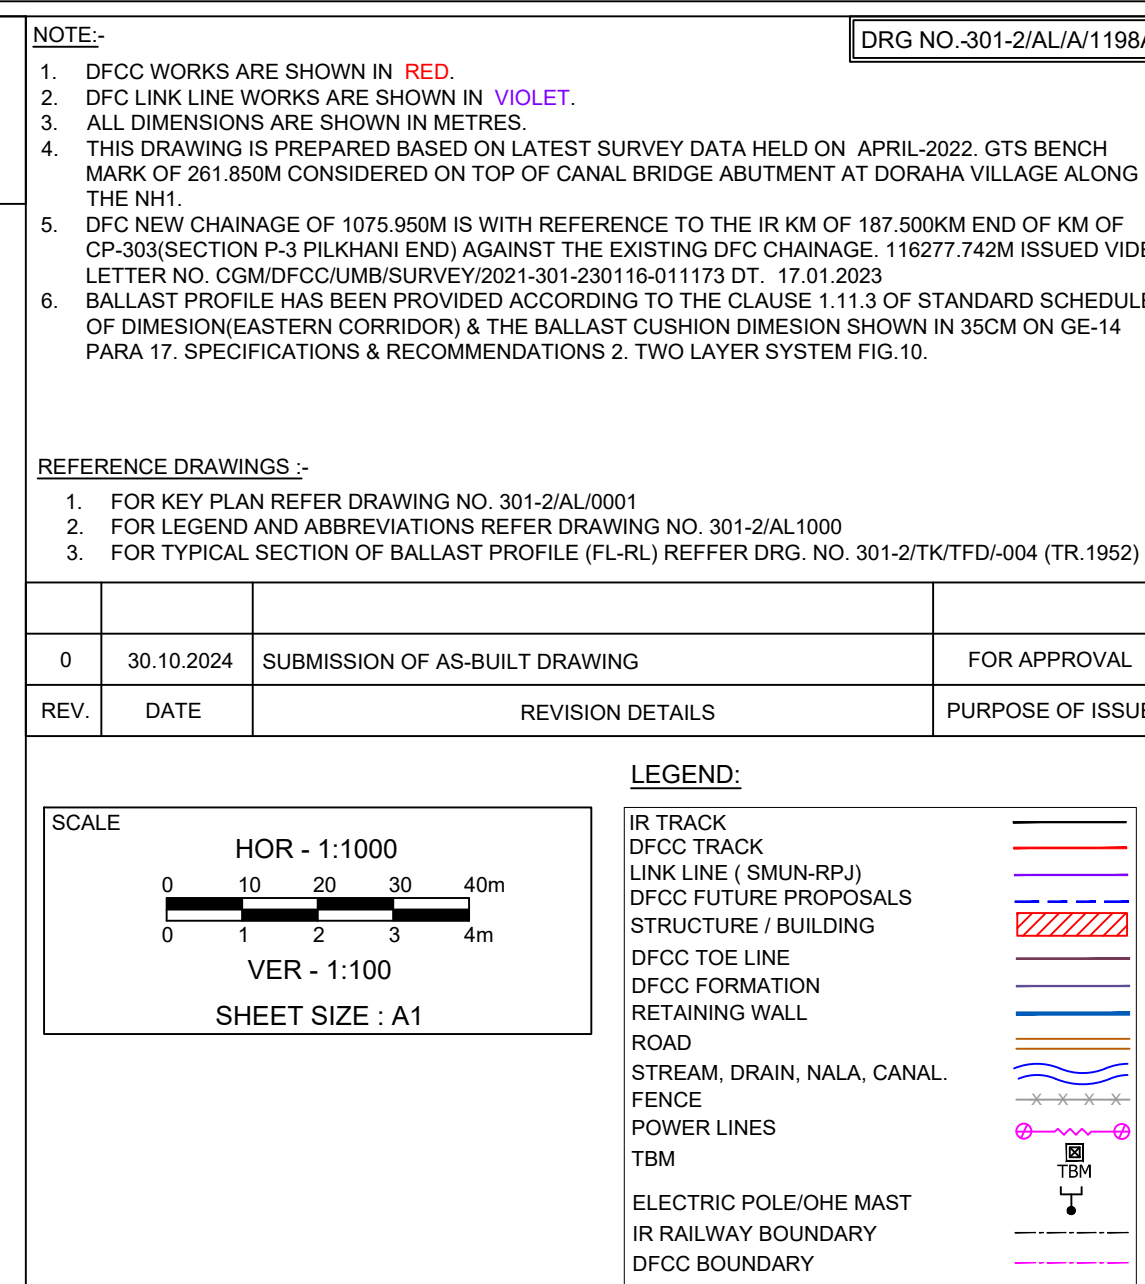

TRACK STRUCTURE		
RAIL SECTION: 60Kg/m (UIC 60Kg/m) DFC LINE: 60Kg/m (UIC 60Kg/m) IR MAIN LINE: 52Kg/m	Difference between FL- RL (Below Rail Seat)	
	IR Line	DFC
	172mm	172mm
RUBBER PAD	6mm	10mm
SLEEPER DEPTH	210mm	210mm
BALLAST CUSHION	300mm	350mm
Total Depth (FL TO RL)	688mm	742mm

OWNER



DEDICATED FREIGHT CORRIDOR CORPORATION OF INDIA LTD
(A GOVERNMENT OF INDIA ENTERPRISE)
PROJECT OFFICE (AMBALA UNIT): OLD RAILWAY COLONY (NEAR
ANAND MARKET) AMBALA CANTT-133001.
CORPORATE IDENTITY NO. : U60232DL2006GOI155068

ENGINEER:

 **DB Engineering & Consulting GmbH**
Deutsche Bahn Engineering & Consulting GmbH

CONTRACTOR: GIL - TPL JV

SUBMITTED BY	GIL - TPL JV		
	DATED	NAME	SIGNATURE
PREPARED BY			
CHECKED BY	30.10.2024	VIJAY PRATAP	
APPROVED BY	30.10.2024	PARASURAM KOTYADA	

APPROVED BY	DEUTSCHE BAHN ENGINEERING & CONSULTING GMBH		
	DATED	NAME	SIGNATURE
Sr. DE./CHIEF ENGINEER		SURESH K.YALANGI	
CHIEF TRACK ENGINEER		RAJ PAL SINGH	
T.L.		H.D. VIDJAK	

	AS BUILT DRAWING
--	---

STAMP AS-BUILT DRAWING
TR. Ref.....

ENGINEER Sign.:

EMPLOYER (DFCCIL):	DEDICATED FREIGHT CORRIDOR CORPORATION OF INDIA LIMITED
--------------------	---

--	--	--	--

--	--	--	--

--	--	--	--

--	--	--	--

AS BUILT DRAWING


TITLE	DFCC APPR. NO. -
-------	------------------

AS-BUILT PLAN AND PROFILE DFC LINK LINE	ENGG. APPR. NO. - DES. NO. - 221-DIAL (A/1423)
--	---

FROM IR KM. 286.000 TO 286.500
DEC KM. 1175.407 TO 1175.807

	DATE : 30.10.2024	A
--	-------------------	---

IR.

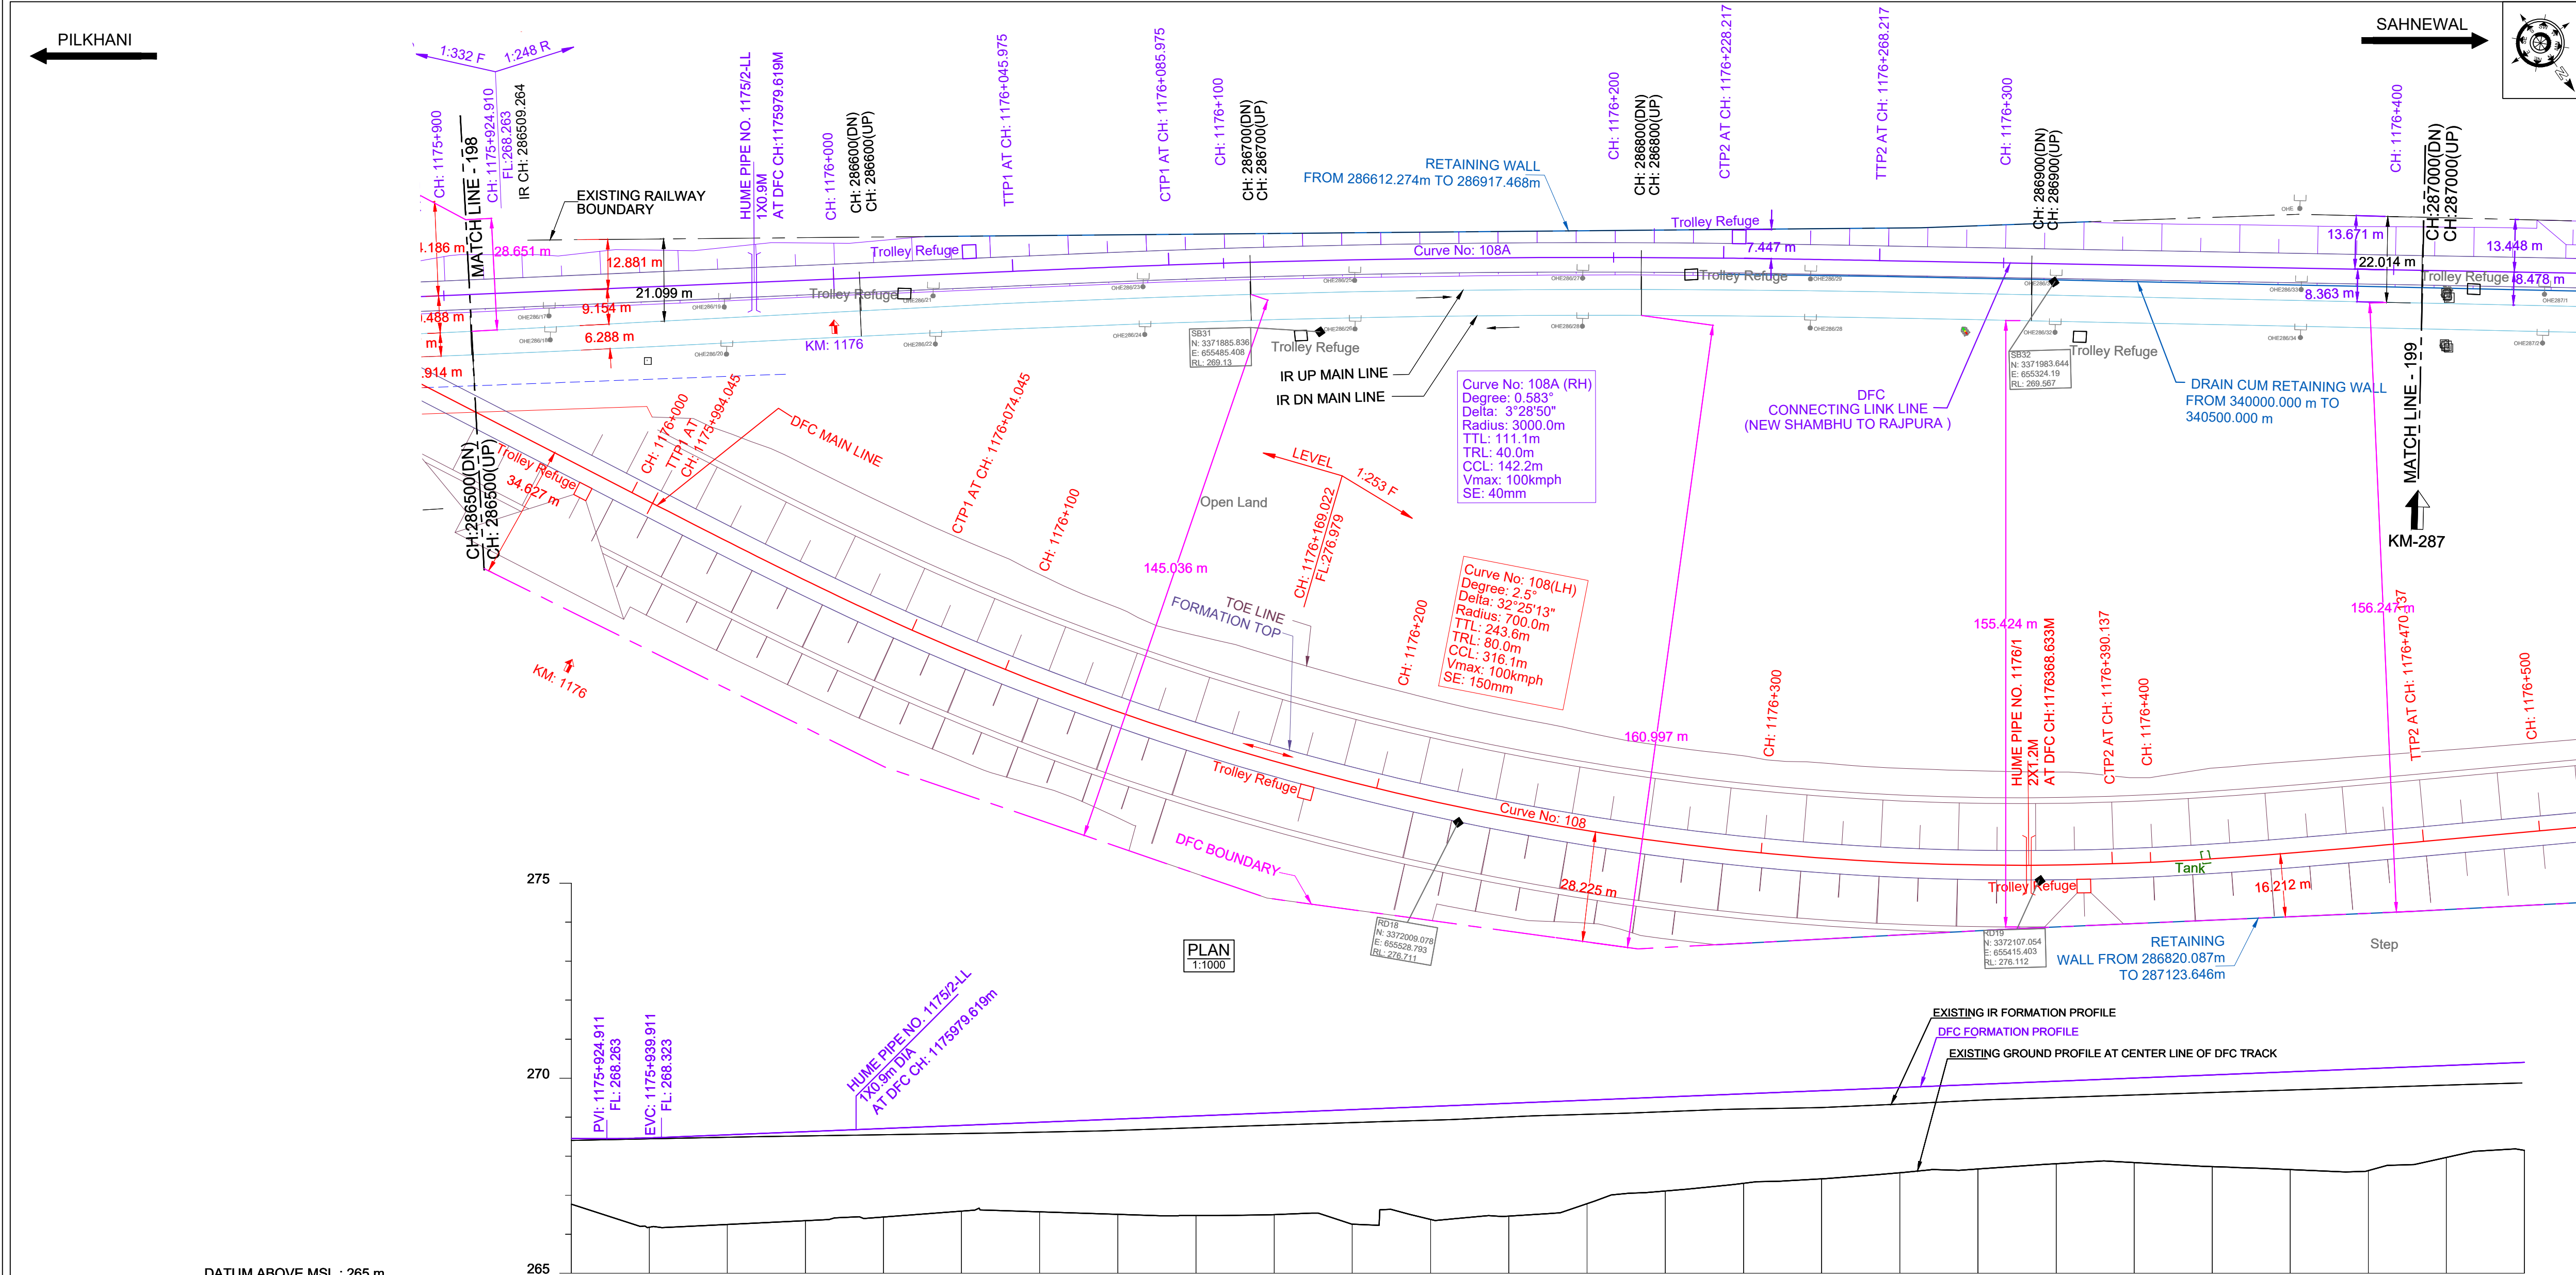

DATUM ABOVE MSL : 265 m

HORIZONTAL ALIGNMENT	L = 156.542m TL= 40m R=3000m TL= 40m L = 201.852m																			
VERTICAL ALIGNMENT	L=30 m R=4283 m L=931.900m 1 IN 248.360 R																			
TRACK DISTANCE FROM EXISTING NEAREST IR UP MAIN LINE TO DFC LINKED LINE	9.429																			
HEIGHT OF BANKING(+)/ DEPTH OF CUTTING(-) (PFL-GL)	+1.884																			
EXG GROUND LEVEL AT CENTER LINE OF DFC TRACK (GL)	266.633	266.633	265.980	265.051	265.147	265.241	265.391	265.374	265.310	265.276	265.304	265.088	265.175	265.264	265.268	265.184	265.012	265.436	265.532	265.952
EXG GROUND LEVEL AT TOE LOCATION OF DFC TRACK	264.980	265.428	265.219	265.754	265.346	265.639	265.510	265.624	265.689	265.677	265.764	265.545	265.773	265.879	265.641	265.804	265.012	265.436	265.532	265.952
DIFFERENCE BETWEEN DFC FORMATION LEVEL AND EXG.FORMATION LEVEL (PFL-EFL)	0.052	0.024	0.065	0.112	0.161	0.210	0.256	0.292	0.303	0.317	0.334	0.354	0.366	0.379	0.391	0.435	0.418	0.433	0.450	0.527
DFC FORMATION LEVEL (PFL)	268.317	268.271	268.351	268.432	268.512	268.593	268.673	268.754	268.835	268.916	269.000	269.077	269.158	269.239	269.319	269.396	269.436	269.516	269.597	270.207
EXG. FORMATION LEVEL OF EXG IR UP MAIN LINE (EFL)	268.265	268.247	268.286	268.320	268.351	268.382	268.417	268.453	268.532	268.599	268.662	268.722	268.782	268.840	268.900	268.951	269.009	269.058	269.107	269.679
DIFFERENCE BETWEEN DFC RAIL LEVEL AND EXG. RAIL LEVEL (PRL - ERL)	0.077	0.049	0.090	0.137	0.186	0.235	0.281	0.317	0.328	0.342	0.359	0.379	0.404	0.437	0.460	0.452	0.443	0.458	0.511	0.552
DFC RAIL LEVEL (PRL)	269.030	268.984	269.064	269.145	269.225	269.306	269.386	269.467	269.548	269.629	269.709	269.790	270.113	270.274	270.335	270.416	270.489	270.516	270.597	270.920
EXG.RAIL LEVEL OF NEAREST IR UP MAIN LINE(ERL)	268.953	268.935	268.974	269.008	269.039	269.070	269.105	269.151	269.220	269.287	269.350	269.410	269.628	269.822	269.823	269.893	270.058	270.058	270.122	270.367
EQUIVALENT CHAINAGE ON DFC TRACK	286500.0	286520.0	286540.0	286560.0	286580.0	286600.0	286620.0	286640.0	286660.0	286680.0	286700.0	286720.0	286740.0	286760.0	286780.0	286800.0	286820.0	286840.0	286860.0	287000.0
EXISTING IR CHAINAGE	286500.0	286520.0	286540.0	286560.0	286580.0	286600.0	286620.0	286640.0	286660.0	286680.0	286700.0	286720.0	286740.0	286760.0	286780.0	286800.0	286820.0	286840.0	286860.0	287000.0

L - SECTION

- NOTE:-
- DFCC WORKS ARE SHOWN IN RED.
 - DFC LINK LINE WORKS ARE SHOWN IN VIOLET.
 - ALL DIMENSIONS ARE SHOWN IN METRES.
 - THIS DRAWING IS PREPARED BASED ON LATEST SURVEY DATA HELD ON APRIL-2022. GTS BENCH MARK OF 261.850M CONSIDERED ON TOP OF CANAL BRIDGE ABUTMENT AT DORANA VILLAGE ALONG THE NH1.
 - DFC NEW CHAINAGE OF 1075.950M IS WITH REFERENCE TO THE IR KM OF 187.500KM END OF KM OF CP-303(SECTION P-3 PILKHANI END) AGAINST THE EXISTING DFC CHAINAGE. 116277.742M ISSUED VIDE LETTER NO. COM/DFCC/UMS/SURVEY/2021-301-230116-011173.DT. 17.01.2023.
 - BALLAST PROFILE HAS BEEN PROVIDED ACCORDING TO THE CLAUSE 1.11.3 OF STANDARD SCHEDULE OF DIMENSION(EASTERN CORRIDOR) & THE BALLAST CUSHION DIMENSION SHOWN IN 35CM ON GE-14 PARA 17. SPECIFICATIONS & RECOMMENDATIONS 2. TWO LAYER SYSTEM FIG.10.

- REFERENCE DRAWINGS :-
- FOR KEY PLAN REFER DRAWING NO. 301-2/AL/0001
 - FOR LEGEND AND ABBREVIATIONS REFER DRAWING NO. 301-2/AL/1000
 - FOR TYPICAL SECTION OF BALLAST PROFILE (FL-RL) REFER DRG. NO. 301-2/TK/TFD/004 (TR.1952)

0	30.10.2024	SUBMISSION OF AS-BUILT DRAWING	FOR APPROVAL
REV.	DATE	REVISION DETAILS	PURPOSE OF ISSUE

LEGEND:


- IR TRACK
- DFCC TRACK
- LINK LINE (SMUN-RP-J)
- DFCC FUTURE PROPOSALS
- STRUCTURE / BUILDING
- DFCC TOE LINE
- DFCC FORMATION
- RETAINING WALL
- ROAD
- STREAM, DRAIN, NALA, CANAL
- FENCE
- POWER LINES
- TBM
- ELECTRIC POLE/OHE MAST
- IR RAILWAY BOUNDARY
- DFCC BOUNDARY

SCALE

HOR - 1:1000

VER - 1:100

SHEET SIZE : A1

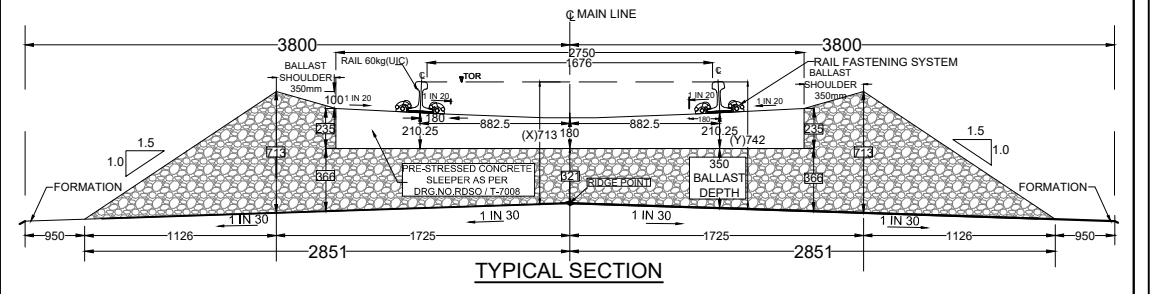

TRACK STRUCTURE		
RAIL SECTION: 60Kg/m (UIC 60Kg/m)	Difference between FL- RL (Below Rail Seat)	
DFC LINE: 60Kg/m (UIC 60Kg/m)	IR Line	DFC
IR MAIN LINE: 52Kg/m	172mm	172mm
RUBBER PAD	6mm	10mm
SLEEPER DEPTH	210mm	210mm
BALLAST CUSHION	300mm	350mm
Total Depth (FL TO RL)	688mm	742mm

OWNER: DEDICATED FREIGHT CORRIDOR CORPORATION OF INDIA LTD. (A GOVERNMENT OF INDIA ENTERPRISE)
PROJECT OFFICE(AMBALA UNIT): OLD RAILWAY COLONY (NEAR ANAND MARKET),AMBALA CANTT-133001.
CORPORATE IDENTITY NO. : U60232DL2006GGI155068

ENGINEER: DB Engineering & Consulting GmbH
Deutsche Bahn Engineering & Consulting GmbH

CONTRACTOR: GIL - TPL JV
GAR TATA

SUBMITTED BY	GIL - TPL JV		
	DATED	NAME	SIGNATURE
PREPARED BY			
CHECKED BY	30.10.2024	VIJAY PRATAP	
APPROVED BY	30.10.2024	PARASURAM KOTYADA	

APPROVED BY	DEUTSCHE BAHN ENGINEERING & CONSULTING GMBH		
	DATED	NAME	SIGNATURE
Sr. DE./CHIEF ENGINEER		SURESH K.YALANGI	
CHIEF TRACK ENGINEER		RAJ PAL SINGH	
T.L.		H.D. VIDJAK	

STAMP	A AS-BUILT DRAWING TR. Ref..... ENGINEER Sign.:		
EMPLOYER (DFCCIL):	DEDICATED FREIGHT CORRIDOR CORPORATION OF INDIA LTD.		

AS BUILT DRAWING

TITLE: AS-BUILT PLAN AND PROFILE DFC LINK LINE FROM IR KM: 286.500 TO 287.000 DFC KM: 1175.907 TO 1176.408

DFCC APPR. NO. -

ENGG. APPR. NO. -


DRG. NO. - 301-2/AL/A/1199A


SHEET NO. : 1 OF 1



DATE : 30.10.2024

STATUS: A

TR.

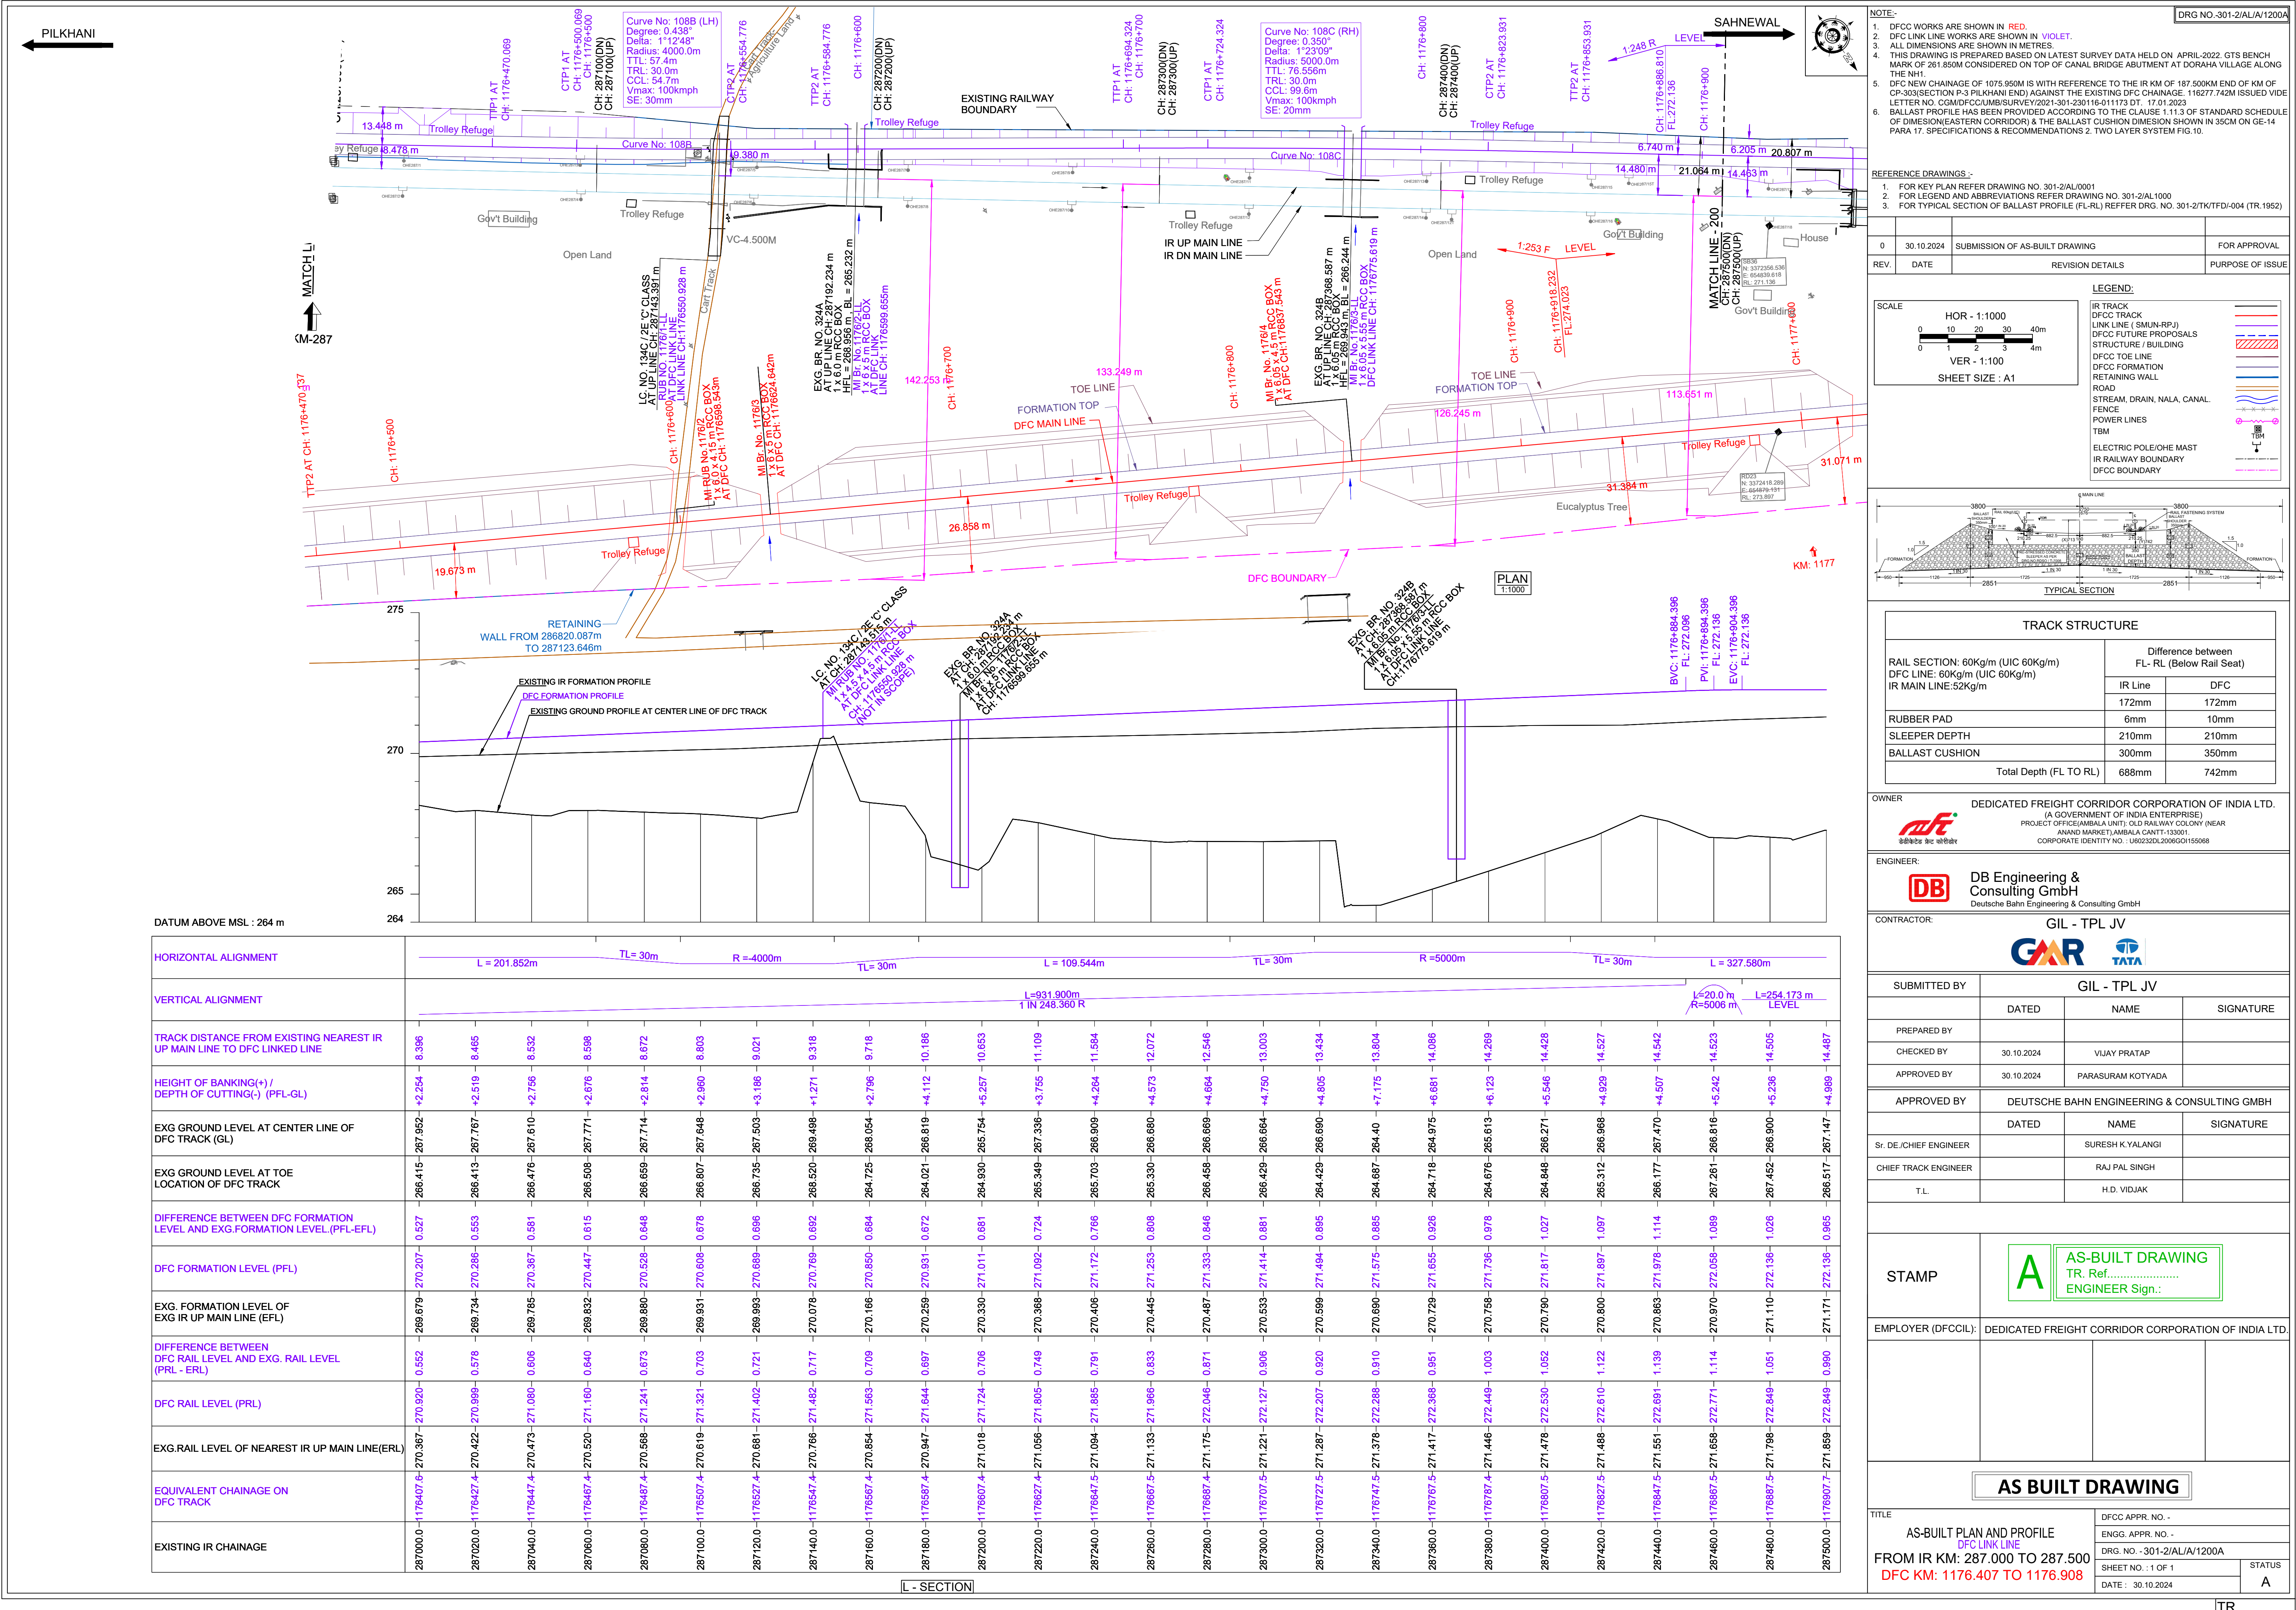

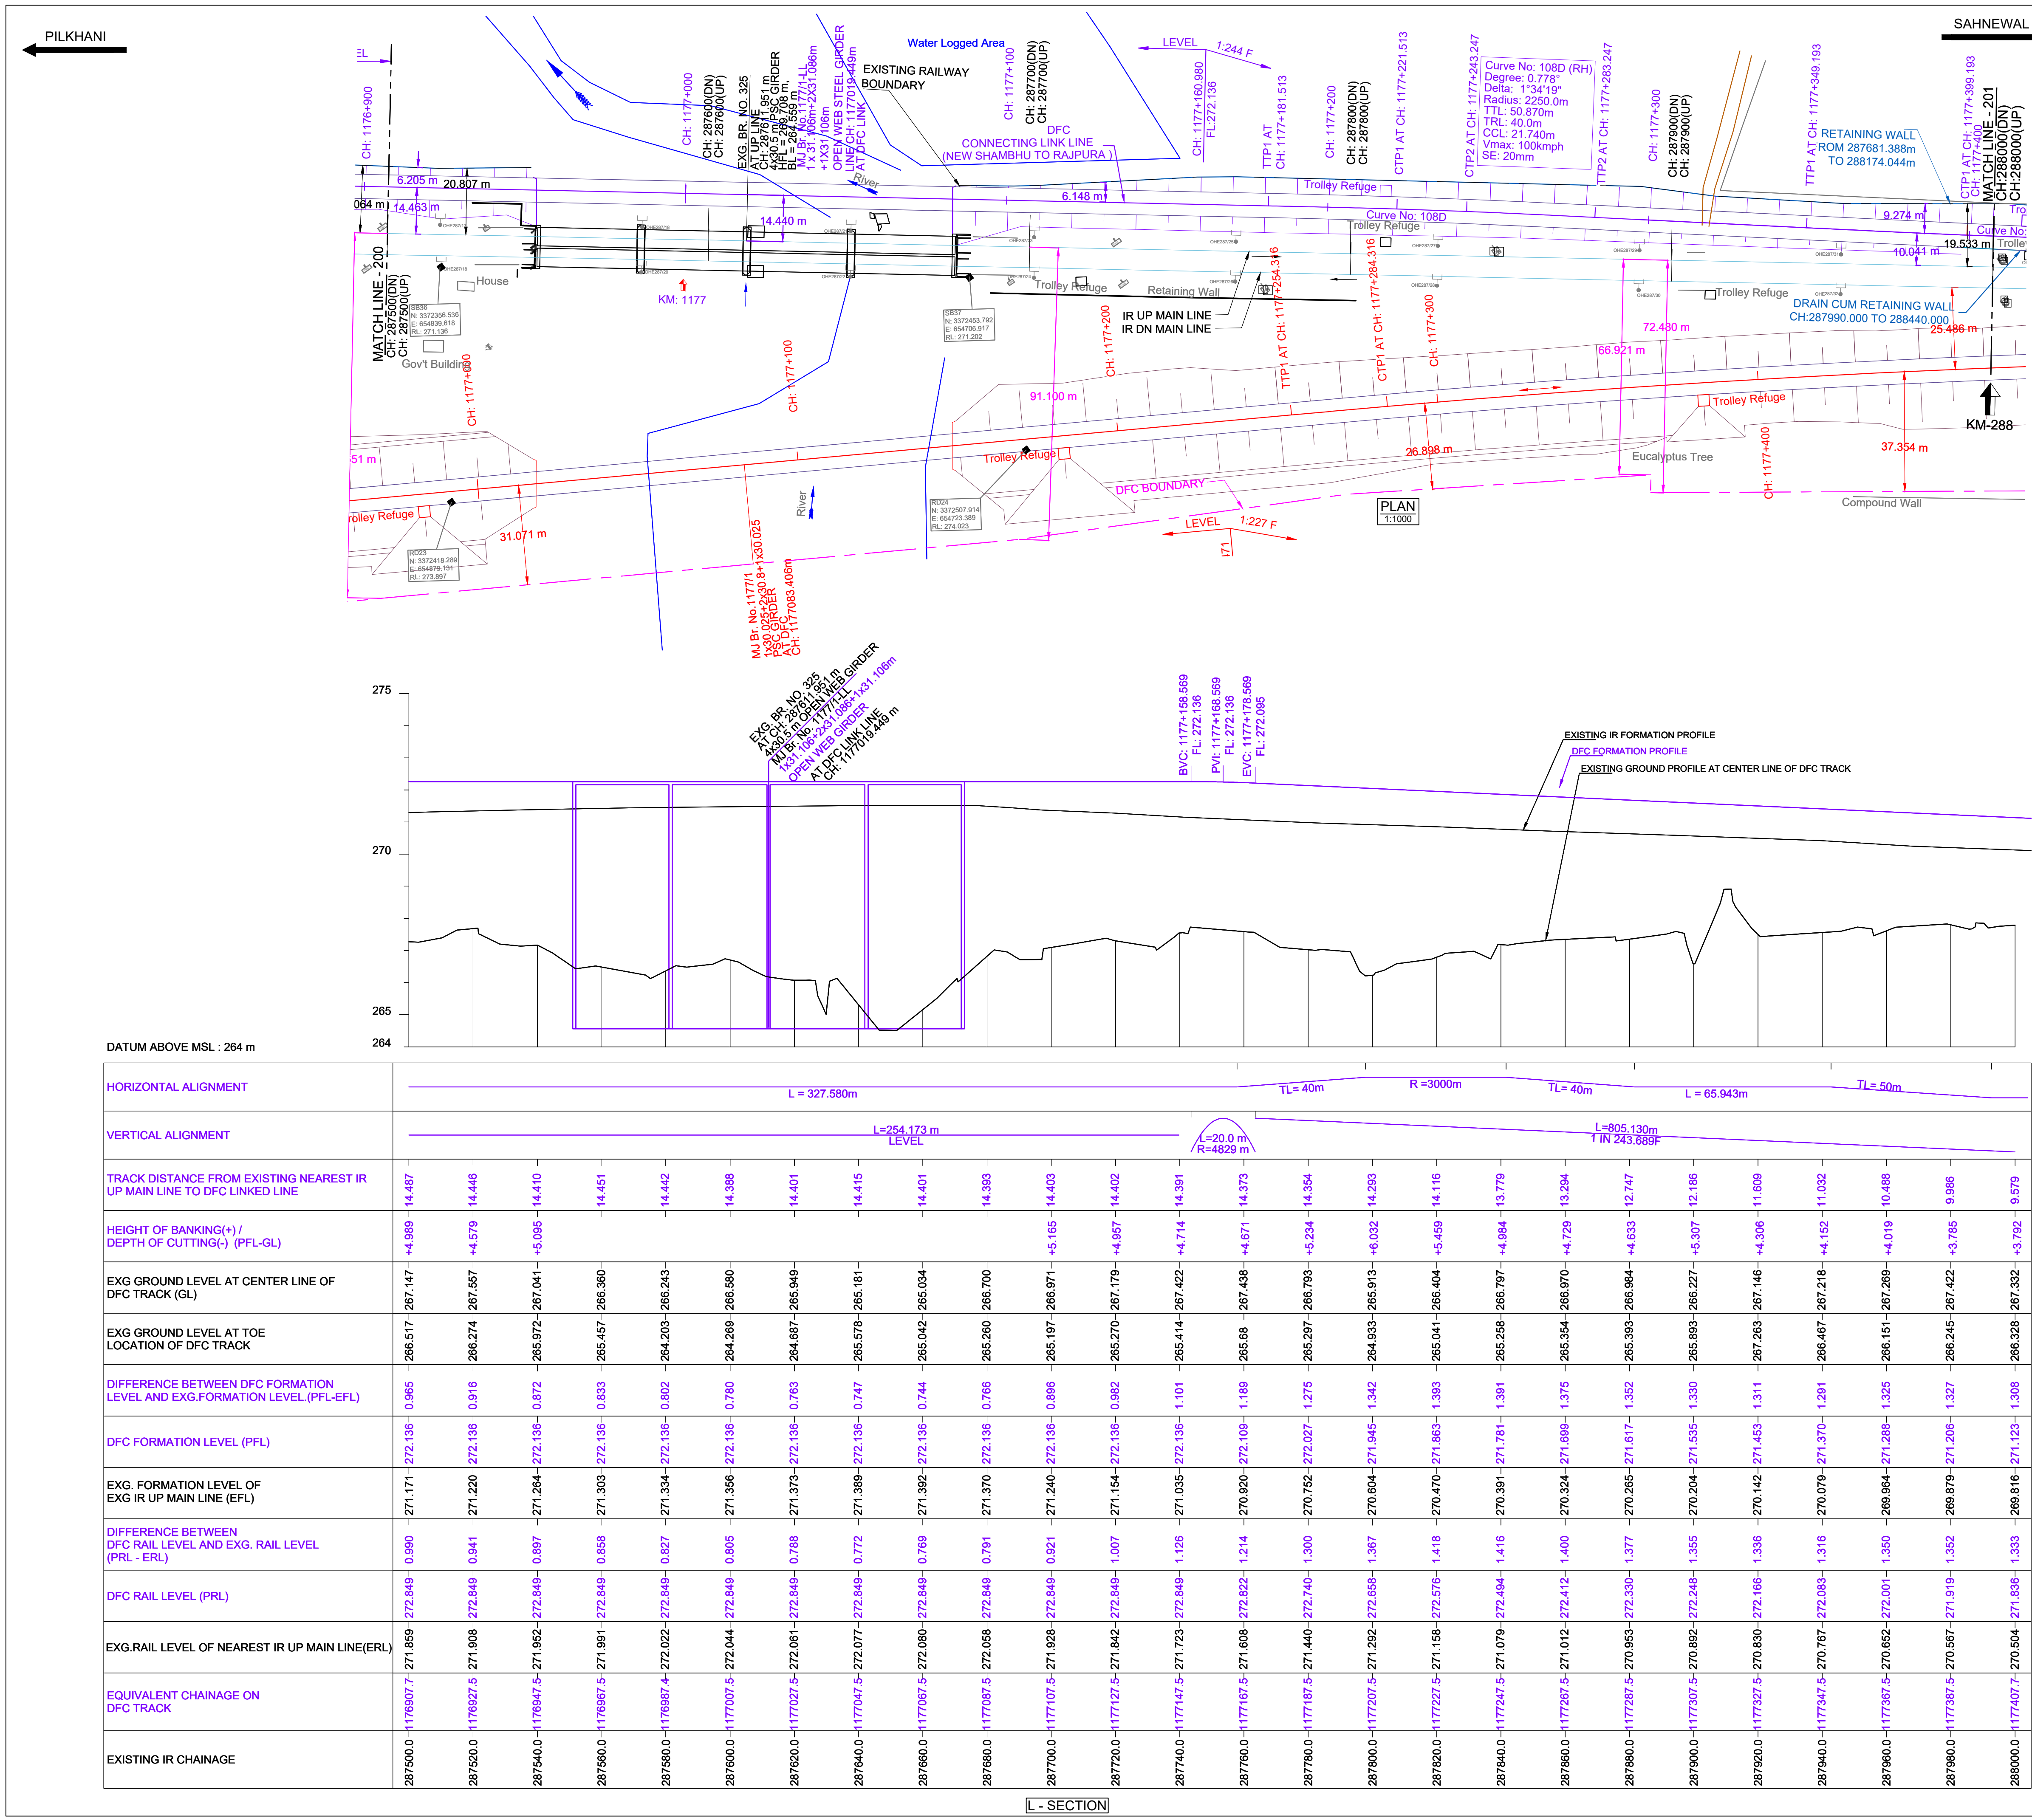

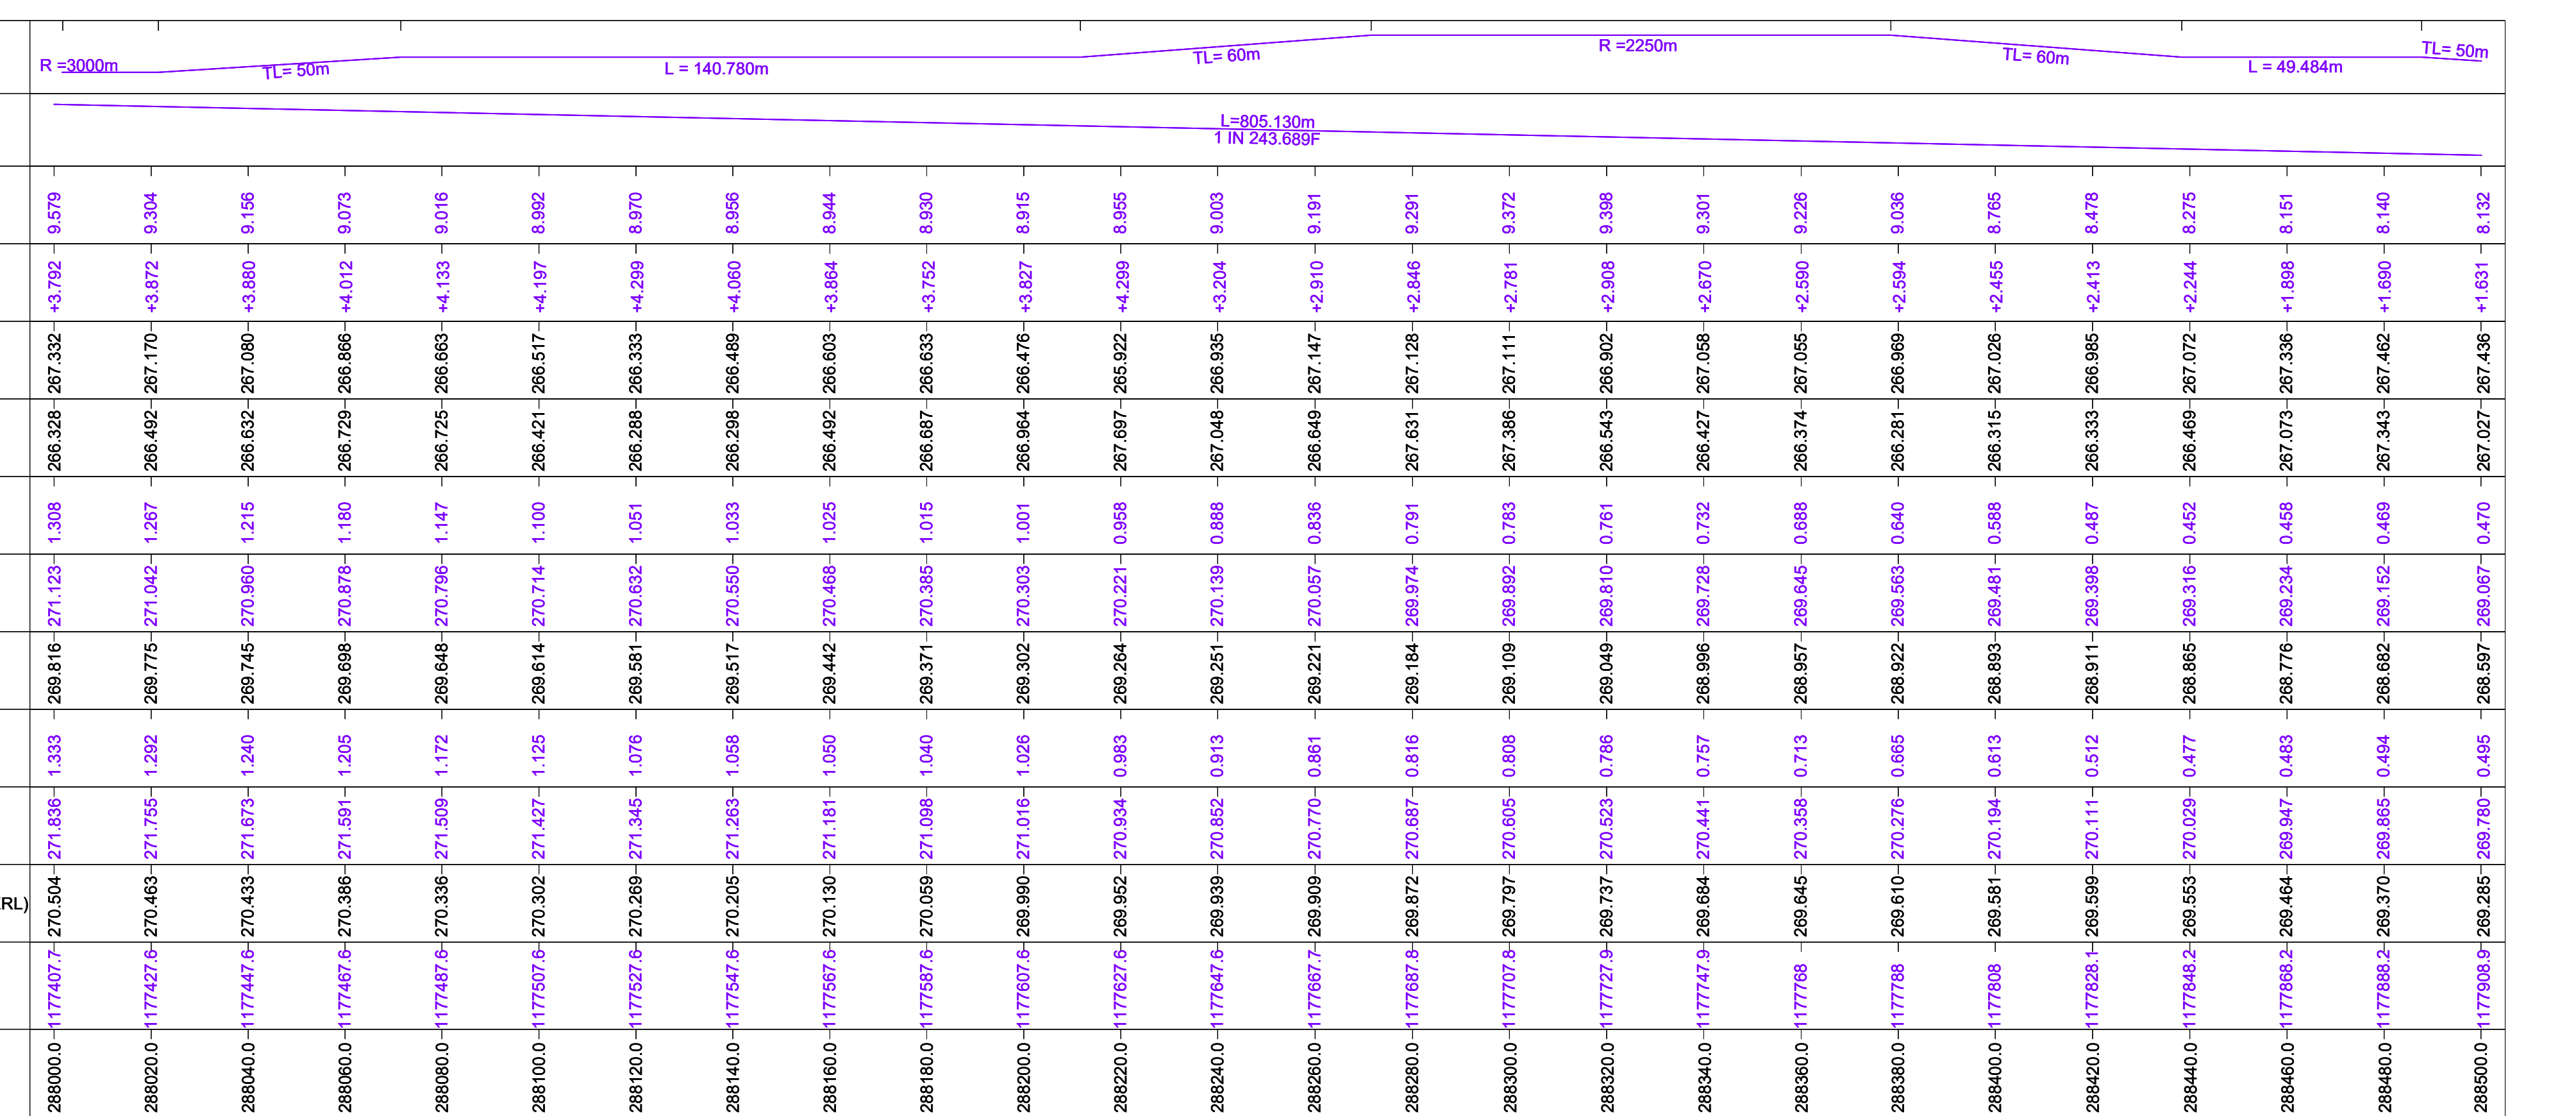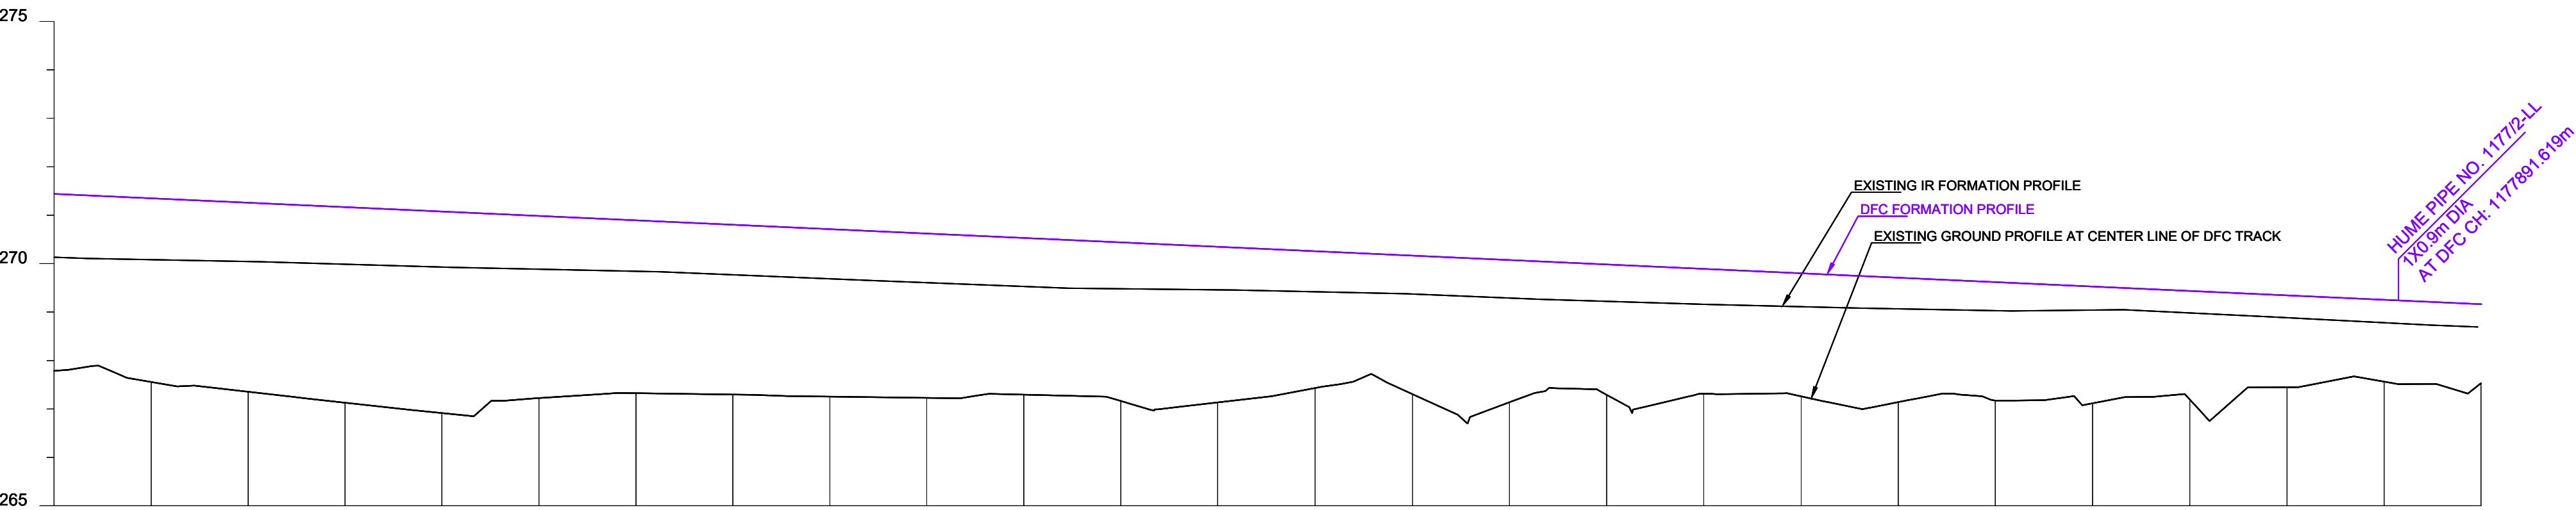

NOTE:-


1. DFCG WORKS ARE SHOWN IN RED .	DRG NO. 301-2/IALA/1202A
2. DFC LINK LINE WORKS ARE SHOWN IN VIOLET .	
3. ALL DIMENSIONS ARE SHOWN IN METRES.	
4. THIS DRAWING IS PREPARED BASED ON THE LATEST SURVEY DATA HELD ON APRIL 2022. GTS BENCH MARK OF 261.850M CONSIDERED ON TOP OF CANAL BRIDGE ABUTMENT AT DOORAH VILLAGE ALONG THE NH1.	
5. DFCW CHAINAGE OF 1075.950M IS WITH REFERENCE TO THE IR KM OF 187.500M END OF KM OF CP-303(SECTION P-3 PLIKHANI END) AGAINST THE EXISTING DFCW CHAINAGE. 116277.742M ISSUED VIDE LETTER NO. CM/GMDC/CIAMB/SURVEY/2021-301-2301-16101173 DT. 17.01.2023	
6. BALLAST PROFILE HAS BEEN PROVIDED ACCORDING TO THE CLAUSE 11.3 OF STANDARD SCHEDULE OF CONDITIONS (GENERAL CONDITIONS) & THE BALLAST CUSHION DIMENSION SHOWN IN 35CM ON GE-14 PARA 17. SPECIFICATIONS & RECOMMENDATIONS 2. TWO LAYER SYSTEM FIG.10.	

REFERENCE DRAWINGS :-

1. FOR KEY PLAN REFER DRAWING NO. 301-2/AL/0001
2. FOR LEGEND AND ABBREVIATIONS REFER DRAWING NO. 301-2/AL/1000
3. FOR TYPICAL SECTION OF BALLAST PROFILE (FL-RL) REFER DRG. NO. 301-2/TK/TFD/-004 (TR.1952)

0	30.10.2024	SUBMISSION OF AS-BUILT DRAWING	FOR APPROVAL
REV.	DATE	REVISION DETAILS	PURPOSE OF ISSUE

SCALE	LEGEND
HOR : 1:1000 VER : 1:100 SHEET SIZE : A1	

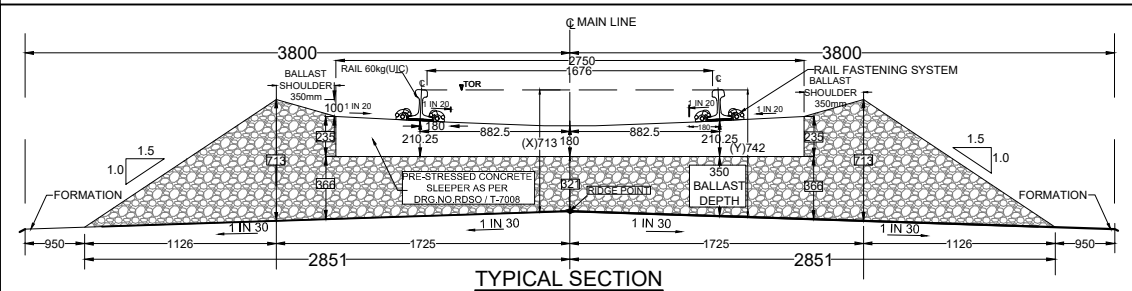

TRACK STRUCTURE		
RAIL SECTION: 60Kg/m (UIC 60Kg/m) DFC LINE: 60Kg/m (UIC 60Kg/m) IR MAIN LINE: 52Kg/m	Difference between FL- RL (Below Rail Seat)	
	IR Line	DFC
	172mm	172mm
RUBBER PAD	6mm	10mm
SLEEPER DEPTH	210mm	210mm
BALLAST CUSHION	300mm	350mm
Total Depth (FL TO RL)	688mm	742mm

OWNER DEDICATED FREIGHT CORRIDOR CORPORATION OF INDIA LTD.
(A GOVERNMENT OF INDIA ENTERPRISE)
PROJECT OFFICE (AMBALA UNIT): OLD RAILWAY COLONY (NEAR
ANAND MARKET), AMBALA CANTT-133001.
CORPORATE IDENTITY NO. : U60232DL2006GO115568

ENGINEER:

 DB Engineering & Consulting GmbH
Deutsche Bahn Engineering & Consulting GmbH

CONTRACTOR: GIL - TPL JV

SUBMITTED BY	GIL - TPL JV		
	DATED	NAME	SIGNATURE
PREPARED BY			
CHECKED BY	30.10.2024	VIJAY PRATAP	
APPROVED BY	30.10.2024	PARASURAM KOTYADA	

APPROVED BY	DEUTSCHE BAHN ENGINEERING & CONSULTING GMBH		
	DATED	NAME	SIGNATURE
Sr. DE/CHIEF ENGINEER		SURESH K.YALANGI	
CHIEF TRACK ENGINEER		RAJ PAL SINGH	
T.L.		H.D. VIDJAK	

[illegible]

	A AS-BUILT DRAWING
--	--

STAMP	A	AS BUILT DRAWING TR. Ref..... ENGINEER Sign.:
-------	----------	---

EMPLOYER (DECCIL):	DEDICATED FREIGHT CORRIDOR CORPORATION OF INDIA LTD.
--------------------	--

EMPLOYER (if any):	DEDICATED FREIGHT CORRIDOR CORPORATION OF INDIA LTD.		

--	--	--	--

--	--	--	--

--	--	--	--

AS PLUM DRAINING

AS BUILT DRAWING

TITLE	DFCC APPR. NO. -
AS-BUILT PLAN AND PROFILE	ENGG. APPR. NO. -



FROM IR KM: 288.000 TO 288.500	DRG. NO. -301-2/AL/A/1202A	
REQ KM: 1177.100 TO 1177.200	SHEET NO. : 1 OF 1	STATUS

DFC KM: 1177.408 TO 1177.909	DATE : 30.10.2024	A
------------------------------	-------------------	---


TR.

PILKHANI

SAHNEWAL

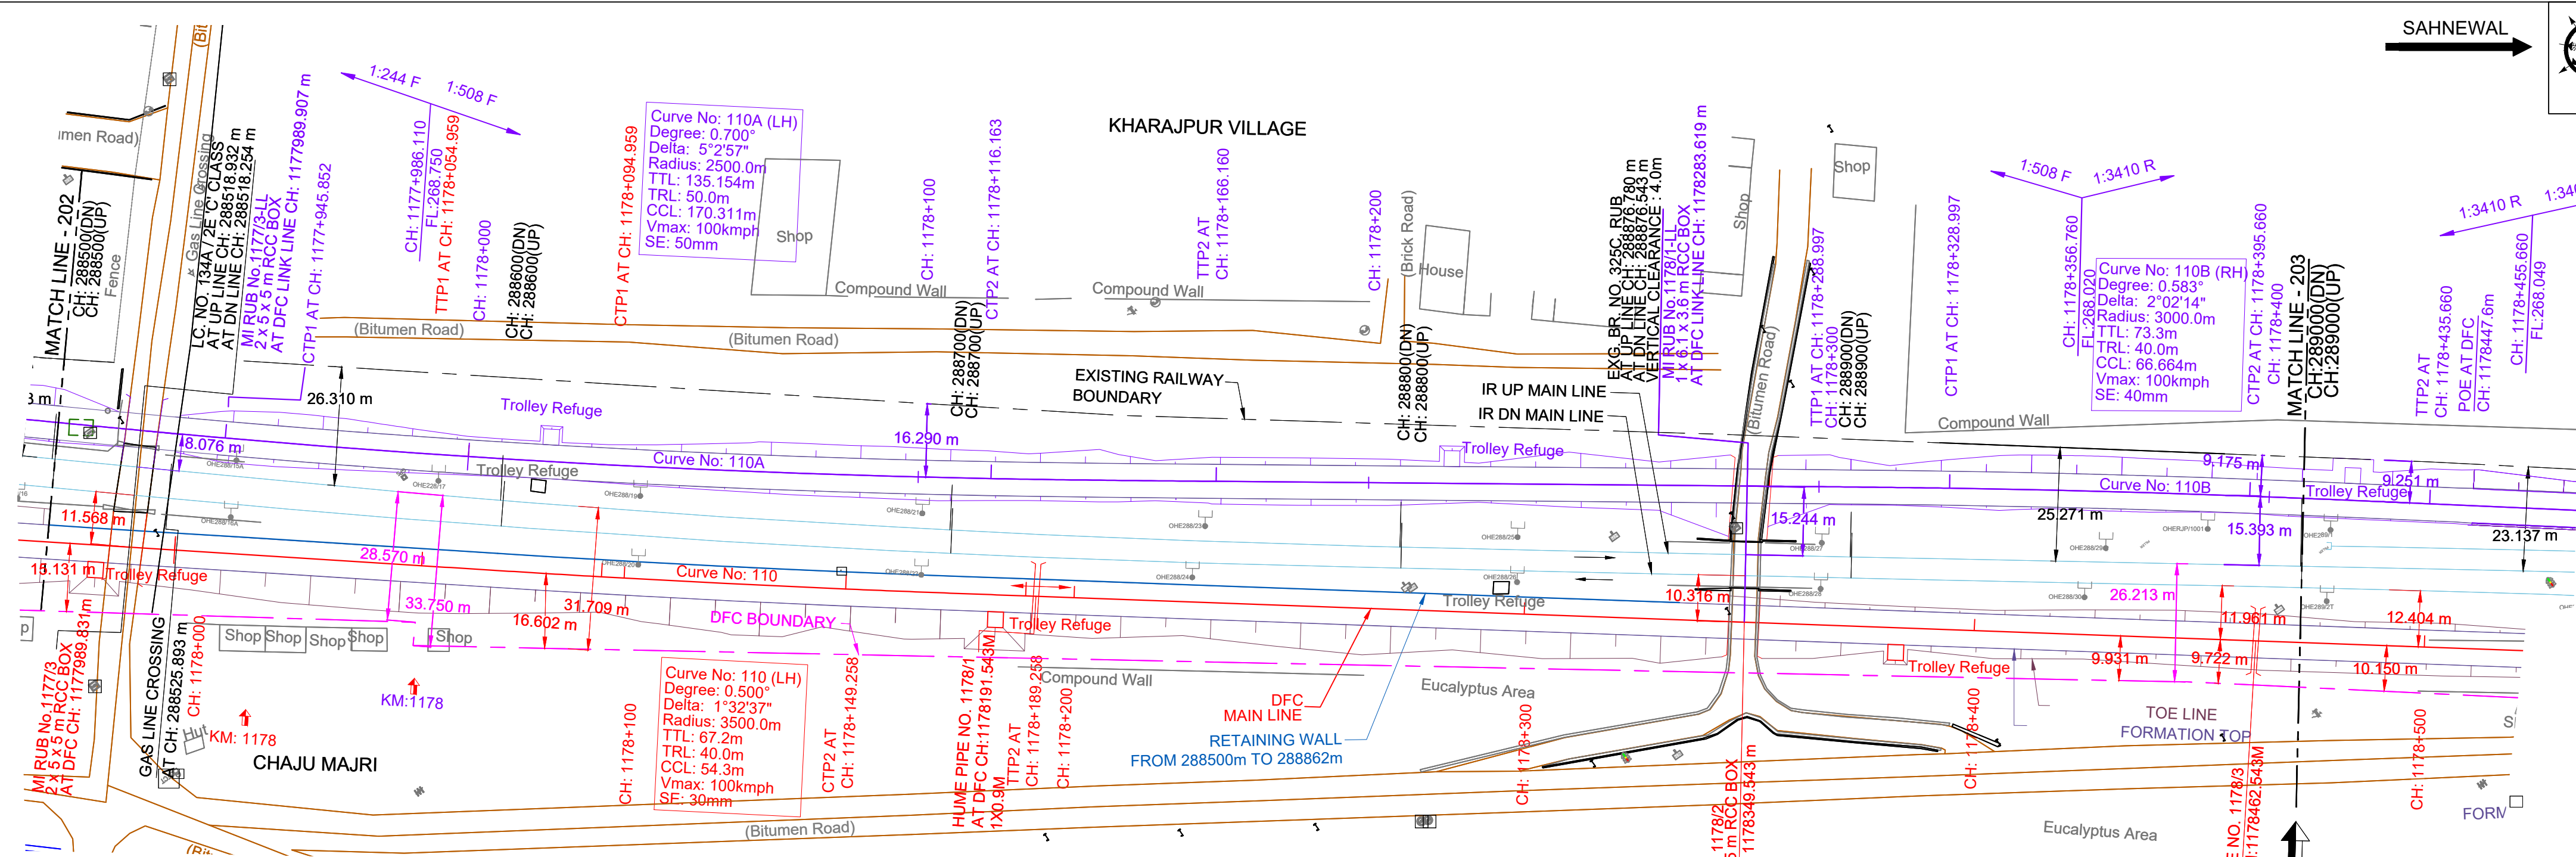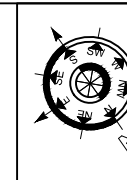

PLAN
1:1000

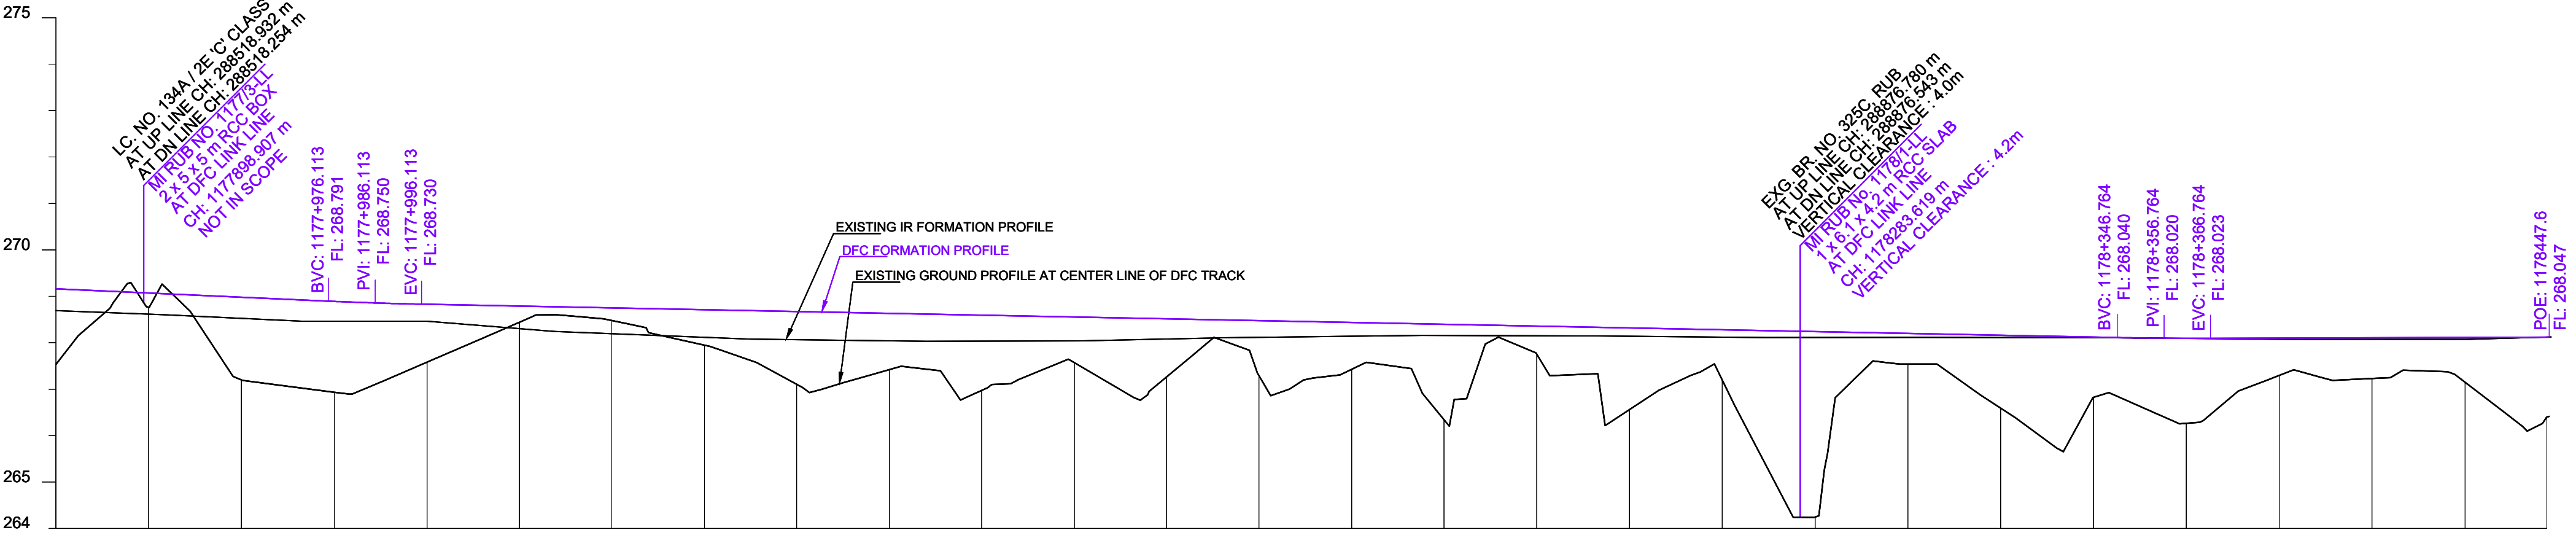

DATUM ABOVE MSL : 264 m

HORIZONTAL ALIGNMENT																				
VERTICAL ALIGNMENT																				
TRACK DISTANCE FROM EXISTING NEAREST IR UP MAIN LINE TO DFC LINKED LINE	8.132	8.163	8.259	8.498	8.880	9.228	9.586													
HEIGHT OF BANKING(+) / DEPTH OF CUTTING(-) (PFL-GL)	+1.631	+0.306	+1.783	+1.957	+1.241	+0.346	+0.271	+0.586												
EXG GROUND LEVEL AT CENTER LINE OF DFC TRACK (GL)	267.436	268.681	267.122	266.866	267.504	268.360	268.396													
EXG GROUND LEVEL AT TOE LOCATION OF DFC TRACK	267.027	268.986	267.548	267.271	267.846	268.240	268.171													
DIFFERENCE BETWEEN DFC FORMATION LEVEL AND EXG.FORMATION LEVEL (PFL-EFL)	0.470	0.457	0.458	0.429	0.362	0.486	0.556													
DFC FORMATION LEVEL (PFL)	268.067	268.987	268.905	268.823	268.746	268.707	268.667													
EXG. FORMATION LEVEL OF EXG IR UP MAIN LINE (EFL)	268.597	268.530	268.447	268.394	268.393	268.220	268.112													
DIFFERENCE BETWEEN DFC RAIL LEVEL AND EXG. RAIL LEVEL (PRL - ERL)	0.495	0.482	0.483	0.454	0.387	0.511	0.581													
DFC RAIL LEVEL (PRL)	269.780	269.700	269.618	269.536	269.459	269.420	269.380													
EXG.RAIL LEVEL OF NEAREST IR UP MAIN LINE(ERL)	269.285	269.218	269.135	269.082	269.071	268.908	268.800													
EQUIVALENT CHAINAGE ON DFC TRACK (LINK LINE)	-1177908.9	-1177928.3	-1177948.3	-1177968.3	-1177988.3	-1178008.2	-1178028.1													
EXISTING IR CHAINAGE	288500.0	288520.0	288540.0	288560.0	288580.0	288600.0	288620.0													

L - SECTION

- NOTE:-
- DFCC WORKS ARE SHOWN IN RED.
 - DFC LINK LINE WORKS ARE SHOWN IN VIOLET.
 - ALL DIMENSIONS ARE SHOWN IN METRES.
 - THIS DRAWING IS PREPARED BASED ON LATEST SURVEY DATA HELD ON APRIL-2022. GTS BENCH MARK OF 261.850M CONSIDERED ON TOP OF CANAL BRIDGE ABUTMENT AT DORANA VILLAGE ALONG THE NH1.
 - DFC NEW CHAINAGE OF 1075.950M IS WITH REFERENCE TO THE IR KM OF 187.500KM END OF KM OF CP-303(SECTION P-3 PILKHANI END) AGAINST THE EXISTING DFC CHAINAGE. 116277.742M ISSUED VIDE LETTER NO. COM/DFCC/MSURV/2021-301-230116-011173 DT. 17.01.2023.
 - BALLAST PROFILE HAS BEEN PROVIDED ACCORDING TO THE CLAUSE 1.11.3 OF STANDARD SCHEDULE OF DIMENSION(EASTERN CORRIDOR) & THE BALLAST CUSHION DIMENSION SHOWN IN 35CM ON GE-14 PARA 17. SPECIFICATIONS & RECOMMENDATIONS 2. TWO LAYER SYSTEM FIG.10.

- REFERENCE DRAWINGS:-
- FOR KEY PLAN REFER DRAWING NO. 301-2/AL/0001
 - FOR LEGEND AND ABBREVIATIONS REFER DRAWING NO. 301-2/AL/1000
 - FOR TYPICAL SECTION OF BALLAST PROFILE (FL-RL) REFER DRG. NO. 301-2/TK/TFD/004 (TR.1952)

REV.	DATE	SUBMISSION OF AS-BUILT DRAWING	PURPOSE OF ISSUE
0	30.10.2024	SUBMISSION OF AS-BUILT DRAWING	FOR APPROVAL

LEGEND:


- IR TRACK
- DFCC TRACK
- LINK LINE (SMUN-RP-J)
- DFCC FUTURE PROPOSALS
- STRUCTURE / BUILDING
- DFCC TOE LINE
- DFCC FORMATION
- RETAINING WALL
- ROAD
- STREAM, DRAIN, NALA, CANAL
- FENCE
- POWER LINES
- TBM
- ELECTRIC POLE/OHE MAST
- IR RAILWAY BOUNDARY
- DFCC BOUNDARY

SCALE

HOR - 1:1000

VER : 1:100

SHEET SIZE : A1

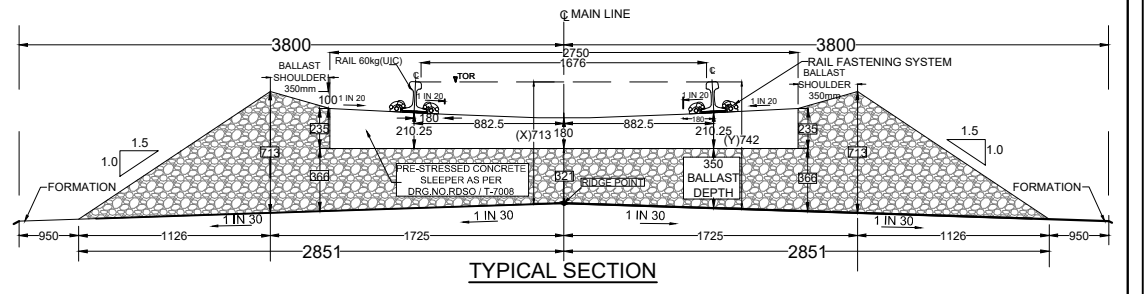

TRACK STRUCTURE		
RAIL SECTION: 60Kg/m (UIC 60Kg/m) DFC LINE: 60Kg/m (UIC 60Kg/m) IR MAIN LINE: 52Kg/m	Difference between FL- RL (Below Rail Seat)	
	IR Line	DFC
RUBBER PAD	172mm	172mm
SLEEPER DEPTH	6mm	10mm
SLEEPER DEPTH	210mm	210mm
BALLAST CUSHION	300mm	350mm
Total Depth (FL TO RL)	688mm	742mm

OWNER: DEDICATED FREIGHT CORRIDOR CORPORATION OF INDIA LTD. (A GOVERNMENT OF INDIA ENTERPRISE)
PROJECT OFFICE(AMBALA UNIT): OLD RAILWAY COLONY (NEAR ANAND MARKET),AMBALA CANTT-133001.
CORPORATE IDENTITY NO. : U60232DL2006GGI155068

ENGINEER: DB Engineering & Consulting GmbH
Deutsche Bahn Engineering & Consulting GmbH

CONTRACTOR: GIL - TPL JV
GAR TATA

SUBMITTED BY	GIL - TPL JV		
	DATED	NAME	SIGNATURE
PREPARED BY			
CHECKED BY	30.10.2024	VIJAY PRATAP	
APPROVED BY	30.10.2024	PARASURAM KOTYADA	

APPROVED BY	DEUTSCHE BAHN ENGINEERING & CONSULTING GMBH		
	DATED	NAME	SIGNATURE
Sr. DE./CHIEF ENGINEER		SURESH K.YALANGI	
CHIEF TRACK ENGINEER		RAJ PAL SINGH	
T.L.		H.D. VIDJAK	

STAMP

A AS-BUILT DRAWING
TR. Ref:.....
ENGINEER Sign.:

EMPLOYER (DFCCIL): DEDICATED FREIGHT CORRIDOR CORPORATION OF INDIA LTD.

AS BUILT DRAWING

TITLE: AS-BUILT PLAN AND PROFILE
DFCC LINK LINE
FROM IR KM: 288.500 TO 289.037
DFC KM: 1177.909 TO 1178.448

DFCC APPR. NO. -
ENGG. APPR. NO. -
DRG. NO. : 301-2/AL/A/1203A
SHEET NO. : 1 OF 1
DATE : 30.10.2024

STATUS: A

TR.