
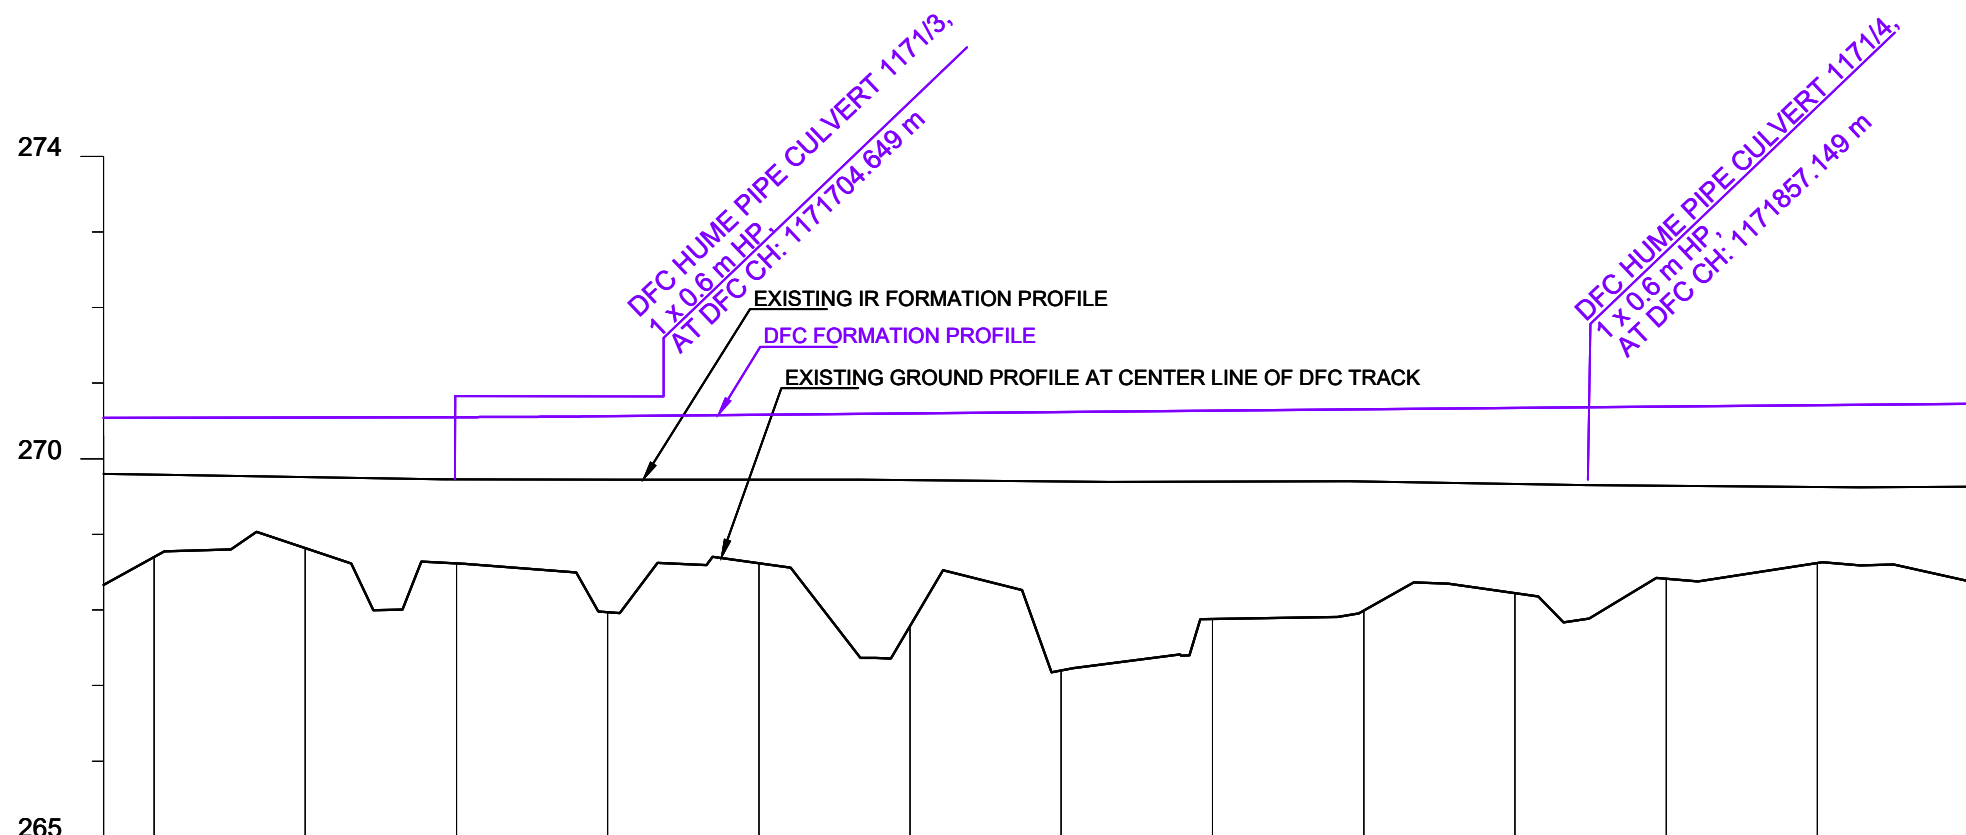


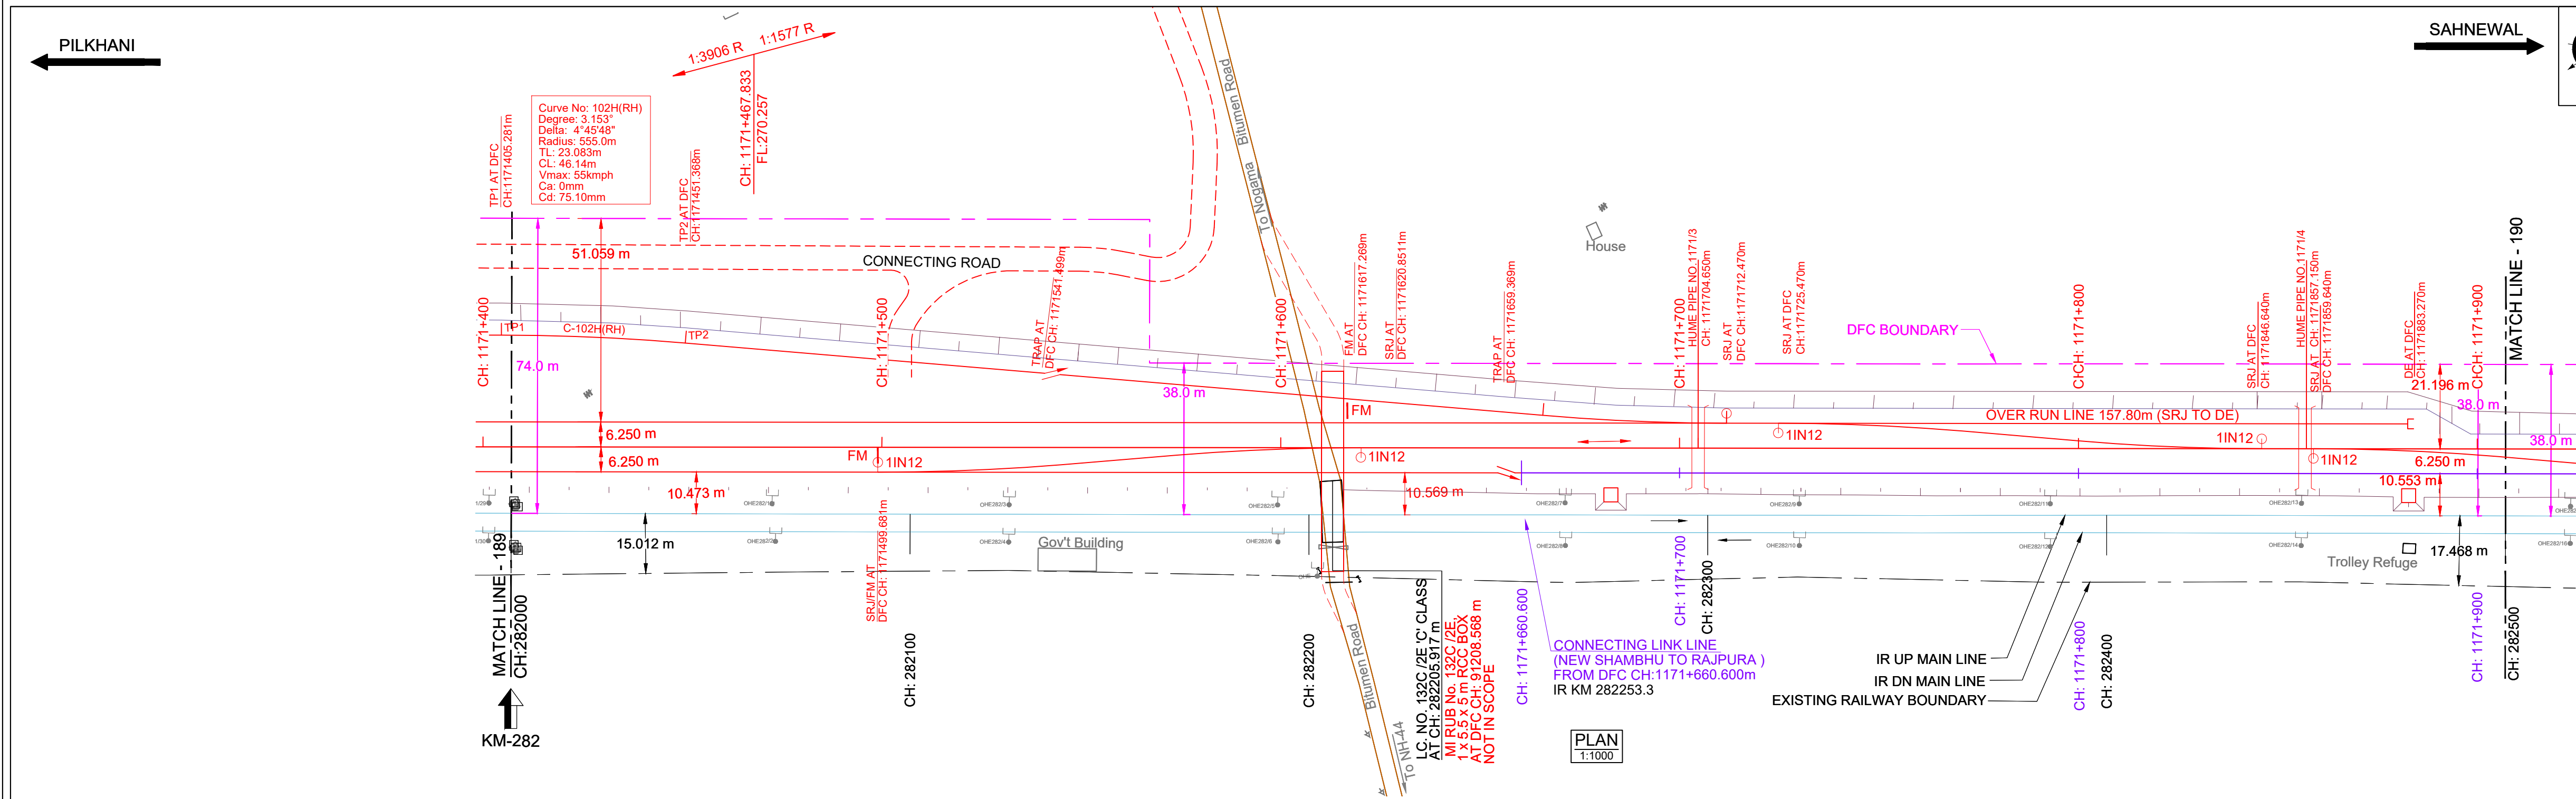


DATUM ABOVE MSL : 265 m

HORIZONTAL ALIGNMENT	L = 634.819m											
VERTICAL ALIGNMENT	L=527.300 m 1 IN 1577.233 R											
TRACK DISTANCE FROM EXISTING NEAREST IR UP MAIN LINE TO DFC LINKED LINE	-10.564	-10.564	-10.566	-10.570	-10.572	-10.597	-10.597	-10.545	-10.506	-10.479	-10.505	-10.549
HEIGHT OF BANKING(+) / DEPTH OF CUTTING(-) (PFL-GL)	+2.210	+1.841	+1.727	+1.934	+2.592	+1.963	+2.816	+3.418	+2.756	+2.661	+2.447	+2.087
EXG GROUND LEVEL AT CENTER LINE OF DFC TRACK (GL)	-268.170	-268.543	-268.669	-268.475	-267.830	-268.472	-267.631	-267.042	-267.717	-267.824	-268.052	-268.436
EXG GROUND LEVEL AT TOE LOCATION OF DFC TRACK	-267.453	-267.544	-267.386	-267.062	-266.663	-266.807	-266.523	-266.380	-266.370	-266.649	-266.697	-267.203
DIFFERENCE BETWEEN DFC FORMATION LEVEL AND EXG.FORMATION LEVEL (PFL-EFL)	0.741	0.752	0.788	0.823	0.840	0.858	0.892	0.918	0.938	0.954	1.005	1.062
DFC FORMATION LEVEL (PFL)	-270.390	-270.384	-270.397	-270.409	-270.422	-270.435	-270.447	-270.460	-270.473	-270.485	-270.498	-270.523
EXG. FORMATION LEVEL OF EXG IR UP MAIN LINE (EFL)	-269.639	-269.632	-269.608	-269.587	-269.582	-269.577	-269.566	-269.542	-269.535	-269.531	-269.493	-269.442
DIFFERENCE BETWEEN DFC RAIL LEVEL AND EXG. RAIL LEVEL (PRL - ERL)	0.766	0.777	0.813	0.848	0.865	0.883	0.907	0.943	0.963	0.979	1.030	1.107
DFC RAIL LEVEL (PRL)	-271.093	-271.097	-271.110	-271.122	-271.135	-271.148	-271.160	-271.173	-271.186	-271.198	-271.211	-271.236
EXG.RAIL LEVEL OF NEAREST IR UP MAIN LINE(ERL)	-270.327	-270.320	-270.296	-270.275	-270.270	-270.265	-270.254	-270.230	-270.223	-270.219	-270.181	-270.130
EQUIVALENT CHAINAGE ON DFC TRACK	-1171660.6	-1171667.3	-1171687.3	-1171707.3	-1171727.3	-1171747.3	-1171767.3	-1171787.3	-1171807.3	-1171827.3	-1171847.3	-1171867.3
EXISTING IR CHAINAGE	282253.3	282260.0	282280.0	282300.0	282320.0	282340.0	282360.0	282380.0	282400.0	282420.0	282440.0	282460.0

L - SECTION

SAHNEWAL

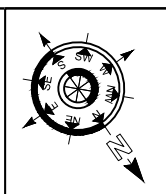

- NOTE:-
- DFCC WORKS ARE SHOWN IN RED.
 - DFC LINK LINE WORKS ARE SHOWN IN VIOLET.
 - ALL DIMENSIONS ARE SHOWN IN METRES.
 - THIS DRAWING IS PREPARED BASED ON LATEST SURVEY DATA HELD ON APRIL-2022. GTS BENCH MARK OF 261.850M CONSIDERED ON TOP OF CANAL BRIDGE ABUTMENT AT DORANA VILLAGE ALONG THE NH1.
 - DFC NEW CHAINAGE OF 1075.950M IS WITH REFERENCE TO THE IR KM OF 187.500KM END OF KM OF CP-303(SECTION P-3 PILKHANI END) AGAINST THE EXISTING DFC CHAINAGE. 116277.742M ISSUED VIDE LETTER NO. COM/DFCC/MB/SURVEY/2021-301-230116-011173.DT. 17.01.2023.
 - BALLAST PROFILE HAS BEEN PROVIDED ACCORDING TO THE CLAUSE 1.11.3 OF STANDARD SCHEDULE OF DIMENSION(EASTERN CORRIDOR) & THE BALLAST CUSHION DIMENSION SHOWN IN 35CM ON GE-14 PARA 17. SPECIFICATIONS & RECOMMENDATIONS 2. TWO LAYER SYSTEM FIG.10.

REFERENCE DRAWINGS:-

- FOR KEY PLAN REFER DRAWING NO. 301-2/AL/0001
- FOR LEGEND AND ABBREVIATIONS REFER DRAWING NO. 301-2/AL/1000
- FOR TYPICAL SECTION OF BALLAST PROFILE (FL-RL) REFER DRG. NO. 301-2/T/TFD/004 (TR. 1952)

REV.	DATE	REVISION DETAILS	PURPOSE OF ISSUE
0	30.10.2024	SUBMISSION OF AS-BUILT DRAWING	FOR APPROVAL

LEGEND:


SCALE

HOR - 1:1000

VER - 1:100

SHEET SIZE : A1

IR TRACK
DFCC TRACK
LINK LINE (SMUN-RP-J)
DFCC FUTURE PROPOSALS
STRUCTURE / BUILDING
DFCC TOE LINE
DFCC FORMATION
RETAINING WALL
ROAD
STREAM, DRAIN, NALA, CANAL.
FENCE
POWER LINES
TBM
ELECTRIC POLE/OHE MAST
IR RAILWAY BOUNDARY
DFCC BOUNDARY

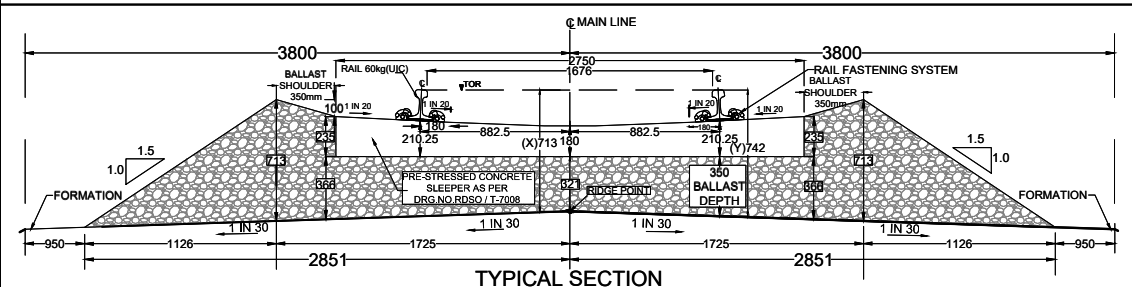

TRACK STRUCTURE		
RAIL SECTION: 60Kg/m (UIC 60Kg/m) DFC LINE: 60Kg/m (UIC 60Kg/m) IR MAIN LINE: 52Kg/m	Difference between FL- RL (Below Rail Seat)	
	IR Line	DFC
RUBBER PAD	172mm	172mm
SLEEPER DEPTH	6mm	10mm
BALLAST CUSHION	210mm	210mm
	300mm	350mm
Total Depth (FL TO RL)	688mm	742mm

OWNER: DEDICATED FREIGHT CORRIDOR CORPORATION OF INDIA LTD. (A GOVERNMENT OF INDIA ENTERPRISE)
PROJECT OFFICE/AMBALA UNIT: OLD RAILWAY COLONY (NEAR ANAND MARKET),AMBALA CANTT-133001.
CORPORATE IDENTITY NO. : U60232DL2006GGI155068

ENGINEER: DB Engineering & Consulting GmbH
Deutsche Bahn Engineering & Consulting GmbH

CONTRACTOR: GIL - TPL JV
GAR TATA

SUBMITTED BY	GIL - TPL JV		
	DATED	NAME	SIGNATURE
PREPARED BY			
CHECKED BY	30.10.2024	VIJAY PRATAP	
APPROVED BY	30.10.2024	PARASURAM KOTYADA	

APPROVED BY	DEUTSCHE BAHN ENGINEERING & CONSULTING GMBH		
	DATED	NAME	SIGNATURE
Sr. DE./CHIEF ENGINEER		SURESH K.YALANGI	
CHIEF TRACK ENGINEER		RAJ PAL SINGH	
T.L.		H.D. VIDJAK	

STAMP	A AS-BUILT DRAWING TR. Ref..... ENGINEER Sign.:		
EMPLOYER (DFCCIL):	DEDICATED FREIGHT CORRIDOR CORPORATION OF INDIA LTD.		

AS BUILT DRAWING			
TITLE		DFCC APPR. NO. - ENGG. APPR. NO. -	
AS-BUILT PLAN AND PROFILE DFC LINK LINE FROM IR KM: 282.253 TO 282.500 DFC KM: 1171.661 TO 1171.907		DRG. NO. -301-2/AL/A/1190A SHEET NO. : 1 OF 1 DATE : 30.10.2024	
		STATUS A	

TR.