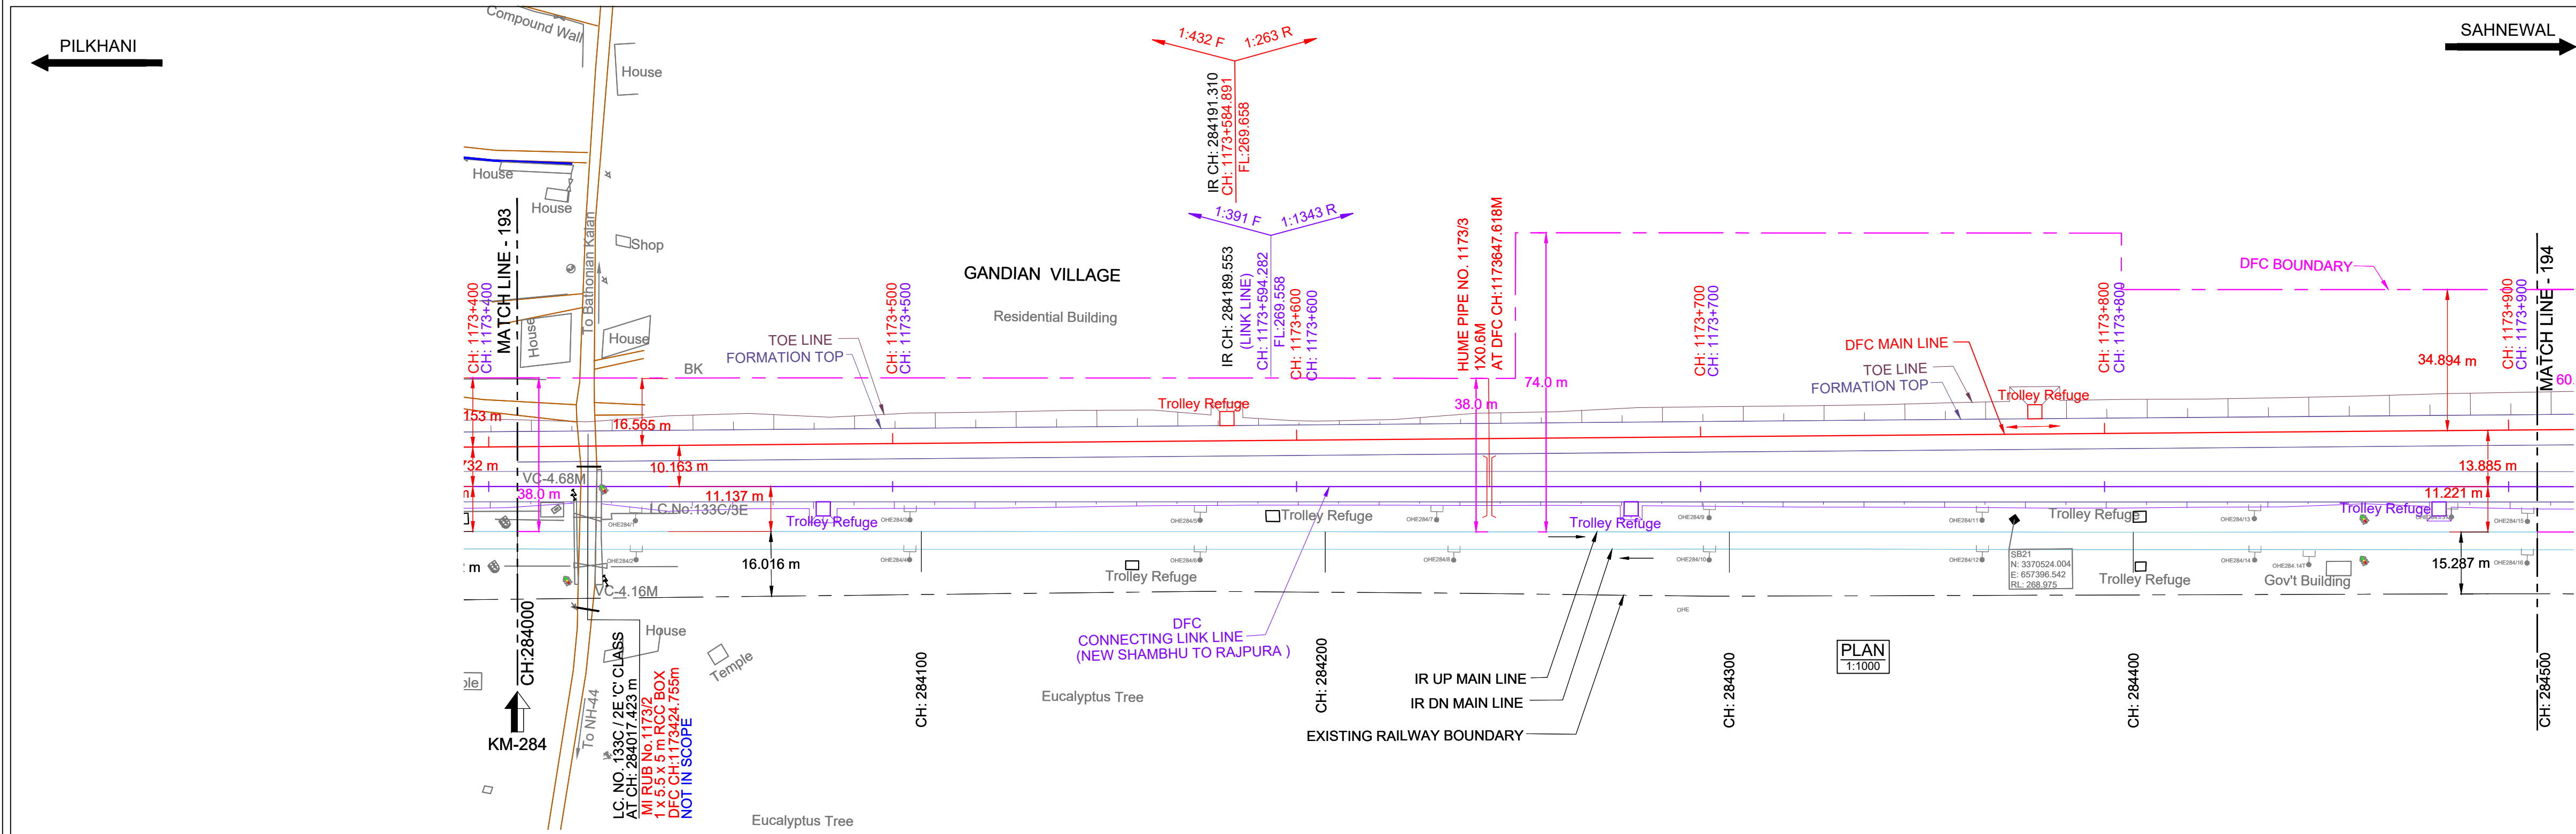


DATUM ABOVE MSL : 265 m

HORIZONTAL ALIGNMENT	L = 1540.039m														
VERTICAL ALIGNMENT	L=521.027m 1 IN 391.303 F														
TRACK DISTANCE FROM EXISTING NEAREST IR UP MAIN LINE TO DFC LINKED LINE	-11.103	-11.103	-11.103	-11.103	-11.103	-11.103	-11.103	-11.103	-11.103	-11.103	-11.103	-11.103	-11.103	-11.103	-11.103
HEIGHT OF BANKING(+) / DEPTH OF CUTTING(-) (PFL-GL)	+0.788	+0.788	+0.788	+0.788	+0.788	+0.788	+0.788	+0.788	+0.788	+0.788	+0.788	+0.788	+0.788	+0.788	+0.788
EXG GROUND LEVEL AT CENTER LINE OF DFC TRACK (GL)	269.246	269.246	269.246	269.246	269.246	269.246	269.246	269.246	269.246	269.246	269.246	269.246	269.246	269.246	269.246
EXG GROUND LEVEL AT TOE LOCATION OF DFC TRACK	269.266	269.266	269.266	269.266	269.266	269.266	269.266	269.266	269.266	269.266	269.266	269.266	269.266	269.266	269.266
DIFFERENCE BETWEEN DFC FORMATION LEVEL AND EXG.FORMATION LEVEL (PFL-EFL)	0.717	0.717	0.717	0.717	0.717	0.717	0.717	0.717	0.717	0.717	0.717	0.717	0.717	0.717	0.717
DFC FORMATION LEVEL (PFL)	270.036	270.036	270.036	270.036	270.036	270.036	270.036	270.036	270.036	270.036	270.036	270.036	270.036	270.036	270.036
EXG. FORMATION LEVEL OF EXG IR UP MAIN LINE (EFL)	269.319	269.319	269.319	269.319	269.319	269.319	269.319	269.319	269.319	269.319	269.319	269.319	269.319	269.319	269.319
DIFFERENCE BETWEEN DFC RAIL LEVEL AND EXG. RAIL LEVEL (PRL - ERL)	0.742	0.742	0.742	0.742	0.742	0.742	0.742	0.742	0.742	0.742	0.742	0.742	0.742	0.742	0.742
DFC RAIL LEVEL (PRL)	270.749	270.749	270.749	270.749	270.749	270.749	270.749	270.749	270.749	270.749	270.749	270.749	270.749	270.749	270.749
EXG.RAIL LEVEL OF NEAREST IR UP MAIN LINE(ERL)	270.007	270.007	270.007	270.007	270.007	270.007	270.007	270.007	270.007	270.007	270.007	270.007	270.007	270.007	270.007
EQUIVALENT CHAINAGE ON DFC TRACK	284000.0	284000.0	284000.0	284000.0	284000.0	284000.0	284000.0	284000.0	284000.0	284000.0	284000.0	284000.0	284000.0	284000.0	284000.0
EXISTING IR CHAINAGE	284020.0	284020.0	284020.0	284020.0	284020.0	284020.0	284020.0	284020.0	284020.0	284020.0	284020.0	284020.0	284020.0	284020.0	284020.0

L - SECTION

- NOTE:-
- DFCC WORKS ARE SHOWN IN RED.
 - DFC LINK LINE WORKS ARE SHOWN IN VIOLET.
 - ALL DIMENSIONS ARE SHOWN IN METRES.
 - THIS DRAWING IS PREPARED BASED ON LATEST SURVEY DATA HELD ON APRIL-2022. GTS BENCH MARK OF 261.850M CONSIDERED ON TOP OF CANAL BRIDGE ABUTMENT AT DORANA VILLAGE ALONG THE NH1.
 - DFC NEW CHAINAGE OF 1075.950M IS WITH REFERENCE TO THE IR KM OF 187.500KM END OF KM OF CP-303(SECTION P-3 PILKHANI END) AGAINST THE EXISTING DFC CHAINAGE. 116277.742M ISSUED VIDE LETTER NO. COM/DFCC/UMS/SURVEY/2021-301-230116-011173 DT. 17.01.2023.
 - BALLAST PROFILE HAS BEEN PROVIDED ACCORDING TO THE CLAUSE 1.11.3 OF STANDARD SCHEDULE OF DIMENSION(EASTERN CORRIDOR) & THE BALLAST CUSHION DIMENSION SHOWN IN 35CM ON GE-14 PARA 17. SPECIFICATIONS & RECOMMENDATIONS 2. TWO LAYER SYSTEM FIG.10.

- REFERENCE DRAWINGS :-
- FOR KEY PLAN REFER DRAWING NO. 301-2/AL/0001
 - FOR LEGEND AND ABBREVIATIONS REFER DRAWING NO. 301-2/AL/1000
 - FOR TYPICAL SECTION OF BALLAST PROFILE (FL-RL) REFER DRG. NO. 301-2/TK/TFD/004 (TR.1952)

REV.	DATE	REVISION DETAILS	PURPOSE OF ISSUE
0	30.10.2024	SUBMISSION OF AS-BUILT DRAWING	FOR APPROVAL

LEGEND:


SCALE

HOR - 1:1000

VER - 1:100

SHEET SIZE : A1

IR TRACK
DFCC TRACK
LINK LINE (SMUN-RP-J)
DFCC FUTURE PROPOSALS
STRUCTURE / BUILDING
DFCC TOE LINE
DFCC FORMATION
RETAINING WALL
ROAD
STREAM, DRAIN, NALA, CANAL.
FENCE
POWER LINES
TBM
ELECTRIC POLE/OHE MAST
IR RAILWAY BOUNDARY
DFCC BOUNDARY

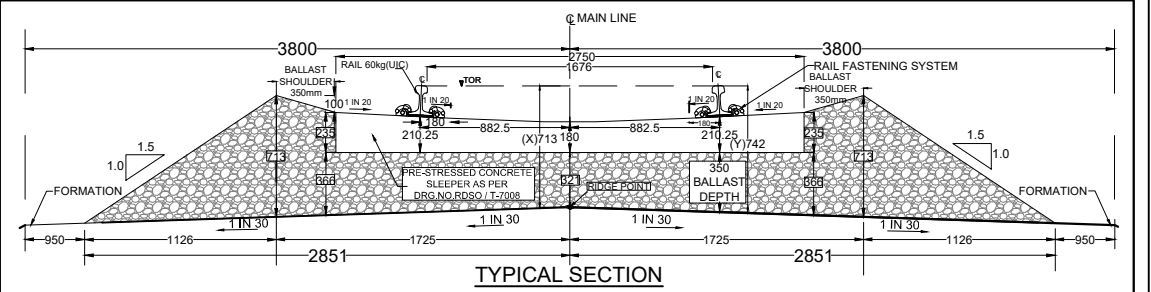

TRACK STRUCTURE		
RAIL SECTION: 60Kg/m (UIC 60Kg/m) DFC LINE: 60Kg/m (UIC 60Kg/m) IR MAIN LINE: 52Kg/m	Difference between FL- RL (Below Rail Seat)	
	IR Line	DFC
RUBBER PAD	172mm	172mm
SLEEPER DEPTH	210mm	210mm
BALLAST CUSHION	300mm	350mm
Total Depth (FL TO RL)	688mm	742mm

OWNER

DEDICATED FREIGHT CORRIDOR CORPORATION OF INDIA LTD.

(A GOVERNMENT OF INDIA ENTERPRISE)

PROJECT OFFICE(AMBALA UNIT): OLD RAILWAY COLONY (NEAR ANAND MARKET),AMBALA CANTT-133001.

CORPORATE IDENTITY NO. : U60232DL20060G0155068

ENGINEER:

DB Engineering & Consulting GmbH

Deutsche Bahn Engineering & Consulting GmbH

CONTRACTOR:

GIL - TPL JV

GAR TATA

SUBMITTED BY	GIL - TPL JV		
	DATED	NAME	SIGNATURE
PREPARED BY			
CHECKED BY	30.10.2024	VIJAY PRATAP	
APPROVED BY	30.10.2024	PARASURAM KOTYADA	

APPROVED BY	DEUTSCHE BAHN ENGINEERING & CONSULTING GMBH		
	DATED	NAME	SIGNATURE
Sr. DE./CHIEF ENGINEER		SURESH K.YALANGI	
CHIEF TRACK ENGINEER		RAJ PAL SINGH	
T.L.		H.D. VIDJAK	

STAMP

A

AS-BUILT DRAWING

TR. Ref.:.....

ENGINEER Sign.:.....

EMPLOYER (DFCCIL): DEDICATED FREIGHT CORRIDOR CORPORATION OF INDIA LTD.

AS BUILT DRAWING			
TITLE	AS-BUILT PLAN AND PROFILE	DFCC APPR. NO. -	
	DFC LINK LINE	ENGG. APPR. NO. -	
FROM IR KM: 284.000 TO 284.500	DFC KM: 1173.407 TO 1173.907	DRG. NO. - 301-2/AL/A/1194A	
		SHEET NO. : 1 OF 1	STATUS
		DATE : 30.10.2024	A

TR.