
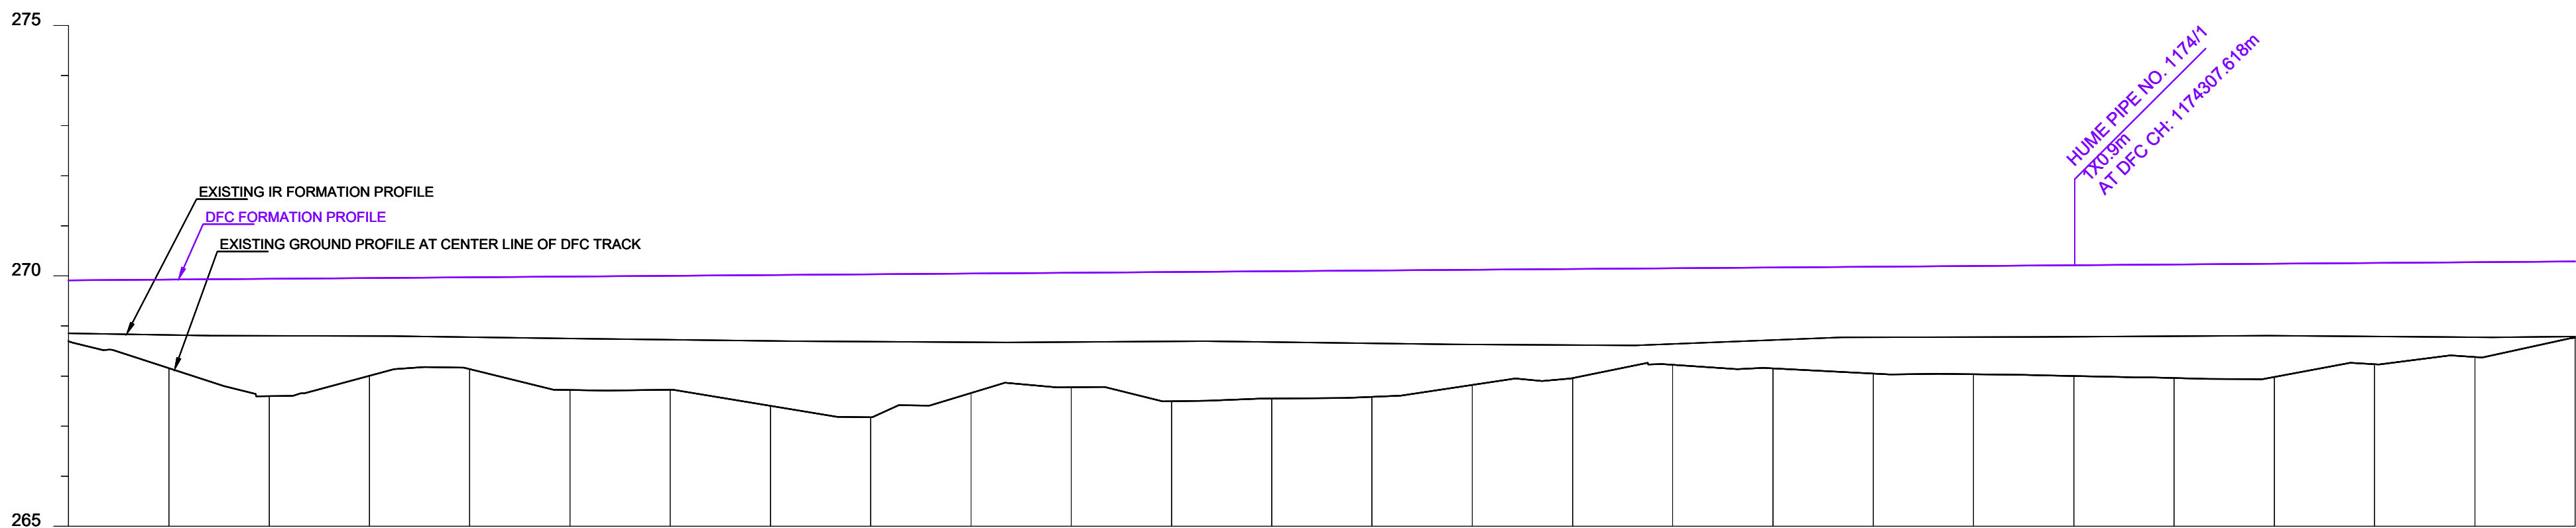


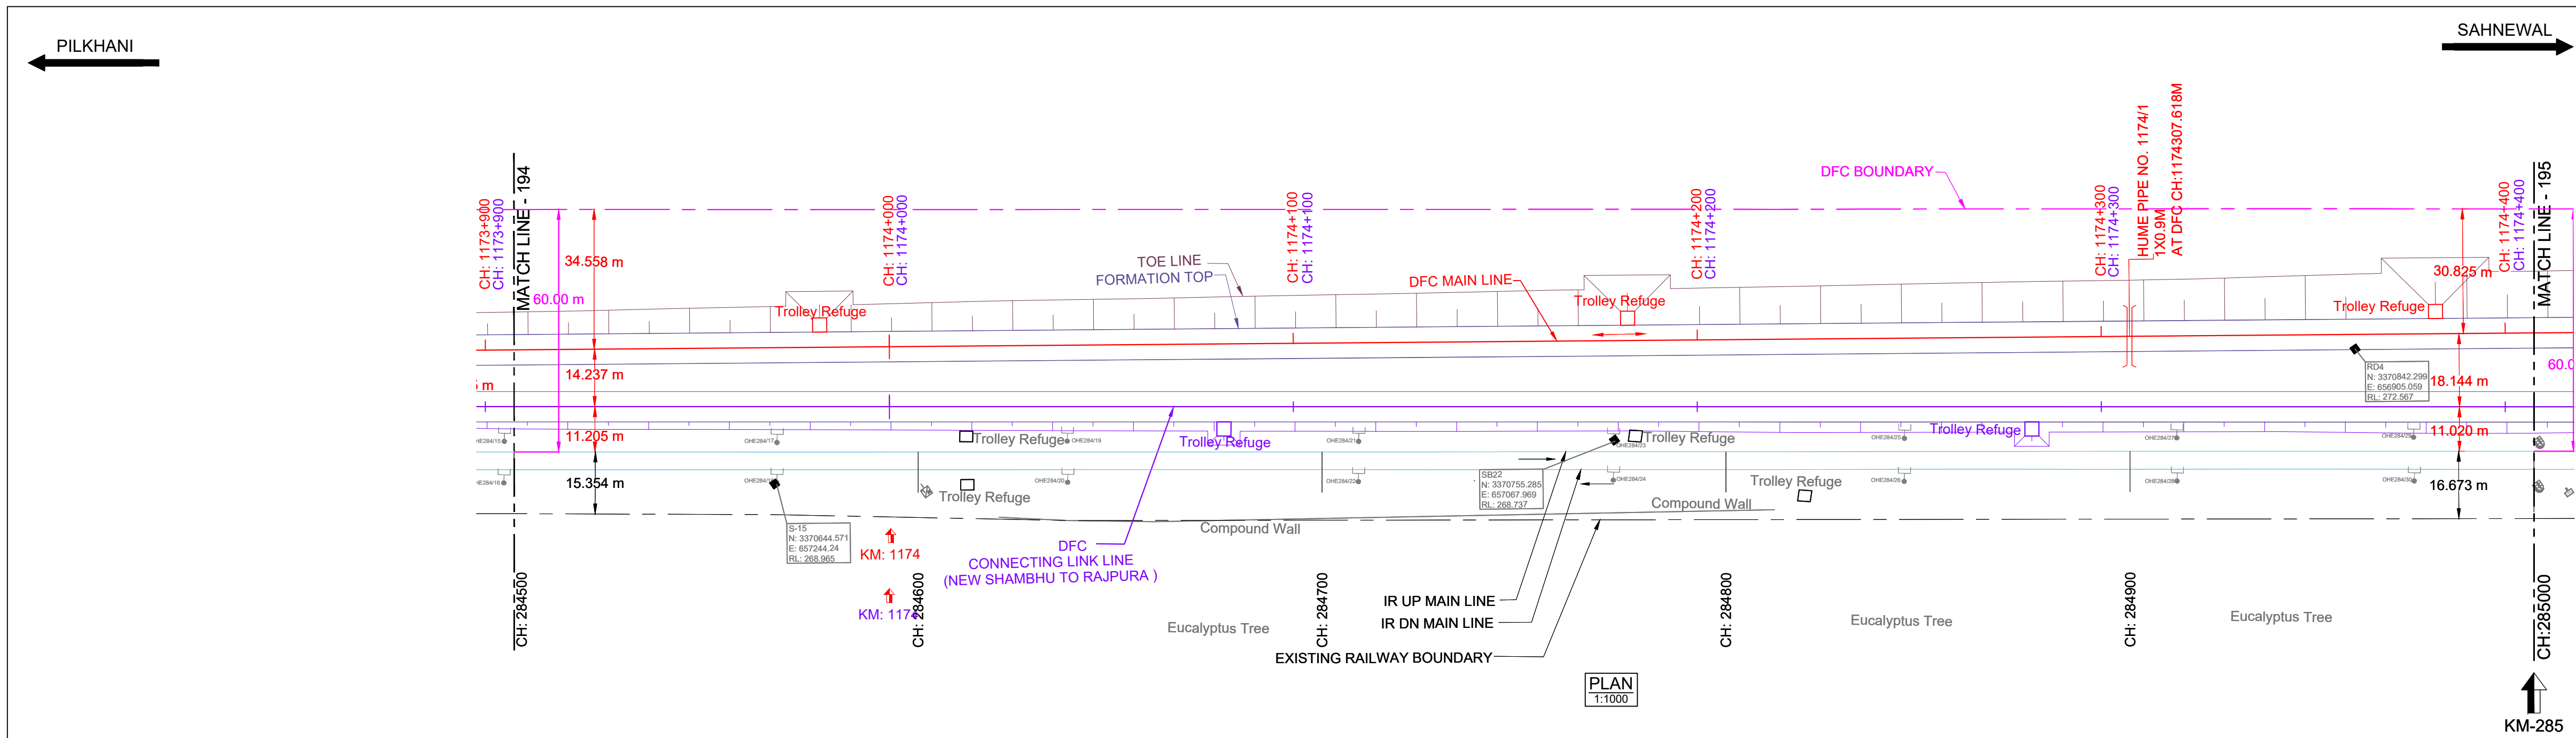


DATUM ABOVE MSL : 265 m

HORIZONTAL ALIGNMENT	L = 1540.039m																			
VERTICAL ALIGNMENT	L=1503.383 m 1 IN 1343.475 R																			
TRACK DISTANCE FROM EXISTING NEAREST IR UP MAIN LINE TO DFC LINKED LINE	-11.214	-11.205	-11.212	-11.232	-11.227	-11.214	-11.208	-11.202	-11.194	-11.184	-11.178	-11.172	-11.159	-11.141	-11.130	-11.145	-11.136	-11.087	-11.022	-11.018
HEIGHT OF BANKING(+) / DEPTH OF CUTTING(-) (PFL-GL)	+1.218	+1.768	+2.343	+1.951	+1.832	+2.285	+2.274	+2.611	+2.855	+2.387	+2.287	+2.581	+2.540	+2.523	+2.301	+2.178	+1.928	+2.016	+2.213	+1.525
EXG GROUND LEVEL AT CENTER LINE OF DFC TRACK (GL)	268.573	268.038	267.477	267.885	268.019	267.601	267.606	267.285	267.055	267.538	267.653	267.374	267.430	267.462	267.699	267.636	268.101	268.028	267.875	268.638
EXG GROUND LEVEL AT TOE LOCATION OF DFC TRACK	268.044	267.981	267.670	267.594	267.568	267.385	267.280	267.050	266.987	267.027	266.952	266.935	266.823	266.713	266.761	267.185	266.955	267.406	266.998	268.592
DIFFERENCE BETWEEN DFC FORMATION LEVEL AND EXG.FORMATION LEVEL.(PFL-EFL)	1.060	1.108	1.139	1.159	1.195	1.237	1.276	1.316	1.345	1.370	1.381	1.384	1.412	1.453	1.491	1.519	1.513	1.450	1.428	1.498
DFC FORMATION LEVEL (PFL)	268.731	268.791	268.821	268.836	268.851	268.829	268.880	268.579	268.365	268.925	268.559	268.571	268.558	268.531	268.508	268.495	268.516	268.594	268.861	268.672
EXG. FORMATION LEVEL OF EXG IR UP MAIN LINE (EFL)	268.731	268.698	268.681	268.677	268.655	268.629	268.604	268.579	268.565	268.555	268.559	268.571	268.558	268.531	268.508	268.495	268.516	268.594	268.861	268.672
DIFFERENCE BETWEEN DFC RAIL LEVEL AND EXG. RAIL LEVEL (PRL - ERL)	1.085	1.133	1.164	1.184	1.220	1.262	1.301	1.341	1.370	1.395	1.406	1.409	1.437	1.478	1.516	1.544	1.538	1.475	1.453	1.523
DFC RAIL LEVEL (PRL)	270.504	270.519	270.534	270.549	270.564	270.578	270.593	270.608	270.623	270.638	270.653	270.668	270.683	270.698	270.712	270.727	270.742	270.757	270.802	270.817
EXG.RAIL LEVEL OF NEAREST IR UP MAIN LINE(ERL)	269.419	269.386	269.369	269.365	269.343	269.317	269.292	269.267	269.253	269.243	269.247	269.259	269.246	269.219	269.196	269.183	269.204	269.282	269.349	269.360
EQUIVALENT CHAINAGE ON DFC TRACK	1173907.3	1173927.3	1173947.3	1173967.3	1173987.3	1174007.3	1174027.3	1174047.3	1174067.3	1174087.3	1174107.3	1174127.3	1174147.3	1174167.3	1174187.3	1174207.3	1174227.3	1174247.3	1174267.3	1174287.3
EXISTING IR CHAINAGE	284500.0	284520.0	284540.0	284560.0	284580.0	284600.0	284620.0	284640.0	284660.0	284680.0	284700.0	284720.0	284740.0	284760.0	284780.0	284800.0	284820.0	284840.0	284860.0	284880.0

L - SECTION

SAHNEWAL

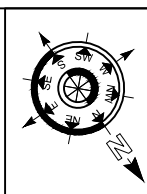

- NOTE:-
- DFCC WORKS ARE SHOWN IN RED.
 - DFC LINK LINE WORKS ARE SHOWN IN VIOLET.
 - ALL DIMENSIONS ARE SHOWN IN METRES.
 - THIS DRAWING IS PREPARED BASED ON LATEST SURVEY DATA HELD ON APRIL-2022. GTS BENCH MARK OF 261.850M CONSIDERED ON TOP OF CANAL BRIDGE ABUTMENT AT DORANA VILLAGE ALONG THE NH1.
 - DFC NEW CHAINAGE OF 1075.950M IS WITH REFERENCE TO THE IR KM OF 187.500KM END OF KM OF CP-303(SECTION P-3 PILKHANI END) AGAINST THE EXISTING DFC CHAINAGE. 116277.742M ISSUED VIDE LETTER NO. COM/DFCC/UMS/SURVEY/2021-301-230116-011173 DT. 17.01.2023.
 - BALLAST PROFILE HAS BEEN PROVIDED ACCORDING TO THE CLAUSE 1.11.3 OF STANDARD SCHEDULE OF DIMENSION(EASTERN CORRIDOR) & THE BALLAST CUSHION DIMENSION SHOWN IN 35CM ON GE-14 PARA 17. SPECIFICATIONS & RECOMMENDATIONS 2. TWO LAYER SYSTEM FIG.10.

REFERENCE DRAWINGS :-


- FOR KEY PLAN REFER DRAWING NO. 301-2/AL/0001
- FOR LEGEND AND ABBREVIATIONS REFER DRAWING NO. 301-2/AL/1000
- FOR TYPICAL SECTION OF BALLAST PROFILE (FL-RL) REFER DRG. NO. 301-2/TK/TFD/-004 (TR.1952)

0	30.10.2024	SUBMISSION OF AS-BUILT DRAWING	FOR APPROVAL
REV.	DATE	REVISION DETAILS	PURPOSE OF ISSUE

LEGEND:

SCALE: HOR - 1:1000, VER - 1:100, SHEET SIZE : A1

IR TRACK, DFC TRACK, LINK LINE (SMUN-RP-J), DFC FUTURE PROPOSALS, STRUCTURE / BUILDING, DFC TOE LINE, DFC FORMATION, RETAINING WALL, ROAD, STREAM, DRAIN, NALA, CANAL, FENCE, POWER LINES, TBM, ELECTRIC POLE/OHE MAST, IR RAILWAY BOUNDARY, DFC BOUNDARY

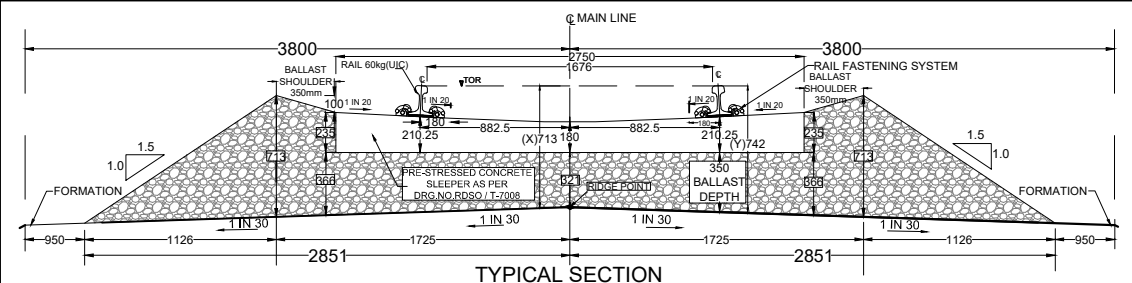

TRACK STRUCTURE		
RAIL SECTION: 60Kg/m (UIC 60Kg/m) DFC LINE: 60Kg/m (UIC 60Kg/m) IR MAIN LINE: 52Kg/m	Difference between FL- RL (Below Rail Seat)	
	IR Line	DFC
RUBBER PAD	172mm	172mm
SLEEPER DEPTH	6mm	10mm
BALLAST CUSHION	210mm	210mm
	300mm	350mm
Total Depth (FL TO RL)	688mm	742mm

OWNER: DEDICATED FREIGHT CORRIDOR CORPORATION OF INDIA LTD. (A GOVERNMENT OF INDIA ENTERPRISE)
PROJECT OFFICE(AMBALA UNIT): OLD RAILWAY COLONY (NEAR ANAND MARKET),AMBALA CANTT-133001.
CORPORATE IDENTITY NO. : U60232DL2006GGI155068

ENGINEER: DB Engineering & Consulting GmbH
Deutsche Bahn Engineering & Consulting GmbH

CONTRACTOR: GIL - TPL JV
GAR TATA

SUBMITTED BY	GIL - TPL JV		
	DATED	NAME	SIGNATURE
PREPARED BY			
CHECKED BY	30.10.2024	VIJAY PRATAP	
APPROVED BY	30.10.2024	PARASURAM KOTYADA	
APPROVED BY	DEUTSCHE BAHN ENGINEERING & CONSULTING GMBH		
	DATED	NAME	SIGNATURE
Sr. DE./CHIEF ENGINEER		SURESH K.YALANGI	
CHIEF TRACK ENGINEER		RAJ PAL SINGH	
T.L.		H.D. VIDJAK	

STAMP	A AS-BUILT DRAWING TR. Ref.:..... ENGINEER Sign.:.....		
EMPLOYER (DFCCIL):	DEDICATED FREIGHT CORRIDOR CORPORATION OF INDIA LTD.		

AS BUILT DRAWING			
TITLE	AS-BUILT PLAN AND PROFILE DFC LINK LINE FROM IR KM: 284.500 TO 285.000 DFC KM: 1173.907 TO 1174.407	DFCC APPR. NO. - ENGG. APPR. NO. - DRG. NO. - 301-2/AL/A/1195A SHEET NO. : 1 OF 1 DATE : 30.10.2024	STATUS A

TR.