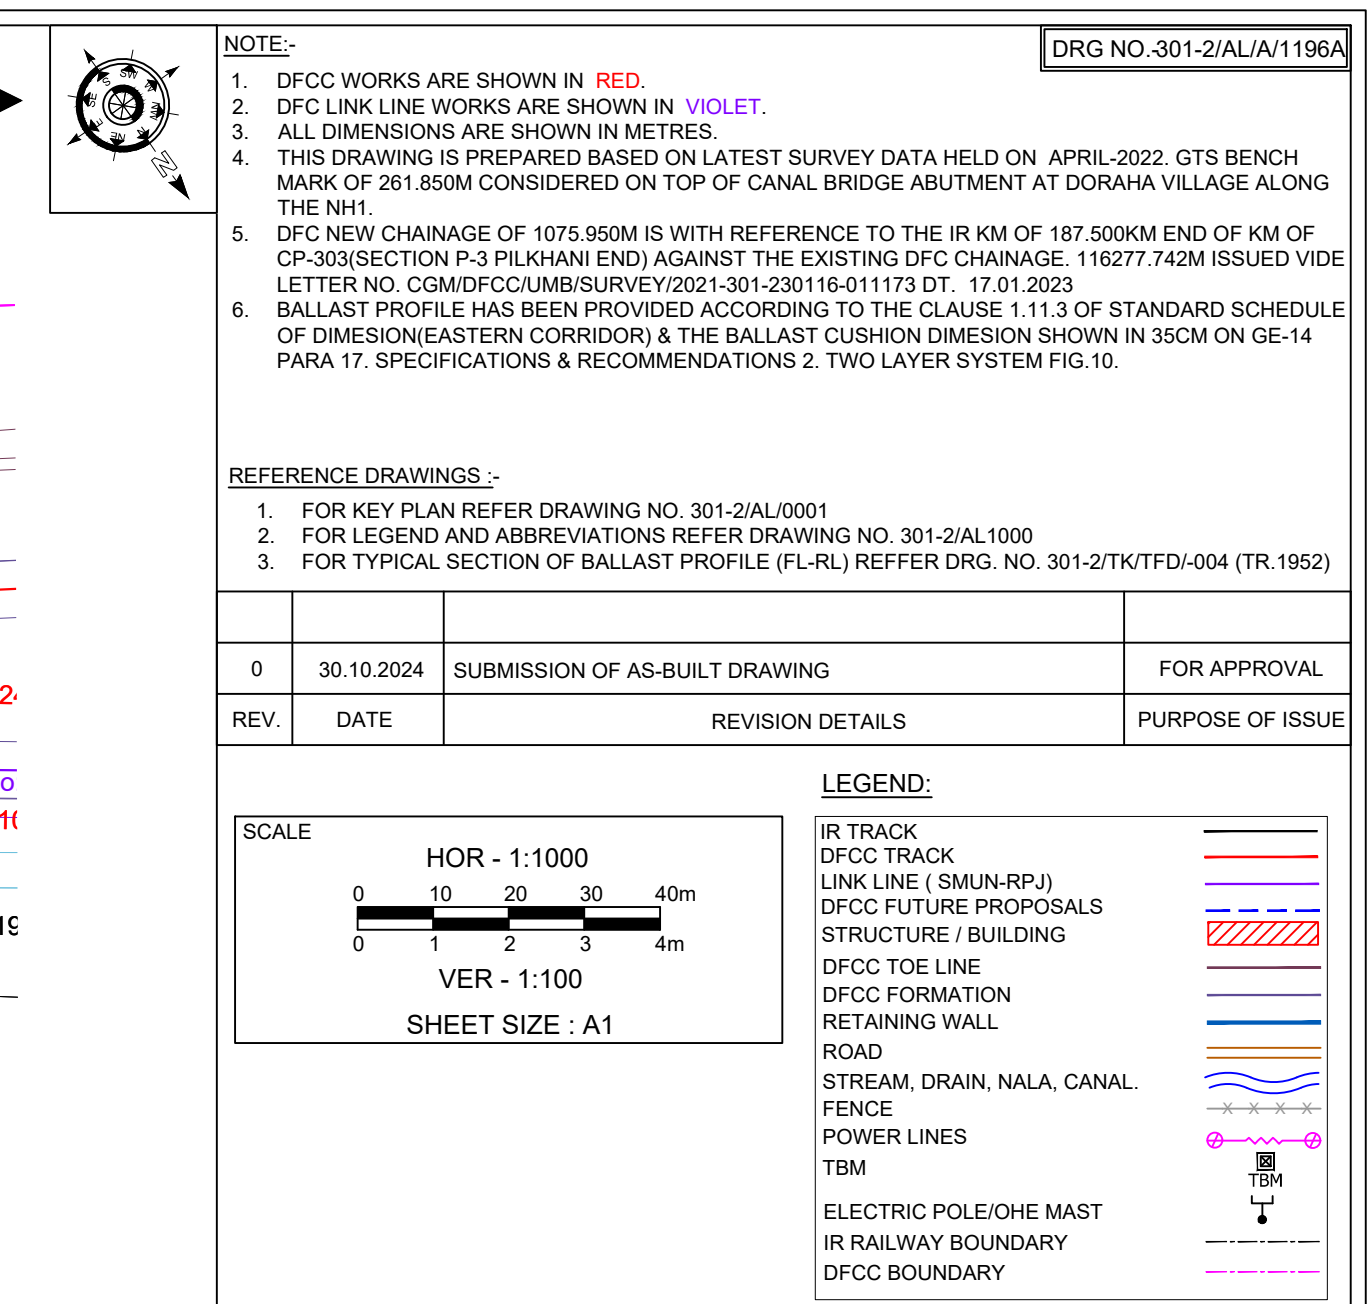


OWNER	DEDICATED FREIGHT CORRIDOR CORPORATION OF INDIA LTD. (A GOVERNMENT OF INDIA ENTERPRISE) PROJECT OFFICE/AMBALA UNIT: OLD RAILWAY COLONY (NEAR ANAND MARKET),AMBALA CANTT-133001. CORPORATE IDENTITY NO. : U60232DL2006GOI155068
-------	--

CONTRACTOR: GIL - TPL JV

STAMP	A AS-BUILT DRAWING TR. Ref..... ENGINEER Sign.:

AS BUILT DRAWING	
TITLE AS-BUILT PLAN AND PROFILE DFC LINK LINE FROM IR KM: 285.000 TO 285.500 DFC KM: 1174.407 TO 1174.907	DFCC APPR. NO. - ENGG. APPR. NO. - DRG. NO. -301-2/A/A/1196A SHEET NO. :1 OF 1 DATE : 30.10.2024
	STATUS A

L - SECTION