



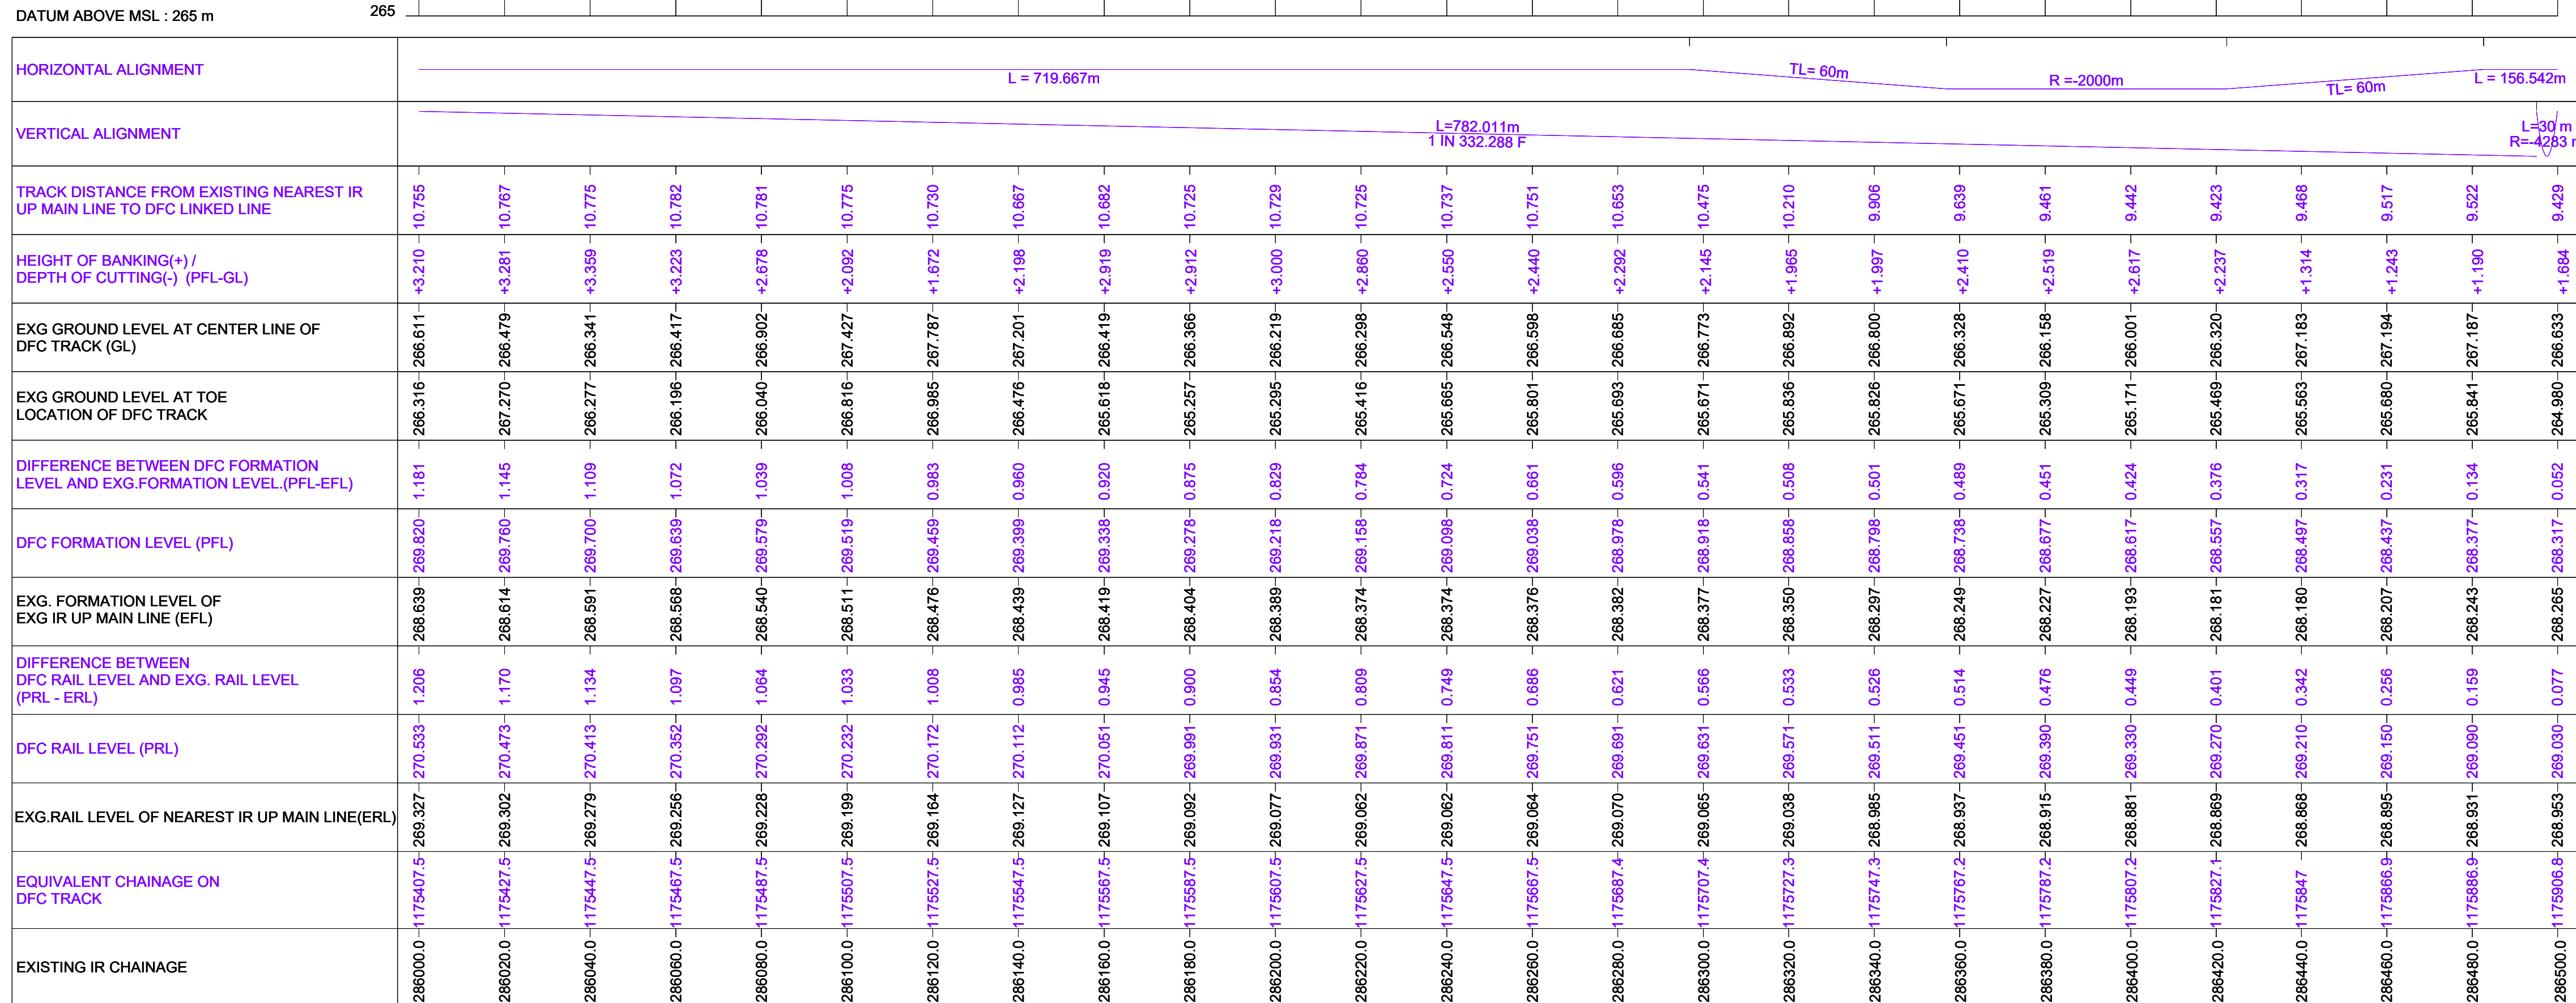

## L - SECTION

SAHNEWAL →

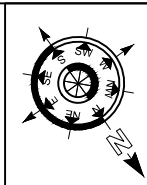



- NOTE:**
- DRG NO.-301-2/AL/A/1198.
1. DFOC WORKS ARE SHOWN IN **RED**.
  2. DFOC LINK LINE WORKS ARE SHOWN IN **VIOLET**.
  3. ALL DIMENSIONS ARE SHOWN IN METRES.
  4. THIS DRAWING IS PREPARED BASED ON THE BEST SURVEY DATA HELD ON APRIL-2022. GTS BENCH MARK OF 261.850M CONSIDERED ON TOP OF CANAL BRIDGE ABUTMENT AT DORAHA VILLAGE ALONG THE NH1.
  5. DFOC NEAR PROFILE OF 1075.950M IS WITH REFERENCE TO THE IR KM OF 187.500M END OF KM OF CP-303/SECTION P-3 (PILKHANI) AGAINST THE EXISTING DFOC CHAINAGE. 116277.742M ISSUED VDU LETTER NO. GM/CMD/CP/CMBM/SURVEY/2021-301-201-216-11173 D7. 17. 01. 2021
  6. BALLAST PROFILE HAS BEEN PROVIDED ACCORDING TO THE CLAUSE 1.11.3 OF STANDARD SCHEDULE FOR WESTERN CORRIDOR, AND THE BALLAST CUSHION DIMENSION SHOWN IN 35CM ON GE-1.
  7. PART 17. SPECIFICATIONS & RECOMMENDATIONS 2. TWO LAYER SYSTEM F10.

REFERENCE DRAWINGS :

1. FOR KEY PLAN REFER DRAWING NO. 301-2/AL/0001
2. FOR LEGEND AND ABBREVIATIONS REFER DRAWING NO. 301-2/AL/1000
3. FOR TYPICAL SECTION OF BALLAST PROFILE (FL-RL) REFFER DRG. NO. 301-2/TK/TFD/-004 (TR.1952)

|      |            |                                |                  |
|------|------------|--------------------------------|------------------|
|      |            |                                |                  |
| 0    | 30.10.2024 | SUBMISSION OF AS-BUILT DRAWING | FOR APPROVAL     |
| REV. | DATE       | REVISION DETAILS               | PURPOSE OF ISSUE |

LEGEND:

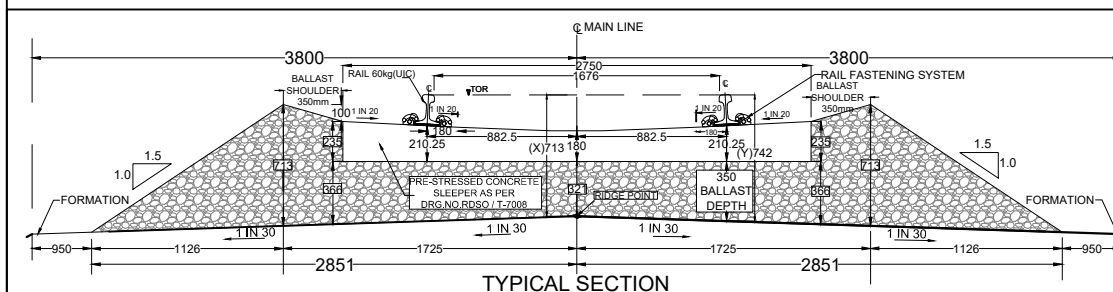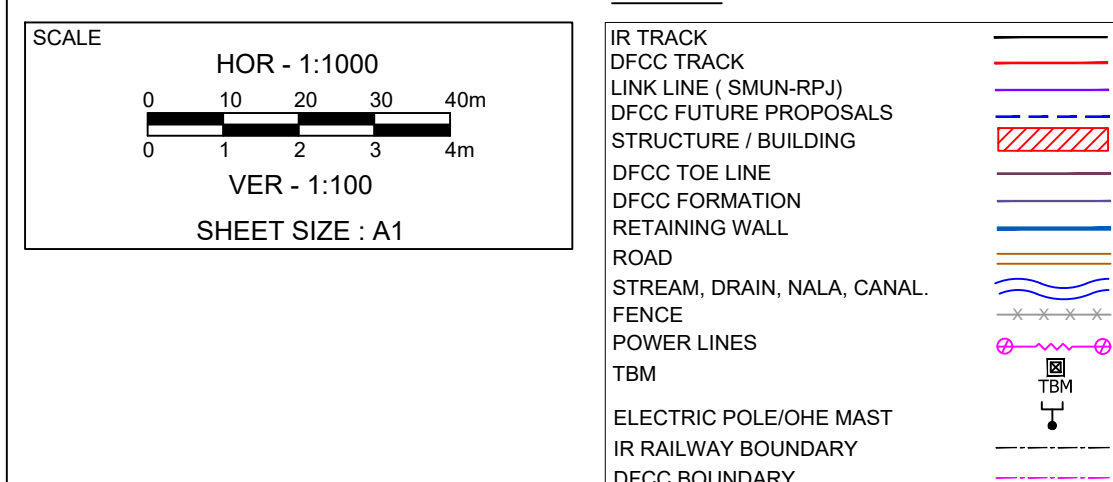

| TRACK STRUCTURE                                                                            |                                                |       |
|--------------------------------------------------------------------------------------------|------------------------------------------------|-------|
| RAIL SECTION: 60Kg/m (UIC 60Kg/m)<br>DFC LINE: 60Kg/m (UIC 60Kg/m)<br>IR MAIN LINE: 52Kg/m | Difference between<br>FL- RL (Below Rail Seat) |       |
|                                                                                            | IR Line                                        | DFC   |
|                                                                                            | 172mm                                          | 172mm |
| RUBBER PAD                                                                                 | 6mm                                            | 10mm  |
| SLEEPER DEPTH                                                                              | 210mm                                          | 210mm |
| BALLAST CUSHION                                                                            | 300mm                                          | 350mm |
| Total Depth (FL TO RL)                                                                     | 688mm                                          | 742mm |

OWNER



डेडीकेटेड फ्रीट कोरिडोर

DEDICATED FREIGHT CORRIDOR CORPORATION OF INDIA LTD.  
(A GOVERNMENT OF INDIA ENTERPRISE)  
PROJECT OFFICE/AMBALA UNIT: OLD RAILWAY COLONY (NEAR  
ANAND MARKET), AMBALA CANTT-133001.  
CORPORATE IDENTITY NO. : U60232DL2006G0155068

ENGINEER:

 DB Engineering & Consulting GmbH  
Deutsche Bahn Engineering & Consulting GmbH

CONTRACTOR: GIL - TPL JV

|              |              |                   |           |
|--------------|--------------|-------------------|-----------|
| SUBMITTED BY | GIL - TPL JV |                   |           |
|              | DATED        | NAME              | SIGNATURE |
| PREPARED BY  |              |                   |           |
| CHECKED BY   | 30.10.2024   | VIJAY PRATAP      |           |
| APPROVED BY  | 30.10.2024   | PARASURAM KOTYADA |           |

|                        |                                             |                  |           |
|------------------------|---------------------------------------------|------------------|-----------|
| APPROVED BY            | DEUTSCHE BAHN ENGINEERING & CONSULTING GMBH |                  |           |
|                        | DATED                                       | NAME             | SIGNATURE |
| Sr. DE./CHIEF ENGINEER |                                             | SURESH K.YALANGI |           |
| CHIEF TRACK ENGINEER   |                                             | RAJ PAL SINGH    |           |
| T.L.                   |                                             | H.D. VIDJAK      |           |

|       |                                                                                       |
|-------|---------------------------------------------------------------------------------------|
| STAMP |  |
|       |                                                                                       |

|                    |                                                    |
|--------------------|----------------------------------------------------|
| EMPLOYER (DFCCIL): | DEDICATED FREIGHT CORRIDOR CORPORATION OF INDIA LT |
|--------------------|----------------------------------------------------|

|  |  |  |  |
|--|--|--|--|
|  |  |  |  |
|--|--|--|--|

**AS BUILT DRAWING**

|                                                                                                                                                                       |                             |                    |
|-----------------------------------------------------------------------------------------------------------------------------------------------------------------------|-----------------------------|--------------------|
| <b>TITLE</b><br><br><b>AS-BUILT PLAN AND PROFILE</b><br><a href="#">DFC LINK LINE</a><br><b>FROM IR KM: 286.000 TO 286.500</b><br><b>DFC KM: 1175.407 TO 1175.907</b> | DFCC APPR. NO. -            |                    |
|                                                                                                                                                                       | ENGG. APPR. NO. -           |                    |
|                                                                                                                                                                       | DRG. NO. - 301-2/AL/A/1198A |                    |
|                                                                                                                                                                       | SHEET NO. : 1 OF 1          | STATUS<br><b>A</b> |
| DATE : 30.10.2024                                                                                                                                                     |                             |                    |

|    |
|----|
| TR |
|----|