


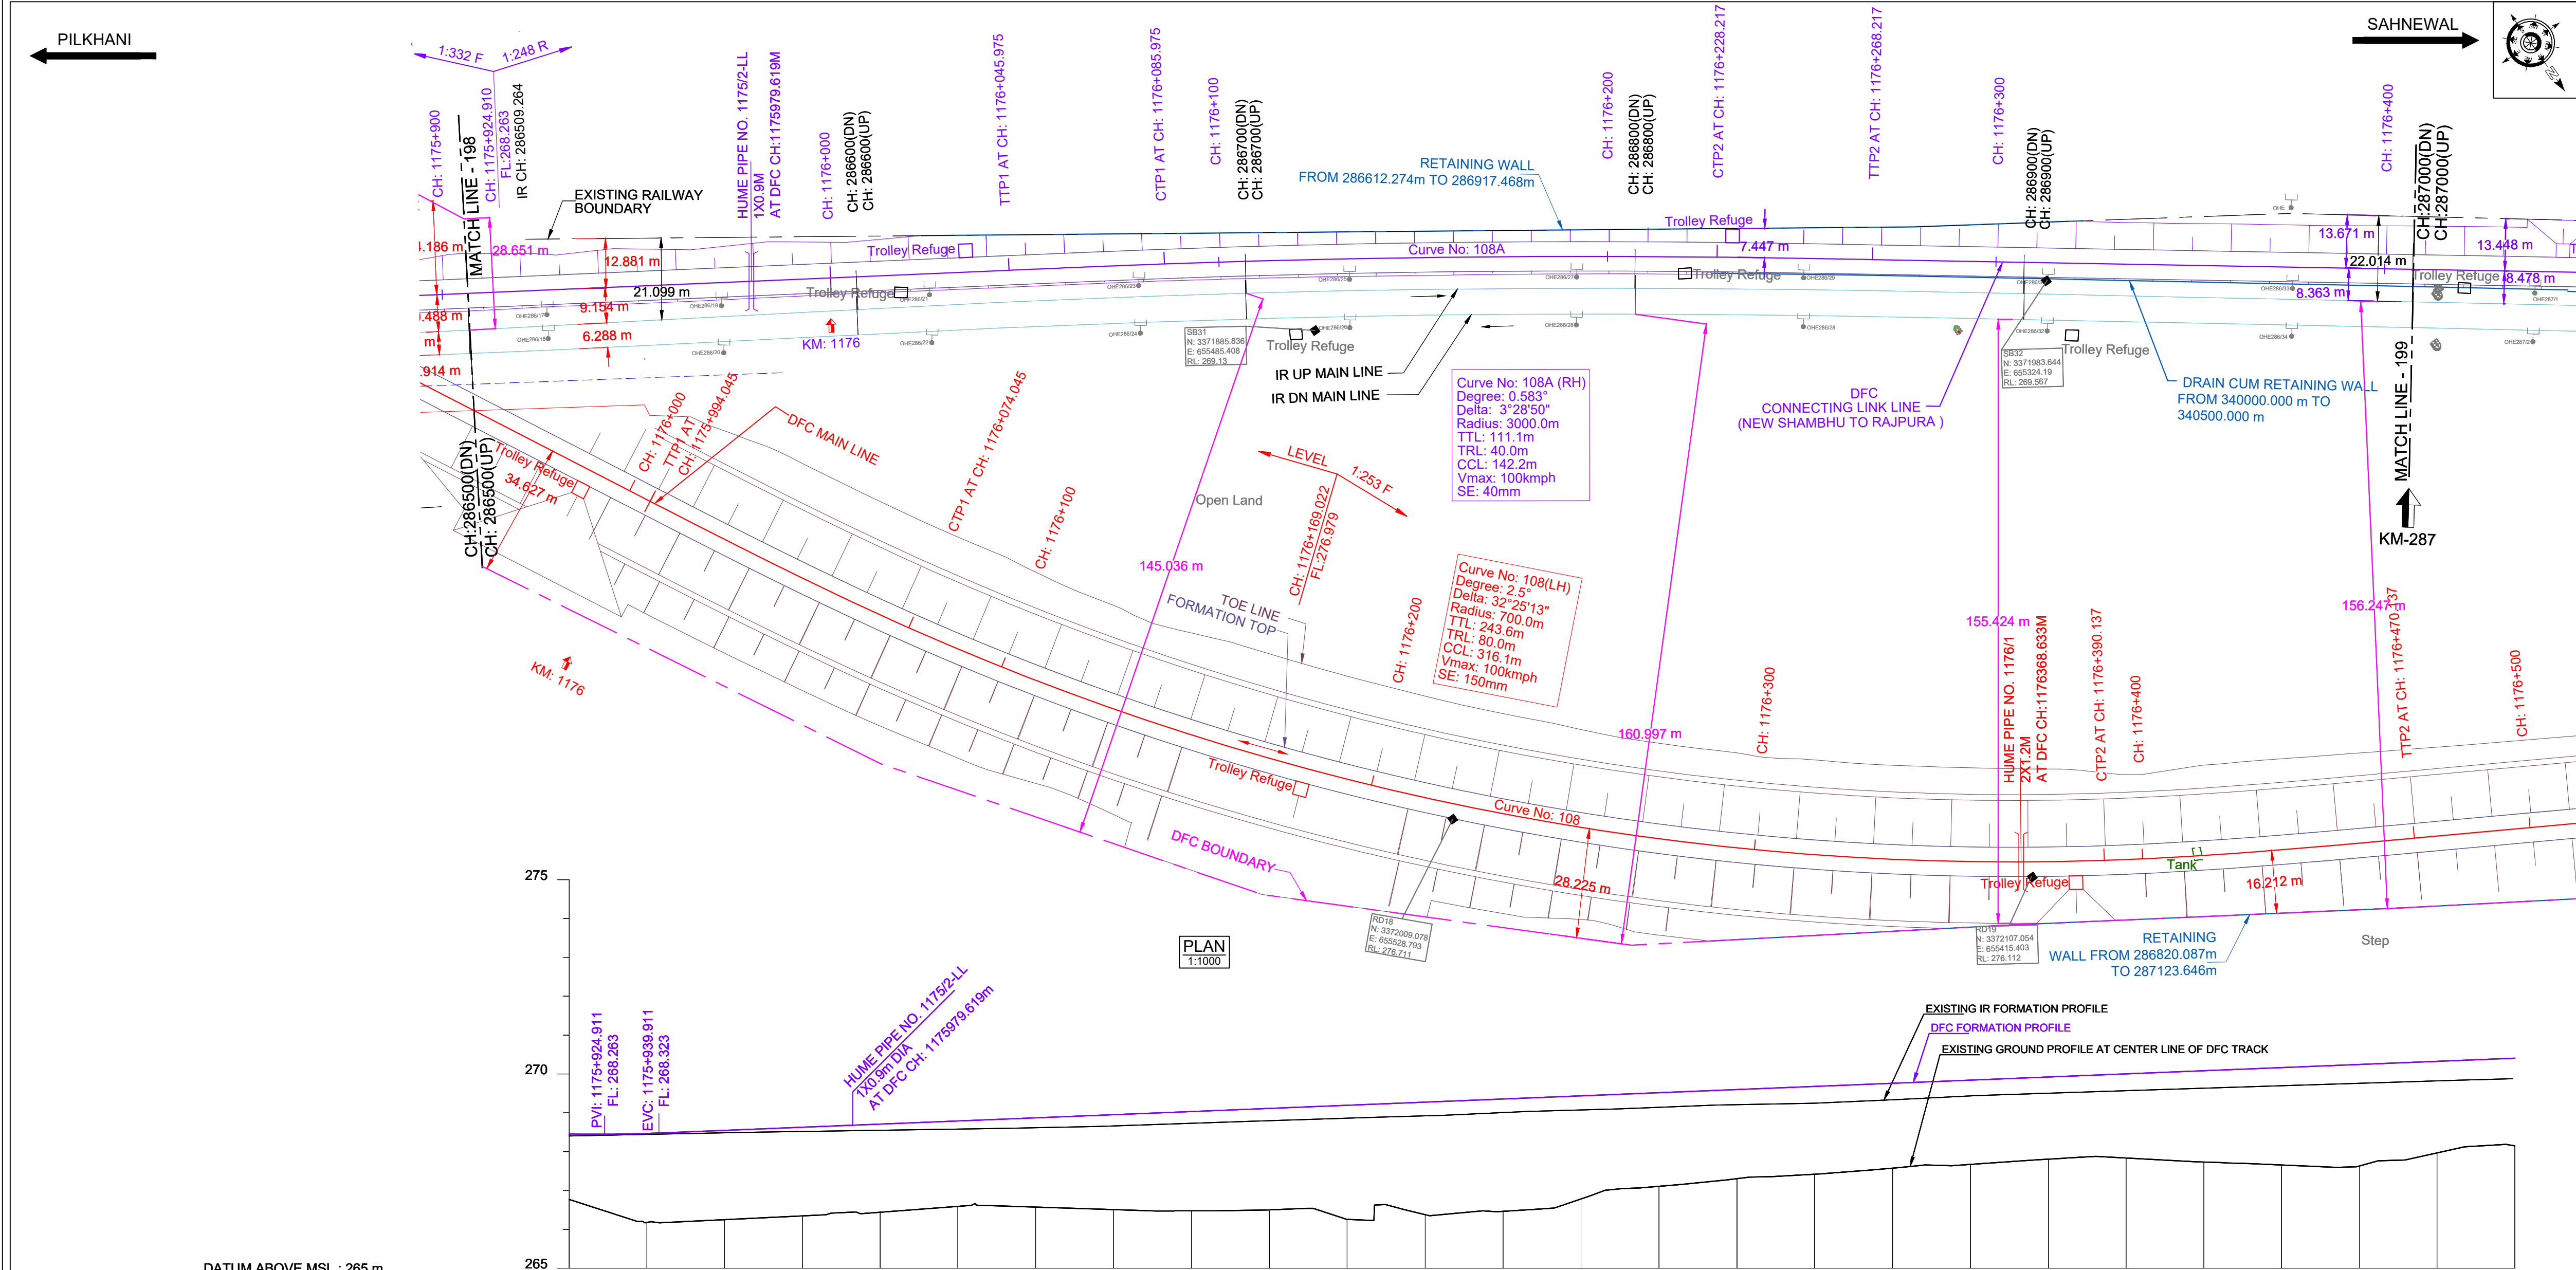

DATUM ABOVE MSL : 265 m

HORIZONTAL ALIGNMENT	L = 156.542m TL= 40m R=3000m TL= 40m L = 201.852m																			
VERTICAL ALIGNMENT	L=30 m R=4283 m L=931.900m 1 IN 248.360 R																			
TRACK DISTANCE FROM EXISTING NEAREST IR UP MAIN LINE TO DFC LINKED LINE	9.429																			
HEIGHT OF BANKING(+)/ DEPTH OF CUTTING(-) (PFL-GL)	+1.884	9.238	9.020	8.816	8.621	8.443	8.275	8.145	8.181	8.203	8.223	8.214	8.234	8.250	8.239	8.198	8.137	8.068	8.011	8.034
EXG GROUND LEVEL AT CENTER LINE OF DFC TRACK (GL)	-266.633	-265.980	-265.051	-266.147	-266.241	-266.391	-266.374	-266.310	-266.276	-266.304	-266.088	-266.175	-266.264	-266.582	-266.908	-267.105	-267.375	-267.473	-267.608	-267.608
EXG GROUND LEVEL AT TOE LOCATION OF DFC TRACK	-264.980	-265.428	-265.219	-265.754	-265.346	-265.839	-265.510	-265.624	-265.688	-265.877	-265.764	-265.545	-265.995	-265.773	-265.879	-265.641	-265.804	-265.688	-265.184	-265.012
DIFFERENCE BETWEEN DFC FORMATION LEVEL AND EXG.FORMATION LEVEL (PFL-EFL)	0.052	0.024	0.065	0.112	0.161	0.210	0.256	0.292	0.303	0.317	0.334	0.354	0.353	0.366	0.379	0.391	0.435	0.427	0.407	0.418
DFC FORMATION LEVEL (PFL)	-268.317	-268.271	-268.351	-268.432	-268.512	-268.593	-268.673	-268.754	-268.835	-268.916	-268.996	-269.077	-269.158	-269.238	-269.319	-269.400	-269.481	-269.561	-269.642	-269.723
EXG. FORMATION LEVEL OF EXG IR UP MAIN LINE (EFL)	-268.265	-268.247	-268.286	-268.320	-268.351	-268.382	-268.417	-268.463	-268.532	-268.599	-268.662	-268.722	-268.804	-268.872	-268.940	-269.009	-269.079	-269.134	-269.235	-269.305
DIFFERENCE BETWEEN DFC RAIL LEVEL AND EXG. RAIL LEVEL (PRL - ERL)	0.077	0.049	0.090	0.137	0.186	0.235	0.281	0.317	0.328	0.342	0.359	0.379	0.378	0.391	0.404	0.416	0.452	0.452	0.432	0.443
DFC RAIL LEVEL (PRL)	-269.030	-268.984	-269.064	-269.145	-269.225	-269.306	-269.386	-269.467	-269.548	-269.629	-269.709	-269.790	-269.871	-269.951	-270.032	-270.113	-270.174	-270.274	-270.355	-270.436
EXG.RAIL LEVEL OF NEAREST IR UP MAIN LINE(ERL)	-269.953	-268.935	-269.974	-269.008	-269.039	-269.070	-269.105	-269.151	-269.220	-269.287	-269.350	-269.410	-269.492	-269.560	-269.628	-269.697	-269.733	-269.822	-269.923	-269.993
EQUIVALENT CHAINAGE ON DFC TRACK	286500.0	286520.0	286540.0	286560.0	286580.0	286600.0	286620.0	286640.0	286660.0	286680.0	286700.0	286720.0	286740.0	286760.0	286780.0	286800.0	286820.0	286840.0	286860.0	286880.0
EXISTING IR CHAINAGE	286500.0	286520.0	286540.0	286560.0	286580.0	286600.0	286620.0	286640.0	286660.0	286680.0	286700.0	286720.0	286740.0	286760.0	286780.0	286800.0	286820.0	286840.0	286860.0	286880.0

L - SECTION

NOTE:-

- DFCC WORKS ARE SHOWN IN RED.
- DFC LINK LINE WORKS ARE SHOWN IN VIOLET.
- ALL DIMENSIONS ARE SHOWN IN METRES.
- THIS DRAWING IS PREPARED BASED ON LATEST SURVEY DATA HELD ON APRIL-2022. GTS BENCH MARK OF 261.850M CONSIDERED ON TOP OF CANAL BRIDGE ABUTMENT AT DORANA VILLAGE ALONG THE NH1.
- DFC NEW CHAINAGE OF 1075.950M IS WITH REFERENCE TO THE IR KM OF 187.500KM END OF KM OF CP-303(SECTION P-3 PILKHANI END) AGAINST THE EXISTING DFC CHAINAGE. 116277.742M ISSUED VIDE LETTER NO. COM/DFCC/UMS/SURVEY/2021-301-230116-011173.DT. 17.01.2023.
- BALLAST PROFILE HAS BEEN PROVIDED ACCORDING TO THE CLAUSE 1.11.3 OF STANDARD SCHEDULE OF DIMENSION(EASTERN CORRIDOR) & THE BALLAST CUSHION DIMENSION SHOWN IN 35CM ON GE-14 PARA 17. SPECIFICATIONS & RECOMMENDATIONS 2. TWO LAYER SYSTEM FIG.10.

REFERENCE DRAWINGS :-

- FOR KEY PLAN REFER DRAWING NO. 301-2/AL/0001
- FOR LEGEND AND ABBREVIATIONS REFER DRAWING NO. 301-2/AL/1000
- FOR TYPICAL SECTION OF BALLAST PROFILE (FL-RL) REFER DRG. NO. 301-2/TK/TFD/-004 (TR.1952)

DRG NO.-301-2/AL/A/1199A

0	30.10.2024	SUBMISSION OF AS-BUILT DRAWING	FOR APPROVAL
REV.	DATE	REVISION DETAILS	PURPOSE OF ISSUE

SCALE

HOR - 1:1000

VER - 1:100

SHEET SIZE : A1

LEGEND:

IR TRACK

DFCC TRACK

LINK LINE (SMUN-RP-J)

DFCC FUTURE PROPOSALS

STRUCTURE / BUILDING

DFCC TOE LINE

DFCC FORMATION

RETAINING WALL

ROAD

STREAM, DRAIN, NALA, CANAL

FENCE

POWER LINES

TBM

ELECTRIC POLE/OHE MAST

IR RAILWAY BOUNDARY

DFCC BOUNDARY

TYPICAL SECTION

TRACK STRUCTURE		Difference between FL- RL (Below Rail Seat)	
RAIL SECTION: 60Kg/m (UIC 60Kg/m)		IR Line	DFC
DFC LINE: 60Kg/m (UIC 60Kg/m)		172mm	172mm
IR MAIN LINE: 52Kg/m		6mm	10mm
RUBBER PAD		210mm	210mm
SLEEPER DEPTH		300mm	350mm
BALLAST CUSHION		688mm	742mm
Total Depth (FL TO RL)			

OWNER

DEDICATED FREIGHT CORRIDOR CORPORATION OF INDIA LTD.

(A GOVERNMENT OF INDIA ENTERPRISE)

PROJECT OFFICE(AMBALA UNIT): OLD RAILWAY COLONY (NEAR ANAND MARKET),AMBALA CANTT-133001.

CORPORATE IDENTITY NO. : U60232DL2006GGI15068

ENGINEER:

DB Engineering & Consulting GmbH

Deutsche Bahn Engineering & Consulting GmbH

CONTRACTOR:

GIL - TPL JV

GAR TATA

SUBMITTED BY	GIL - TPL JV		
	DATED	NAME	SIGNATURE
PREPARED BY			
CHECKED BY	30.10.2024	VIJAY PRATAP	
APPROVED BY	30.10.2024	PARASURAM KOTYADA	
APPROVED BY	DEUTSCHE BAHN ENGINEERING & CONSULTING GMBH		
	DATED	NAME	SIGNATURE
Sr. DE./CHIEF ENGINEER		SURESH K.YALANGI	
CHIEF TRACK ENGINEER		RAJ PAL SINGH	
T.L.		H.D. VIDJAK	

STAMP

A AS-BUILT DRAWING TR. Ref..... ENGINEER Sign.:

EMPLOYER (DFCCIL):	DEDICATED FREIGHT CORRIDOR CORPORATION OF INDIA LTD.		

AS BUILT DRAWING

TITLE

AS-BUILT PLAN AND PROFILE DFC LINK LINE

FROM IR KM: 286.500 TO 287.000 DFC KM: 1175.907 TO 1176.408

DFCC APPR. NO. -

ENGG. APPR. NO. -

DRG. NO. - 301-2/AL/A/1199A

SHEET NO. : 1 OF 1

DATE : 30.10.2024

STATUS

A

TR.