



DATUM ABOVE MSL : 265 m

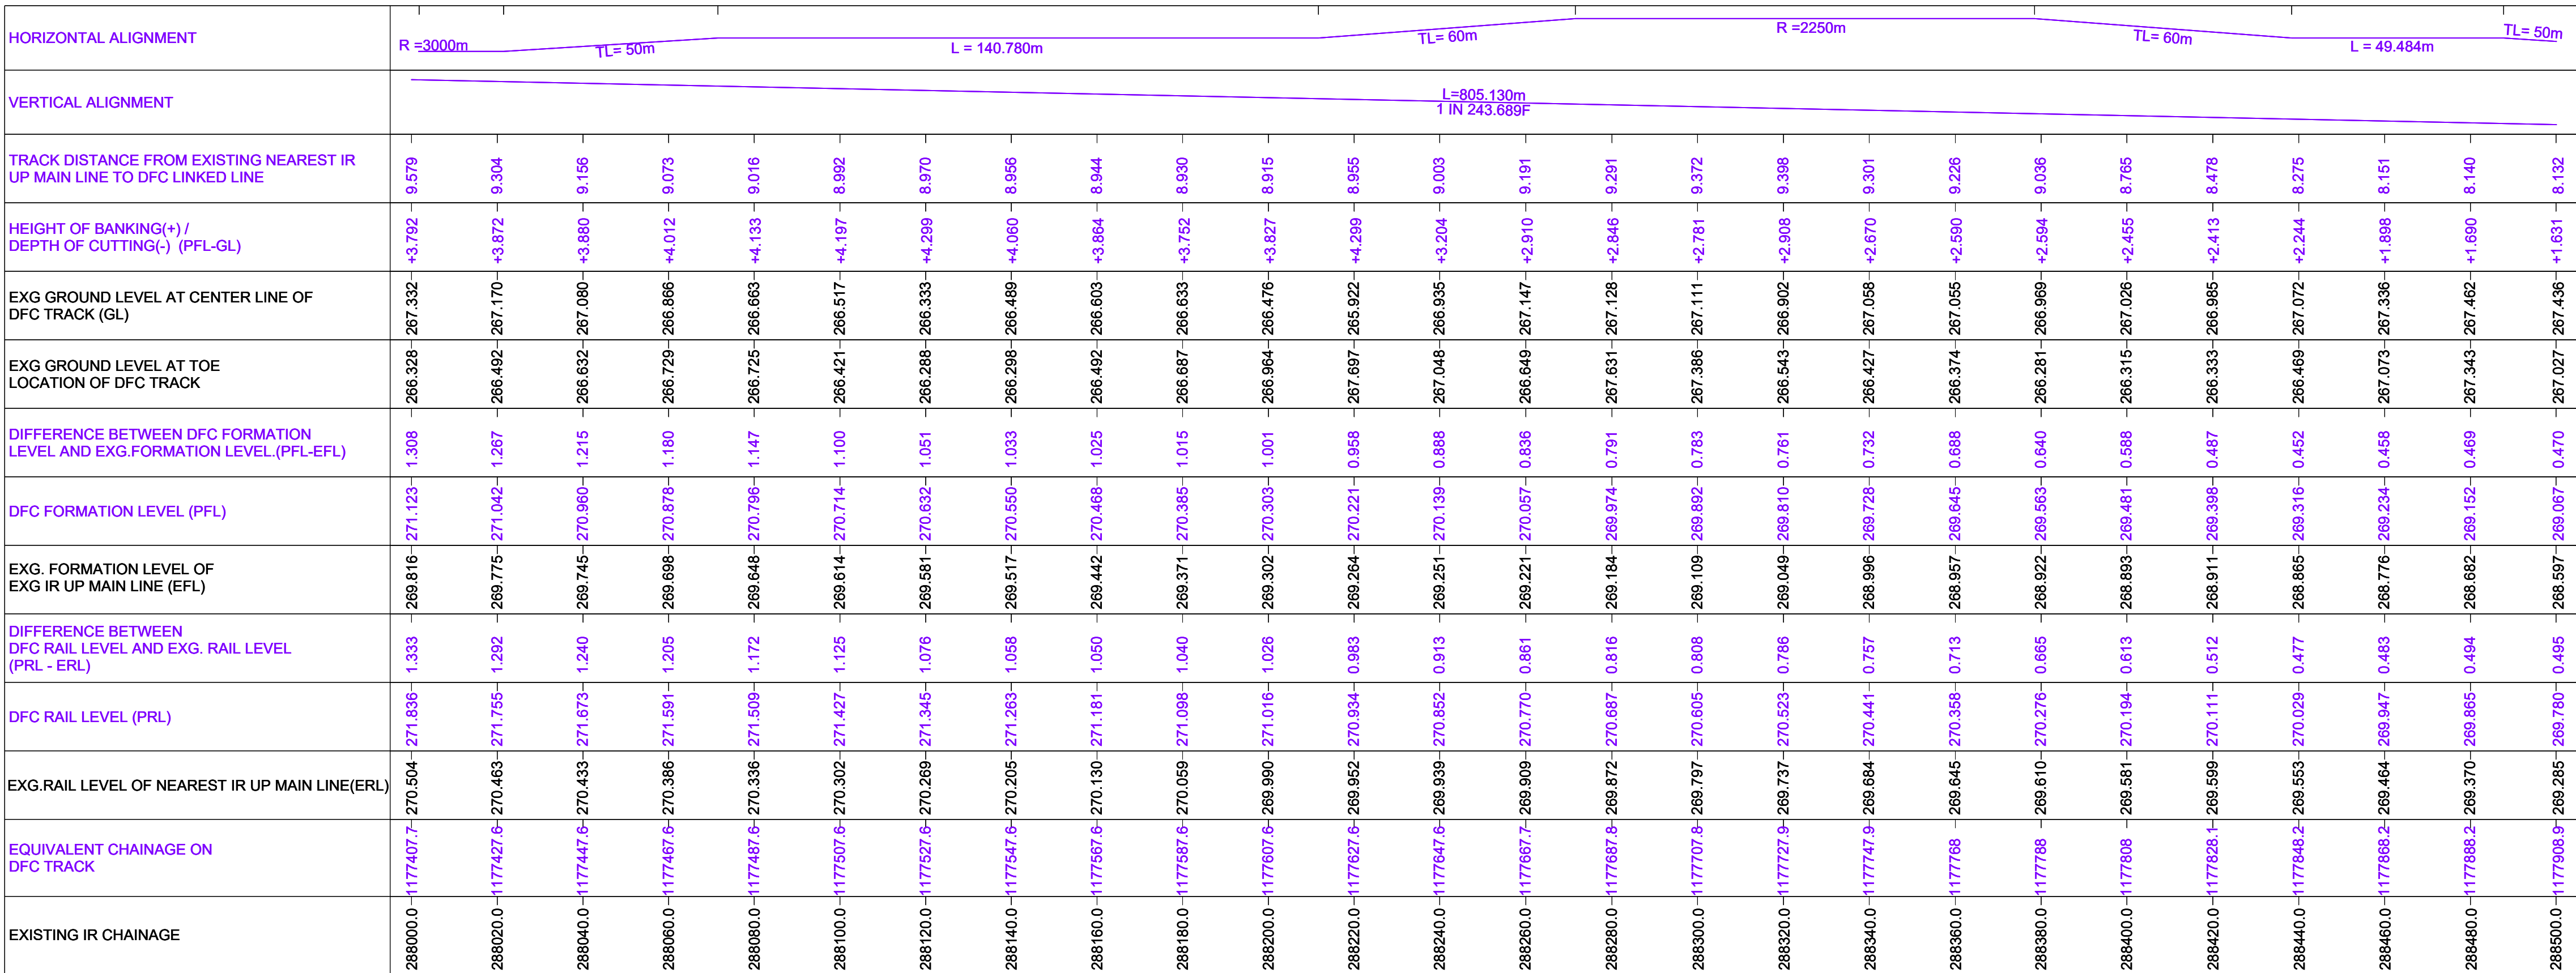

L - SECTION

SAHNEWAL

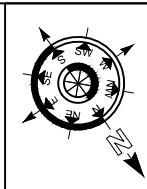


- | | |
|--|--------------------------|
| NOTE:- | DRG NO.-301-2/ALIA/1202A |
| <ol style="list-style-type: none"> 1. DFFC CORKERS ARE SHOWN IN RED. 2. DFC LINK LINE WORKS ARE SHOWN IN VIOLET. 3. ALL DIMENSIONS ARE SHOWN IN METRES. 4. THIS DRAWING IS PREPARED BASED ON LATEST SURVEY DATA HELD ON APRIL-2022. GTS BENCH MARK OF 261.950M CONSIDERED ON TOP OF CANAL BRIDGE ABUTMENT AT DORAKA VILLAGE ALONG THE NH-1. 5. NEW CHAINAGE OF 1075.950M IS WITH REFERENCE TO THE IR KM OF 187.500M END OF KM OF CP-303(SECTION P-3 PLIKHANI) END AGAINST THE EXISTING DFC CHAINAGE. 116277.74M ISSUED VIDE LETTER NO. CM/GMDC/CM/UR/SURVEY/2021-301-2301-1611173 DT. 17.01.2023. 6. NEW ONE LANE (ONE WAY) CORRIDOR & BALLAST CUSHION DIMENSION SHOWN IN 35CM ON GE-14 PALLAST PROFILE HAS BEEN PROVIDED ACCORDING TO THE CLAUSE 11.1.3 OF STANDARD SCHEDULE OF MATERIALS (S.O.M) OF 2010. 7. BALLAST 17. SPECIFICATIONS & RECOMMENDATIONS 2. TWO LAYER SYSTEM FIG.10. | |

REFERENCE DRAWINGS :-


1. FOR KEY PLAN REFER DRAWING NO. 301-2/AL/0001
2. FOR LEGEND AND ABBREVIATIONS REFER DRAWING NO. 301-2/AL1000
3. FOR TYPICAL SECTION OF BALLAST PROFILE (FL-RL) REFFER DRG. NO. 301-2/TK/TFD/-004 (TR.1952)

0	30.10.2024	SUBMISSION OF AS-BUILT DRAWING	FOR APPROVAL
REV.	DATE	REVISION DETAILS	PURPOSE OF ISSUE

LEGEND:

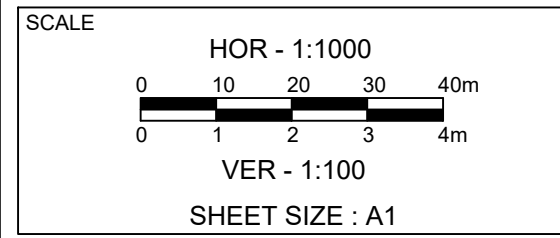

- | | |
|-----------------------------|---|
| IR TRACK |  |
| DFCC TRACK |  |
| LINK LINE (SMUN-RPJ) |  |
| DFCC FUTURE PROPOSALS |  |
| STRUCTURE / BUILDING |  |
| DFCC TOE LINE |  |
| DFCC FORMATION |  |
| RETAINING WALL |  |
| ROAD |  |
| STREAM, DRAIN, NALA, CANAL. |  |
| FENCE |  |
| POWER LINES |  |
| TBM |  |
| ELECTRIC POLE/OHE MAST |  |
| IR RAILWAY BOUNDARY |  |
| DFCC BOUNDARY |  |

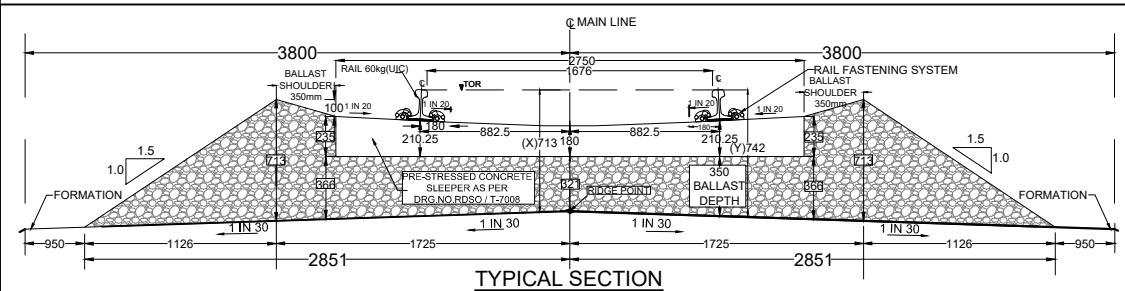

TRACK STRUCTURE		
RAIL SECTION: 60Kg/m (UIC 60Kg/m) DFC LINE: 60kg/m (UIC 60kg/m) IR MAIN LINE: 52Kg/m	Difference between FL- RL (Below Rail Seat)	
	IR Line	DFC
	172mm	172mm
RUBBER PAD	6mm	10mm
SLEEPER DEPTH	210mm	210mm
BALLAST CUSHION	300mm	350mm
Total Depth (FL TO RL)	688mm	742mm

OWNER

DEDICATED FREIGHT CORRIDOR CORPORATION OF INDIA LTD.

(A GOVERNMENT OF INDIA ENTERPRISE)
PROJECT OFFICE(AMBALA UNIT): OLD RAILWAY COLONY (NEAR
ANAND MARKET),AMBALA CANTT-133001.
CORPORATE IDENTITY NO. : U60232DL2006GOI155068

ENGINEER:



DB Engineering & Consulting GmbH
Deutsche Bahn Engineering & Consulting GmbH

CONTRACTOR

GIL - TPL JV



SUBMITTED BY	GIL - TPL JV		
	DATED	NAME	SIGNATURE
PREPARED BY			
CHECKED BY	30.10.2024	VIJAY PRATAP	
APPROVED BY	30.10.2024	PARASURAM KOTYADA	
APPROVED BY	DEUTSCHE BAHN ENGINEERING & CONSULTING GMBH		
	DATED	NAME	SIGNATURE
Sr. DE./CHIEF ENGINEER		SURESH K.YALANGI	
CHIEF TRACK ENGINEER		RAJ PAL SINGH	
T.L.		H.D. VIDJAK	

STAMP

A AS-BUILT DRAWING
TR. Ref.....
ENGINEER Sign.:

EMPLOYER (DFCCIL):

DEDICATED FREIGHT CORRIDOR CORPORATION OF INDIA LTD

AS BUILT DRAWING

TITLE AS-BUILT PLAN AND PROFILE DFC LINK LINE FROM IR KM: 288.000 TO 288.500 DFC KM: 1177.408 TO 1177.909	DFCC APPR. NO. -	STATUS A
	ENGG. APPR. NO. -	
	DRG. NO. -301-2/AL/A/1202A	
	SHEET NO. : 1 OF 1	
	DATE : 30.10.2024	

TR.