
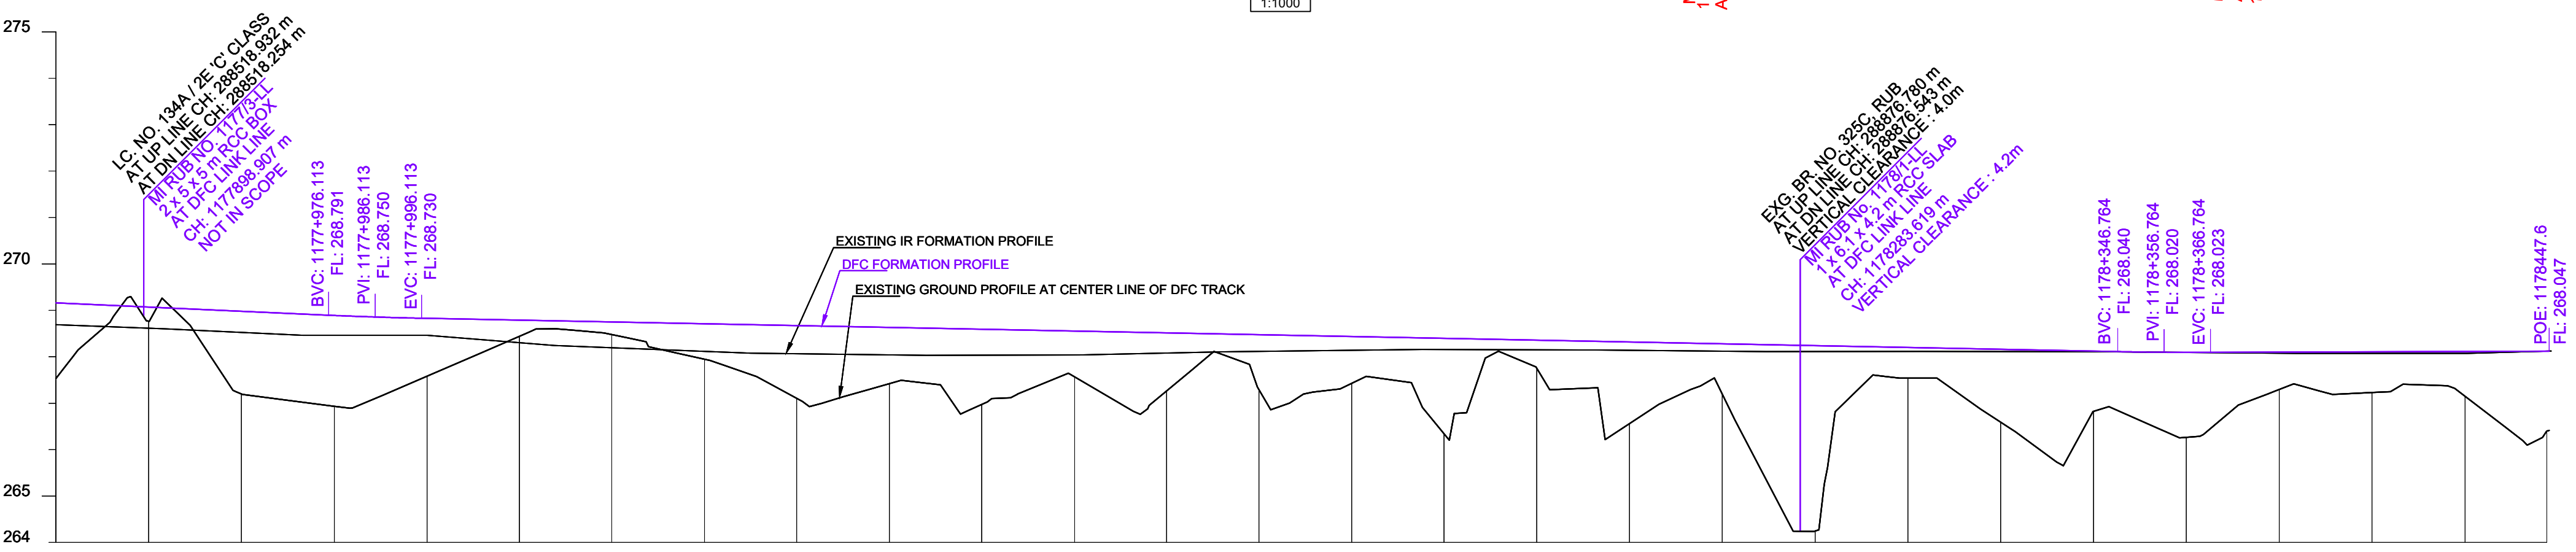
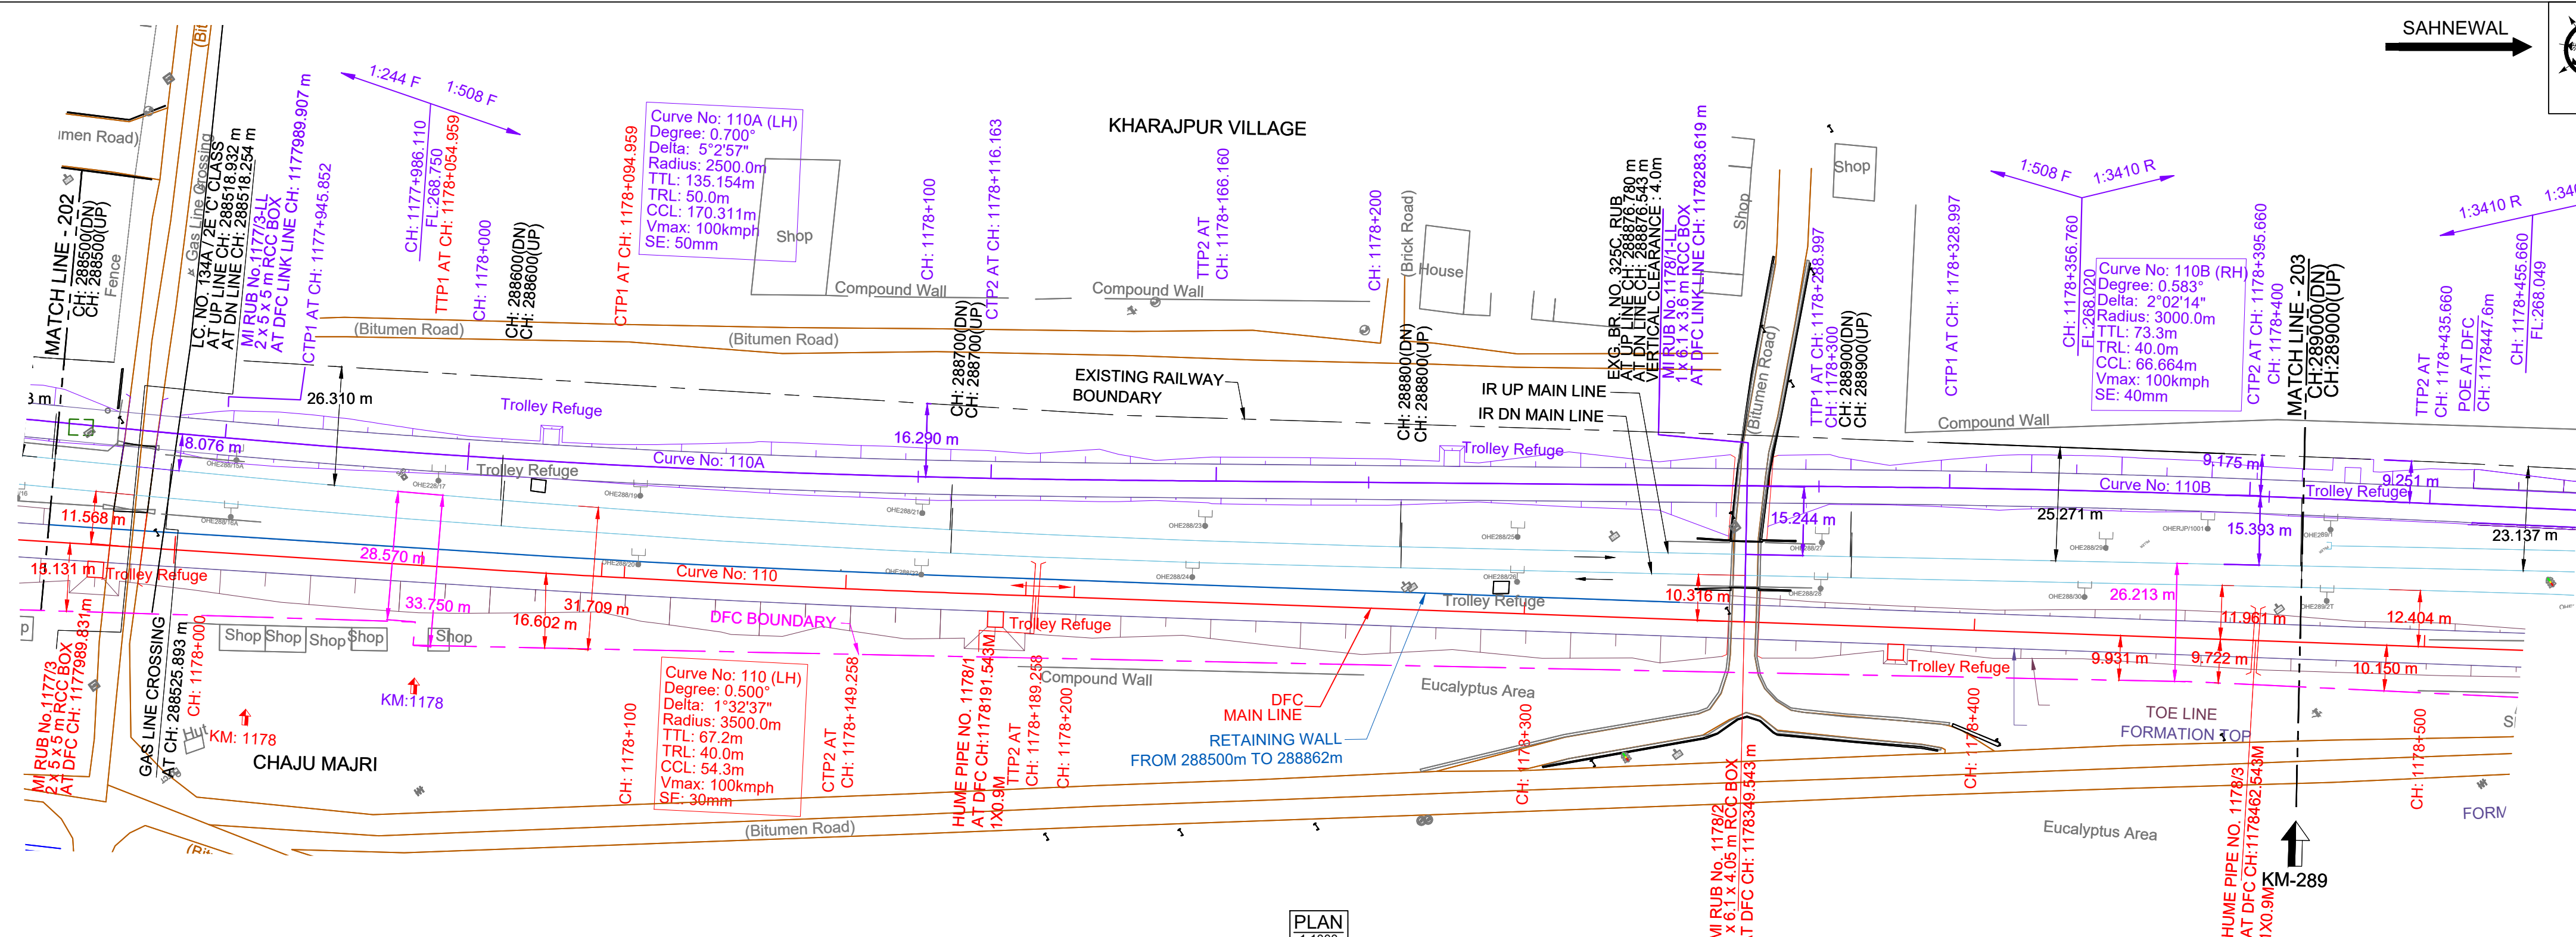


PILKHANI

SAHNEWAL

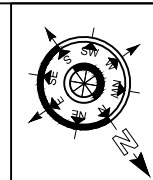

DATUM ABOVE MSL : 264 m

HORIZONTAL ALIGNMENT																				
VERTICAL ALIGNMENT																				
TRACK DISTANCE FROM EXISTING NEAREST IR UP MAIN LINE TO DFC LINKED LINE	8.132	8.132	8.132	8.132	8.132	8.132	8.132	8.132	8.132	8.132	8.132	8.132	8.132	8.132	8.132	8.132	8.132	8.132	8.132	
HEIGHT OF BANKING(+) / DEPTH OF CUTTING(-) (PFL-GL)	+1.631	+1.631	+1.631	+1.631	+1.631	+1.631	+1.631	+1.631	+1.631	+1.631	+1.631	+1.631	+1.631	+1.631	+1.631	+1.631	+1.631	+1.631	+1.631	
EXG GROUND LEVEL AT CENTER LINE OF DFC TRACK (GL)	267.436	267.436	267.436	267.436	267.436	267.436	267.436	267.436	267.436	267.436	267.436	267.436	267.436	267.436	267.436	267.436	267.436	267.436	267.436	
EXG GROUND LEVEL AT TOE LOCATION OF DFC TRACK	267.027	267.027	267.027	267.027	267.027	267.027	267.027	267.027	267.027	267.027	267.027	267.027	267.027	267.027	267.027	267.027	267.027	267.027	267.027	
DIFFERENCE BETWEEN DFC FORMATION LEVEL AND EXG.FORMATION LEVEL (PFL-EFL)	0.470	0.470	0.470	0.470	0.470	0.470	0.470	0.470	0.470	0.470	0.470	0.470	0.470	0.470	0.470	0.470	0.470	0.470	0.470	
DFC FORMATION LEVEL (PFL)	268.067	268.067	268.067	268.067	268.067	268.067	268.067	268.067	268.067	268.067	268.067	268.067	268.067	268.067	268.067	268.067	268.067	268.067	268.067	
EXG. FORMATION LEVEL OF EXG IR UP MAIN LINE (EFL)	268.597	268.597	268.597	268.597	268.597	268.597	268.597	268.597	268.597	268.597	268.597	268.597	268.597	268.597	268.597	268.597	268.597	268.597	268.597	
DIFFERENCE BETWEEN DFC RAIL LEVEL AND EXG. RAIL LEVEL (PRL - ERL)	0.495	0.495	0.495	0.495	0.495	0.495	0.495	0.495	0.495	0.495	0.495	0.495	0.495	0.495	0.495	0.495	0.495	0.495	0.495	
DFC RAIL LEVEL (PRL)	268.780	268.780	268.780	268.780	268.780	268.780	268.780	268.780	268.780	268.780	268.780	268.780	268.780	268.780	268.780	268.780	268.780	268.780	268.780	
EXG.RAIL LEVEL OF NEAREST IR UP MAIN LINE(ERL)	269.285	269.285	269.285	269.285	269.285	269.285	269.285	269.285	269.285	269.285	269.285	269.285	269.285	269.285	269.285	269.285	269.285	269.285	269.285	
EQUIVALENT CHAINAGE ON DFC TRACK (LINK LINE)	-1177908.9	-1177908.9	-1177908.9	-1177908.9	-1177908.9	-1177908.9	-1177908.9	-1177908.9	-1177908.9	-1177908.9	-1177908.9	-1177908.9	-1177908.9	-1177908.9	-1177908.9	-1177908.9	-1177908.9	-1177908.9	-1177908.9	
EXISTING IR CHAINAGE	288500.0	288500.0	288500.0	288500.0	288500.0	288500.0	288500.0	288500.0	288500.0	288500.0	288500.0	288500.0	288500.0	288500.0	288500.0	288500.0	288500.0	288500.0	288500.0	

L - SECTION

- NOTE:-
- DFCC WORKS ARE SHOWN IN RED.
 - DFC LINK LINE WORKS ARE SHOWN IN VIOLET.
 - ALL DIMENSIONS ARE SHOWN IN METRES.
 - THIS DRAWING IS PREPARED BASED ON LATEST SURVEY DATA HELD ON APRIL-2022. GTS BENCH MARK OF 261.850M CONSIDERED ON TOP OF CANAL BRIDGE ABUTMENT AT DORANA VILLAGE ALONG THE NH1.
 - DFC NEW CHAINAGE OF 1075.950M IS WITH REFERENCE TO THE IR KM OF 187.500KM END OF KM OF CP-303(SECTION P-3 PILKHANI END) AGAINST THE EXISTING DFC CHAINAGE. 116277.742M ISSUED VIDE LETTER NO. COM/DFCC/MS/SURVEY/2021-301-2301/16-011173 DT. 17.01.2023.
 - BALLAST PROFILE HAS BEEN PROVIDED ACCORDING TO THE CLAUSE 1.11.3 OF STANDARD SCHEDULE OF DIMENSION(EASTERN CORRIDOR) & THE BALLAST CUSHION DIMENSION SHOWN IN 35CM ON GE-14 PARA 17. SPECIFICATIONS & RECOMMENDATIONS 2. TWO LAYER SYSTEM FIG.10.

- REFERENCE DRAWINGS:-
- FOR KEY PLAN REFER DRAWING NO. 301-2/AL/0001
 - FOR LEGEND AND ABBREVIATIONS REFER DRAWING NO. 301-2/AL/1000
 - FOR TYPICAL SECTION OF BALLAST PROFILE (FL-RL) REFER DRG. NO. 301-2/TK/TFD/004 (TR.1952)

REV.	DATE	SUBMISSION OF AS-BUILT DRAWING	PURPOSE OF ISSUE
0	30.10.2024	SUBMISSION OF AS-BUILT DRAWING	FOR APPROVAL

LEGEND:


- IR TRACK
- DFCC TRACK
- LINK LINE (SMUN-RPJ)
- DFCC FUTURE PROPOSALS
- STRUCTURE / BUILDING
- DFCC TOE LINE
- DFCC FORMATION
- RETAINING WALL
- ROAD
- STREAM, DRAIN, NALA, CANAL
- FENCE
- POWER LINES
- TBM
- ELECTRIC POLE/OHE MAST
- IR RAILWAY BOUNDARY
- DFCC BOUNDARY

SCALE

HOR - 1:1000

VER - 1:100

SHEET SIZE : A1

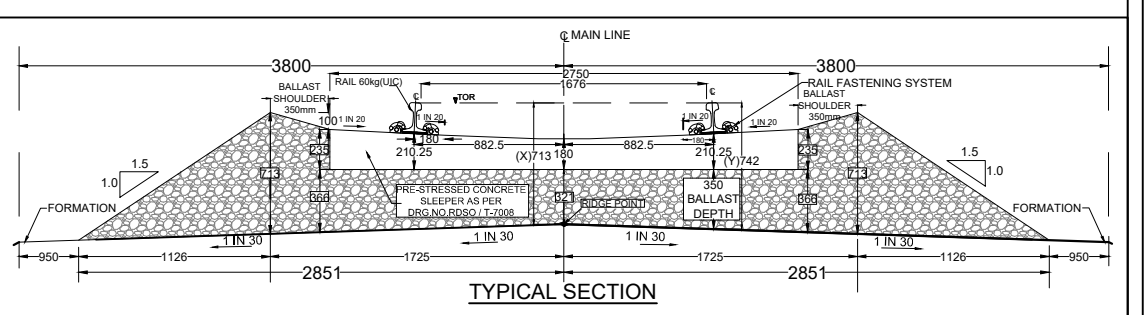

TRACK STRUCTURE		
RAIL SECTION: 60Kg/m (UIC 60Kg/m) DFC LINE: 60Kg/m (UIC 60Kg/m) IR MAIN LINE: 52Kg/m	Difference between FL- RL (Below Rail Seat)	
	IR Line	DFC
RUBBER PAD	172mm	172mm
SLEEPER DEPTH	210mm	210mm
BALLAST CUSHION	300mm	350mm
Total Depth (FL TO RL)	688mm	742mm

OWNER: DEDICATED FREIGHT CORRIDOR CORPORATION OF INDIA LTD. (A GOVERNMENT OF INDIA ENTERPRISE)
PROJECT OFFICE(AMBALA UNIT): OLD RAILWAY COLONY (NEAR ANAND MARKET),AMBALA CANTT-133001.
CORPORATE IDENTITY NO. : U60232DL2006GGI15068

ENGINEER: DB Engineering & Consulting GmbH
Deutsche Bahn Engineering & Consulting GmbH

CONTRACTOR: GIL - TPL JV
GAR TATA

SUBMITTED BY	GIL - TPL JV		
	DATED	NAME	SIGNATURE
PREPARED BY			
CHECKED BY	30.10.2024	VIJAY PRATAP	
APPROVED BY	30.10.2024	PARASURAM KOTYADA	

APPROVED BY	DEUTSCHE BAHN ENGINEERING & CONSULTING GMBH		
	DATED	NAME	SIGNATURE
Sr. DE./CHIEF ENGINEER		SURESH K.YALANGI	
CHIEF TRACK ENGINEER		RAJ PAL SINGH	
T.L.		H.D. VIDJAK	

STAMP

AS-BUILT DRAWING
TR. Ref.:.....
ENGINEER Sign.:.....

EMPLOYER (DFCCIL): DEDICATED FREIGHT CORRIDOR CORPORATION OF INDIA LTD.

AS BUILT DRAWING		
TITLE		DFCC APPR. NO. -
AS-BUILT PLAN AND PROFILE		ENGG. APPR. NO. -
FROM IR KM: 288.500 TO 289.037		DRG. NO. - 301-2/AL/A/1203A
DFC LINK LINE		SHEET NO. : 1 OF 1
DATE : 30.10.2024		STATUS
		A

TR.