



DEDICATED FREIGHT CORRIDOR CORPORATION OF INDIA LTD.
(A GOVERNMENT OF INDIA ENTERPRISE)

EASTERN DEDICATED FREIGHT CORRIDOR
SAHNEWAL TO PILKHANI SECTION
CONTRACT PACKAGE - 301

PLAN & PROFILE OF AS BUILT DRAWINGS FOR DFC MAIN LINE

IR CHAINAGE FROM 283.000 KM TO 297.500 KM
DFCC CHAINAGE FROM KM 1172.407 TO KM 1186.989

DESIGN CONSULTANT





ENGINEER



CONTRACTOR CLIENT
GIL - TPL JV



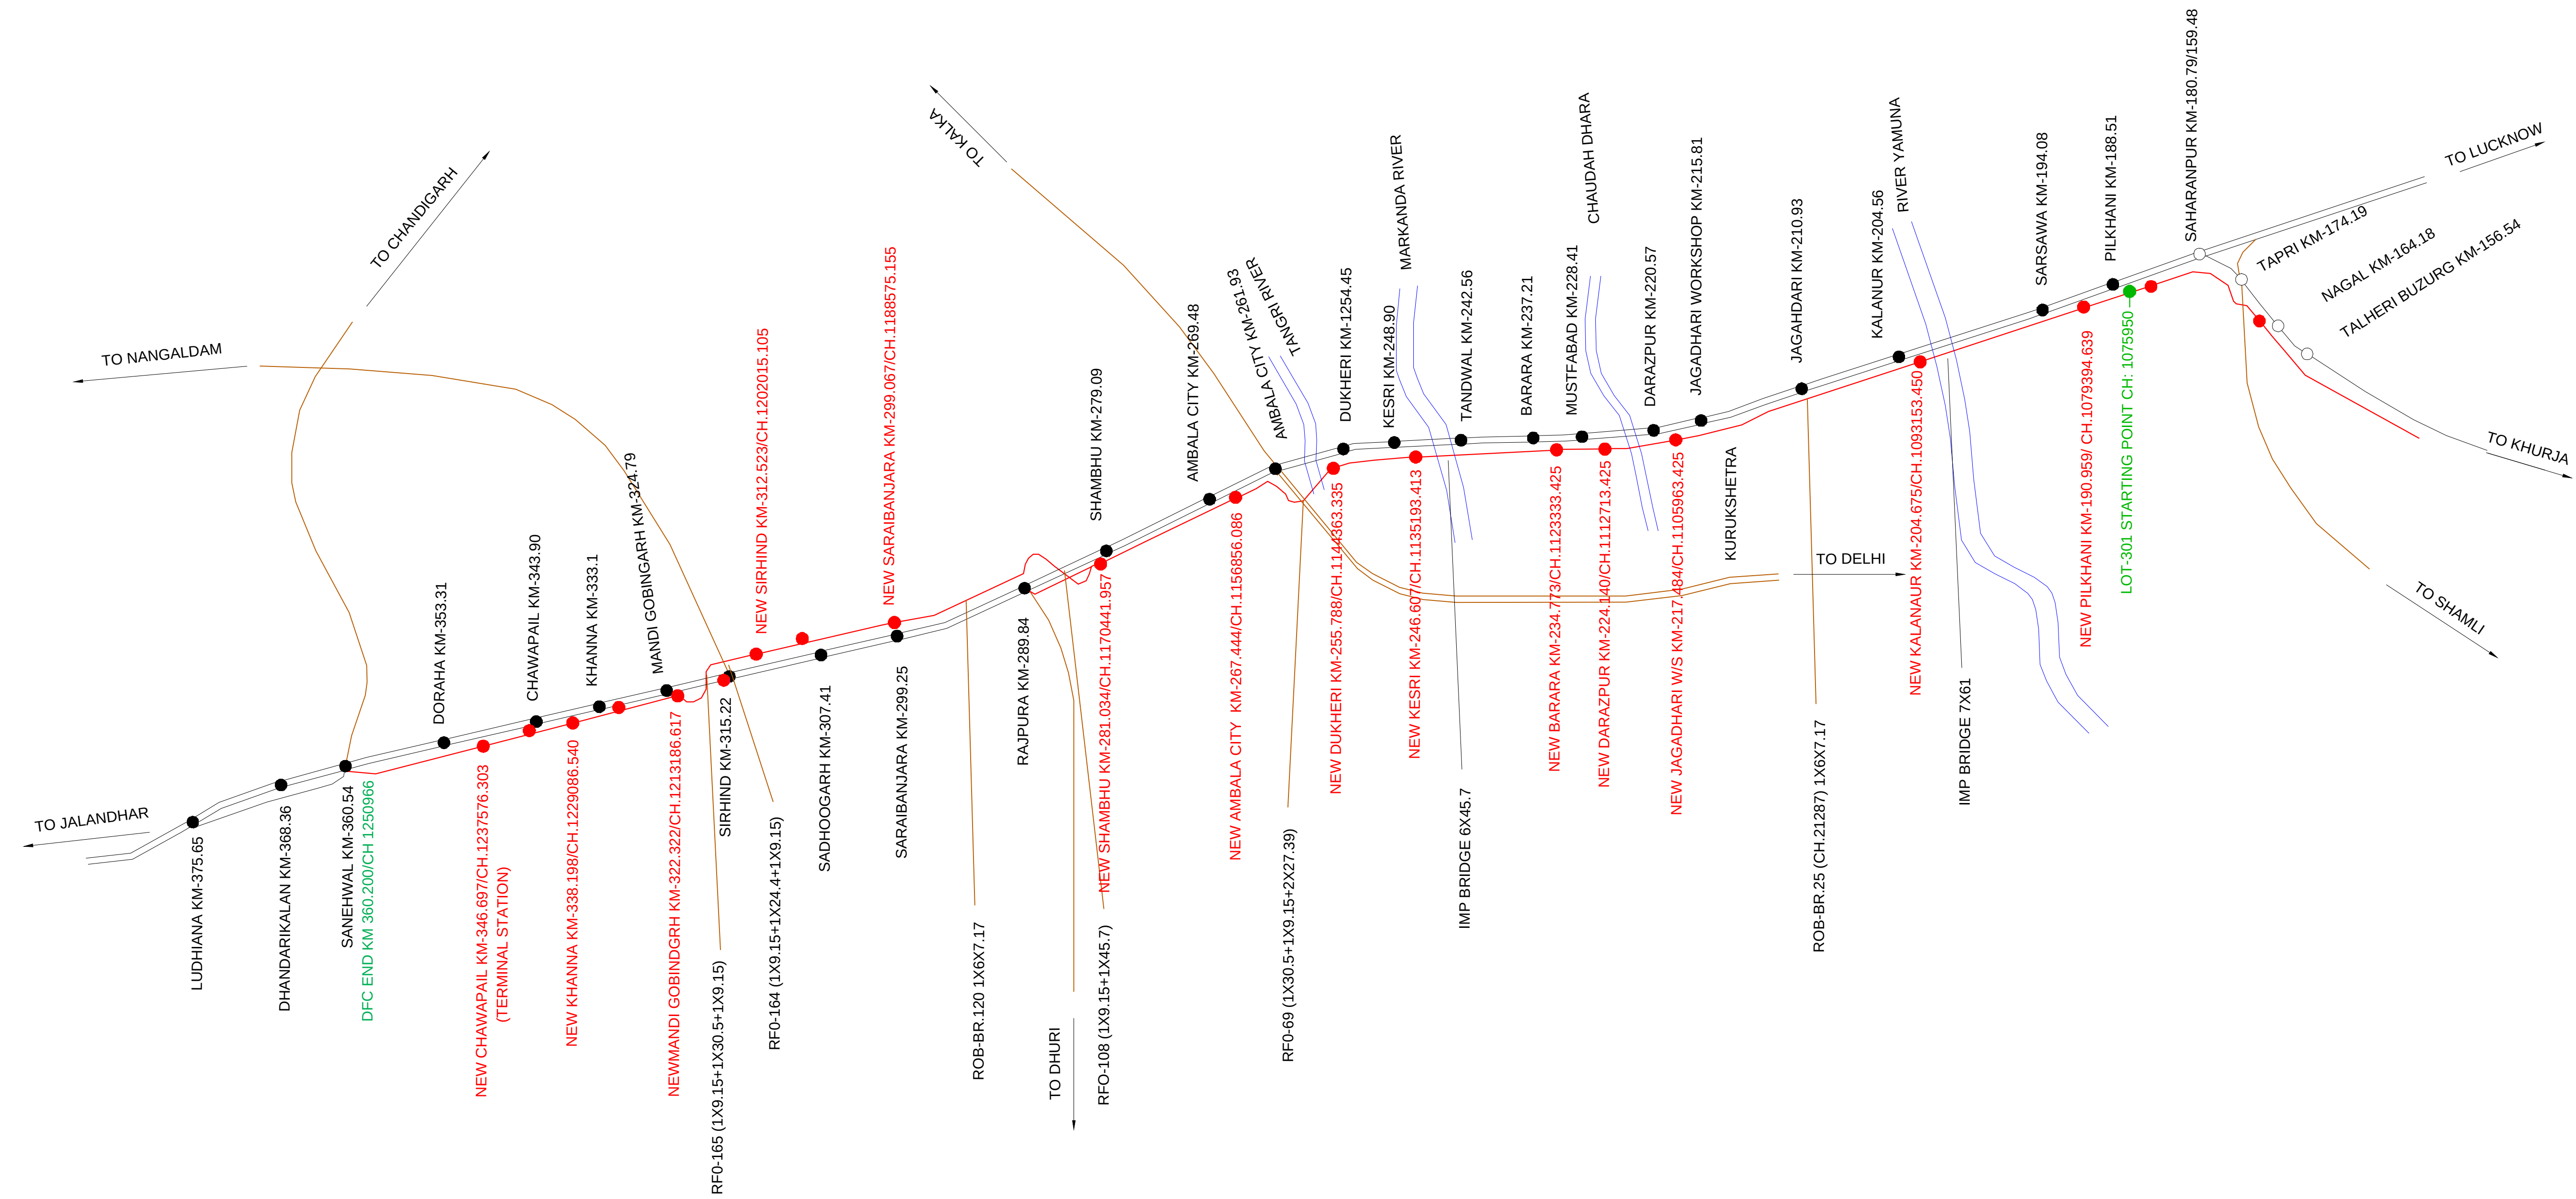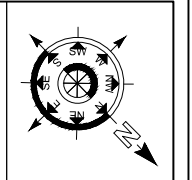

--	--	
DESIGN CONSULTANT

aarvee associates
architects engineers & consultants pvt.ltd.

CONTRACTOR

GIL - TPL JV

ENGINEER

DB Engineering & Consulting GmbH

OWNER

उत्तर प्रदेश रेलवे कोरपोरेशन

DEDICATED FREIGHT CORRIDOR CORPORATION OF INDIA LTD.
(A GOVERNMENT OF INDIA ENTERPRISE)
PROJECT OFFICE(AMBALA UNIT): OLD RAILWAY COLONY (NEAR ANAND MARKET),AMBALA CANTT-133001.
CORPORATE IDENTITY NO. : U60232DL2006GOI155068

PROJECT
EASTERN DEDICATED FREIGHT CORRIDOR
SAHNEWAL TO PILKHANI
CONTRACT PACKAGE - 301


TITLE
ALIGNMENT DRAWINGS
KEY PLAN

DFCC APPR. NO. -
ENGG. APPR. NO. -
DRG. NO. - 301-2/AL/0001
SHEET NO. : 1 OF 1
DATE : 15-06-2024
REV. No. 0
STATUS A

LEGEND	
EXISTING IR TRACK	
DFC TRACK	
DFC FUTURE PROPOSALS	
IR PROPOSALS	
TOE LINE	
FORMATION CESS	
RETAINING WALL	
DRAIN CUM RETAINING WALL	
ROAD	
STREAM, DRAIN, NALA, CANAL.	
FENCE	
POWER LINES	
GPS POINTS	
ELECTRIC POLE/OHE MAST	
EXISTING RAILWAY BOUNDARY	
DFC BOUNDARY	
DISMANTLED WORKS	
IOCL PIPE LINE	
IOCL ROW	
SIGNALLING CABLE PIPE	

ABBREVIATIONS		
1.	BL	- BED LEVEL
2.	BVC	- BEGIN OF VERTICAL CURVE
3.	Ca	- APPLIED CANT
4.	CCL	- CIRCULAR CURVE LENGTH
5.	CTP1	- COMMON TANGENT POINT
6.	CTP2	- COMMON TANGENT POINT
7.	DEGREE	- DEGREE OF CURVE
8.	DE	- DEAD END
9.	ECL	- EXISTING CLEARANCE
10.	EFB	- EXISTING FREE BOARD
11.	EFL	- EXISTING FORMATION LEVEL
12.	ERL	- EXISTING RAIL LEVEL
13.	ESL	- EXISTING SOFFIT LEVEL
14.	EVC	- END OF VERTICAL CURVE
15.	EVCL	- EXISTING VERTICAL CLEARANCE
16.	F/CSB	- FROM CENTER LINE OF STN BLDG
17.	FM	- FOULING MARK
18.	FSL	- FULL SUPPLY LEVEL
19.	HFL	- HIGH FLOOD LEVEL
20.	L	- STRAIGHT LENGTH
21.	LH	- LEFT HANDED
22.	LHS	- LIMITED HEIGHT SUBWAY
23.	PCL	- PROPOSED CLEARANCE
24.	PFB	- PROPOSED FREE BOARD
25.	PFL	- PROPOSED FORMATION LEVEL
26.	PRL	- PROPOSED RAIL LEVEL
27.	PSL	- PROPOSED SOFFIT LEVEL
28.	PVCL	- PROPOSED VERTICAL CLEARANCE
29.	PVI	- POINT OF VERTICAL INTERSECTION
30.	R	- RADIUS
31.	REV.BL	- REVISED BED LEVEL
32.	RH	- RIGHT HANDED
33.	Rr	- RESULTANT RADIUS
34.	SE	- SUPER ELEVATION
35.	SRJ	- STOCK RAIL JOINT
36.	TS	- TRAP SWITCH
37.	TTL	- TOTAL TANGENT LENGTH
38.	TTP1	- TRANSITION TANGENT POINT
39.	TTP2	- TRANSITION TANGENT POINT
40.	TL	- TRANSITION LENGTH
41.	DELTA	- DEFLECTION ANGLE

					SCALE	DESIGN CONSULTANT	CONTRACTOR	ENGINEER	OWNER	PROJECT	TITLE	DFCC APPR. NO. -			
					NOT TO SCALE	 aarvee associates architects engineers & consultants pvt.ltd.	  GIL - TPL JV	 DB Engineering & Consulting GmbH	 मेडीफ्रेट फ्रेट कॉर्पोरेश	DEDICATED FREIGHT CORRIDOR CORPORATION OF INDIA LTD. (A GOVERNMENT OF INDIA ENTERPRISE) PROJECT OFFICE(AMBALA UNIT): OLD RAILWAY COLONY (NEAR ANAND MARKET),AMBALA CANTT-133001. CORPORATE IDENTITY NO. : U60232DL2006GOI155068	EASTERN DEDICATED FREIGHT CORRIDOR SAHNEWAL TO PILKHANI CONTRACT PACKAGE - 301	ALIGNMENT DRAWINGS LEGEND AND ABBREVIATIONS	ENG. APPR. NO. -		
															DRG. NO. - 301-2/AL/1000
															SHEET NO. : 1 OF 1
REV.	DATE		REVISION DETAILS	PURPOSE OF ISSUE								DATE : 15-06-2024	0	A	

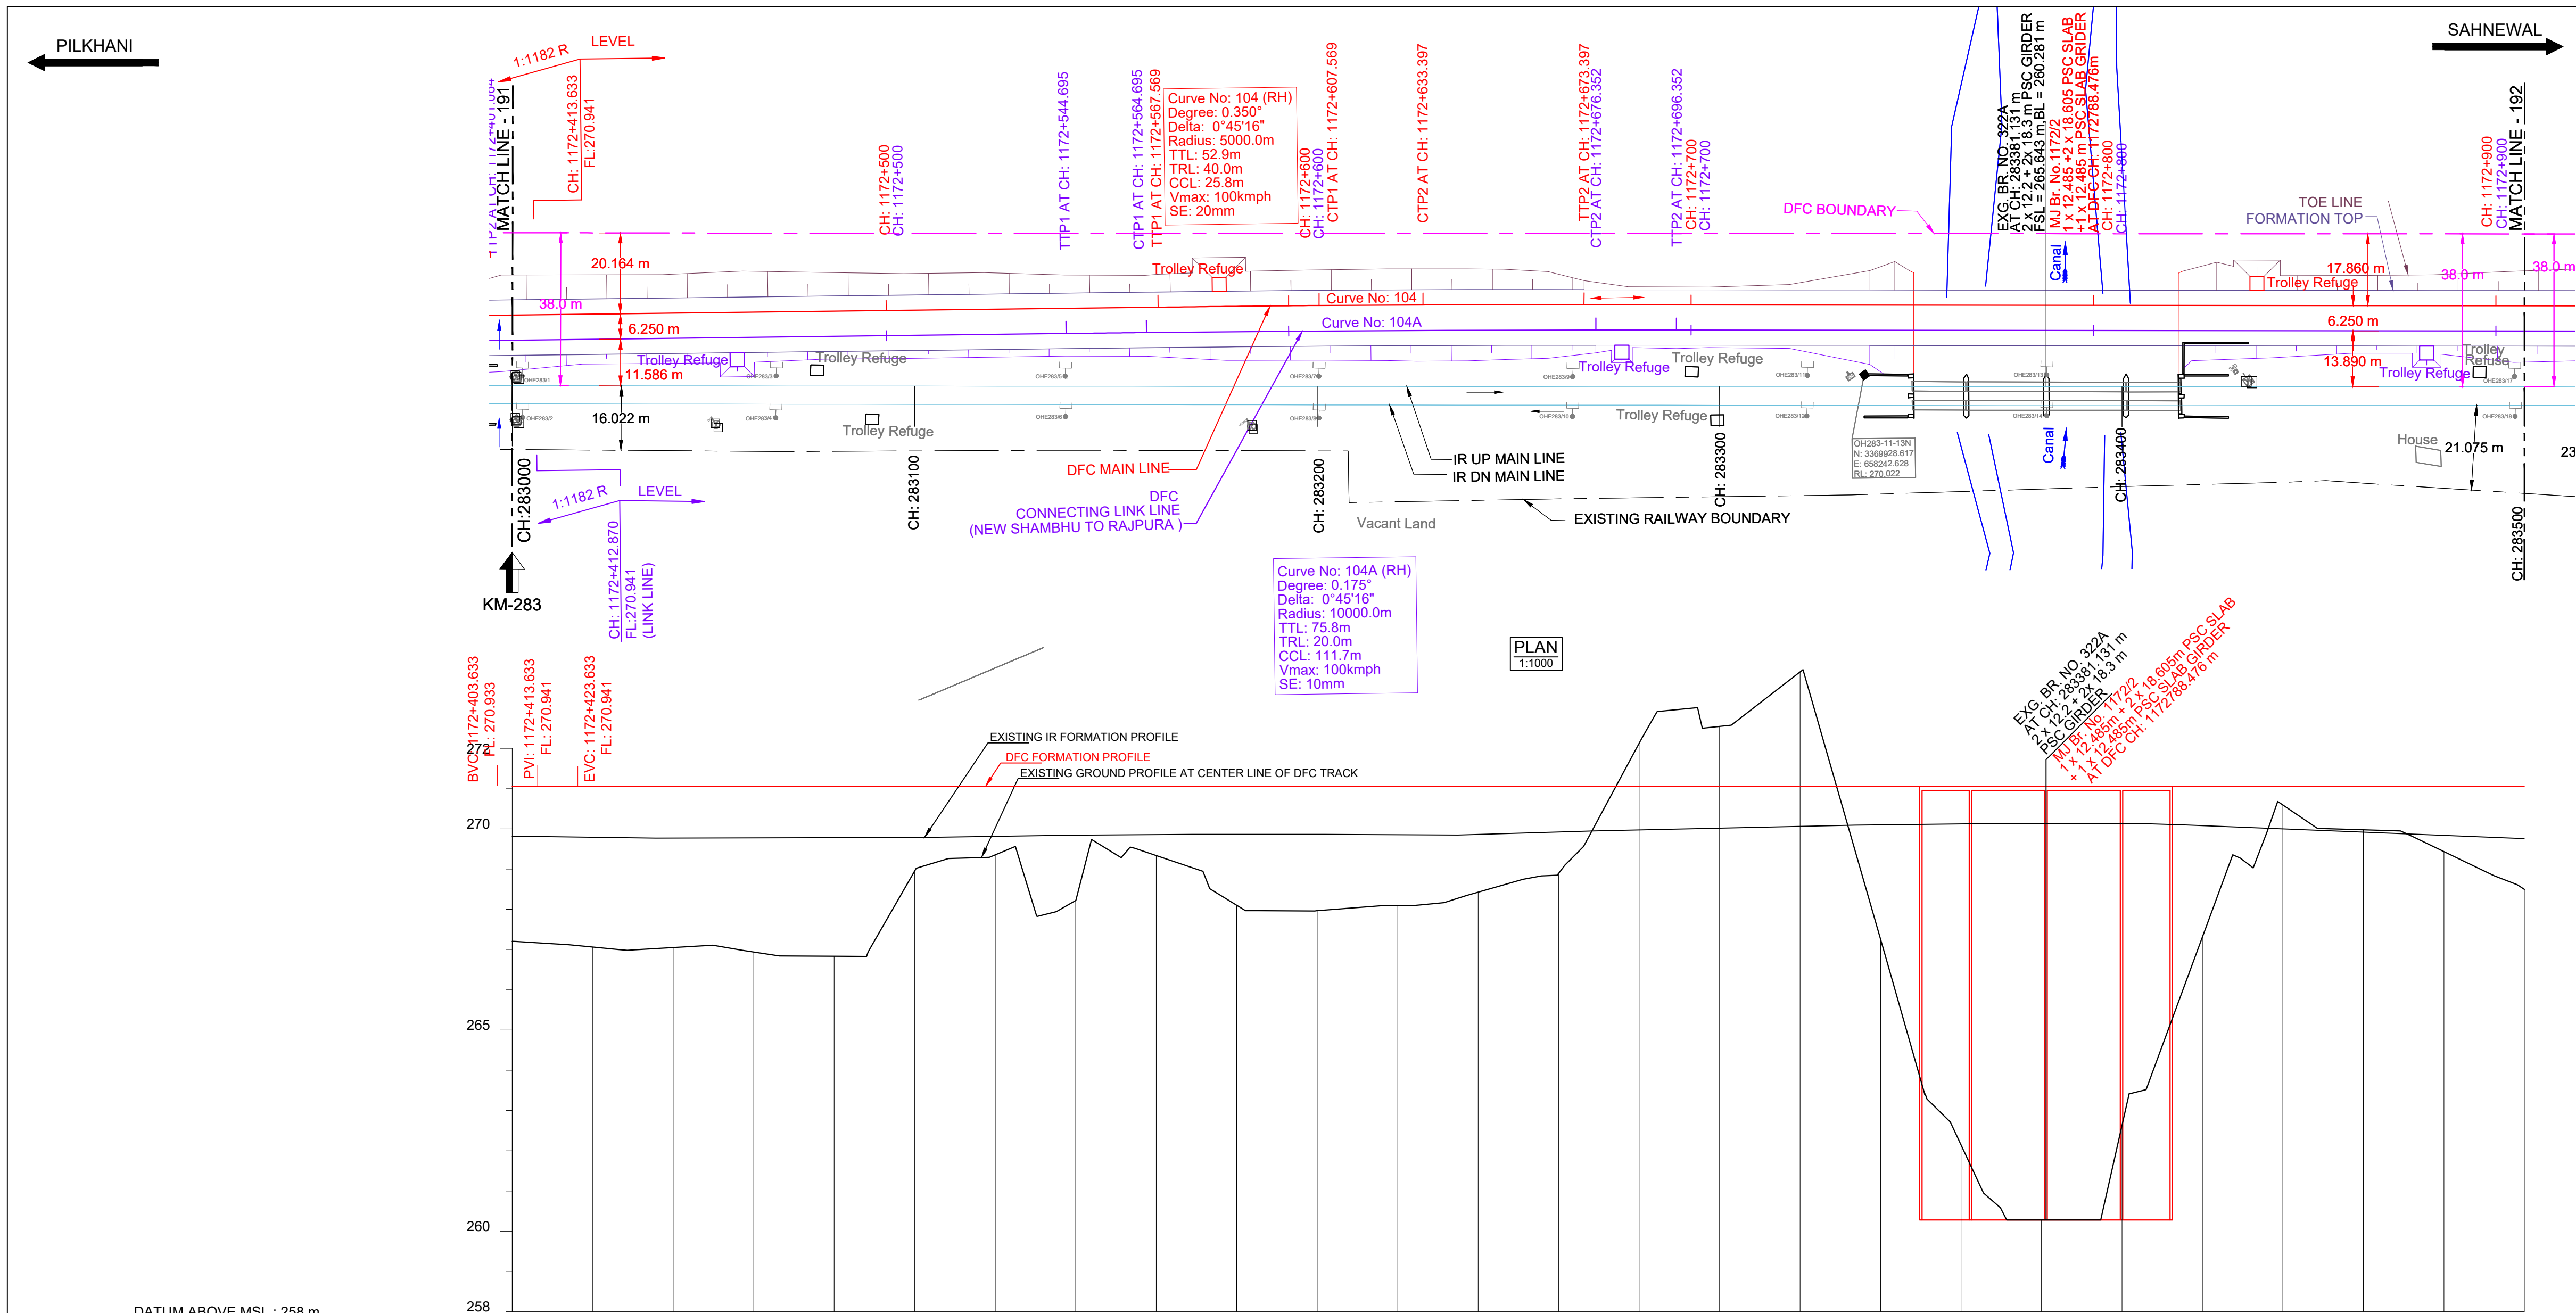

DATUM ABOVE MSL : 258 m

HORIZONTAL ALIGNMENT	L = 166.546m																												TL= 40m				R =5000m				TL= 40m				L = 554.292m																																																																																																																																																																																																																																																																																																																																																																																																																																																																																																																																																																																																																																																																																																																																																																																
VERTICAL ALIGNMENT	L=20.0 m R=23650 m																												L=597.289 m LEVEL																																																																																																																																																																																																																																																																																																																																																																																																																																																																																																																																																																																																																																																																																																																																																																																												
TRACK DISTANCE FROM EXISTING NEAREST IR UP MAIN LINE TO DFC MAIN LINE	17.540	17.540	
L - SECTION

NOTE:

- DFCC WORKS ARE SHOWN IN RED.
- IR NEW WORKS ARE SHOWN IN VIOLET.
- ALL DIMENSIONS ARE SHOWN IN METRES.
- THIS DRAWING IS PREPARED BASED ON LATEST SURVEY DATA HELD ON APRIL-2022. GTS BENCH MARK OF 261.850M CONSIDERED ON TOP OF CANAL BRIDGE ABUTMENT AT DORANA VILLAGE ALONG THE NH1.
- DFC NEW CHAINAGE OF 1075.950M IS WITH REFERENCE TO THE IR KM OF 187.500KM END OF KM OF CP-303(SECTION P-3 PILKHANI END) AGAINST THE EXISTING DFC CHAINAGE. 116277.742M ISSUED VIDE LETTER NO. COM/DFCC/MB/SURVEY/2021-301-28016-01173.DT. 17.01.2023
- BALLAST PROFILE HAS BEEN PROVIDED ACCORDING TO THE CLAUSE 1.11.3 OF STANDARD SCHEDULE OF DIMENSION(EASTERN CORRIDOR) & THE BALLAST CUSHION DIMENSION SHOWN IN 35CM ON GE-14 PARA 17. SPECIFICATIONS & RECOMMENDATIONS 2. TWO LAYER SYSTEM FIG.10.

REFERENCE DRAWINGS :-

- FOR KEY PLAN REFER DRAWING NO. 301-2/AL/0001
- FOR LEGEND AND ABBREVIATIONS REFER DRAWING NO. 301-2/AL/1000
- FOR TYPICAL SECTION OF BALLAST PROFILE (FL-RL) REFER DRG. NO. 301-2/TK/TFD/004 (TR.1952)

027.08.2024SUBMISSION OF AS-BUILT DRAWINGFOR APPROVAL

REV. DATE REVISION DETAILS PURPOSE OF ISSUE

SCALE
HOR - 1:1000
VER - 1:100
SHEET SIZE : A1

LEGEND:

- IR TRACK
- DFCC TRACK
- LINK LINE (SMUN-RP-J)
- DFCC FUTURE PROPOSALS
- STRUCTURE / BUILDING
- DFCC TOE LINE
- DFCC FORMATION
- RETAINING WALL
- ROAD
- STREAM, DRAIN, NALA, CANAL.
- FENCE
- POWER LINES
- TBM
- ELECTRIC POLE/OHE MAST
- IR RAILWAY BOUNDARY
- DFCC BOUNDARY

TYPICAL SECTION

TRACK STRUCTURE

RAIL SECTION: 60Kg/m (UIC 60Kg/m)	Difference between FL- RL (Below Rail Seat)	
DFC LINE: 60Kg/m (UIC 60Kg/m)	IR Line	DFC
IR MAIN LINE: 52Kg/m	172mm	172mm
RUBBER PAD	6mm	10mm
SLEEPER DEPTH	210mm	210mm
BALLAST CUSHION	300mm	350mm
Total Depth (FL TO RL)	688mm	742mm

OWNER

DEDICATED FREIGHT CORRIDOR CORPORATION OF INDIA LTD.
(A GOVERNMENT OF INDIA ENTERPRISE)
PROJECT OFFICE(AMBALA UNIT): OLD RAILWAY COLONY (NEAR ANAND MARKET),AMBALA CANTT-133001.
CORPORATE IDENTITY NO. : U60232DL20060G01155068

ENGINEER:

DB Engineering & Consulting GmbH
Deutsche Bahn Engineering & Consulting GmbH

CONTRACTOR:

GIL - TPL JV

SUBMITTED BY	GIL - TPL JV		
	DATED	NAME	SIGNATURE
PREPARED BY			
CHECKED BY	27.08.2024	VIJAY PRATAP	
APPROVED BY	27.08.2024	PARASURAM KOTYADA	
APPROVED BY	DEUTSCHE BAHN ENGINEERING & CONSULTING GMBH		
	DATED	NAME	SIGNATURE
Sr. DE./CHIEF ENGINEER		SURESH K.YALANGI	
CHIEF TRACK ENGINEER		RAJ PAL SINGH	
T.L.		H.D. VIDJAK	

STAMP

AS-BUILT DRAWING
TR. Ref.....
ENGINEER Sign.:

EMPLOYER (DFCCIL):

DEDICATED FREIGHT CORRIDOR CORPORATION OF INDIA LTD.

TITLE


AS-BUILT PLAN AND PROFILE



FROM IR KM: 283.000 TO 283.500
DFC KM: 1172.407 TO 1172.907

DFCC APPR. NO. -
ENGG. APPR. NO. -
DRG. NO. -301-2/AL/A/1192
SHEET NO. : 1 OF 1
DATE : 27.08.2024

STATUS
A

TR.

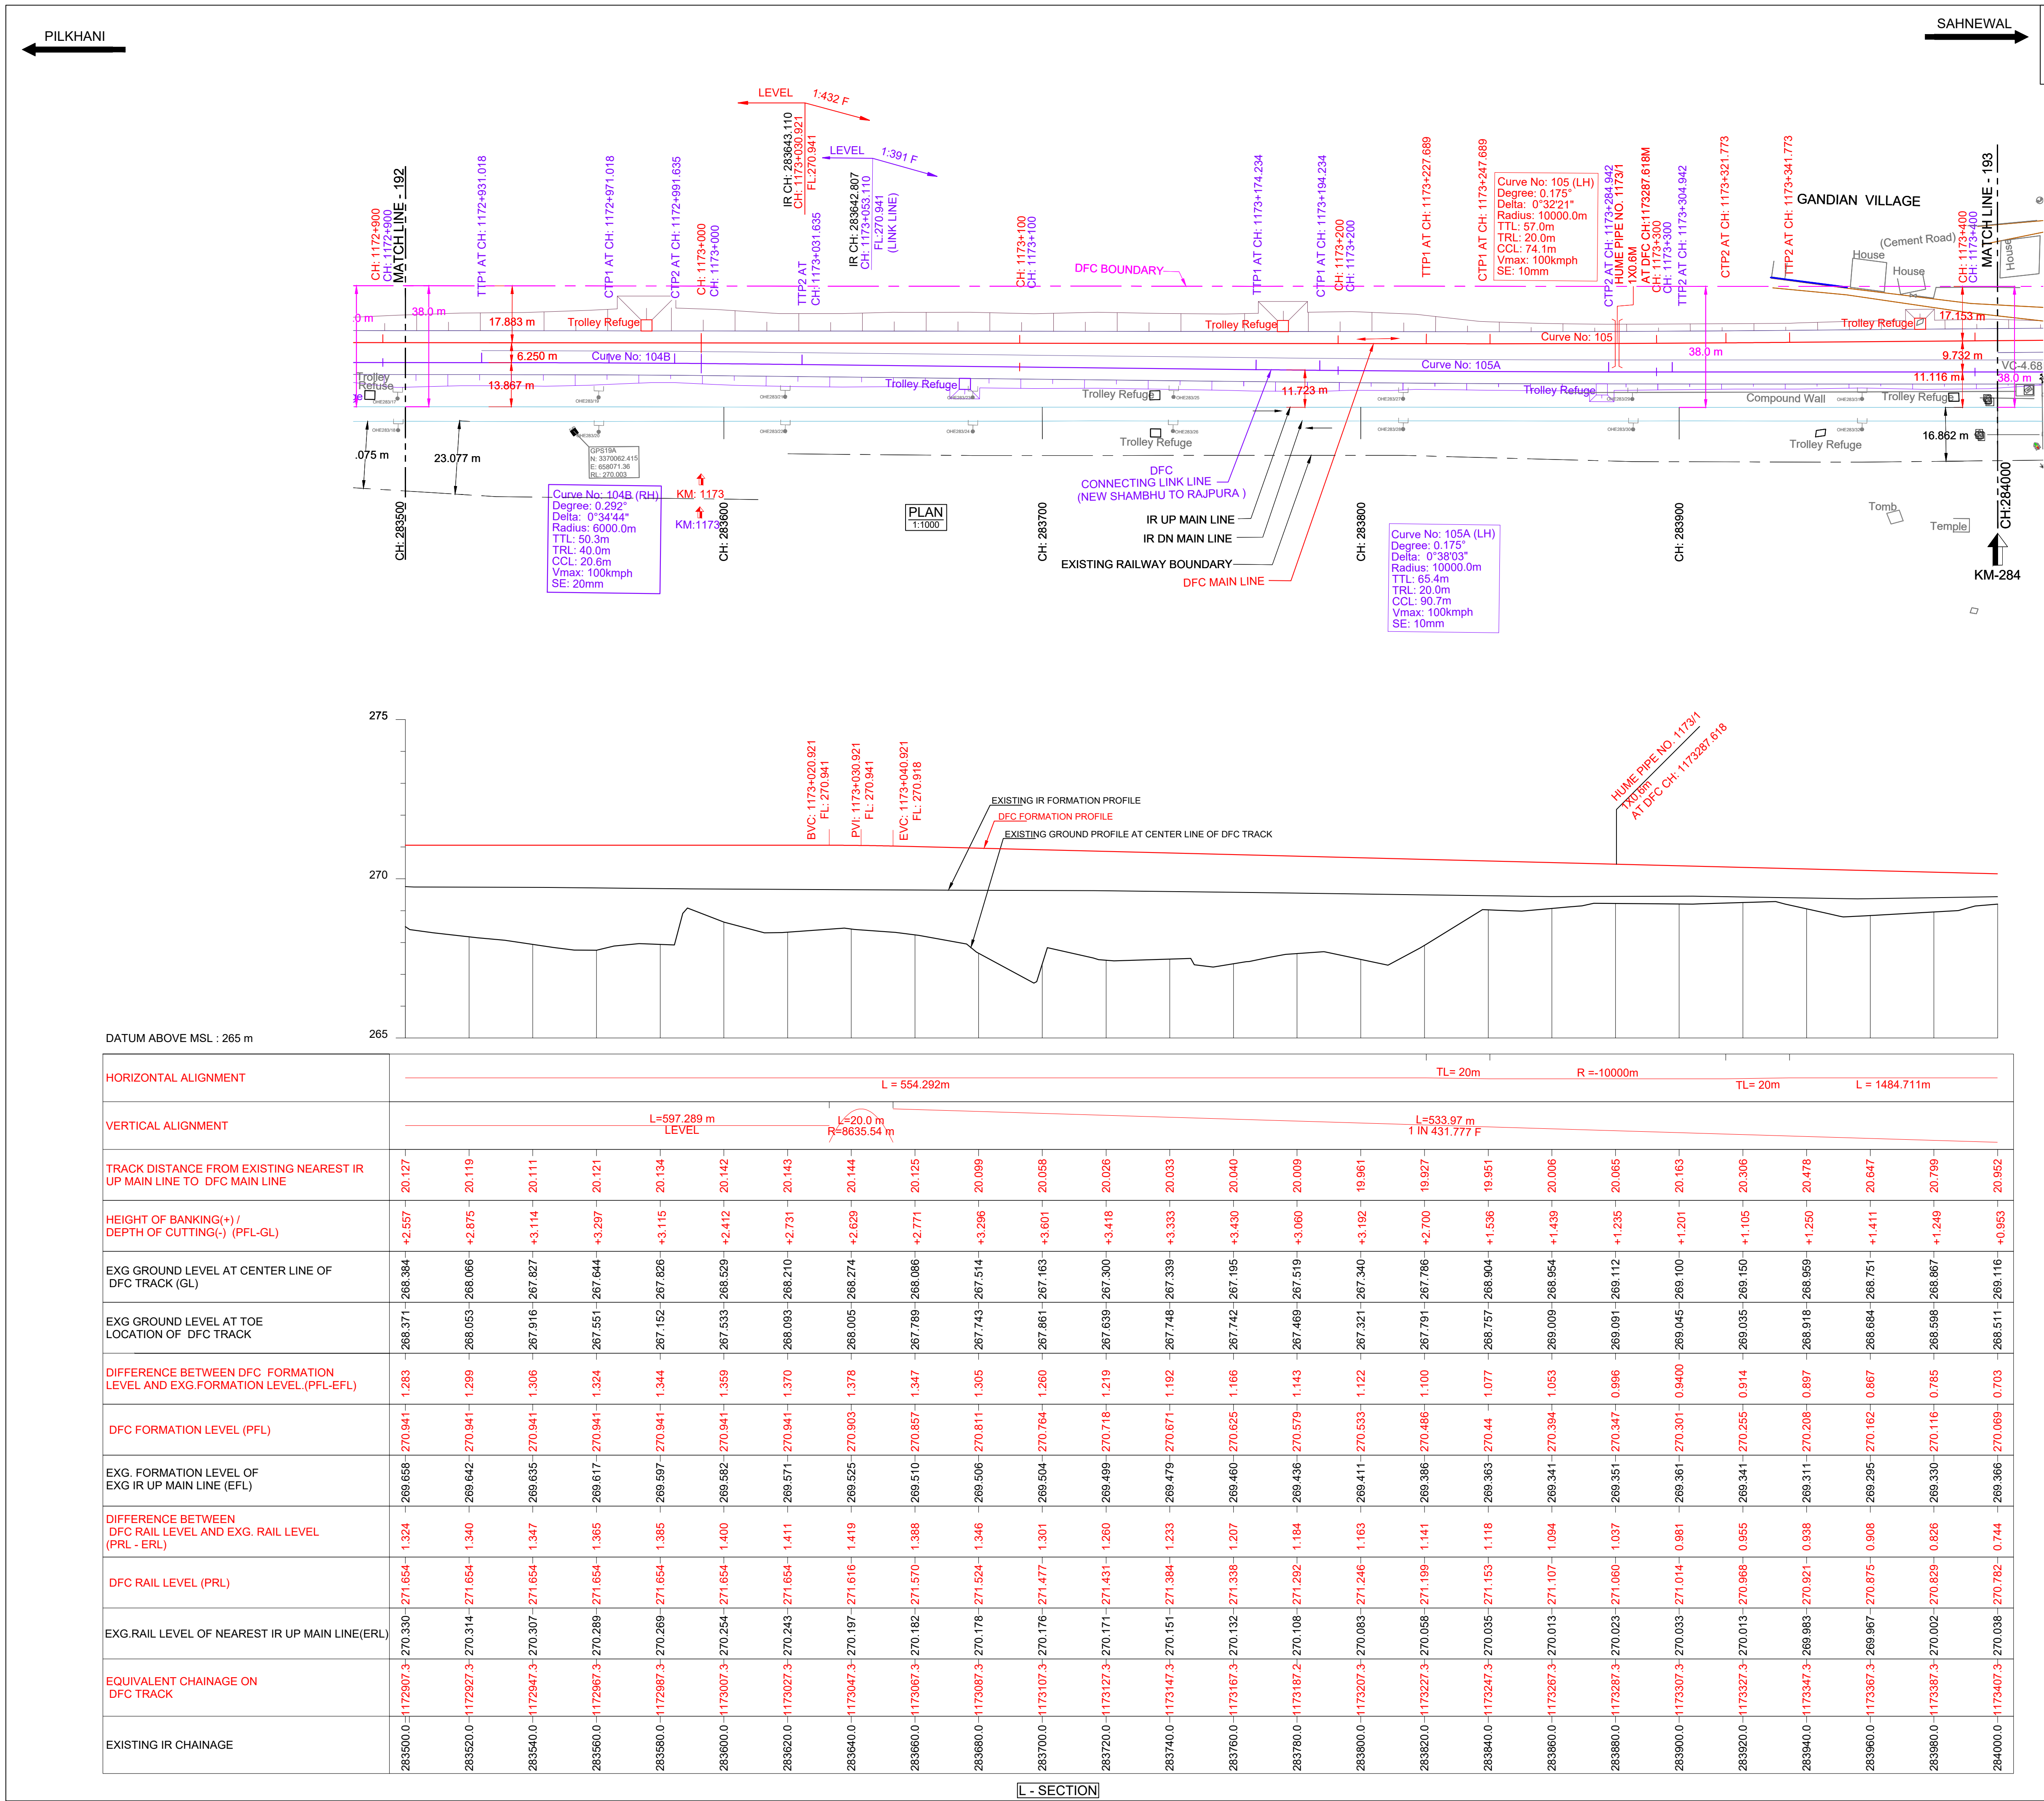


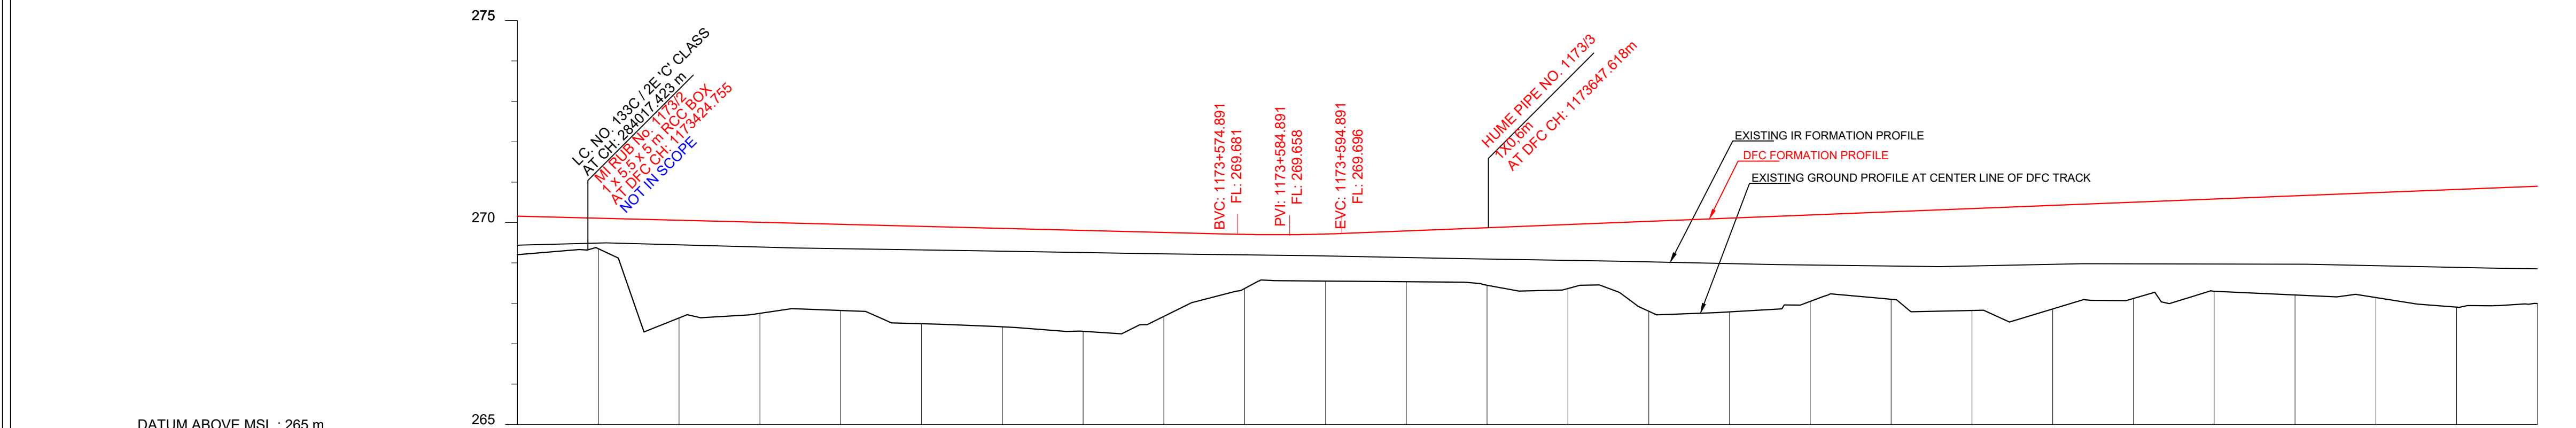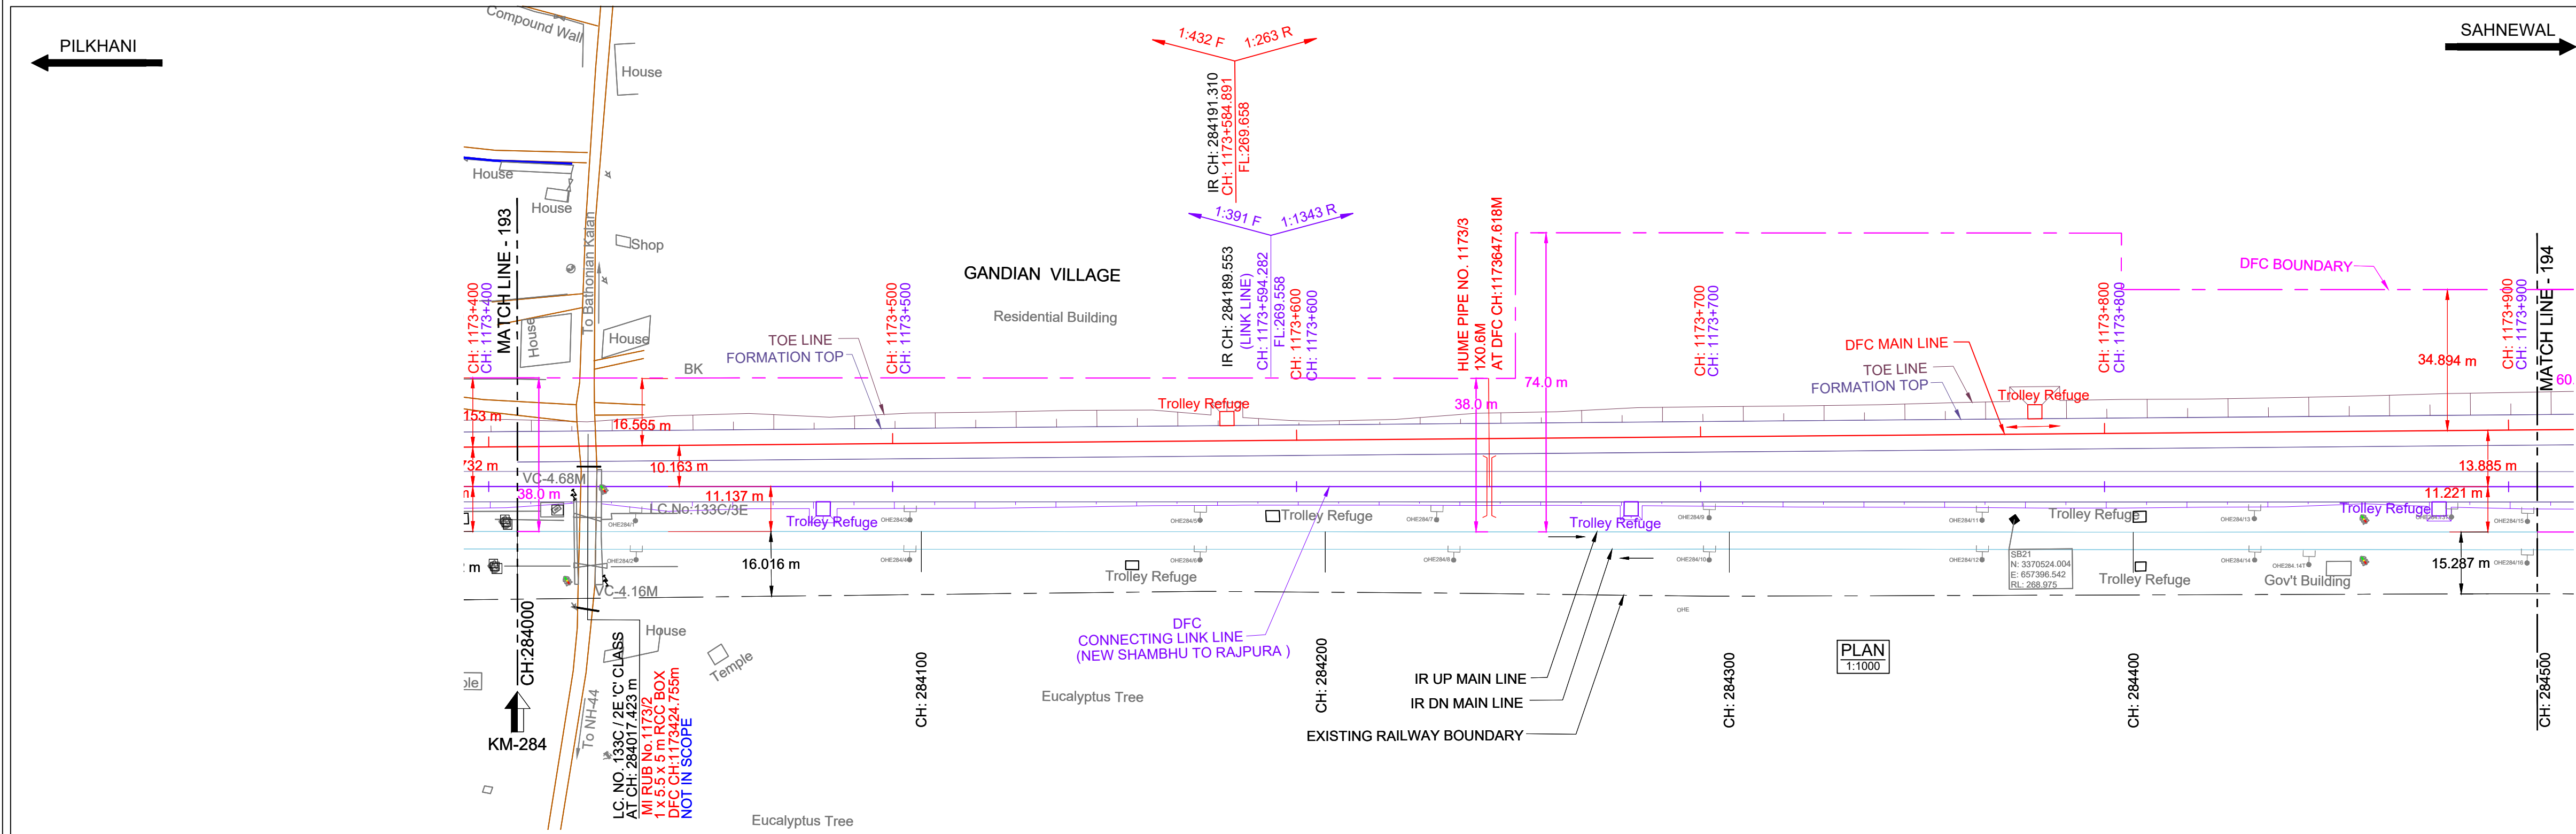

HORIZONTAL ALIGNMENT	L = 1484.711m																								
VERTICAL ALIGNMENT	L=533.97 m 1 IN 431.777 F										L=25.8 m R=4000 m										L=1904 m 1 IN 262.873 R				
TRACK DISTANCE FROM EXISTING NEAREST IR UP MAIN LINE TO DFC MAIN LINE	20.952																								
HEIGHT OF BANKING(+) / DEPTH OF CUTTING(-) (PFL-GL)	+0.953																								
EXG GROUND LEVEL AT CENTER LINE OF DFC TRACK (GL)	268.511	268.116																							
EXG GROUND LEVEL AT TOE LOCATION OF DFC TRACK	268.704	268.267																							
DIFFERENCE BETWEEN DFC FORMATION LEVEL AND EXG.FORMATION LEVEL (PFL-EFL)	0.703																								
DFC FORMATION LEVEL (PFL)	270.069	270.069																							
EXG. FORMATION LEVEL OF EXG IR UP MAIN LINE (EFL)	269.366	269.366																							
DIFFERENCE BETWEEN DFC RAIL LEVEL AND EXG. RAIL LEVEL (PRL - ERL)	0.744																								
DFC RAIL LEVEL (PRL)	270.762	270.762																							
EXG.RAIL LEVEL OF NEAREST IR UP MAIN LINE(ERL)	270.038	270.038																							
EQUIVALENT CHAINAGE ON DFC TRACK	284000.0	284000.0																							
EXISTING IR CHAINAGE	284000.0	284000.0																							

L - SECTION

SAHNEWAL

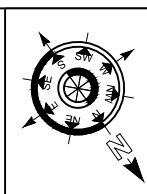

NOTE:-

1. DFC WORKS ARE SHOWN IN RED.
2. IR NEW WORKS ARE SHOWN IN VIOLET.
3. ALL DIMENSIONS ARE SHOWN IN METRES.
4. THIS DRAWING IS PREPARED BASED ON LATEST SURVEY DATA HELD ON APRIL-2022. GTS BENCH MARK OF 261.850M CONSIDERED ON TOP OF CANAL BRIDGE ABUTMENT AT DORANA VILLAGE ALONG THE NH1.
5. DFC NEW CHAINAGE OF 1075.950M IS WITH REFERENCE TO THE IR KM OF 187.500KM END OF KM OF CP-303(SECTION P-3 PILKHANI END) AGAINST THE EXISTING DFC CHAINAGE. 116277.742M ISSUED VIDE LETTER NO. COM/DFCC/UM/SURVEY/2021-301-2301/16-01/173 DT. 17.01.2023.
6. BALLAST PROFILE HAS BEEN PROVIDED ACCORDING TO THE CLAUSE 1.11.3 OF STANDARD SCHEDULE OF DIMENSION(EASTERN CORRIDOR) & THE BALLAST CUSHION DIMENSION SHOWN IN 35CM ON GE-14 PARA 17. SPECIFICATIONS & RECOMMENDATIONS 2. TWO LAYER SYSTEM FIG.10.

REFERENCE DRAWINGS:-


1. FOR KEY PLAN REFER DRAWING NO. 301-2/AL/0001
2. FOR LEGEND AND ABBREVIATIONS REFER DRAWING NO. 301-2/AL/1000
3. FOR TYPICAL SECTION OF BALLAST PROFILE (FL-RL) REFER DRG. NO. 301-2/TK/TFD/004 (TR.1952)

REV.	DATE	REVISION DETAILS	PURPOSE OF ISSUE
0	27.08.2024	SUBMISSION OF AS-BUILT DRAWING	FOR APPROVAL

LEGEND:

SCALE: HOR - 1:1000, VER - 1:100, SHEET SIZE : A1

IR TRACK, DFC TRACK, LINK LINE (SMUN-RP-J), DFC FUTURE PROPOSALS, STRUCTURE / BUILDING, DFC TOE LINE, DFC FORMATION, RETAINING WALL, ROAD, STREAM, DRAIN, NALA, CANAL, FENCE, POWER LINES, TBM, ELECTRIC POLE/OHE MAST, IR RAILWAY BOUNDARY, DFC BOUNDARY

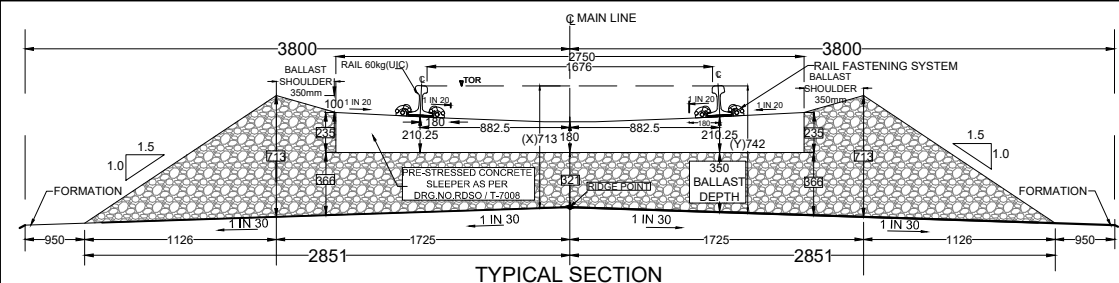

TRACK STRUCTURE		
RAIL SECTION: 60Kg/m (UIC 60Kg/m) DFC LINE: 60Kg/m (UIC 60Kg/m) IR MAIN LINE: 52Kg/m	Difference between FL- RL (Below Rail Seat)	
	IR Line	DFC
RUBBER PAD	172mm	172mm
SLEEPER DEPTH	6mm	10mm
BALLAST CUSHION	210mm	210mm
	300mm	350mm
Total Depth (FL TO RL)	688mm	742mm

OWNER: DEDICATED FREIGHT CORRIDOR CORPORATION OF INDIA LTD. (A GOVERNMENT OF INDIA ENTERPRISE) PROJECT OFFICE/AMBALA UNIT: OLD RAILWAY COLONY (NEAR ANAND MARKET),AMBALA CANTT-133001. CORPORATE IDENTITY NO. : U60232DL2006GGI155068

ENGINEER: DB Engineering & Consulting GmbH Deutsche Bahn Engineering & Consulting GmbH

CONTRACTOR: GIL - TPL JV



SUBMITTED BY	GIL - TPL JV		
	DATED	NAME	SIGNATURE
PREPARED BY			
CHECKED BY	27.08.2024	VIJAY PRATAP	
APPROVED BY	27.08.2024	PARASURAM KOTYADA	

APPROVED BY	DEUTSCHE BAHN ENGINEERING & CONSULTING GMBH		
	DATED	NAME	SIGNATURE
Sr. DE./CHIEF ENGINEER		SURESH K.YALANGI	
CHIEF TRACK ENGINEER		RAJ PAL SINGH	
T.L.		H.D. VIDJAK	

STAMP	AS-BUILT DRAWING TR. Ref.:..... ENGINEER Sign.:.....		
EMPLOYER (DFCCIL):	DEDICATED FREIGHT CORRIDOR CORPORATION OF INDIA LTD.		

AS BUILT DRAWING			
TITLE	AS-BUILT PLAN AND PROFILE		
FROM IR KM: 284.000 TO 284.500	DFC KM: 1173.407 TO 1173.907		
DFCC APPR. NO. -	ENGG. APPR. NO. -		
DRG. NO. - 301-2/AL/A/1194	SHEET NO. : 1 OF 1		
DATE : 27.08.2024	STATUS		
	A		

TR.

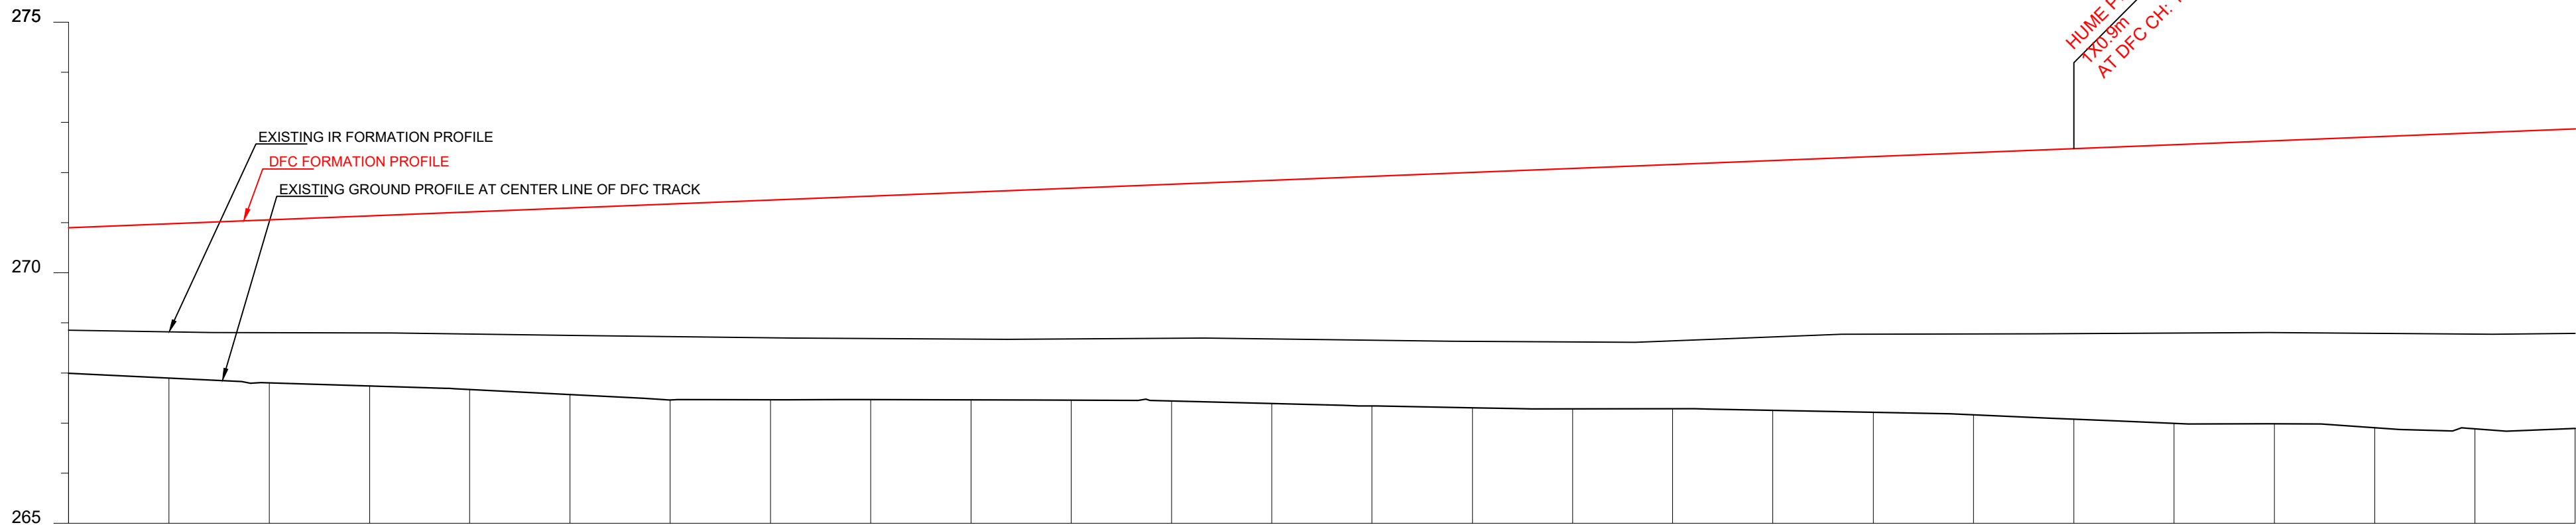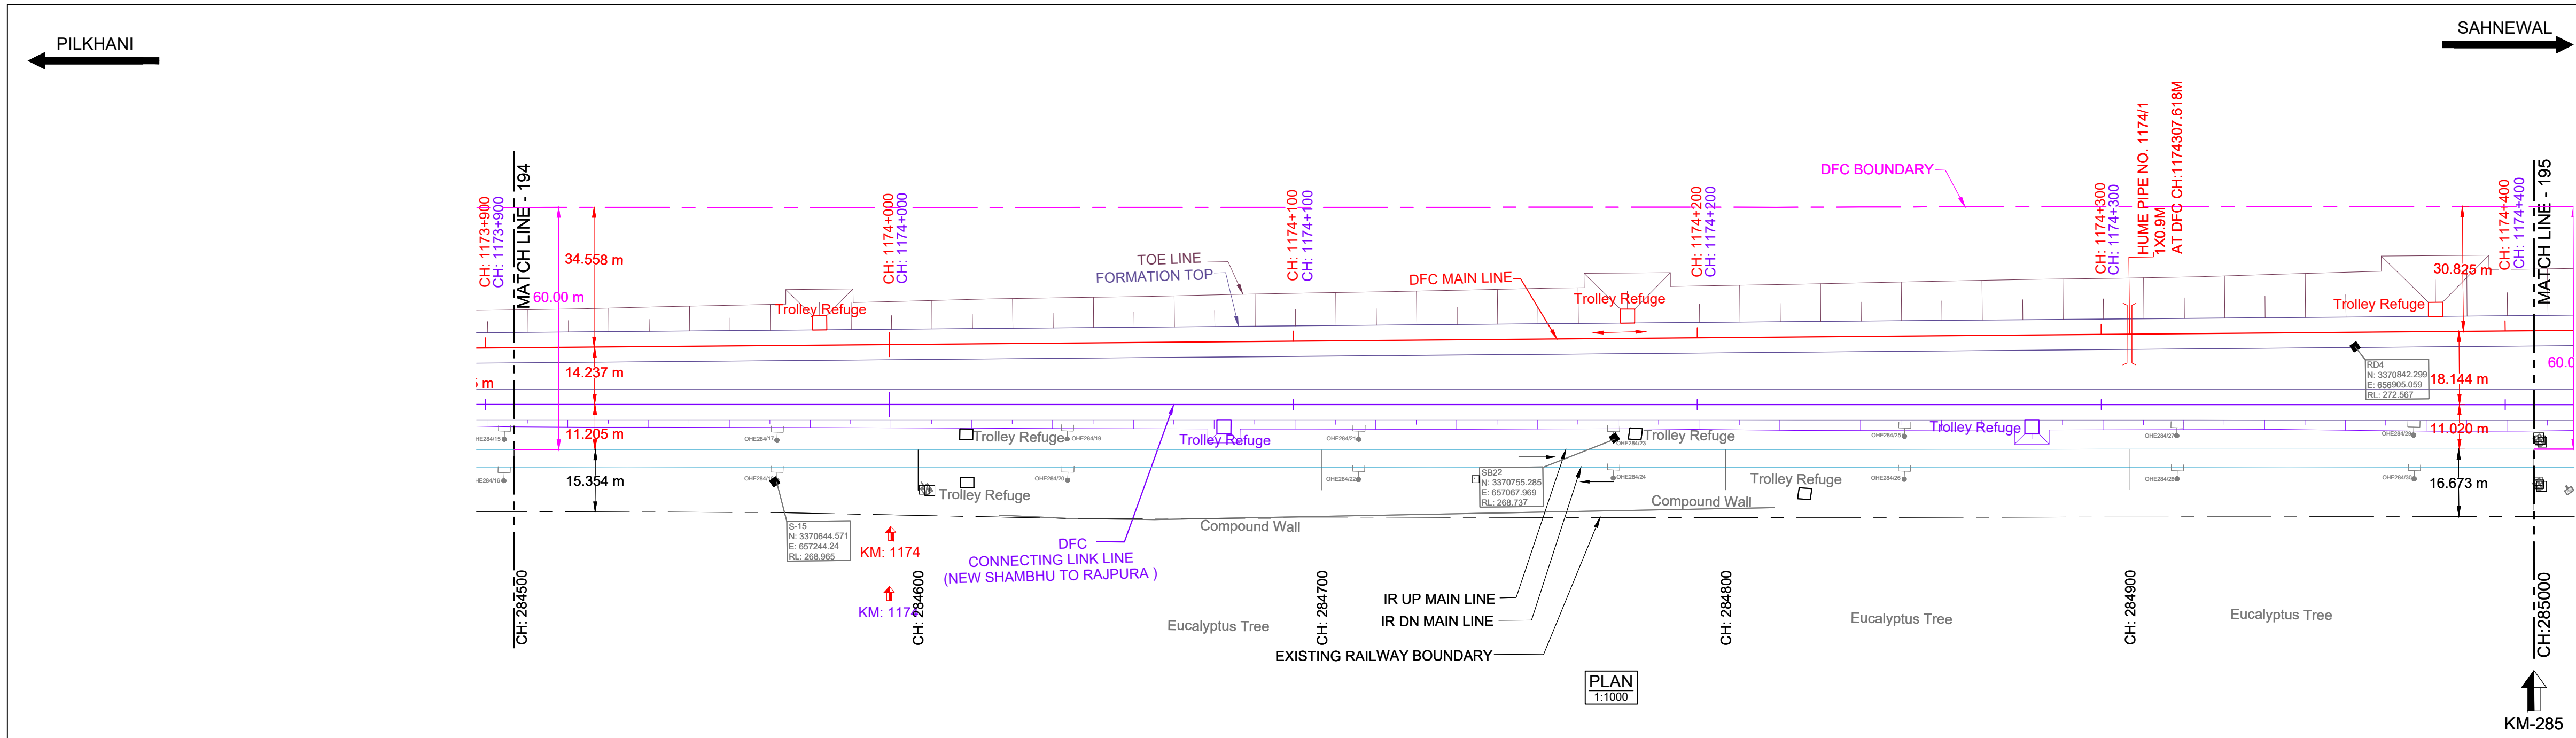


DATUM ABOVE MSL : 265 m

HORIZONTAL ALIGNMENT	L = 1484.711m																			
VERTICAL ALIGNMENT	L=1904 m 1 IN 262.873 R																			
TRACK DISTANCE FROM EXISTING NEAREST IR UP MAIN LINE TO DFC MAIN LINE	25.282	25.902	25.442	25.616	25.807	25.970	26.127	26.289	26.452	26.612	26.772	26.934	27.098	27.253	27.404	27.562	27.716	27.874	28.025	28.155
HEIGHT OF BANKING(+) / DEPTH OF CUTTING(-) (PFL-GL)	+2.902	+3.080	+3.252	+3.394	+3.543	+3.722	+3.911	+3.984	+4.061	+4.146	+4.230	+4.324	+4.455	+4.563	+4.697	+4.799	+4.874	+4.985	+5.103	+5.234
EXG GROUND LEVEL AT CENTER LINE OF DFC TRACK (GL)	267.983	267.981	267.981	267.981	267.981	267.981	267.981	267.981	267.981	267.981	267.981	267.981	267.981	267.981	267.981	267.981	267.981	267.981	267.981	267.981
EXG GROUND LEVEL AT TOE LOCATION OF DFC TRACK	267.979	267.954	267.881	267.785	267.719	267.646	267.543	267.430	267.333	267.233	267.142	267.041	266.939	266.836	266.732	266.628	266.524	266.420	266.316	266.212
DIFFERENCE BETWEEN DFC FORMATION LEVEL AND EXG.FORMATION LEVEL (PFL-EFL)	2.029	2.141	2.237	2.320	2.421	2.526	2.629	2.733	2.825	2.915	2.990	3.056	3.148	3.253	3.366	3.447	3.505	3.506	3.530	3.604
DFC FORMATION LEVEL (PFL)	270.884	270.961	271.037	271.113	271.189	271.265	271.341	271.417	271.493	271.569	271.645	271.721	271.797	271.873	271.950	272.026	272.102	272.178	272.254	272.330
EXG. FORMATION LEVEL OF EXG IR UP MAIN LINE (EFL)	268.855	268.819	268.800	268.792	268.786	268.783	268.782	268.782	268.782	268.782	268.782	268.782	268.782	268.782	268.782	268.782	268.782	268.782	268.782	268.782
DIFFERENCE BETWEEN DFC RAIL LEVEL AND EXG. RAIL LEVEL (PRL - ERL)	2.070	2.182	2.278	2.361	2.462	2.567	2.670	2.774	2.866	2.956	3.031	3.097	3.189	3.294	3.397	3.488	3.546	3.547	3.571	3.645
DFC RAIL LEVEL (PRL)	271.597	271.674	271.750	271.826	271.902	271.978	272.054	272.130	272.206	272.282	272.358	272.434	272.510	272.586	272.663	272.739	272.815	272.891	272.967	273.043
EXG.RAIL LEVEL OF NEAREST IR UP MAIN LINE(ERL)	269.527	269.491	269.472	269.464	269.440	269.411	269.384	269.356	269.340	269.326	269.321	269.337	269.349	269.369	269.396	269.419	269.441	269.464	269.489	269.515
EQUIVALENT CHAINAGE ON DFC TRACK	1173907.3	1173927.3	1173947.3	1173967.3	1173987.3	1174007.3	1174027.3	1174047.3	1174067.3	1174087.3	1174107.3	1174127.3	1174147.3	1174167.3	1174187.3	1174207.3	1174227.3	1174247.3	1174267.3	1174287.3
EXISTING IR CHAINAGE	284500.0	284520.0	284540.0	284560.0	284580.0	284600.0	284620.0	284640.0	284660.0	284680.0	284700.0	284720.0	284740.0	284760.0	284780.0	284800.0	284820.0	284840.0	284860.0	284880.0

L - SECTION

SAHNEWAL

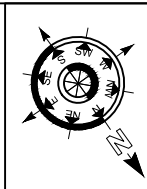

- NOTE:-
- DFCC WORKS ARE SHOWN IN RED.
 - IR NEW WORKS ARE SHOWN IN VIOLET.
 - ALL DIMENSIONS ARE SHOWN IN METRES.
 - THIS DRAWING IS PREPARED BASED ON LATEST SURVEY DATA HELD ON APRIL-2022. GTS BENCH MARK OF 261.850M CONSIDERED ON TOP OF CANAL BRIDGE ABUTMENT AT DORANA VILLAGE ALONG THE NH1.
 - DFC NEW CHAINAGE OF 1075.950M IS WITH REFERENCE TO THE IR KM OF 187.500KM END OF KM OF CP-303(SECTION P-3 PILKHANI END) AGAINST THE EXISTING DFC CHAINAGE. 116277.742M ISSUED VIDE LETTER NO. COM/DFCC/UMS/SURVEY/2021-301-230116-011173 DT. 17.01.2023.
 - BALLAST PROFILE HAS BEEN PROVIDED ACCORDING TO THE CLAUSE 1.11.3 OF STANDARD SCHEDULE OF DIMENSION(EASTERN CORRIDOR) & THE BALLAST CUSHION DIMENSION SHOWN IN 35CM ON GE-14 PARA 17. SPECIFICATIONS & RECOMMENDATIONS 2. TWO LAYER SYSTEM FIG.10.

- REFERENCE DRAWINGS :-
- FOR KEY PLAN REFER DRAWING NO. 301-2/AL/0001
 - FOR LEGEND AND ABBREVIATIONS REFER DRAWING NO. 301-2/AL/1000
 - FOR TYPICAL SECTION OF BALLAST PROFILE (FL-RL) REFER DRG. NO. 301-2/TK/TFD/-004 (TR.1952)

0	27.08.2024	SUBMISSION OF AS-BUILT DRAWING	FOR APPROVAL
REV.	DATE	REVISION DETAILS	PURPOSE OF ISSUE

LEGEND:


SCALE

HOR - 1:1000

VER - 1:100

SHEET SIZE : A1

IR TRACK
DFCC TRACK
LINK LINE (SMUN-RP-J)
DFCC FUTURE PROPOSALS
STRUCTURE / BUILDING
DFCC TOE LINE
DFCC FORMATION
RETAINING WALL
ROAD
STREAM, DRAIN, NALA, CANAL.
FENCE
POWER LINES
TBM
ELECTRIC POLE/OHE MAST
IR RAILWAY BOUNDARY
DFCC BOUNDARY

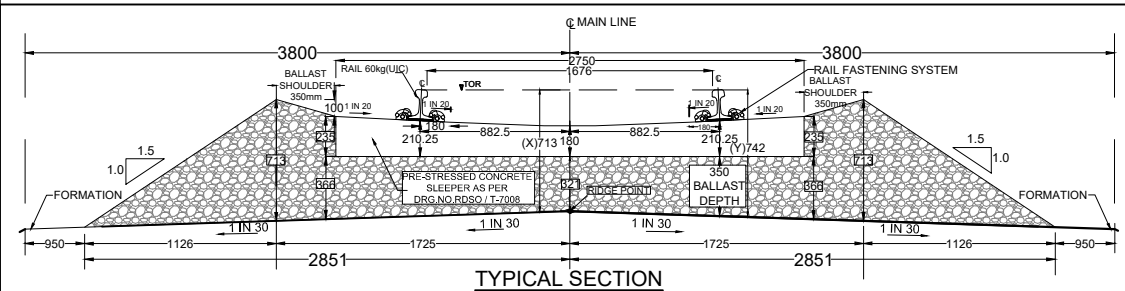

TRACK STRUCTURE		
RAIL SECTION: 60Kg/m (UIC 60Kg/m) DFC LINE: 60Kg/m (UIC 60Kg/m) IR MAIN LINE: 52Kg/m	Difference between FL- RL (Below Rail Seat)	
	IR Line	DFC
RUBBER PAD	172mm	172mm
SLEEPER DEPTH	6mm	10mm
BALLAST CUSHION	210mm	210mm
	300mm	350mm
Total Depth (FL TO RL)	688mm	742mm

OWNER

DEDICATED FREIGHT CORRIDOR CORPORATION OF INDIA LTD.

(A GOVERNMENT OF INDIA ENTERPRISE)

PROJECT OFFICE(AMBALA UNIT): OLD RAILWAY COLONY (NEAR ANAND MARKET),AMBALA CANTT-133001.

CORPORATE IDENTITY NO. : U60232DL20060G0155068

ENGINEER:

DB Engineering & Consulting GmbH

Deutsche Bahn Engineering & Consulting GmbH

CONTRACTOR:

GIL - TPL JV



GAR TATA

GIL - TPL JV			
SUBMITTED BY	DATED	NAME	SIGNATURE
PREPARED BY			
CHECKED BY	27.08.2024	VIJAY PRATAP	
APPROVED BY	27.08.2024	PARASURAM KOTYADA	
DEUTSCHE BAHN ENGINEERING & CONSULTING GMBH			
	DATED	NAME	SIGNATURE
Sr. DE./CHIEF ENGINEER		SURESH K.YALANGI	
CHIEF TRACK ENGINEER		RAJ PAL SINGH	
T.L.		H.D. VIDJAK	

STAMP	A AS-BUILT DRAWING TR. Ref.:..... ENGINEER Sign.:.....		
EMPLOYER (DFCCIL):	DEDICATED FREIGHT CORRIDOR CORPORATION OF INDIA LTD.		

AS BUILT DRAWING			
TITLE		DFCC APPR. NO. -	
AS-BUILT PLAN AND PROFILE		ENGG. APPR. NO. -	
FROM IR KM: 284.500 TO 285.000		DRG. NO. - 301-2/AL/A/1195	
DFC KM: 1173.907 TO 1174.407		SHEET NO. : 1 OF 1	
		DATE : 27.08.2024	
		STATUS	
		A	

TR.

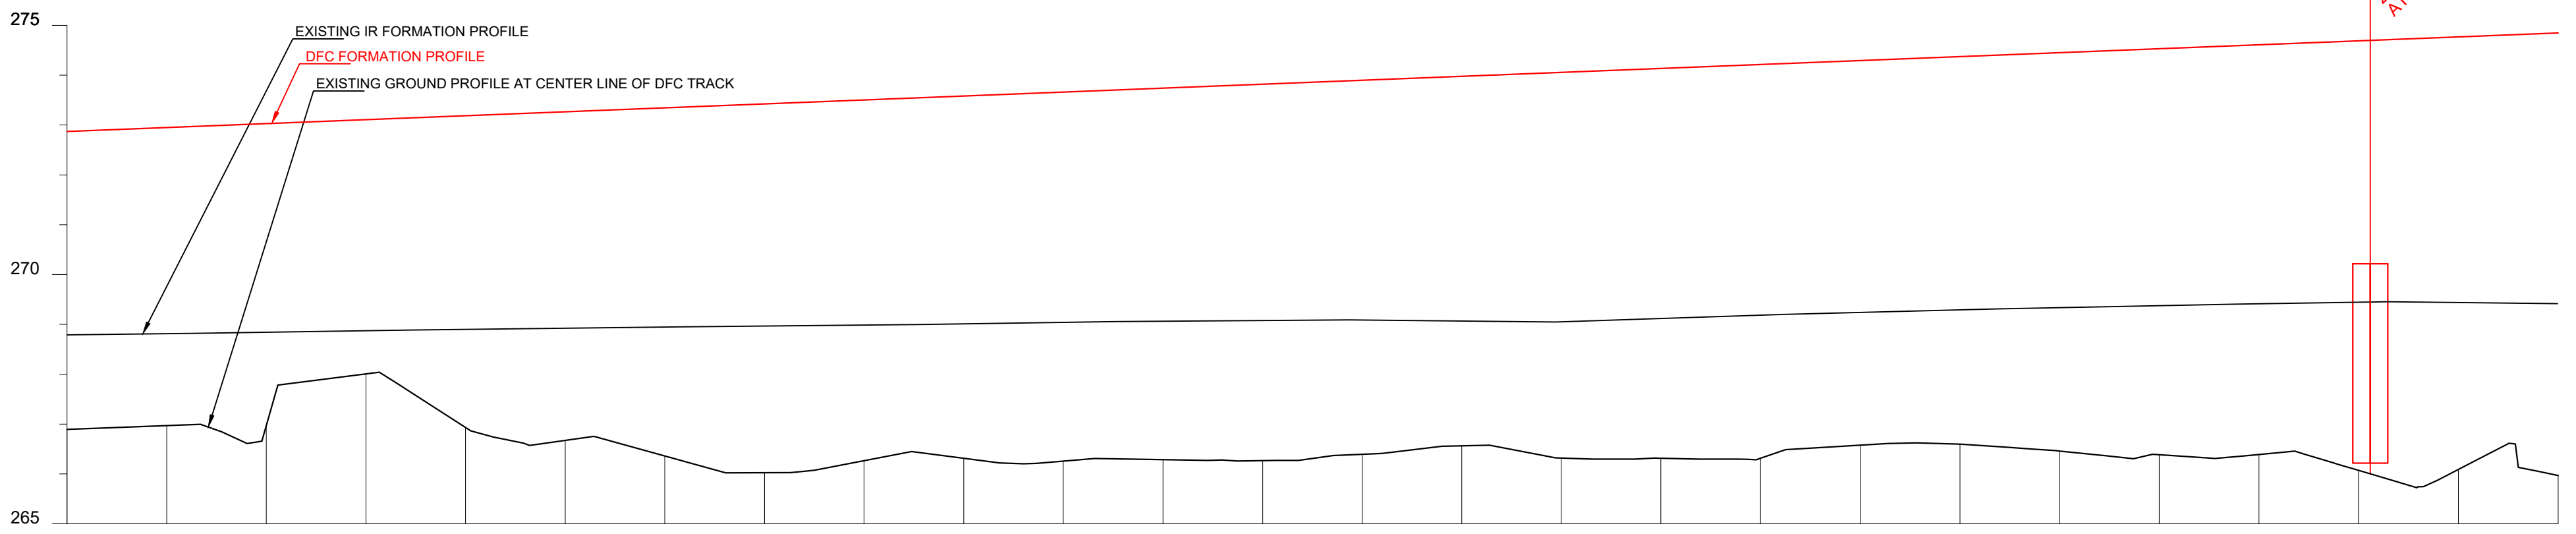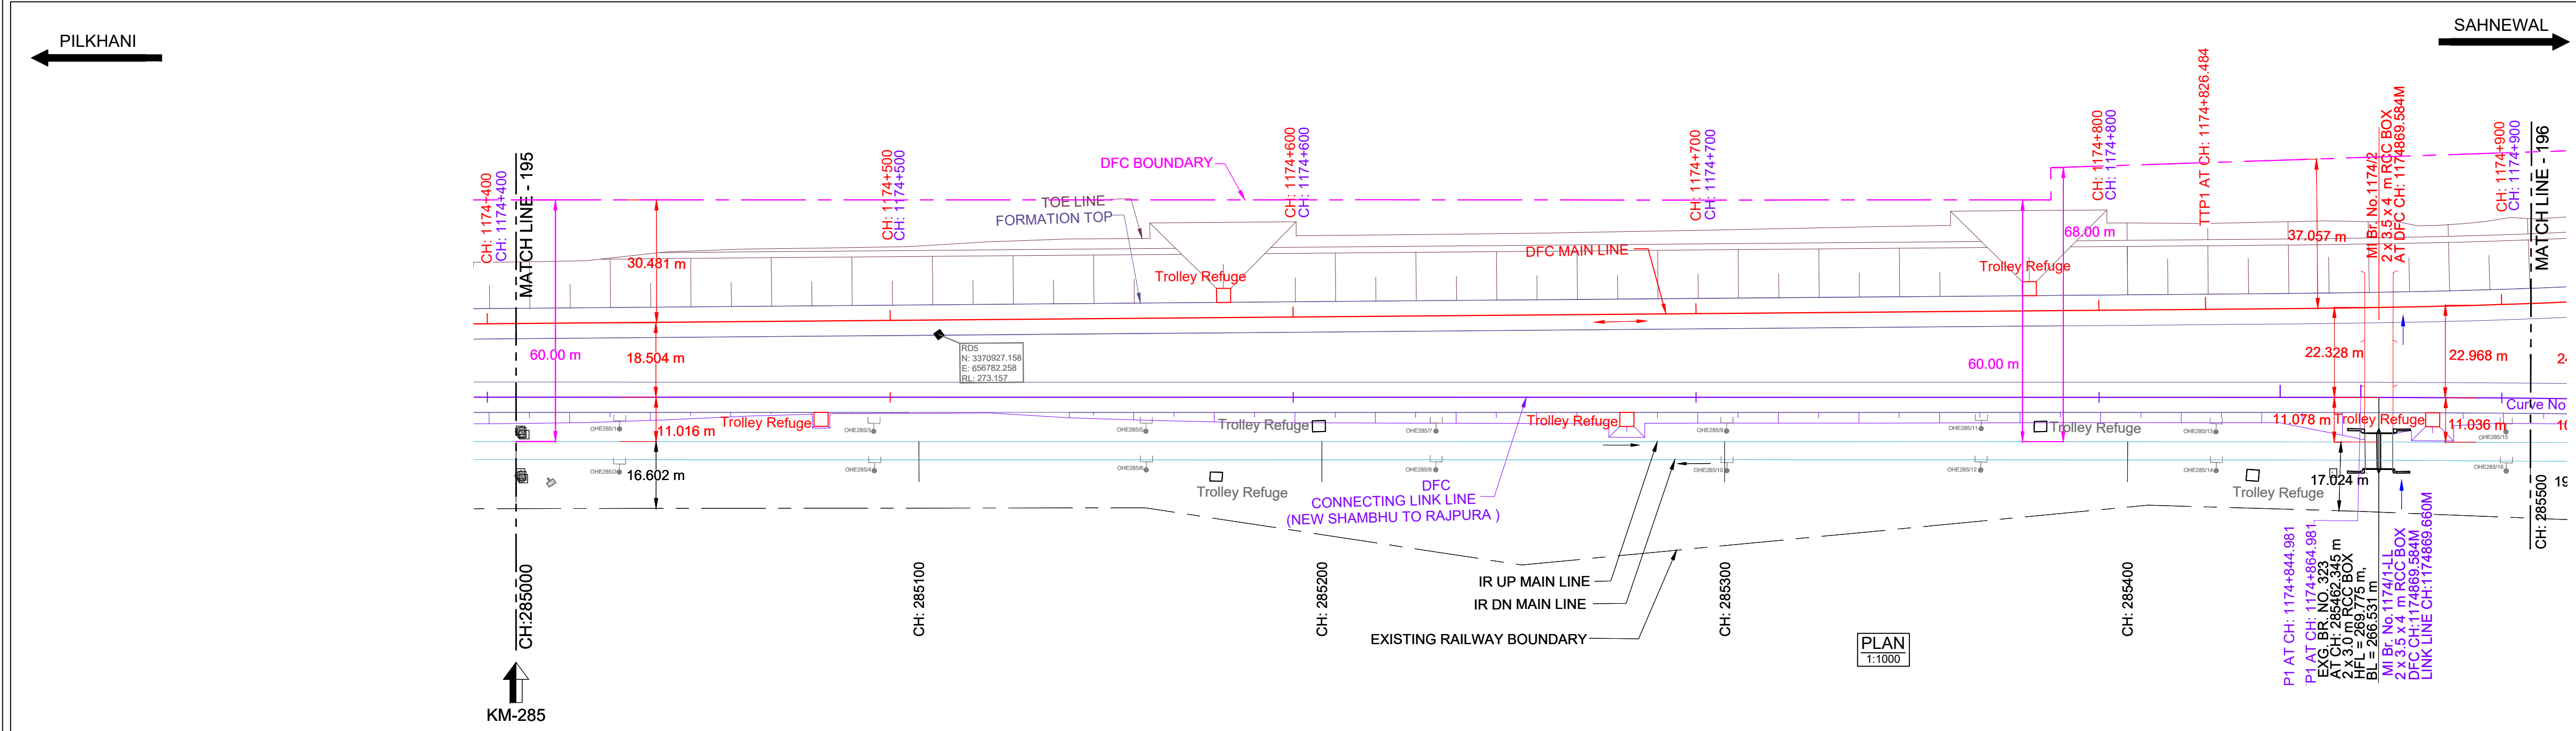

HORIZONTAL ALIGNMENT	L = 1484.711m																								TL= 140m																										
VERTICAL ALIGNMENT	L=1904 m 1 IN 262.873 R																																																		
TRACK DISTANCE FROM EXISTING NEAREST IR UP MAIN LINE TO DFC MAIN LINE	29.307		29.474		29.643		29.813		29.978		30.137		30.296		30.465		30.636		30.802		30.965		31.138		31.324		31.508		31.682		31.854		32.004		32.155		32.327		32.506		32.695		32.890		33.095		33.365		33.813		34.491
HEIGHT OF BANKING(+) / DEPTH OF CUTTING(-) (PFL-GL)	+5.980		+5.982		+6.055		+5.104		+6.258		+6.595		+6.986		+7.402		+7.240		+7.269		+7.407		+7.454		+7.554		+7.505		+7.416		+7.739		+7.821		+7.900		+7.717		+7.773		+7.994		+8.145		+8.220		+8.618		+8.678		+8.875
EXG GROUND LEVEL AT CENTER LINE OF DFC TRACK (GL)	266.807		266.881		266.884		267.911		266.833		266.572		266.257		265.917		266.155		265.203		265.141		266.169		266.146		266.271		266.436		266.188		266.182		266.180		266.459		266.459		266.315		266.240		266.241		265.919		265.936		265.814
EXG GROUND LEVEL AT TOE LOCATION OF DFC TRACK	266.922		266.887		266.696		266.512		266.539		266.475		266.088		265.921		266.000		265.919		265.975		266.042		266.099		266.115		266.103		266.082		266.031		265.982		265.975		265.986		266.022		266.242		266.189		266.395		267.035		266.659
DIFFERENCE BETWEEN DFC FORMATION LEVEL AND EXG.FORMATION LEVEL (PFL-EFL)	4.066		4.121		4.171		4.220		4.272		4.327		4.382		4.441		4.500		4.555		4.604		4.660		4.725		4.794		4.895		4.990		5.003		5.015		5.039		5.066		5.101		5.141		5.181		5.228		5.313		5.416
DFC FORMATION LEVEL (PFL)	272.787		272.863		272.939		273.015		273.091		273.167		273.243		273.319		273.395		273.471		273.547		273.624		273.700		273.776		273.852		273.928		274.004		274.080		274.156		274.232		274.308		274.385		274.461		274.537		274.613		274.689
EXG. FORMATION LEVEL OF EXG IR UP MAIN LINE (EFL)	268.721		268.742		268.767		268.795		268.819		268.840		268.861		268.878		268.895		268.916		268.944		268.963		268.975		268.981		268.957		268.937		268.901		268.865		268.817		268.768		268.707		268.644		268.579		268.509		268.430		
DIFFERENCE BETWEEN DFC RAIL LEVEL AND EXG. RAIL LEVEL (PRL - ERL)	4.107		4.162		4.212		4.261		4.313		4.368		4.423		4.482		4.541		4.596		4.645		4.701		4.766		4.835		4.936		5.031		5.044		5.056		5.080		5.107		5.142		5.182		5.222		5.269		5.354		5.457
DFC RAIL LEVEL (PRL)	273.500		273.576		273.652		273.728		273.804		273.880		273.956		274.032		274.108		274.184		274.260		274.337		274.413		274.489		274.565		274.641		274.717		274.793		274.869		274.945		275.021		275.098		275.174		275.250		275.326		275.402
EXG.RAIL LEVEL OF NEAREST IR UP MAIN LINE(ERL)	269.393		269.414		269.439		269.467		269.491		269.512		269.533		269.550		269.567		269.588		269.616		269.635		269.647		269.653		269.629		269.609		269.673		269.737		269.789		269.838		269.879		269.916		269.951		269.981		270.012		270.045
EQUIVALENT CHAINAGE ON DFC TRACK	1174407.3		1174427.3		1174447.3		1174467.3		1174487.3		1174507.3		1174527.3		1174547.3		1174567.3		1174587.3		1174607.3		1174627.3		1174647.3		1174667.3		1174687.3		1174707.3		1174727.3		1174747.3		1174767.3		1174787.3		1174807.3		1174827.3		1174847.3		1174867.3		1174887.3		1174907.3
EXISTING IR CHAINAGE	285000.0		285020.0		285040.0		285060.0		285080.0		285100.0		285120.0		285140.0		285160.0		285180.0		285200.0		285220.0		285240.0		285260.0		285280.0		285300.0		285320.0		285340.0		285360.0		285380.0		285400.0		285420.0		285440.0		285460.0		285480.0		285500.0

NOTE:-

- DFCC WORKS ARE SHOWN IN RED.
- IR NEW WORKS ARE SHOWN IN VIOLET.
- ALL DIMENSIONS ARE SHOWN IN METRES.
- THIS DRAWING IS PREPARED BASED ON LATEST SURVEY DATA HELD ON APRIL-2022. GTS BENCH MARK OF 261.850M CONSIDERED ON TOP OF CANAL BRIDGE ABUTMENT AT DORANA VILLAGE ALONG THE NH1.
- DFC NEW CHAINAGE OF 1075.950M IS WITH REFERENCE TO THE IR KM OF 187.500KM END OF KM OF CP-303(SECTION P-3 PILKHANI END) AGAINST THE EXISTING DFC CHAINAGE. 116277.742M ISSUED VIDE LETTER NO. COM/DFCC/UMS/SURVEY/2021-301-230116-011173 DT. 17.01.2023.
- BALLAST PROFILE HAS BEEN PROVIDED ACCORDING TO THE CLAUSE 1.11.3 OF STANDARD SCHEDULE OF DIMENSION(EASTERN CORRIDOR) & THE BALLAST CUSHION DIMENSION SHOWN IN 35CM ON GE-14 PARA 17. SPECIFICATIONS & RECOMMENDATIONS 2. TWO LAYER SYSTEM FIG.10.

REFERENCE DRAWINGS :-

- FOR KEY PLAN REFER DRAWING NO. 301-2/AL/0001
- FOR LEGEND AND ABBREVIATIONS REFER DRAWING NO. 301-2/AL/1000
- FOR TYPICAL SECTION OF BALLAST PROFILE (FL-RL) REFER DRG. NO. 301-2/TK/TFD/-004 (TR.1952)

0	27.08.2024	SUBMISSION OF AS-BUILT DRAWING	FOR APPROVAL
REV.	DATE	REVISION DETAILS	PURPOSE OF ISSUE

SCALE
HOR - 1:1000
VER - 1:100
SHEET SIZE : A1

LEGEND:

- IR TRACK
- DFCC TRACK
- LINK LINE (SMUN-RP-J)
- DFCC FUTURE PROPOSALS
- STRUCTURE / BUILDING
- DFCC TOE LINE
- DFCC FORMATION
- RETAINING WALL
- ROAD
- STREAM, DRAIN, NALA, CANAL.
- FENCE
- POWER LINES
- TBM
- ELECTRIC POLE/OHE MAST
- IR RAILWAY BOUNDARY
- DFCC BOUNDARY

TYPICAL SECTION

TRACK STRUCTURE

RAIL SECTION: 60Kg/m (UIC 60Kg/m)	Difference between FL- RL (Below Rail Seat)	
DFC LINE: 60Kg/m (UIC 60Kg/m)	IR Line	DFC
IR MAIN LINE: 52Kg/m	172mm	172mm
	6mm	10mm
RUBBER PAD	210mm	210mm
SLEEPER DEPTH	300mm	350mm
BALLAST CUSHION	688mm	742mm

OWNER
DEDICATED FREIGHT CORRIDOR CORPORATION OF INDIA LTD.
(A GOVERNMENT OF INDIA ENTERPRISE)
PROJECT OFFICE(AMBALA UNIT): OLD RAILWAY COLONY (NEAR ANAND MARKET),AMBALA CANTT-133001.
CORPORATE IDENTITY NO. : U60232DL2006GGI155068

ENGINEER:
DB Engineering & Consulting GmbH
Deutsche Bahn Engineering & Consulting GmbH

CONTRACTOR:
GIL - TPL JV

SUBMITTED BY	GIL - TPL JV		
	DATED	NAME	SIGNATURE
PREPARED BY			
CHECKED BY	27.08.2024	VIJAY PRATAP	
APPROVED BY	27.08.2024	PARASURAM KOTYADA	
APPROVED BY	DEUTSCHE BAHN ENGINEERING & CONSULTING GMBH		
	DATED	NAME	SIGNATURE
Sr. DE./CHIEF ENGINEER		SURESH K.YALANGI	
CHIEF TRACK ENGINEER		RAJ PAL SINGH	
T.L.		H.D. VIDJAK	

STAMP

A
AS-BUILT DRAWING
TR. Ref.....
ENGINEER Sign.:

EMPLOYER (DFCCIL): DEDICATED FREIGHT CORRIDOR CORPORATION OF INDIA LTD.


AS BUILT DRAWING

TITLE
AS-BUILT PLAN AND PROFILE
FROM IR KM: 285.000 TO 285.500
DFC KM: 1174.407 TO 1174.907

DFCC APPR. NO. -
ENGG. APPR. NO. -
DRG. NO. -301-2/AL/A/1196
SHEET NO. : 1 OF 1
DATE : 27.08.2024


STATUS
A

TR.

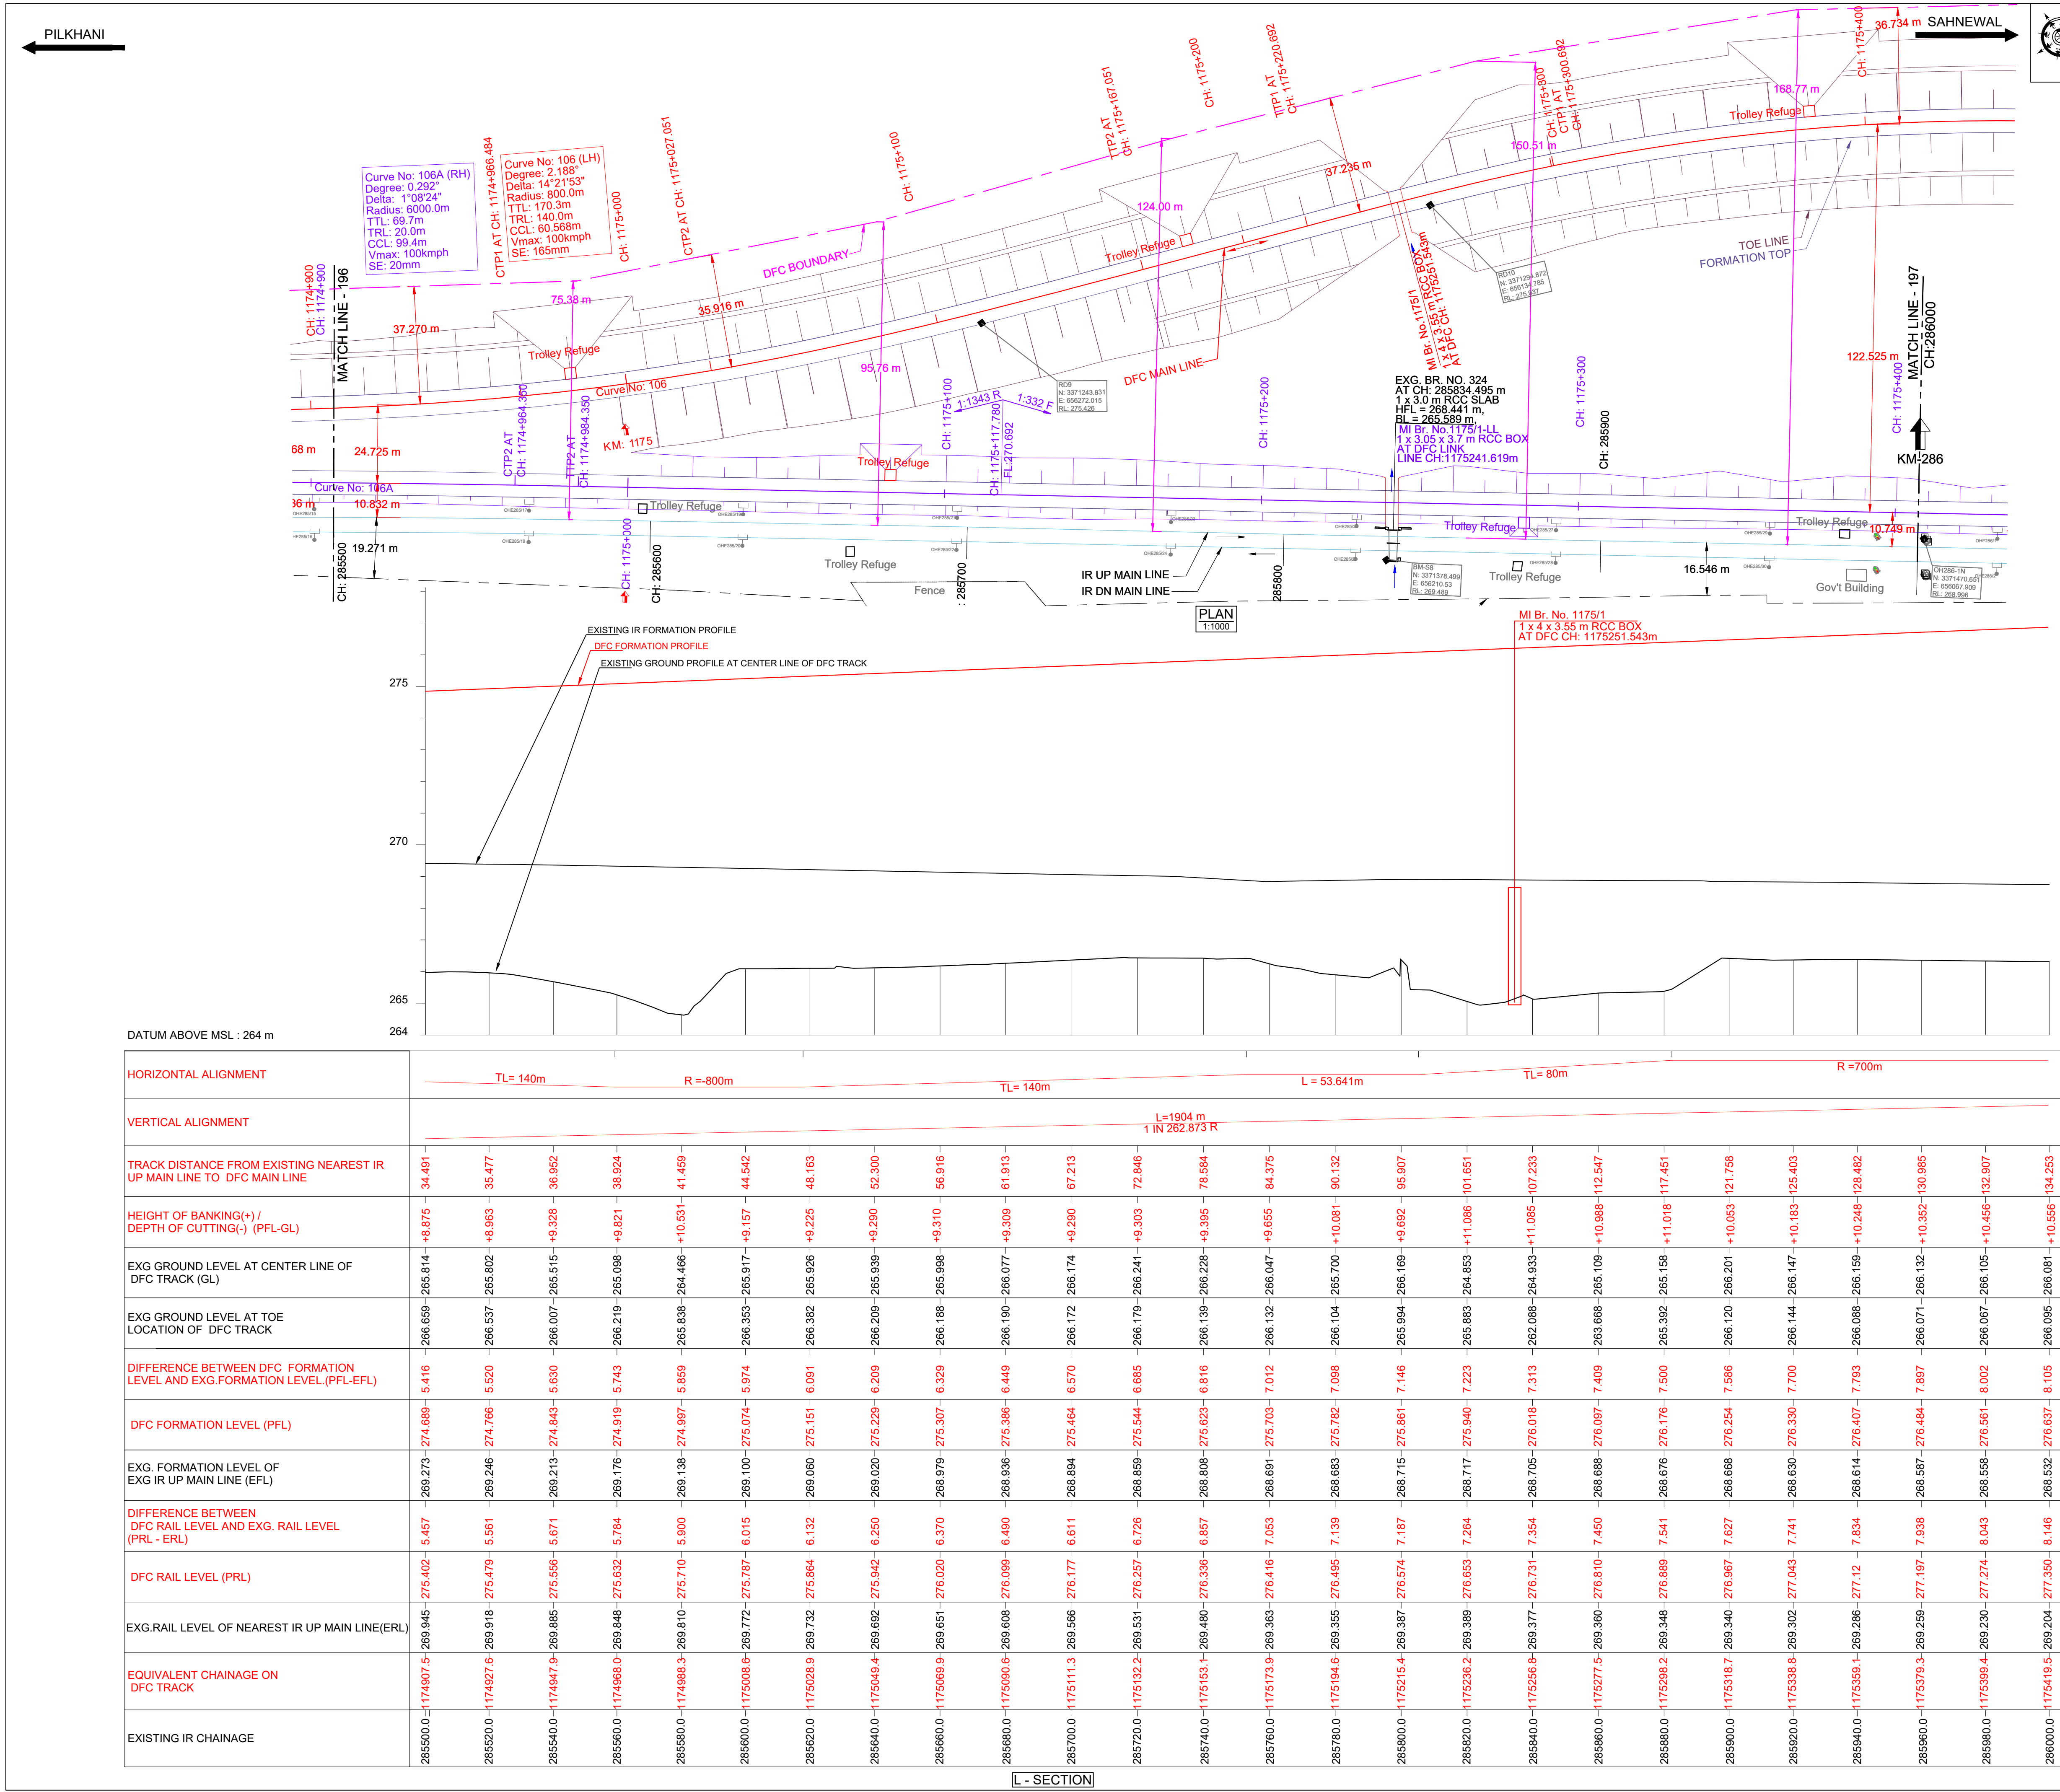

PILKHANI

SAHNEWAL

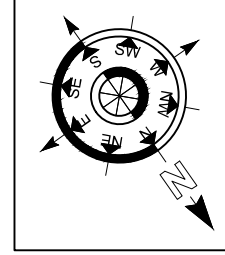

NOTE:-

- DFCC WORKS ARE SHOWN IN RED.
- IR NEW WORKS ARE SHOWN IN VIOLET.
- ALL DIMENSIONS ARE SHOWN IN METRES.
- THIS DRAWING IS PREPARED BASED ON LATEST SURVEY DATA HELD ON APRIL-2022. GTS BENCH MARK OF 261.850M CONSIDERED ON TOP OF CANAL BRIDGE ABUTMENT AT DORAHA VILLAGE ALONG THE NH1.
- DFCC NEW CHAINAGE OF 1075.950M IS WITH REFERENCE TO THE IR KM OF 187.500KM END OF KM OF CP-303/SECTION P-3 PILKHANI END) AGAINST THE EXISTING DFC CHAINAGE. 116277.742M ISSUED VIDE LETTER NO. CGM/DFCC/JMB/SURVEY/2021-301-230116-011173 DT. 17.01.2023
- BALLAST PROFILE HAS BEEN PROVIDED ACCORDING TO THE CLAUSE 1.11.3 OF STANDARD SCHEDULE OF DIMENSION(EASTERN CORRIDOR) & THE BALLAST CUSHION DIMENSION SHOWN IN 35CM ON GE-14 PARA 17. SPECIFICATIONS & RECOMMENDATIONS 2. TWO LAYER SYSTEM FIG.10.

REFERENCE DRAWINGS :-

- FOR KEY PLAN REFER DRAWING NO. 301-2/AL/0001
- FOR LEGEND AND ABBREVIATIONS REFER DRAWING NO. 301-2/AL/1000
- FOR TYPICAL SECTION OF BALLAST PROFILE (FL-RL) REFER DRG. NO. 301-2/TK/TFD/004 (TR.1952)

0	27.08.2024	SUBMISSION OF AS-BUILT DRAWING	FOR APPROVAL
REV.	DATE	REVISION DETAILS	PURPOSE OF ISSUE

SCALE


HOR - 1:1000

VER - 1:100

SHEET SIZE : A0

LEGEND:

IR TRACK
DFCC TRACK
LINK LINE (SHUN-RPJ)
DFCC FUTURE PROPOSALS
STRUCTURE / BUILDING
DFCC TOE LINE
DFCC FORMATION
RETAINING WALL
ROAD
STREAM, DRAIN, NALA, CANAL.
FENCE
POWER LINES
TBM
ELECTRIC POLE/OHE MAST
IR RAILWAY BOUNDARY
DFCC BOUNDARY

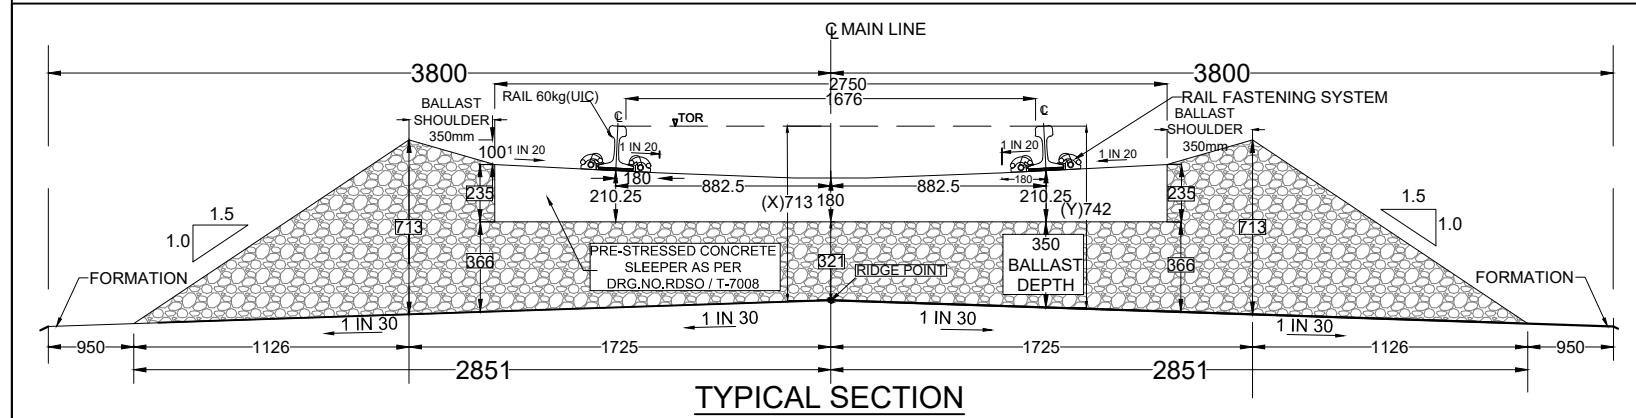

TRACK STRUCTURE		
RAIL SECTION: 60Kg/m (UIC 60Kg/m) DFC LINE: 60Kg/m (UIC 60Kg/m) IR MAIN LINE: 52Kg/m	Difference between FL- RL (Below Rail Seat)	
	IR Line	DFC
RUBBER PAD	172mm	172mm
SLEEPER DEPTH	6mm	10mm
BALLAST CUSHION	210mm	210mm
	300mm	350mm
Total Depth (FL TO RL)		688mm 742mm

OWNER
dfcc
DEDICATED FREIGHT CORRIDOR CORPORATION OF INDIA LTD.
(A GOVERNMENT OF INDIA ENTERPRISE)
PROJECT OFFICE: AMBALA UNIT, OLD RAILWAY COLONY (NEAR ANAND MARKET), AMBALA CANTT-133001.
CORPORATE IDENTITY NO. : U60232DL2006GOI155068

ENGINEER:
DB DB Engineering & Consulting GmbH
Deutsche Bahn Engineering & Consulting GmbH

CONTRACTOR:
GIL - TPL JV
GAR **TATA**

SUBMITTED BY	GIL - TPL JV		
	DATED	NAME	SIGNATURE
PREPARED BY			
CHECKED BY	27.08.2024	VIJAY PRATAP	
APPROVED BY	27.08.2024	PARASURAM KOTYADA	



APPROVED BY	DEUTSCHE BAHN ENGINEERING & CONSULTING GMBH		
	DATED	NAME	SIGNATURE
Sr. DE./CHIEF ENGINEER		SURESH K.YALANGI	
CHIEF TRACK ENGINEER		RAJ PAL SINGH	
T.L.		H.D. VIDJAK	

STAMP
A AS-BUILT DRAWING
TR. Ref.....
ENGINEER Sign..:

EMPLOYER (DFCCIL): DEDICATED FREIGHT CORRIDOR CORPORATION OF INDIA LTD.

AS BUILT DRAWING			
TITLE		DFCC APPR. NO. -	
AS-BUILT PLAN AND PROFILE		ENGG. APPR. NO. -	
FROM IR KM: 286.000 TO 286.500		DRG. NO. - 301-2/AL/A/1198	
DFC KM: 1175.419 TO 1175.949		SHEET NO. : 1 OF 1	
		DATE : 27.08.2024	
		STATUS	
		A	

TR.

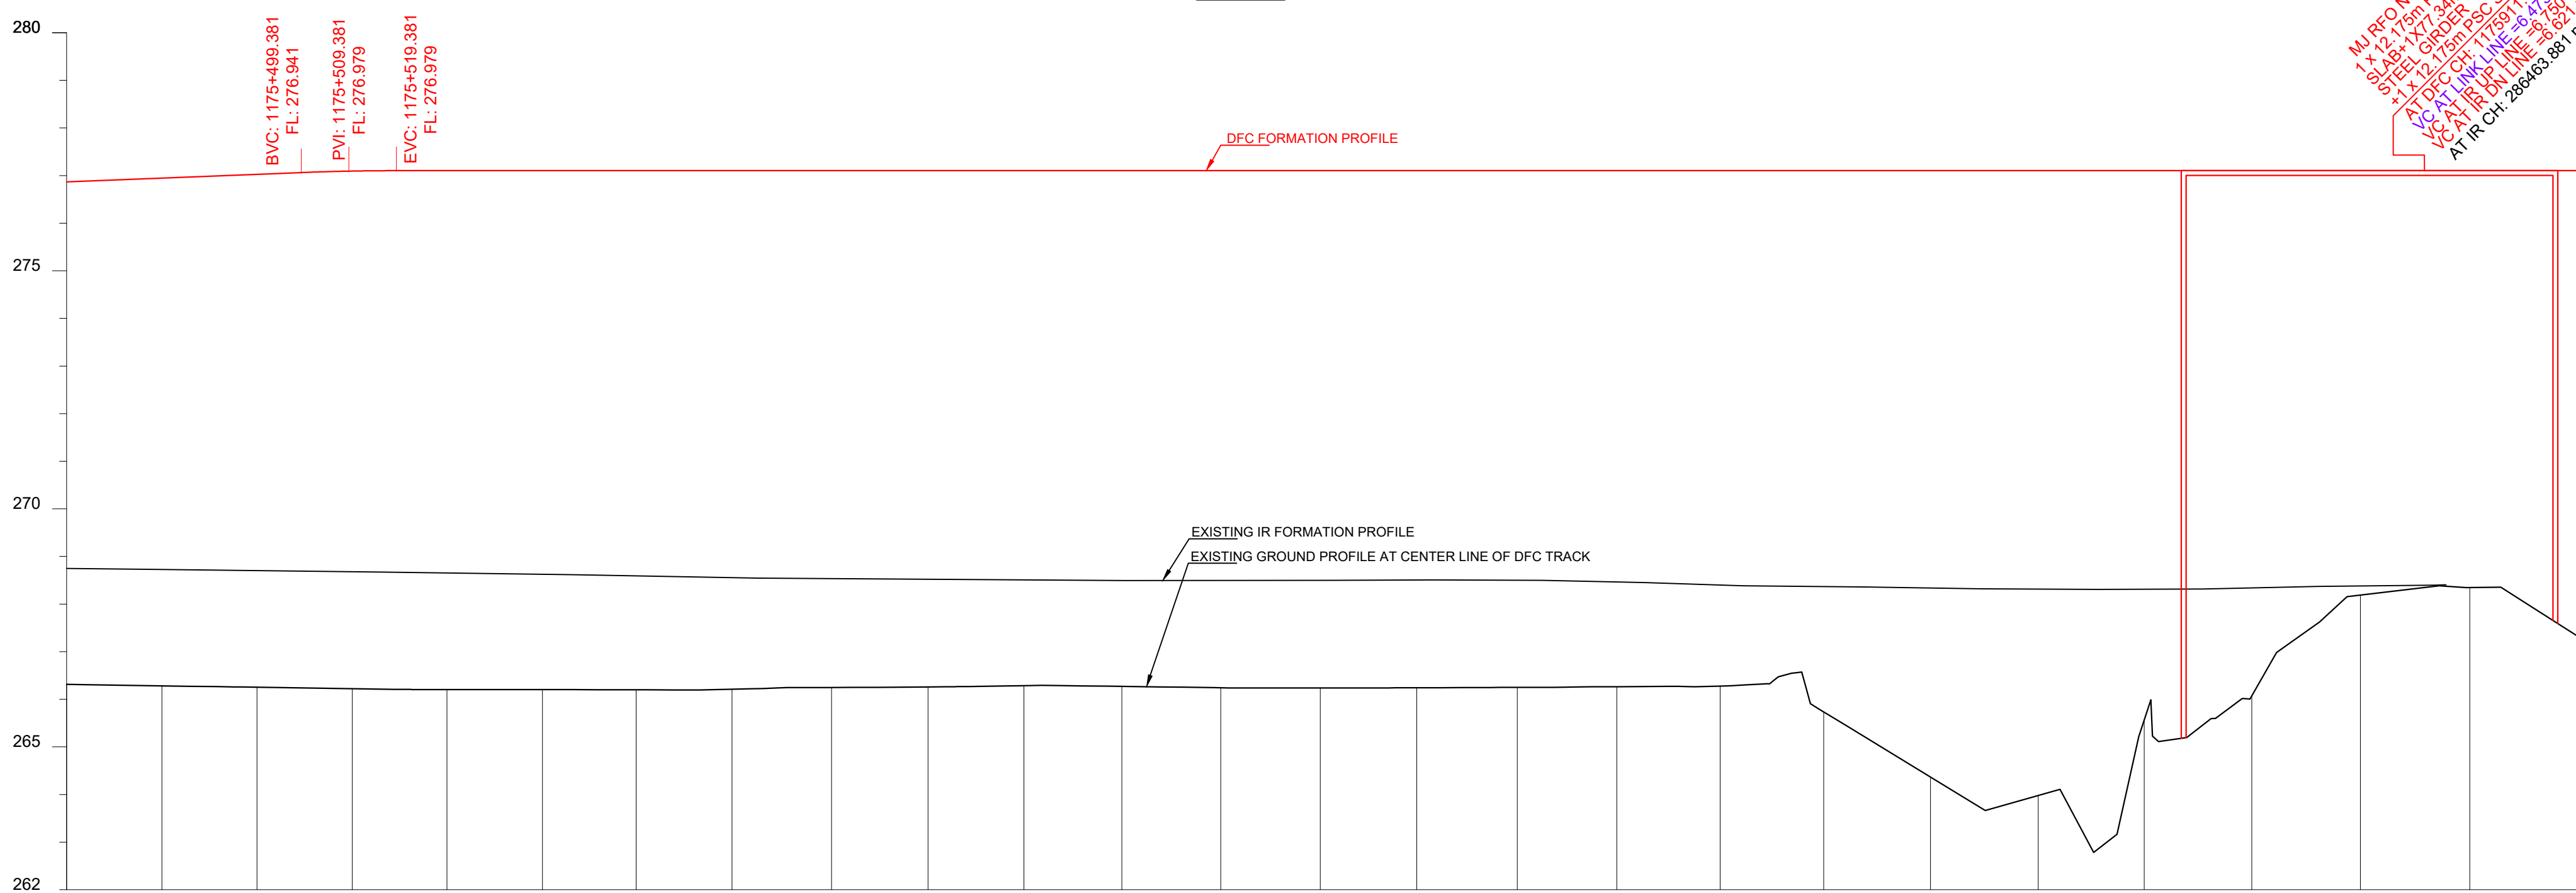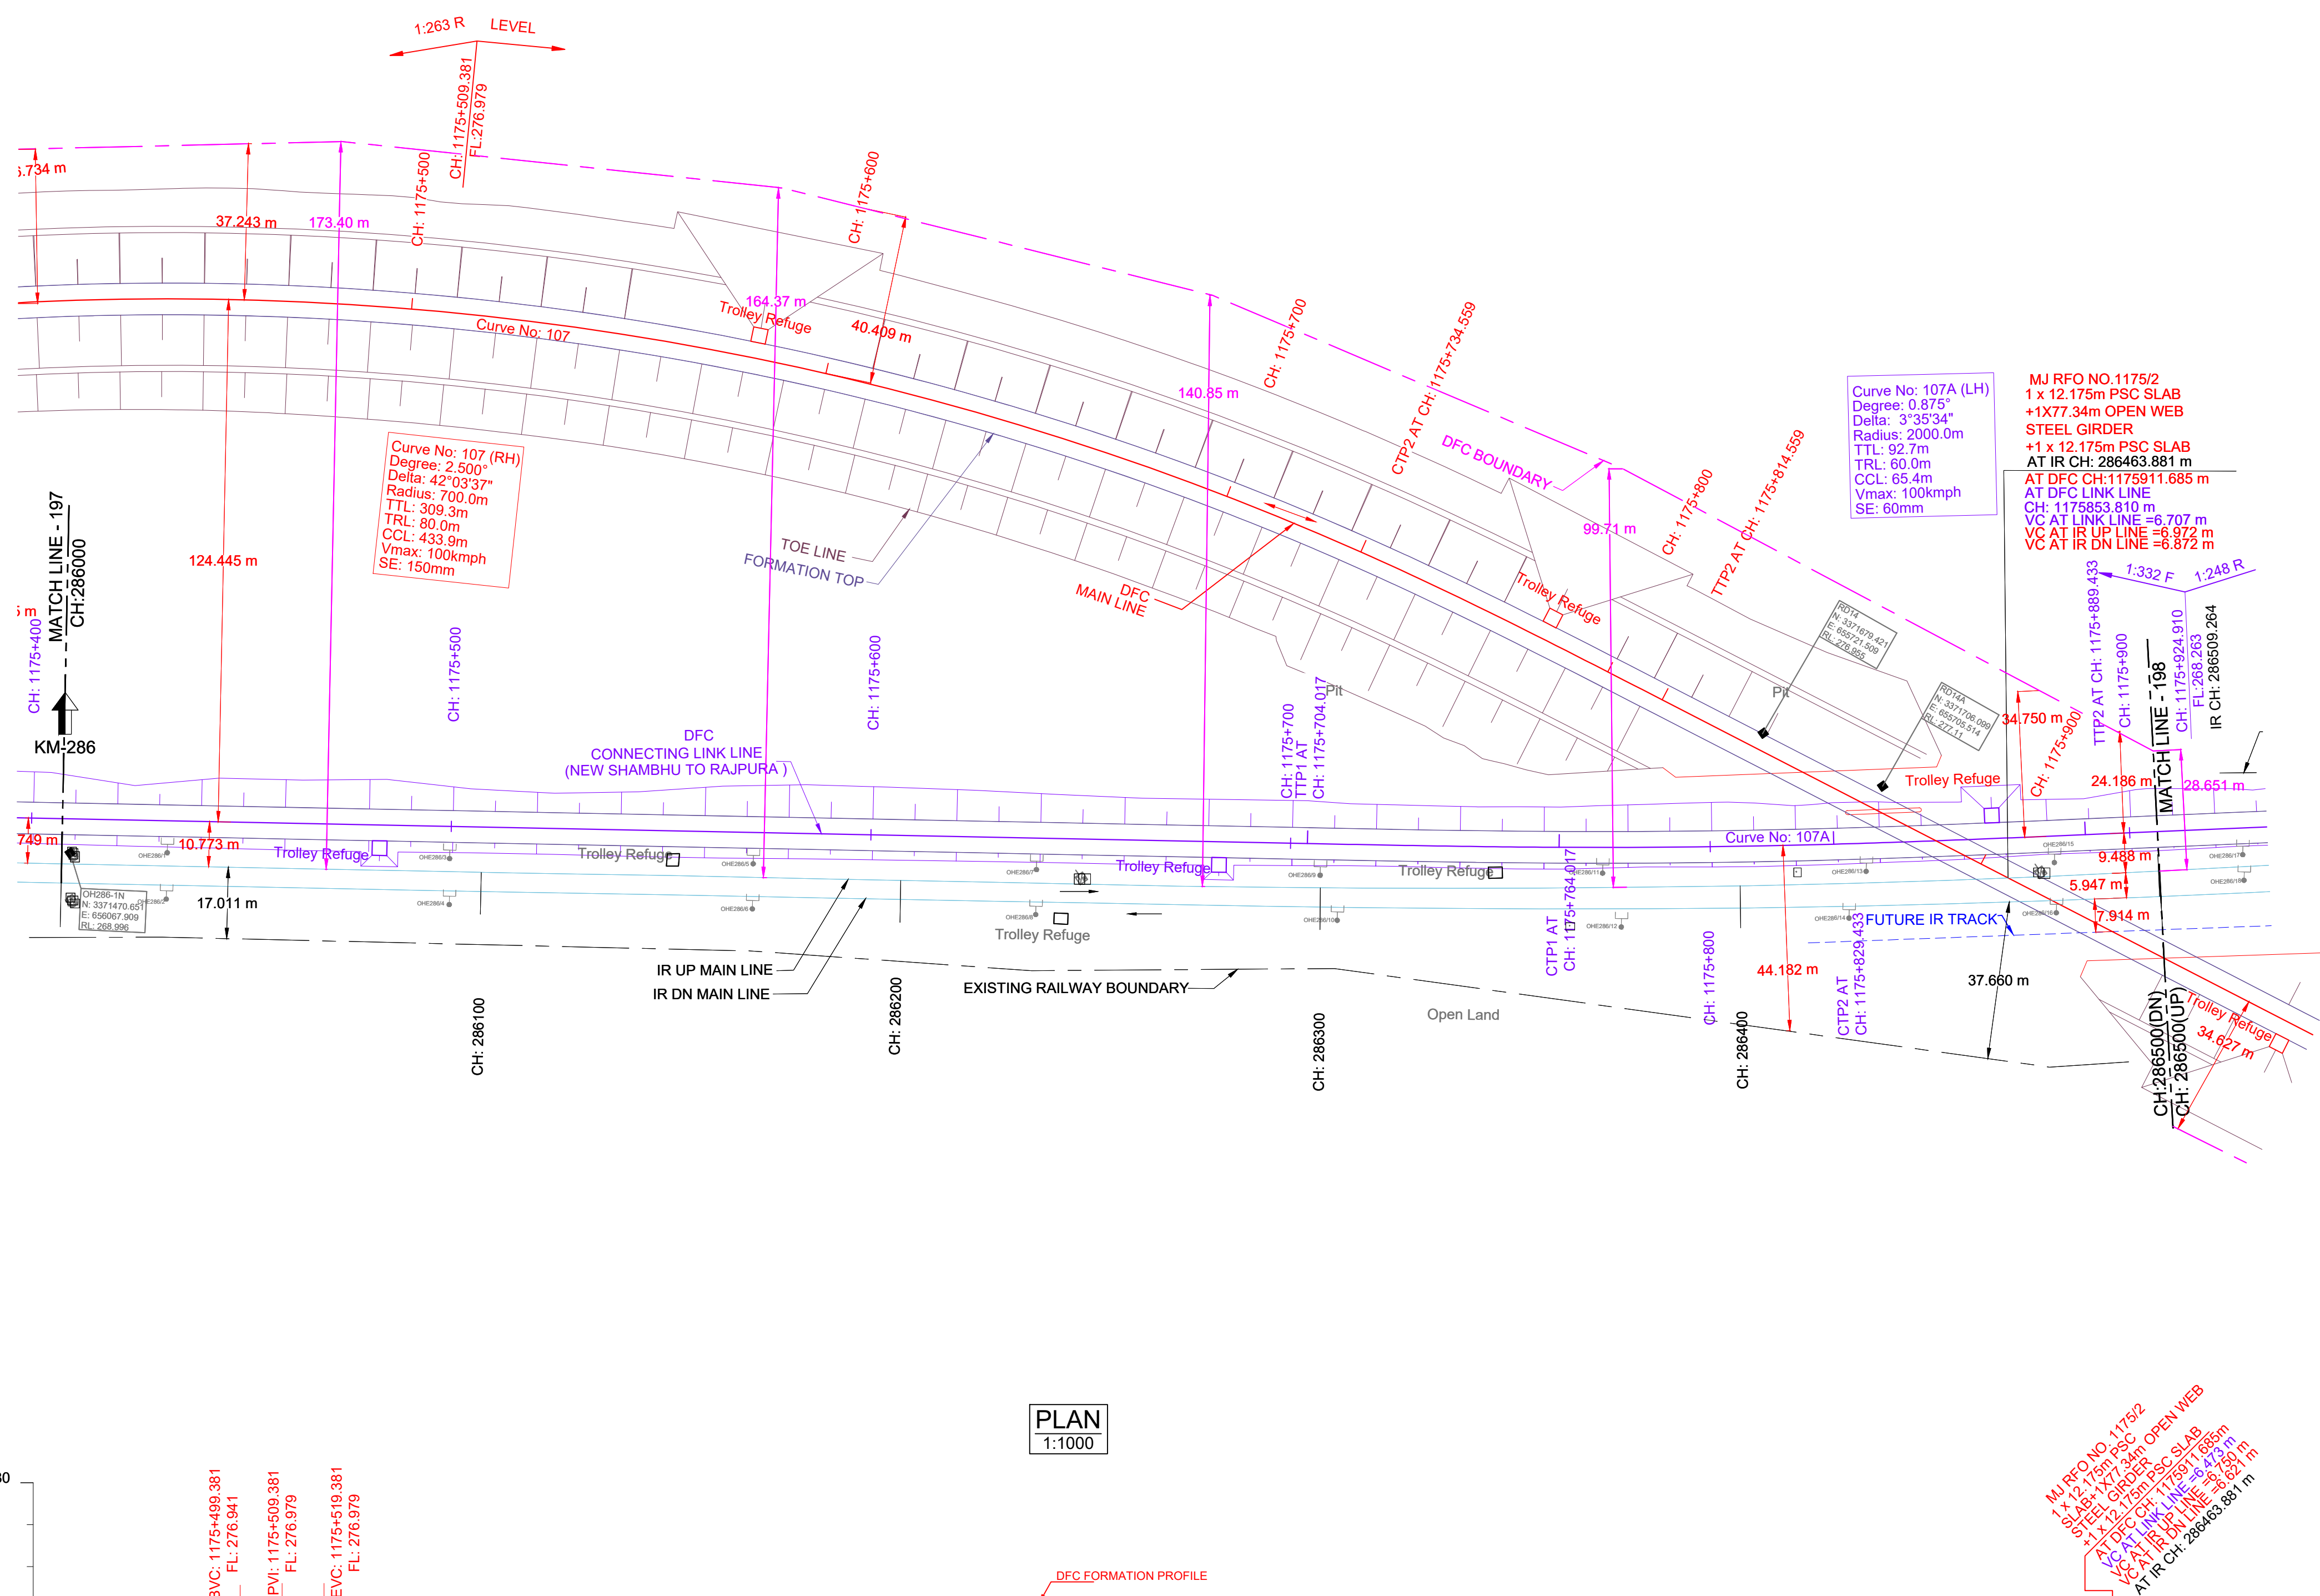


HORIZONTAL ALIGNMENT		R=700m		TL= 80m		L= 179.487m	
VERTICAL ALIGNMENT		L=100.4 m T.W=202.973 R		L=20.0 m H=52.57 m		L=69.6 m H=54 m	
TRACK DISTANCE FROM EXISTING NEAREST IR UP MAIN LINE TO DFC MAIN LINE		286000.0-1175419.5	134.233	286000.0-1175419.5	134.233	286000.0-1175419.5	134.233
HEIGHT OF BANKING(+) / DEPTH OF CUTTING(-) (PFL-GL)		286000.0-1175419.5	+10.536-134.233	286000.0-1175419.5	+10.536-134.233	286000.0-1175419.5	+10.536-134.233
EXG GROUND LEVEL AT CENTER LINE OF DFC TRACK (GL)		286000.0-1175419.5	266.081	286000.0-1175419.5	266.081	286000.0-1175419.5	266.081
EXG GROUND LEVEL AT TOE LOCATION OF DFC TRACK		286000.0-1175419.5	266.081	286000.0-1175419.5	266.081	286000.0-1175419.5	266.081
DIFFERENCE BETWEEN DFC FORMATION LEVEL AND EXG FORMATION LEVEL (PFL-EFL)		286000.0-1175419.5	8.105	286000.0-1175419.5	8.105	286000.0-1175419.5	8.105
DFC FORMATION LEVEL (PFL)		286000.0-1175419.5	276.637	286000.0-1175419.5	276.637	286000.0-1175419.5	276.637
EXG FORMATION LEVEL OF EXG IR UP MAIN LINE (EFL)		286000.0-1175419.5	268.532	286000.0-1175419.5	268.532	286000.0-1175419.5	268.532
DIFFERENCE BETWEEN DFC RAIL LEVEL AND EXG RAIL LEVEL (PRL - ERL)		286000.0-1175419.5	8.146	286000.0-1175419.5	8.146	286000.0-1175419.5	8.146
DFC RAIL LEVEL (PRL)		286000.0-1175419.5	277.330	286000.0-1175419.5	277.330	286000.0-1175419.5	277.330
EXG RAIL LEVEL OF NEAREST IR UP MAIN LINE(ERL)		286000.0-1175419.5	269.204	286000.0-1175419.5	269.204	286000.0-1175419.5	269.204
EQUIVALENT CHAINAGE ON DFC TRACK		286000.0-1175419.5	269.204	286000.0-1175419.5	269.204	286000.0-1175419.5	269.204
EXISTING IR CHAINAGE		286000.0-1175419.5	269.204	286000.0-1175419.5	269.204	286000.0-1175419.5	269.204

L - SECTION

PILKHANI

SAHNEWAL

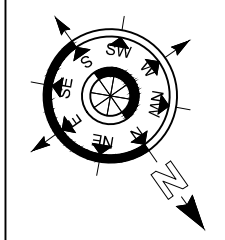

DRG NO.301-2/AL/A/1199

NOTE:-

- DFCC WORKS ARE SHOWN IN **RED**.
- IR NEW WORKS ARE SHOWN IN **VIOLET**.
- ALL DIMENSIONS ARE SHOWN IN METRES.
- THIS DRAWING IS PREPARED BASED ON LATEST SURVEY DATA HELD ON APRIL-2022. GTS BENCH MARK OF 261.850M CONSIDERED ON TOP OF CANAL BRIDGE ABUTMENT AT DORAHA VILLAGE ALONG THE NH-1.
- DFCC NEW CHAINAGE OF 1075.950M IS WITH REFERENCE TO THE IR KM OF 187.500KM END OF KM OF CP-303/SECTION P-3 PILKHANI END) AGAINST THE EXISTING DFC CHAINAGE. 116277.742M ISSUED VIDE LETTER NO. CGM/DFCC/JMB/SURVEY/2021-301-230116-011173 DT. 17.01.2023
- BALLAST PROFILE HAS BEEN PROVIDED ACCORDING TO THE CLAUSE 1.11.3 OF STANDARD SCHEDULE OF DIMENSION (EASTERN CORRIDOR) & THE BALLAST CUSHION DIMENSION SHOWN IN 35CM ON GE-14 PARA 17. SPECIFICATIONS & RECOMMENDATIONS 2. TWO LAYER SYSTEM FIG.10.

REFERENCE DRAWINGS :-

- FOR KEY PLAN REFER DRAWING NO. 301-2/AL/0001
- FOR LEGEND AND ABBREVIATIONS REFER DRAWING NO. 301-2/AL/1000
- FOR TYPICAL SECTION OF BALLAST PROFILE (FL-RL) REFER DRG. NO. 301-2/TK/TFD/-004 (TR.1952)

0	27.08.2024	SUBMISSION OF AS-BUILT DRAWING	FOR APPROVAL
REV.	DATE	REVISION DETAILS	PURPOSE OF ISSUE

SCALE


HOR - 1:1000

VER - 1:100

SHEET SIZE : A0

LEGEND:

- IR TRACK
- DFCC TRACK
- LINK LINE (SHUN-RPJ)
- DFCC FUTURE PROPOSALS
- STRUCTURE / BUILDING
- DFCC TOE LINE
- DFCC FORMATION
- RETAINING WALL
- ROAD
- STREAM, DRAIN, NALA, CANAL.
- FENCE
- POWER LINES
- TBM
- ELECTRIC POLE/OHE MAST
- IR RAILWAY BOUNDARY
- DFCC BOUNDARY

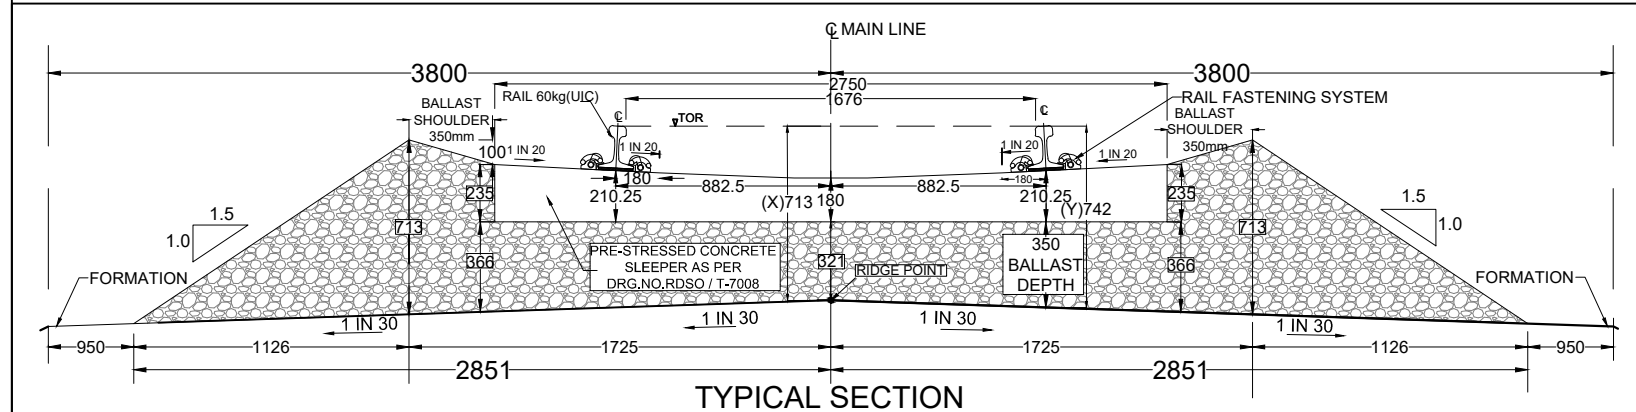

TRACK STRUCTURE		
RAIL SECTION: 60Kg/m (UIC 60Kg/m) DFC LINE: 60Kg/m (UIC 60Kg/m) IR MAIN LINE: 52Kg/m	Difference between FL- RL (Below Rail Seat)	
	IR Line	DFC
RUBBER PAD	172mm	172mm
SLEEPER DEPTH	6mm	10mm
BALLAST CUSHION	210mm	210mm
	300mm	350mm
Total Depth (FL TO RL)		688mm 742mm

OWNER	DEDICATED FREIGHT CORRIDOR CORPORATION OF INDIA LTD. (A GOVERNMENT OF INDIA ENTERPRISE) PROJECT OFFICE: AMBALA UNIT, OLD RAILWAY COLONY (NEAR ANAND MARKET), AMBALA CANTT-133001. CORPORATE IDENTITY NO. : U60232DL2006GOI155068
-------	---

ENGINEER:	DB Engineering & Consulting GmbH Deutsche Bahn Engineering & Consulting GmbH
-----------	--

CONTRACTOR:	GIL - TPL JV GAR TATA
-------------	---------------------------------

SUBMITTED BY	GIL - TPL JV		
	DATED	NAME	SIGNATURE
PREPARED BY			
CHECKED BY	27.08.2024	VIJAY PRATAP	
APPROVED BY	27.08.2024	PARASURAM KOTYADA	

APPROVED BY	DEUTSCHE BAHN ENGINEERING & CONSULTING GMBH		
	DATED	NAME	SIGNATURE
Sr. DE./CHIEF ENGINEER		SURESH K.YALANGI	
CHIEF TRACK ENGINEER		RAJ PAL SINGH	
T.L.		H.D. VIDJAK	



STAMP	A AS-BUILT DRAWING TR. Ref..... ENGINEER Sign:.....
-------	---

EMPLOYER (DFCCIL):	DEDICATED FREIGHT CORRIDOR CORPORATION OF INDIA LTD.
--------------------	--

--	--	--	--

AS BUILT DRAWING			
TITLE		DFCC APPR. NO. -	
AS-BUILT PLAN AND PROFILE		ENGG. APPR. NO. -	
FROM IR KM: 286.500 TO 287.000		DRG. NO. - 301-2/AL/A/1199	
DFC KM: 1175.949 TO 1176.467		SHEET NO. : 1 OF 1	
		DATE : 27.08.2024	
		STATUS	
		A	

TR.

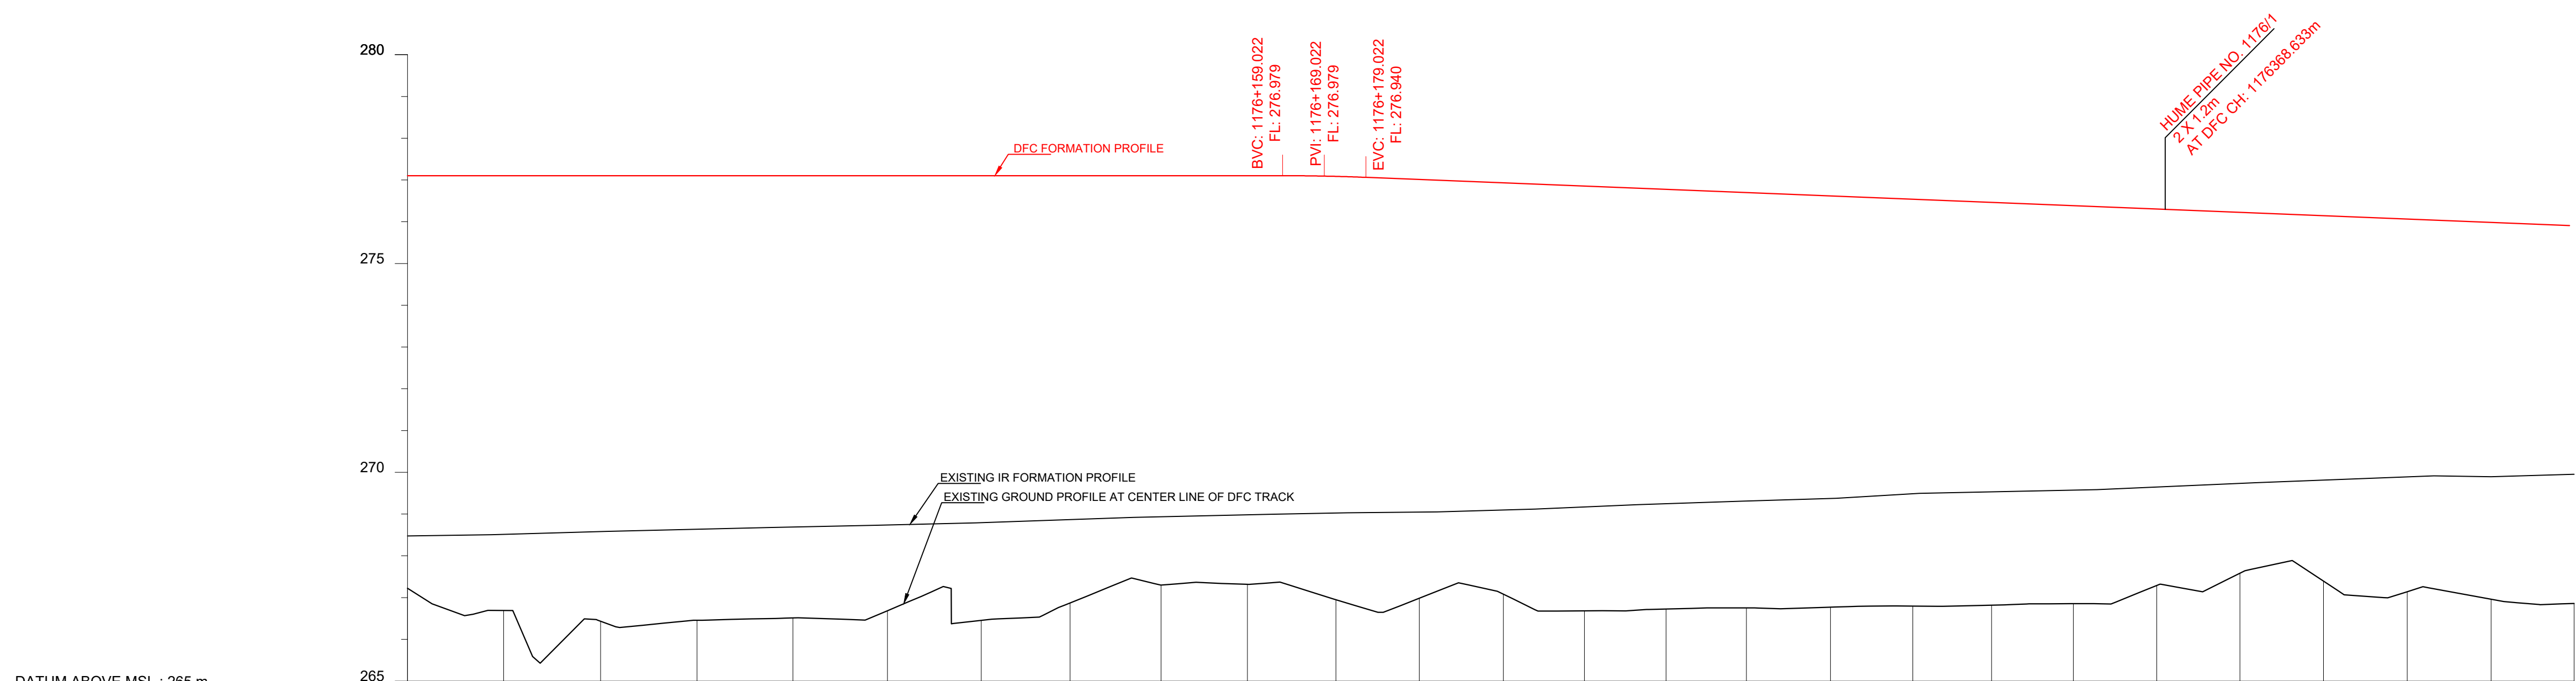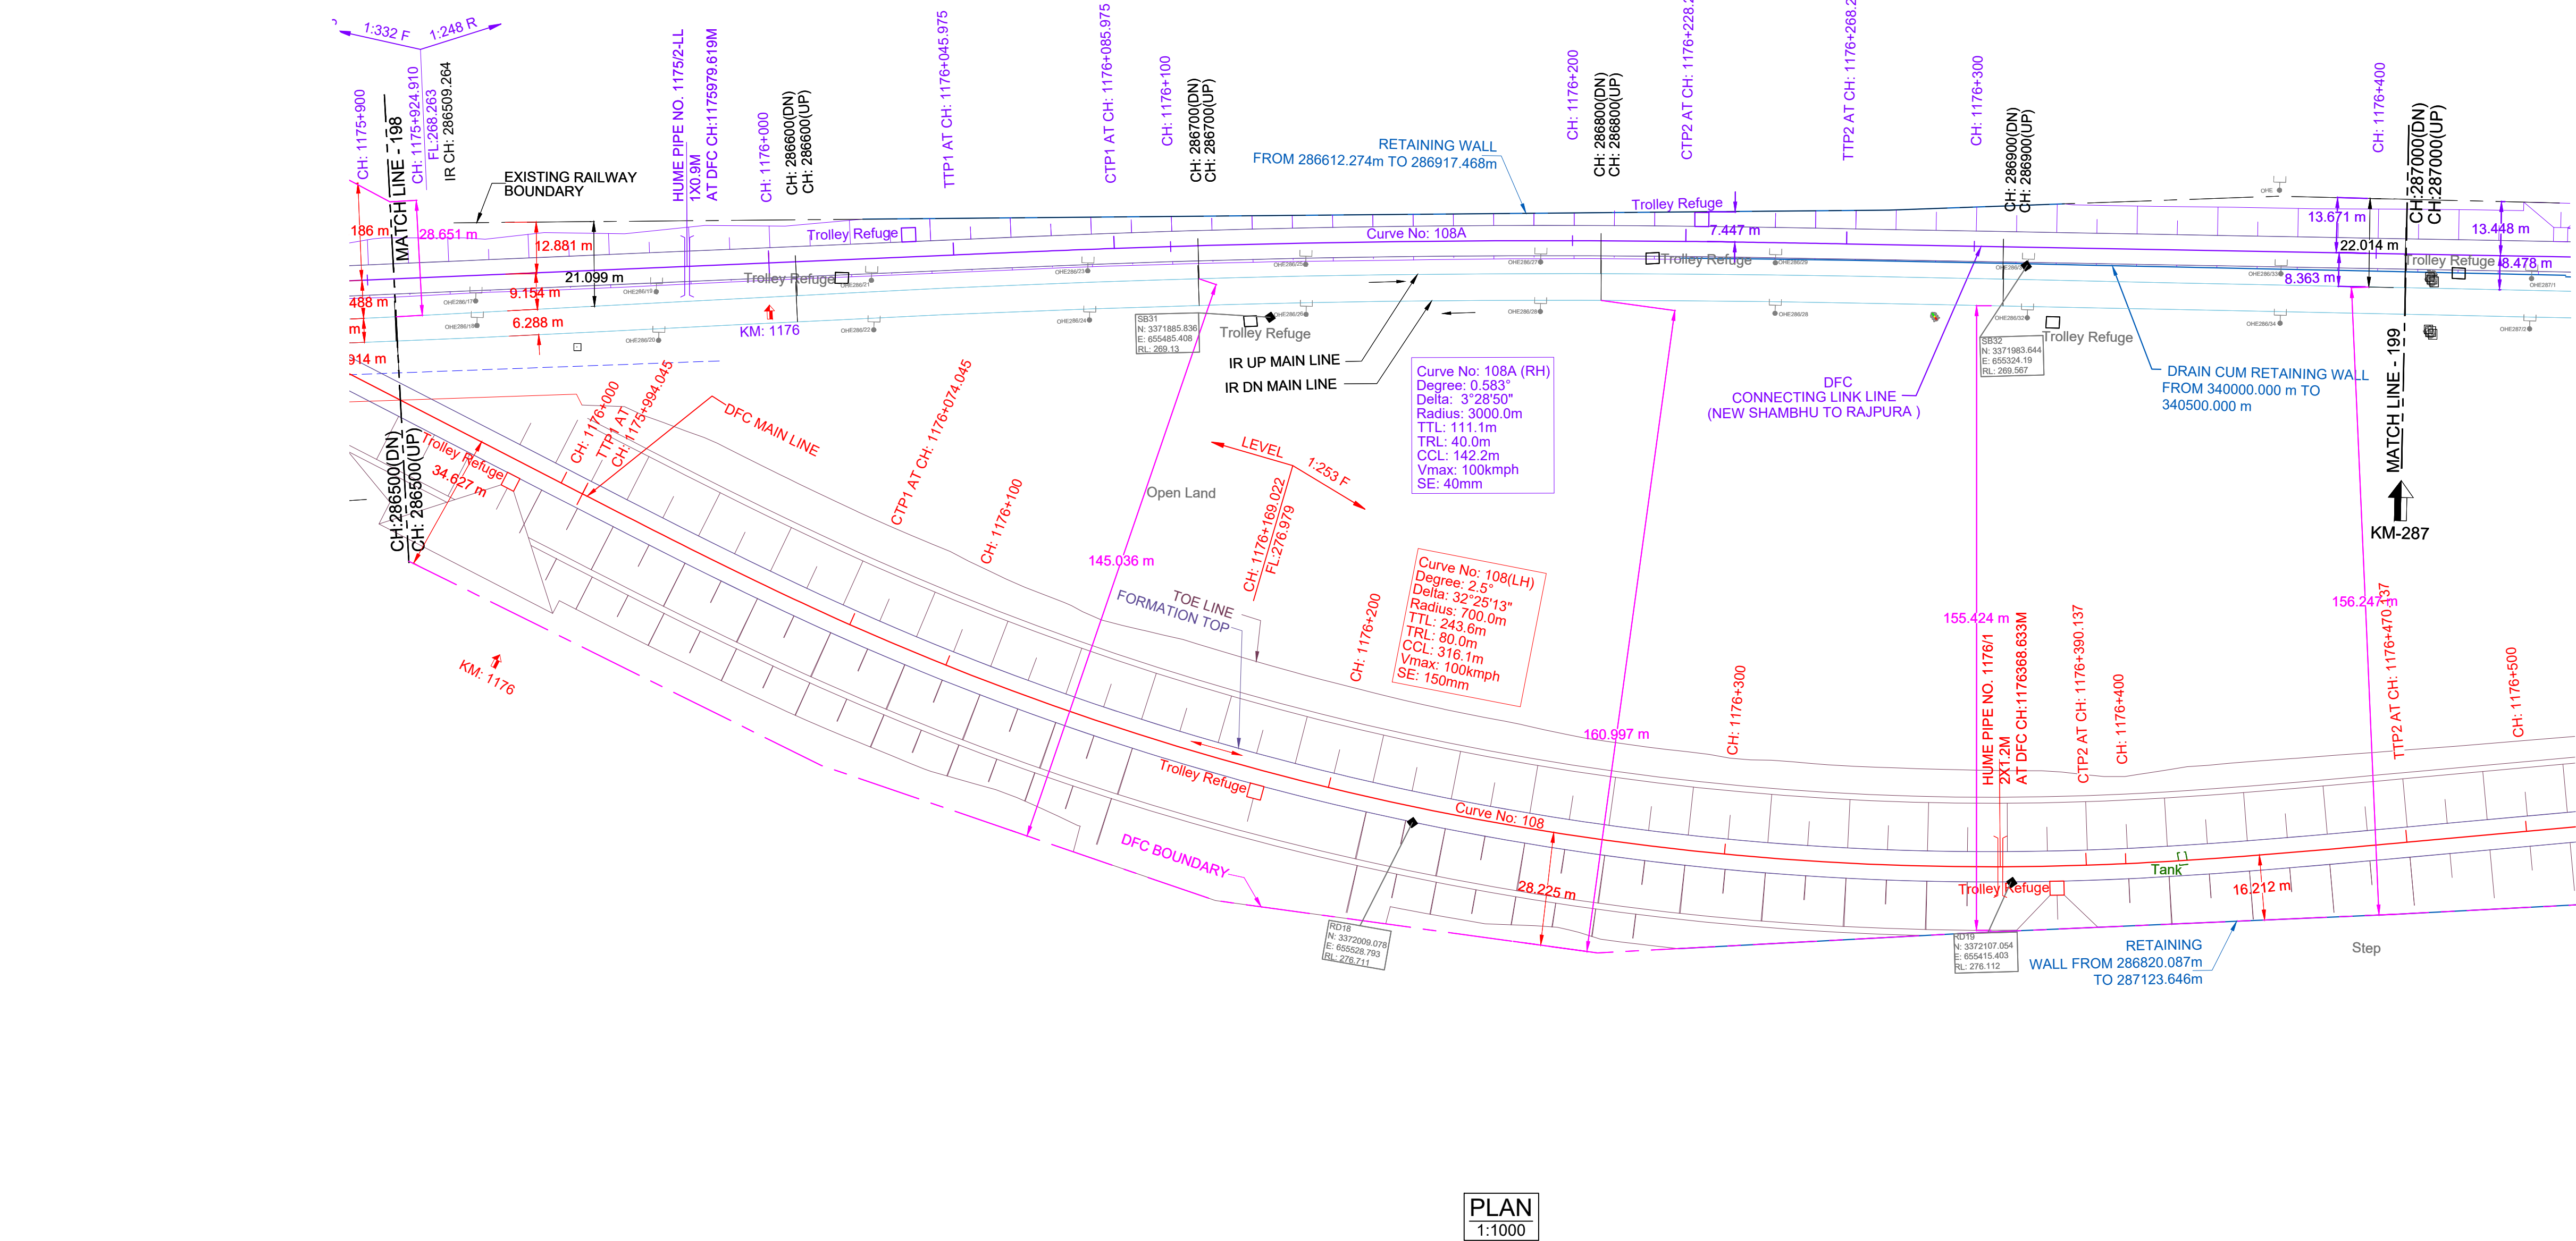


HORIZONTAL ALIGNMENT	L = 179.487m TL= 80m		R = 700m		TL= 80m	
VERTICAL ALIGNMENT	L=630.64 m		L=520.0 m R=5069 m		L=729.210 m IN 253.454 F	
TRACK DISTANCE FROM EXISTING NEAREST IR DN MAIN LINE TO DFC MAIN LINE	14.688					
HEIGHT OF BANKING(+)/ DEPTH OF CUTTING(-) (PRL-GL)	+5.880	-14.688				
EXG GROUND LEVEL AT CENTER LINE OF DFC TRACK (GL)	265.186	267.099	+5.880			
EXG GROUND LEVEL AT TOE LOCATION OF DFC TRACK	265.157	266.568	+10.411	25.976		
DIFFERENCE BETWEEN DFC FORMATION LEVEL AND EXG FORMATION LEVEL (PFL-EFL)	8.612					
DFC FORMATION LEVEL (PFL)	265.979	267.979	8.612			
EXG FORMATION LEVEL OF EXG IR DN MAIN LINE (EFL)	265.367	267.367	265.979	8.612		
DIFFERENCE BETWEEN DFC RAIL LEVEL AND EXG. RAIL LEVEL (PRL - ERL)	8.633					
DFC RAIL LEVEL (PRL)	267.602	267.602	8.633			
EXG RAIL LEVEL OF NEAREST IR DN MAIN LINE (ERL)	266.969	266.969	267.602	8.633		
EQUIVALENT CHAINAGE ON DFC TRACK	286500.0	286500.0	286500.0	286500.0	286500.0	286500.0
EXISTING IR CHAINAGE	286500.0	286500.0	286500.0	286500.0	286500.0	286500.0

L - SECTION

PILKHANI

SAHNEWAL

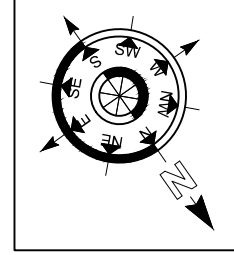

DRG NO.301-2/AL/A/1200

- NOTE:-
- DFCC WORKS ARE SHOWN IN **RED**.
 - IR NEW WORKS ARE SHOWN IN **VIOLET**.
 - ALL DIMENSIONS ARE SHOWN IN METRES.
 - THIS DRAWING IS PREPARED BASED ON LATEST SURVEY DATA HELD ON APRIL-2022. GTS BENCH MARK OF 261.850M CONSIDERED ON TOP OF CANAL BRIDGE ABUTMENT AT DORAHA VILLAGE ALONG THE NH-1.
 - DFCC NEW CHAINAGE OF 1075.950M IS WITH REFERENCE TO THE IR KM OF 187.500KM END OF KM OF CP-303/SECTION P-3 PILKHANI END) AGAINST THE EXISTING DFC CHAINAGE. 116277.742M ISSUED VIDE LETTER NO. CGM/DFCC/JMB/SURVEY/2021-301-230/116-01/1173 DT. 17.01.2023
 - BALLAST PROFILE HAS BEEN PROVIDED ACCORDING TO THE CLAUSE 1.11.3 OF STANDARD SCHEDULE OF DIMENSION(EASTERN CORRIDOR) & THE BALLAST CUSHION DIMENSION SHOWN IN 35CM ON GE-14 PARA 17. SPECIFICATIONS & RECOMMENDATIONS 2. TWO LAYER SYSTEM FIG.10.

REFERENCE DRAWINGS :-

- FOR KEY PLAN REFER DRAWING NO. 301-2/AL/0001
- FOR LEGEND AND ABBREVIATIONS REFER DRAWING NO. 301-2/AL/1000
- FOR TYPICAL SECTION OF BALLAST PROFILE (FL-RL) REFER DRG. NO. 301-2/TK/TFD/004 (TR.1952)

REV.	DATE	REVISION DETAILS	PURPOSE OF ISSUE
0	27.08.2024	SUBMISSION OF AS-BUILT DRAWING	FOR APPROVAL

SCALE


HOR - 1:1000

VER - 1:100

SHEET SIZE : A0

LEGEND:

- IR TRACK
- DFCC TRACK
- LINK LINE (S/MUN-RPJ)
- DFCC FUTURE PROPOSALS
- STRUCTURE / BUILDING
- DFCC TOE LINE
- DFCC FORMATION
- RETAINING WALL
- ROAD
- STREAM, DRAIN, NALA, CANAL.
- FENCE
- POWER LINES
- TBM
- ELECTRIC POLE/OHE MAST
- IR RAILWAY BOUNDARY
- DFCC BOUNDARY

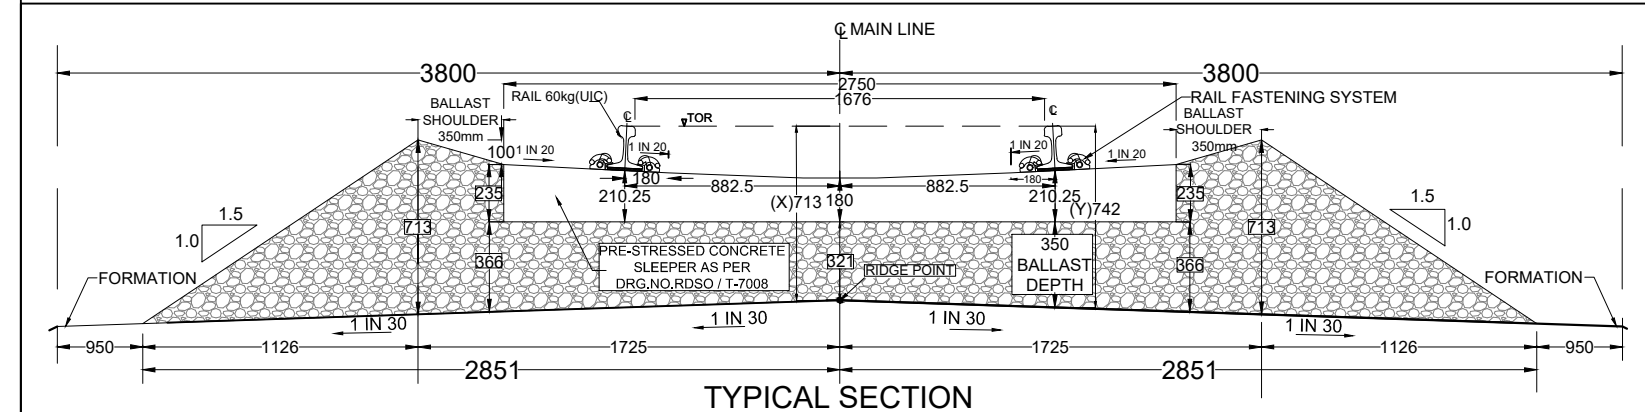

TRACK STRUCTURE		
RAIL SECTION: 60Kg/m (UIC 60Kg/m) DFC LINE: 60Kg/m (UIC 60Kg/m) IR MAIN LINE: 52Kg/m	Difference between FL- RL (Below Rail Seat)	
	IR Line	DFC
RUBBER PAD	172mm	172mm
SLEEPER DEPTH	6mm	10mm
BALLAST CUSHION	210mm	210mm
	300mm	350mm
Total Depth (FL TO RL)	688mm	742mm

OWNER
dedicated freight corridor corporation of india ltd.
(A GOVERNMENT OF INDIA ENTERPRISE)
PROJECT OFFICE: AMBALA UNIT, OLD RAILWAY COLONY (NEAR ANAND MARKET), AMBALA CANTT-133001.
CORPORATE IDENTITY NO.: U60232DL2006GOI155068

ENGINEER:
DB Engineering & Consulting GmbH
Deutsche Bahn Engineering & Consulting GmbH

CONTRACTOR:
GIL - TPL JV
GAR TATA

SUBMITTED BY	GIL - TPL JV		
	DATED	NAME	SIGNATURE
PREPARED BY			
CHECKED BY	27.08.2024	VIJAY PRATAP	
APPROVED BY	27.08.2024	PARASURAM KOTYADA	


APPROVED BY	DEUTSCHE BAHN ENGINEERING & CONSULTING GMBH		
	DATED	NAME	SIGNATURE
Sr. DE./CHIEF ENGINEER		SURESH K.YALANGI	
CHIEF TRACK ENGINEER		RAJ PAL SINGH	
T.L.		H.D. VIDJAK	

STAMP
A AS-BUILT DRAWING
TR. Ref.....
ENGINEER Sign:..


EMPLOYER (DFCCIL): DEDICATED FREIGHT CORRIDOR CORPORATION OF INDIA LTD.

AS BUILT DRAWING		
TITLE AS-BUILT PLAN AND PROFILE FROM IR KM: 287.000 TO 287.500 DFC KM: 1176.467 TO 1177.970	DFCC APPR. NO. -	
	ENGG. APPR. NO. -	
	DRG. NO. - 301-2/AL/A/1200	
	SHEET NO. : 1 OF 1	STATUS A
DATE: 27.08.2024		

TR.

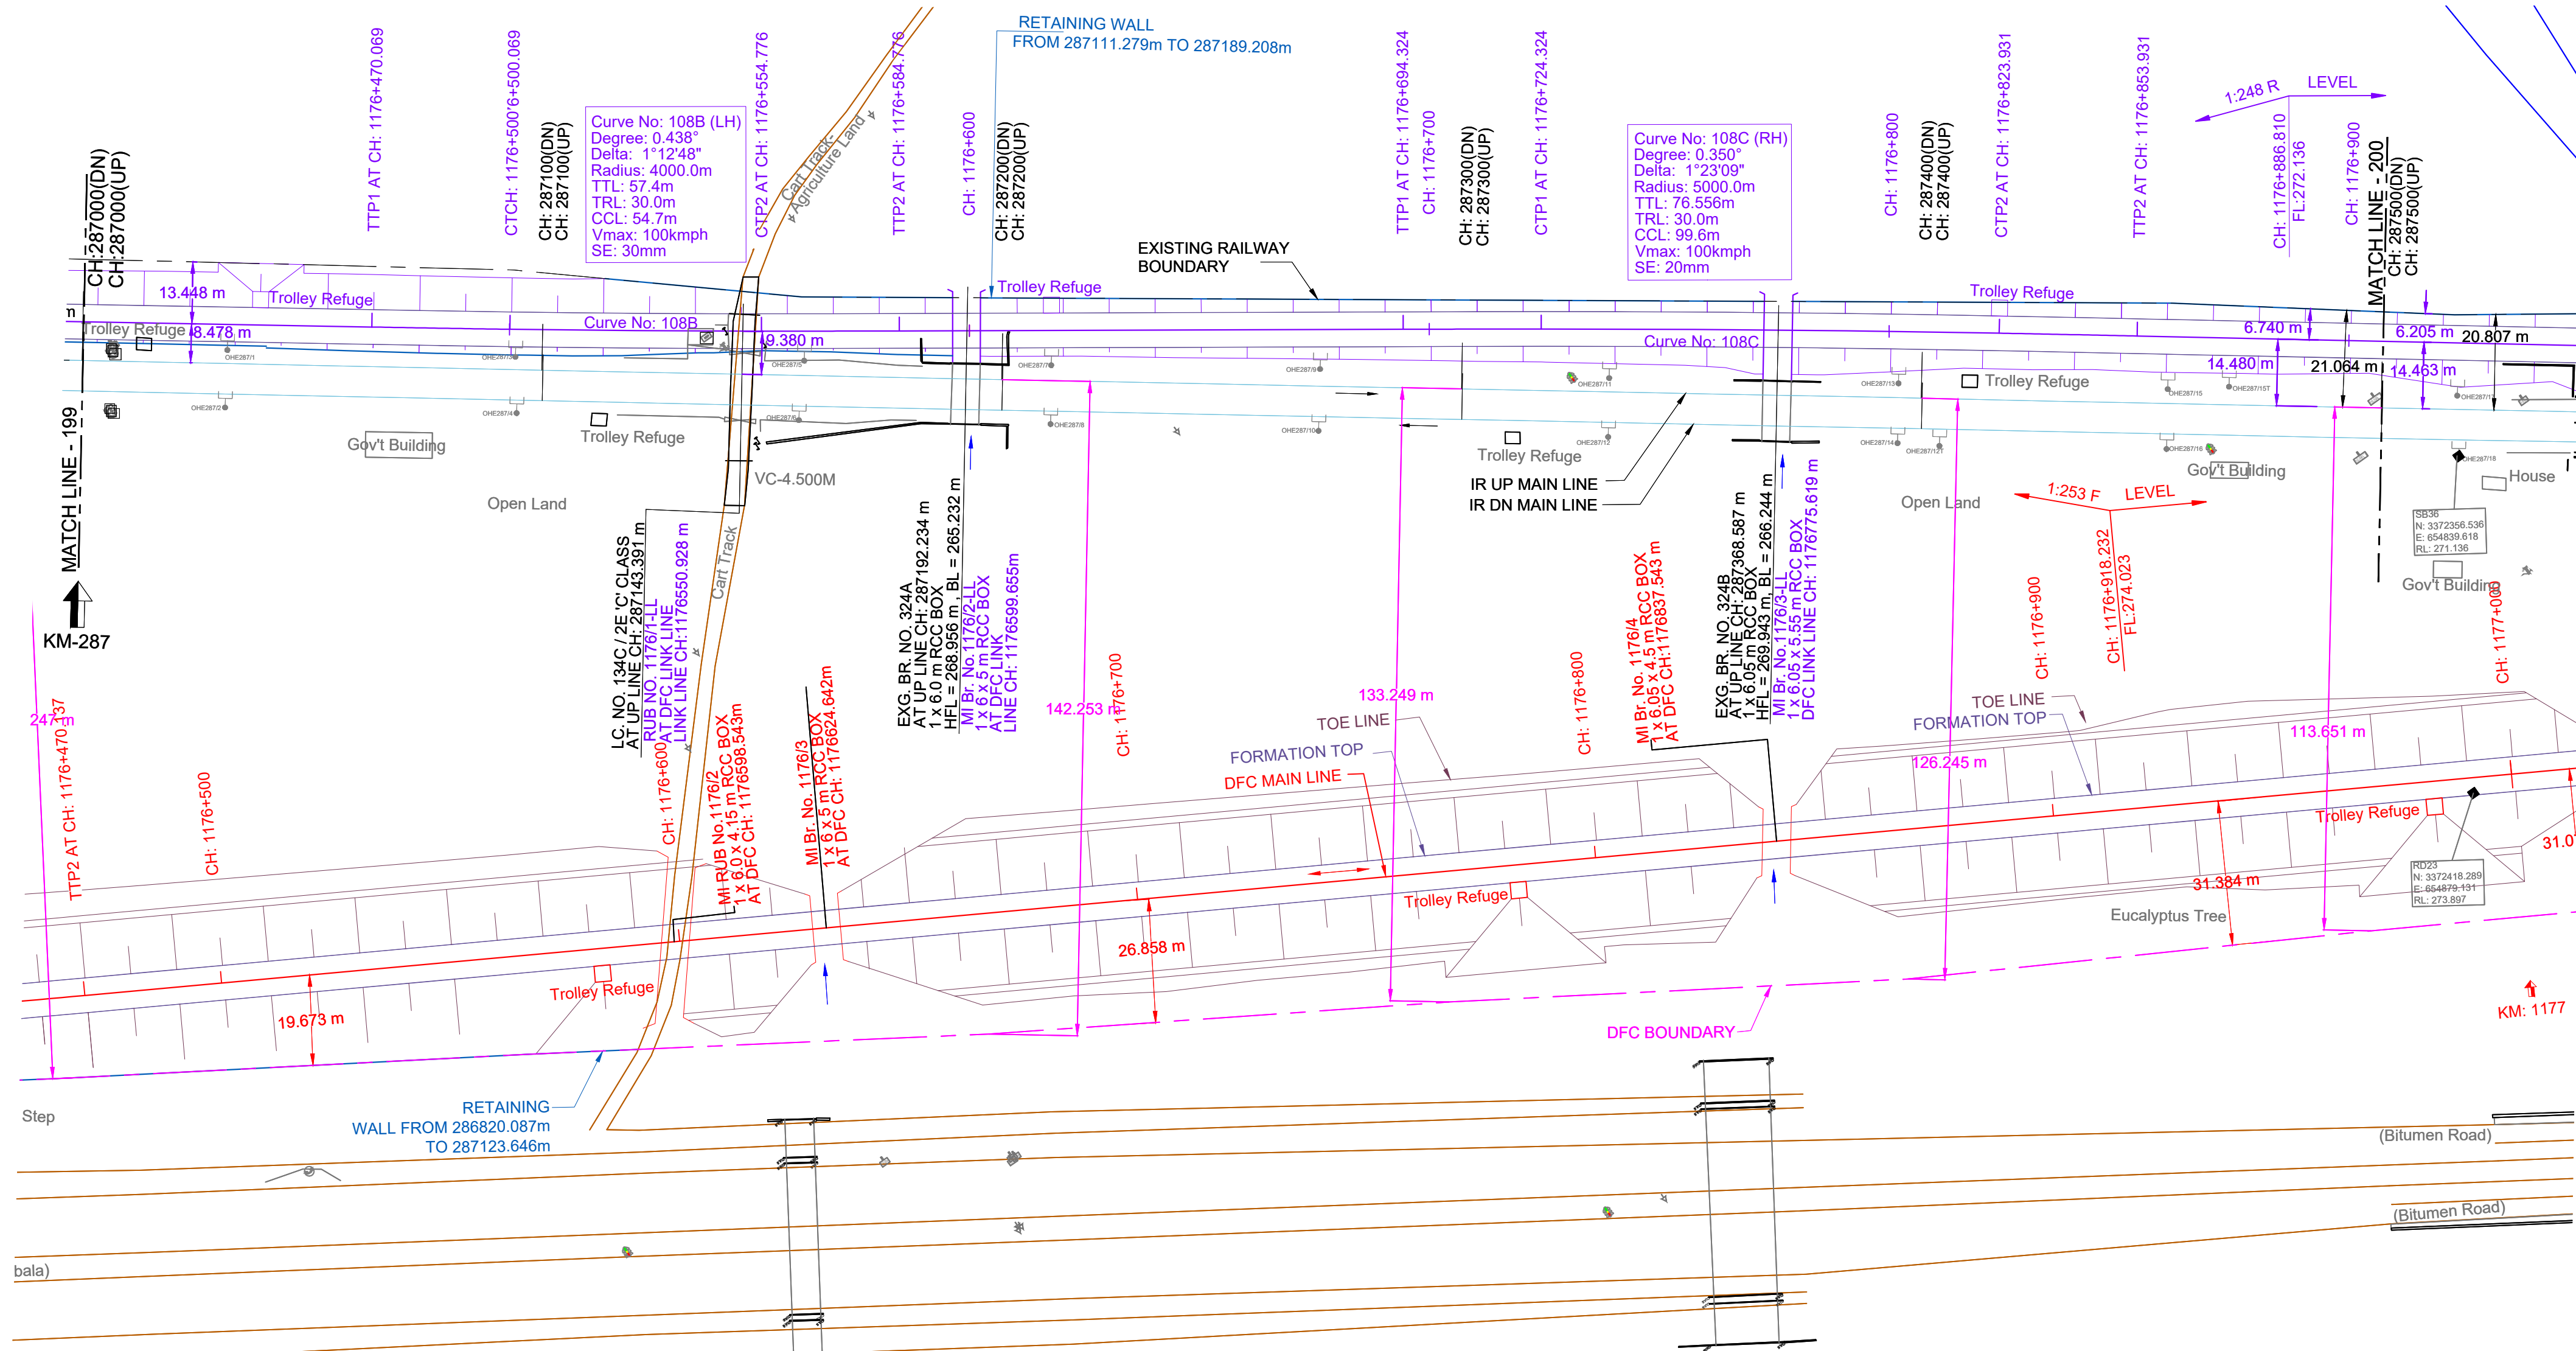

PLAN
1:1000

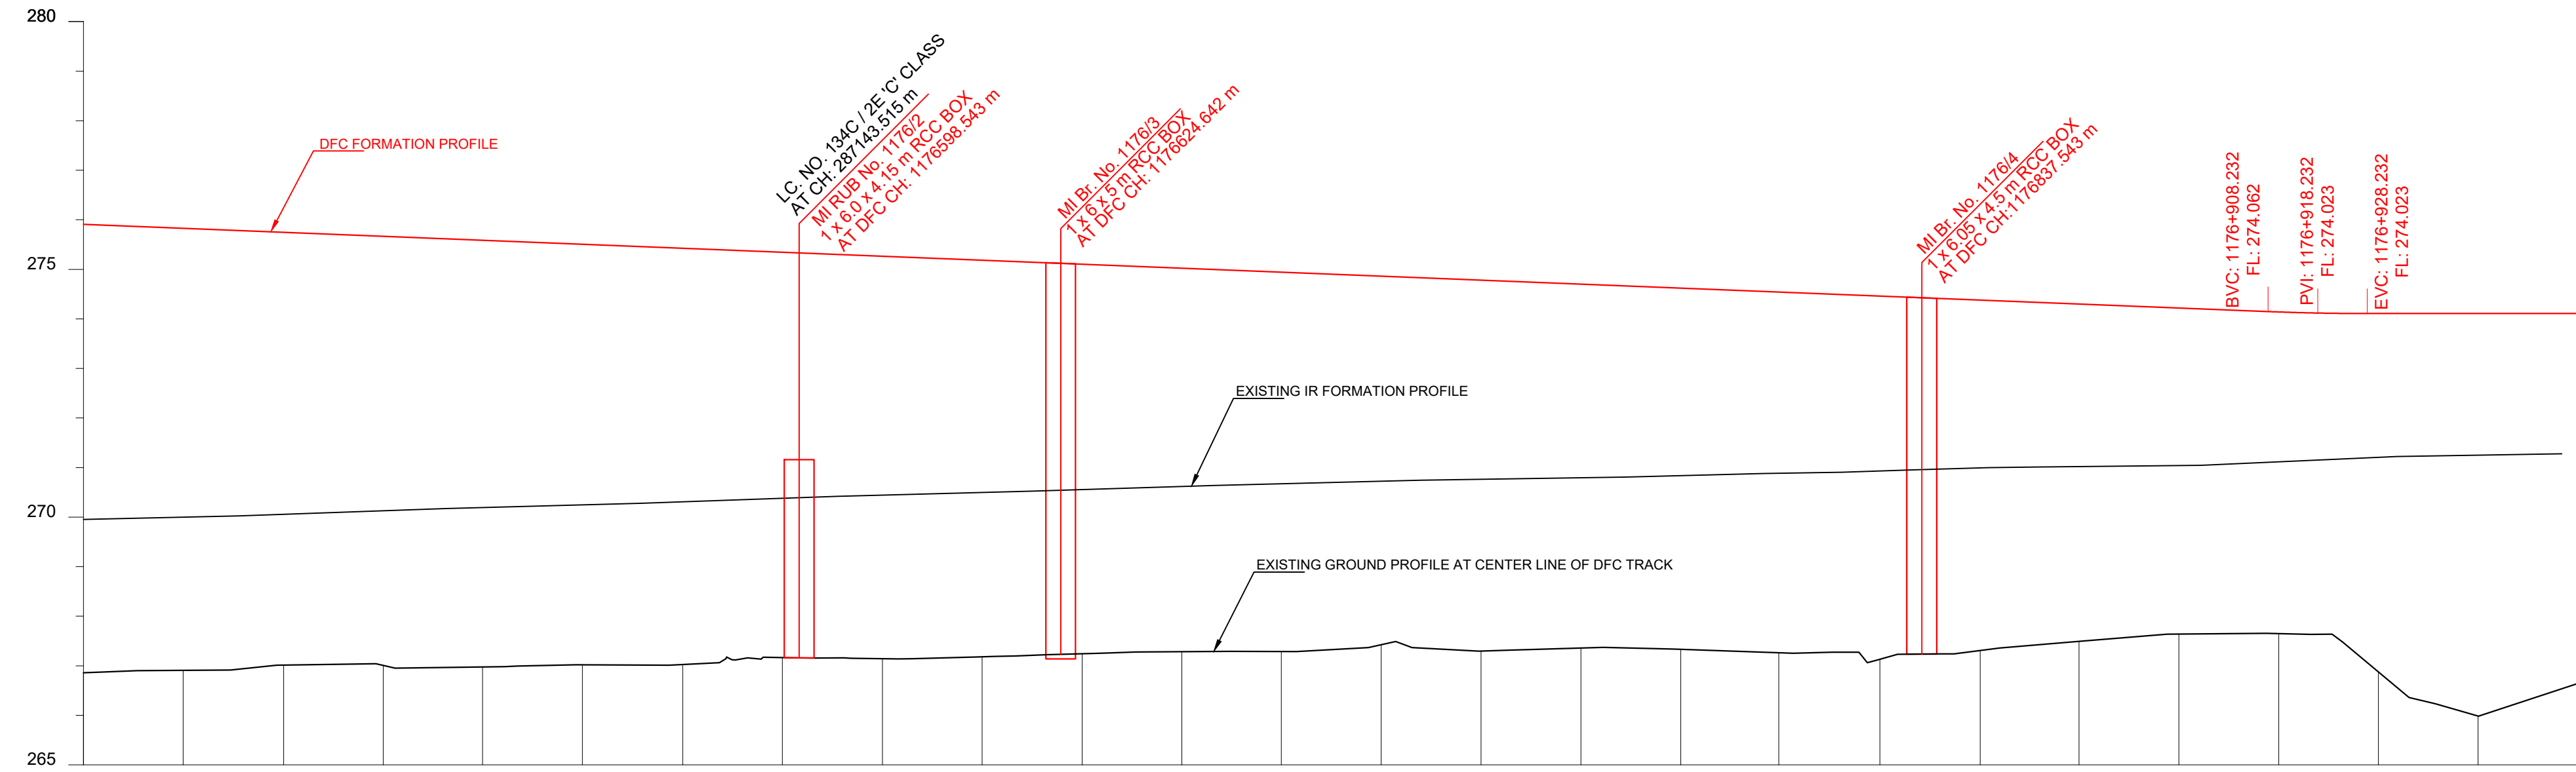


HORIZONTAL ALIGNMENT	TL= 80m										L= 784.179m										L=20.0 m P=500m										L=276.240 m LEVEL																			
VERTICAL ALIGNMENT	L=729.210 m 1 IN 253.454 F																																																	
TRACK DISTANCE FROM EXISTING NEAREST IR DN MAIN LINE TO DFC MAIN LINE	-131.720																																																	
HEIGHT OF BANKING(+) / DEPTH OF CUTTING(-) (PFL-GL)	+6.052																																																	
EXG GROUND LEVEL AT CENTER LINE OF DFC TRACK (GL)	266.854																																																	
EXG GROUND LEVEL AT TOE LOCATION OF DFC TRACK	266.914																																																	
DIFFERENCE BETWEEN DFC FORMATION LEVEL AND EXG FORMATION LEVEL (PFL-EFL)	-5.443																																																	
DFC FORMATION LEVEL (PFL)	-275.804																																																	
EXG FORMATION LEVEL OF EXG IR DN MAIN LINE (EFL)	-268.861																																																	
DIFFERENCE BETWEEN DFC RAIL LEVEL AND EXG. RAIL LEVEL (PRL - ERL)	-5.884																																																	
DFC RAIL LEVEL (PRL)	-276.517																																																	
EXG RAIL LEVEL OF NEAREST IR DN MAIN LINE (ERL)	-270.533																																																	
EQUIVALENT CHAINAGE ON DFC TRACK	1176468.9																																																	
EXISTING IR CHAINAGE	287000.0																																																	

L - SECTION



L - SECTION

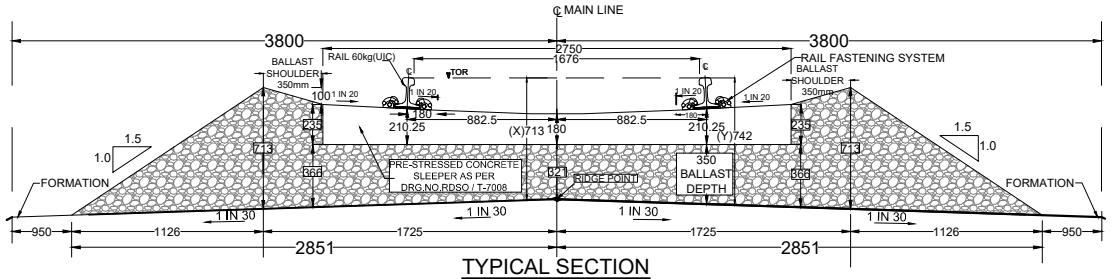

OWNER



 **DEDICATED FREIGHT CORRIDOR CORPORATION OF INDIA LTD.**
(A GOVERNMENT OF INDIA ENTERPRISE)
PROJECT OFFICE/AMBALA UNIT: OLD RAILWAY COLONY (NEAR
ANAND MARKET), AMBALA CANTT-133001.
CORPORATE IDENTITY NO. : U60232DL2006GOI155068

CONTRACTOR: GIL - TPL JV

STAMP	

AS BUILT DRAWING	
TITLE AS-BUILT PLAN AND PROFILE FROM IR KM: 287.500 TO 288.000 DFC KM: 1176.970 TO 1177.473	DFCC APPR. NO. - ENGG. APPR. NO. - DRG. NO. - 301-2/AL/A/1201 SHEET NO. : 1 OF 1 DATE : 27.08.2024
	STATUS A

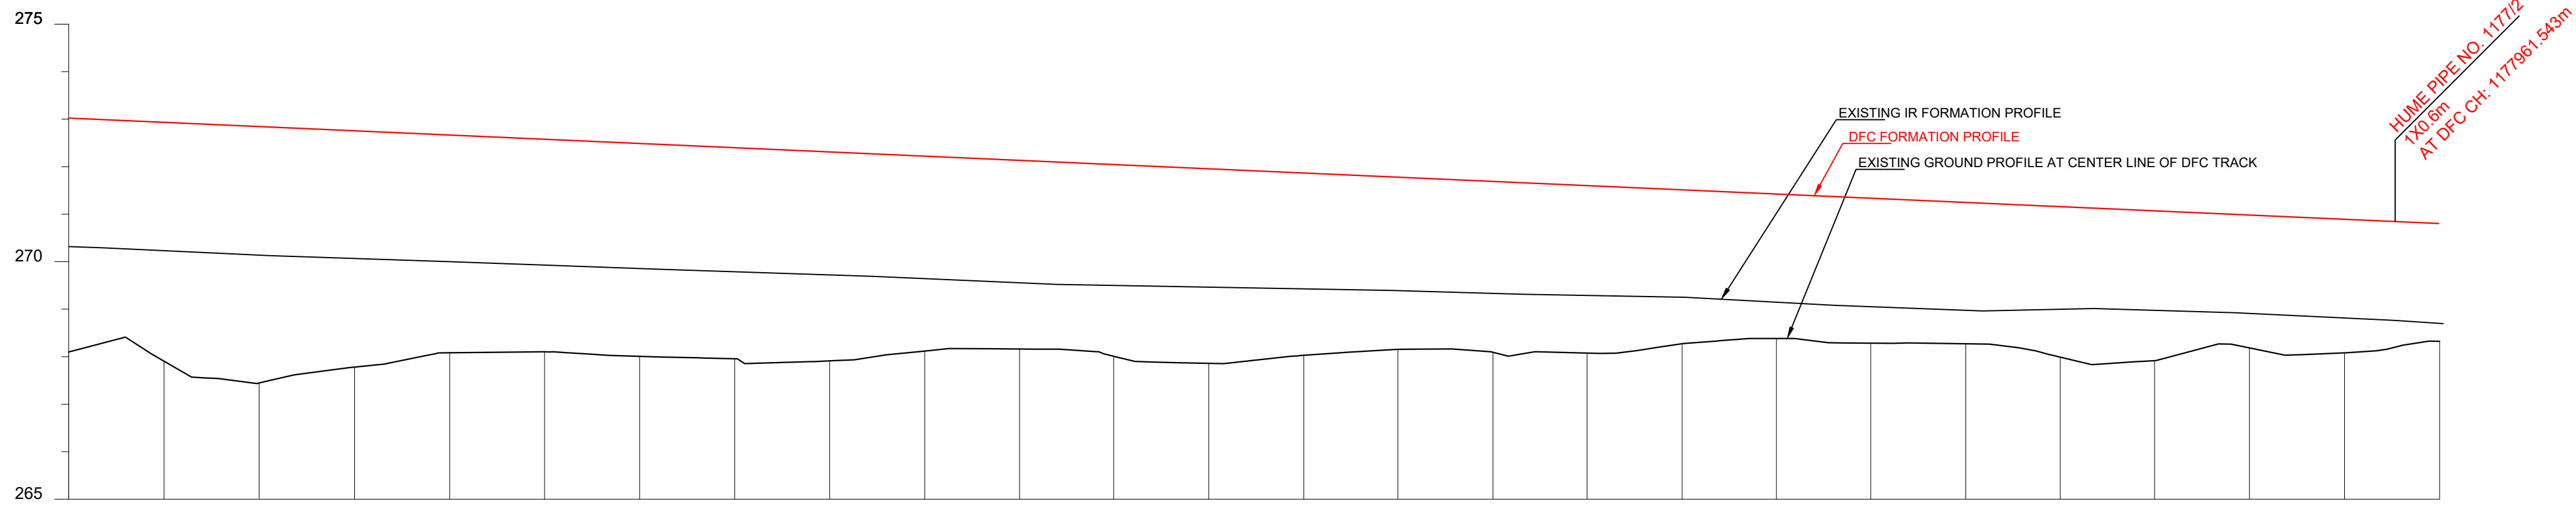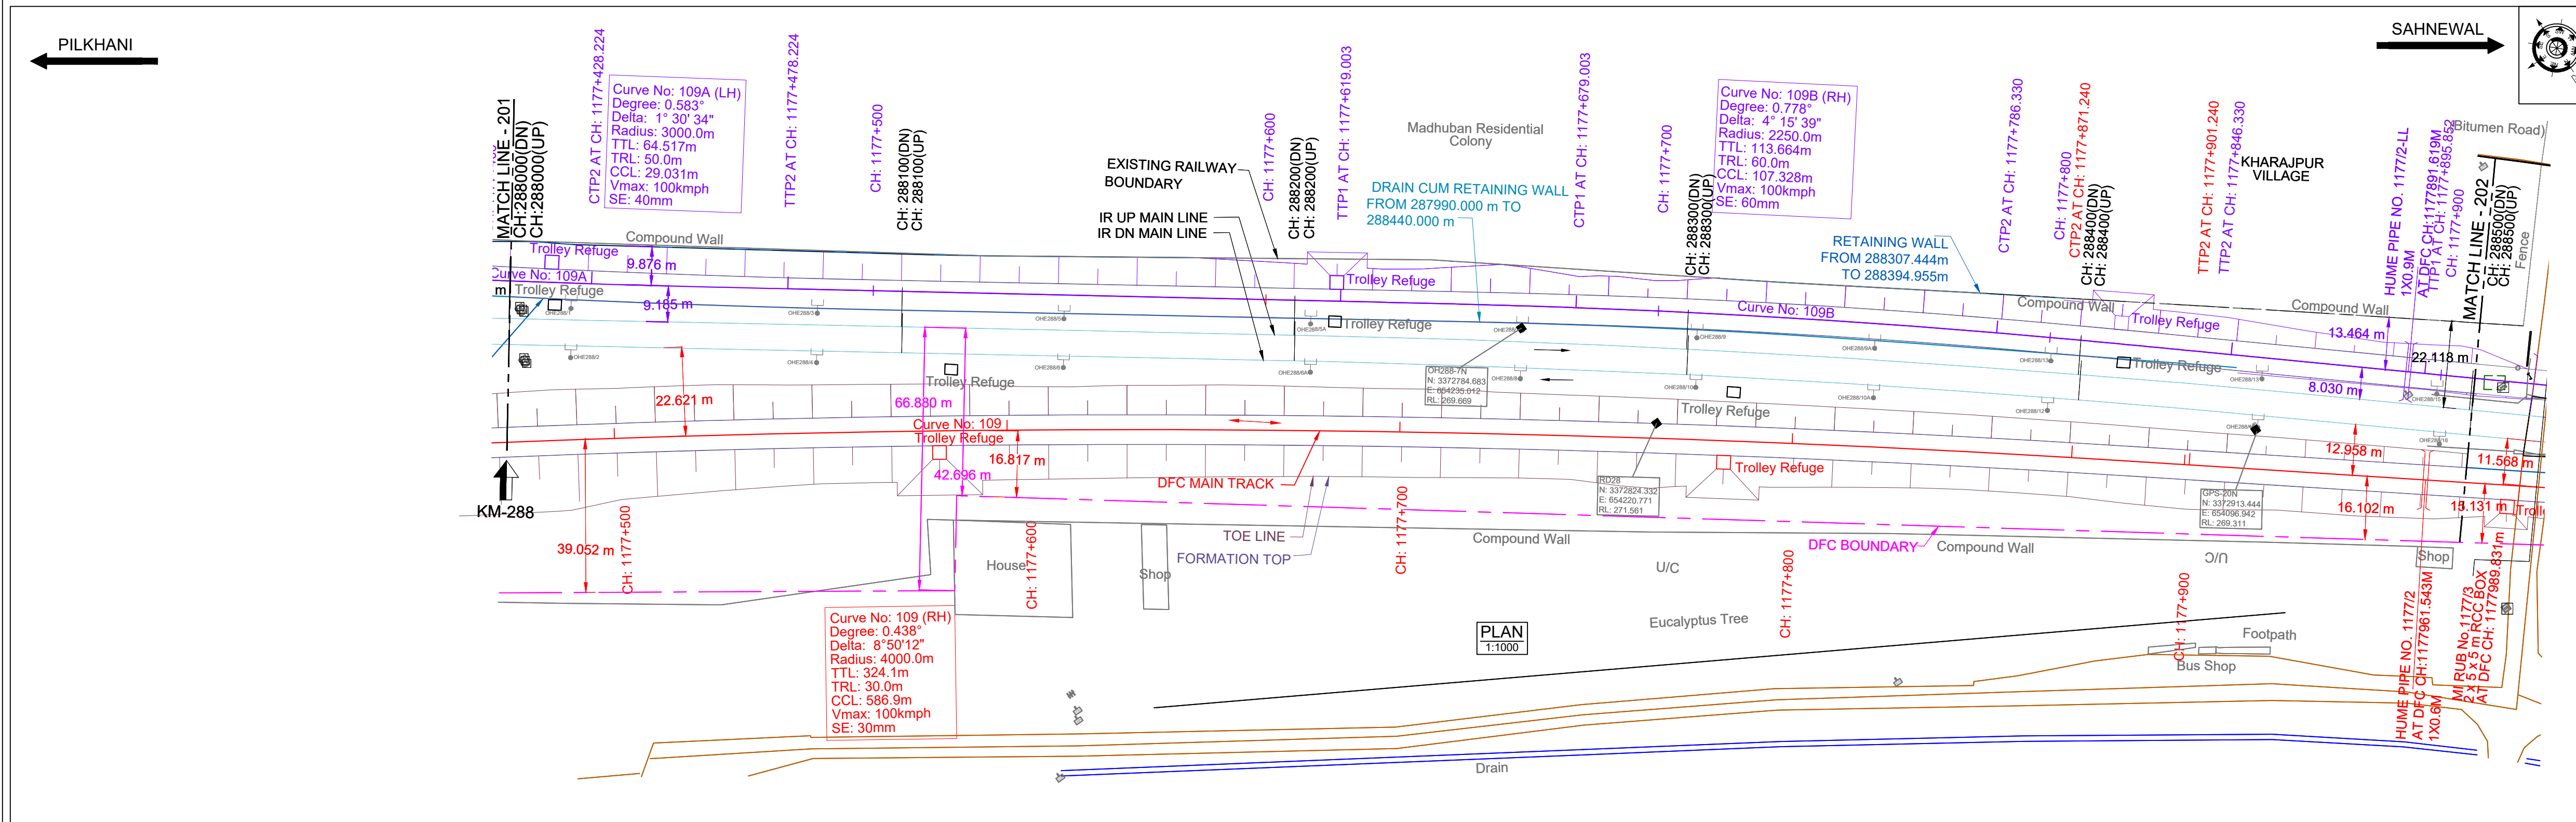

DATUM ABOVE MSL : 265 m

HORIZONTAL ALIGNMENT	R =4000m																								TL= 30m		L = 153.720m																																																																																																																																																																																																																																																																																																																																																																																																																																																																																																																																																																																																																																																																																																																																
VERTICAL ALIGNMENT	L=1317.982 m 1 IN 227.047 F																																																																																																																																																																																																																																																																																																																																																																																																																																																																																																																																																																																																																																																																																																																																																										
TRACK DISTANCE FROM EXISTING NEAREST IR DN MAIN LINE TO DFC MAIN LINE	24.881	24.923	23.702	22.610	21.649	20.795	20.028	19.361	18.801	18.344	17.983	17.719	17.400	17.071	16.698	16.228	15.844	15.462	15.107	14.750	14.367	13.962	13.286	12.692	12.103																																																																																																																																																																																																																																																																																																																																																																																																																																																																																																																																																																																																																																																																																																																																		
HEIGHT OF BANKING(+) / DEPTH OF CUTTING(-) (PFL-GL)		+4.923	+5.025	+5.399	+4.976	+4.595	+4.476	+4.482	+4.445	+4.400	+4.105	+3.973	+4.034	+4.097	+3.838	+3.627	+3.242	+3.044	+3.054	+2.977	+3.165	+3.157	+2.797	+2.817	+2.480																																																																																																																																																																																																																																																																																																																																																																																																																																																																																																																																																																																																																																																																																																																																		
EXG GROUND LEVEL AT CENTER LINE OF DFC TRACK (GL)		268.373	267.962	268.169	267.772	268.072	267.310	268.052	267.645	268.207	267.947	268.200	267.968	268.324	267.874	268.556	267.823	268.297	267.971	268.305	267.951	268.317	266.147	268.318	268.258	268.325	268.161	268.325	268.161	268.325	268.1

L - SECTION

NOTE:-
1. DFC WORKS ARE SHOWN IN RED.
2. IR NEW WORKS ARE SHOWN IN VIOLET.
3. ALL DIMENSIONS ARE SHOWN IN METRES.
4. THIS DRAWING IS PREPARED BASED ON LATEST SURVEY DATA HELD ON APRIL-2022. GTS BENCH MARK OF 261.85M CONSIDERED ON TOP OF CANAL BRIDGE ABUTMENT AT DORANA VILLAGE ALONG THE NH1.
5. DFC NEW CHAINAGE OF 1075.95M IS WITH REFERENCE TO THE IR KM OF 187.50KM END OF KM OF CP-303(SECTION P-3 PILKHANI END) AGAINST THE EXISTING DFC CHAINAGE. 116277.742M ISSUED VIDE LETTER NO. COM/DFCC/COMB/SURVEY/2021-301-2301/16-011173.DT. 17.01.2023.
6. BALLAST PROFILE HAS BEEN PROVIDED ACCORDING TO THE CLAUSE 1.11.3 OF STANDARD SCHEDULE OF DIMENSION(EASTERN CORRIDOR) & THE BALLAST CUSHION DIMENSION SHOWN IN 35CM ON GE-14 PARA 17. SPECIFICATIONS & RECOMMENDATIONS 2. TWO LAYER SYSTEM FIG.10.


REFERENCE DRAWINGS :-
1. FOR KEY PLAN REFER DRAWING NO. 301-2/AL/0001
2. FOR LEGEND AND ABBREVIATIONS REFER DRAWING NO. 301-2/AL/1000
3. FOR TYPICAL SECTION OF BALLAST PROFILE (FL-RL) REFER DRG. NO. 301-2/TK/TFD/004 (TR.1952)

027.08.2024SUBMISSION OF AS-BUILT DRAWINGFOR APPROVAL

REV. DATE REVISION DETAILS PURPOSE OF ISSUE

SCALE
HOR - 1:1000
VER - 1:100
SHEET SIZE : A1

LEGEND:
IR TRACK
DFCC TRACK
LINK LINE (SMUN-RP-J)
DFCC FUTURE PROPOSALS
STRUCTURE / BUILDING
DFCC TOE LINE
DFCC FORMATION
RETAINING WALL
ROAD
STREAM, DRAIN, NALA, CANAL.
FENCE
POWER LINES
TBM
ELECTRIC POLE/OHE MAST
IR RAILWAY BOUNDARY
DFCC BOUNDARY

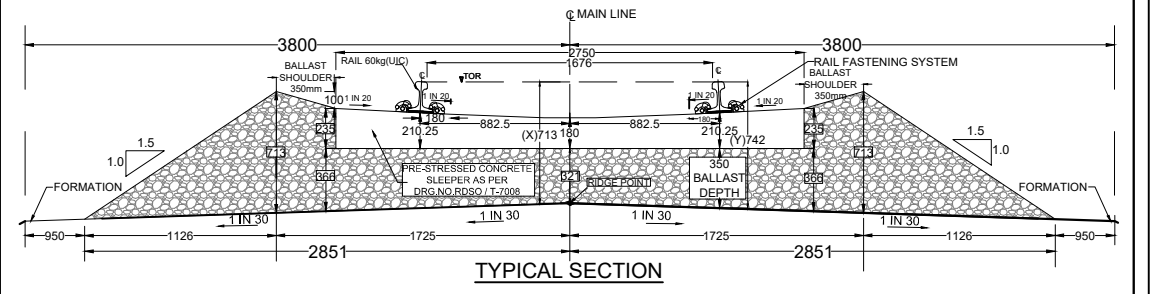

TRACK STRUCTURE		
RAIL SECTION: 60Kg/m (UIC 60Kg/m) DFC LINE: 60Kg/m (UIC 60Kg/m) IR MAIN LINE: 52Kg/m	Difference between FL- RL (Below Rail Seat)	
	IR Line	DFC
RUBBER PAD	172mm	172mm
SLEEPER DEPTH	6mm	10mm
BALLAST CUSHION	210mm	210mm
	300mm	350mm
Total Depth (FL TO RL)	688mm	742mm

OWNER
DEDICATED FREIGHT CORRIDOR CORPORATION OF INDIA LTD.
(A GOVERNMENT OF INDIA ENTERPRISE)
PROJECT OFFICE (AMBALA UNIT): OLD RAILWAY COLONY (NEAR ANAND MARKET), AMBALA CANTT-133001.
CORPORATE IDENTITY NO. : U60232DL20060G0155068

ENGINEER:
DB Engineering & Consulting GmbH
Deutsche Bahn Engineering & Consulting GmbH

CONTRACTOR:
GIL - TPL JV
GAR TATA

SUBMITTED BY GIL - TPL JV			
	DATED	NAME	SIGNATURE
PREPARED BY			
CHECKED BY	27.08.2024	VIJAY PRATAP	
APPROVED BY	27.08.2024	PARASURAM KOTYADA	
APPROVED BY DEUTSCHE BAHN ENGINEERING & CONSULTING GMBH			
	DATED	NAME	SIGNATURE
Sr. DE./CHIEF ENGINEER		SURESH K.YALANGI	
CHIEF TRACK ENGINEER		RAJ PAL SINGH	
T.L.		H.D. VIDJAK	

STAMP
A AS-BUILT DRAWING
TR. Ref.....
ENGINEER Sign.:

EMPLOYER (DFCCIL): DEDICATED FREIGHT CORRIDOR CORPORATION OF INDIA LTD.

AS BUILT DRAWING			
TITLE AS-BUILT PLAN AND PROFILE		DFCC APPR. NO. - ENGG. APPR. NO. -	
FROM IR KM: 288.000 TO 288.500 DFC KM: 1177.473 TO 1177.972		DRG. NO. - 301-2/AL/A/1202 SHEET NO. : 1 OF 1 DATE : 27.08.2024	
		STATUS A	

TR.



L - SECTION

A schematic diagram of a cyclotron. It shows two semi-circular electrodes (dees) with a central gap. A particle path is shown spiraling out from the center, alternating between the two dees. A north arrow is located at the bottom right of the diagram.


- NOTE:-
1. DFCW WORKS ARE SHOWN IN RED.
2. IR NEW WORKS ARE SHOWN IN VIOLET.
3. ALL DIMENSIONS ARE GIVEN IN METRES.
4. THIS DRAWING IS PREPARED BASED ON LATEST SURVEY DATA HELD ON APRIL-2022. GTS BENCH MARK OF 261.850M CONSIDERED ON TOP OF CANAL BRIDGE ABUTMENT AT DORAHA VILLAGE ALONG THE NH.
5. DESIGN OF NEW CHANNEL OF 1075.950M IS WITH REFERENCE TO THE IR KM OF 187.500M END OF KM OF CP-303(SECTION 3-PILKHAANI END) AGAINST THE EXISTING DFCW CHANNEL. 116277.74M ISSUED VIDEO LETTER NO. CGM/DFCWM/BS/IR/SURVEY/2021-301-23011611173 DT. 17.01.2023.
6. BALLAST PROFILE HAS BEEN PROVIDED ACCORDING TO THE CLAUSE 11.3 OF STANDARD SCHEDULE OF MATERIALS AND SPECIFICATIONS 2. TWO LAYER SYSTEM FIG.10.
7. BALLAST SPECIFICATIONS & RECOMMENDATIONS 2. TWO LAYER SYSTEM FIG.10.
- DRG NO. - 301-2/AL/A/1203

REFERENCE DRAWINGS :-

1. FOR KEY PLAN REFER DRAWING NO. 301-2/AL/0001
2. FOR LEGEND AND ABBREVIATIONS REFER DRAWING NO. 301-2/AL1000
3. FOR TYPICAL SECTION OF BALLAST PROFILE (FL-RL) REFFER DRG. NO. 301-2/TK/TFD/-004 (TR.1952)


LEGEND:

SCALE

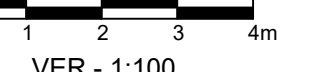

VER = 1.100

SHEET SIZE : A1

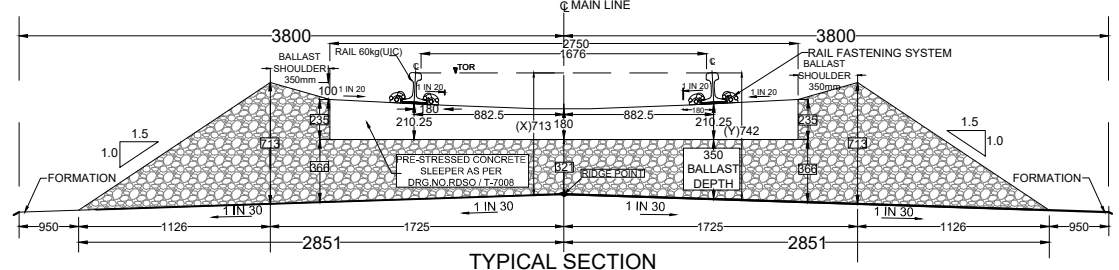

TRACK STRUCTURE		
RAIL SECTION: 60Kg/m (UIC 60Kg/m) DFC LINE: 60Kg/m (UIC 60Kg/m) IR MAIN LINE: 52Kg/m	Difference between FL- RL (Below Rail Seat)	
	IR Line	DFC
	172mm	172mm
RUBBER PAD	6mm	10mm
SLEEPER DEPTH	210mm	210mm
BALLAST CUSHION	300mm	350mm
Total Depth (FL TO RL)	688mm	742mm

OWNER

DEDICATED FREIGHT CORRIDOR CORPORATION OF INDIA LTD.

DEDICATED FREIGHT CORRIDOR CORPORATION
(A GOVERNMENT OF INDIA ENTERPRISE)

PROJECT OFFICE(AMBALA UNIT): OLD RAILWAY COLONY
ANAND MARKET),AMBALA CANTT-133001.
CORPORATE IDENTITY NO. : U60232DL2006GOI1550

ENGINEER

DB Engineering & Consulting GmbH
Deutsche Bahn Engineering &

CONTRACTOR

GIL - TPL JV



SUBMITTED BY	GIL - TPL JV		
	DATED	NAME	SIGNATURE
PREPARED BY			
CHECKED BY	27.08.2024	VIJAY PRATAP	
APPROVED BY	27.08.2024	PARASURAM KOTYADA	
APPROVED BY	DEUTSCHE BAHN ENGINEERING & CONSULTING GMBH		
	DATED	NAME	SIGNATURE
Sr. DE./CHIEF ENGINEER		SURESH K.YALANGI	
CHIEF TRACK ENGINEER		RAJ PAL SINGH	
T.L.		H.D. VIDJAK	

STAMP

A AS-BUILT DRAWING
TR. Ref.....
ENGINEER Sign.:

EMPLOYER (DFCCIL):

DEDICATED FREIGHT CORRIDOR CORPORATION OF INDIA LTD

AS BUILT DRAWING

TITLE

AS-BUILT PLAN AND PROFILE

FROM IR KM: 288 500 TO 289 000

DFC KM: 1177.972 TO 1178.473

DECC APPR NO. -



ENGG. APPR. NO. -

DRG. NO. - 301-2/

SHEET NO.: 1 OF 1

STATUS

TR

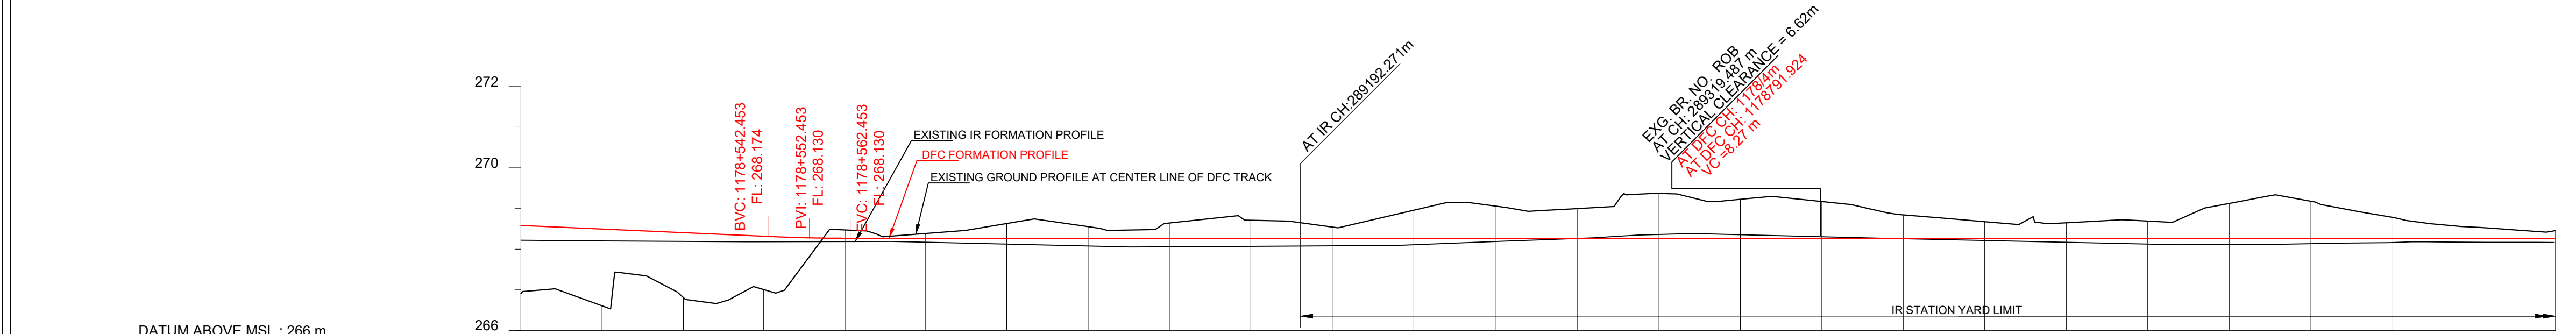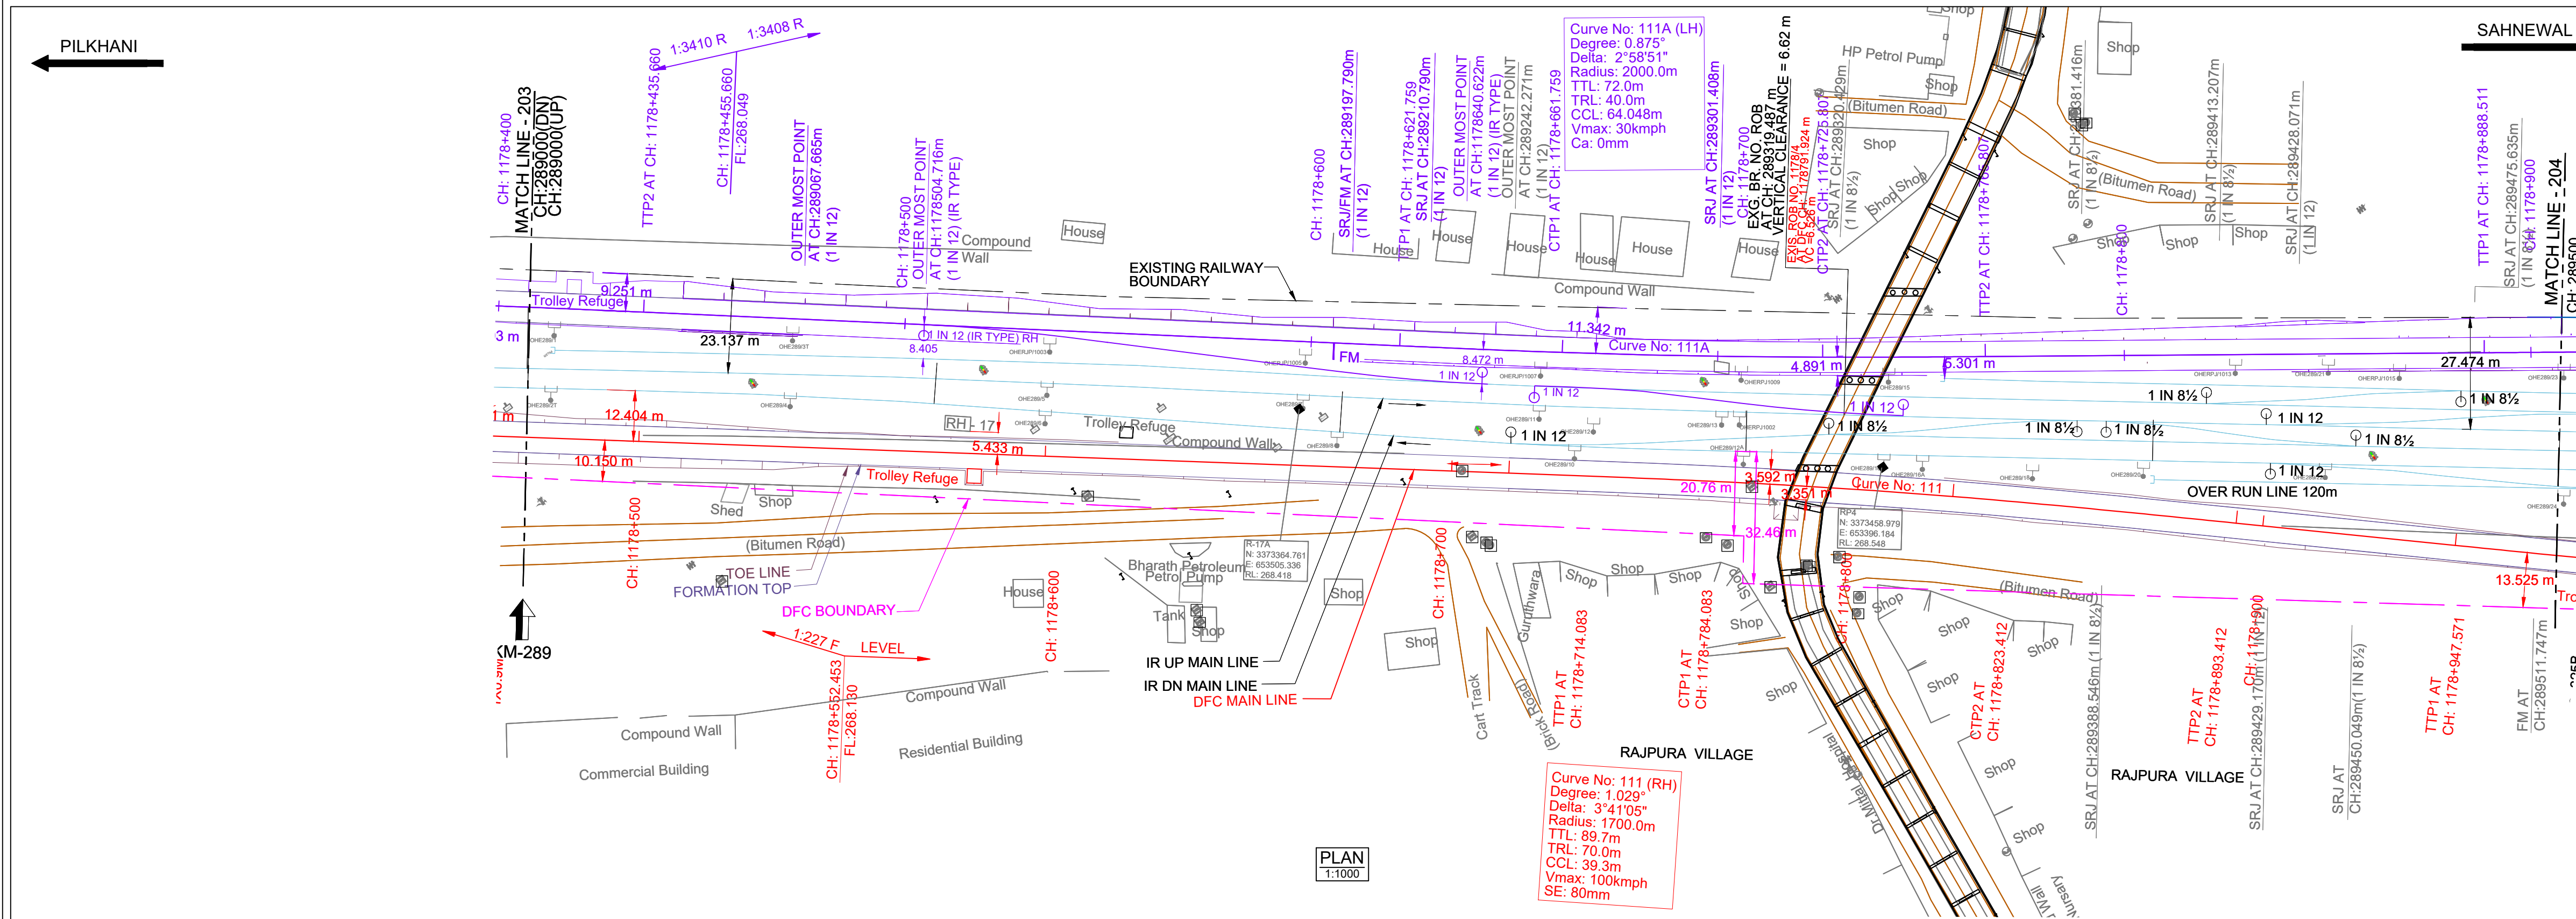

DATUM ABOVE MSL : 266 m

HORIZONTAL ALIGNMENT	L = 524.825m																				TL= 70m
VERTICAL ALIGNMENT	L=1317.982 m 1 IN 227.047 F																				L=1572.113 m LEVEL
TRACK DISTANCE FROM EXISTING NEAREST IR DN MAIN LINE TO DFC MAIN LINE	12.154	12.154	HEIGHT OF BANKING(+) / DEPTH OF CUTTING(-) (PFL-GL)	+1.674	+1.886	+1.595	+1.310	-0.206	-0.117	-0.363	-0.287	-0.377	-0.443	-0.278	-0.692	-0.792	-0.731	-1.105	-0.957	-0.903	-0.576	-0.409	-0.382	-0.187
EXG GROUND LEVEL AT CENTER LINE OF DFC TRACK (GL)	266.808	266.508	266.711	266.908	268.337	268.247	268.493	268.417	268.507	268.573	268.408	268.622	268.922	268.987	269.235	269.087	269.033	268.706	268.539	269.041	268.317
EXG GROUND LEVEL AT TOE LOCATION OF DFC TRACK	267.442	267.570	267.528	267.807	268.310	268.165	268.403	268.428	268.389	268.497	268.521	268.765	268.974	268.987	269.117	269.096	269.155	268.732	268.536	269.070	268.288
DIFFERENCE BETWEEN DFC FORMATION LEVEL AND EXG.FORMATION LEVEL (PFL-EFL)	0.347	0.277	0.198	0.118	0.064	0.082	0.127	0.173	0.190	0.180	0.169	0.143	0.062	-0.012	-0.110	-0.103	-0.054	-0.006	0.039	0.083	0.088
DFC FORMATION LEVEL (PFL)	268.482	268.394	268.306	268.219	268.131	268.130	268.130	268.130	268.130	268.130	268.130	268.130	268.130	268.130	268.130	268.130	268.130	268.130	268.130	268.130	268.130
EXG. FORMATION LEVEL OF EXG IR DN MAIN LINE (EFL)	268.135	268.117	268.108	268.101	268.067	268.048	268.003	267.957	267.940	267.95	267.961	267.987	268.068	268.142	268.240	268.233	268.164	268.136	268.091	268.013	268.042
DIFFERENCE BETWEEN DFC RAIL LEVEL AND EXG. RAIL LEVEL (PRL - ERL)	0.388	0.318	0.239	0.159	0.105	0.123	0.168	0.214	0.231	0.221	0.210	0.184	0.103	0.029	-0.069	-0.062	-0.013	-0.035	-0.030	0.124	0.129
DFC RAIL LEVEL (PRL)	269.195	269.107	269.019	268.932	268.844	268.843	268.843	268.843	268.843	268.843	268.843	268.843	268.843	268.843	268.843	268.843	268.843	268.843	268.843	268.843	268.843
EXG.RAIL LEVEL OF NEAREST IR DN MAIN LINE(ERL)	268.807	268.789	268.780	268.773	268.739	268.720	268.675	268.629	268.612	268.622	268.633	268.659	268.740	268.814	268.912	268.905	268.856	268.808	268.763	268.719	268.714
EQUIVALENT CHAINAGE ON DFC TRACK	289000.0	289020.0	289040.0	289060.0	289080.0	289100.0	289120.0	289140.0	289160.0	289180.0	289200.0	289220.0	289240.0	289260.0	289280.0	289300.0	289320.0	289340.0	289360.0	289380.0	289400.0
EXISTING IR CHAINAGE	289000.0	289020.0	289040.0	289060.0	289080.0	289100.0	289120.0	289140.0	289160.0	289180.0	289200.0	289220.0	289240.0	289260.0	289280.0	289300.0	289320.0	289340.0	289360.0	289380.0	289400.0

L - SECTION

NOTE:-

- DFCC WORKS ARE SHOWN IN RED.
- IR NEW WORKS ARE SHOWN IN VIOLET.
- ALL DIMENSIONS ARE SHOWN IN METRES.
- THIS DRAWING IS PREPARED BASED ON LATEST SURVEY DATA HELD ON APRIL-2022. GTS BENCH MARK OF 261.850M CONSIDERED ON TOP OF CANAL BRIDGE ABUTMENT AT DORANA VILLAGE ALONG THE NH1.
- DFC NEW CHAINAGE OF 1075.950M IS WITH REFERENCE TO THE IR KM OF 187.500KM END OF KM OF CP-303(SECTION P-3 PILKHANI END) AGAINST THE EXISTING DFC CHAINAGE. 116277.742M ISSUED VIDE LETTER NO. COM/DFCC/MB/SURVEY/2021-301-280116-01173.DT. 17.01.2023
- BALLAST PROFILE HAS BEEN PROVIDED ACCORDING TO THE CLAUSE 1.11.3 OF STANDARD SCHEDULE OF DIMENSION(EASTERN CORRIDOR) & THE BALLAST CUSHION DIMENSION SHOWN IN 35CM ON GE-14 PARA 17. SPECIFICATIONS & RECOMMENDATIONS 2. TWO LAYER SYSTEM FIG.10.

REFERENCE DRAWINGS :-

- FOR KEY PLAN REFER DRAWING NO. 301-2/AL/0001
- FOR LEGEND AND ABBREVIATIONS REFER DRAWING NO. 301-2/AL/1000
- FOR TYPICAL SECTION OF BALLAST PROFILE (FL-RL) REFER DRG. NO. 301-2/TK/TFD/-004 (TR.1952)

SCALE

HOR - 1:1000

VER - 1:100

SHEET SIZE : A1

LEGEND:

IR TRACK
DFCC TRACK
LINK LINE (SMUN-RP-J)
DFCC FUTURE PROPOSALS
STRUCTURE / BUILDING
DFCC TOE LINE
DFCC FORMATION
RETAINING WALL
ROAD
STREAM, DRAIN, NALA, CANAL.
FENCE
POWER LINES
TBM
ELECTRIC POLE/OHE MAST
IR RAILWAY BOUNDARY
DFCC BOUNDARY

TYPICAL SECTION

TRACK STRUCTURE

RAIL SECTION: 60Kg/m (UIC 60Kg/m) DFC LINE: 60Kg/m (UIC 60Kg/m) IR MAIN LINE: 52Kg/m	Difference between FL- RL (Below Rail Seat)	
	IR Line	DFC
RUBBER PAD	172mm	172mm
SLEEPER DEPTH	6mm	10mm
BALLAST CUSHION	210mm	210mm
	300mm	350mm
Total Depth (FL TO RL)	688mm	742mm

OWNER

DEDICATED FREIGHT CORRIDOR CORPORATION OF INDIA LTD.

(A GOVERNMENT OF INDIA ENTERPRISE)

PROJECT OFFICE (AMBALA UNIT): OLD RAILWAY COLONY (NEAR ANAND MARKET), AMBALA CANTT-133001.

CORPORATE IDENTITY NO. : U60232DL2006GG0115068

ENGINEER:

DB Engineering & Consulting GmbH

Deutsche Bahn Engineering & Consulting GmbH

CONTRACTOR:

GIL - TPL JV

GAR TATA

SUBMITTED BY	GIL - TPL JV		
	DATED	NAME	SIGNATURE
PREPARED BY			
CHECKED BY	27.08.2024	VIJAY PRATAP	
APPROVED BY	27.08.2024	PARASURAM KOTYADA	

APPROVED BY

DEUTSCHE BAHN ENGINEERING & CONSULTING GMBH

	DATED	NAME	SIGNATURE
Sr. DE./CHIEF ENGINEER		SURESH K.YALANGI	
CHIEF TRACK ENGINEER		RAJ PAL SINGH	
T.L.		H.D. VIDJAK	

STAMP

AS-BUILT DRAWING


TR. Ref.....



ENGINEER Sign.:

EMPLOYER (DFCCIL): DEDICATED FREIGHT CORRIDOR CORPORATION OF INDIA LTD.

AS BUILT DRAWING	
TITLE	AS-BUILT PLAN AND PROFILE
DFCC APPR. NO. -	
ENGG. APPR. NO. -	
DRG. NO. - 301-2/AL/A/1204	
SHEET NO. : 1 OF 1	
DATE : 27.08.2024	
STATUS	A

TR.

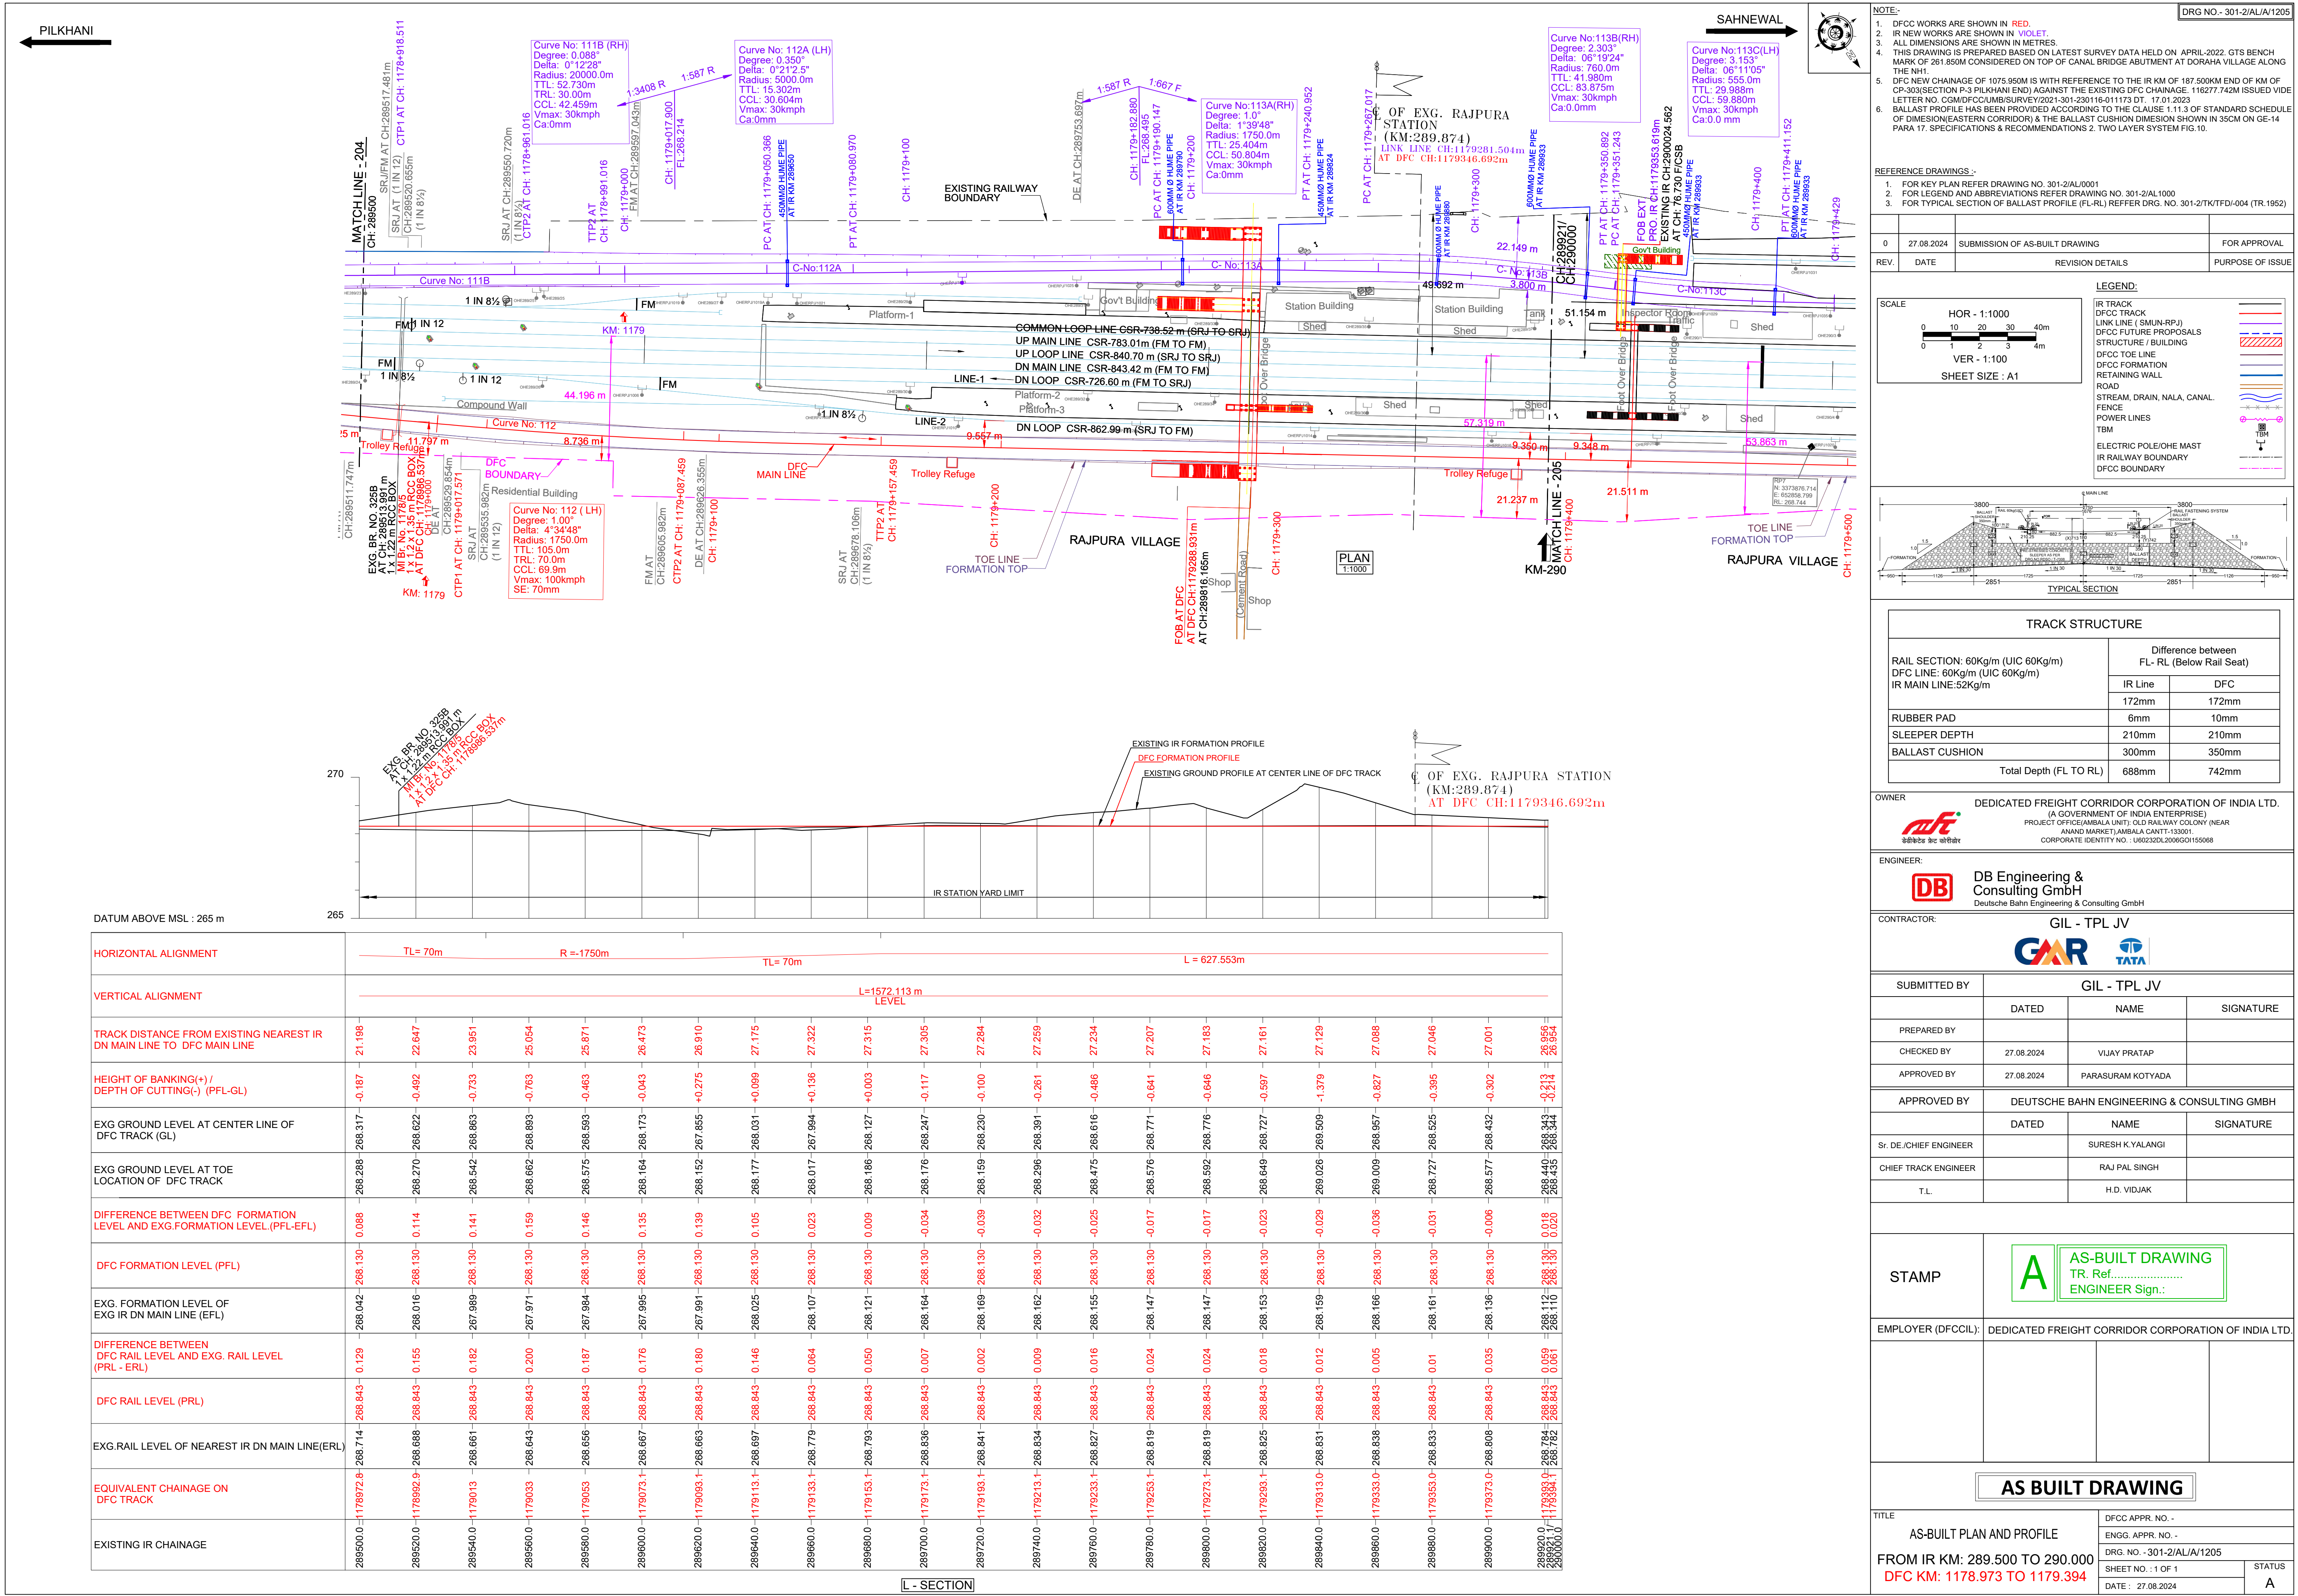

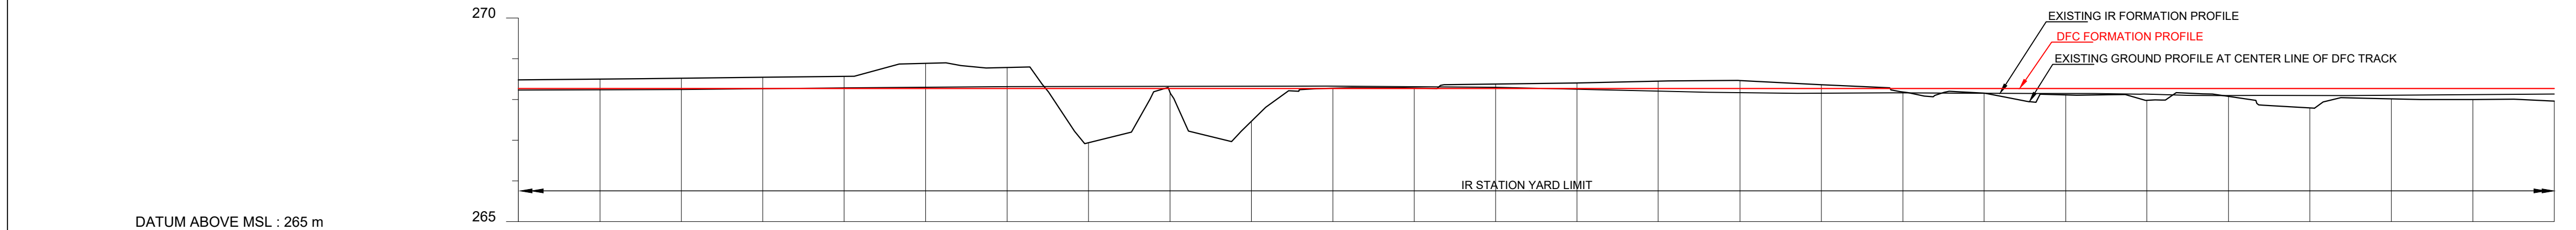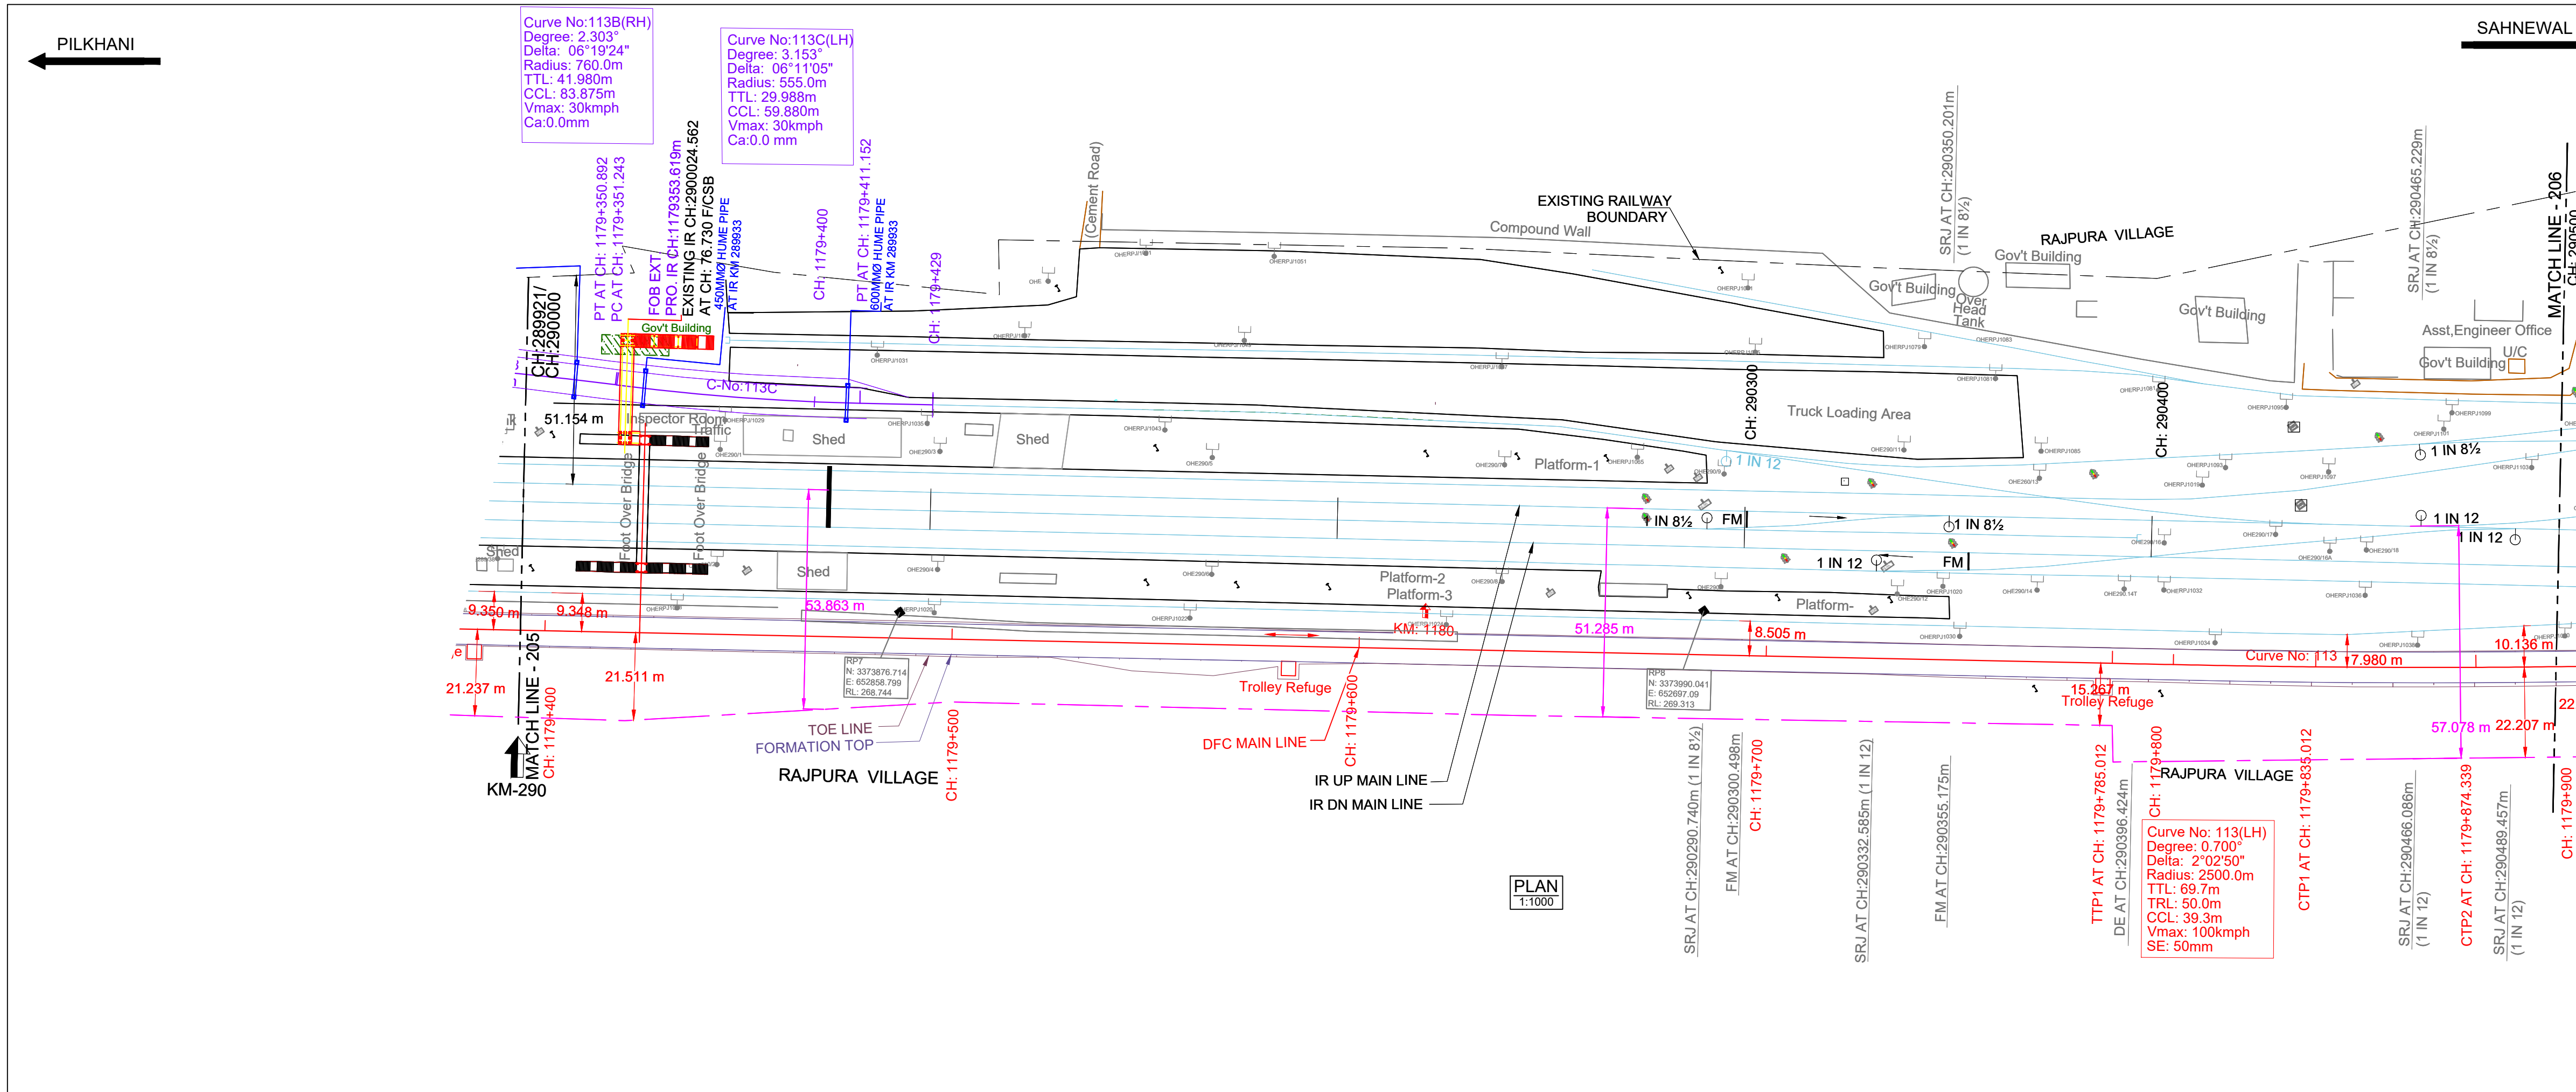

HORIZONTAL ALIGNMENT	L = 627.553m																			
VERTICAL ALIGNMENT	L=1572.113 m LEVEL																			
TRACK DISTANCE FROM EXISTING NEAREST IR DN MAIN LINE TO DFC MAIN LINE	26.954	26.954	26.939	26.925	26.885	26.845	26.814	26.783	26.754	26.724	26.695	26.665	26.637	26.609	26.556	26.549	26.477	26.446	26.424	26.401
HEIGHT OF BANKING(+) / DEPTH OF CUTTING(-) (PFL-GL)	-0.214	-0.214	-0.232	-0.253	-0.277	-0.298	-0.62	-0.517	-0.332	-0.091	-0.806	-0.009	-0.014	-0.11	-0.136	-0.184	-0.198	-0.092	-0.085	-0.111
EXG GROUND LEVEL AT CENTER LINE OF DFC TRACK (GL)	268.344	268.344	268.362	268.383	268.407	268.428	268.750	268.647	268.796	268.039	267.324	268.139	268.144	268.240	268.268	268.314	268.328	268.222	268.045	268.019
EXG GROUND LEVEL AT TOE LOCATION OF DFC TRACK	268.435	268.435	268.391	268.404	268.440	268.483	268.499	268.201	267.843	267.764	267.970	268.212	268.218	268.265	268.282	268.287	268.254	268.243	268.147	268.043
DIFFERENCE BETWEEN DFC FORMATION LEVEL AND EXG.FORMATION LEVEL (PFL-EFL)	0.020	0.020	0.013	0.006	-0.014	-0.035	-0.049	-0.063	-0.066	-0.069	-0.072	-0.074	-0.060	-0.046	0.000	0.047	0.084	0.097	0.091	0.100
DFC FORMATION LEVEL (PFL)	268.130	268.130	268.130	268.130	268.130	268.130	268.130	268.130	268.130	268.130	268.130	268.130	268.130	268.130	268.130	268.130	268.130	268.130	268.130	268.130
EXG. FORMATION LEVEL OF EXG IR DN MAIN LINE (EFL)	268.110	268.110	268.117	268.124	268.144	268.165	268.179	268.193	268.196	268.199	268.202	268.204	268.190	268.176	268.130	268.083	268.046	268.033	268.039	268.030
DIFFERENCE BETWEEN DFC RAIL LEVEL AND EXG. RAIL LEVEL (PRL - ERL)	0.061	0.061	0.054	0.047	0.027	0.006	-0.008	-0.022	-0.025	-0.028	-0.031	-0.033	-0.019	-0.005	0.041	0.088	0.125	0.138	0.132	0.141
DFC RAIL LEVEL (PRL)	268.843	268.843	268.843	268.843	268.843	268.843	268.843	268.843	268.843	268.843	268.843	268.843	268.843	268.843	268.843	268.843	268.843	268.843	268.843	268.843
EXG.RAIL LEVEL OF NEAREST IR DN MAIN LINE(ERL)	268.782	268.782	268.789	268.796	268.816	268.837	268.851	268.865	268.868	268.871	268.874	268.876	268.862	268.848	268.802	268.755	268.718	268.705	268.711	268.702
EQUIVALENT CHAINAGE ON DFC TRACK	289921.7	289921.7	289921.7	289921.7	289921.7	289921.7	289921.7	289921.7	289921.7	289921.7	289921.7	289921.7	289921.7	289921.7	289921.7	289921.7	289921.7	289921.7	289921.7	289921.7
EXISTING IR CHAINAGE	290000.0	290000.0	290000.0	290000.0	290000.0	290000.0	290000.0	290000.0	290000.0	290000.0	290000.0	290000.0	290000.0	290000.0	290000.0	290000.0	290000.0	290000.0	290000.0	290000.0

L - SECTION

SAHNEWAL



- NOTE:-
- DFCC WORKS ARE SHOWN IN RED.
 - IR NEW WORKS ARE SHOWN IN VIOLET.
 - ALL DIMENSIONS ARE SHOWN IN METRES.
 - THIS DRAWING IS PREPARED BASED ON LATEST SURVEY DATA HELD ON APRIL-2022. GTS BENCH MARK OF 261.850M CONSIDERED ON TOP OF CANAL BRIDGE ABUTMENT AT DORANA VILLAGE ALONG THE NH1.
 - DFC NEW CHAINAGE OF 1075.950M IS WITH REFERENCE TO THE IR KM OF 187.500KM END OF KM OF CP-303(SECTION P-3 PILKHANI END) AGAINST THE EXISTING DFC CHAINAGE. 116277.742M ISSUED VIDE LETTER NO. COM/DFCC/UM/SURVEY/2021-301-29016-011173 DT. 17.01.2023.
 - BALLAST PROFILE HAS BEEN PROVIDED ACCORDING TO THE CLAUSE 1.11.3 OF STANDARD SCHEDULE OF DIMENSION(EASTERN CORRIDOR) & THE BALLAST CUSHION DIMENSION SHOWN IN 35CM ON GE-14 PARA 17. SPECIFICATIONS & RECOMMENDATIONS 2. TWO LAYER SYSTEM FIG.10.

REFERENCE DRAWINGS :-

- FOR KEY PLAN REFER DRAWING NO. 301-2/AL/0001
- FOR LEGEND AND ABBREVIATIONS REFER DRAWING NO. 301-2/AL/1000
- FOR TYPICAL SECTION OF BALLAST PROFILE (FL-RL) REFER DRG. NO. 301-2/TK/TFD/004 (TR.1952)

REV.	DATE	SUBMISSION OF AS-BUILT DRAWING	FOR APPROVAL
0	27.08.2024	SUBMISSION OF AS-BUILT DRAWING	FOR APPROVAL

LEGEND:


- IR TRACK
- DFCC TRACK
- LINK LINE (SMUN-RP-J)
- DFCC FUTURE PROPOSALS
- STRUCTURE / BUILDING
- DFCC TOE LINE
- DFCC FORMATION
- RETAINING WALL
- ROAD
- STREAM, DRAIN, NALA, CANAL
- FENCE
- POWER LINES
- TBM
- ELECTRIC POLE/OHE MAST
- IR RAILWAY BOUNDARY
- DFCC BOUNDARY

SCALE

HOR - 1:1000

VER - 1:100

SHEET SIZE : A1

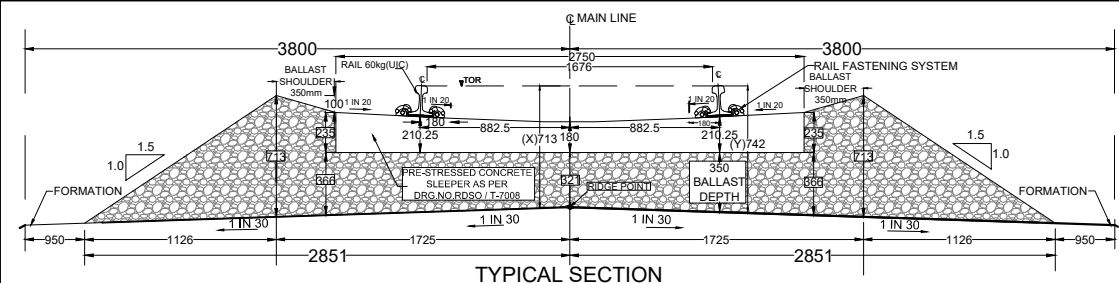

TRACK STRUCTURE		
RAIL SECTION: 60Kg/m (UIC 60Kg/m) DFC LINE: 60Kg/m (UIC 60Kg/m) IR MAIN LINE: 52Kg/m	Difference between FL- RL (Below Rail Seat)	
	IR Line	DFC
RUBBER PAD	172mm	172mm
SLEEPER DEPTH	6mm	10mm
BALLAST CUSHION	210mm	210mm
	300mm	350mm
Total Depth (FL TO RL)	688mm	742mm

OWNER: DEDICATED FREIGHT CORRIDOR CORPORATION OF INDIA LTD.
(A GOVERNMENT OF INDIA ENTERPRISE)
PROJECT OFFICE (AMBALA UNIT): OLD RAILWAY COLONY (NEAR ANAND MARKET), AMBALA CANTT-133001.
CORPORATE IDENTITY NO.: U60232DL2006001155068

ENGINEER: DB Engineering & Consulting GmbH
Deutsche Bahn Engineering & Consulting GmbH

CONTRACTOR: GIL - TPL JV
GAR TATA


SUBMITTED BY	GIL - TPL JV		
	DATED	NAME	SIGNATURE
PREPARED BY			
CHECKED BY	27.08.2024	VIJAY PRATAP	
APPROVED BY	27.08.2024	PARASURAM KOTYADA	

APPROVED BY	DEUTSCHE BAHN ENGINEERING & CONSULTING GMBH		
	DATED	NAME	SIGNATURE
Sr. DE./CHIEF ENGINEER		SURESH K.YALANGI	
CHIEF TRACK ENGINEER		RAJ PAL SINGH	
T.L.		H.D. VIDJAK	

STAMP	A AS-BUILT DRAWING TR. Ref.:..... ENGINEER Sign.:.....		
EMPLOYER (DFCCIL):	DEDICATED FREIGHT CORRIDOR CORPORATION OF INDIA LTD.		

AS BUILT DRAWING			
TITLE		DFCC APPR. NO. -	
AS-BUILT PLAN AND PROFILE		ENGG. APPR. NO. -	
FROM IR KM: 290.000 TO 290.500		DRG. NO. - 301-2/AL/A/1206	
DFC KM: 1179.394 TO 1179.894		SHEET NO. : 1 OF 1	
		DATE : 27.08.2024	
		STATUS	
		A	

TR.

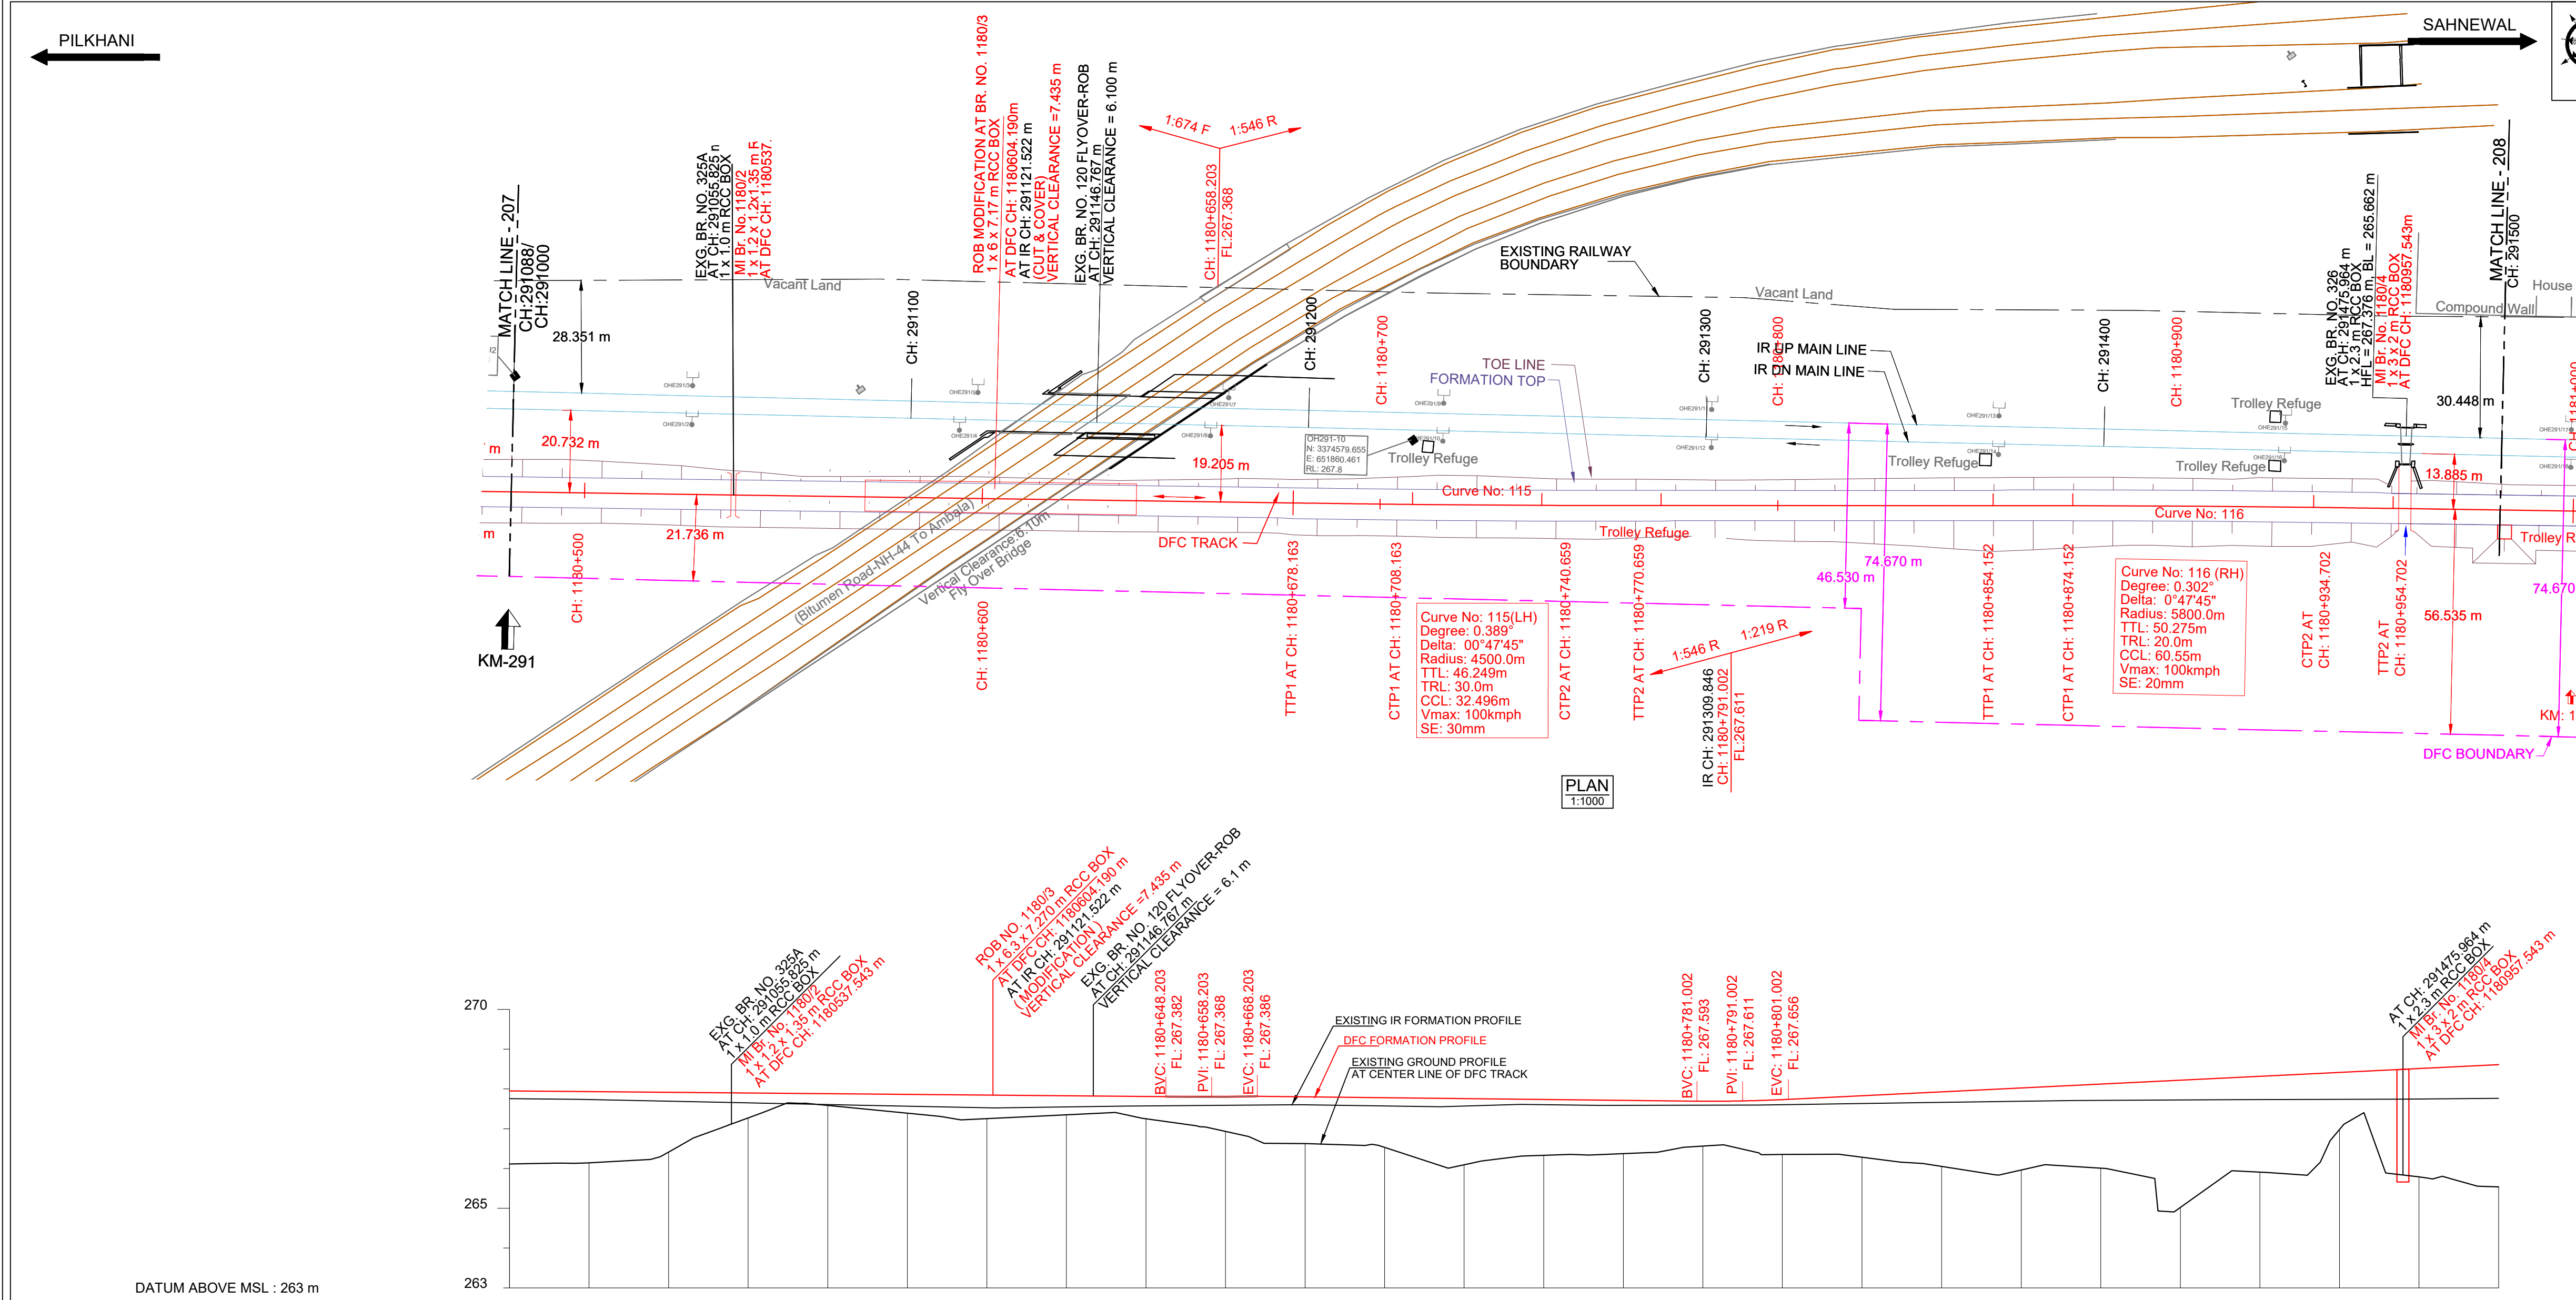

DATUM ABOVE MSL : 263 m

HORIZONTAL ALIGNMENT	L = 393.750m TL= 30m R =4500m TL= 30m L = 83.493m TL= 20m R =5800m TL= 20m L = 229.287m																			
VERTICAL ALIGNMENT	L=504.140 m 1 IN 674.292 F L=20.0 m R=6032 m L=112.799 m 1 IN 545.660 R L=20.0 m R=7344 m L=485.500 m 1 IN 219.488 R																			
TRACK DISTANCE FROM EXISTING NEAREST IR DN MAIN LINE TO DFC MAIN LINE	20.848																			
HEIGHT OF BANKING(+) / DEPTH OF CUTTING(-) (PFL-GL)	+1.609																			
EXG GROUND LEVEL AT CENTER LINE OF DFC TRACK (GL)	266.021																			
EXG GROUND LEVEL AT TOE LOCATION OF DFC TRACK	266.302																			
DIFFERENCE BETWEEN DFC FORMATION LEVEL AND EXG.FORMATION LEVEL (PFL-EFL)	-0.051																			
DFC FORMATION LEVEL (PFL)	267.630																			
EXG. FORMATION LEVEL OF EXG IR DN MAIN LINE (EFL)	267.681																			
DIFFERENCE BETWEEN DFC RAIL LEVEL AND EXG. RAIL LEVEL (PRL - ERL)	-0.010																			
DFC RAIL LEVEL (PRL)	268.343																			
EXG.RAIL LEVEL OF NEAREST IR DN MAIN LINE(ERL)	268.353																			
EQUIVALENT CHAINAGE ON DFC TRACK	291087.61																			
EXISTING IR CHAINAGE	291087.61																			

L - SECTION

NOTE:-
1. DFC WORKS ARE SHOWN IN RED.
2. IR NEW WORKS ARE SHOWN IN VIOLET.
3. ALL DIMENSIONS ARE SHOWN IN METRES.
4. THIS DRAWING IS PREPARED BASED ON LATEST SURVEY DATA HELD ON APRIL-2022. GTS BENCH MARK OF 261.850M CONSIDERED ON TOP OF CANAL BRIDGE ABUTMENT AT DORANA VILLAGE ALONG THE NH1.
5. DFC NEW CHAINAGE OF 1075.950M IS WITH REFERENCE TO THE IR KM OF 187.500KM END OF KM OF CP-303(SECTION P-3 PILKHANI END) AGAINST THE EXISTING DFC CHAINAGE. 116277.742M ISSUED VIDE LETTER NO. COM/DFCC/MB/SURVEY/2021-301-29116-011173.DT. 17.01.2023.
6. BALLAST PROFILE HAS BEEN PROVIDED ACCORDING TO THE CLAUSE 1.11.3 OF STANDARD SCHEDULE OF DIMENSION(EASTERN CORRIDOR) & THE BALLAST CUSHION DIMENSION SHOWN IN 35CM ON GE-14 PARA 17. SPECIFICATIONS & RECOMMENDATIONS 2. TWO LAYER SYSTEM FIG.10.


REFERENCE DRAWINGS :-
1. FOR KEY PLAN REFER DRAWING NO. 301-2/AL/0001
2. FOR LEGEND AND ABBREVIATIONS REFER DRAWING NO. 301-2/AL/1000
3. FOR TYPICAL SECTION OF BALLAST PROFILE (FL-RL) REFER DRG. NO. 301-2/TK/TFD/004 (TR.1952)

027.08.2024SUBMISSION OF AS-BUILT DRAWINGFOR APPROVAL

REV. DATE REVISION DETAILS PURPOSE OF ISSUE

SCALE
HOR - 1:1000
VER - 1:100
SHEET SIZE : A1

LEGEND:
IR TRACK
DFCC TRACK
LINK LINE (SMUN-RPJ)
DFCC FUTURE PROPOSALS
STRUCTURE / BUILDING
DFCC TOE LINE
DFCC FORMATION
RETAINING WALL
ROAD
STREAM, DRAIN, NALA, CANAL.
FENCE
POWER LINES
TBM
ELECTRIC POLE/OHE MAST
IR RAILWAY BOUNDARY
DFCC BOUNDARY

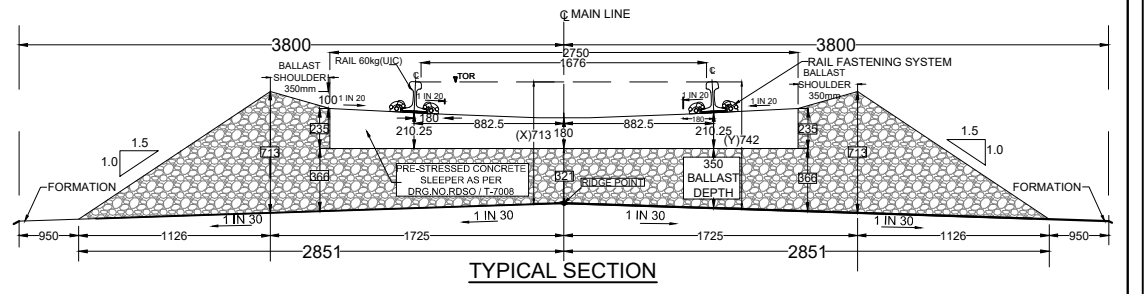

TRACK STRUCTURE		
RAIL SECTION: 60Kg/m (UIC 60Kg/m) DFC LINE: 60Kg/m (UIC 60Kg/m) IR MAIN LINE: 52Kg/m	Difference between FL- RL (Below Rail Seat)	
	IR Line	DFC
RUBBER PAD	172mm	172mm
SLEEPER DEPTH	6mm	10mm
BALLAST CUSHION	210mm	210mm
Total Depth (FL TO RL)	300mm	350mm

OWNER
DEDICATED FREIGHT CORRIDOR CORPORATION OF INDIA LTD.
(A GOVERNMENT OF INDIA ENTERPRISE)
PROJECT OFFICE(AMBALA UNIT): OLD RAILWAY COLONY (NEAR ANAND MARKET),AMBALA CANTT.-133001.
CORPORATE IDENTITY NO. : U60232DL2006GGI155068

ENGINEER:
DB Engineering & Consulting GmbH
Deutsche Bahn Engineering & Consulting GmbH

CONTRACTOR:
GIL - TPL JV
GAR TATA

SUBMITTED BY	GIL - TPL JV		
	DATED	NAME	SIGNATURE
PREPARED BY			
CHECKED BY	27.08.2024	VIJAY PRATAP	
APPROVED BY	27.08.2024	PARASURAM KOTYADA	

APPROVED BY	DEUTSCHE BAHN ENGINEERING & CONSULTING GMBH		
	DATED	NAME	SIGNATURE
Sr. DE./CHIEF ENGINEER		SURESH K.YALANGI	
CHIEF TRACK ENGINEER		RAJ PAL SINGH	
T.L.		H.D. VIDJAK	

STAMP

AAS-BUILT DRAWING
TR. Ref.:.....
ENGINEER Sign.:.....

EMPLOYER (DFCCIL): DEDICATED FREIGHT CORRIDOR CORPORATION OF INDIA LTD.


AS BUILT DRAWING

TITLE
AS-BUILT PLAN AND PROFILE
FROM IR KM: 291.000 TO 291.500
DFC KM: 1180.482 TO 1180.982

DFCC APPR. NO. -
ENGG. APPR. NO. -
DRG. NO. -301-2/AL/A/1208
SHEET NO. : 1 OF 1
DATE : 27.08.2024

STATUS
A

TR.

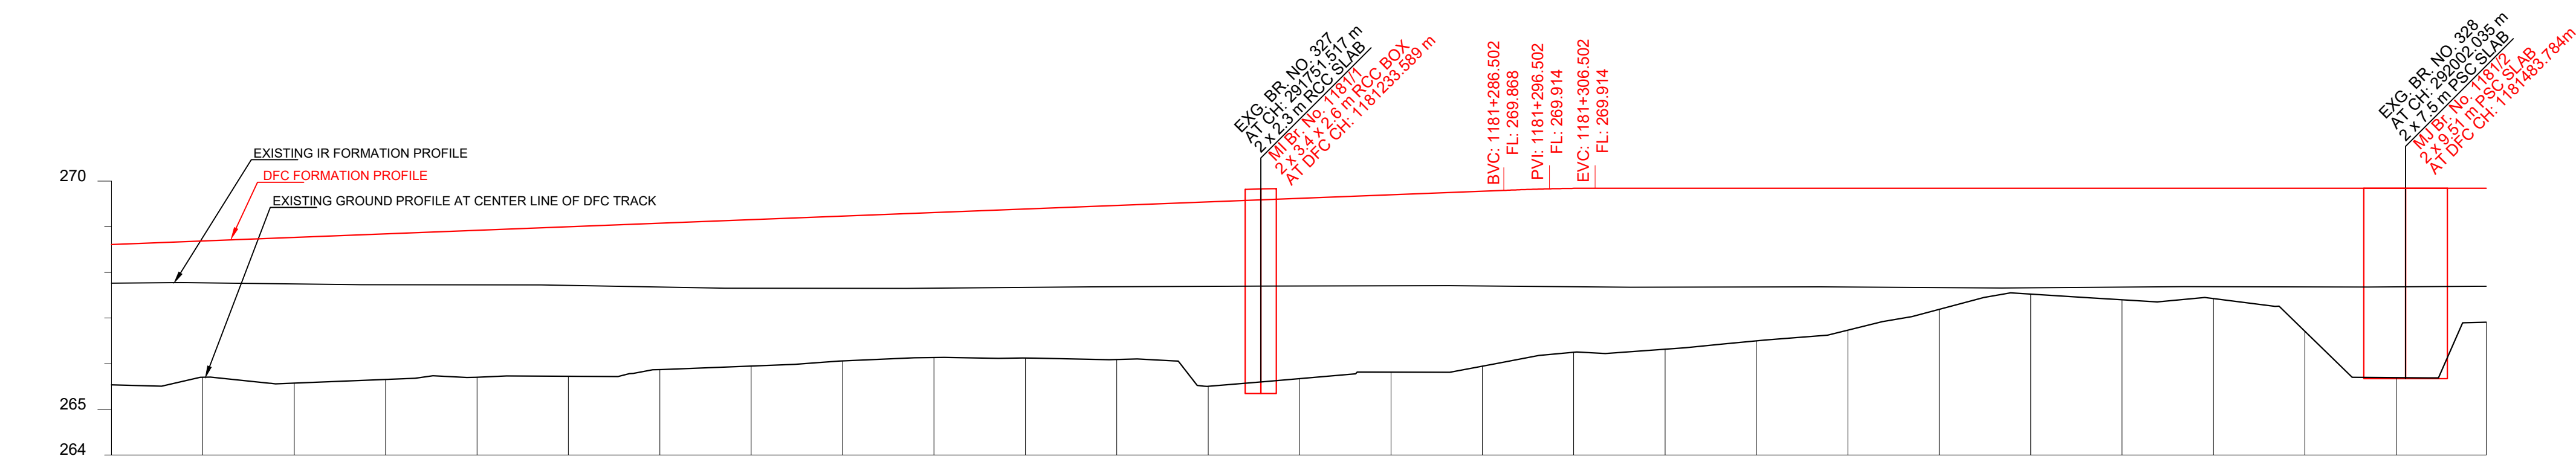

ELEVATION ABOVE MSL : 264 m		264	
HORIZONTAL ALIGNMENT			
VERTICAL ALIGNMENT			
TRACK DISTANCE FROM EXISTING NEAREST IR DN MAIN LINE TO DFC MAIN LINE	13.707	13.525	13.329
HEIGHT OF BANKING(+) / DEPTH OF CUTTING(-) (PFL-GL)	+3.073	+3.000	+3.231
EXG GROUND LEVEL AT CENTER LINE OF DFC TRACK (GL)	265.408	265.565	265.432
EXG GROUND LEVEL AT TOE LOCATION OF DFC TRACK	267.004	267.142	267.197
DIFFERENCE BETWEEN DFC FORMATION LEVEL AND EXG.FORMATION LEVEL.(PFL-EFL)	0.832	0.922	1.043
DFC FORMATION LEVEL (PFL)	268.480	268.571	268.662
EXG FORMATION LEVEL OF EXG IR DN MAIN LINE (EFL)	267.648	267.649	267.619
DIFFERENCE BETWEEN DFC RAIL LEVEL AND EXG. RAIL LEVEL (PRL - ERL)	0.873	0.963	1.084
DFC RAIL LEVEL (PRL)	269.193	269.284	269.375
EXG.RAIL LEVEL OF NEAREST IR DN MAIN LINE(ERL)	268.320	268.321	268.291
EQUIVALENT CHAINAGE ON DFC TRACK	291500.0	291520.0	291540.0
EXISTING IR CHAINAGE	291500.0	291520.0	291540.0


L - SECTION

- | | |
|--|----------------------------|
| NOTE:- | DRG NO. - 301-2/LA/LA/1209 |
| 1. DFFC WORKS ARE SHOWN IN RED. | |
| 2. IR NEW WORKS ARE SHOWN IN VIOLET. | |
| 3. ALL DIMENSIONS ARE SHOWN IN METRES. | |
| 4. THIS DRAWING IS PREPARED BASED ON LATEST SURVEY DATA HELD ON APRIL, 2022. GTS BENCH MARK OF 261.850M CONSIDERED ON TOP OF CANAL BRIDGE ABUTMENT AT DORAHA VILLAGE ALONG THE NH1. | |
| 5. DFFC NEW CATCHMENT OF 1075.950M IS WITH REFERENCE TO THE IR KM OF 167.500M END OF KM OF CP303/SECTION 3-P LUKHANI END) AGAINST THE EXISTING DFFC CATCHMENT. 116277.724D ISSUED VIDE LETTER NO. GM/CDDFC/CLM/SURVEY/2021-301-2301-1611173 DT. 17.01.2023 | |
| 6. BALLAST PROFILE HAS BEEN PROVIDED ACCORDING TO THE CLAUSE 11.13 OF STANDARD SCHEDULE OF WORKS (EASTERN CORRIDOR) & THE BALLAST CUSHION DIMENSION GIVEN IN 35CM ON GE-14 PARA 17. SPECIFICATIONS & RECOMMENDATIONS 2. TWO LAYER SYSTEM FIG.10. | |

- REFERENCE DRAWINGS :-**
1. FOR KEY PLAN REFER DRAWING NO. 301-2/AL/0001
 2. FOR LEGEND AND ABBREVIATIONS REFER DRAWING NO. 301-2/AL/1000
 3. FOR TYPICAL SECTION OF BALLAST PROFILE (FL-RL) REFFER DRG. NO. 301-2/TK/TFD/-004 (TR.1952)

0	27.08.2024	SUBMISSION OF AS-BUILT DRAWING	FOR APPROVAL
REV.	DATE	REVISION DETAILS	PURPOSE OF ISSUE

SCALE	LEGEND
HOR - 1:1000 VER - 1:100 SHEET SIZE : A1	IR TRACK DFCC TRACK LINK LINE (SMUN-RPJ) DFCC FUTURE PROPOSALS STRUCTURE / BUILDING DFCC TOE LINE DFCC FORMATION RETAINING WALL ROAD STREAM, DRAIN, NALA, CANAL. FENCE POWER LINES TBM ELECTRIC POLE/OHE MAST IR RAILWAY BOUNDARY DFCC BOUNDARY

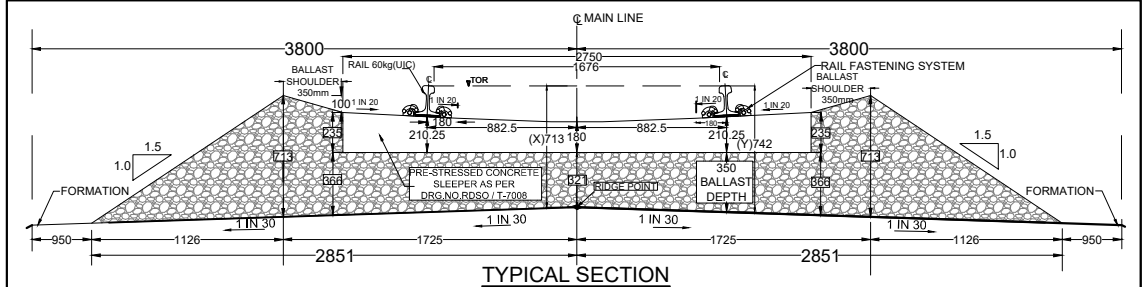

TRACK STRUCTURE		
RAIL SECTION: 60Kg/m (UIC 60Kg/m) DFC LINE: 60Kg/m (UIC 60Kg/m) IR MAIN LINE: 52Kg/m	Difference between FL- RL (Below Rail Seat)	
	IR Line	DFC
	172mm	172mm
RUBBER PAD	6mm	10mm
SLEEPER DEPTH	210mm	210mm
BALLAST CUSHION	300mm	350mm
Total Depth (FL TO RL)	688mm	742mm

OWNER



डेडीकेड फ्रेट कोरिडोर

DEDICATED FREIGHT CORRIDOR CORPORATION OF INDIA LTD.
(A GOVERNMENT OF INDIA ENTERPRISE)
PROJECT OFFICE (AMBALA UNIT): OLD RAILWAY COLONY (NEAR
ANAND MARKET), AMBALA CANTT-133001.
CORPORATE IDENTITY NO. : U60232D12006G01155068

ENGINEER:

 DB Engineering & Consulting GmbH
Deutsche Bahn Engineering & Consulting GmbH

CONTRACTOR: GIL - TPL JV

SUBMITTED BY	GIL - TPL JV		
	DATED	NAME	SIGNATURE
PREPARED BY			
CHECKED BY	27.08.2024	VIJAY PRATAP	
APPROVED BY	27.08.2024	PARASURAM KOTYADA	


APPROVED BY	DEUTSCHE BAHN ENGINEERING & CONSULTING GMBH		
	DATED	NAME	SIGNATURE
Sr. DE./CHIEF ENGINEER		SURESH K.YALANGI	
CHIEF TRACK ENGINEER		RAJ PAL SINGH	
T.L.		H.D. VIDJAK	

--

STAMP	A AS-BUILT DRAWING TR. Ref..... ENGINEER Sign.:		
EMPLOYER (DFCCIL):	DEDICATED FREIGHT CORRIDOR CORPORATION OF INDIA LTD.		


AS BUILT DRAWING			
TITLE AS-BUILT PLAN AND PROFILE FROM IR KM: 291.500 TO 292.000 DFC KM: 1180.982 TO 1181.501	DFCC APPR. NO. -		STATUS A
	ENGG. APPR. NO. -		
	DRG. NO. :301-2/AL/A/1209		
	SHEET NO. : 1 OF 1		
DATE : 27.08.2024			

TR.

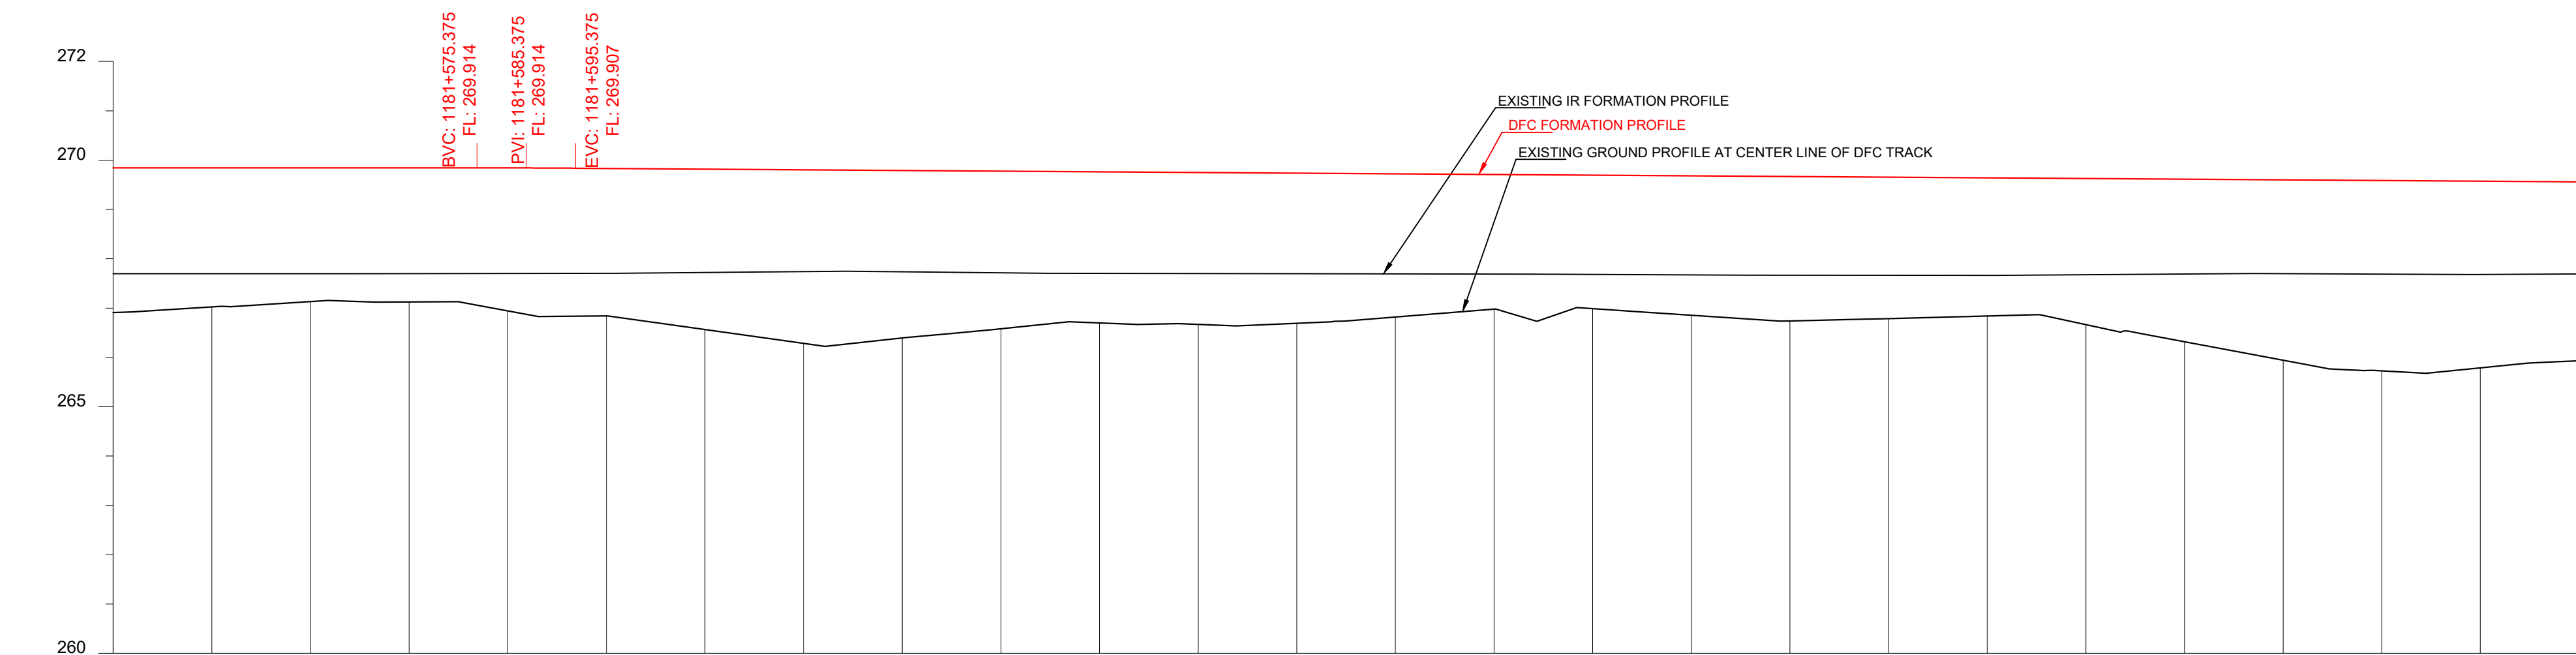

HORIZONTAL ALIGNMENT																											
VERTICAL ALIGNMENT																											
TRACK DISTANCE FROM EXISTING NEAREST IR DN MAIN LINE TO DFC MAIN LINE	11.748	11.748	11.770	11.792	11.808	11.818	11.828	11.837	11.847	11.862	11.863	11.917	11.963	12.009	12.027	12.041	12.066	12.097	12.119	12.127	12.136	12.155	12.175	12.202	12.246	12.287	12.300
HEIGHT OF BANKING(+) / DEPTH OF CUTTING(-) (PFL-GL)	+2.933	+2.933	+2.820	+2.711	+2.719	+2.899	+2.991	+3.254	+3.921	+3.397	+3.065	+3.083	+3.046	+2.906	+2.828	+2.831	+2.709	+2.828	+2.869	+2.804	+2.963	+3.298	+3.659	+3.963	+3.786	+3.631	
EXG GROUND LEVEL AT CENTER LINE OF DFC TRACK (GL)	267.863	266.981	267.084	267.203	267.195	267.015	266.912	266.634	266.353	266.483	266.785	266.733	266.756	266.882	266.916	267.040	267.050	267.882	266.846	266.897	266.724	266.375	265.999	265.701	265.843	265.984	
EXG GROUND LEVEL AT TOE LOCATION OF DFC TRACK	267.863	266.981	267.084	267.203	267.195	267.015	266.912	266.634	266.353	266.483	266.785	266.733	266.756	266.882	266.916	267.040	267.050	267.882	266.846	266.897	266.724	266.375	265.999	265.701	265.843	265.984	
DIFFERENCE BETWEEN DFC FORMATION LEVEL AND EXG.FORMATION LEVEL (PFL-EFL)	2.145	2.145	2.129	2.129	2.127	2.123	2.109	2.080	2.049	2.039	2.044	2.034	2.025	2.015	1.999	2.004	1.996	1.975	1.962	1.935	1.908	1.887	1.850	1.833	1.878	1.850	
DFC FORMATION LEVEL (PFL)	269.914	269.914	269.914	269.914	269.914	269.914	269.902	269.888	269.874	269.859	269.831	269.816	269.802	269.787	269.744	269.730	269.716	269.687	269.658	269.609	269.544	269.473	269.398	269.319	269.246	269.171	
EXG. FORMATION LEVEL OF EXG IR DN MAIN LINE (EFL)	267.769	267.769	267.785	267.785	267.787	267.791	267.793	267.808	267.825	267.820	267.787	267.782	267.777	267.773	267.749	267.742	267.741	267.739	267.751	267.760	267.765	267.760	267.752	267.741	267.726	267.715	
DIFFERENCE BETWEEN DFC RAIL LEVEL AND EXG. RAIL LEVEL (PRL - ERL)	2.186	2.186	2.170	2.170	2.168	2.164	2.150	2.121	2.090	2.080	2.085	2.075	2.066	2.056	2.037	2.029	2.016	2.003	1.976	1.949	1.924	1.899	1.878	1.850	1.824	1.801	
DFC RAIL LEVEL (PRL)	270.627	270.627	270.627	270.627	270.627	270.627	270.615	270.601	270.587	270.572	270.544	270.529	270.515	270.500	270.457	270.443	270.429	270.414	270.400	270.386	270.366	270.342	270.318	270.294	270.270	270.246	
EXG.RAIL LEVEL OF NEAREST IR DN MAIN LINE(ERL)	268.441	268.441	268.457	268.457	268.459	268.463	268.465	268.480	268.497	268.492	268.459	268.454	268.449	268.445	268.421	268.414	268.413	268.411	268.423	268.437	268.437	268.424	268.409	268.394	268.369	268.344	
EQUIVALENT CHAINAGE ON DFC TRACK	1181501.5	1181501.5	1181521.5	1181541.5	1181561.5	1181581.5	1181601.5	1181621.5	1181641.5	1181661.5	1181681.5	1181701.5	1181721.5	1181741.5	1181761.5	1181781.5	1181801.5	1181821.5	1181841.5	1181861.5	1181881.5	1181901.5	1181921.5	1181941.5	1181961.5	1181981.5	1182001.5
EXISTING IR CHAINAGE																											

L - SECTION

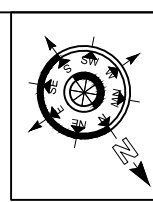

NOTE:-	DRG NO. - 301-2/AL/A/1210
1. DFFC WORKS ARE SHOWN IN RED. 2. IR NEW WORKS ARE SHOWN IN VIOLET. 3. ALL DIMENSIONS ARE SHOWN IN METRES. 4. THIS DRAWING IS PREPARED BASED ON THE LATEST SURVEY DATA HELD ON APRIL-2022, GTS BENCH MARK OF 261.850M CONSIDERED ON TOP OF CANAL BRIDGE ABUTMENT AT DORAKA VILLAGE ALONG THE NH-1. 5. THE NEW CHAINAGE OF 1075.950M IS WITH REFERENCE TO THE IR KM OF 187.500M END OF KM OF CP-303(SECTION 3 P.3)KUHANI)END AGAINST THE EXISTING DFC CHAINAGE. 116277.74M ISSUED VIDEO LETTER NO. CM/GMDC/CM/UR/SURVEY/2021-301-2301-1611173 DT. 17.01.2023. 6. BALLAST PROFILE HAS BEEN PROVIDED ACCORDING TO THE CLAUSE 11.1.3 OF STANDARD SCHEDULE FOR ONE AND A HALF METRE CORRIDOR & THE BALLAST CUSHION DIMENSION SHOWN IN 35CM ON GE-14 PARALL 17. SPECIFICATIONS & RECOMMENDATIONS 2. TWO LAYER SYSTEM FIG.10.	

DRG NO.- 301-2/AL/A/1210

REFERENCE DRAWINGS :-

1. FOR KEY PLAN REFER DRAWING NO. 301-2/AL/0001
2. FOR LEGEND AND ABBREVIATIONS REFER DRAWING NO. 301-2/AL1000
3. FOR TYPICAL SECTION OF BALLAST PROFILE (FL-RL) REFFER DRG. NO. 301-2/TK/TFD/-004 (TR.1952)

0	27.08.2024	SUBMISSION OF AS-BUILT DRAWING	FOR APPROVAL
REV.	DATE	REVISION DETAILS	PURPOSE OF ISSUE

LEGEND:


SCALE

HOR - 1:1000

VER - 1:100

SHEET SIZE : A1

IR TRACK	
DFCC TRACK	
LINK LINE (SMUN-RPJ)	
DFCC FUTURE PROPOSALS	
STRUCTURE / BUILDING	
DFCC TOE LINE	
DFCC FORMATION	
RETAINING WALL	
ROAD	
STREAM, DRAIN, NALA, CANAL.	
FENCE	
POWER LINES	
TBM	
ELECTRIC POLE/OHE MAST	
IR RAILWAY BOUNDARY	
DFCC BOUNDARY	

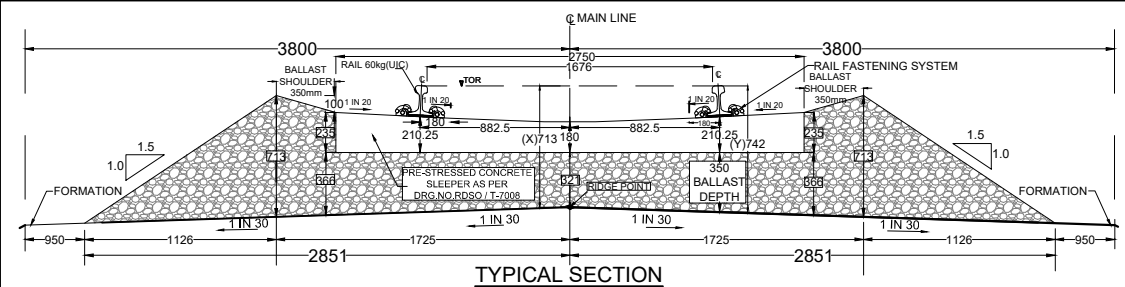

TRACK STRUCTURE		
RAIL SECTION: 60Kg/m (UIC 60Kg/m) DFC LINE: 60kg/m (UIC 60kg/m) IR MAIN LINE: 52Kg/m	Difference between FL- RL (Below Rail Seat)	
	IR Line	DFC
	172mm	172mm
RUBBER PAD	6mm	10mm
SLEEPER DEPTH	210mm	210mm
BALLAST CUSHION	300mm	350mm
Total Depth (FL TO RL)	688mm	742mm

OWNER

DEDICATED FREIGHT CORRIDOR CORPORATION OF INDIA LTD.
(A GOVERNMENT OF INDIA ENTERPRISE)
PROJECT OFFICE(AMBALA UNIT): OLD RAILWAY COLONY (NEAR
ANAND MARKET),AMBALA CANTT-133001.
CORPORATE IDENTITY NO. : U60232DL2006GOI155068


डेडीकेड फ्रीट कोरिडोर

ENGINEER



DB Engineering & Consulting GmbH
Deutsche Bahn Engineering & Consulting GmbH

CONTRACTOR

GIL - TPL JV



SUBMITTED BY	GIL - TPL JV		
	DATED	NAME	SIGNATURE
PREPARED BY			
CHECKED BY	27.08.2024	VIJAY PRATAP	
APPROVED BY	27.08.2024	PARASURAM KOTYADA	
APPROVED BY	DEUTSCHE BAHN ENGINEERING & CONSULTING GMBH		
	DATED	NAME	SIGNATURE
Sr. DE./CHIEF ENGINEER		SURESH K.YALANGI	
CHIEF TRACK ENGINEER		RAJ PAL SINGH	
T.L.		H.D. VIDJAK	


STAMP	A AS-BUILT DRAWING TR. Ref.:..... ENGINEER Sign.:..		
EMPLOYER (DFCCIL):	DEDICATED FREIGHT CORRIDOR CORPORATION OF INDIA LTD		

AS BUILT DRAWING		TITLE	
		AS-BUILT PLAN AND PROFILE FROM IR KM: 292.000 TO 292.500 DFC KM: 1181.501 TO 1182.001	
DFCC APPR. NO. -	ENGG. APPR. NO. -	DRG. NO. -301-2/AL/A/1210	
SHEET NO. : 1 OF 1		STATUS	
DATE : 27.08.2024		A	

TR.

PILKHANI

SAHNEWAL

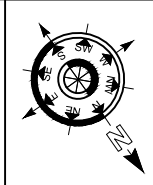

- NOTE:-
- DFCC WORKS ARE SHOWN IN **RED**.
 - IR NEW WORKS ARE SHOWN IN **VIOLET**.
 - ALL DIMENSIONS ARE SHOWN IN METRES.
 - THIS DRAWING IS PREPARED BASED ON LATEST SURVEY DATA HELD ON APRIL-2022. GTS BENCH MARK OF 261.850M CONSIDERED ON TOP OF CANAL BRIDGE ABUTMENT AT DORANA VILLAGE ALONG THE NH1.
 - DFC NEW CHAINAGE OF 1075.950M IS WITH REFERENCE TO THE IR KM OF 187.500KM END OF KM OF CP-303(SECTION P-3 PILKHANI END) AGAINST THE EXISTING DFC CHAINAGE. 116277.742M ISSUED VIDE LETTER NO. COM/DFCC/UM/SURVEY/2021-301-230116-011173 DT. 17.01.2023.
 - BALLAST PROFILE HAS BEEN PROVIDED ACCORDING TO THE CLAUSE 1.11.3 OF STANDARD SCHEDULE OF DIMENSION(EASTERN CORRIDOR) & THE BALLAST CUSHION DIMESION SHOWN IN 35CM ON GE-14 PARA 17. SPECIFICATIONS & RECOMMENDATIONS 2. TWO LAYER SYSTEM FIG.10.

DRG NO.- 301-2/AL/A/1211

REFERENCE DRAWINGS :-

- FOR KEY PLAN REFER DRAWING NO. 301-2/AL/0001
- FOR LEGEND AND ABBREVIATIONS REFER DRAWING NO. 301-2/AL/1000
- FOR TYPICAL SECTION OF BALLAST PROFILE (FL-RL) REFER DRG. NO. 301-2/TK/TFD/004 (TR.1952)

0	27.08.2024	SUBMISSION OF AS-BUILT DRAWING	FOR APPROVAL
REV.	DATE	REVISION DETAILS	PURPOSE OF ISSUE

LEGEND:


SCALE

HOR - 1:1000

VER - 1:100

SHEET SIZE : A1

IR TRACK
DFCC TRACK
LINK LINE (SMUN-RP-J)
DFCC FUTURE PROPOSALS
STRUCTURE / BUILDING
DFCC TOE LINE
DFCC FORMATION
RETAINING WALL
ROAD
STREAM, DRAIN, NALA, CANAL.
FENCE
POWER LINES
TBM
ELECTRIC POLE/OHE MAST
IR RAILWAY BOUNDARY
DFCC BOUNDARY

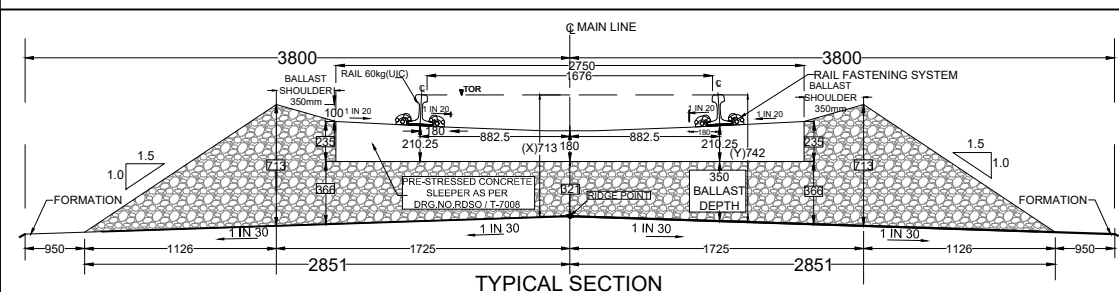

TRACK STRUCTURE		
RAIL SECTION: 60Kg/m (UIC 60Kg/m) DFC LINE: 60Kg/m (UIC 60Kg/m) IR MAIN LINE :52Kg/m	Difference between FL- RL (Below Rail Seat)	
	IR Line	DFC
RUBBER PAD	172mm	172mm
SLEEPER DEPTH	210mm	210mm
BALLAST CUSHION	300mm	350mm
Total Depth (FL TO RL)	688mm	742mm

OWNER

DEDICATED FREIGHT CORRIDOR CORPORATION OF INDIA LTD.

(A GOVERNMENT OF INDIA ENTERPRISE)

PROJECT OFFICE(AMBALA UNIT): OLD RAILWAY COLONY (NEAR ANAND MARKET),AMBALA CANTT-133001.

CORPORATE IDENTITY NO. : U60232DL2006GGI155068

ENGINEER:

DB DB Engineering & Consulting GmbH

Deutsche Bahn Engineering & Consulting GmbH

CONTRACTOR:

GIL - TPL JV

GAR **TATA**



SUBMITTED BY	GIL - TPL JV		
	DATED	NAME	SIGNATURE
PREPARED BY			
CHECKED BY	27.08.2024	VIJAY PRATAP	
APPROVED BY	27.08.2024	PARASURAM KOTYADA	

APPROVED BY	DEUTSCHE BAHN ENGINEERING & CONSULTING GMBH		
	DATED	NAME	SIGNATURE
Sr. DE./CHIEF ENGINEER		SURESH K.YALANGI	
CHIEF TRACK ENGINEER		RAJ PAL SINGH	
T.L.		H.D. VIDJAK	

STAMP	A AS-BUILT DRAWING TR. Ref.:..... ENGINEER Sign.:.....		
	EMPLOYER (DFCCIL): DEDICATED FREIGHT CORRIDOR CORPORATION OF INDIA LTD.		

AS BUILT DRAWING			
TITLE		DFCC APPR. NO. -	
AS-BUILT PLAN AND PROFILE		ENGG. APPR. NO. -	
FROM IR KM: 292.500 TO 293.000		DRG. NO. -301-2/AL/A/1211	
DFC KM: 1182.001 TO 1182.459		SHEET NO. : 1 OF 1	
		DATE : 27.08.2024	
		STATUS	
		A	


TR.

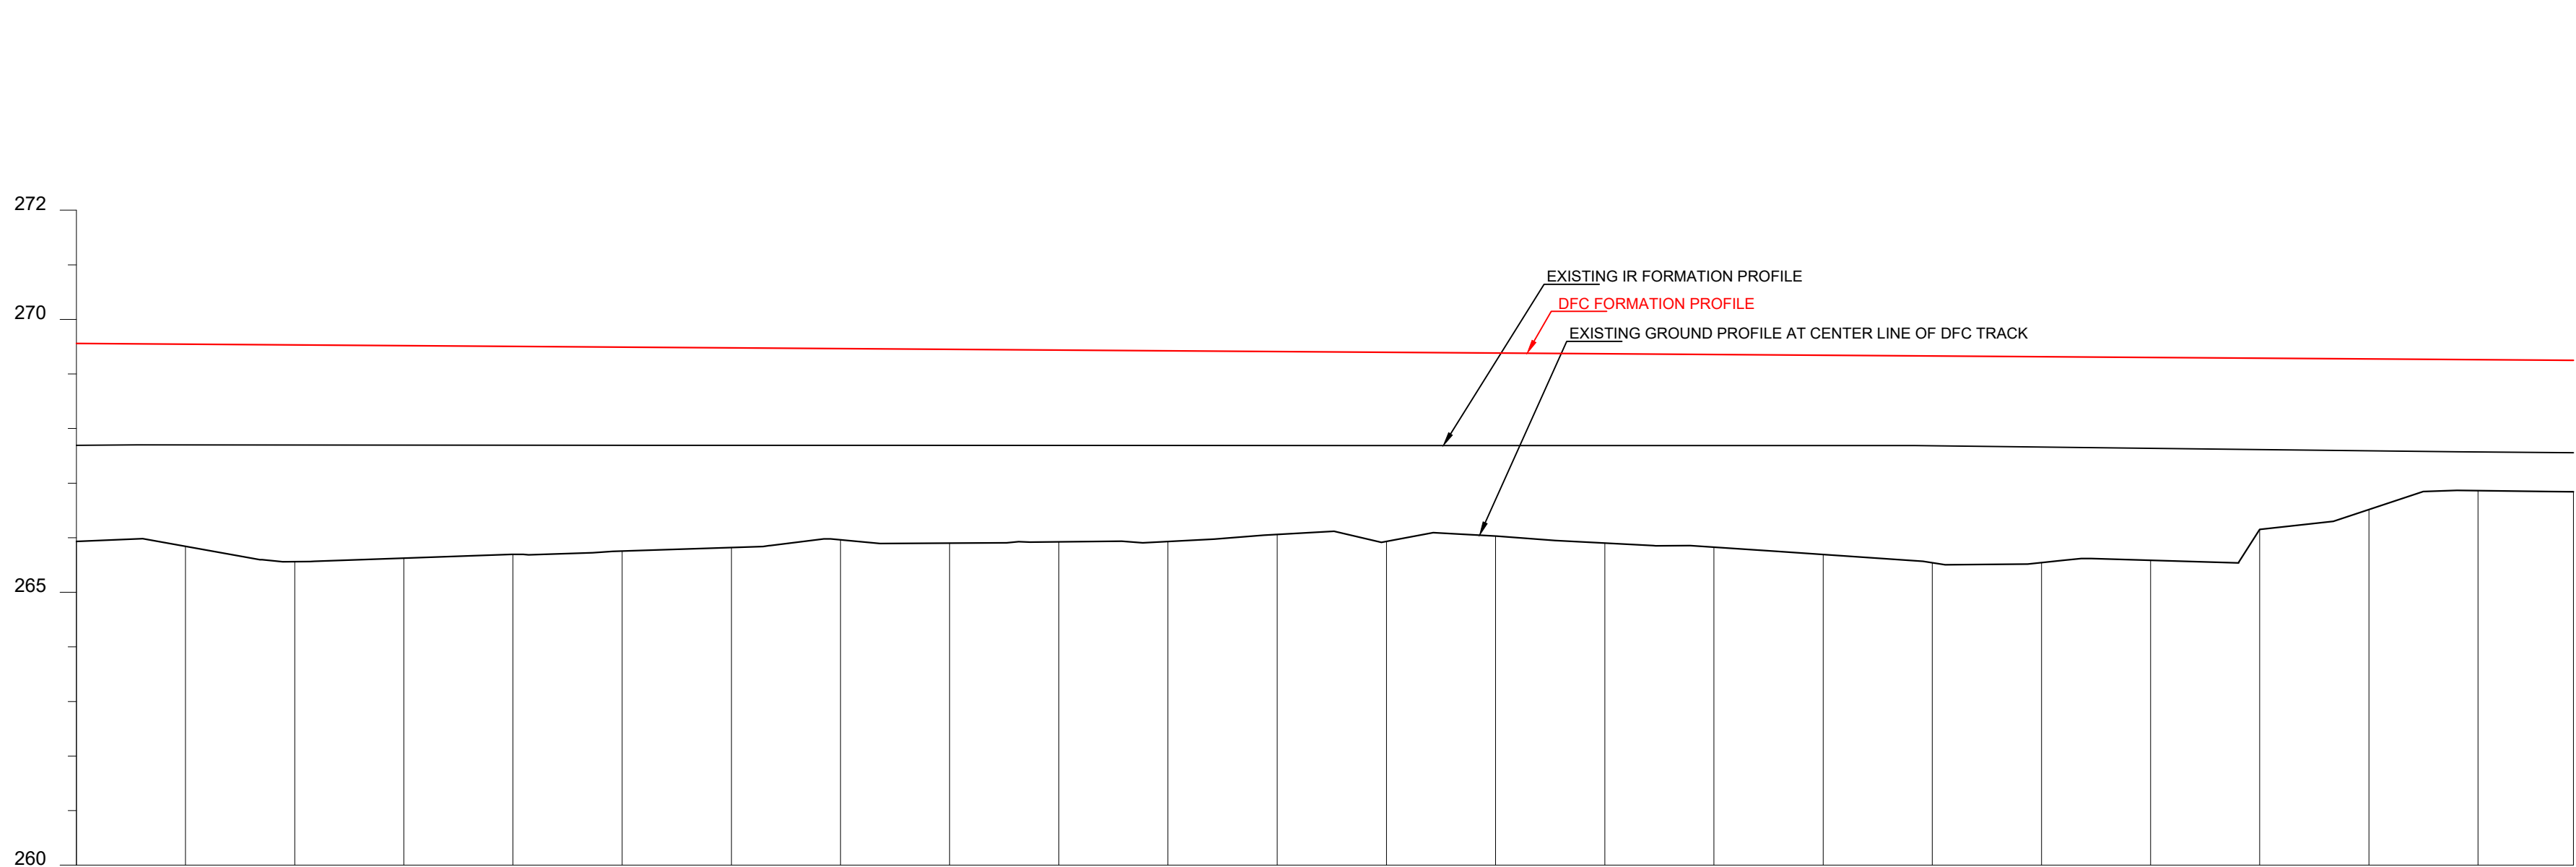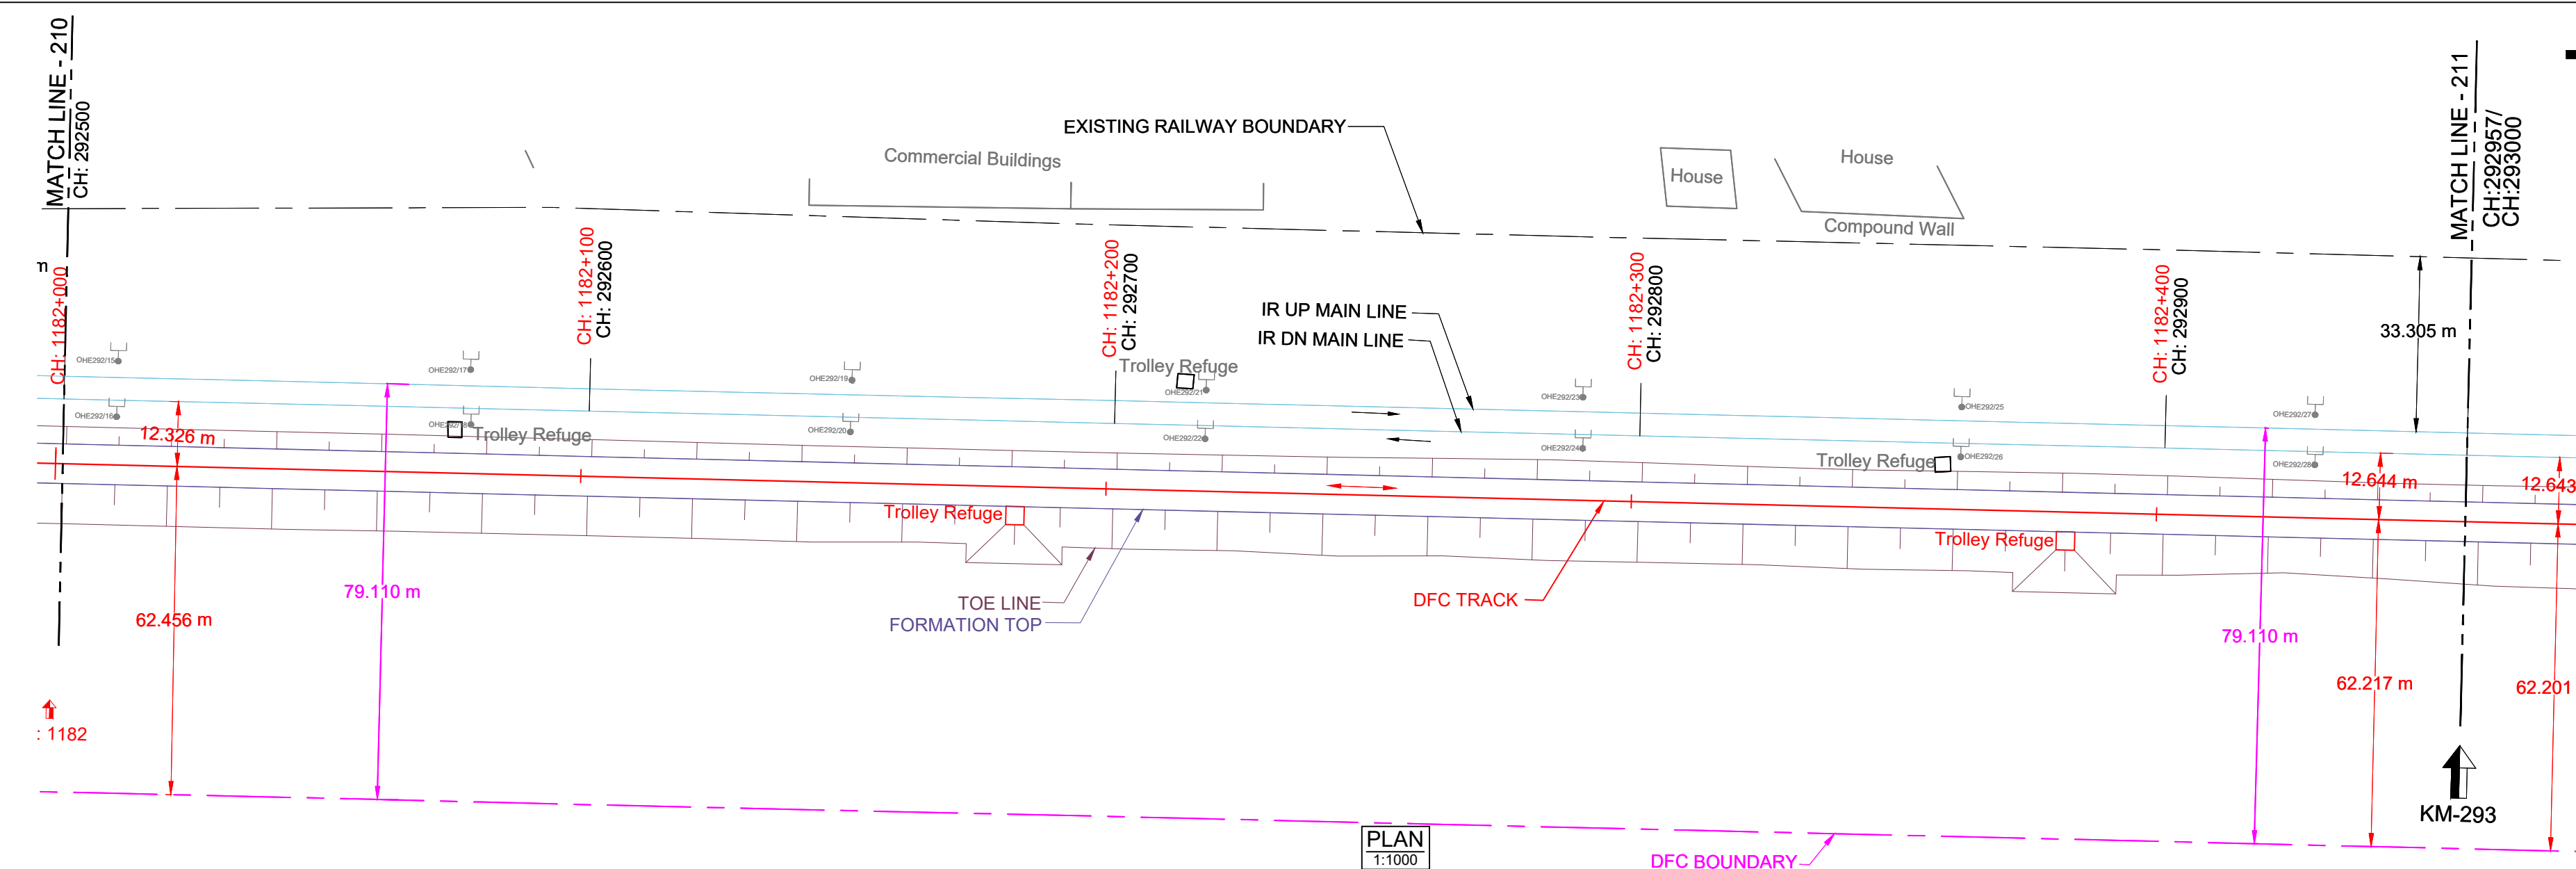

DATUM ABOVE MSL : 260 m

HORIZONTAL ALIGNMENT	L = 5898.430m																																															
VERTICAL ALIGNMENT	L=1742.5 m 1 IN 1392.188 F																																															
TRACK DISTANCE FROM EXISTING NEAREST IR DN MAIN LINE TO DFC MAIN LINE	12.300	12.300	12.326	12.326	12.367	12.367	12.402	12.402	12.408	12.408	12.413	12.431	12.431	12.452	12.452	12.465	12.465	12.468	12.468	12.472	12.472	12.476	12.476	12.483	12.483	12.502	12.502	12.521	12.521	12.540	12.540	12.559	12.559	12.579	12.579	12.602	12.602	12.624	12.624	12.638	12.638	12.641	12.641	12.644	12.644	12.643	12.643	
HEIGHT OF BANKING(+) / DEPTH OF CUTTING(-) (PFL-GL)	+3.631	+3.631	+3.705	+3.705	+3.973	+3.973	+3.895	+3.895	+3.811	+3.811	+3.739	+3.658	+3.658	+3.505	+3.505	+3.552	+3.552	+3.514	+3.514	+3.495	+3.495	+3.351	+3.351	+3.466	+3.466	+3.354	+3.354	+3.470	+3.470	+3.530	+3.530	+3.651	+3.651	+3.769	+3.769	+3.774	+3.774	+3.718	+3.718	+2.760	+2.760	+2.398	+2.398	+2.408	+2.408			
EXG GROUND LEVEL AT CENTER LINE OF DFC TRACK (GL)	267.846	267.846	265.896	265.896	267.842	267.842	265.896	265.896	267.822	267.822	265.614	265.614	265.806	265.806	267.806	267.806	265.677	265.677	267.823	267.823	265.870	265.870	267.823	267.823	265.870	265.870	267.801	267.801	265.977	265.977	267.801	267.801	265.977	265.977	267.801	267.801	265.977	265.977	267.801	267.801	265.977	265.977	267.801	267.801	265.977	265.977		
EXG GROUND LEVEL AT TOE LOCATION OF DFC TRACK	267.846	267.846	265.896	265.896	267.842	267.842	265.896	265.896	267.822	267.822	265.614	265.614	265.806	265.806	267.806	267.806	265.677	265.677	267.823	267.823	265.870	265.870	267.823	267.823	265.870	265.870	267.801	267.801	265.977	265.977	267.801	267.801	265.977	265.977	267.801	267.801	265.977	265.977	267.801	267.801	265.977	265.977	267.801	267.801	265.977	265.977		
DIFFERENCE BETWEEN DFC FORMATION LEVEL AND EXG.FORMATION LEVEL (PFL-EFL)	1.850	1.850	1.830	1.830	1.818	1.818	1.806	1.806	1.795	1.795	1.784	1.784	1.771	1.771	1.756	1.756	1.743	1.743	1.730	1.730	1.717	1.717	1.705	1.705	1.692	1.692	1.679	1.679	1.666	1.666	1.653	1.653	1.640	1.640	1.631	1.631	1.640	1.640	1.650	1.650	1.659	1.659	1.677	1.677	1.677	1.677		
DFC FORMATION LEVEL (PFL)	269.615	269.615	269.601	269.601	269.586	269.586	269.572	269.572	269.558	269.558	269.543	269.543	269.529	269.529	269.515	269.515	269.500	269.500	269.486	269.486	269.471	269.471	269.457	269.457	269.443	269.443	269.428	269.428	269.414	269.414	269.400	269.400	269.385	269.385	269.371	269.371	269.357	269.357	269.342	269.342	269.328	269.328	269.299	269.299	269.286	269.286		
EXG. FORMATION LEVEL OF EXG IR DN MAIN LINE (EFL)	267.765	267.765	267.771	267.771	267.768	267.768	267.766	267.766	267.762	267.762	267.759	267.759	267.758	267.758	267.758	267.758	267.758	267.758	267.756	267.756	267.754	267.754	267.752	267.752	267.751	267.751	267.749	267.749	267.748	267.748	267.746	267.746	267.745	267.745	267.740	267.740	267.716	267.716	267.692	267.692	267.669	267.669	267.622	267.622	267.609	267.609		
DIFFERENCE BETWEEN DFC RAIL LEVEL AND EXG. RAIL LEVEL (PRL - ERL)	1.891	1.891	1.871	1.871	1.859	1.859	1.847	1.847	1.836	1.836	1.825	1.825	1.812	1.812	1.797	1.797	1.784	1.784	1.771	1.771	1.758	1.758	1.746	1.746	1.733	1.733	1.720	1.720	1.707	1.707	1.694	1.694	1.681	1.681	1.672	1.672	1.681	1.681	1.691	1.691	1.700	1.700	1.718	1.718	1.718	1.718		
DFC RAIL LEVEL (PRL)	270.328	270.328	270.314	270.314	270.299	270.299	270.285	270.285	270.271	270.271	270.256	270.256	270.242	270.242	270.228	270.228	270.213	270.213	270.199	270.199	270.184	270.184	270.170	270.170	270.156	270.156	270.141	270.141	270.127	270.127	270.113	270.113	270.098	270.098	270.084	270.084	270.070	270.070	270.055	270.055	270.041	270.041	270.026	270.026	270.012	270.012		
EXG.RAIL LEVEL OF NEAREST IR DN MAIN LINE(ERL)	268.437	268.437	268.443	268.443	268.440	268.440	268.438	268.438	268.434	268.434	268.431	268.431	268.430	268.430	268.430	268.430	268.430	268.430	268.428	268.428	268.426	268.426	268.424	268.424	268.423	268.423	268.421	268.421	268.420	268.420	268.418	268.418	268.417	268.417	268.412	268.412	268.364	268.364	268.341	268.341	268.294	268.294	268.281	268.281				
EQUIVALENT CHAINAGE ON DFC TRACK	1182001.5	1182001.5	1182021.5	1182021.5	1182041.5	1182041.5	1182061.5	1182061.5	1182081.5	1182081.5	1182101.5	1182101.5	1182121.5	1182121.5	1182141.5	1182141.5	1182161.5	1182161.5	1182181.5	1182181.5	1182201.5	1182201.5	1182221.5	1182221.5	1182241.5	1182241.5	1182261.5	1182261.5	1182281.5	1182281.5	1182301.5	1182301.5	1182321.5	1182321.5	1182341.5	1182341.5	1182361.5	1182361.5	1182381.5	1182381.5	1182401.5	1182401.5	1182421.5	1182421.5	1182441.5	1182441.5		
EXISTING IR CHAINAGE	292500.0	292500.0	292520.0	292520.0	292540.0	292540.0	292560.0	292560.0	292580.0	292580.0	292600.0	292600.0	292620.0	292620.0	292640.0	292640.0	292660.0	292660.0	292680.0	292680.0	292700.0	292700.0	292720.0	292720.0	292740.0	292740.0	292760.0	292760.0	292780.0	292780.0	292800.0	292800.0	292820.0	292820.0	292840.0	292840.0	292860.0	292860.0	292880.0	292880.0	292900.0	292900.0	292920.0	292920.0	292940.0	292940.0	292957.5	292957.5

L - SECTION

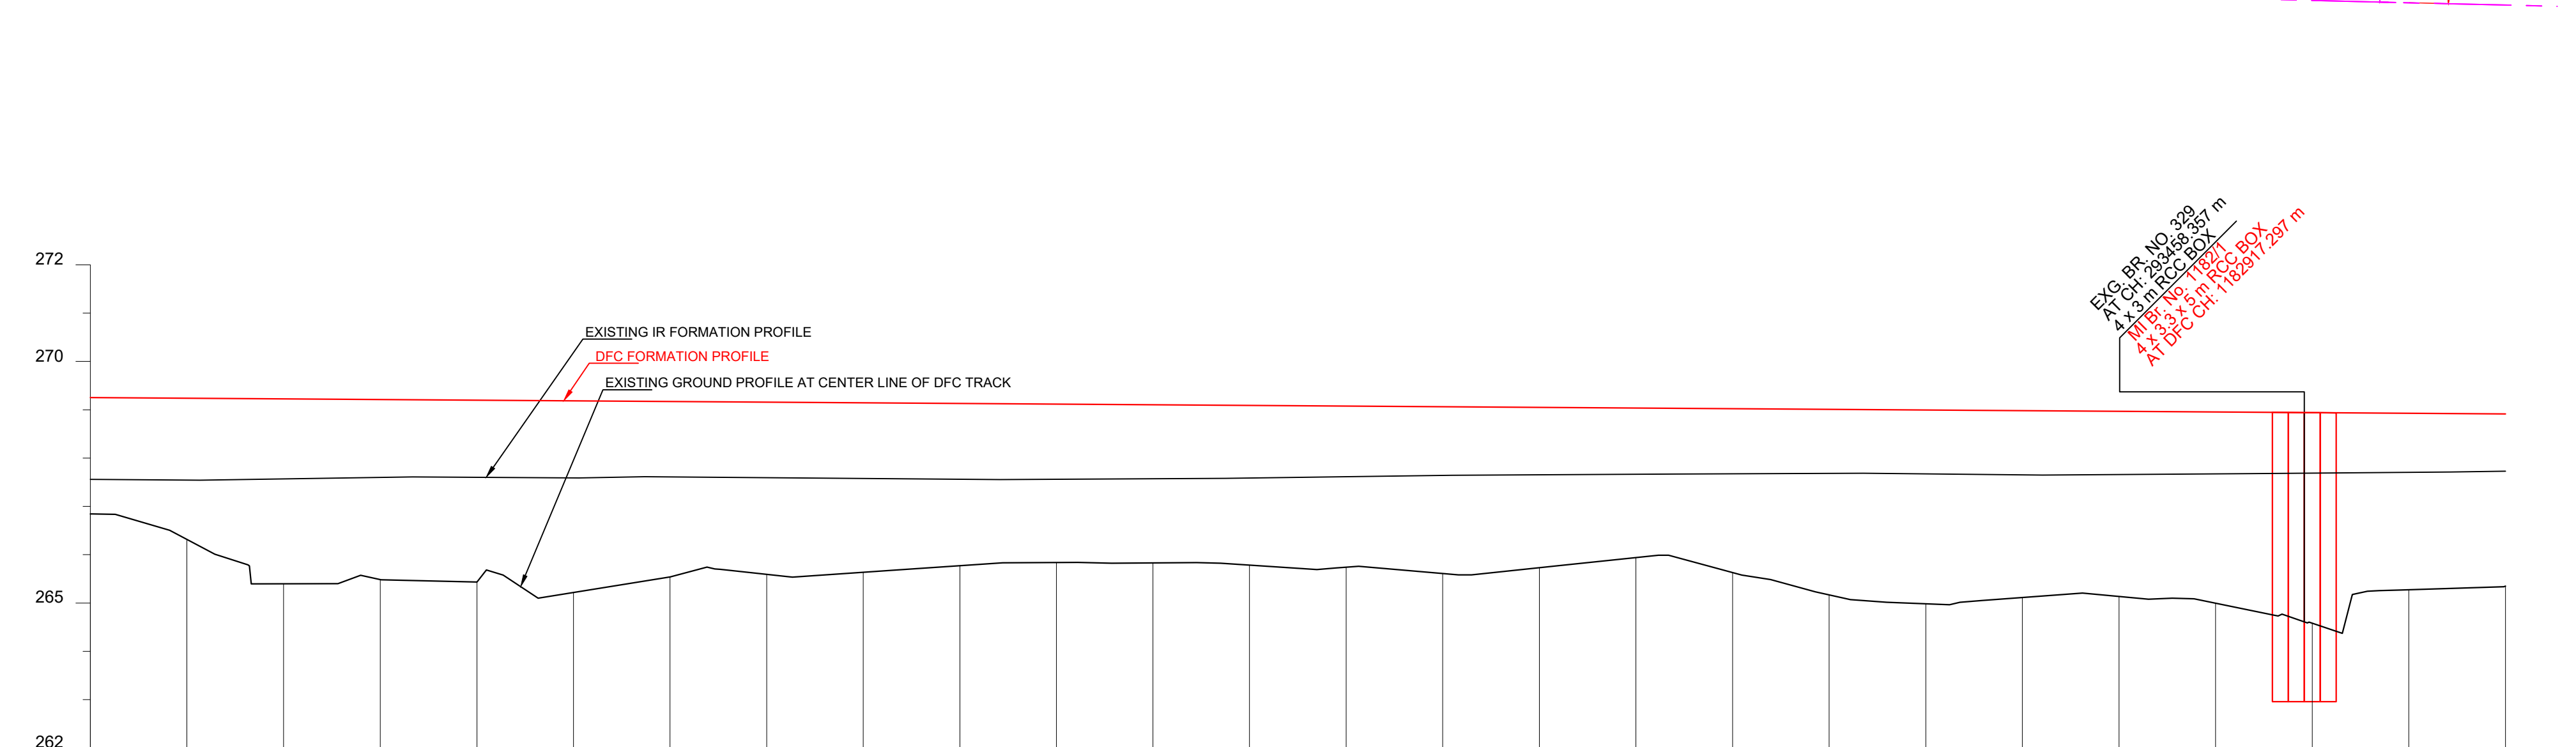

HORIZONTAL ALIGNMENT										
VERTICAL ALIGNMENT	L = 5898.430m									
TRACK DISTANCE FROM EXISTING NEAREST IR DN MAIN LINE TO DFC MAIN LINE	L=1742.5 m 1 IN 1392.188 F									
HEIGHT OF BANKING(+)/ DEPTH OF CUTTING(-) (PFL-GL)										
EXG GROUND LEVEL AT CENTER LINE OF DFC TRACK (GL)										
EXG GROUND LEVEL AT TOE LOCATION OF DFC TRACK										
DIFFERENCE BETWEEN DFC FORMATION LEVEL AND EXG.FORMATION LEVEL (PFL-EFL)										
DFC FORMATION LEVEL (PFL)										
EXG. FORMATION LEVEL OF EXG IR DN MAIN LINE (EFL)										
DIFFERENCE BETWEEN DFC RAIL LEVEL AND EXG. RAIL LEVEL (PRL - ERL)										
DFC RAIL LEVEL (PRL)										
EXG.RAIL LEVEL OF NEAREST IR DN MAIN LINE(ERL)										
EQUIVALENT CHAINAGE ON DFC TRACK										
EXISTING IR CHAINAGE										


NOTE:-	DRG NO. - 301-2/A/1212
1. DFOC WORKS ARE SHOWN IN RED. 2. IR NEW WORKS ARE SHOWN IN VIOLET. 3. ALL DIMENSIONS ARE SHOWN IN METRES. 4. THIS DRAWING IS PREPARED BASED ON LATEST SURVEY DATA HELD ON APRIL 2022. GETS BENCH MARK OF 261.850M CONSIDERED ON TOP OF CANAL BRIDGE ABUTMENT AT DORAKA VILLAGE ALONG THE NH1. 5. DFOC NEW CHAINAGE OF 1075.950M IS WITH REFERENCE TO THE IR KM OF 187.500KM OF KM OF CP-30(SECTION 3 PILLKANI) END AGAINST THE EXISTING DFOC CHAINAGE. 116277.742M ISSUED VIDE LETTER NO. CM/GMDC/CIUMB/SURVEY/2021-301-2301-1611173 DT. 17.01.2023 6. BALLAST PROFILE HAS BEEN PROVIDED ACCORDING TO THE CLAUSE 11.1.3 OF STANDARD SCHEDULE FOR NORTH-EASTERN CORRIDOR & THE BALLAST CUSHION DIMENSION SHOWN IN 35CM ON GE-14 PARALL 17. SPECIFICATIONS & RECOMMENDATIONS 2. TWO LAYER SYSTEM FIG.10.	

REFERENCE DRAWINGS :-

1. FOR KEY PLAN REFER DRAWING NO. 301-2/AL/0001
2. FOR LEGEND AND ABBREVIATIONS REFER DRAWING NO. 301-2/AL/1000
3. FOR TYPICAL SECTION OF BALLAST PROFILE (FL-RL) REFER DRG. NO. 301-2/TK/TFD/-004 (TR.1952)

0	27.08.2024	SUBMISSION OF AS-BUILT DRAWING	FOR APPROVAL
REV.	DATE	REVISION DETAILS	PURPOSE OF ISSUE

SCALE	LEGEND
HOR - 1:1000 VER - 1:100 SHEET SIZE : A1	IR TRACK DFCC TRACK LINK LINE (SMUN-RPJ) DFCC FUTURE PROPOSALS STRUCTURE / BUILDING DFCC TOE LINE DFCC FORMATION RETAINING WALL ROAD STREAM, DRAIN, NALA, CANAL FENCE POWER LINES TBM ELECTRIC POLE/OHE MAST IR RAILWAY BOUNDARY DFCC BOUNDARY

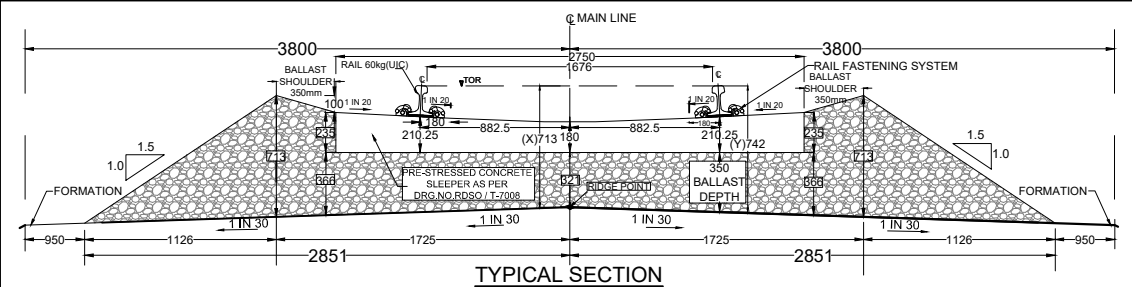

TRACK STRUCTURE		
RAIL SECTION: 60Kg/m (UIC 60Kg/m) DFC LINE: 60Kg/m (UIC 60Kg/m) IR MAIN LINE: 52Kg/m	Difference between FL- RL (Below Rail Seat)	
	IR Line	DFC
	172mm	172mm
RUBBER PAD	6mm	10mm
SLEEPER DEPTH	210mm	210mm
BALLAST CUSHION	300mm	350mm
Total Depth (FL TO RL)	688mm	742mm

OWNER



डेडीकेटेड फ्रीट कॉरिडोर

DEDICATED FREIGHT CORRIDOR CORPORATION OF INDIA LTD.
(A GOVERNMENT OF INDIA ENTERPRISE)
PROJECT OFFICE (AMBALA UNIT): OLD RAILWAY COLONY (NEAR
ANAND MARKET), AMBALA CANTT-133001.
CORPORATE IDENTITY NO. : U60232DL2006GOI155068

ENGINEER:

 DB Engineering & Consulting GmbH
Deutsche Bahn Engineering & Consulting GmbH

CONTRACTOR: GIL - TPL JV

SUBMITTED BY	GIL - TPL JV		
	DATED	NAME	SIGNATURE
PREPARED BY			
CHECKED BY	27.08.2024	VIJAY PRATAP	
APPROVED BY	27.08.2024	PARASURAM KOTYADA	

APPROVED BY	DEUTSCHE BAHN ENGINEERING & CONSULTING GMBH		
	DATED	NAME	SIGNATURE
Sr. DE/CHIEF ENGINEER		SURESH K.YALANGI	
CHIEF TRACK ENGINEER		RAJ PAL SINGH	
T.L.		H.D. VIDJAK	


STAMP		

EMPLOYER (DFCCIL):	DEDICATED FREIGHT CORRIDOR CORPORATION OF INDIA LTD.		

AS BUILT DRAWING

TITLE AS-BUILT PLAN AND PROFILE FROM IR KM: 293.000 TO 293.500 DFC KM: 1182.459 TO 1182.959	DFCC APPR. NO. -	
	ENGG. APPR. NO. -	
	DRG. NO. -301-2/AL/A/1212	
	SHEET NO. : OF 1	STATUS
DATE : 27.08.2024		A

TR.

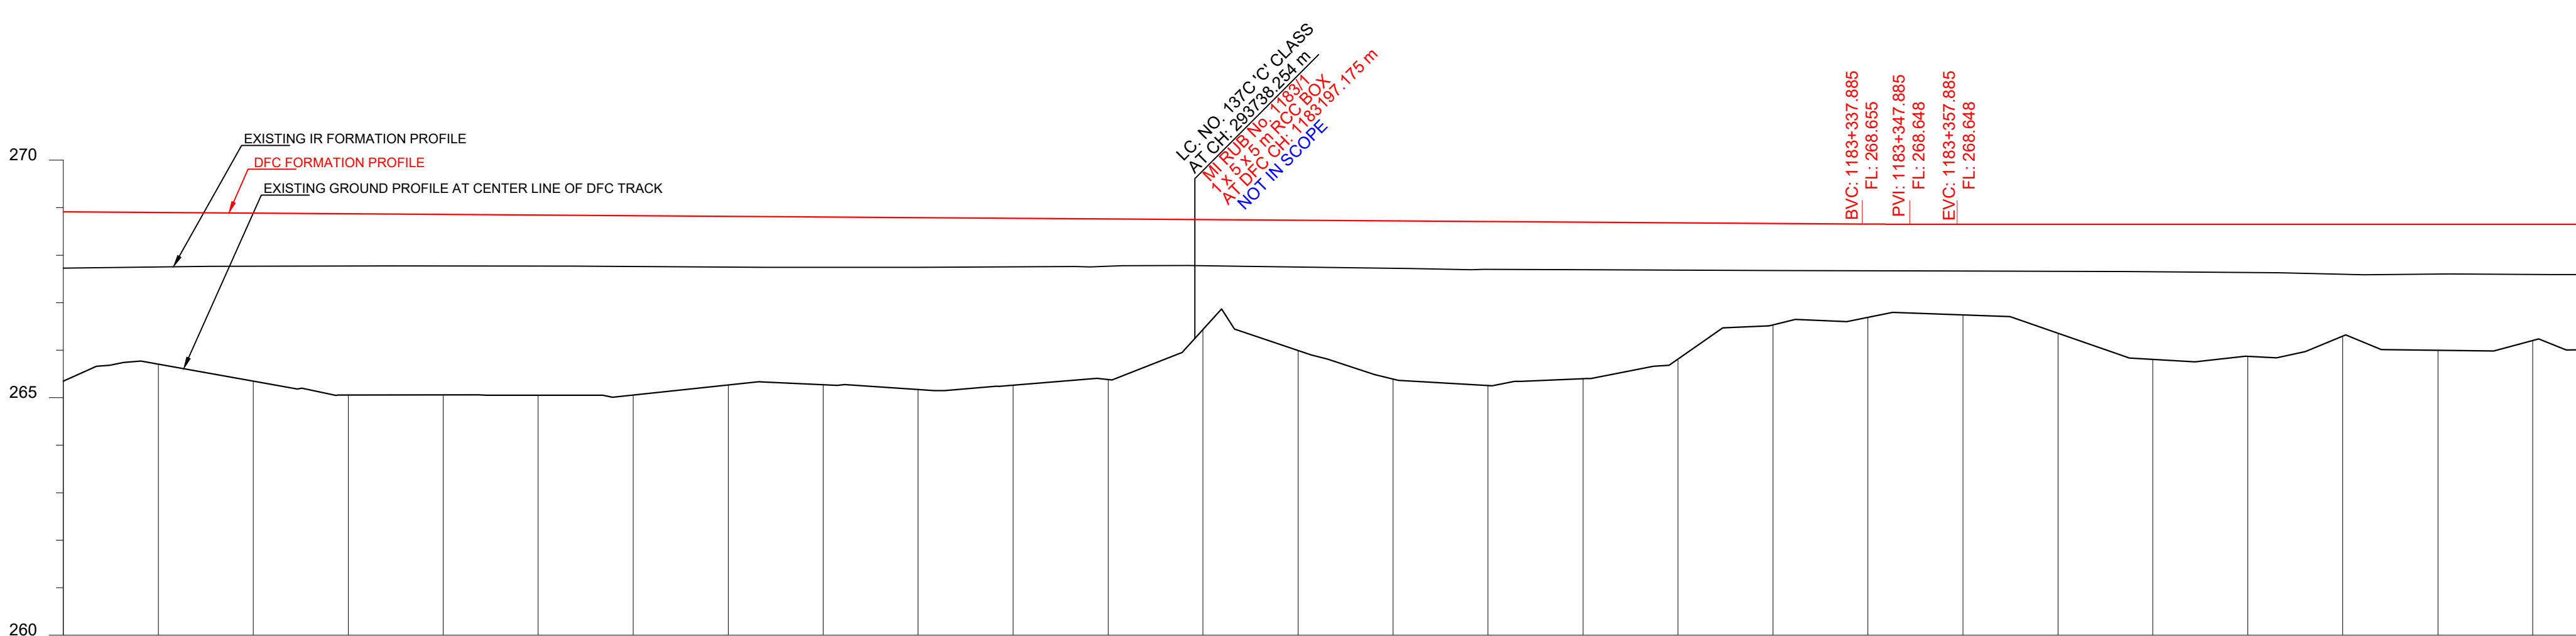L - SECTION

A diagram of a cyclotron. It shows two semi-circular electrodes called dees, labeled 'D1' and 'D2'. A central vertical axis is shown. A particle path is indicated by a line with arrows, starting from the center and spiraling outwards, crossing the gap between the dees multiple times. A north arrow is located at the bottom right of the diagram.

- REFERENCE DRAWINGS :-**
1. FOR KEY PLAN REFER DRAWING NO. 301-2/AL/0001
 2. FOR LEGEND AND ABBREVIATIONS REFER DRAWING NO. 301-2/AL1000
 3. FOR TYPICAL SECTION OF BALLAST PROFILE (FL-RL) REFER DRG. NO. 301-2/TK/TFD/-004 (TR.1952)

SCALE


HOR - 1:1000

VER - 1:100

SHEET SIZE : A1

LEGEND:

- IR TRACK
- DFCC TRACK
- LINK LINE (SMUN-RPJ)
- DFCC FUTURE PROPOSALS
- STRUCTURE / BUILDING
- DFCC TOE LINE
- DFCC FORMATION
- RETAINING WALL
- ROAD
- STREAM, DRAIN, NALA, CANAL
- FENCE
- POWER LINES
- TBM
- ELECTRIC POLE/OHE MAST
- IR RAILWAY BOUNDARY
- DFCC BOUNDARY

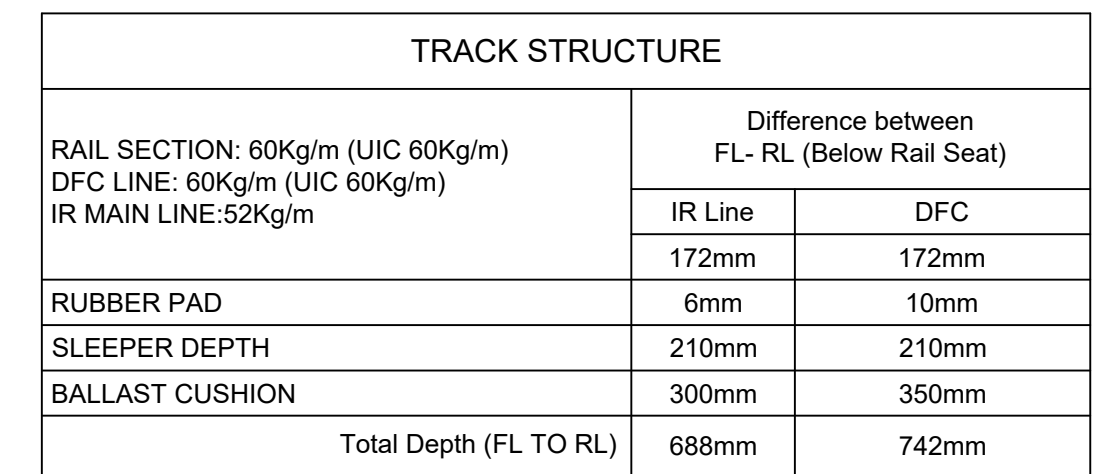

ENGINEER:

 DB Engineering &
Consulting GmbH
Deutsche Bahn Engineering & Consulting GmbH



SUBMITTED BY	GIL - TPL JV		
	DATED	NAME	SIGNATURE
PREPARED BY			
CHECKED BY	27.08.2024	VIJAY PRATAP	
APPROVED BY	27.08.2024	PARASURAM KOTYADA	

APPROVED BY	DEUTSCHE BAHN ENGINEERING & CONSULTING GMBH		
	DATED	NAME	SIGNATURE
Sr. DE./CHIEF ENGINEER		SURESH K.YALANGI	
CHIEF TRACK ENGINEER		RAJ PAL SINGH	
T.L.		H.D. VIDJAK	

STAMP	A AS-BUILT DRAWING TR. Ref.:..... ENGINEER Sign.:		
EMPLOYER (DFCCIL):	DEDICATED FREIGHT CORRIDOR CORPORATION OF INDIA LTD.		

AS BUILT DRAWING		
TITLE AS-BUILT PLAN AND PROFILE FROM IR KM: 293.500 TO 294.000 DFC KM: 1182.959 TO 1183.489	DFCC APPR. NO. -	STATUS A
	ENGG. APPR. NO. -	
	DRG. NO. -301-2/AL/A/1213	
	SHEET NO. : 1 OF 1	
	DATE : 27.08.2024	


TR

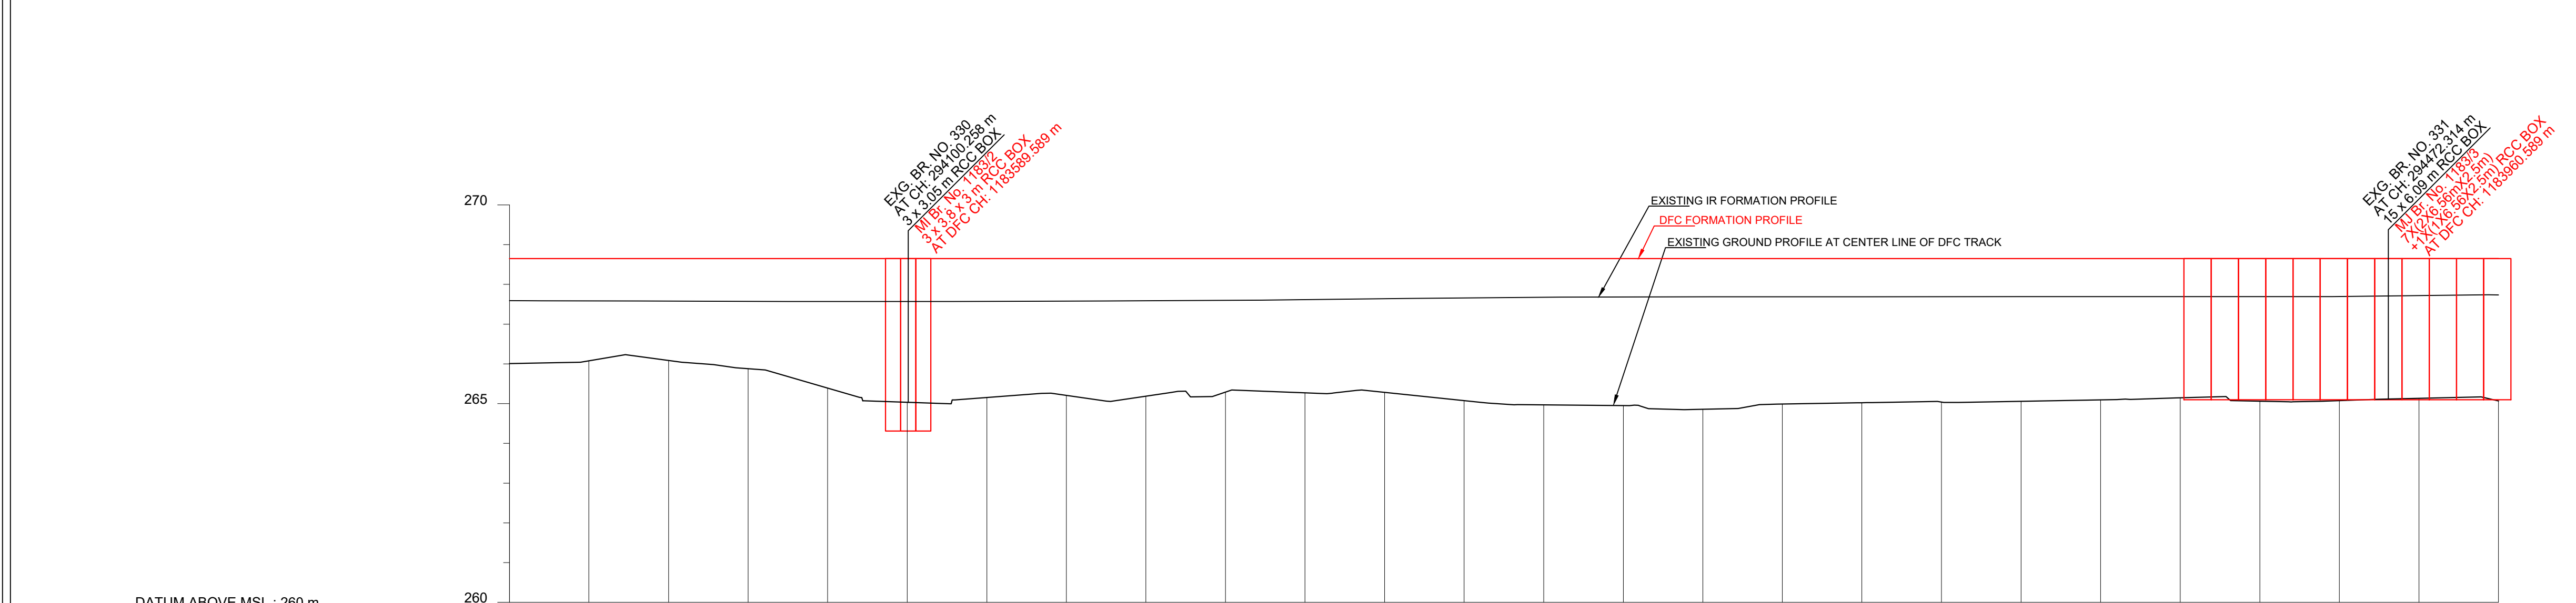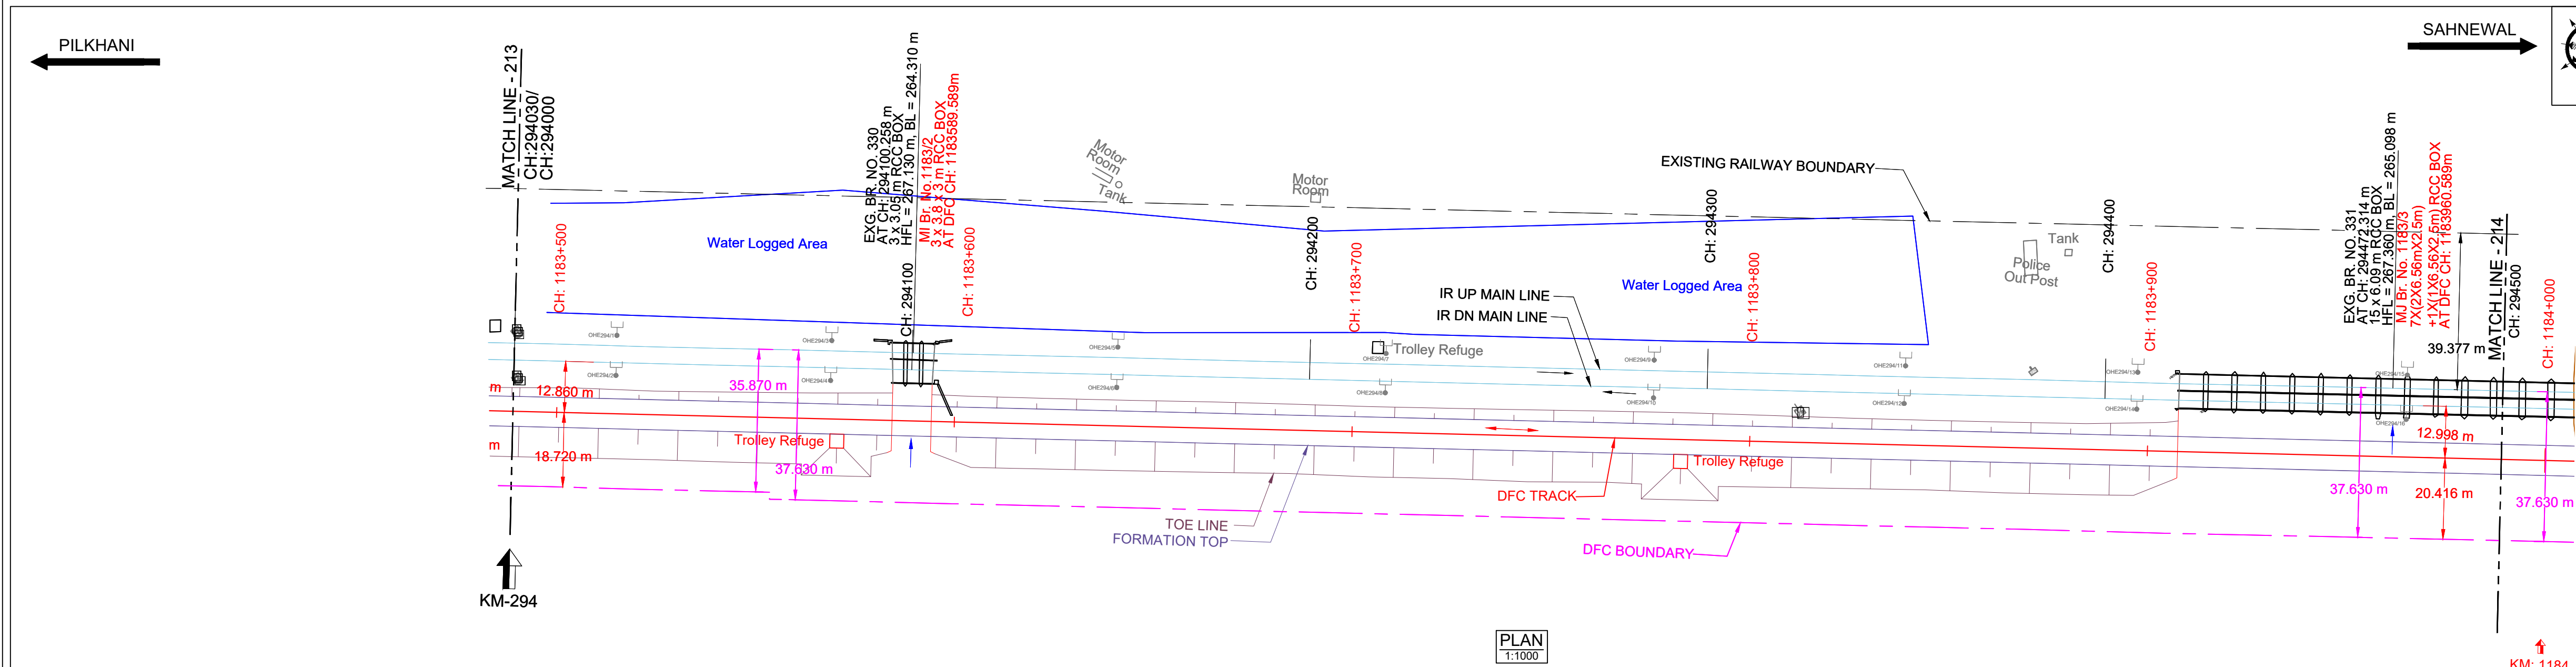

ATUM ABOVE MSL : 260 m		260																																																																																																																																																																																																																																																																																																																																																																																																																																																																																																																																																																																																																																																																																																																																																																																																																																																																																																																																																																																																																																																																																																																																																																																																																																																																																																																																																																																																																							
------------------------	--	-----	--	--	
L - SECTION

SAHNEWAL

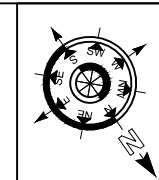

- NOTE:-
1. DFC WORKS ARE SHOWN IN RED.
 2. IR NEW WORKS ARE SHOWN IN VIOLET.
 3. ALL DIMENSIONS ARE SHOWN IN METRES.
 4. THIS DRAWING IS PREPARED BASED ON LATEST SURVEY DATA HELD ON APRIL-2022. GTS BENCH MARK OF 261.850M CONSIDERED ON TOP OF CANAL BRIDGE ABUTMENT AT DORANA VILLAGE ALONG THE NH1.
 5. DFC NEW CHAINAGE OF 1075.950M IS WITH REFERENCE TO THE IR KM OF 187.500KM END OF KM OF CP-303(SECTION P-3 PILKHANI END) AGAINST THE EXISTING DFC CHAINAGE. 116277.742M ISSUED VIDE LETTER NO. COM/DFCC/MB/SURVEY/2021-301-230116-011173 DT. 17.01.2023.
 6. BALLAST PROFILE HAS BEEN PROVIDED ACCORDING TO THE CLAUSE 1.11.3 OF STANDARD SCHEDULE OF DIMENSION(EASTERN CORRIDOR) & THE BALLAST CUSHION DIMENSION SHOWN IN 35CM ON GE-14 PARA 17. SPECIFICATIONS & RECOMMENDATIONS 2. TWO LAYER SYSTEM FIG.10.

- REFERENCE DRAWINGS :-
1. FOR KEY PLAN REFER DRAWING NO. 301-2/AL/0001
 2. FOR LEGEND AND ABBREVIATIONS REFER DRAWING NO. 301-2/AL/1000
 3. FOR TYPICAL SECTION OF BALLAST PROFILE (FL-RL) REFER DRG. NO. 301-2/TK/TFD/004 (TR.1952)

0	27.08.2024	SUBMISSION OF AS-BUILT DRAWING	FOR APPROVAL
REV.	DATE	REVISION DETAILS	PURPOSE OF ISSUE

LEGEND:


SCALE

HOR - 1:1000

VER - 1:100

SHEET SIZE : A1

IR TRACK
DFCC TRACK
LINK LINE (SMUN-RP-J)
DFCC FUTURE PROPOSALS
STRUCTURE / BUILDING
DFCC TOE LINE
DFCC FORMATION
RETAINING WALL
ROAD
STREAM, DRAIN, NALA, CANAL.
FENCE
POWER LINES
TBM
ELECTRIC POLE/OHE MAST
IR RAILWAY BOUNDARY
DFCC BOUNDARY

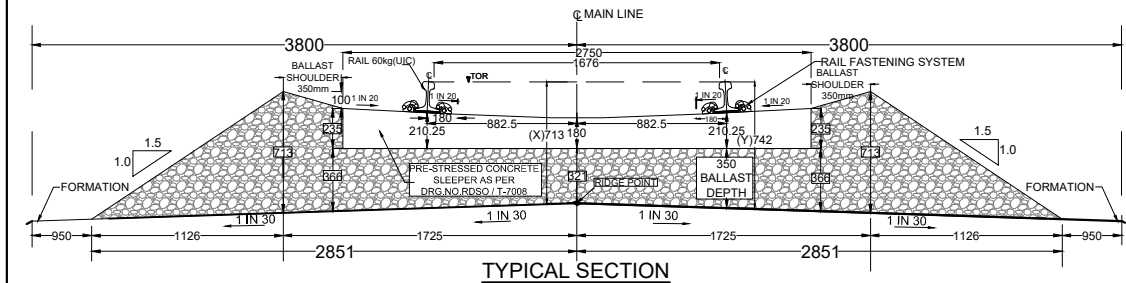

TRACK STRUCTURE		
RAIL SECTION: 60Kg/m (UIC 60Kg/m) DFC LINE: 60Kg/m (UIC 60Kg/m) IR MAIN LINE: 52Kg/m	Difference between FL- RL (Below Rail Seat)	
	IR Line	DFC
RUBBER PAD	172mm	172mm
SLEEPER DEPTH	6mm	10mm
BALLAST CUSHION	210mm	210mm
	300mm	350mm
Total Depth (FL TO RL)	688mm	742mm

OWNER

DEDICATED FREIGHT CORRIDOR CORPORATION OF INDIA LTD.

(A GOVERNMENT OF INDIA ENTERPRISE)

PROJECT OFFICE/AMBALA UNIT: OLD RAILWAY COLONY (NEAR ANAND MARKET), AMBALA CANTT-133001.

CORPORATE IDENTITY NO. : U60232DL2006GGI155068

ENGINEER:

DB Engineering & Consulting GmbH

Deutsche Bahn Engineering & Consulting GmbH

CONTRACTOR:

GIL - TPL JV

GAR TATA

SUBMITTED BY	GIL - TPL JV		
	DATED	NAME	SIGNATURE
PREPARED BY			
CHECKED BY	27.08.2024	VIJAY PRATAP	
APPROVED BY	27.08.2024	PARASURAM KOTYADA	



APPROVED BY	DEUTSCHE BAHN ENGINEERING & CONSULTING GMBH		
	DATED	NAME	SIGNATURE
Sr. DE./CHIEF ENGINEER		SURESH K.YALANGI	
CHIEF TRACK ENGINEER		RAJ PAL SINGH	
T.L.		H.D. VIDJAK	

STAMP

A AS-BUILT DRAWING
TR. Ref.:.....
ENGINEER Sign.:.....

EMPLOYER (DFCCIL): DEDICATED FREIGHT CORRIDOR CORPORATION OF INDIA LTD.

AS BUILT DRAWING		
TITLE	AS-BUILT PLAN AND PROFILE	DFCC APPR. NO. -
	FROM IR KM: 294.000 TO 294.500	ENGG. APPR. NO. -
	DFC KM: 1183.489 TO 1183.989	DRG. NO. - 301-2/AL/A/1214
		SHEET NO. : 1 OF 1
		DATE : 27.08.2024
		STATUS
		A

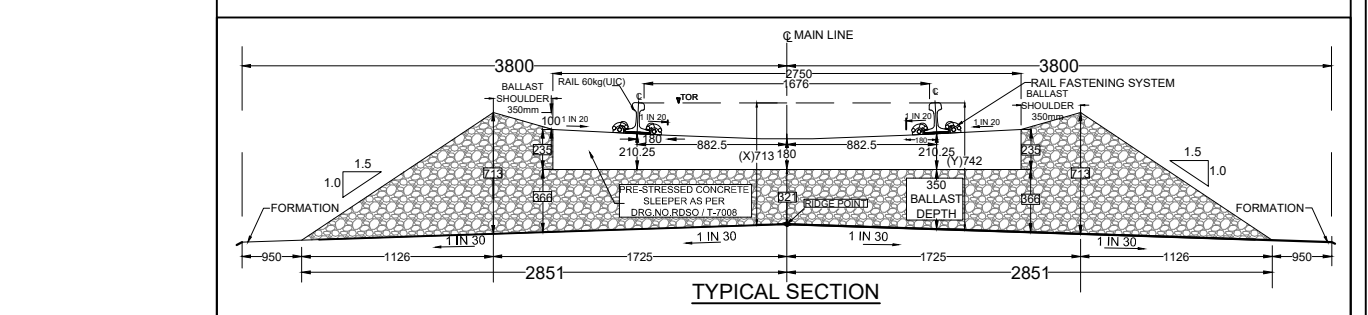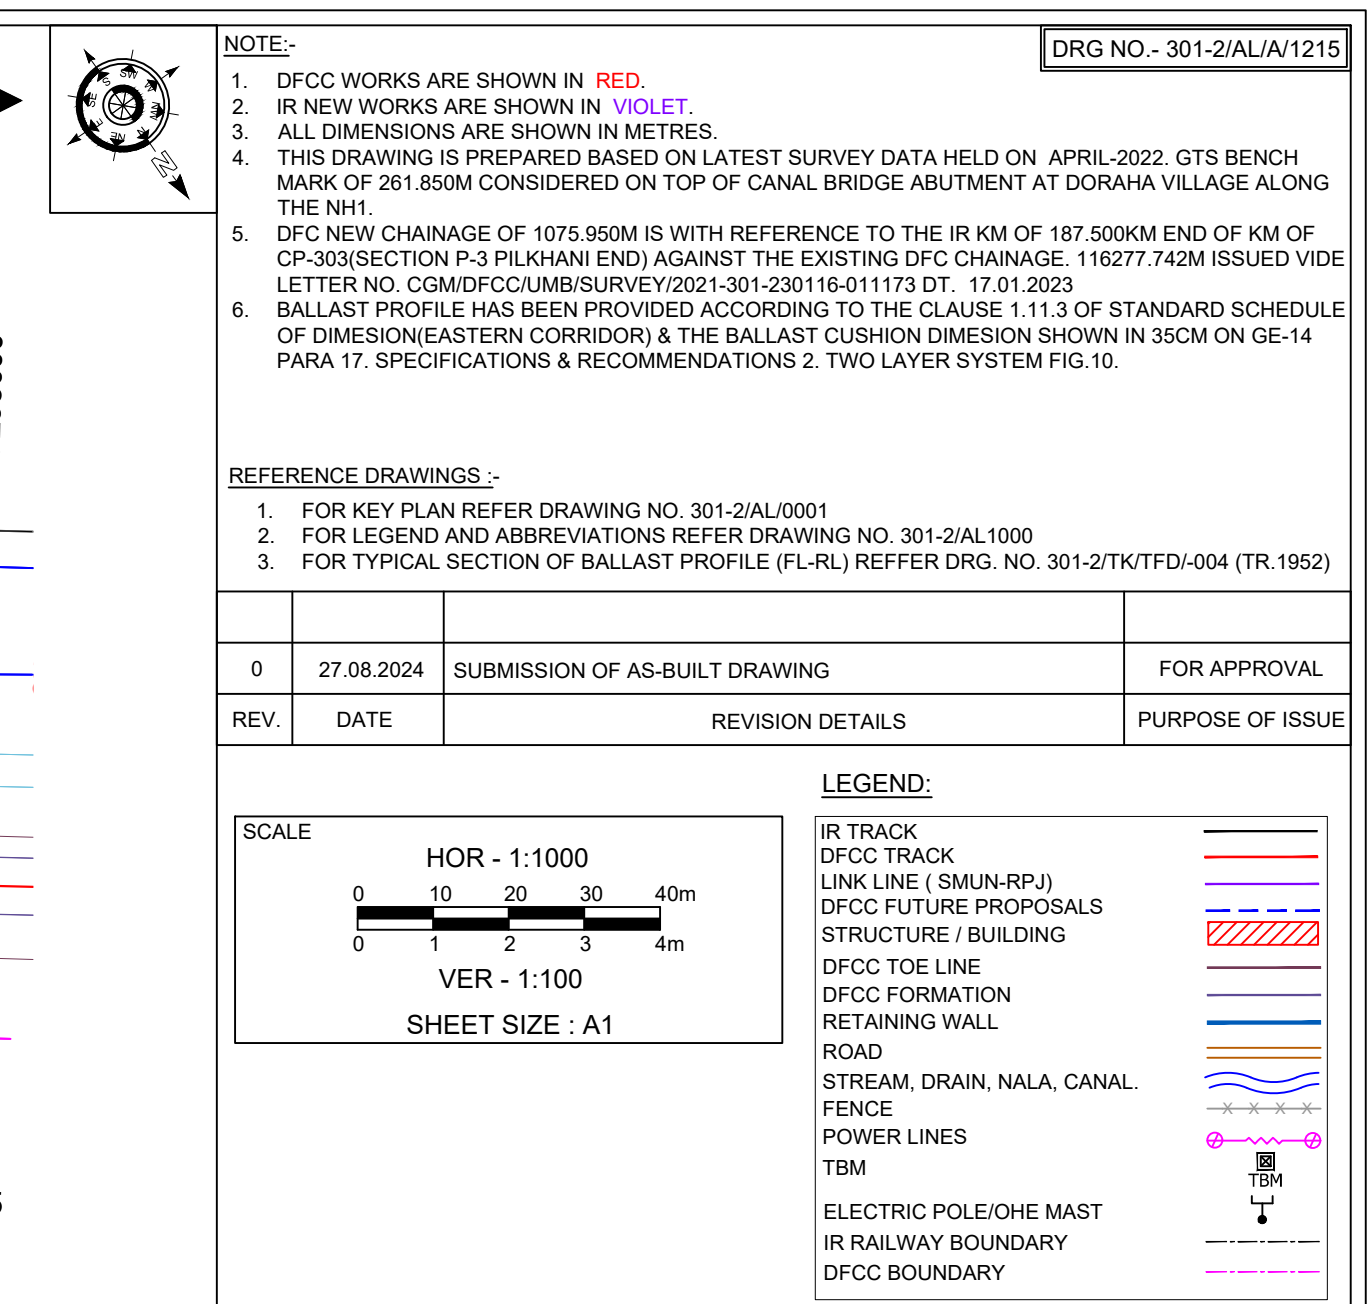

TRACK STRUCTURE		
RAIL SECTION: 60Kg/m (UIC 60Kg/m) DFC LINE: 60Kg/m (UIC 60Kg/m) IR MAIN LINE: 52Kg/m	Difference between FL- RL (Below Rail Seat)	
	IR Line	DFC
	172mm	172mm
RUBBER PAD	6mm	10mm
SLEEPER DEPTH	210mm	210mm
BALLAST CUSHION	300mm	350mm
Total Depth (FL TO RL)	688mm	742mm

OWNER 	DEDICATED FREIGHT CORRIDOR CORPORATION OF INDIA LTD. (A GOVERNMENT OF INDIA ENTERPRISE) PROJECT OFFICE/AMBALA UNIT: OLD RAILWAY COLONY (NEAR ANAND MARKET)/AMBALA CANTT-133001. CORPORATE IDENTITY NO.: U60232DL2006GH155068
--	---

ENGINEER:

 **DB Engineering & Consulting GmbH**
Deutsche Bahn Engineering & Consulting GmbH

CONTRACTOR:	GIL - TPL JV
	 


SUBMITTED BY	GIL - TPL JV		
	DATED	NAME	SIGNATURE
PREPARED BY			
CHECKED BY	27.08.2024	VIJAY PRATAP	
APPROVED BY	27.08.2024	PARASURAM KOTYADA	

APPROVED BY	DEUTSCHE BAHN ENGINEERING & CONSULTING GMBH		
	DATED	NAME	SIGNATURE
Sr. DE./CHIEF ENGINEER		SURESH K.YALANGI	
CHIEF TRACK ENGINEER		RAJ PAL SINGH	
T.L.		H.D. VIDJAK	

STAMP	A AS-BUILT DRAWING TR. Ref..... ENGINEER Sign.:		
EMPLOYER (DFCCIL):	DEDICATED FREIGHT CORRIDOR CORPORATION OF INDIA LTD.		

AS BUILT DRAWING			
TITLE AS-BUILT PLAN AND PROFILE FROM IR KM: 294.500 TO 295.000 DFC KM: 1183.989 TO 1184.489	DFCC APPR. NO. - ENGG. APPR. NO. -		
	DRG. NO. -301-2/AL/A/1215		
	SHEET NO. : 1 OF 1		STATUS A
	DATE : 27.08.2024		

TR

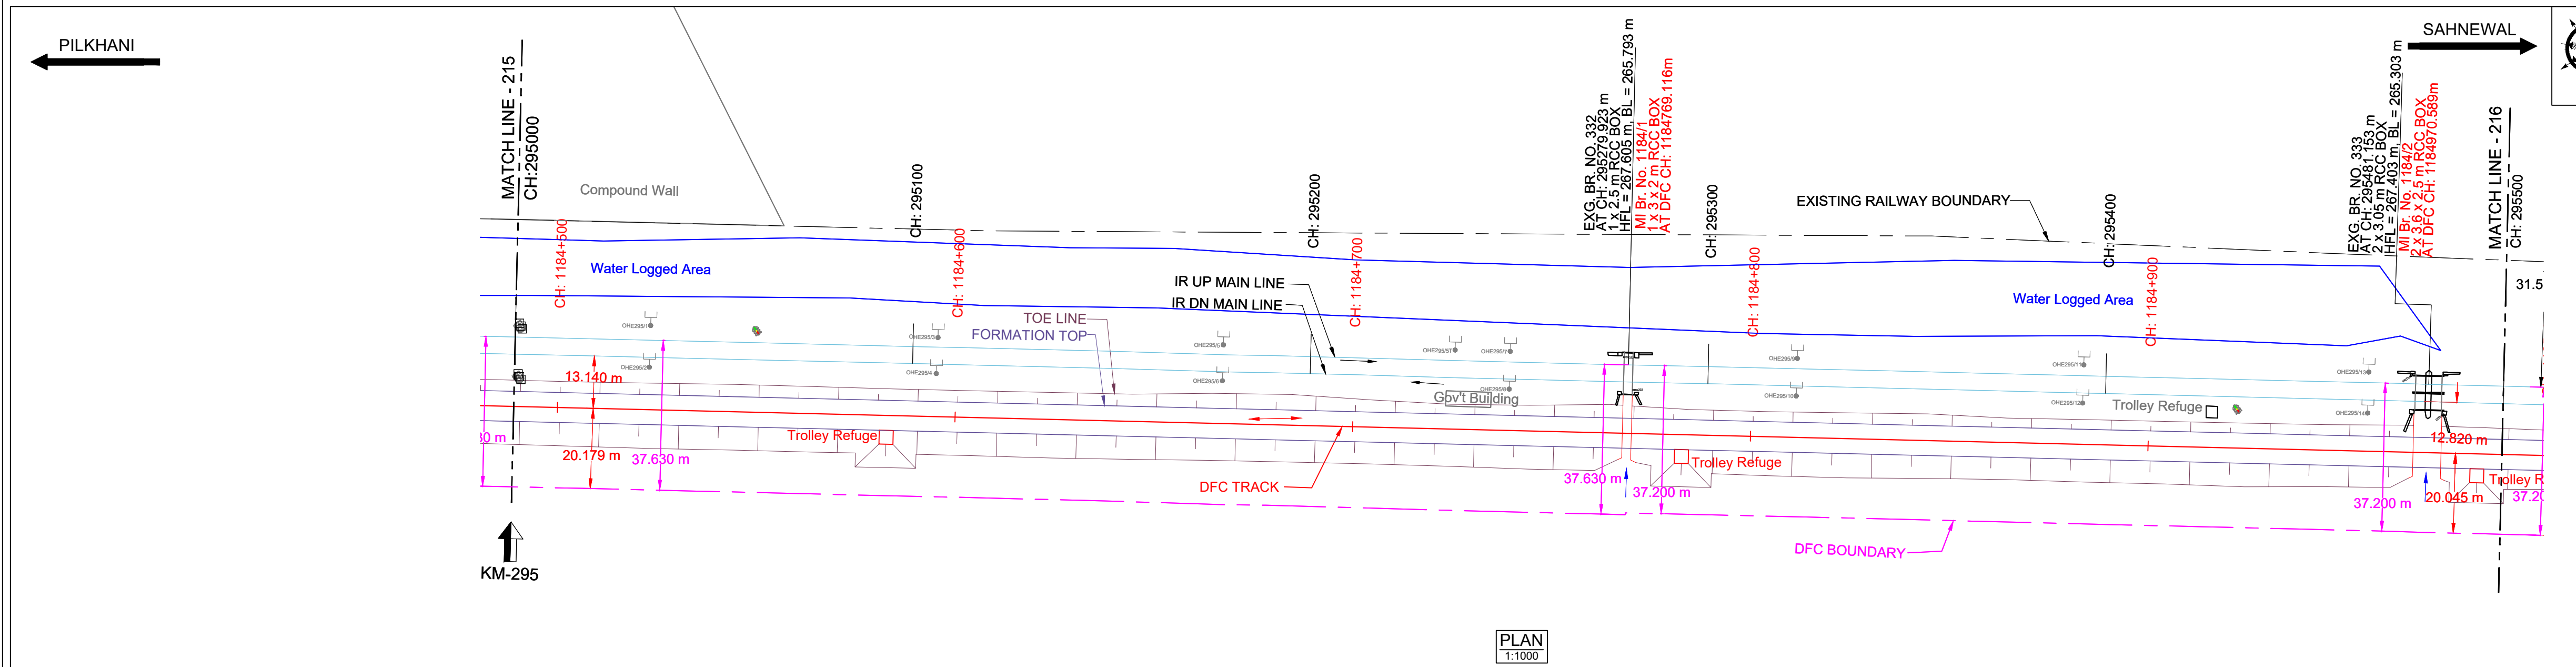

DATUM ABOVE MSL : 260 m

HORIZONTAL ALIGNMENT	L = 5898.430m																									
VERTICAL ALIGNMENT	L=1883.2 m LEVEL																									
TRACK DISTANCE FROM EXISTING NEAREST IR DN MAIN LINE TO DFC MAIN LINE	13.124	13.140	13.147	13.154	13.165	13.177	13.177	13.162	13.092	12.978	13.072	13.026	12.918	12.896	12.893	12.938	12.932	12.914	12.905	12.896	12.886	12.870	12.853	12.820	12.756	
HEIGHT OF BANKING(+)/ DEPTH OF CUTTING(-) (PFL-GL)	+3.024	+3.054	+3.057	+3.052	+3.050	+3.005	+2.986	+2.985	+2.899	+2.849	+2.866	+2.878	+2.937	+3.034	+3.042	+3.071	+2.989	+2.997	+2.854	+2.734	+2.806	+2.958	+2.895	+2.698	+2.551	
EXG GROUND LEVEL AT CENTER LINE OF DFC TRACK (GL)	265.624	265.594	265.591	265.596	265.598	265.643	265.662	265.663	265.749	265.766	265.790	265.770	265.711	265.828	265.806	265.602	265.659	265.651	265.691	265.794	265.842	265.690	265.950	266.030	266.097	
EXG GROUND LEVEL AT TOE LOCATION OF DFC TRACK	265.650	265.587	265.563	265.596	265.591	265.613	265.609	265.583	265.672	265.706	265.790	265.778	265.709	265.828	265.806	265.602	265.659	265.651	265.691	265.794	265.842	265.690	265.950	266.030	266.097	
DIFFERENCE BETWEEN DFC FORMATION LEVEL AND EXG.FORMATION LEVEL (PFL-EFL)	0.817	0.815	0.790	0.765	0.784	0.807	0.784	0.769	0.790	0.787	0.759	0.712	0.655	0.657	0.643	0.586	0.597	0.624	0.631	0.630	0.635	0.651	0.672	0.693	0.694	
DFC FORMATION LEVEL (PFL)	268.648	268.648	EXG. FORMATION LEVEL OF EXG IR DN MAIN LINE (EFL)	267.831	267.833	267.858	267.883	267.864	267.841	267.864	267.859	267.858	267.861	267.889	267.936	267.993	267.991	268.005	268.062	268.051	268.024	268.017	268.018	268.013	267.997	267.955	267.935	267.954	
DIFFERENCE BETWEEN DFC RAIL LEVEL AND EXG. RAIL LEVEL (PRL - ERL)	0.842	0.840	0.815	0.790	0.809	0.832	0.809	0.814	0.815	0.812	0.784	0.737	0.680	0.682	0.668	0.611	0.622	0.649	0.656	0.655	0.660	0.676	0.718	0.738	0.719	
DFC RAIL LEVEL (PRL)	269.361	269.361	EXG.RAIL LEVEL OF NEAREST IR DN MAIN LINE(ERL)	268.519	268.521	268.546	268.571	268.552	268.529	268.552	268.547	268.546	268.549	268.577	268.624	268.681	268.679	268.693	268.750	268.739	268.712	268.705	268.706	268.701	268.685	268.643	268.623	268.642	
EQUIVALENT CHAINAGE ON DFC TRACK	-1184.489.2	-1184.509.2	-1184.529.2	-1184.549.2	-1184.569.2	-1184.589.2	-1184.609.2	-1184.629.2	-1184.649.1	-1184.669.2	-1184.689.2	-1184.709.1	-1184.729.2	-1184.749.2	-1184.769.2	-1184.789.2	-1184.809.2	-1184.829.2	-1184.849.2	-1184.869.2	-1184.889.2	-1184.909.2	-1184.929.2	-1184.949.2	-1184.969.1	
EXISTING IR CHAINAGE	295000.0	295020.0	295040.0	295060.0	295080.0	295100.0	295120.0	295140.0	295160.0	295180.0	295200.0	295220.0	295240.0	295260.0	295280.0	295300.0	295320.0	295340.0	295360.0	295380.0	295400.0	295420.0	295440.0	295460.0	295480.0	295500.0

L - SECTION

NOTE:-
1. DFC WORKS ARE SHOWN IN RED.
2. IR NEW WORKS ARE SHOWN IN VIOLET.
3. ALL DIMENSIONS ARE SHOWN IN METRES.
4. THIS DRAWING IS PREPARED BASED ON LATEST SURVEY DATA HELD ON APRIL-2022. GTS BENCH MARK OF 261.850M CONSIDERED ON TOP OF CANAL BRIDGE ABUTMENT AT DORAHA VILLAGE ALONG THE NH1.
5. DFC NEW CHAINAGE OF 1075.950M IS WITH REFERENCE TO THE IR KM OF 187.500KM END OF KM OF CP-303(SECTION P-3 PILKHANI END) AGAINST THE EXISTING DFC CHAINAGE. 116277.742M ISSUED VIDE LETTER NO. COM/DFCC/UMS/SURVEY/2021-301-230116-011173 DT. 17.01.2023.
6. BALLAST PROFILE HAS BEEN PROVIDED ACCORDING TO THE CLAUSE 1.11.3 OF STANDARD SCHEDULE OF DIMENSION(EASTERN CORRIDOR) & THE BALLAST CUSHION DIMENSION SHOWN IN 35CM ON GE-14 PARA 17. SPECIFICATIONS & RECOMMENDATIONS 2. TWO LAYER SYSTEM FIG.10.


REFERENCE DRAWINGS :-
1. FOR KEY PLAN REFER DRAWING NO. 301-2/AL/0001
2. FOR LEGEND AND ABBREVIATIONS REFER DRAWING NO. 301-2/AL/1000
3. FOR TYPICAL SECTION OF BALLAST PROFILE (FL-RL) REFER DRG. NO. 301-2/TK/TFD/-004 (TR.1952)

027.08.2024SUBMISSION OF AS-BUILT DRAWINGFOR APPROVAL

REV. DATE REVISION DETAILS PURPOSE OF ISSUE

SCALE
HOR - 1:1000
VER - 1:100
SHEET SIZE : A1

LEGEND:
IR TRACK
DFCC TRACK
LINK LINE (SMUN-RP-J)
DFCC FUTURE PROPOSALS
STRUCTURE / BUILDING
DFCC TOE LINE
DFCC FORMATION
RETAINING WALL
ROAD
STREAM, DRAIN, NALA, CANAL.
FENCE
POWER LINES
TBM
ELECTRIC POLE/OHE MAST
IR RAILWAY BOUNDARY
DFCC BOUNDARY

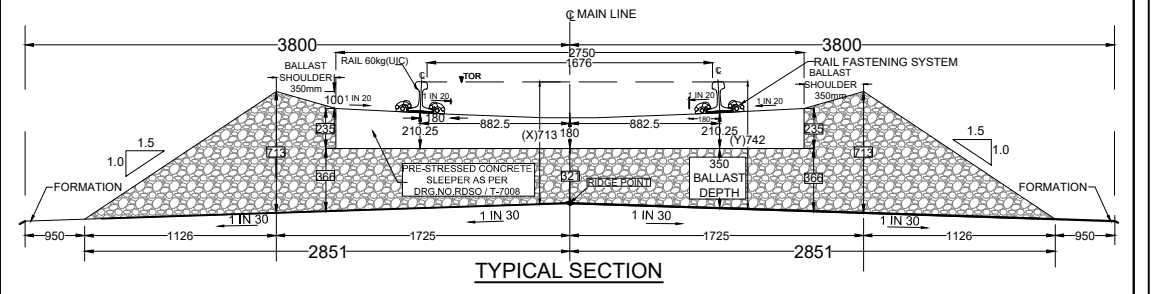

TRACK STRUCTURE		
RAIL SECTION: 60Kg/m (UIC 60Kg/m) DFC LINE: 60Kg/m (UIC 60Kg/m) IR MAIN LINE: 52Kg/m	Difference between FL- RL (Below Rail Seat)	
	IR Line	DFC
RUBBER PAD	172mm	172mm
SLEEPER DEPTH	6mm	10mm
BALLAST CUSHION	210mm	210mm
	300mm	350mm
Total Depth (FL TO RL)	688mm	742mm

OWNER
DEDICATED FREIGHT CORRIDOR CORPORATION OF INDIA LTD.
(A GOVERNMENT OF INDIA ENTERPRISE)
PROJECT OFFICE(AMBALA UNIT): OLD RAILWAY COLONY (NEAR ANAND MARKET),AMBALA CANTT-133001.
CORPORATE IDENTITY NO. : U60232DL2006GGI155068

ENGINEER:
DB Engineering & Consulting GmbH
Deutsche Bahn Engineering & Consulting GmbH

CONTRACTOR:
GIL - TPL JV
GAR TATA



SUBMITTED BY	GIL - TPL JV		
	DATED	NAME	SIGNATURE
PREPARED BY			
CHECKED BY	27.08.2024	VIJAY PRATAP	
APPROVED BY	27.08.2024	PARASURAM KOTYADA	
APPROVED BY	DEUTSCHE BAHN ENGINEERING & CONSULTING GMBH		
	DATED	NAME	SIGNATURE
Sr. DE./CHIEF ENGINEER		SURESH K.YALANGI	
CHIEF TRACK ENGINEER		RAJ PAL SINGH	
T.L.		H.D. VIDJAK	

STAMP
A AS-BUILT DRAWING
TR. Ref.:.....
ENGINEER Sign.:.....

EMPLOYER (DFCCIL): DEDICATED FREIGHT CORRIDOR CORPORATION OF INDIA LTD.

AS BUILT DRAWING		
TITLE AS-BUILT PLAN AND PROFILE	DFCC APPR. NO. - ENGG. APPR. NO. -	STATUS A
FROM IR KM: 295.000 TO 295.500 DFC KM: 1184.489 TO 1184.989	DRG. NO. -301-2/AL/A/1216 SHEET NO. : 1 OF 1 DATE : 27.08.2024	

TR.

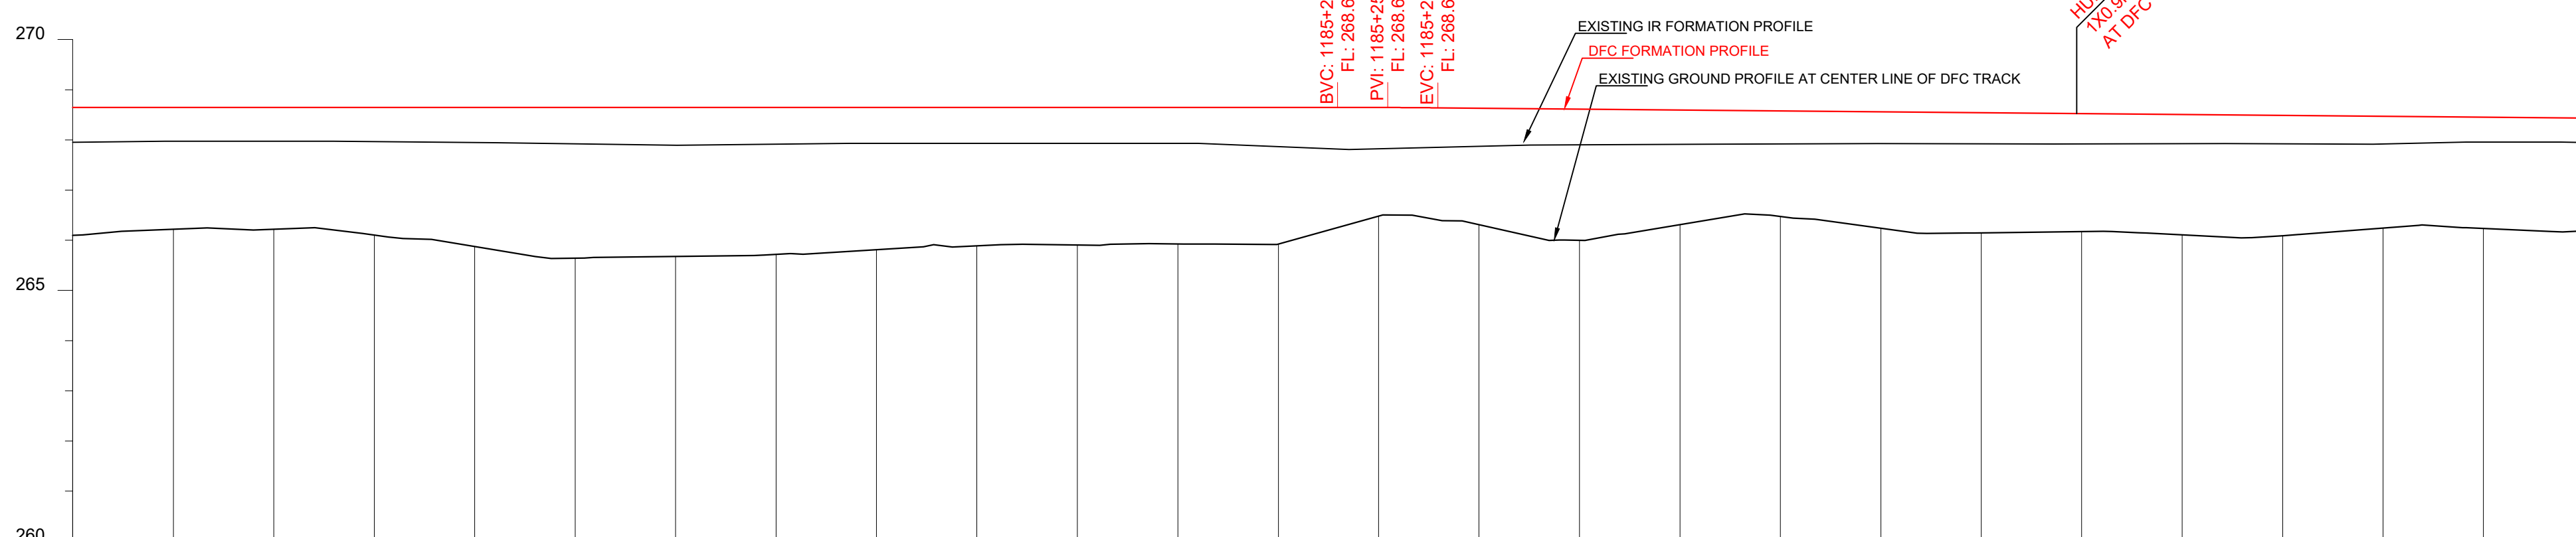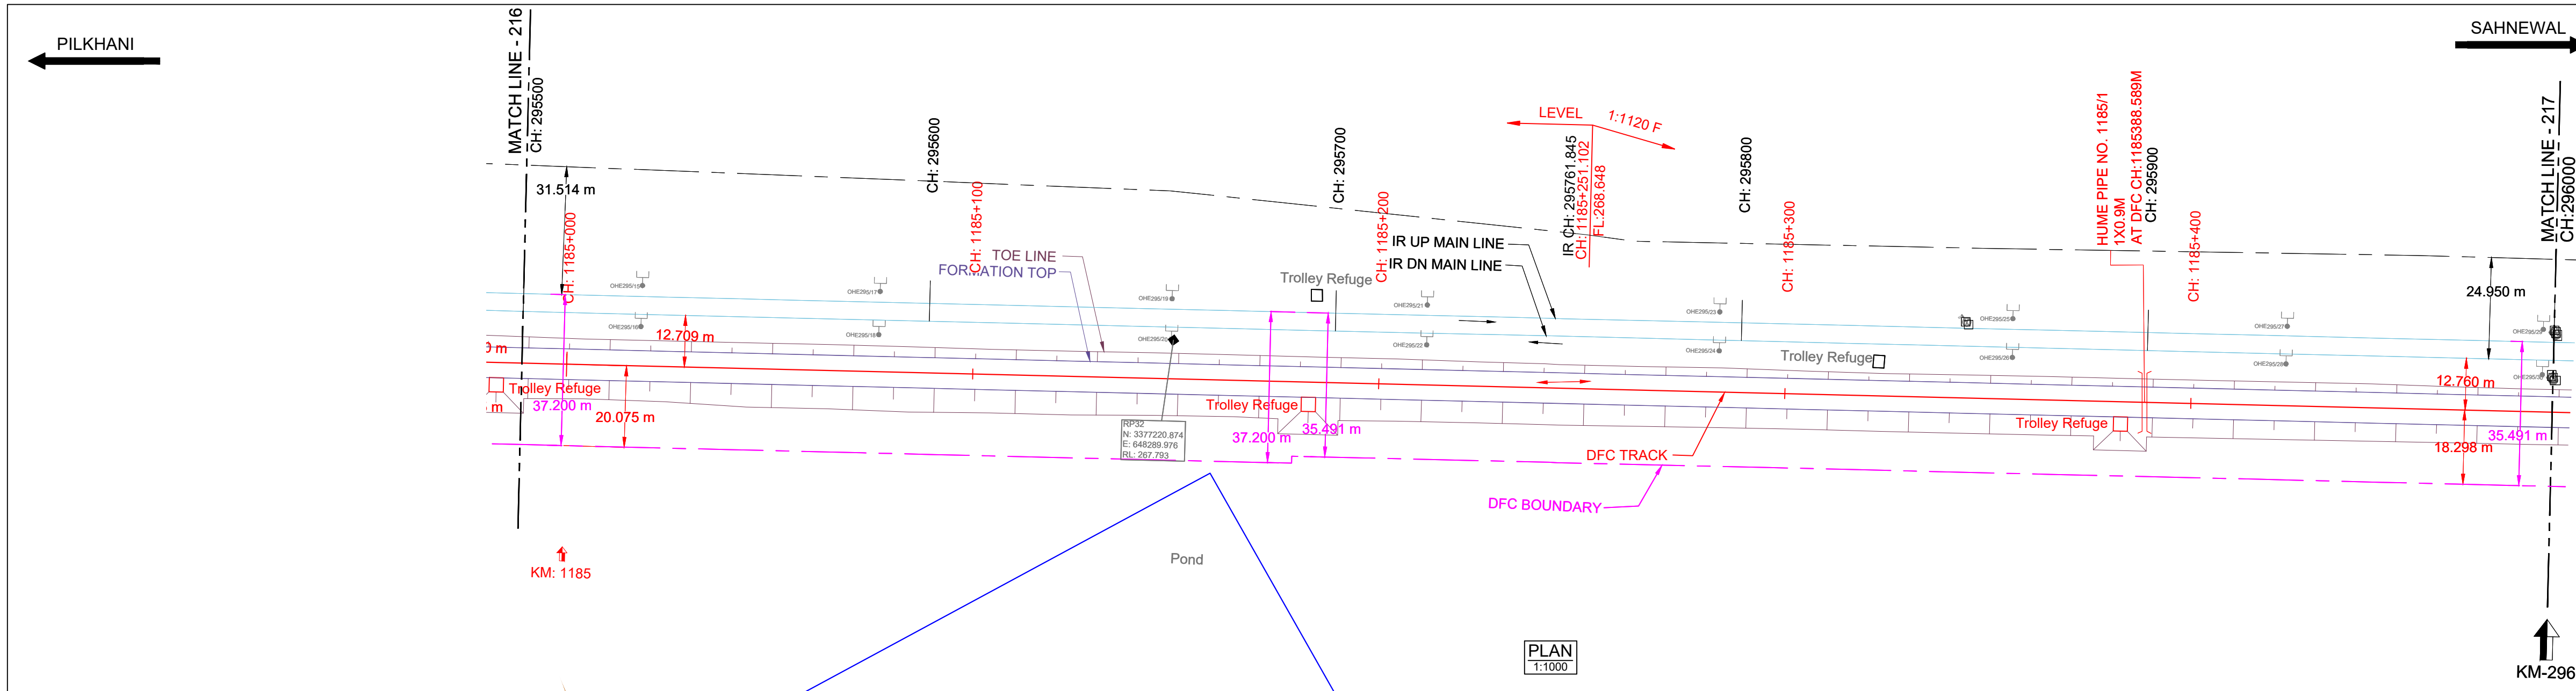

HORIZONTAL ALIGNMENT	L = 5898.430m																																									
VERTICAL ALIGNMENT	L=1883.2 m LEVEL																						L=20.0 m R=22395 m		L=1122.714 m 1 IN 1119.746 F																	
TRACK DISTANCE FROM EXISTING NEAREST IR DN MAIN LINE TO DFC MAIN LINE	12.756																																									
HEIGHT OF BANKING(+) / DEPTH OF CUTTING(-) (PFL-GL)	+2.551																																									
EXG GROUND LEVEL AT CENTER LINE OF DFC TRACK (GL)	266.097																																									
EXG GROUND LEVEL AT TOE LOCATION OF DFC TRACK	266.041																																									
DIFFERENCE BETWEEN DFC FORMATION LEVEL AND EXG.FORMATION LEVEL (PFL-EFL)	0.694																																									
DFC FORMATION LEVEL (PFL)	268.648																																									
EXG. FORMATION LEVEL OF EXG IR DN MAIN LINE (EFL)	267.954																																									
DIFFERENCE BETWEEN DFC RAIL LEVEL AND EXG. RAIL LEVEL (PRL - ERL)	0.719																																									
DFC RAIL LEVEL (PRL)	269.361																																									
EXG.RAIL LEVEL OF NEAREST IR DN MAIN LINE(ERL)	268.642																																									
EQUIVALENT CHAINAGE ON DFC TRACK	1184.989.2																																									
EXISTING IR CHAINAGE	295500.0																																									

L - SECTION

NOTE:-

- DFCC WORKS ARE SHOWN IN RED.
- IR NEW WORKS ARE SHOWN IN VIOLET.
- ALL DIMENSIONS ARE SHOWN IN METRES.
- THIS DRAWING IS PREPARED BASED ON LATEST SURVEY DATA HELD ON APRIL-2022. GTS BENCH MARK OF 261.850M CONSIDERED ON TOP OF CANAL BRIDGE ABUTMENT AT DORANA VILLAGE ALONG THE NH1.
- DFC NEW CHAINAGE OF 1075.950M IS WITH REFERENCE TO THE IR KM OF 187.500KM END OF KM OF CP-303(SECTION P-3 PILKHANI END) AGAINST THE EXISTING DFC CHAINAGE. 116277.742M ISSUED VIDE LETTER NO. COM/DFCC/UM/SURVEY/2021-301-2301/6-011173.DT. 17.01.2023.
- BALLAST PROFILE HAS BEEN PROVIDED ACCORDING TO THE CLAUSE 1.11.3 OF STANDARD SCHEDULE OF DIMENSION(EASTERN CORRIDOR) & THE BALLAST CUSHION DIMENSION SHOWN IN 35CM ON GE-14 PARA 17. SPECIFICATIONS & RECOMMENDATIONS 2. TWO LAYER SYSTEM FIG.10.

REFERENCE DRAWINGS :-

- FOR KEY PLAN REFER DRAWING NO. 301-2/AL/0001
- FOR LEGEND AND ABBREVIATIONS REFER DRAWING NO. 301-2/AL/1000
- FOR TYPICAL SECTION OF BALLAST PROFILE (FL-RL) REFER DRG. NO. 301-2/TK/TFD/-004 (TR.1952)

LEGEND:

IR TRACK
DFCC TRACK
LINK LINE (SMUN-RP-J)
DFCC FUTURE PROPOSALS
STRUCTURE / BUILDING
DFCC TOE LINE
DFCC FORMATION
RETAINING WALL
ROAD
STREAM, DRAIN, NALA, CANAL.
FENCE
POWER LINES
TBM
ELECTRIC POLE/OHE MAST
IR RAILWAY BOUNDARY
DFCC BOUNDARY

SCALE

HOR - 1:1000

VER - 1:100

SHEET SIZE : A1

TYPICAL SECTION

TRACK STRUCTURE	
RAIL SECTION: 60Kg/m (UIC 60Kg/m) DFC LINE: 60Kg/m (UIC 60Kg/m) IR MAIN LINE: 52Kg/m	Difference between FL - RL (Below Rail Seat)
	IR Line DFC
	172mm 172mm
RUBBER PAD	6mm 10mm
SLEEPER DEPTH	210mm 210mm
BALLAST CUSHION	300mm 350mm
Total Depth (FL TO RL)	688mm 742mm

OWNER

DEDICATED FREIGHT CORRIDOR CORPORATION OF INDIA LTD.

(A GOVERNMENT OF INDIA ENTERPRISE)

PROJECT OFFICE (AMBALA UNIT): OLD RAILWAY COLONY (NEAR ANAND MARKET), AMBALA CANTT-133001.

CORPORATE IDENTITY NO. : U60232DL20060G01155068

ENGINEER:

DB Engineering & Consulting GmbH

Deutsche Bahn Engineering & Consulting GmbH

CONTRACTOR:

GIL - TPL JV

GAR TATA

SUBMITTED BY	GIL - TPL JV		
	DATED	NAME	SIGNATURE
PREPARED BY			
CHECKED BY	27.08.2024	VIJAY PRATAP	
APPROVED BY	27.08.2024	PARASURAM KOTYADA	

APPROVED BY	DEUTSCHE BAHN ENGINEERING & CONSULTING GMBH		
	DATED	NAME	SIGNATURE
Sr. DE./CHIEF ENGINEER		SURESH K.YALANGI	
CHIEF TRACK ENGINEER		RAJ PAL SINGH	
T.L.		H.D. VIDJAK	

STAMP

A AS-BUILT DRAWING TR. Ref.:..... ENGINEER Sign.:.....

EMPLOYER (DFCCIL): DEDICATED FREIGHT CORRIDOR CORPORATION OF INDIA LTD.

AS BUILT DRAWING

TITLE


AS-BUILT PLAN AND PROFILE

FROM IR KM: 295.500 TO 296.000
DFC KM: 1184.989 TO 1185.489

DFCC APPR. NO. -
ENGG. APPR. NO. -
DRG. NO. - 301-2/AL/A/1217
SHEET NO. : 1 OF 1
DATE : 27.08.2024

STATUS
A



TR.

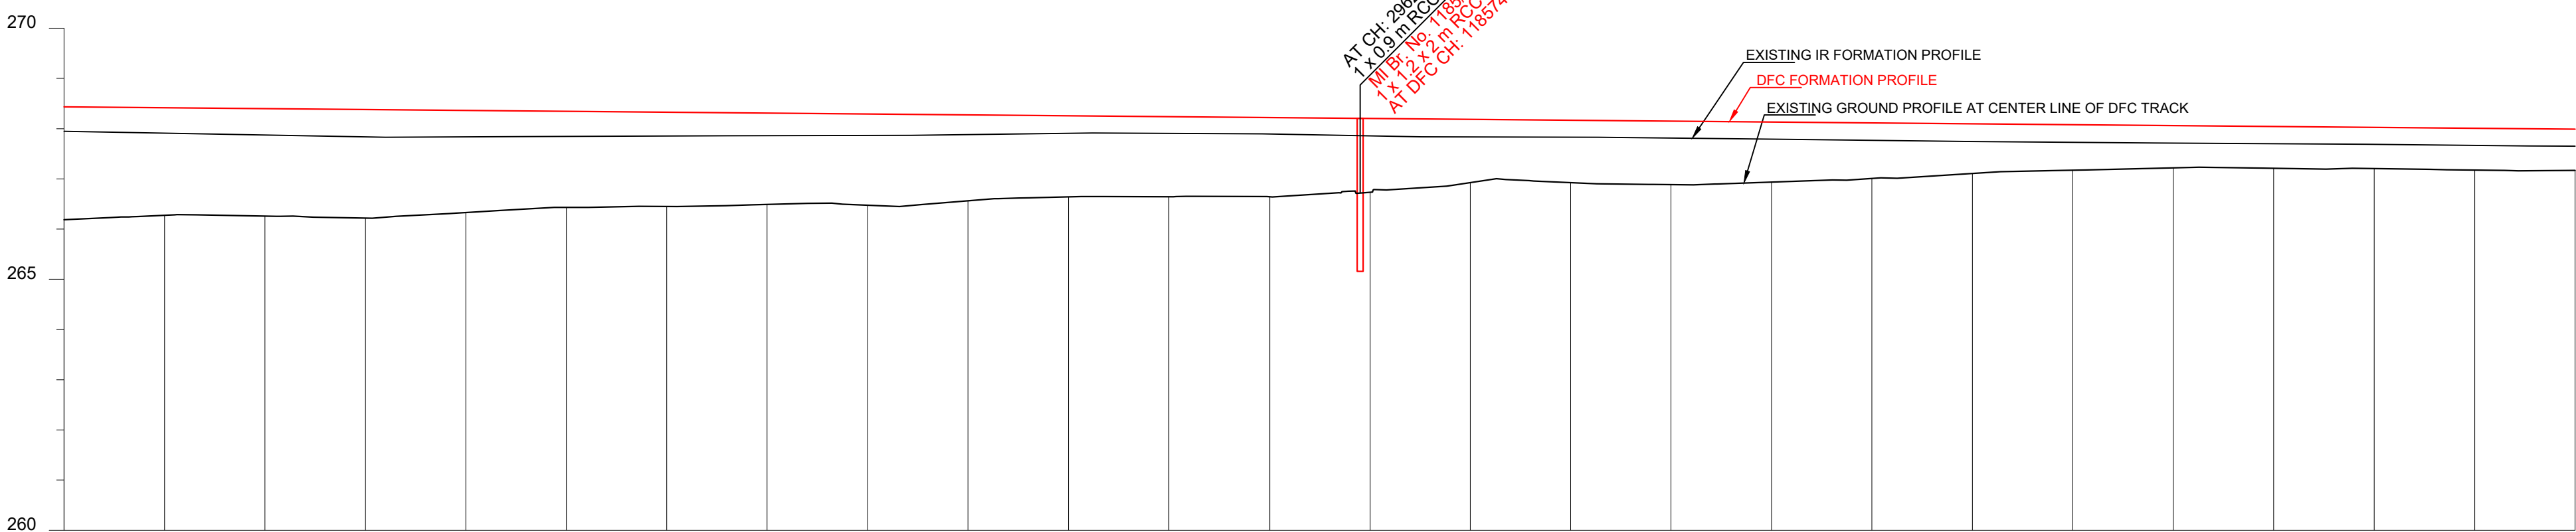


DATUM ABOVE MSL : 260 m

HORIZONTAL ALIGNMENT	L = 5898.430m																							
VERTICAL ALIGNMENT	L=1122.714 m 1 IN 1119.746 F																							
TRACK DISTANCE FROM EXISTING NEAREST IR DN MAIN LINE TO DFC MAIN LINE	-12.761	-12.761	-12.764	-12.767	-12.771	-12.751	-12.738	-12.728	-12.719	-12.712	-12.706	-12.710	-12.835	-12.892	-12.878	-12.863	-12.848	-12.830	-12.813	-12.805	-12.789	-12.776	-12.791	-12.792
HEIGHT OF BANKING(+) / DEPTH OF CUTTING(-) (PFL-GL)	+2.249	+2.249	+2.141	+2.141	+2.165	+2.036	+1.915	+1.817	+1.712	+1.615	+1.583	+1.575	+1.468	+1.260	+1.264	+1.264	+1.198	+1.106	+0.986	+0.842	+0.832	+0.819	+0.833	+0.821
EXG GROUND LEVEL AT CENTER LINE OF DFC TRACK (GL)	266.186	266.186	266.276	266.259	266.217	266.328	266.431	266.475	266.563	266.642	266.646	266.646	266.735	266.925	266.924	266.886	266.936	267.008	267.110	267.173	267.218	267.205	267.174	267.168
EXG GROUND LEVEL AT TOE LOCATION OF DFC TRACK	266.188	266.188	266.241	266.261	266.286	266.370	266.462	266.508	266.551	266.626	266.644	266.646	266.878	266.938	266.924	266.886	266.870	266.874	266.892	267.030	267.039	267.030	267.046	267.023
DIFFERENCE BETWEEN DFC FORMATION LEVEL AND EXG FORMATION LEVEL (PFL-EFL)	0.485	0.485	0.504	0.525	0.544	0.527	0.501	0.427	0.393	0.349	0.333	0.327	0.347	0.351	0.337	0.337	0.341	0.347	0.351	0.349	0.346	0.338	0.341	0.337
DFC FORMATION LEVEL (PFL)	268.435	268.435	268.417	268.400	268.382	268.364	268.348	268.292	268.275	268.257	268.239	268.221	268.203	268.185	268.150	268.132	268.114	268.096	268.078	268.060	268.042	268.024	268.007	267.989
EXG FORMATION LEVEL OF EXG IR DN MAIN LINE (EFL)	267.950	267.950	267.913	267.875	267.838	267.837	267.845	267.865	267.882	267.908	267.906	267.894	267.856	267.834	267.813	267.791	267.767	267.745	267.729	267.714	267.701	267.686	267.666	267.652
DIFFERENCE BETWEEN DFC RAIL LEVEL AND EXG RAIL LEVEL (PRL - ERL)	0.511	0.511	0.530	0.549	0.568	0.552	0.526	0.452	0.418	0.374	0.358	0.352	0.372	0.376	0.361	0.366	0.371	0.376	0.374	0.371	0.363	0.366	0.362	0.362
DFC RAIL LEVEL (PRL)	269.148	269.148	269.131	269.113	269.095	269.077	269.059	269.006	268.988	268.970	268.952	268.934	268.916	268.898	268.863	268.845	268.827	268.809	268.791	268.773	268.755	268.738	268.720	268.702
EXG RAIL LEVEL OF NEAREST IR DN MAIN LINE (ERL)	268.638	268.638	268.601	268.563	268.526	268.525	268.533	268.553	268.570	268.596	268.594	268.582	268.544	268.522	268.501	268.479	268.455	268.433	268.417	268.402	268.389	268.374	268.354	268.340
EQUIVALENT CHAINAGE ON DFC TRACK	-1185489.2	-1185489.2	-1185509.2	-1185529.2	-1185549.2	-1185569.2	-1185589.2	-1185609.2	-1185629.2	-1185649.2	-1185669.2	-1185689.2	-1185709.2	-1185729.2	-1185749.2	-1185769.2	-1185789.2	-1185809.2	-1185829.2	-1185849.2	-1185869.2	-1185889.2	-1185909.2	-1185929.2
EXISTING IR CHAINAGE	296000.0	296000.0	296002.0	296004.0	296006.0	296008.0	296010.0	296012.0	296014.0	296016.0	296018.0	296020.0	296022.0	296024.0	296026.0	296028.0	296030.0	296032.0	296034.0	296036.0	296038.0	296040.0	296042.0	296044.0

L - SECTION

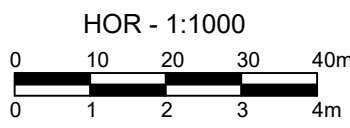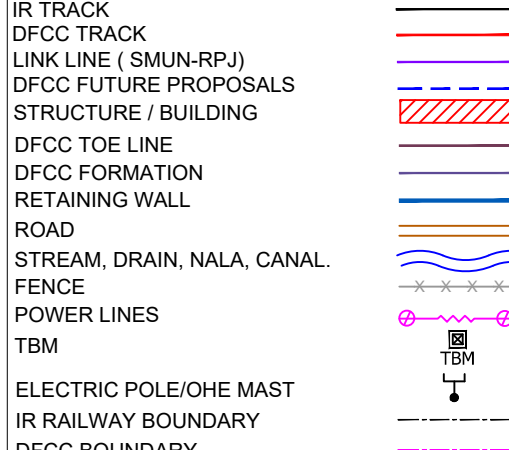NOTE:		DRG NO.- 301-2/AL/02	
	- DCCC WORKS ARE SHOWN IN RED. - IR NEW WORKS ARE SHOWN IN VIOLET. - ALL DIMENSIONS ARE GIVEN IN METRES. - THIS DRAWING IS PREPARED BASED ON LATEST SURVEY DATA HELD ON APRIL-2022. GTS BENCH MARK OF 261.850M CONSIDERED ON TOP OF CANAL BRIDGE ABUTMENT AT DORAHA VILLAGE ALONG THE NH1. - D/C NEW CHAINAGE OF 1075.950M IS WITH REFERENCE TO THE IR KM OF 187.500KM END OF KM OF CP-303(SECTION P-2 PILKHAJI END) AGAINST THE EXISTING D/C CHAINAGE. 116277.742M ISSUED VIDEO LETTER NO. CGMDFFCCUMB/SURVEY2021-301-230116-111173 DT. 17.01.2023 - BALLAST PROFILE HAS BEEN PROVIDED ACCORDING TO THE CLAUSE 1.11.3 OF STANDARD SCHEDULE OF DIMENSION(EASTERN CORRIDOR) & THE BALLAST CUSHION DIMENSION SHOWN IN 35CM ON GE-14 PARA 17, SPECIFICATIONS & RECOMMENDATIONS 2. TWO LAYER SYSTEM FIG.10.		
REFERENCE DRAWINGS :-	- FOR KEY PLAN REFER DRAWING NO. 301-2/AL/0001 - FOR LEGEND AND ABBREVIATIONS REFER DRAWING NO. 301-2/AL/1000 - FOR PORTAL SECTION OF BALLAST PROFILE (FL-RL) REFER DRG. NO. 301-2/TX(TFD)-004 (TR.1952)		
REV.	DATE	REVISION DETAILS	PURPOSE OF ISSUE
0	27.08.2024	SUBMISSION OF AS-BUILT DRAWING	FOR APPROVAL
SCALE  HOR - 1:1000 VER - 1:100 SHEET SIZE : A1		LEGEND: 	

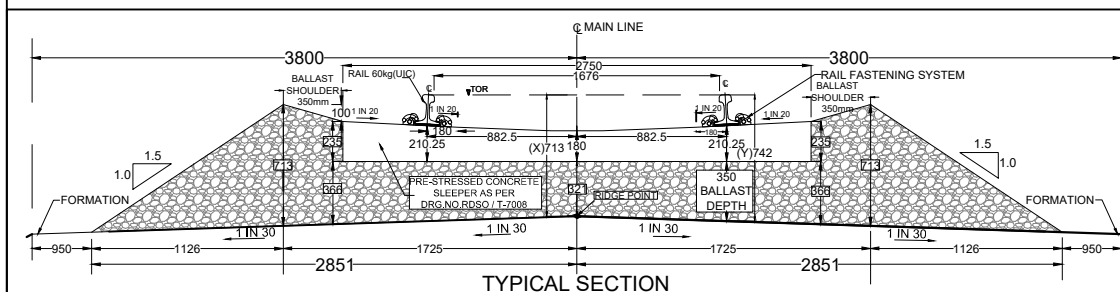

TRACK STRUCTURE		
RAIL SECTION: 60Kg/m (UIC 60Kg/m) DFC LINE: 60Kg/m (UIC 60Kg/m) IR MAIN LINE :52Kg/m	Difference between FL- RL (Below Rail Seat)	
	IR Line	DFC
	172mm	172mm
RUBBER PAD	6mm	10mm
SLEEPER DEPTH	210mm	210mm
BALLAST CUSHION	300mm	350mm
Total Depth (FL TO RL)	688mm	742mm

OWNER



डेडीकेटेड फ्रेट कॉरिडोर

DEDICATED FREIGHT CORRIDOR CORPORATION OF INDIA LTD.
(A GOVERNMENT OF INDIA ENTERPRISE)
PROJECT OFFICE(AMBALA UNIT): OLD RAILWAY COLONY (NEAR
ANAND MARKET),AMBALA CANTT-133001.
CORPORATE IDENTITY NO. : U60232DL200301155068

ENGINEER:

 DB Engineering & Consulting GmbH
Deutsche Bahn Engineering & Consulting GmbH

CONTRACTOR: GIL - TPL JV

SUBMITTED BY	GIL - TPL JV		
	DATED	NAME	SIGNATURE
PREPARED BY			
CHECKED BY	27.08.2024	VIJAY PRATAP	
APPROVED BY	27.08.2024	PARASURAM KOTYADA	

APPROVED BY	DEUTSCHE BAHN ENGINEERING & CONSULTING GMBH		
	DATED	NAME	SIGNATURE
Sr. DE./CHIEF ENGINEER		SURESH K.YALANGI	
CHIEF TRACK ENGINEER		RAJ PAL SINGH	
T.L.		H.D. VIDJAK	

--	---

STAMP	A AS-BUILT DRAWING TR. Ref..... ENGINEER Sign.:
-------	---

EMPLOYER (DEOCL):	REDIANT FREIGHT CORRIDOR CORPORATION OF INDIA LTD

EMPLOYER (DFCCIL)	DEDICATED FREIGHT CORRIDOR CORPORATION OF INDIA LTD.		

--	--	--	--

--	--	--	--

--	--	--	--

AS BUILT DRAWING


TITLE	DFCC APPR. NO. -
-------	------------------

AS-BUILT PLAN AND PROFILE	ENGG. APPR. NO. -
FROM CH. KM. 339.333 TO 339.533	DRG. NO. - 301-2/AL/A/1218



FROM IR KM: 296.000 TO 296.500	SHEET NO.: 1 OF 1	STATUS
DFC KM: 1185.489 TO 1185.989		A

	DATE : 27.08.2024	A
		TR.

TR.

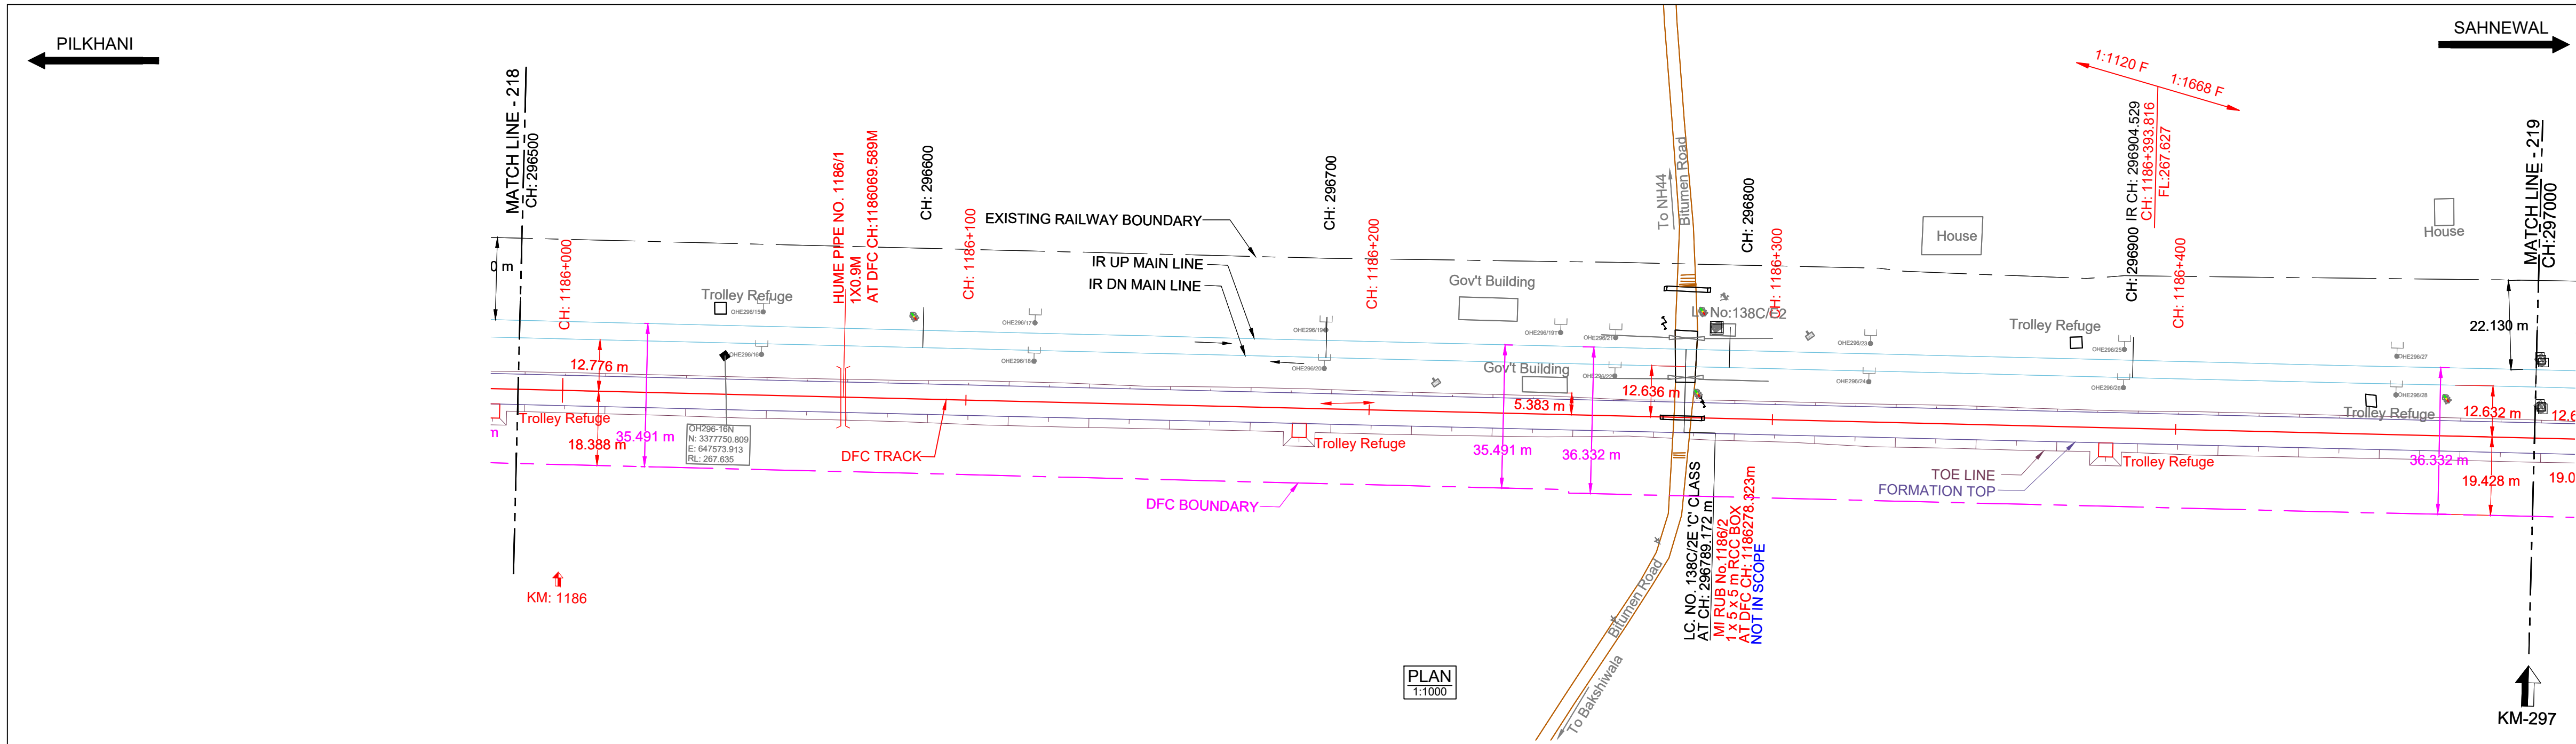


HORIZONTAL ALIGNMENT		L = 5898.430m	
VERTICAL ALIGNMENT		L=1122.714 m 1 IN 119.746 F	
TRACK DISTANCE FROM EXISTING NEAREST IR DN MAIN LINE TO DFC MAIN LINE		L=20.0 m R=68129.68 m	
HEIGHT OF BANKING(+) / DEPTH OF CUTTING(-) (PFL-GL)		L=1575.274 m 1 IN 1668 F	
EXG GROUND LEVEL AT CENTER LINE OF DFC TRACK (GL)	267.168	267.147	267.085
EXG GROUND LEVEL AT TOE LOCATION OF DFC TRACK	267.023	266.968	266.847
DIFFERENCE BETWEEN DFC FORMATION LEVEL AND EXG.FORMATION LEVEL (PFL-EFL)	0.337	0.325	0.314
DFC FORMATION LEVEL (PFL)	267.969	267.971	267.953
EXG. FORMATION LEVEL OF EXG IR DN MAIN LINE (EFL)	267.652	267.646	267.639
DIFFERENCE BETWEEN DFC RAIL LEVEL AND EXG. RAIL LEVEL (PRL - ERL)	0.362	0.350	0.339
DFC RAIL LEVEL (PRL)	268.702	268.684	268.666
EXG.RAIL LEVEL OF NEAREST IR DN MAIN LINE(ERL)	268.340	268.334	268.327
EQUIVALENT CHAINAGE ON DFC TRACK	296500.0	296520.0	296540.0
EXISTING IR CHAINAGE	1185.989	1186.009	1186.029

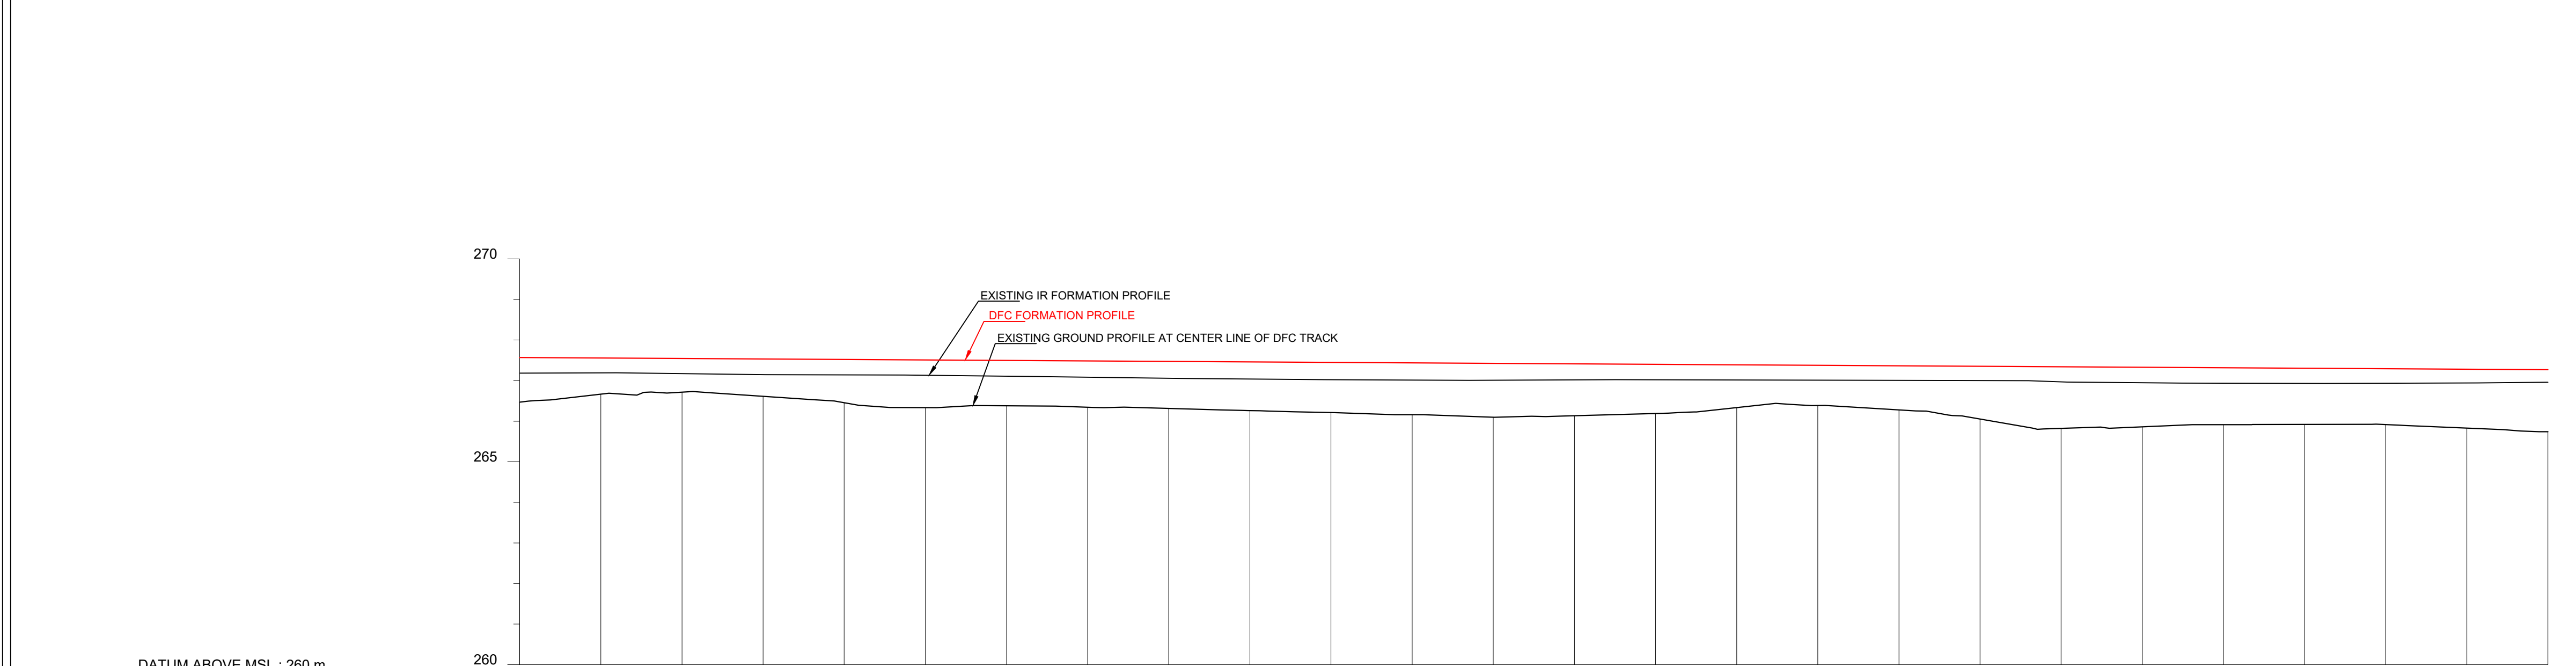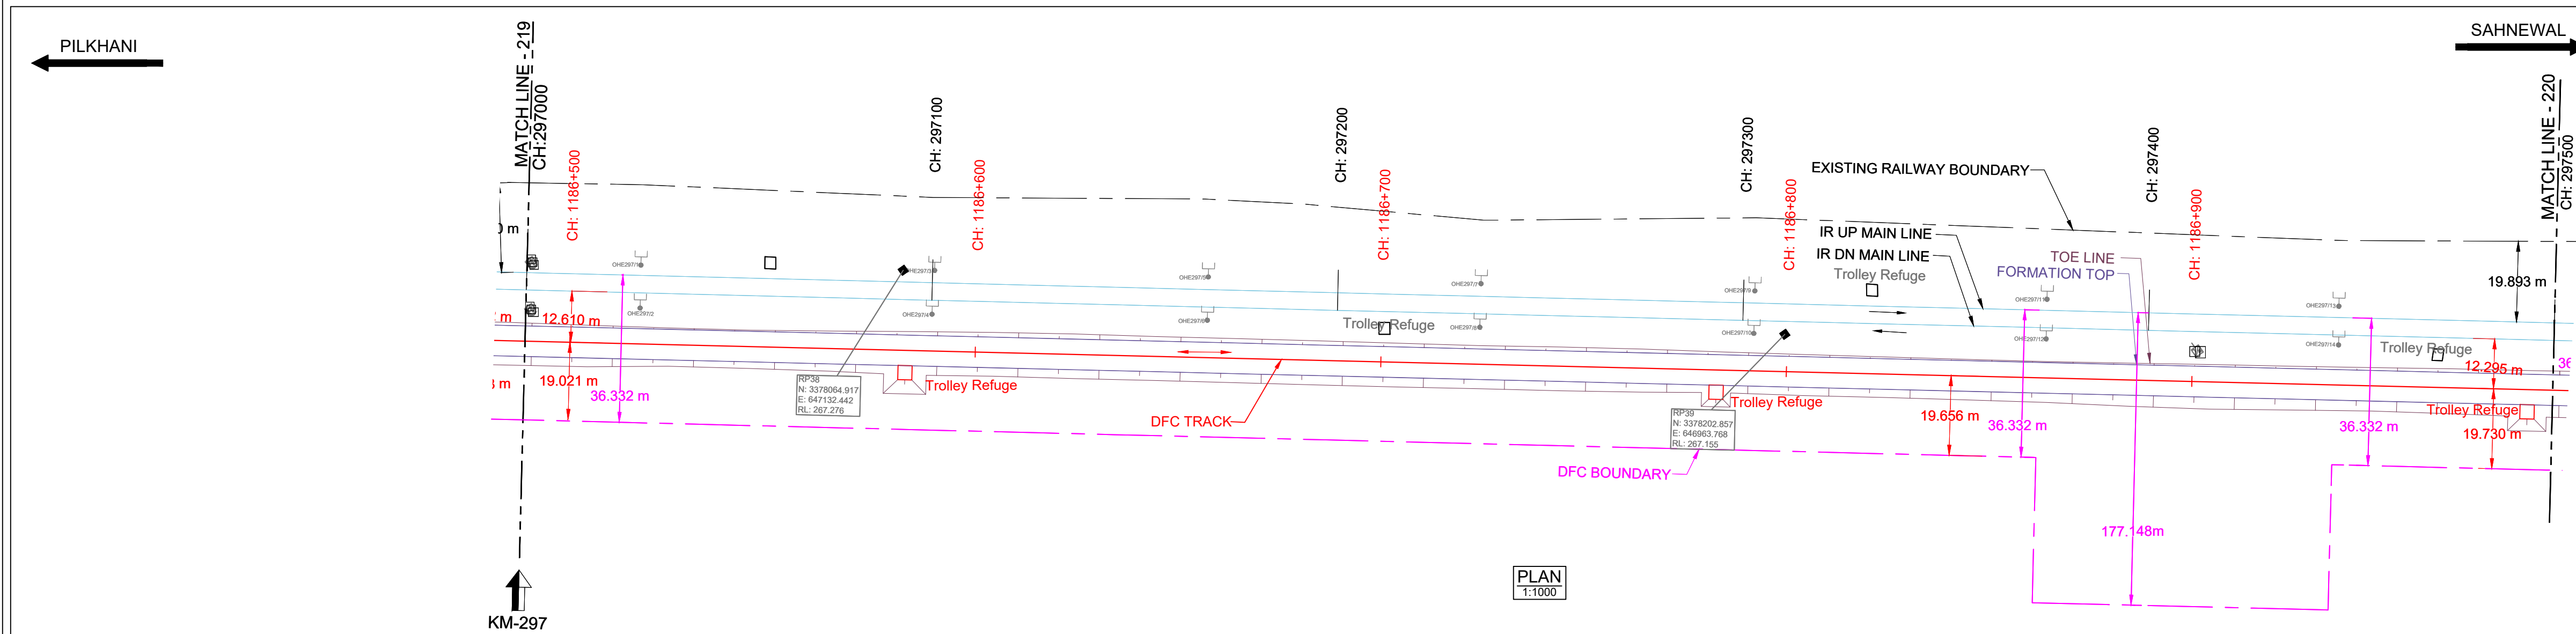

DATUM ABOVE MSL : 260 m

HORIZONTAL ALIGNMENT	L = 5898.430m																			
VERTICAL ALIGNMENT	L=1575.274 m 1 IN 1668 F																			
TRACK DISTANCE FROM EXISTING NEAREST IR DN MAIN LINE TO DFC MAIN LINE	12.644	12.610	12.589	12.570	12.553	12.505	12.490	12.457	12.434	12.384	12.373	12.366	12.364	12.354	12.360	12.354	12.331	12.319	12.318	12.295
HEIGHT OF BANKING(+) / DEPTH OF CUTTING(-) (PFL-GL)	+1.102	+0.892	+0.831	+0.921	+1.066	+1.176	+1.119	+1.150	+1.201	+1.239	+1.279	+1.054	+1.088	+1.301	+1.517	+1.459	+1.404	+1.366	+1.377	+1.527
EXG GROUND LEVEL AT CENTER LINE OF DFC TRACK (GL)	266.468	266.666	266.715	266.613	266.456	266.334	266.379	266.314	266.261	266.211	266.159	266.098	266.278	266.053	265.825	265.861	265.914	265.920	265.917	265.743
EXG GROUND LEVEL AT TOE LOCATION OF DFC TRACK	266.350	266.433	266.643	266.591	266.441	266.274	266.328	266.278	266.233	266.191	266.173	266.170	266.243	266.160	266.035	266.831	265.761	265.873	265.937	265.806
DIFFERENCE BETWEEN DFC FORMATION LEVEL AND EXG.FORMATION LEVEL (PFL-EFL)	0.385	0.368	0.375	0.388	0.382	0.380	0.389	0.417	0.423	0.427	0.424	0.416	0.361	0.354	0.372	0.383	0.383	0.376	0.359	0.339
DFC FORMATION LEVEL (PFL)	267.570	267.558	267.546	267.534	267.522	267.510	267.498	267.474	267.462	267.450	267.438	267.426	267.366	267.354	267.342	267.330	267.318	267.306	267.294	267.282
EXG. FORMATION LEVEL OF EXG IR DN MAIN LINE (EFL)	267.185	267.190	267.171	267.146	267.140	267.130	267.109	267.057	267.039	267.023	267.014	267.010	267.005	267.000	266.970	266.947	266.935	266.930	266.935	266.943
DIFFERENCE BETWEEN DFC RAIL LEVEL AND EXG. RAIL LEVEL (PRL - ERL)	0.410	0.393	0.400	0.413	0.407	0.404	0.414	0.427	0.448	0.452	0.449	0.408	0.386	0.379	0.397	0.408	0.408	0.401	0.384	0.354
DFC RAIL LEVEL (PRL)	268.283	268.271	268.259	268.247	268.235	268.223	268.211	268.187	268.175	268.163	268.151	268.139	268.079	268.067	268.055	268.043	268.031	268.019	268.007	267.995
EXG.RAIL LEVEL OF NEAREST IR DN MAIN LINE(ERL)	267.873	267.878	267.859	267.834	267.828	267.818	267.797	267.745	267.727	267.711	267.702	267.698	267.693	267.688	267.658	267.635	267.623	267.618	267.623	267.631
EQUIVALENT CHAINAGE ON DFC TRACK	297000.0	297020.0	297040.0	297060.0	297080.0	297100.0	297120.0	297140.0	297160.0	297180.0	297200.0	297220.0	297240.0	297260.0	297280.0	297300.0	297320.0	297340.0	297360.0	297380.0
EXISTING IR CHAINAGE	297000.0	297020.0	297040.0	297060.0	297080.0	297100.0	297120.0	297140.0	297160.0	297180.0	297200.0	297220.0	297240.0	297260.0	297280.0	297300.0	297320.0	297340.0	297360.0	297380.0

L - SECTION

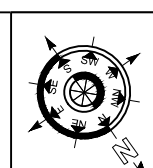

NOTE:-

- DFCC WORKS ARE SHOWN IN RED.
- IR NEW WORKS ARE SHOWN IN VIOLET.
- ALL DIMENSIONS ARE SHOWN IN METRES.
- THIS DRAWING IS PREPARED BASED ON LATEST SURVEY DATA HELD ON APRIL-2022. GTS BENCH MARK OF 261.850M CONSIDERED ON TOP OF CANAL BRIDGE ABUTMENT AT DORAHA VILLAGE ALONG THE NH1.
- DFC NEW CHAINAGE OF 1075.950M IS WITH REFERENCE TO THE IR KM OF 187.500KM END OF KM OF CP-303(SECTION P-3 PILKHANI END) AGAINST THE EXISTING DFC CHAINAGE. 116277.742M ISSUED VIDE LETTER NO. COM/DFCC/UMS/SURVEY/2021-301-230116-011173.DT. 17.01.2023.
- BALLAST PROFILE HAS BEEN PROVIDED ACCORDING TO THE CLAUSE 1.11.3 OF STANDARD SCHEDULE OF DIMENSION(EASTERN CORRIDOR) & THE BALLAST CUSHION DIMENSION SHOWN IN 35CM ON GE-14 PARA 17. SPECIFICATIONS & RECOMMENDATIONS 2. TWO LAYER SYSTEM FIG.10.

REFERENCE DRAWINGS :-

- FOR KEY PLAN REFER DRAWING NO. 301-2/AL/0001
- FOR LEGEND AND ABBREVIATIONS REFER DRAWING NO. 301-2/AL/1000
- FOR TYPICAL SECTION OF BALLAST PROFILE (FL-RL) REFER DRG. NO. 301-2/TK/TFD/004 (TR.1952)

DRG NO.- 301-2/AL/A/1220

0	27.08.2024	SUBMISSION OF AS-BUILT DRAWING	FOR APPROVAL
REV.	DATE	REVISION DETAILS	PURPOSE OF ISSUE

LEGEND:

SCALE

HOR - 1:1000

VER - 1:100

SHEET SIZE : A1

IR TRACK
DFCC TRACK
LINK LINE (SMUN-RP-J)
DFCC FUTURE PROPOSALS
STRUCTURE / BUILDING
DFCC TOE LINE
DFCC FORMATION
RETAINING WALL
ROAD
STREAM, DRAIN, NALA, CANAL.
FENCE
POWER LINES
TBM
ELECTRIC POLE/OHE MAST
IR RAILWAY BOUNDARY
DFCC BOUNDARY

TYPICAL SECTION

TRACK STRUCTURE		
RAIL SECTION: 60Kg/m (UIC 60Kg/m) DFC LINE: 60Kg/m (UIC 60Kg/m) IR MAIN LINE: 52Kg/m	Difference between FL- RL (Below Rail Seat)	
	IR Line	DFC
	172mm	172mm
RUBBER PAD	6mm	10mm
SLEEPER DEPTH	210mm	210mm
BALLAST CUSHION	300mm	350mm
Total Depth (FL TO RL)	688mm	742mm

OWNER

DEDICATED FREIGHT CORRIDOR CORPORATION OF INDIA LTD.

(A GOVERNMENT OF INDIA ENTERPRISE)

PROJECT OFFICE(AMBALA UNIT): OLD RAILWAY COLONY (NEAR ANAND MARKET),AMBALA CANTT-133001.

CORPORATE IDENTITY NO. : U60232DL2006GGI155068

ENGINEER:

DB Engineering & Consulting GmbH

Deutsche Bahn Engineering & Consulting GmbH

CONTRACTOR:

GIL - TPL JV

GAR TATA

SUBMITTED BY	GIL - TPL JV		
	DATED	NAME	SIGNATURE
PREPARED BY			
CHECKED BY	27.08.2024	VIJAY PRATAP	
APPROVED BY	27.08.2024	PARASURAM KOTYADA	

APPROVED BY

DEUTSCHE BAHN ENGINEERING & CONSULTING GMBH

DATED	NAME	SIGNATURE
Sr. DE./CHIEF ENGINEER	SURESH K.YALANGI	
CHIEF TRACK ENGINEER	RAJ PAL SINGH	
T.L.	H.D. VIDJAK	

STAMP

A AS-BUILT DRAWING TR. Ref..... ENGINEER Sign.:

EMPLOYER (DFCCIL): DEDICATED FREIGHT CORRIDOR CORPORATION OF INDIA LTD.

--	--	--	--

AS BUILT DRAWING

TITLE

AS-BUILT PLAN AND PROFILE

FROM IR KM: 297.000 TO 297.500

DFC KM: 1186.489 TO 1186.989

DFCC APPR. NO. -

ENGG. APPR. NO. -

DRG. NO. - 301-2/AL/A/1220

SHEET NO. : 1 OF 1

DATE : 27.08.2024

STATUS

A

TR.