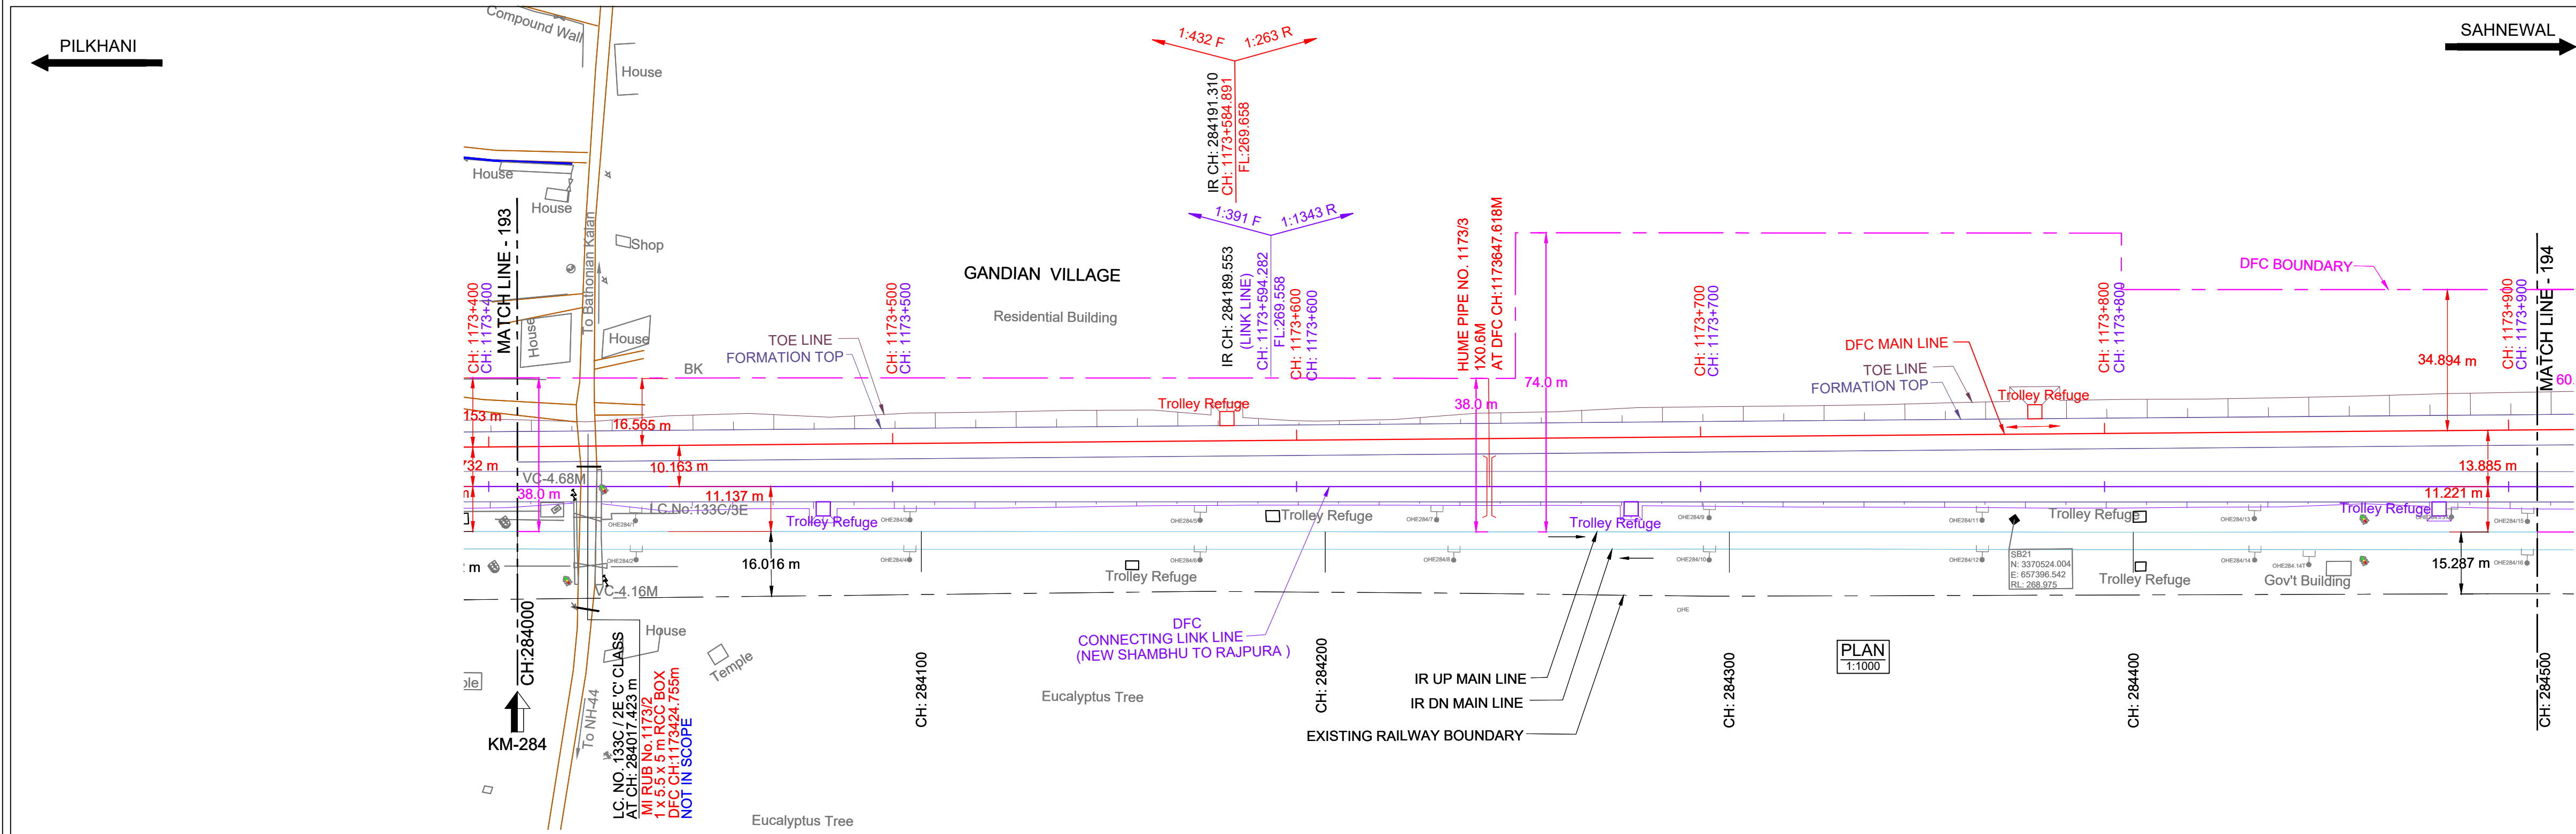


HORIZONTAL ALIGNMENT	L = 1484.711m																									
VERTICAL ALIGNMENT	L=533.97 m 1 IN 431.777 F												L=25.8 m R=4000 m											L=1904 m 1 IN 262.873 R		
TRACK DISTANCE FROM EXISTING NEAREST IR UP MAIN LINE TO DFC MAIN LINE	20.952																									
HEIGHT OF BANKING(+) / DEPTH OF CUTTING(-) (PFL-GL)	+0.953																									
EXG GROUND LEVEL AT CENTER LINE OF DFC TRACK (GL)	268.511	268.116																								
EXG GROUND LEVEL AT TOE LOCATION OF DFC TRACK	268.704	268.267																								
DIFFERENCE BETWEEN DFC FORMATION LEVEL AND EXG.FORMATION LEVEL (PFL-EFL)	0.703																									
DFC FORMATION LEVEL (PFL)	270.069	270.023																								
EXG. FORMATION LEVEL OF EXG IR UP MAIN LINE (EFL)	269.366	269.421																								
DIFFERENCE BETWEEN DFC RAIL LEVEL AND EXG. RAIL LEVEL (PRL - ERL)	0.744																									
DFC RAIL LEVEL (PRL)	270.762	270.736																								
EXG.RAIL LEVEL OF NEAREST IR UP MAIN LINE(ERL)	270.038	270.083																								
EQUIVALENT CHAINAGE ON DFC TRACK	284000.0	284020.0	284040.0	284060.0	284080.0	284100.0	284120.0	284140.0	284160.0	284180.0	284200.0	284220.0	284240.0	284260.0	284280.0	284300.0	284320.0	284340.0	284360.0	284380.0	284400.0	284420.0	284440.0	284460.0	284480.0	284500.0
EXISTING IR CHAINAGE	284000.0	284020.0	284040.0	284060.0	284080.0	284100.0	284120.0	284140.0	284160.0	284180.0	284200.0	284220.0	284240.0	284260.0	284280.0	284300.0	284320.0	284340.0	284360.0	284380.0	284400.0	284420.0	284440.0	284460.0	284480.0	284500.0

L - SECTION

NOTE:-

- DFCC WORKS ARE SHOWN IN RED.
- IR NEW WORKS ARE SHOWN IN VIOLET.
- ALL DIMENSIONS ARE SHOWN IN METRES.
- THIS DRAWING IS PREPARED BASED ON LATEST SURVEY DATA HELD ON APRIL-2022. GTS BENCH MARK OF 261.850M CONSIDERED ON TOP OF CANAL BRIDGE ABUTMENT AT DORANA VILLAGE ALONG THE NH1.
- DFC NEW CHAINAGE OF 1075.950M IS WITH REFERENCE TO THE IR KM OF 187.500KM END OF KM OF CP-303(SECTION P-3 PILKHANI END) AGAINST THE EXISTING DFC CHAINAGE. 116277.742M ISSUED VIDE LETTER NO. COM/DFCC/UM/SURVEY/2021-301-2301/16-01/173 DT. 17.01.2023.
- BALLAST PROFILE HAS BEEN PROVIDED ACCORDING TO THE CLAUSE 1.11.3 OF STANDARD SCHEDULE OF DIMENSION(EASTERN CORRIDOR) & THE BALLAST CUSHION DIMENSION SHOWN IN 35CM ON GE-14 PARA 17. SPECIFICATIONS & RECOMMENDATIONS 2. TWO LAYER SYSTEM FIG.10.

REFERENCE DRAWINGS:-

- FOR KEY PLAN REFER DRAWING NO. 301-2/AL/0001
- FOR LEGEND AND ABBREVIATIONS REFER DRAWING NO. 301-2/AL/1000
- FOR TYPICAL SECTION OF BALLAST PROFILE (FL-RL) REFER DRG. NO. 301-2/TK/TFD/004 (TR.1952)

LEGEND:

IR TRACK
DFCC TRACK
LINK LINE (SMUN-RP-J)
DFCC FUTURE PROPOSALS
STRUCTURE / BUILDING
DFCC TOE LINE
DFCC FORMATION
RETAINING WALL
ROAD
STREAM, DRAIN, NALA, CANAL.
FENCE
POWER LINES
TBM
ELECTRIC POLE/OHE MAST
IR RAILWAY BOUNDARY
DFCC BOUNDARY

SCALE

HOR - 1:1000

VER - 1:100

SHEET SIZE : A1

TYPICAL SECTION

TRACK STRUCTURE	
RAIL SECTION: 60Kg/m (UIC 60Kg/m) DFC LINE: 60Kg/m (UIC 60Kg/m) IR MAIN LINE: 52Kg/m	Difference between FL- RL (Below Rail Seat)
	IR Line DFC
RUBBER PAD	172mm 172mm
SLEEPER DEPTH	6mm 10mm
BALLAST CUSHION	210mm 210mm
	300mm 350mm
Total Depth (FL TO RL)	688mm 742mm

OWNER

DEDICATED FREIGHT CORRIDOR CORPORATION OF INDIA LTD.

(A GOVERNMENT OF INDIA ENTERPRISE)

PROJECT OFFICE/AMBALA UNIT: OLD RAILWAY COLONY (NEAR ANAND MARKET),AMBALA CANTT-133001.

CORPORATE IDENTITY NO. : U60232DL2006GGI155068

ENGINEER:

DB Engineering & Consulting GmbH

Deutsche Bahn Engineering & Consulting GmbH

CONTRACTOR:

GIL - TPL JV

GAR TATA

SUBMITTED BY	GIL - TPL JV		
	DATED	NAME	SIGNATURE
PREPARED BY			
CHECKED BY	27.08.2024	VIJAY PRATAP	
APPROVED BY	27.08.2024	PARASURAM KOTYADA	

APPROVED BY

DEUTSCHE BAHN ENGINEERING & CONSULTING GMBH

	DATED	NAME	SIGNATURE
Sr. DE./CHIEF ENGINEER		SURESH K.YALANGI	
CHIEF TRACK ENGINEER		RAJ PAL SINGH	
T.L.		H.D. VIDJAK	

STAMP

AS-BUILT DRAWING
TR. Ref.:.....
ENGINEER Sign.:.....

EMPLOYER (DFCCIL):

DEDICATED FREIGHT CORRIDOR CORPORATION OF INDIA LTD.

AS BUILT DRAWING

TITLE

AS-BUILT PLAN AND PROFILE

FROM IR KM: 284.000 TO 284.500
DFC KM: 1173.407 TO 1173.907

DFCC APPR. NO. -
ENGG. APPR. NO. -
DRG. NO. -301-2/AL/A/1194
SHEET NO. : 1 OF 1
DATE : 27.08.2024

STATUS
A

TR.