
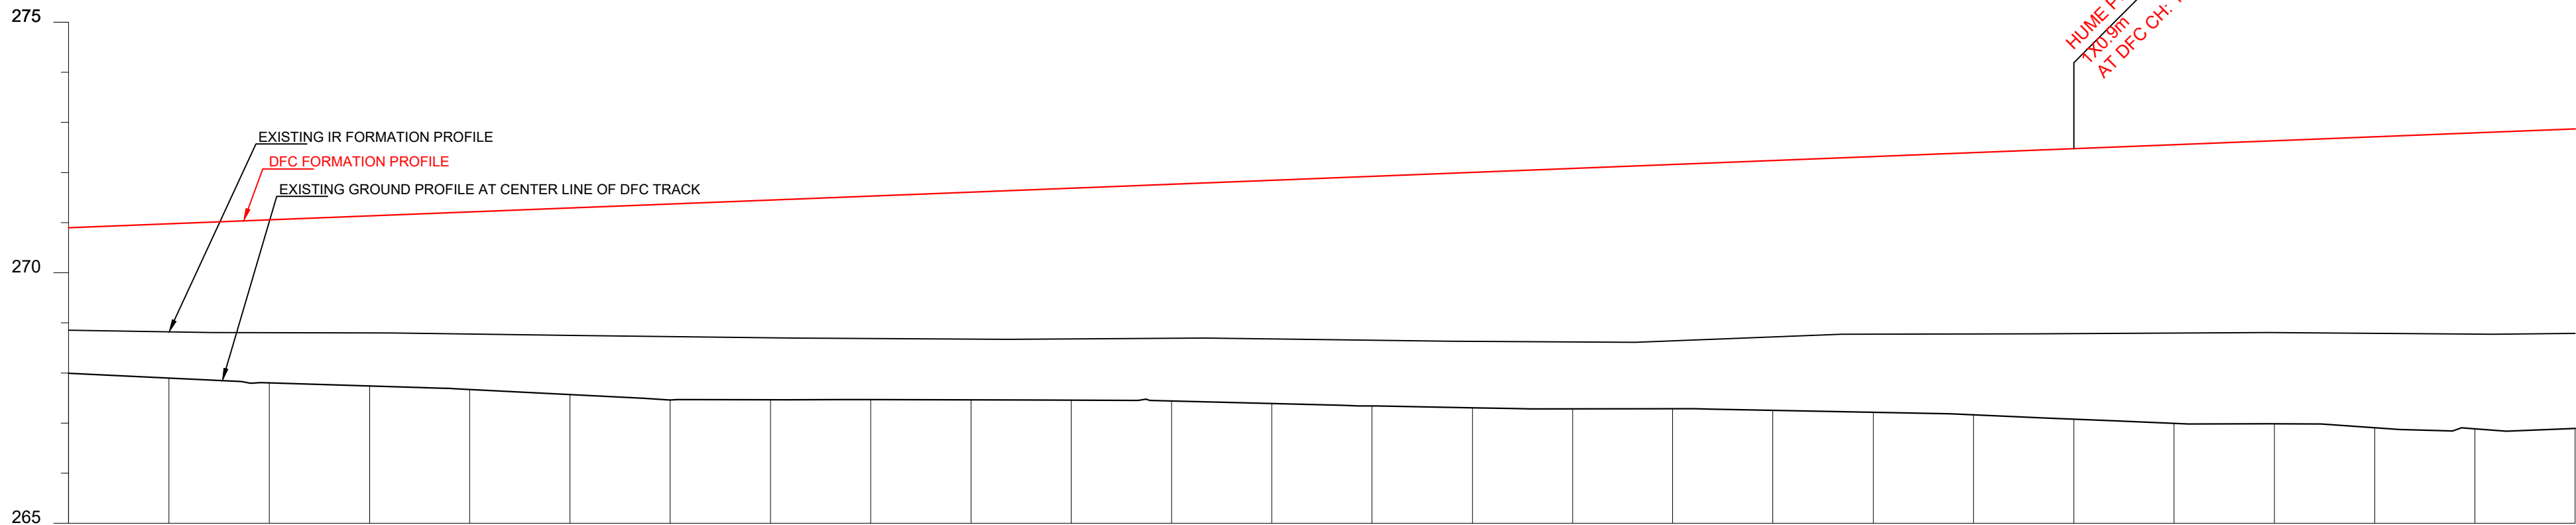


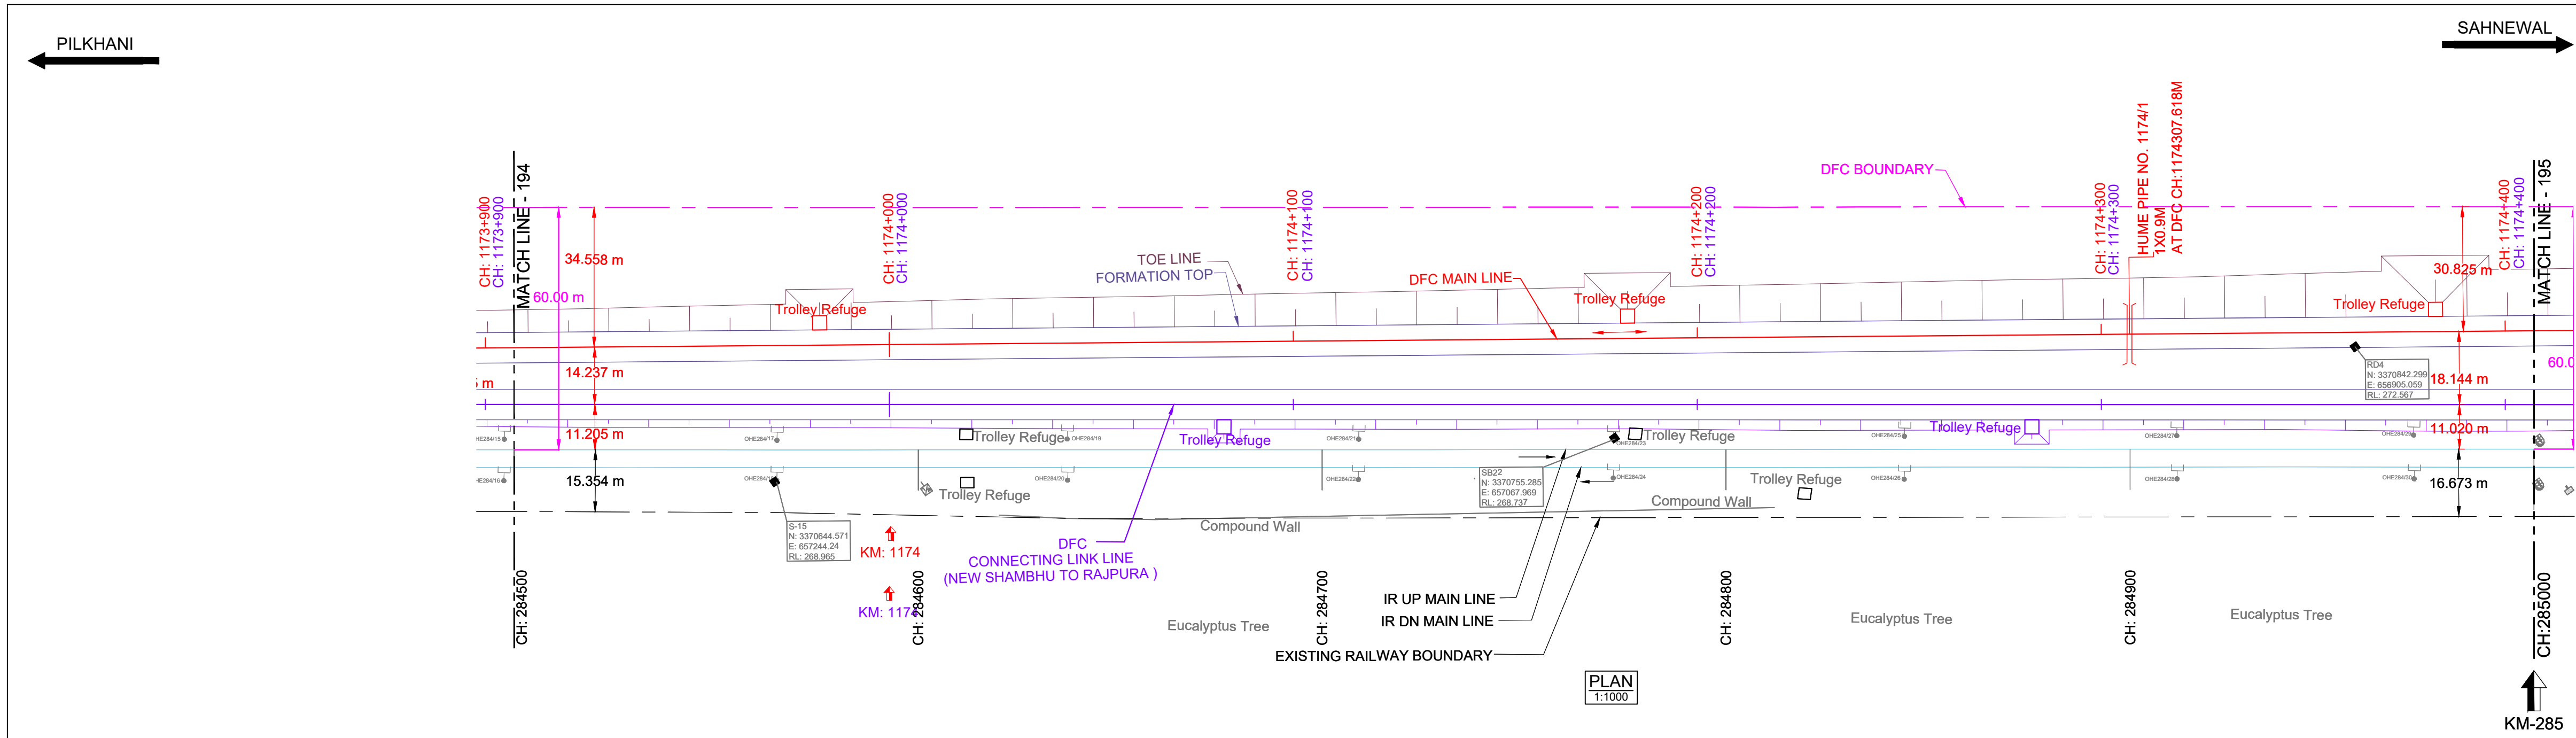


DATUM ABOVE MSL : 265 m

HORIZONTAL ALIGNMENT	L = 1484.711m																									
VERTICAL ALIGNMENT	L=1904 m 1 IN 262.873 R																									
TRACK DISTANCE FROM EXISTING NEAREST IR UP MAIN LINE TO DFC MAIN LINE	25.282	25.442	25.618	25.807	25.970	26.127	26.289	26.452	26.612	26.772	26.934	27.098	27.253	27.404	27.562	27.746	27.905	28.025	28.155	28.309	28.467	28.630	28.794	28.967	29.139	29.307
HEIGHT OF BANKING(+) / DEPTH OF CUTTING(-) (PFL-GL)	+2.902	+3.080	+3.252	+3.394	+3.543	+3.722	+3.911	+3.984	+4.061	+4.146	+4.230	+4.324	+4.455	+4.583	+4.697	+4.799	+4.874	+4.985	+5.103	+5.234	+5.400	+5.563	+5.647	+5.805	+5.908	+5.980
EXG GROUND LEVEL AT CENTER LINE OF DFC TRACK (GL)	267.979	267.981	267.981	267.927	267.719	267.671	267.543	267.567	267.432	267.489	267.471	267.415	267.458	267.387	267.394	267.343	267.346	267.280	267.293	267.193	267.239	267.151	267.212	266.911	266.829	266.807
EXG GROUND LEVEL AT TOE LOCATION OF DFC TRACK	267.979	267.954	267.881	267.827	267.719	267.671	267.543	267.567	267.432	267.489	267.471	267.415	267.458	267.387	267.394	267.343	267.346	267.280	267.293	267.193	267.239	267.151	267.212	266.911	266.829	266.807
DIFFERENCE BETWEEN DFC FORMATION LEVEL AND EXG.FORMATION LEVEL (PFL-EFL)	2.029	2.141	2.237	2.320	2.421	2.526	2.629	2.733	2.825	2.915	2.990	3.056	3.148	3.253	3.356	3.447	3.505	3.506	3.530	3.604	3.676	3.743	3.812	3.907	4.003	4.066
DFC FORMATION LEVEL (PFL)	270.884	270.961	271.037	271.113	271.189	271.265	271.341	271.417	271.493	271.569	271.645	271.721	271.797	271.873	271.950	272.026	272.102	272.178	272.254	272.330	272.406	272.482	272.558	272.634	272.711	272.787
EXG. FORMATION LEVEL OF EXG IR UP MAIN LINE (EFL)	268.855	268.819	268.800	268.792	268.768	268.739	268.712	268.684	268.668	268.654	268.655	268.665	268.649	268.620	268.594	268.579	268.597	268.672	268.724	268.726	268.731	268.739	268.747	268.727	268.708	268.721
DIFFERENCE BETWEEN DFC RAIL LEVEL AND EXG. RAIL LEVEL (PRL - ERL)	2.070	2.182	2.278	2.361	2.462	2.567	2.670	2.774	2.866	2.956	3.031	3.097	3.189	3.294	3.397	3.488	3.546	3.547	3.571	3.645	3.717	3.784	3.853	3.948	4.044	4.107
DFC RAIL LEVEL (PRL)	271.597	271.674	271.750	271.826	271.902	271.978	272.054	272.130	272.206	272.282	272.358	272.434	272.510	272.586	272.663	272.739	272.815	272.891	272.967	273.043	273.119	273.195	273.271	273.347	273.424	273.500
EXG.RAIL LEVEL OF NEAREST IR UP MAIN LINE(ERL)	269.527	269.491	269.472	269.464	269.440	269.411	269.384	269.356	269.340	269.326	269.327	269.337	269.321	269.292	269.266	269.251	269.269	269.344	269.396	269.398	269.403	269.411	269.419	269.399	269.380	269.393
EQUIVALENT CHAINAGE ON DFC TRACK	1173907.3	1173927.3	1173947.3	1173967.3	1173987.3	1174007.3	1174027.3	1174047.3	1174067.3	1174087.3	1174107.3	1174127.3	1174147.3	1174167.3	1174187.3	1174207.3	1174227.3	1174247.3	1174267.3	1174287.3	1174307.3	1174327.3	1174347.3	1174367.3	1174387.3	1174407.3
EXISTING IR CHAINAGE	284500.0	284520.0	284540.0	284560.0	284580.0	284600.0	284620.0	284640.0	284660.0	284680.0	284700.0	284720.0	284740.0	284760.0	284780.0	284800.0	284820.0	284840.0	284860.0	284880.0	284900.0	284920.0	284940.0	284960.0	284980.0	285000.0

L - SECTION

SAHNEWAL

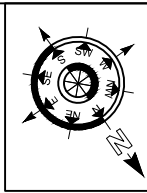

NOTE:-

- DFCC WORKS ARE SHOWN IN RED.
- IR NEW WORKS ARE SHOWN IN VIOLET.
- ALL DIMENSIONS ARE SHOWN IN METRES.
- THIS DRAWING IS PREPARED BASED ON LATEST SURVEY DATA HELD ON APRIL-2022. GTS BENCH MARK OF 261.850M CONSIDERED ON TOP OF CANAL BRIDGE ABUTMENT AT DORANA VILLAGE ALONG THE NH1.
- DFC NEW CHAINAGE OF 1075.950M IS WITH REFERENCE TO THE IR KM OF 187.500KM END OF KM OF CP-303(SECTION P-3 PILKHANI END) AGAINST THE EXISTING DFC CHAINAGE. 116277.742M ISSUED VIDE LETTER NO. COM/DFCC/UMS/SURVEY/2021-301-230116-011173 DT. 17.01.2023.
- BALLAST PROFILE HAS BEEN PROVIDED ACCORDING TO THE CLAUSE 1.11.3 OF STANDARD SCHEDULE OF DIMENSION(EASTERN CORRIDOR) & THE BALLAST CUSHION DIMENSION SHOWN IN 35CM ON GE-14 PARA 17. SPECIFICATIONS & RECOMMENDATIONS 2. TWO LAYER SYSTEM FIG.10.

REFERENCE DRAWINGS :-


- FOR KEY PLAN REFER DRAWING NO. 301-2/AL/0001
- FOR LEGEND AND ABBREVIATIONS REFER DRAWING NO. 301-2/AL/1000
- FOR TYPICAL SECTION OF BALLAST PROFILE (FL-RL) REFER DRG. NO. 301-2/TK/TFD/-004 (TR.1952)

REV.	DATE	REVISION DETAILS	PURPOSE OF ISSUE
0	27.08.2024	SUBMISSION OF AS-BUILT DRAWING	FOR APPROVAL

LEGEND:

SCALE: HOR - 1:1000, VER - 1:100, SHEET SIZE : A1

IR TRACK, DFC TRACK, LINK LINE (SMUN-RP-J), DFC FUTURE PROPOSALS, STRUCTURE / BUILDING, DFC TOE LINE, DFC FORMATION, RETAINING WALL, ROAD, STREAM, DRAIN, NALA, CANAL, FENCE, POWER LINES, TBM, ELECTRIC POLE/OHE MAST, IR RAILWAY BOUNDARY, DFC BOUNDARY

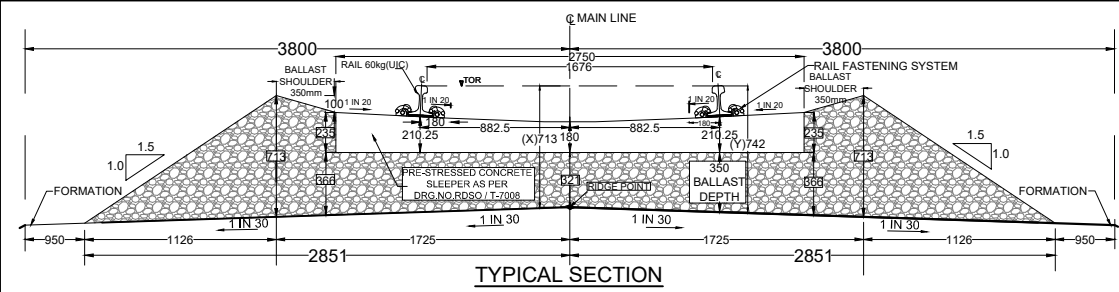

TRACK STRUCTURE		
RAIL SECTION: 60Kg/m (UIC 60Kg/m) DFC LINE: 60Kg/m (UIC 60Kg/m) IR MAIN LINE: 52Kg/m	Difference between FL- RL (Below Rail Seat)	
	IR Line	DFC
RUBBER PAD	172mm	172mm
SLEEPER DEPTH	6mm	10mm
BALLAST CUSHION	210mm	210mm
	300mm	350mm
Total Depth (FL TO RL)	688mm	742mm

OWNER: DEDICATED FREIGHT CORRIDOR CORPORATION OF INDIA LTD. (A GOVERNMENT OF INDIA ENTERPRISE)
PROJECT OFFICE(AMBALA UNIT): OLD RAILWAY COLONY (NEAR ANAND MARKET),AMBALA CANTT-133001.
CORPORATE IDENTITY NO. : U60232DL20060G0155068

ENGINEER: DB Engineering & Consulting GmbH
Deutsche Bahn Engineering & Consulting GmbH

CONTRACTOR: GIL - TPL JV
GAR TATA

SUBMITTED BY			
GIL - TPL JV			
	DATED	NAME	SIGNATURE
PREPARED BY			
CHECKED BY	27.08.2024	VIJAY PRATAP	
APPROVED BY	27.08.2024	PARASURAM KOTYADA	
APPROVED BY			
DEUTSCHE BAHN ENGINEERING & CONSULTING GMBH			
	DATED	NAME	SIGNATURE
Sr. DE./CHIEF ENGINEER		SURESH K.YALANGI	
CHIEF TRACK ENGINEER		RAJ PAL SINGH	
T.L.		H.D. VIDJAK	

STAMP	
A AS-BUILT DRAWING TR. Ref.:..... ENGINEER Sign.:.....	
EMPLOYER (DFCCIL):	DEDICATED FREIGHT CORRIDOR CORPORATION OF INDIA LTD.

AS BUILT DRAWING			
TITLE		DFCC APPR. NO. -	
AS-BUILT PLAN AND PROFILE		ENGG. APPR. NO. -	
FROM IR KM: 284.500 TO 285.000		DRG. NO. - 301-2/AL/A/1195	
DFC KM: 1173.907 TO 1174.407		SHEET NO. : 1 OF 1	
		DATE : 27.08.2024	
		STATUS	
		A	

TR.