
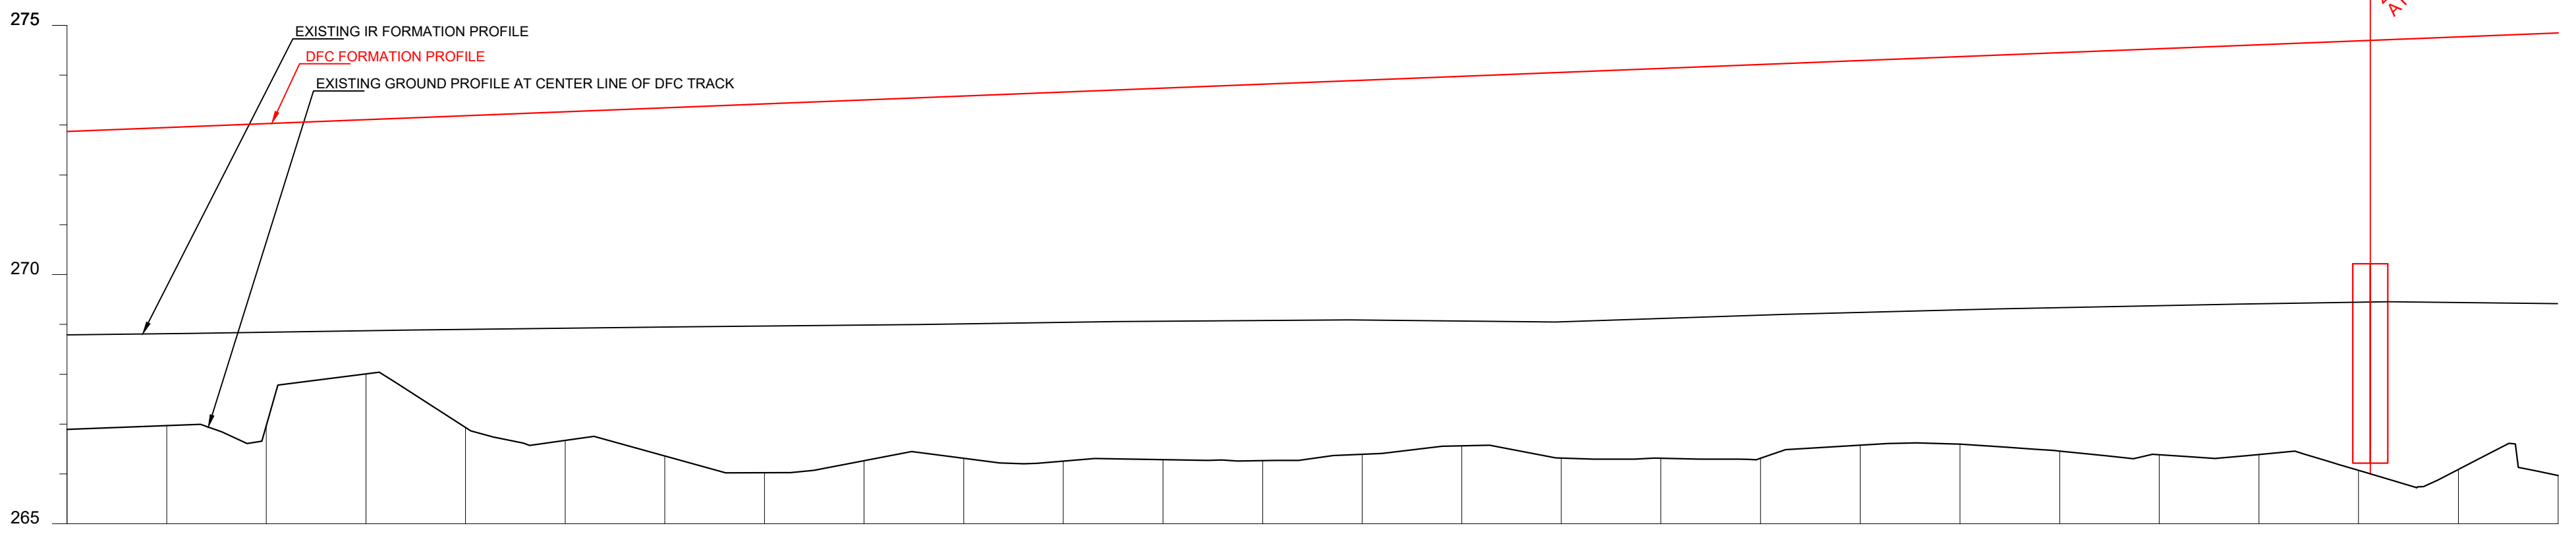


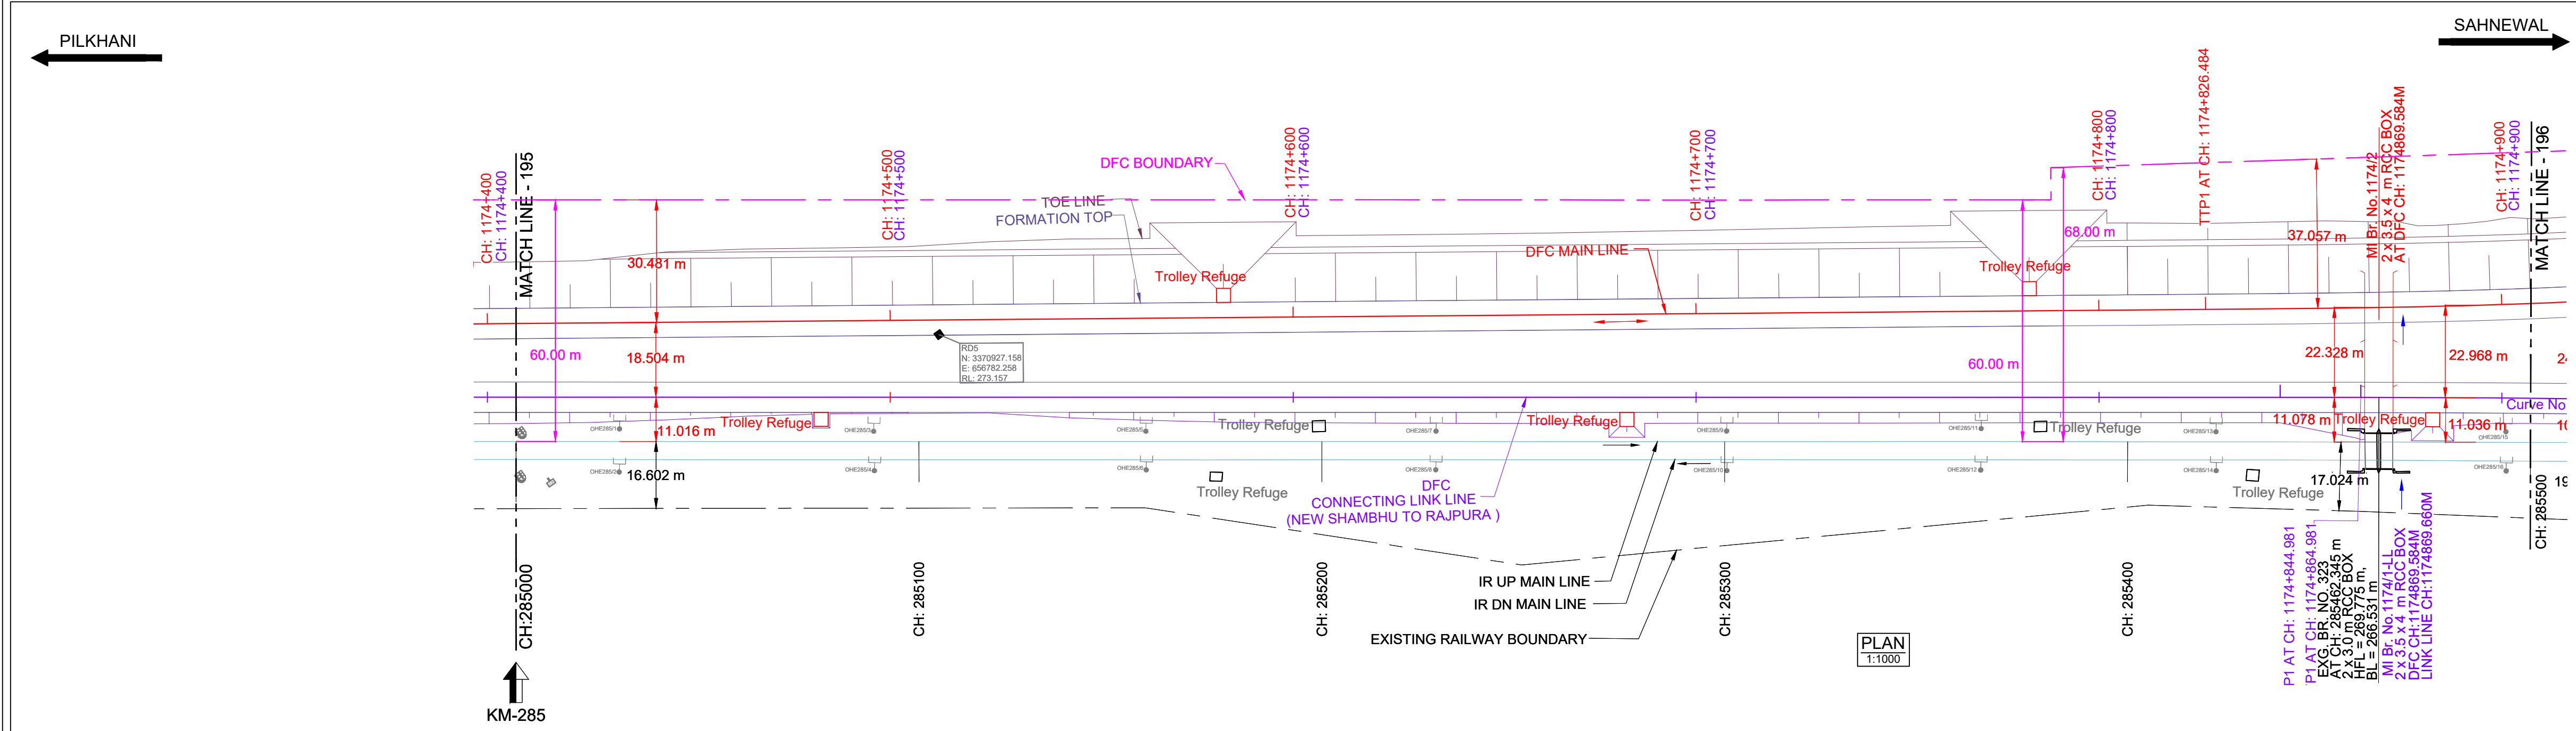

HORIZONTAL ALIGNMENT	L = 1484.711m																								TL= 140m	
VERTICAL ALIGNMENT	L=1904 m 1 IN 262.873 R																									
TRACK DISTANCE FROM EXISTING NEAREST IR UP MAIN LINE TO DFC MAIN LINE	29.307	29.474	29.643	29.813	29.978	30.137	30.296	30.465	30.636	30.802	30.965	31.138	31.324	31.508	31.682	31.854	32.004	32.155	32.327	32.506	32.695	32.890	33.095	33.365	33.813	34.491
HEIGHT OF BANKING(+) / DEPTH OF CUTTING(-) (PFL-GL)	+5.980	+5.982	+6.055	+5.104	+6.258	+6.595	+6.986	+7.402	+7.240	+7.269	+7.407	+7.454	+7.554	+7.505	+7.416	+7.739	+7.821	+7.900	+7.717	+7.773	+7.994	+8.145	+8.220	+8.618	+8.678	+8.875
EXG GROUND LEVEL AT CENTER LINE OF DFC TRACK (GL)	266.807	266.881	266.884	267.911	266.833	266.572	266.257	265.917	266.155	266.203	266.141	266.169	266.146	266.271	266.436	266.188	266.182	266.180	266.439	266.459	266.315	266.240	266.241	265.919	265.936	265.814
EXG GROUND LEVEL AT TOE LOCATION OF DFC TRACK	266.922	266.887	266.696	266.512	266.539	266.475	266.088	265.921	266.000	265.919	265.975	266.042	266.099	266.115	266.103	266.002	266.031	265.982	265.975	265.986	266.022	266.242	266.189	266.395	267.035	266.659
DIFFERENCE BETWEEN DFC FORMATION LEVEL AND EXG.FORMATION LEVEL (PFL-EFL)	4.066	4.121	4.171	4.220	4.272	4.327	4.382	4.441	4.500	4.555	4.604	4.660	4.725	4.794	4.895	4.990	5.003	5.015	5.039	5.066	5.101	5.141	5.181	5.228	5.313	5.416
DFC FORMATION LEVEL (PFL)	272.787	272.863	272.899	273.015	273.091	273.167	273.243	273.319	273.395	273.471	273.547	273.624	273.700	273.776	273.852	273.928	274.004	274.080	274.156	274.232	274.308	274.385	274.461	274.537	274.613	274.689
EXG. FORMATION LEVEL OF EXG IR UP MAIN LINE (EFL)	268.721	268.742	268.767	268.795	268.819	268.840	268.861	268.878	268.895	268.916	268.944	268.963	268.975	268.981	268.957	268.937	269.001	269.065	269.117	269.166	269.207	269.244	269.279	269.309	269.300	269.273
DIFFERENCE BETWEEN DFC RAIL LEVEL AND EXG. RAIL LEVEL (PRL - ERL)	4.107	4.162	4.212	4.261	4.313	4.368	4.423	4.482	4.541	4.596	4.645	4.701	4.766	4.835	4.936	5.031	5.044	5.056	5.080	5.107	5.142	5.182	5.222	5.269	5.354	5.457
DFC RAIL LEVEL (PRL)	273.500	273.576	273.652	273.728	273.804	273.880	273.956	274.032	274.108	274.184	274.260	274.337	274.413	274.489	274.565	274.641	274.717	274.793	274.869	274.945	275.021	275.098	275.174	275.250	275.326	275.402
EXG.RAIL LEVEL OF NEAREST IR UP MAIN LINE(ERL)	269.393	269.414	269.439	269.467	269.491	269.512	269.533	269.550	269.567	269.588	269.616	269.635	269.647	269.653	269.629	269.609	269.673	269.737	269.789	269.838	269.879	269.916	269.951	269.981	269.972	269.945
EQUIVALENT CHAINAGE ON DFC TRACK	1174407.3	1174427.3	1174447.3	1174467.3	1174487.3	1174507.3	1174527.3	1174547.3	1174567.3	1174587.3	1174607.3	1174627.3	1174647.3	1174667.3	1174687.3	1174707.3	1174727.3	1174747.3	1174767.3	1174787.3	1174807.4	1174827.4	1174847.4	1174867.4	1174887.4	1174907.5
EXISTING IR CHAINAGE	285000.0	285020.0	285040.0	285060.0	285080.0	285100.0	285120.0	285140.0	285160.0	285180.0	285200.0	285220.0	285240.0	285260.0	285280.0	285300.0	285320.0	285340.0	285360.0	285380.0	285400.0	285420.0	285440.0	285460.0	285480.0	285500.0

L - SECTION

NOTE:-

- DFCC WORKS ARE SHOWN IN RED.
- IR NEW WORKS ARE SHOWN IN VIOLET.
- ALL DIMENSIONS ARE SHOWN IN METRES.
- THIS DRAWING IS PREPARED BASED ON LATEST SURVEY DATA HELD ON APRIL-2022. GTS BENCH MARK OF 261.850M CONSIDERED ON TOP OF CANAL BRIDGE ABUTMENT AT DORANA VILLAGE ALONG THE NH1.
- DFC NEW CHAINAGE OF 1075.950M IS WITH REFERENCE TO THE IR KM OF 187.500KM END OF KM OF CP-303(SECTION P-3 PILKHANI END) AGAINST THE EXISTING DFC CHAINAGE. 116277.742M ISSUED VIDE LETTER NO. COM/DFCC/UMS/SURVEY/2021-301-230116-011173 DT. 17.01.2023.
- BALLAST PROFILE HAS BEEN PROVIDED ACCORDING TO THE CLAUSE 1.11.3 OF STANDARD SCHEDULE OF DIMENSION(EASTERN CORRIDOR) & THE BALLAST CUSHION DIMENSION SHOWN IN 35CM ON GE-14 PARA 17. SPECIFICATIONS & RECOMMENDATIONS 2. TWO LAYER SYSTEM FIG.10.

REFERENCE DRAWINGS :-

- FOR KEY PLAN REFER DRAWING NO. 301-2/AL/0001
- FOR LEGEND AND ABBREVIATIONS REFER DRAWING NO. 301-2/AL/1000
- FOR TYPICAL SECTION OF BALLAST PROFILE (FL-RL) REFER DRG. NO. 301-2/TK/TFD/-004 (TR.1952)

SCALE

HOR - 1:1000

VER - 1:100

SHEET SIZE : A1

LEGEND:

IR TRACK
DFCC TRACK
LINK LINE (SMUN-RP-J)
DFCC FUTURE PROPOSALS
STRUCTURE / BUILDING
DFCC TOE LINE
DFCC FORMATION
RETAINING WALL
ROAD
STREAM, DRAIN, NALA, CANAL.
FENCE
POWER LINES
TBM
ELECTRIC POLE/OHE MAST
IR RAILWAY BOUNDARY
DFCC BOUNDARY

TYPICAL SECTION

TRACK STRUCTURE		
RAIL SECTION: 60Kg/m (UIC 60Kg/m) DFC LINE: 60Kg/m (UIC 60Kg/m) IR MAIN LINE: 52Kg/m	Difference between FL- RL (Below Rail Seat)	
	IR Line	DFC
RUBBER PAD	172mm	172mm
SLEEPER DEPTH	6mm	10mm
BALLAST CUSHION	210mm	210mm
	300mm	350mm
Total Depth (FL TO RL)	688mm	742mm

OWNER

DEDICATED FREIGHT CORRIDOR CORPORATION OF INDIA LTD.

(A GOVERNMENT OF INDIA ENTERPRISE)

PROJECT OFFICE (AMBALA UNIT): OLD RAILWAY COLONY (NEAR ANAND MARKET), AMBALA CANTT-133001.

CORPORATE IDENTITY NO. : U60232DL2006GGI155068

ENGINEER:

DB Engineering & Consulting GmbH

Deutsche Bahn Engineering & Consulting GmbH

CONTRACTOR:

GIL - TPL JV

SUBMITTED BY	GIL - TPL JV		
	DATED	NAME	SIGNATURE
PREPARED BY			
CHECKED BY	27.08.2024	VIJAY PRATAP	
APPROVED BY	27.08.2024	PARASURAM KOTYADA	
APPROVED BY	DEUTSCHE BAHN ENGINEERING & CONSULTING GMBH		
	DATED	NAME	SIGNATURE
Sr. DE./CHIEF ENGINEER		SURESH K.YALANGI	
CHIEF TRACK ENGINEER		RAJ PAL SINGH	
T.L.		H.D. VIDJAK	

STAMP

AS-BUILT DRAWING
TR. Ref.:.....
ENGINEER Sign.:.....

EMPLOYER (DFCCIL): DEDICATED FREIGHT CORRIDOR CORPORATION OF INDIA LTD.

TITLE

AS-BUILT PLAN AND PROFILE

FROM IR KM: 285.000 TO 285.500
DFC KM: 1174.407 TO 1174.907

DFCC APPR. NO. -
ENGG. APPR. NO. -
DRG. NO. - 301-2/AL/A/1196
SHEET NO. : 1 OF 1
DATE : 27.08.2024

STATUS
A

TR.