


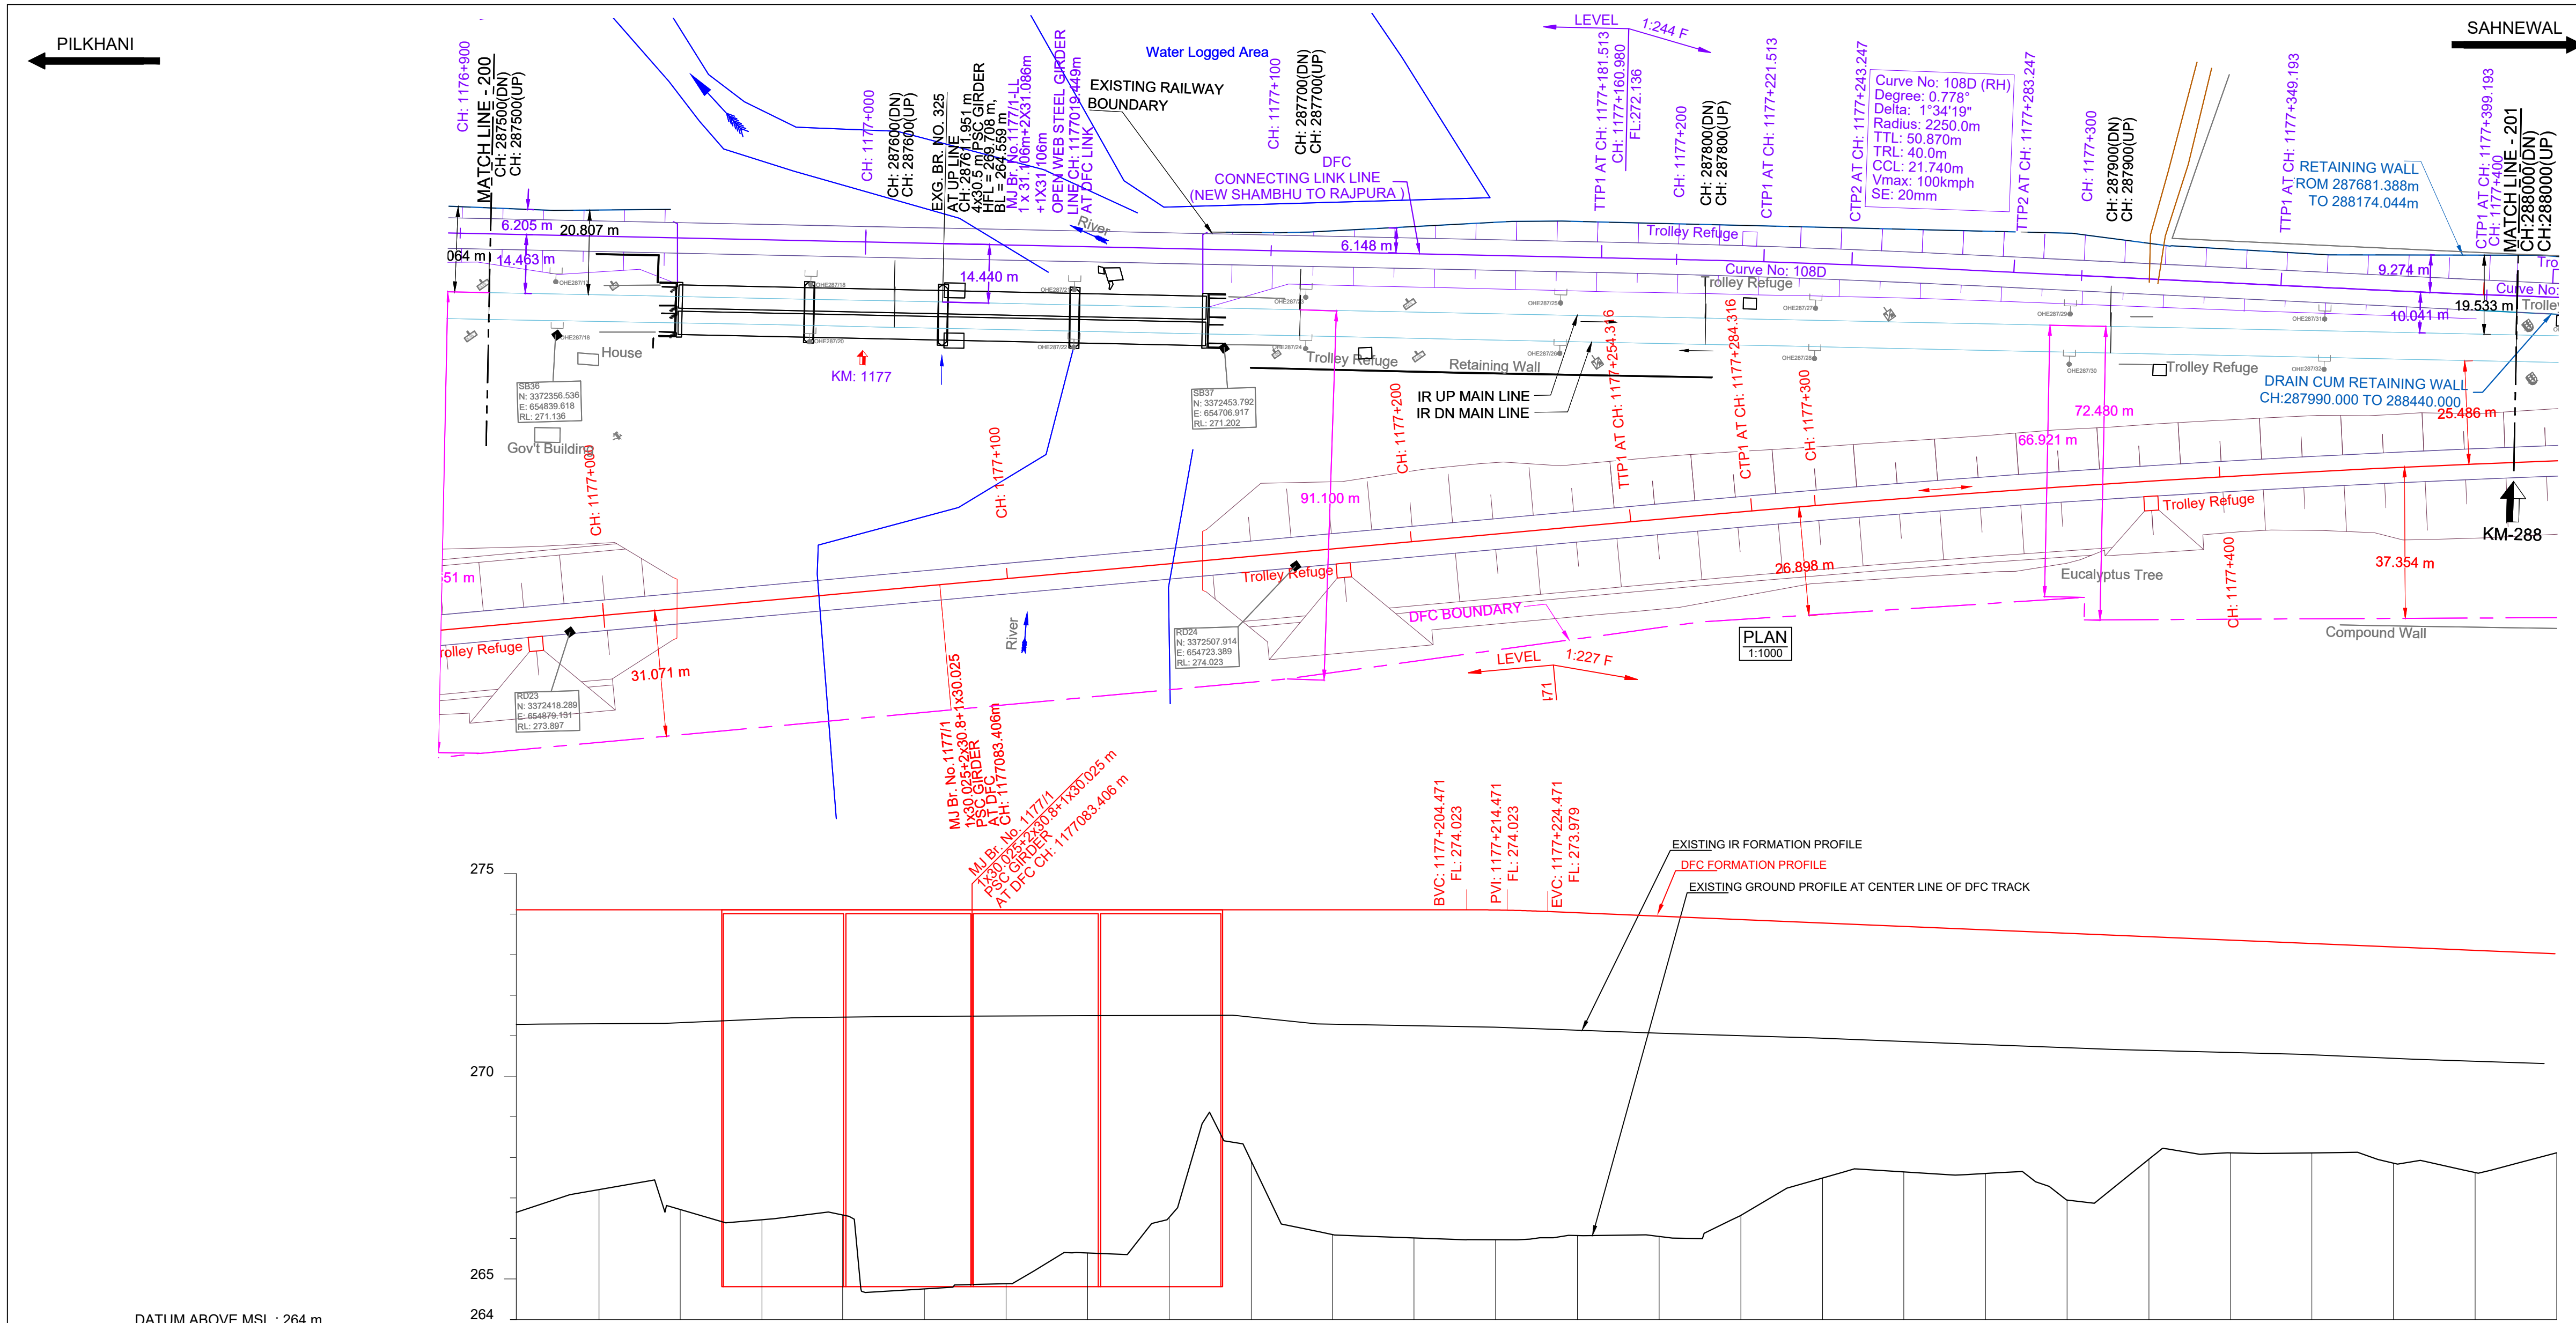

DATUM ABOVE MSL : 264 m

HORIZONTAL ALIGNMENT	L = 784.179m																												TL= 30m				R =4000m									
VERTICAL ALIGNMENT	L=276.240 m LEVEL														L=20.0 m R=4541 m														L=1317.982 m 1 IN 227.047 F													
TRACK DISTANCE FROM EXISTING NEAREST IR DN MAIN LINE TO DFC MAIN LINE	75.716																																									
HEIGHT OF BANKING(+) / DEPTH OF CUTTING(-) (PFL-GL)	+7.465																																									
EXG GROUND LEVEL AT CENTER LINE OF DFC TRACK (GL)	266.860	266.860	267.443	267.443	267.305	267.305	266.358	266.358	266.142	266.142	265.589	265.589	264.695	264.695	266.021	266.021	267.755	267.755	267.854	267.854	267.741	267.741	267.873	267.873	267.969	267.969	267.960	267.960														
EXG GROUND LEVEL AT TOE LOCATION OF DFC TRACK	266.860	266.860	267.443	267.443	267.305	267.305	266.358	266.358	266.142	266.142	265.589	265.589	264.695	264.695	266.021	266.021	267.755	267.755	267.854	267.854	267.741	267.741	267.873	267.873	267.969	267.969	267.960	267.960														
DIFFERENCE BETWEEN DFC FORMATION LEVEL AND EXG.FORMATION LEVEL (PFL-EFL)	2.813	2.813	2.795	2.795	2.771	2.771	2.685	2.685	2.614	2.614	2.606	2.606	2.598	2.598	2.590	2.590	2.804	2.804	2.841	2.841	2.878	2.878	2.929	2.929	2.917	2.917	2.890	2.890														
DFC FORMATION LEVEL (PFL)	274.023	274.023	273.947	273.947	273.868	273.868	273.769	273.769														
EXG. FORMATION LEVEL OF EXG IR DN MAIN LINE (EFL)	271.210	271.210	271.228	271.228	271.252	271.252	271.338	271.338	271.409	271.409	271.417	271.417	271.425	271.425	271.433	271.433	271.219	271.219	271.182	271.182	271.145	271.145	271.018	271.018	270.941	270.941	270.879	270.879														
DIFFERENCE BETWEEN DFC RAIL LEVEL AND EXG. RAIL LEVEL (PRL - ERL)	2.854	2.854	2.836	2.836	2.812	2.812	2.726	2.726	2.676	2.676	2.647	2.647	2.639	2.639	2.631	2.631	2.845	2.845	2.882	2.882	2.919	2.919	2.970	2.970	2.958	2.958	2.931	2.931														
DFC RAIL LEVEL (PRL)	274.736	274.736	274.650	274.650	274.571	274.571	274.482	274.482														
EXG.RAIL LEVEL OF NEAREST IR DN MAIN LINE(ERL)	271.882	271.882	271.900	271.900	271.924	271.924	272.010	272.010	272.06	272.06	272.089	272.089	272.097	272.097	272.105	272.105	271.891	271.891	271.854	271.854	271.817	271.817	271.690	271.690	271.613	271.613	271.551	271.551														
EQUIVALENT CHAINAGE ON DFC TRACK	287500.2	287500.2	287520.5	287520.5	287540.6	287540.6	287560.7	287560.7	287580.6	287580.6	287600.9	287600.9	287620.7	287620.7	287640.1	287640.1	287660.5	287660.5	287680.5	287680.5	287700.6	287700.6	287720.8	287720.8	287740.9	287740.9	287760.9	287760.9														
EXISTING IR CHAINAGE	287500.0	287500.0	287520.0	287520.0	287540.0	287540.0	287560.0	287560.0	287580.0	287580.0	287600.0	287600.0	287620.0	287620.0	287640.0	287640.0	287660.0	287660.0	287680.0	287680.0	287700.0	287700.0	287720.0	287720.0	287740.0	287740.0	287760.0	287760.0														

L - SECTION

NOTE:-

- DFCC WORKS ARE SHOWN IN RED.
- IR NEW WORKS ARE SHOWN IN VIOLET.
- ALL DIMENSIONS ARE SHOWN IN METRES.
- THIS DRAWING IS PREPARED BASED ON LATEST SURVEY DATA HELD ON APRIL-2022. GTS BENCH MARK OF 261.850M CONSIDERED ON TOP OF CANAL BRIDGE ABUTMENT AT DORANA VILLAGE ALONG THE NH1.
- DFC NEW CHAINAGE OF 1075.950M IS WITH REFERENCE TO THE IR KM OF 187.500KM END OF KM OF CP-303(SECTION P-3 PILKHANI END) AGAINST THE EXISTING DFC CHAINAGE. 116277.742M ISSUED VIDE LETTER NO. COM/DFCC/SURVEY/2021-301-230116-01173.DT. 17.01.2023.
- BALLAST PROFILE HAS BEEN PROVIDED ACCORDING TO THE CLAUSE 1.11.3 OF STANDARD SCHEDULE OF DIMENSION(EASTERN CORRIDOR) & THE BALLAST CUSHION DIMENSION SHOWN IN 35CM ON GE-14 PARA 17. SPECIFICATIONS & RECOMMENDATIONS 2. TWO LAYER SYSTEM FIG.10.

REFERENCE DRAWINGS :-

- FOR KEY PLAN REFER DRAWING NO. 301-2/AL/0001
- FOR LEGEND AND ABBREVIATIONS REFER DRAWING NO. 301-2/AL/1000
- FOR TYPICAL SECTION OF BALLAST PROFILE (FL-RL) REFER DRG. NO. 301-2/TK/TFD/004 (TR.1952)

0	27.08.2024	SUBMISSION OF AS-BUILT DRAWING	FOR APPROVAL
REV.	DATE	REVISION DETAILS	PURPOSE OF ISSUE

SCALE
HOR - 1:1000
VER - 1:100
SHEET SIZE : A1

LEGEND:

- IR TRACK
- DFCC TRACK
- LINK LINE (SMUN-RP-J)
- DFCC FUTURE PROPOSALS
- STRUCTURE / BUILDING
- DFCC TOE LINE
- DFCC FORMATION
- RETAINING WALL
- ROAD
- STREAM, DRAIN, NALA, CANAL.
- FENCE
- POWER LINES
- TBM
- ELECTRIC POLE/OHE MAST
- IR RAILWAY BOUNDARY
- DFCC BOUNDARY

TYPICAL SECTION

TRACK STRUCTURE

RAIL SECTION: 60Kg/m (UIC 60Kg/m)	Difference between FL-RL (Below Rail Seat)	
DFC LINE: 60Kg/m (UIC 60Kg/m)	IR Line	DFC
IR MAIN LINE: 52Kg/m	172mm	172mm
RUBBER PAD	6mm	10mm
SLEEPER DEPTH	210mm	210mm
BALLAST CUSHION	300mm	350mm
Total Depth (FL TO RL)	688mm	742mm

OWNER

DEDICATED FREIGHT CORRIDOR CORPORATION OF INDIA LTD.
(A GOVERNMENT OF INDIA ENTERPRISE)
PROJECT OFFICE(AMBALA UNIT): OLD RAILWAY COLONY (NEAR ANAND MARKET),AMBALA CANTT-133001.
CORPORATE IDENTITY NO. : U60232DL2006GGI155068

ENGINEER:

DB Engineering & Consulting GmbH
Deutsche Bahn Engineering & Consulting GmbH

CONTRACTOR:

GAR
 TATA

SUBMITTED BY	GIL - TPL JV		
	DATED	NAME	SIGNATURE
PREPARED BY			
CHECKED BY	27.08.2024	VIJAY PRATAP	
APPROVED BY	27.08.2024	PARASURAM KOTYADA	
APPROVED BY	DEUTSCHE BAHN ENGINEERING & CONSULTING GMBH		
	DATED	NAME	SIGNATURE
Sr. DE./CHIEF ENGINEER		SURESH K.YALANGI	
CHIEF TRACK ENGINEER		RAJ PAL SINGH	
T.L.		H.D. VIDJAK	

STAMP

AS-BUILT DRAWING
TR. Ref.....
ENGINEER Sign.:

EMPLOYER (DFCCIL):

DEDICATED FREIGHT CORRIDOR CORPORATION OF INDIA LTD.

AS BUILT DRAWING

TITLE	DFCC APPR. NO. -
AS-BUILT PLAN AND PROFILE	ENGG. APPR. NO. -
FROM IR KM: 287.500 TO 288.000	DRG. NO. -301-2/AL/A/1201
DFC KM: 1176.970 TO 1177.473	SHEET NO. : 1 OF 1
	DATE : 27.08.2024
	STATUS
	A

TR.