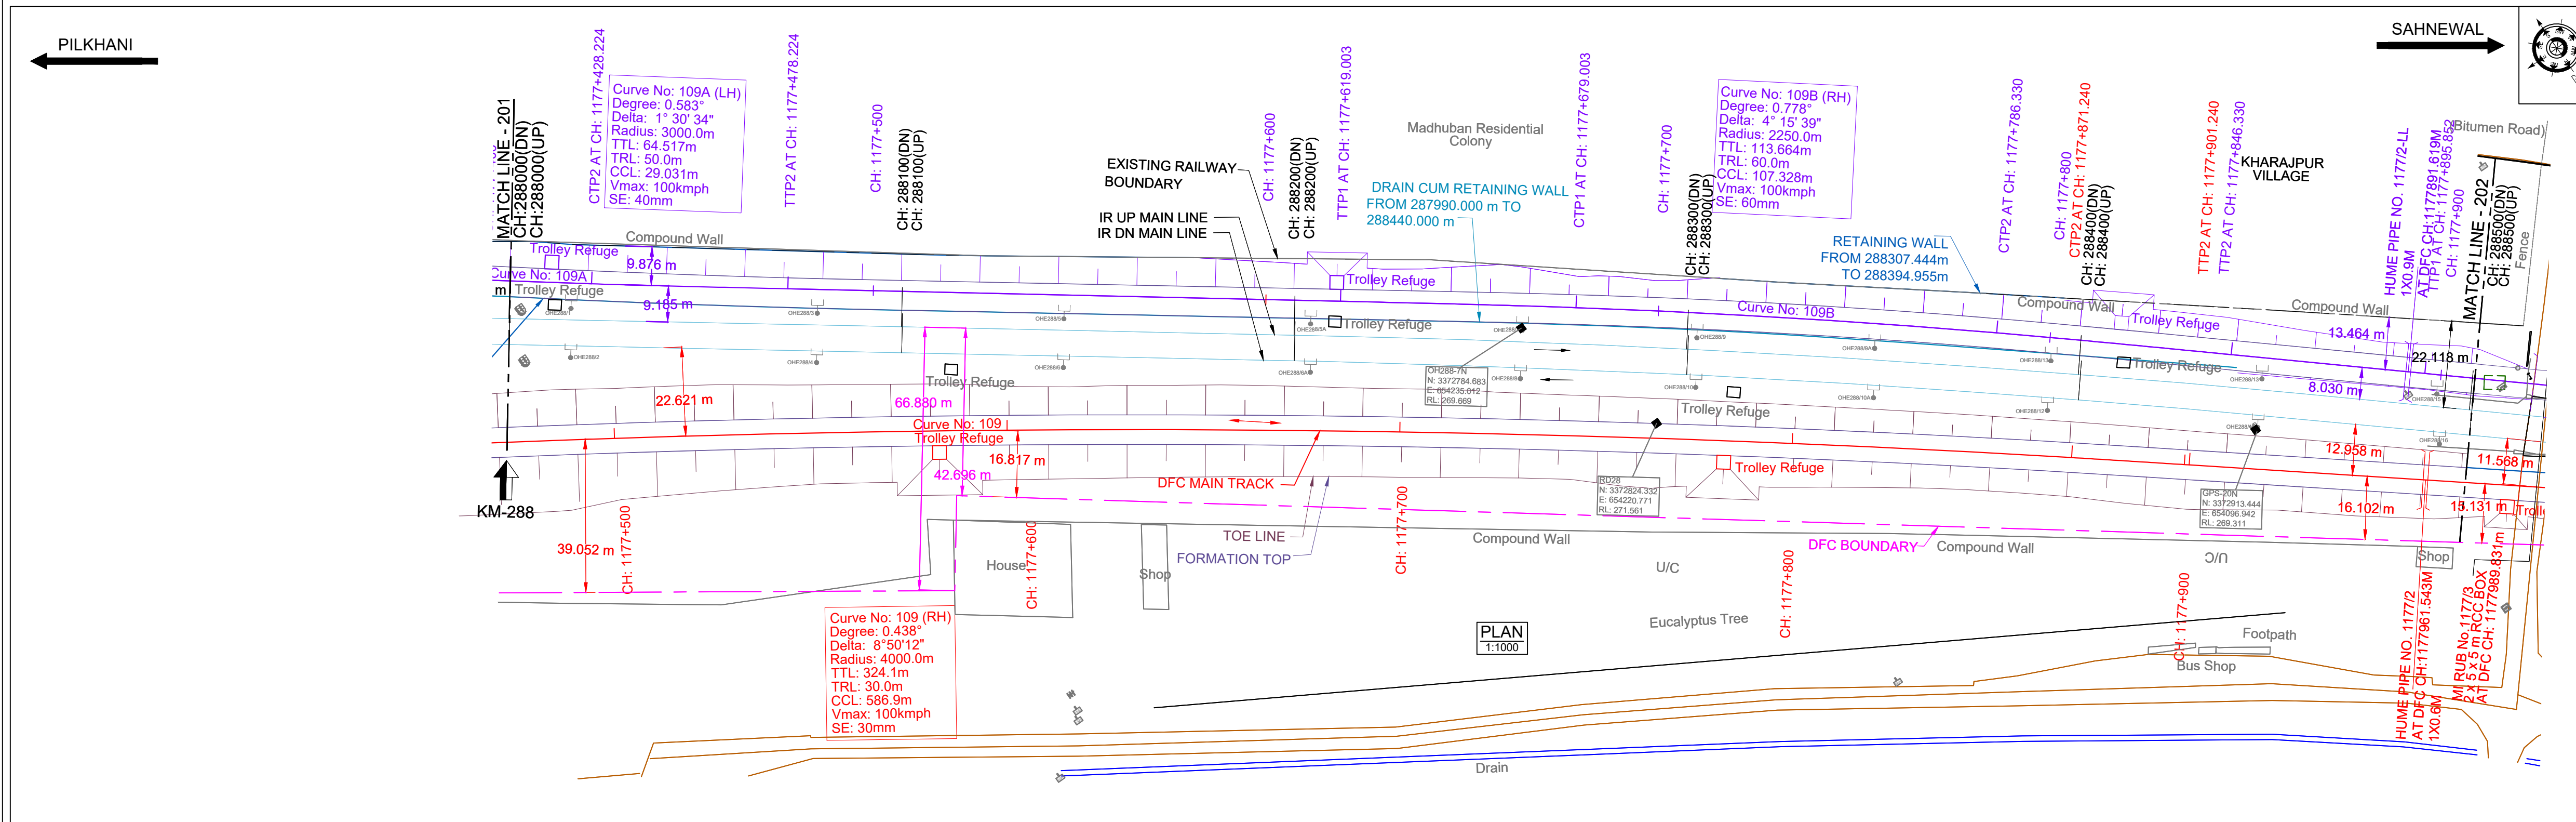


DATUM ABOVE MSL : 265 m

HORIZONTAL ALIGNMENT	R=4000m																			
VERTICAL ALIGNMENT	L=1317.982m 1 IN 227.047 F																			
TRACK DISTANCE FROM EXISTING NEAREST IR DN MAIN LINE TO DFC MAIN LINE	24.881	24.923	23.702	22.610	21.649	20.795	20.028	19.361	18.801	18.344	17.983	17.719	17.400	17.071	16.732	16.440	16.128	15.844	15.462	15.107
HEIGHT OF BANKING(+) / DEPTH OF CUTTING(-) (PFL-GL)	+4.923	+5.025	+5.399	+4.976	+4.595	+4.476	+4.482	+4.445	+4.400	+4.405	+3.973	+4.034	+3.838	+3.627	+3.594	+3.527	+2.977	+3.165	+3.157	+2.817
EXG GROUND LEVEL AT CENTER LINE OF DFC TRACK (GL)	267.962	267.772	267.310	267.645	267.947	267.968	267.874	267.823	267.780	267.987	268.030	268.258	268.267	268.317	268.318	268.325	268.149	268.424	268.473	268.527
EXG GROUND LEVEL AT TOE LOCATION OF DFC TRACK	268.373	268.169	268.072	268.052	268.207	268.200	268.324	268.556	268.322	268.146	268.156	268.216	268.299	268.297	268.305	268.317	268.303	268.424	268.473	268.527
DIFFERENCE BETWEEN DFC FORMATION LEVEL AND EXG.FORMATION LEVEL (PFL-EFL)	2.691	2.686	2.691	2.672	2.650	2.633	2.616	2.595	2.573	2.562	2.562	2.532	2.375	2.479	2.345	2.264	2.272	2.261	2.084	2.061
DFC FORMATION LEVEL (PFL)	270.194	270.111	270.109	270.108	270.109	270.108	270.109	270.108	270.109	270.108	270.109	270.108	270.109	270.108	270.109	270.108	270.109	270.108	270.109	270.108
EXG. FORMATION LEVEL OF EXG IR DN MAIN LINE (EFL)	270.194	270.111	270.109	270.108	270.109	270.108	270.109	270.108	270.109	270.108	270.109	270.108	270.109	270.108	270.109	270.108	270.109	270.108	270.109	270.108
DIFFERENCE BETWEEN DFC RAIL LEVEL AND EXG. RAIL LEVEL (PRL - ERL)	2.732	2.727	2.732	2.713	2.691	2.674	2.657	2.636	2.614	2.603	2.603	2.573	2.416	2.520	2.386	2.340	2.305	2.313	2.125	2.102
DFC RAIL LEVEL (PRL)	273.598	273.510	273.422	273.334	273.245	273.157	273.069	272.981	272.893	272.805	272.717	272.630	272.463	272.542	272.278	272.191	272.015	271.928	271.752	271.665
EXG.RAIL LEVEL OF NEAREST IR DN MAIN LINE(ERL)	270.866	270.783	270.690	270.620	270.554	270.483	270.412	270.345	270.279	270.201	270.113	270.057	269.987	269.950	269.892	269.850	269.710	269.615	269.538	269.474
EQUIVALENT CHAINAGE ON DFC TRACK	288000.0	288020.0	288040.0	288060.0	288080.0	288100.0	288120.0	288140.0	288160.0	288180.0	288200.0	288220.0	288240.0	288260.0	288280.0	288300.0	288320.0	288340.0	288360.0	288380.0
EXISTING IR CHAINAGE	288000.0	288020.0	288040.0	288060.0	288080.0	288100.0	288120.0	288140.0	288160.0	288180.0	288200.0	288220.0	288240.0	288260.0	288280.0	288300.0	288320.0	288340.0	288360.0	288380.0

L - SECTION

NOTE:-
1. DFC WORKS ARE SHOWN IN RED.
2. IR NEW WORKS ARE SHOWN IN VIOLET.
3. ALL DIMENSIONS ARE SHOWN IN METRES.
4. THIS DRAWING IS PREPARED BASED ON LATEST SURVEY DATA HELD ON APRIL-2022. GTS BENCH MARK OF 261.85M CONSIDERED ON TOP OF CANAL BRIDGE ABUTMENT AT DORANA VILLAGE ALONG THE NH1.
5. DFC NEW CHAINAGE OF 1075.950M IS WITH REFERENCE TO THE IR KM OF 187.500KM END OF KM OF CP-303(SECTION P-3 PILKHANI END) AGAINST THE EXISTING DFC CHAINAGE. 116277.742M ISSUED VIDE LETTER NO. COM/DFCC/COMB/SURVEY/2021-301-2301/16-01/173 DT. 17.01.2023.
6. BALLAST PROFILE HAS BEEN PROVIDED ACCORDING TO THE CLAUSE 1.11.3 OF STANDARD SCHEDULE OF DIMENSION(EASTERN CORRIDOR) & THE BALLAST CUSHION DIMENSION SHOWN IN 35CM ON GE-14 PARA 17. SPECIFICATIONS & RECOMMENDATIONS 2. TWO LAYER SYSTEM FIG.10.


REFERENCE DRAWINGS :-
1. FOR KEY PLAN REFER DRAWING NO. 301-2/AL/0001
2. FOR LEGEND AND ABBREVIATIONS REFER DRAWING NO. 301-2/AL/1000
3. FOR TYPICAL SECTION OF BALLAST PROFILE (FL-RL) REFER DRG. NO. 301-2/TK/TFD/-004 (TR.1952)

027.08.2024SUBMISSION OF AS-BUILT DRAWINGFOR APPROVAL

REV. DATE REVISION DETAILS PURPOSE OF ISSUE

SCALE
HOR - 1:1000
VER - 1:100
SHEET SIZE : A1

LEGEND:
IR TRACK
DFCC TRACK
LINK LINE (SMUN-RP-J)
DFCC FUTURE PROPOSALS
STRUCTURE / BUILDING
DFCC TOE LINE
DFCC FORMATION
RETAINING WALL
ROAD
STREAM, DRAIN, NALA, CANAL.
FENCE
POWER LINES
TBM
ELECTRIC POLE/OHE MAST
IR RAILWAY BOUNDARY
DFCC BOUNDARY

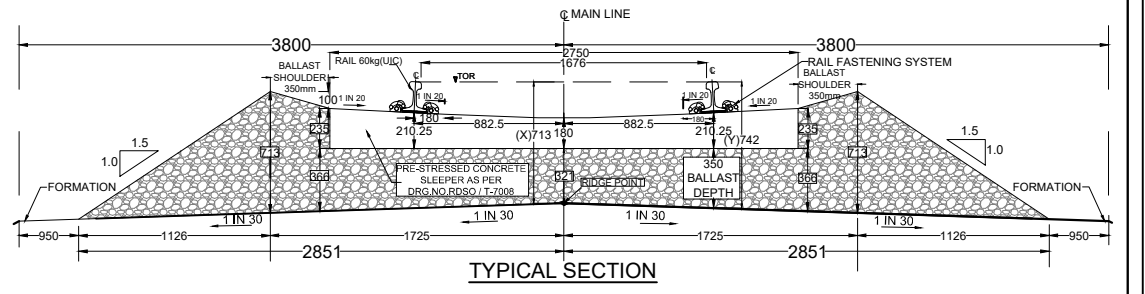

TRACK STRUCTURE		
RAIL SECTION: 60Kg/m (UIC 60Kg/m) DFC LINE: 60Kg/m (UIC 60Kg/m) IR MAIN LINE: 52Kg/m	Difference between FL- RL (Below Rail Seat)	
	IR Line	DFC
RUBBER PAD	172mm	172mm
SLEEPER DEPTH	6mm	10mm
BALLAST CUSHION	210mm	210mm
	300mm	350mm
Total Depth (FL TO RL)	688mm	742mm

OWNER
DEDICATED FREIGHT CORRIDOR CORPORATION OF INDIA LTD.
(A GOVERNMENT OF INDIA ENTERPRISE)
PROJECT OFFICE(AMBALA UNIT): OLD RAILWAY COLONY (NEAR ANAND MARKET),AMBALA CANTT-133001.
CORPORATE IDENTITY NO. : U60232DL20060G0155068

ENGINEER:
DB Engineering & Consulting GmbH
Deutsche Bahn Engineering & Consulting GmbH

CONTRACTOR:
GIL - TPL JV
GAR TATA

SUBMITTED BY			
GIL - TPL JV			
	DATED	NAME	SIGNATURE
PREPARED BY			
CHECKED BY	27.08.2024	VIJAY PRATAP	
APPROVED BY	27.08.2024	PARASURAM KOTYADA	
APPROVED BY			
	DATED	NAME	SIGNATURE
Sr. DE./CHIEF ENGINEER		SURESH K.YALANGI	
CHIEF TRACK ENGINEER		RAJ PAL SINGH	
T.L.		H.D. VIDJAK	

STAMP
A AS-BUILT DRAWING
TR. Ref.....
ENGINEER Sign.:

EMPLOYER (DFCCIL):	DEDICATED FREIGHT CORRIDOR CORPORATION OF INDIA LTD.		

AS BUILT DRAWING

AS-BUILT PLAN AND PROFILE

FROM IR KM: 288.000 TO 288.500
DFC KM: 1177.473 TO 1177.972

DFCC APPR. NO. -
ENGG. APPR. NO. -
DRG. NO. -301-2/AL/A/1202
SHEET NO. : 1 OF 1
DATE : 27.08.2024

STATUS
A

TR.