


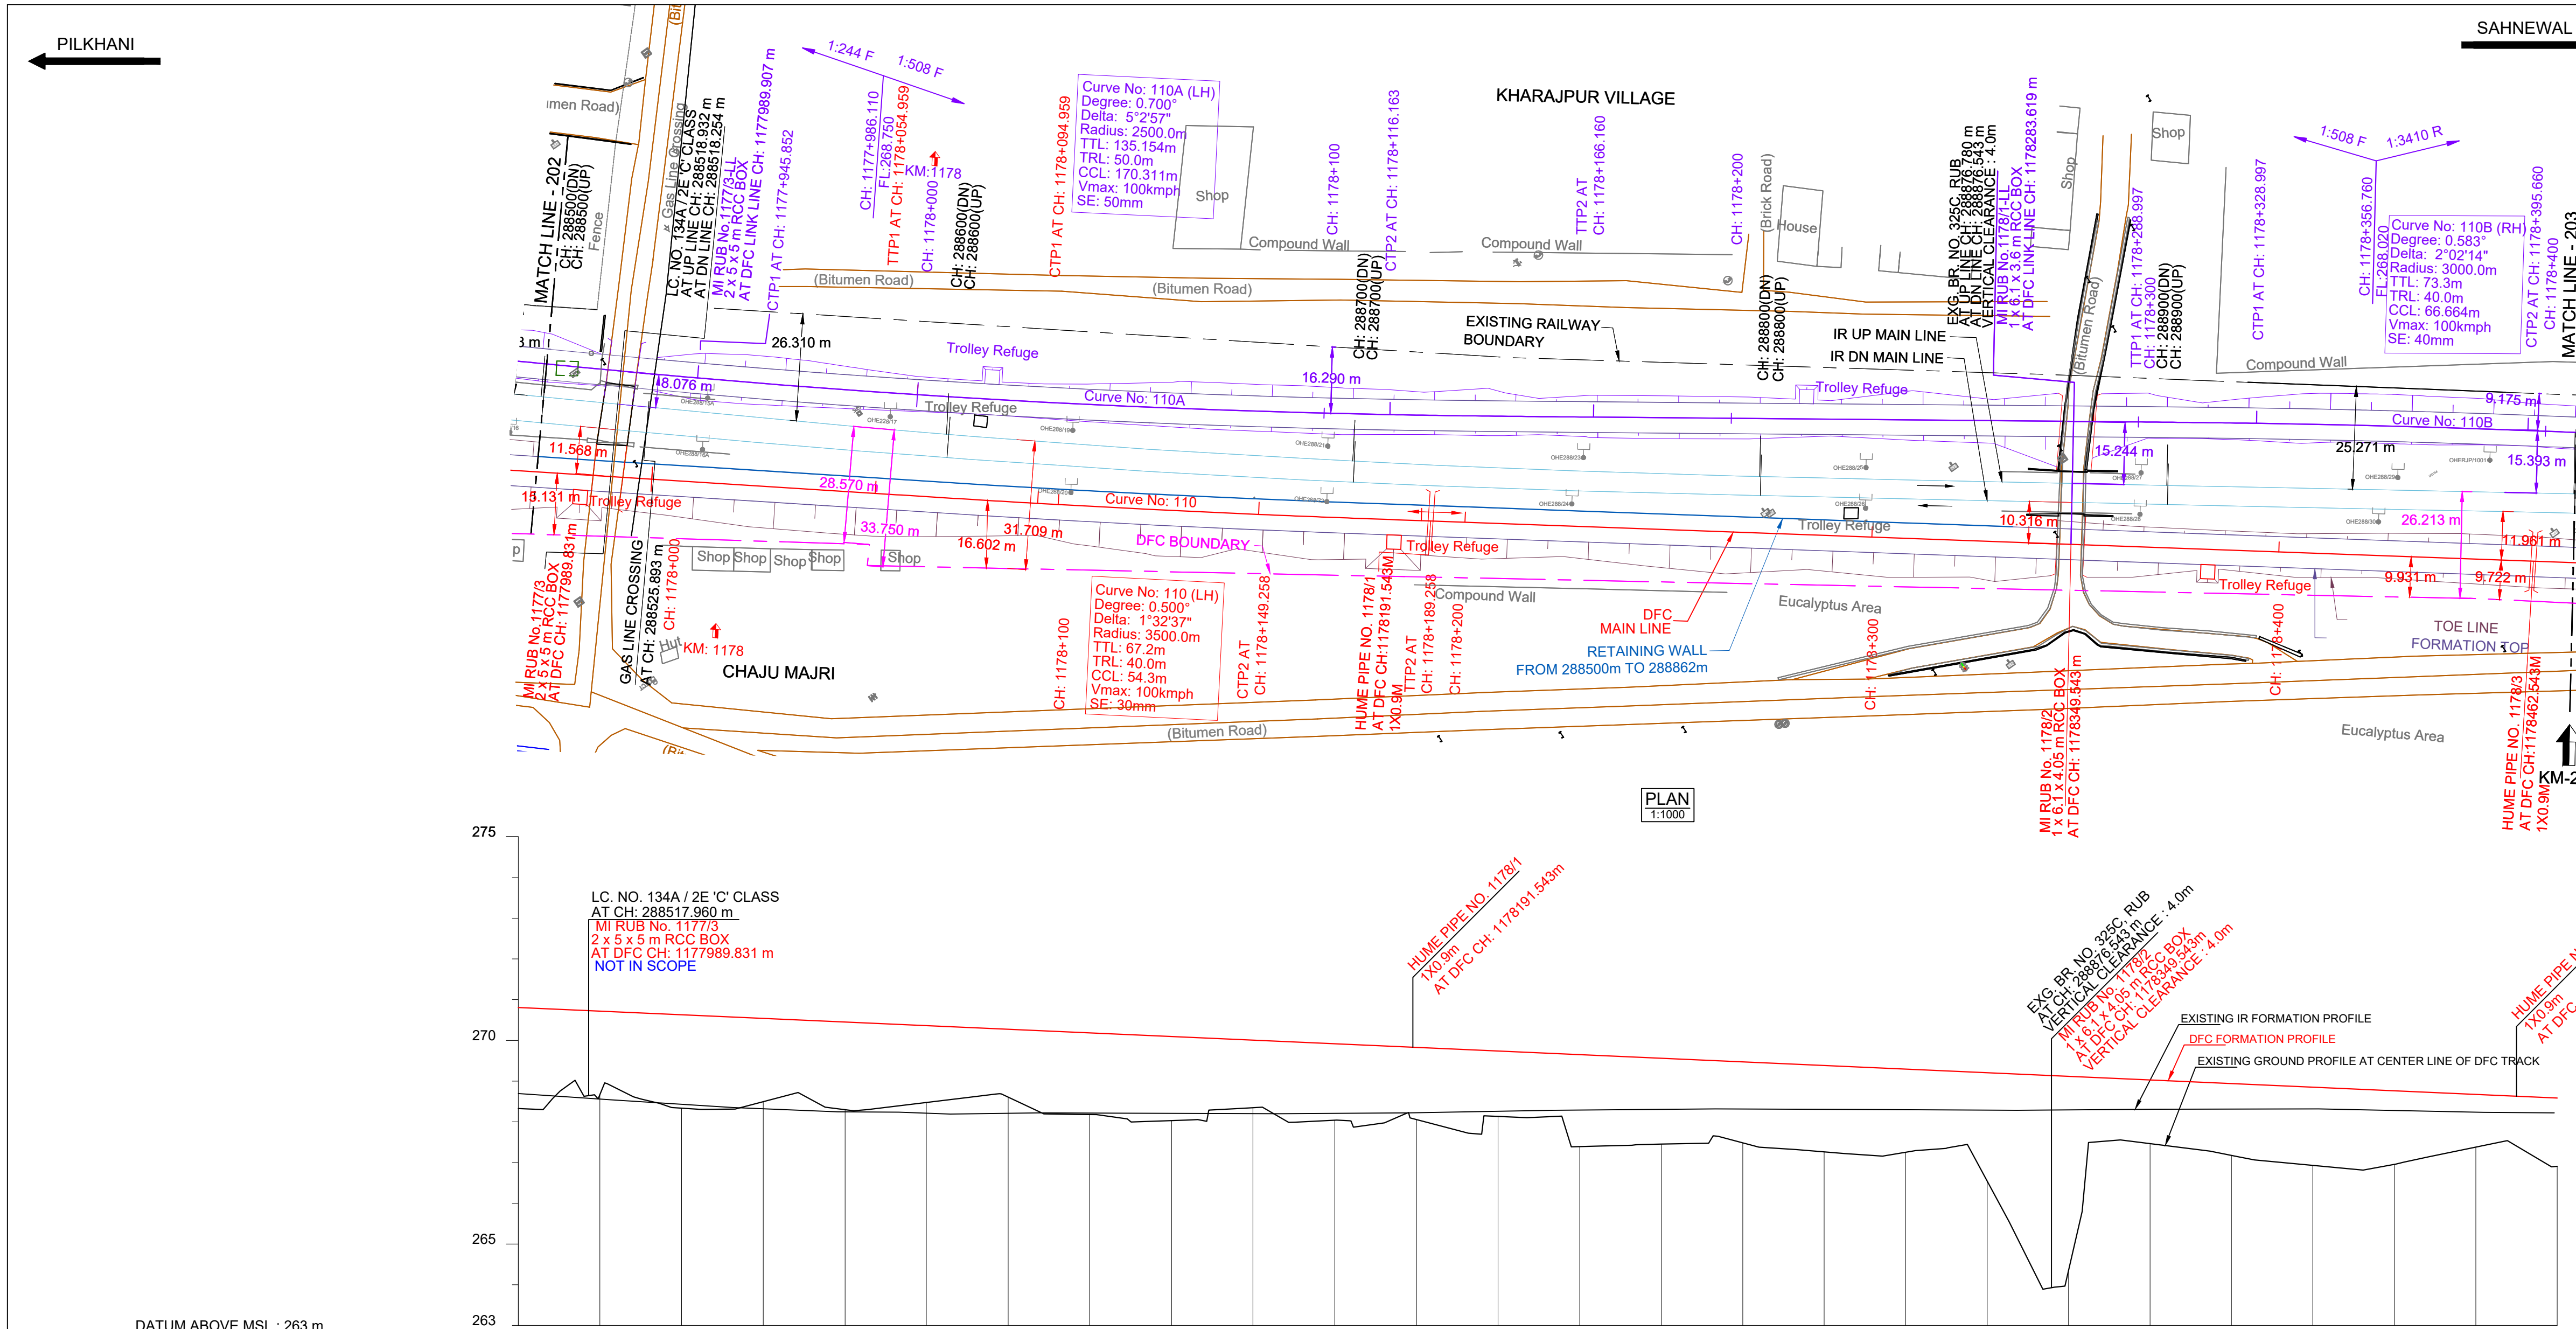

DATUM ABOVE MSL : 263 m

HORIZONTAL ALIGNMENT	L = 153.720m TL= 40m R =3500m TL= 40m L = 524.825m																			
VERTICAL ALIGNMENT	L=1317.982 m 1 IN 227.047 F																			
TRACK DISTANCE FROM EXISTING NEAREST IR DN MAIN LINE TO DFC MAIN LINE	12.103																			
HEIGHT OF BANKING(+) / DEPTH OF CUTTING(-) (PFL-GL)	+2.480	+2.051	+2.293	+2.044	+2.152	+1.888	+1.667	+2.004	+2.065	+1.658	+1.875	+1.772	+1.604	+2.256	+2.107	+2.040	+2.656	+4.761	+1.562	+1.761
EXG GROUND LEVEL AT CENTER LINE OF DFC TRACK (GL)	268.207	268.548	268.218	268.378	268.182	268.358	268.490	268.065	267.915	268.234	267.929	267.944	268.023	267.283	267.344	267.375	266.043	266.488	266.250	267.074
EXG GROUND LEVEL AT TOE LOCATION OF DFC TRACK	268.805	268.779	268.366	268.311	268.757	268.525	268.329	268.211	268.124	268.131	268.152	268.062	268.118	268.154	268.162	268.123	266.015	266.488	268.250	268.259
DIFFERENCE BETWEEN DFC FORMATION LEVEL AND EXG.FORMATION LEVEL (PFL-EFL)	2.095	2.142	2.182	2.203	2.189	2.132	2.047	1.952	1.872	1.790	1.693	1.588	1.463	1.343	1.238	1.140	0.900	0.806	0.702	0.608
DFC FORMATION LEVEL (PFL)	270.687	270.599	270.511	270.422	270.334	270.246	270.157	270.069	269.981	269.893	269.804	269.716	269.628	269.539	269.451	269.363	268.043	269.010	268.922	268.834
EXG. FORMATION LEVEL OF EXG IR DN MAIN LINE (EFL)	268.592	268.457	268.329	268.219	268.145	268.114	268.111	268.117	268.109	268.103	268.111	268.127	268.165	268.196	268.213	268.223	268.216	268.209	268.221	268.227
DIFFERENCE BETWEEN DFC RAIL LEVEL AND EXG. RAIL LEVEL (PRL - ERL)	2.136	2.183	2.223	2.244	2.230	2.173	2.088	1.993	1.913	1.831	1.734	1.629	1.504	1.384	1.279	1.181	0.999	0.847	0.743	0.649
DFC RAIL LEVEL (PRL)	271.400	271.312	271.224	271.135	271.047	270.959	270.870	270.782	270.694	270.606	270.517	270.429	270.341	270.252	270.164	270.076	268.988	269.723	269.635	269.547
EXG.RAIL LEVEL OF NEAREST IR DN MAIN LINE(ERL)	269.264	269.129	269.001	268.891	268.817	268.786	268.783	268.789	268.781	268.775	268.783	268.799	268.837	268.868	268.885	268.895	268.888	268.876	268.893	268.899
EQUIVALENT CHAINAGE ON DFC TRACK	288500.0	288520.0	288540.0	288560.0	288580.0	288600.0	288620.0	288640.0	288660.0	288680.0	288700.0	288720.0	288740.0	288760.0	288780.0	288800.0	288820.0	288840.0	288860.0	288880.0
EXISTING IR CHAINAGE	288500.0	288520.0	288540.0	288560.0	288580.0	288600.0	288620.0	288640.0	288660.0	288680.0	288700.0	288720.0	288740.0	288760.0	288780.0	288800.0	288820.0	288840.0	288860.0	288880.0

L - SECTION

NOTE:-
1. DFC WORKS ARE SHOWN IN RED.
2. IR NEW WORKS ARE SHOWN IN VIOLET.
3. ALL DIMENSIONS ARE SHOWN IN METRES.
4. THIS DRAWING IS PREPARED BASED ON LATEST SURVEY DATA HELD ON APRIL-2022. GTS BENCH MARK OF 261.850M CONSIDERED ON TOP OF CANAL BRIDGE ABUTMENT AT DORANA VILLAGE ALONG THE NH1.
5. DFC NEW CHAINAGE OF 1075.950M IS WITH REFERENCE TO THE IR KM OF 187.500KM END OF KM OF CP-303(SECTION P-3 PILKHANI END) AGAINST THE EXISTING DFC CHAINAGE. 116277.742M ISSUED VIDE LETTER NO. COM/DFCC/CLUB/SURVEY/2021-301-230116-011173.DT. 17.01.2023.
6. BALLAST PROFILE HAS BEEN PROVIDED ACCORDING TO THE CLAUSE 1.1.3 OF STANDARD SCHEDULE OF DIMENSION(EASTERN CORRIDOR) & THE BALLAST CUSHION DIMENSION SHOWN IN 35CM ON GE-14 PARA 17. SPECIFICATIONS & RECOMMENDATIONS 2. TWO LAYER SYSTEM FIG.10.

REFERENCE DRAWINGS :-
1. FOR KEY PLAN REFER DRAWING NO. 301-2/AL/0001
2. FOR LEGEND AND ABBREVIATIONS REFER DRAWING NO. 301-2/AL/1000
3. FOR TYPICAL SECTION OF BALLAST PROFILE (FL-RL) REFER DRG. NO. 301-2/TK/TFD/-004 (TR.1952)

REV.	DATE	SUBMISSION OF AS-BUILT DRAWING	FOR APPROVAL
0	27.08.2024	SUBMISSION OF AS-BUILT DRAWING	FOR APPROVAL

LEGEND:


- IR TRACK
- DFCC TRACK
- LINK LINE (SMUN-RPJ)
- DFCC FUTURE PROPOSALS
- STRUCTURE / BUILDING
- DFCC TOE LINE
- DFCC FORMATION
- RETAINING WALL
- ROAD
- STREAM, DRAIN, NALA, CANAL
- FENCE
- POWER LINES
- TBM
- ELECTRIC POLE/OHE MAST
- IR RAILWAY BOUNDARY
- DFCC BOUNDARY

SCALE

HOR - 1:1000

VER - 1:100

SHEET SIZE : A1

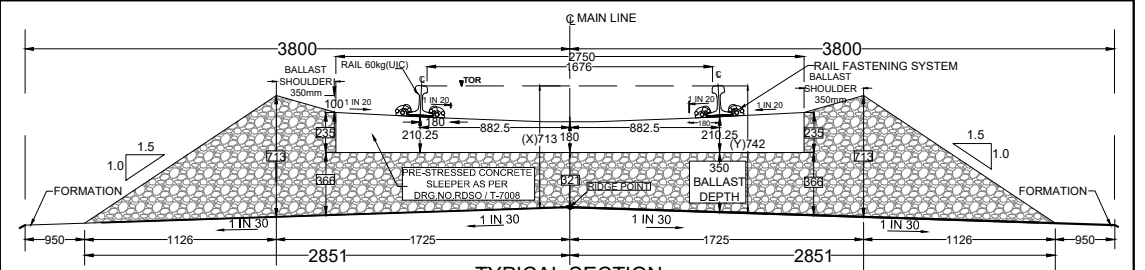

TRACK STRUCTURE		
RAIL SECTION: 60Kg/m (UIC 60Kg/m) DFC LINE: 60Kg/m (UIC 60Kg/m) IR MAIN LINE: 52Kg/m	Difference between FL- RL (Below Rail Seat)	
	IR Line	DFC
RUBBER PAD	172mm	172mm
SLEEPER DEPTH	6mm	10mm
BALLAST CUSHION	210mm	210mm
Total Depth (FL TO RL)	300mm	350mm

OWNER: DEDICATED FREIGHT CORRIDOR CORPORATION OF INDIA LTD. (A GOVERNMENT OF INDIA ENTERPRISE)
PROJECT OFFICE (AMBALA UNIT): OLD RAILWAY COLONY (NEAR ANAND MARKET), AMBALA CANTT-133001.
CORPORATE IDENTITY NO. : U60232DL2006GGI155068

ENGINEER: DB Engineering & Consulting GmbH
Deutsche Bahn Engineering & Consulting GmbH

CONTRACTOR: GIL - TPL JV

SUBMITTED BY	GIL - TPL JV		
	DATED	NAME	SIGNATURE
PREPARED BY			
CHECKED BY	27.08.2024	VIJAY PRATAP	
APPROVED BY	27.08.2024	PARASURAM KOTYADA	

APPROVED BY	DEUTSCHE BAHN ENGINEERING & CONSULTING GMBH		
	DATED	NAME	SIGNATURE
Sr. DE./CHIEF ENGINEER		SURESH K.YALANGI	
CHIEF TRACK ENGINEER		RAJ PAL SINGH	
T.L.		H.D. VIDJAK	

STAMP

AS-BUILT DRAWING
TR. Ref.....
ENGINEER Sign.:

EMPLOYER (DFCCIL):	DEDICATED FREIGHT CORRIDOR CORPORATION OF INDIA LTD.		

TITLE: AS-BUILT PLAN AND PROFILE
FROM IR KM: 288.500 TO 289.000
DFC KM: 1177.972 TO 1178.473

DFCC APPR. NO. -
ENGG. APPR. NO. -
DRG. NO. - 301-2/AL/A/1203
SHEET NO. : 1 OF 1
DATE : 27.08.2024

STATUS: A

TR.