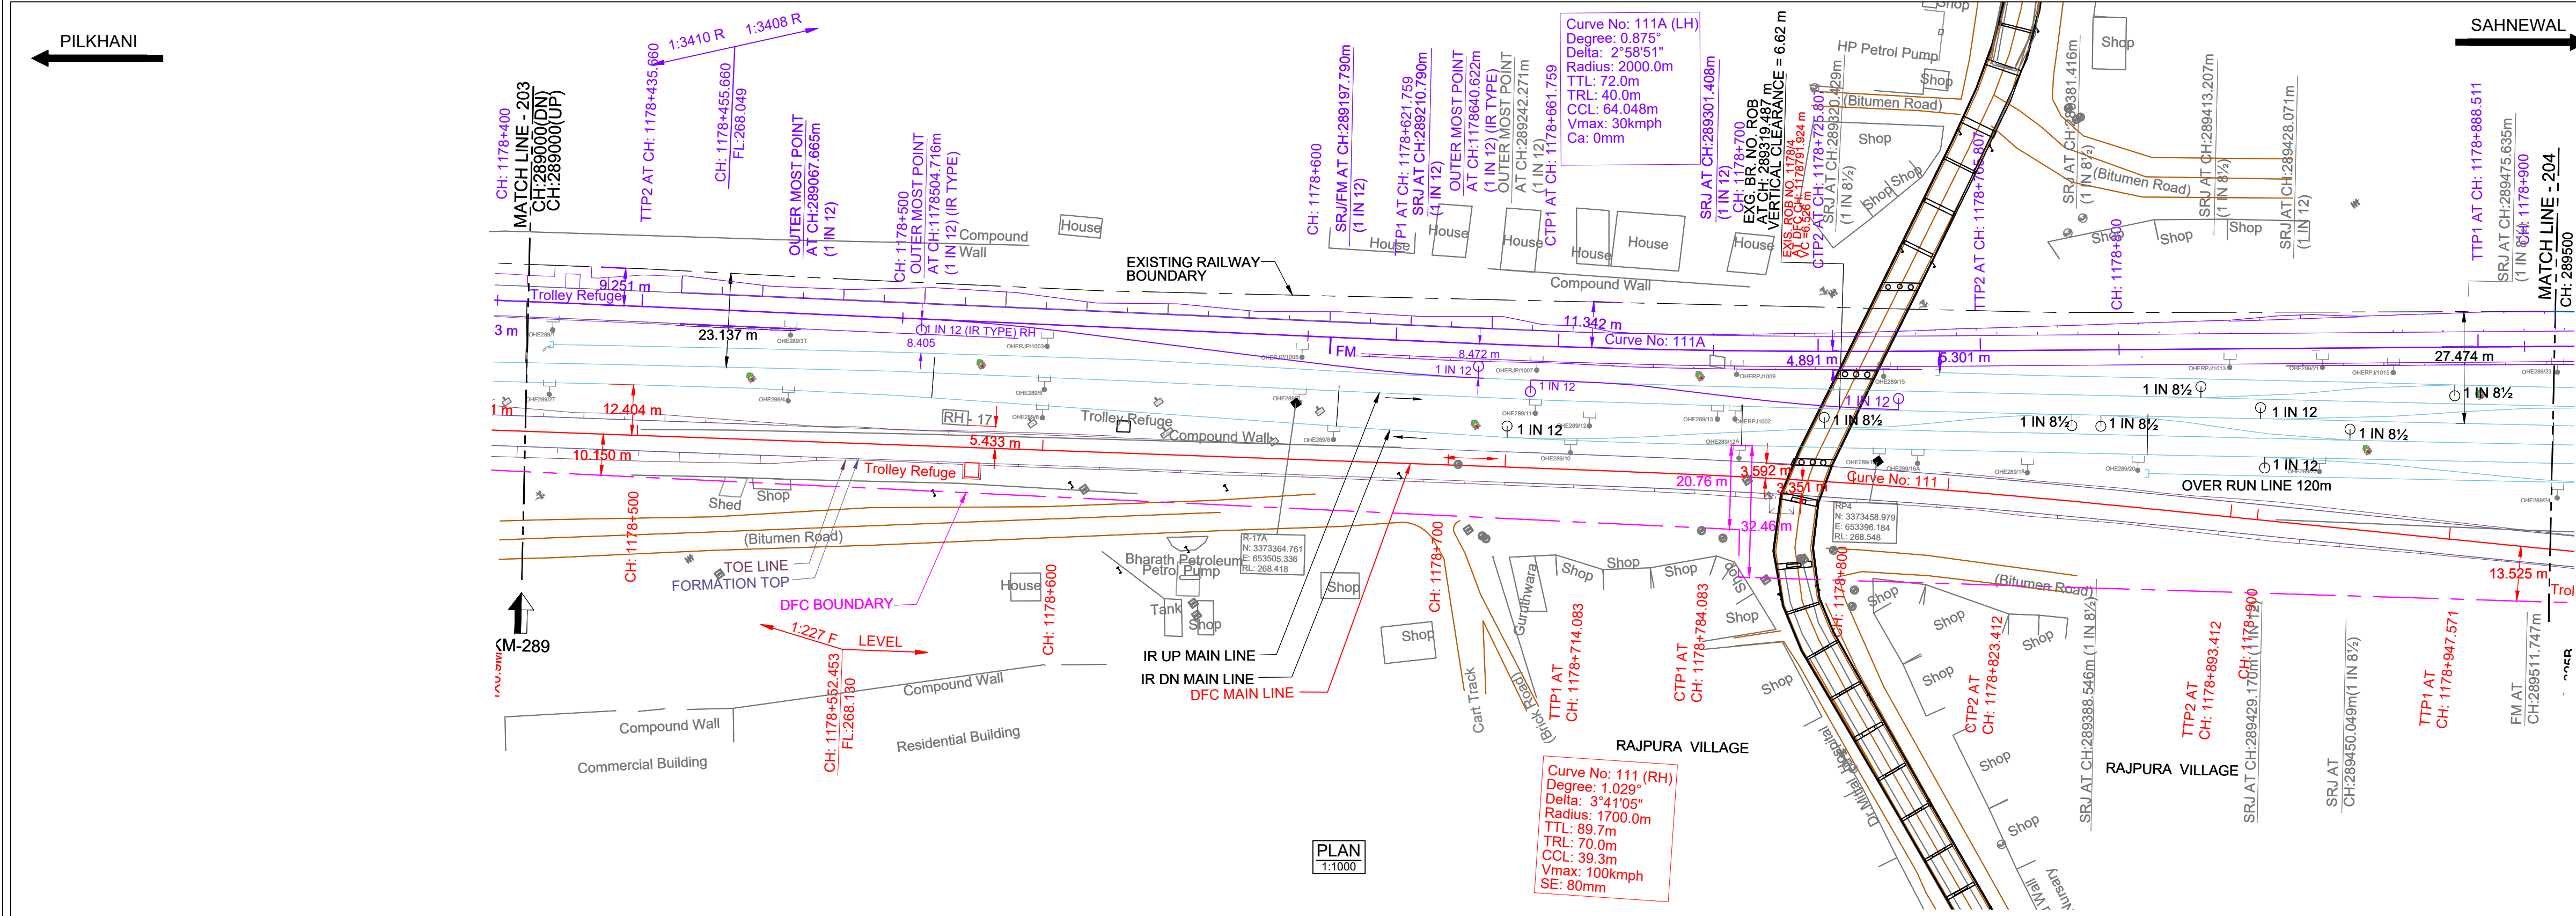


DATUM ABOVE MSL : 266 m

HORIZONTAL ALIGNMENT	L = 524.825m																				TL= 70m
VERTICAL ALIGNMENT	L=1317.982 m 1 IN 227.047 F																				L=1572.113 m LEVEL
TRACK DISTANCE FROM EXISTING NEAREST IR DN MAIN LINE TO DFC MAIN LINE	12.154	12.154	HEIGHT OF BANKING(+) / DEPTH OF CUTTING(-) (PFL-GL)	+1.674	+1.886	+1.595	+1.310	-0.206	-0.117	-0.363	-0.287	-0.377	-0.443	-0.278	-0.692	-0.792	-0.731	-1.105	-0.957	-0.903	-0.576	-0.409	-0.382	-0.859
EXG GROUND LEVEL AT CENTER LINE OF DFC TRACK (GL)	266.808	266.508	266.711	266.908	268.337	268.247	268.493	268.417	268.507	268.573	268.408	268.622	268.922	268.987	269.235	269.087	269.033	268.706	268.539	268.512	268.989
EXG GROUND LEVEL AT TOE LOCATION OF DFC TRACK	267.442	267.570	267.528	267.807	268.310	268.165	268.403	268.428	268.389	268.497	268.521	268.765	268.974	268.987	269.117	269.066	269.015	268.732	268.536	268.487	268.905
DIFFERENCE BETWEEN DFC FORMATION LEVEL AND EXG.FORMATION LEVEL (PFL-EFL)	0.347	0.277	0.198	0.118	0.064	0.082	0.127	0.173	0.190	0.180	0.169	0.143	0.062	-0.012	-0.110	-0.103	-0.054	-0.006	0.039	0.083	0.140
DFC FORMATION LEVEL (PFL)	268.482	268.394	268.306	268.219	268.131	268.130	268.130	268.130	268.130	268.130	268.130	268.130	268.130	268.130	268.130	268.130	268.130	268.130	268.130	268.130	268.130
EXG. FORMATION LEVEL OF EXG IR DN MAIN LINE (EFL)	268.135	268.117	268.108	268.101	268.067	268.048	268.003	267.957	267.940	267.95	267.961	267.987	268.068	268.142	268.240	268.233	268.164	268.136	268.091	268.047	267.990
DIFFERENCE BETWEEN DFC RAIL LEVEL AND EXG. RAIL LEVEL (PRL - ERL)	0.388	0.318	0.239	0.159	0.105	0.123	0.168	0.214	0.231	0.221	0.210	0.184	0.103	0.029	-0.069	-0.062	-0.013	-0.035	-0.030	0.124	0.181
DFC RAIL LEVEL (PRL)	269.195	269.107	269.019	268.932	268.844	268.843	268.843	268.843	268.843	268.843	268.843	268.843	268.843	268.843	268.843	268.843	268.843	268.843	268.843	268.843	268.843
EXG.RAIL LEVEL OF NEAREST IR DN MAIN LINE(ERL)	268.807	268.789	268.780	268.773	268.739	268.720	268.675	268.629	268.612	268.622	268.633	268.659	268.740	268.814	268.912	268.905	268.856	268.808	268.763	268.719	268.662
EQUIVALENT CHAINAGE ON DFC TRACK	289000.0	289020.0	289040.0	289060.0	289080.0	289100.0	289120.0	289140.0	289160.0	289180.0	289200.0	289220.0	289240.0	289260.0	289280.0	289300.0	289320.0	289340.0	289360.0	289380.0	289400.0
EXISTING IR CHAINAGE	289000.0	289020.0	289040.0	289060.0	289080.0	289100.0	289120.0	289140.0	289160.0	289180.0	289200.0	289220.0	289240.0	289260.0	289280.0	289300.0	289320.0	289340.0	289360.0	289380.0	289400.0

L - SECTION

NOTE:-

- DFCC WORKS ARE SHOWN IN RED.
- IR NEW WORKS ARE SHOWN IN VIOLET.
- ALL DIMENSIONS ARE SHOWN IN METRES.
- THIS DRAWING IS PREPARED BASED ON LATEST SURVEY DATA HELD ON APRIL-2022. GTS BENCH MARK OF 261.850M CONSIDERED ON TOP OF CANAL BRIDGE ABUTMENT AT DORAH VILLAGE ALONG THE NH1.
- DFC NEW CHAINAGE OF 1075.950M IS WITH REFERENCE TO THE IR KM OF 187.500KM END OF KM OF CP-303(SECTION P-3 PILKHANI END) AGAINST THE EXISTING DFC CHAINAGE. 116277.742M ISSUED VIDE LETTER NO. COM/DFCC/MB/SURVEY/2021-301-280116-01173.DT. 17.01.2023.
- BALLAST PROFILE HAS BEEN PROVIDED ACCORDING TO THE CLAUSE 1.11.3 OF STANDARD SCHEDULE OF DIMENSION(EASTERN CORRIDOR) & THE BALLAST CUSHION DIMENSION SHOWN IN 35CM ON GE-14 PARA 17. SPECIFICATIONS & RECOMMENDATIONS 2. TWO LAYER SYSTEM FIG.10.

REFERENCE DRAWINGS :-

- FOR KEY PLAN REFER DRAWING NO. 301-2/AL/0001
- FOR LEGEND AND ABBREVIATIONS REFER DRAWING NO. 301-2/AL/1000
- FOR TYPICAL SECTION OF BALLAST PROFILE (FL-RL) REFER DRG. NO. 301-2/TK/TFD/-004 (TR.1952)

SCALE

HOR - 1:1000

VER - 1:100

SHEET SIZE : A1

LEGEND:

IR TRACK
DFCC TRACK
LINK LINE (SMUN-RP-J)
DFCC FUTURE PROPOSALS
STRUCTURE / BUILDING
DFCC TOE LINE
DFCC FORMATION
RETAINING WALL
ROAD
STREAM, DRAIN, NALA, CANAL.
FENCE
POWER LINES
TBM
ELECTRIC POLE/OHE MAST
IR RAILWAY BOUNDARY
DFCC BOUNDARY

TYPICAL SECTION

TRACK STRUCTURE

RAIL SECTION: 60Kg/m (UIC 60Kg/m) DFC LINE: 60Kg/m (UIC 60Kg/m) IR MAIN LINE: 52Kg/m	Difference between FL- RL (Below Rail Seat)	
	IR Line	DFC
RUBBER PAD	172mm	172mm
SLEEPER DEPTH	6mm	10mm
BALLAST CUSHION	210mm	210mm
	300mm	350mm
Total Depth (FL TO RL)	688mm	742mm

OWNER

DEDICATED FREIGHT CORRIDOR CORPORATION OF INDIA LTD.

(A GOVERNMENT OF INDIA ENTERPRISE)

PROJECT OFFICE(AMBALA UNIT): OLD RAILWAY COLONY (NEAR ANAND MARKET),AMBALA CANTT-133001.

CORPORATE IDENTITY NO. : U60232DL2006GG0115068

ENGINEER:

DB Engineering & Consulting GmbH

Deutsche Bahn Engineering & Consulting GmbH

CONTRACTOR:

GIL - TPL JV

GAR TATA

SUBMITTED BY	GIL - TPL JV		
	DATED	NAME	SIGNATURE
PREPARED BY			
CHECKED BY	27.08.2024	VIJAY PRATAP	
APPROVED BY	27.08.2024	PARASURAM KOTYADA	

APPROVED BY

DEUTSCHE BAHN ENGINEERING & CONSULTING GMBH

	DATED	NAME	SIGNATURE
Sr. DE./CHIEF ENGINEER		SURESH K.YALANGI	
CHIEF TRACK ENGINEER		RAJ PAL SINGH	
T.L.		H.D. VIDJAK	

STAMP

AS-BUILT DRAWING

TR. Ref.....

ENGINEER Sign.:

EMPLOYER (DFCCIL):

DEDICATED FREIGHT CORRIDOR CORPORATION OF INDIA LTD.

TITLE

AS-BUILT PLAN AND PROFILE

DFCC APPR. NO. -

ENGG. APPR. NO. -

DRG. NO. - 301-2/AL/A/1204

SHEET NO. : 1 OF 1

DATE : 27.08.2024

STATUS

A

TR.