


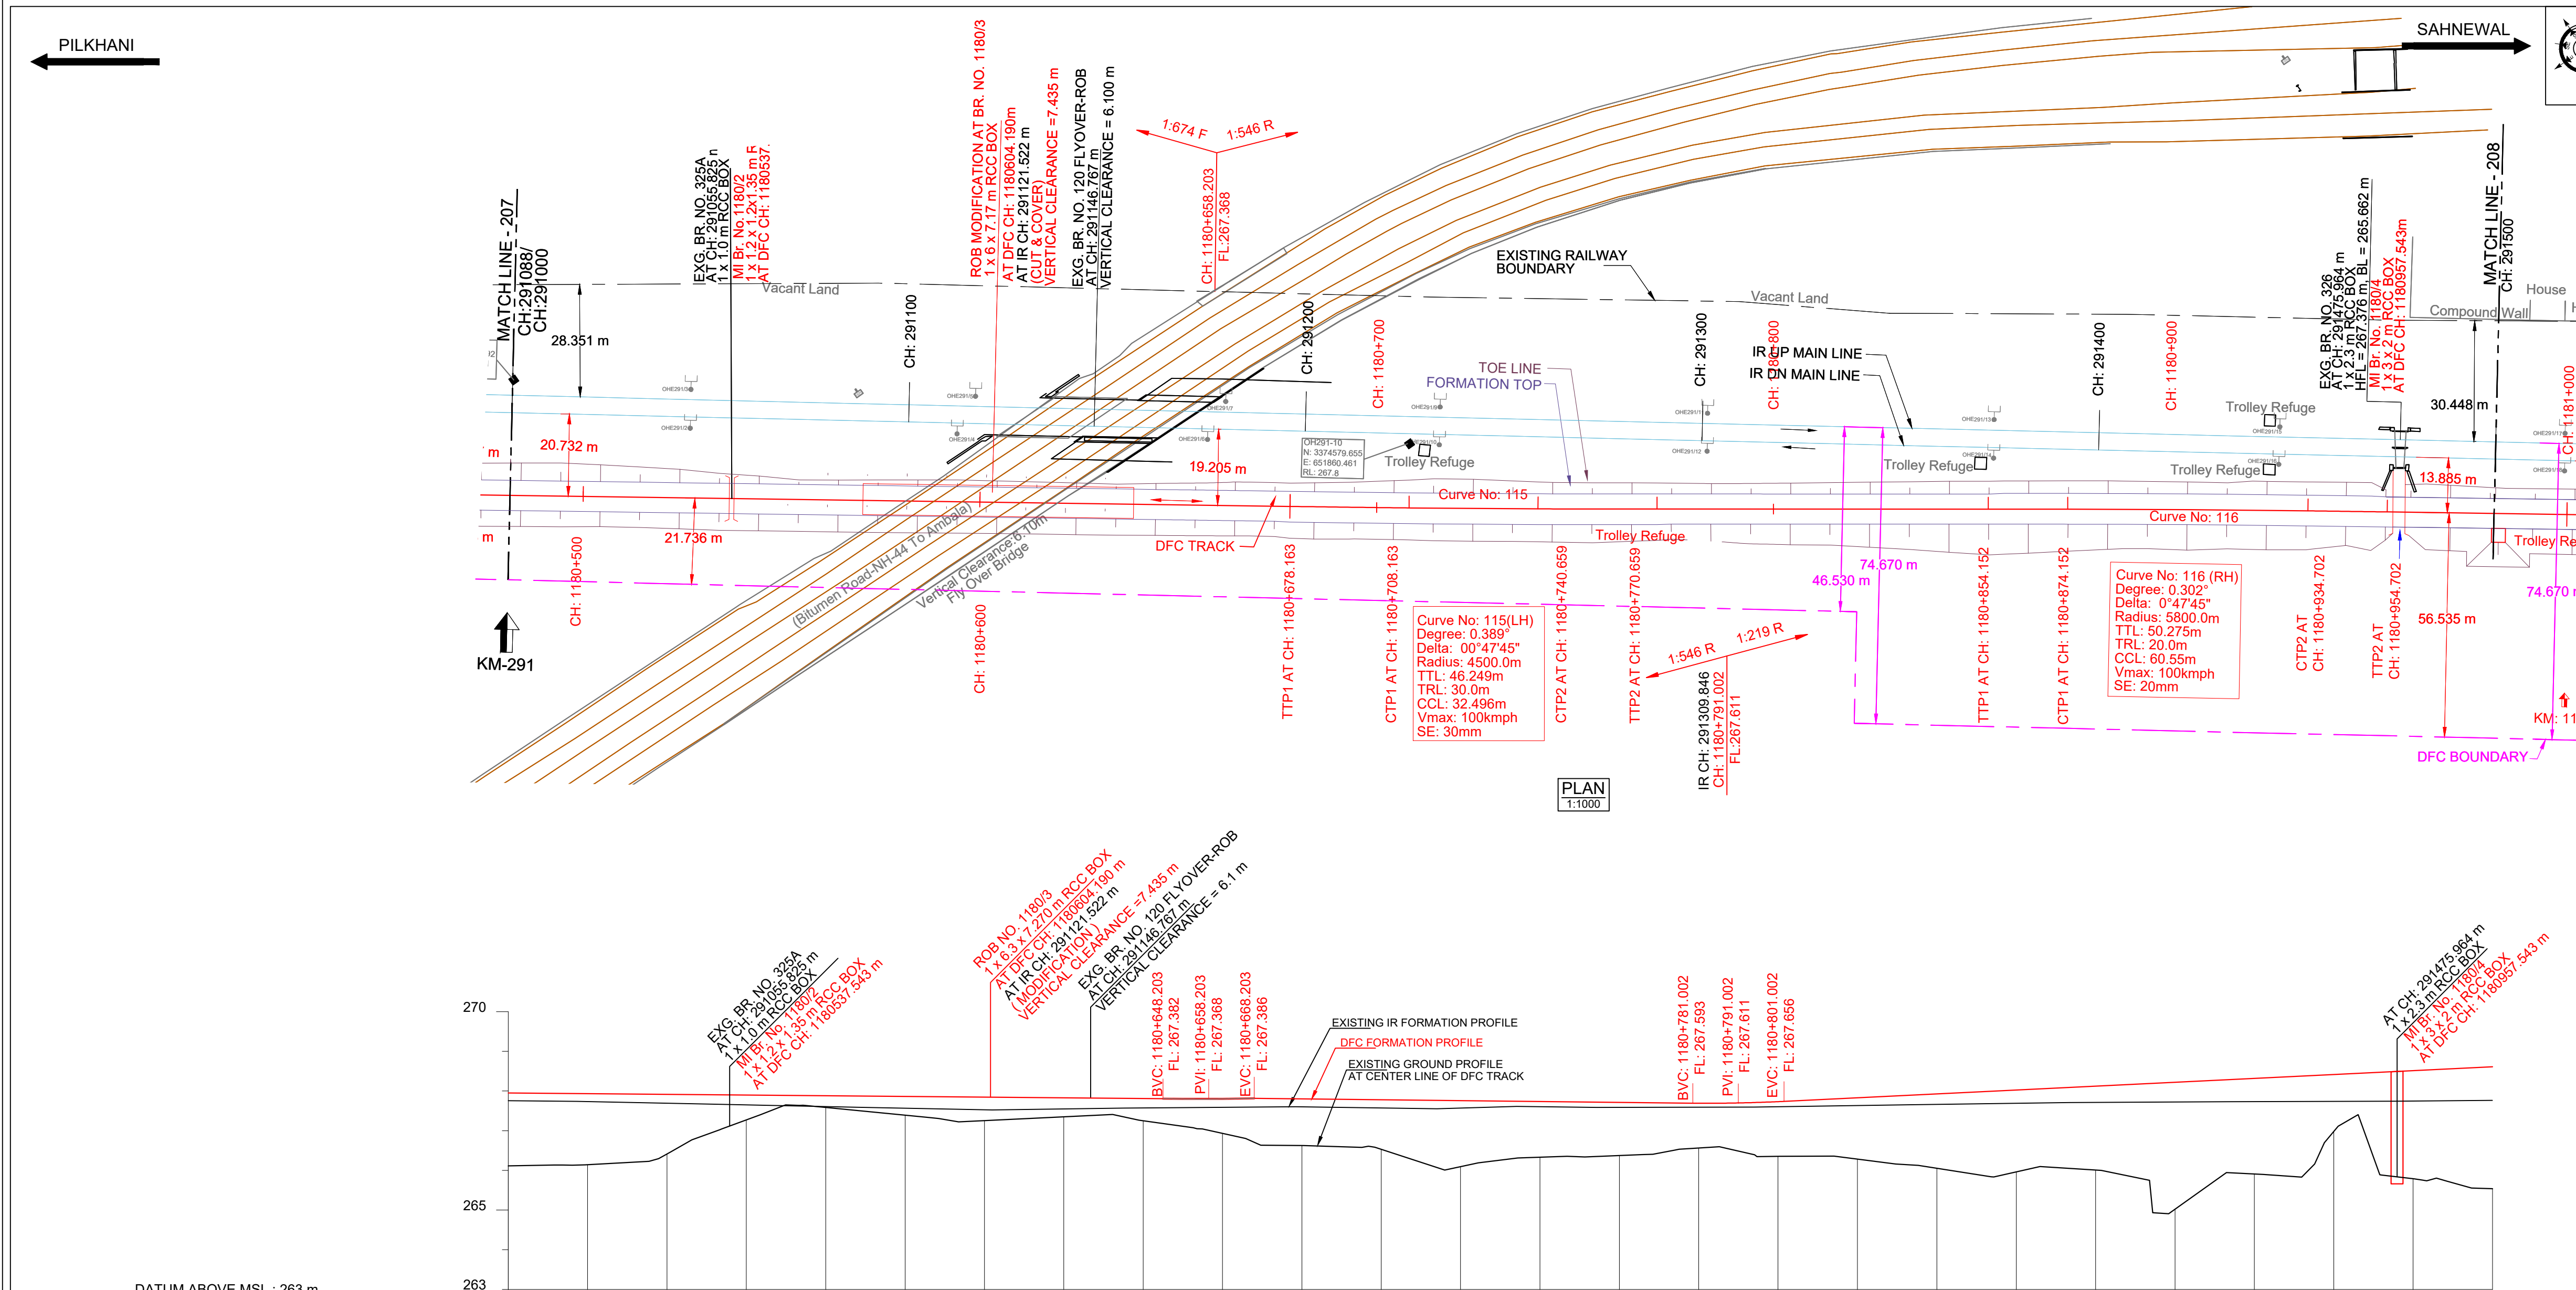

DATUM ABOVE MSL : 263 m

HORIZONTAL ALIGNMENT	L = 393.750m TL= 30m R =4500m TL= 30m L = 83.493m TL= 20m R =5800m TL= 20m L = 229.287m																									
VERTICAL ALIGNMENT	L=504.140 m 1 IN 674.292 F L=20.0 m R=6032 m L=112.799 m 1 IN 545.660 R L=20.0 m R=7344 m L=485.500 m 1 IN 219.488 R																									
TRACK DISTANCE FROM EXISTING NEAREST IR DN MAIN LINE TO DFC MAIN LINE	20.848	20.848	20.659	20.470	20.285	20.104	19.929	19.758	19.570	19.382	19.205	19.008	18.802	18.525	18.152	17.710	17.247	16.776	16.286	15.809	15.357	14.937	14.592	14.067	13.885	13.707
HEIGHT OF BANKING(+) / DEPTH OF CUTTING(-) (PFL-GL)	+1.609	+1.609	+1.550	+1.250	+0.360	+0.018	+0.181	+0.291	+0.165	+0.236	+0.538	+0.874	+1.002	+1.473	+1.268	+1.260	+1.102	+1.379	+1.546	+1.876	+2.063	+2.113	+3.197	+1.435	+2.722	+3.073
EXG GROUND LEVEL AT CENTER LINE OF DFC TRACK (GL)	266.021	266.302	266.050	266.321	267.181	267.493	267.300	267.161	267.257	267.157	266.837	266.538	266.446	266.012	266.253	266.298	266.492	266.281	266.205	265.967	265.871	265.912	264.918	266.863	265.667	265.408
EXG GROUND LEVEL AT TOE LOCATION OF DFC TRACK	266.302	266.330	266.330	266.550	267.045	267.426	267.353	267.338	267.412	267.328	267.098	267.062	266.662	266.499	266.791	266.843	266.925	266.906	266.843	266.782	266.807	266.775	266.853	266.629	266.629	267.004
DIFFERENCE BETWEEN DFC FORMATION LEVEL AND EXG.FORMATION LEVEL (PFL-EFL)	-0.051	-0.051	-0.058	-0.047	-0.036	-0.022	-0.011	-0.001	-0.050	-0.104	-0.136	-0.119	-0.057	-0.021	-0.021	0.028	0.057	0.110	0.178	0.248	0.317	0.393	0.479	0.660	0.751	0.832
DFC FORMATION LEVEL (PFL)	267.630	267.630	267.600	267.571	267.541	267.511	267.482	267.452	267.422	267.393	267.374	267.411	267.448	267.484	267.521	267.558	267.594	267.660	267.751	267.842	267.934	268.025	268.116	268.298	268.389	268.480
EXG. FORMATION LEVEL OF EXG IR DN MAIN LINE (EFL)	267.681	267.658	267.618	267.576	267.533	267.492	267.453	267.412	267.353	267.287	267.250	267.199	267.148	267.098	267.047	266.997	266.946	266.895	266.844	266.793	266.742	266.691	266.640	266.589	266.538	266.487
DIFFERENCE BETWEEN DFC RAIL LEVEL AND EXG. RAIL LEVEL (PRL - ERL)	-0.010	-0.017	-0.006	0.005	0.019	0.030	0.040	-0.009	-0.009	-0.063	-0.095	-0.078	-0.016	0.020	0.020	0.069	0.098	0.151	0.219	0.289	0.358	0.434	0.520	0.701	0.792	0.873
DFC RAIL LEVEL (PRL)	268.343	268.313	268.284	268.254	268.224	268.165	268.135	268.106	268.087	268.028	267.977	267.926	267.875	267.824	267.773	267.722	267.671	267.620	267.569	267.518	267.467	267.416	267.365	267.314	267.263	267.212
EXG.RAIL LEVEL OF NEAREST IR DN MAIN LINE(ERL)	268.353	268.330	268.290	268.248	268.205	268.125	268.104	268.083	268.062	267.993	267.942	267.891	267.840	267.789	267.738	267.687	267.636	267.585	267.534	267.483	267.432	267.381	267.330	267.279	267.228	267.177
EQUIVALENT CHAINAGE ON DFC TRACK	291087.61	2910901.7	2910921.7	2910941.7	2910961.7	2910981.7	2911001.7	2911021.7	2911041.7	2911061.7	2911081.7	2911101.7	2911121.7	2911141.7	2911161.7	2911181.7	2911201.7	2911221.7	2911241.7	2911261.7	2911281.7	2911301.7	2911321.7	2911341.7	2911361.7	2911381.7
EXISTING IR CHAINAGE	291087.61	2910901.7	2910921.7	2910941.7	2910961.7	2910981.7	2911001.7	2911021.7	2911041.7	2911061.7	2911081.7	2911101.7	2911121.7	2911141.7	2911161.7	2911181.7	2911201.7	2911221.7	2911241.7	2911261.7	2911281.7	2911301.7	2911321.7	2911341.7	2911361.7	2911381.7

L - SECTION

- NOTE:-
- DFCC WORKS ARE SHOWN IN RED.
 - IR NEW WORKS ARE SHOWN IN VIOLET.
 - ALL DIMENSIONS ARE SHOWN IN METRES.
 - THIS DRAWING IS PREPARED BASED ON LATEST SURVEY DATA HELD ON APRIL-2022. GTS BENCH MARK OF 261.850M CONSIDERED ON TOP OF CANAL BRIDGE ABUTMENT AT DORANA VILLAGE ALONG THE NH1.
 - DFC NEW CHAINAGE OF 1075.950M IS WITH REFERENCE TO THE IR KM OF 187.500KM END OF KM OF CP-303(SECTION P-3 PILKHANI END) AGAINST THE EXISTING DFC CHAINAGE. 116277.742M ISSUED VIDE LETTER NO. COM/DFCC/MB/SURVEY/2021-301-290116-011173 DT. 17.01.2023.
 - BALLAST PROFILE HAS BEEN PROVIDED ACCORDING TO THE CLAUSE 1.11.3 OF STANDARD SCHEDULE OF DIMENSION(EASTERN CORRIDOR) & THE BALLAST CUSHION DIMENSION SHOWN IN 35CM ON GE-14 PARA 17. SPECIFICATIONS & RECOMMENDATIONS 2. TWO LAYER SYSTEM FIG.10.


- REFERENCE DRAWINGS :-
- FOR KEY PLAN REFER DRAWING NO. 301-2/AL/0001
 - FOR LEGEND AND ABBREVIATIONS REFER DRAWING NO. 301-2/AL/1000
 - FOR TYPICAL SECTION OF BALLAST PROFILE (FL-RL) REFER DRG. NO. 301-2/TK/TFD/004 (TR.1952)

REV.	DATE	REVISION DETAILS	PURPOSE OF ISSUE
0	27.08.2024	SUBMISSION OF AS-BUILT DRAWING	FOR APPROVAL

LEGEND:

IR TRACK
DFCC TRACK
LINK LINE (SMUN-RP-J)
DFCC FUTURE PROPOSALS
STRUCTURE / BUILDING
DFCC TOE LINE
DFCC FORMATION
RETAINING WALL
ROAD
STREAM, DRAIN, NALA, CANAL.
FENCE
POWER LINES
TBM
ELECTRIC POLE/OHE MAST
IR RAILWAY BOUNDARY
DFCC BOUNDARY

SCALE
HOR - 1:1000
VER - 1:100
SHEET SIZE : A1

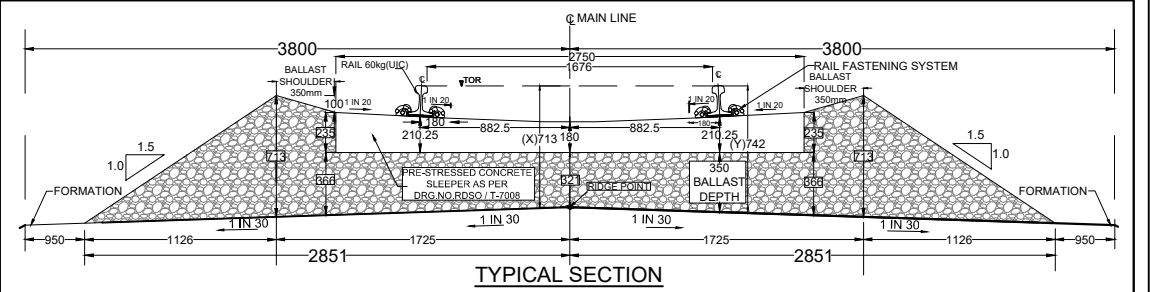

TRACK STRUCTURE		
RAIL SECTION: 60Kg/m (UIC 60Kg/m) DFC LINE: 60Kg/m (UIC 60Kg/m) IR MAIN LINE: 52Kg/m	Difference between FL- RL (Below Rail Seat)	
	IR Line	DFC
RUBBER PAD	172mm	172mm
SLEEPER DEPTH	6mm	10mm
BALLAST CUSHION	210mm	210mm
Total Depth (FL TO RL)	688mm	742mm

OWNER
DEDICATED FREIGHT CORRIDOR CORPORATION OF INDIA LTD.
(A GOVERNMENT OF INDIA ENTERPRISE)
PROJECT OFFICE(AMBALA UNIT): OLD RAILWAY COLONY (NEAR ANAND MARKET),AMBALA CANTT.-133001.
CORPORATE IDENTITY NO. : U60232DL2006G01155068

ENGINEER:
DB Engineering & Consulting GmbH
Deutsche Bahn Engineering & Consulting GmbH

CONTRACTOR:
GIL - TPL JV
GAR TATA

SUBMITTED BY	GIL - TPL JV		
	DATED	NAME	SIGNATURE
PREPARED BY			
CHECKED BY	27.08.2024	VIJAY PRATAP	
APPROVED BY	27.08.2024	PARASURAM KOTYADA	

APPROVED BY	DEUTSCHE BAHN ENGINEERING & CONSULTING GMBH		
	DATED	NAME	SIGNATURE
Sr. DE./CHIEF ENGINEER		SURESH K.YALANGI	
CHIEF TRACK ENGINEER		RAJ PAL SINGH	
T.L.		H.D. VIDJAK	

STAMP	A AS-BUILT DRAWING TR. Ref.:..... ENGINEER Sign.:.....		
EMPLOYER (DFCCIL):	DEDICATED FREIGHT CORRIDOR CORPORATION OF INDIA LTD.		

AS BUILT DRAWING			
TITLE AS-BUILT PLAN AND PROFILE		DFCC APPR. NO. - ENGG. APPR. NO. -	
FROM IR KM: 291.000 TO 291.500 DFC KM: 1180.482 TO 1180.982		DRG. NO. -301-2/AL/A/1208 SHEET NO. : 1 OF 1 DATE : 27.08.2024	
		STATUS A	

TR.