


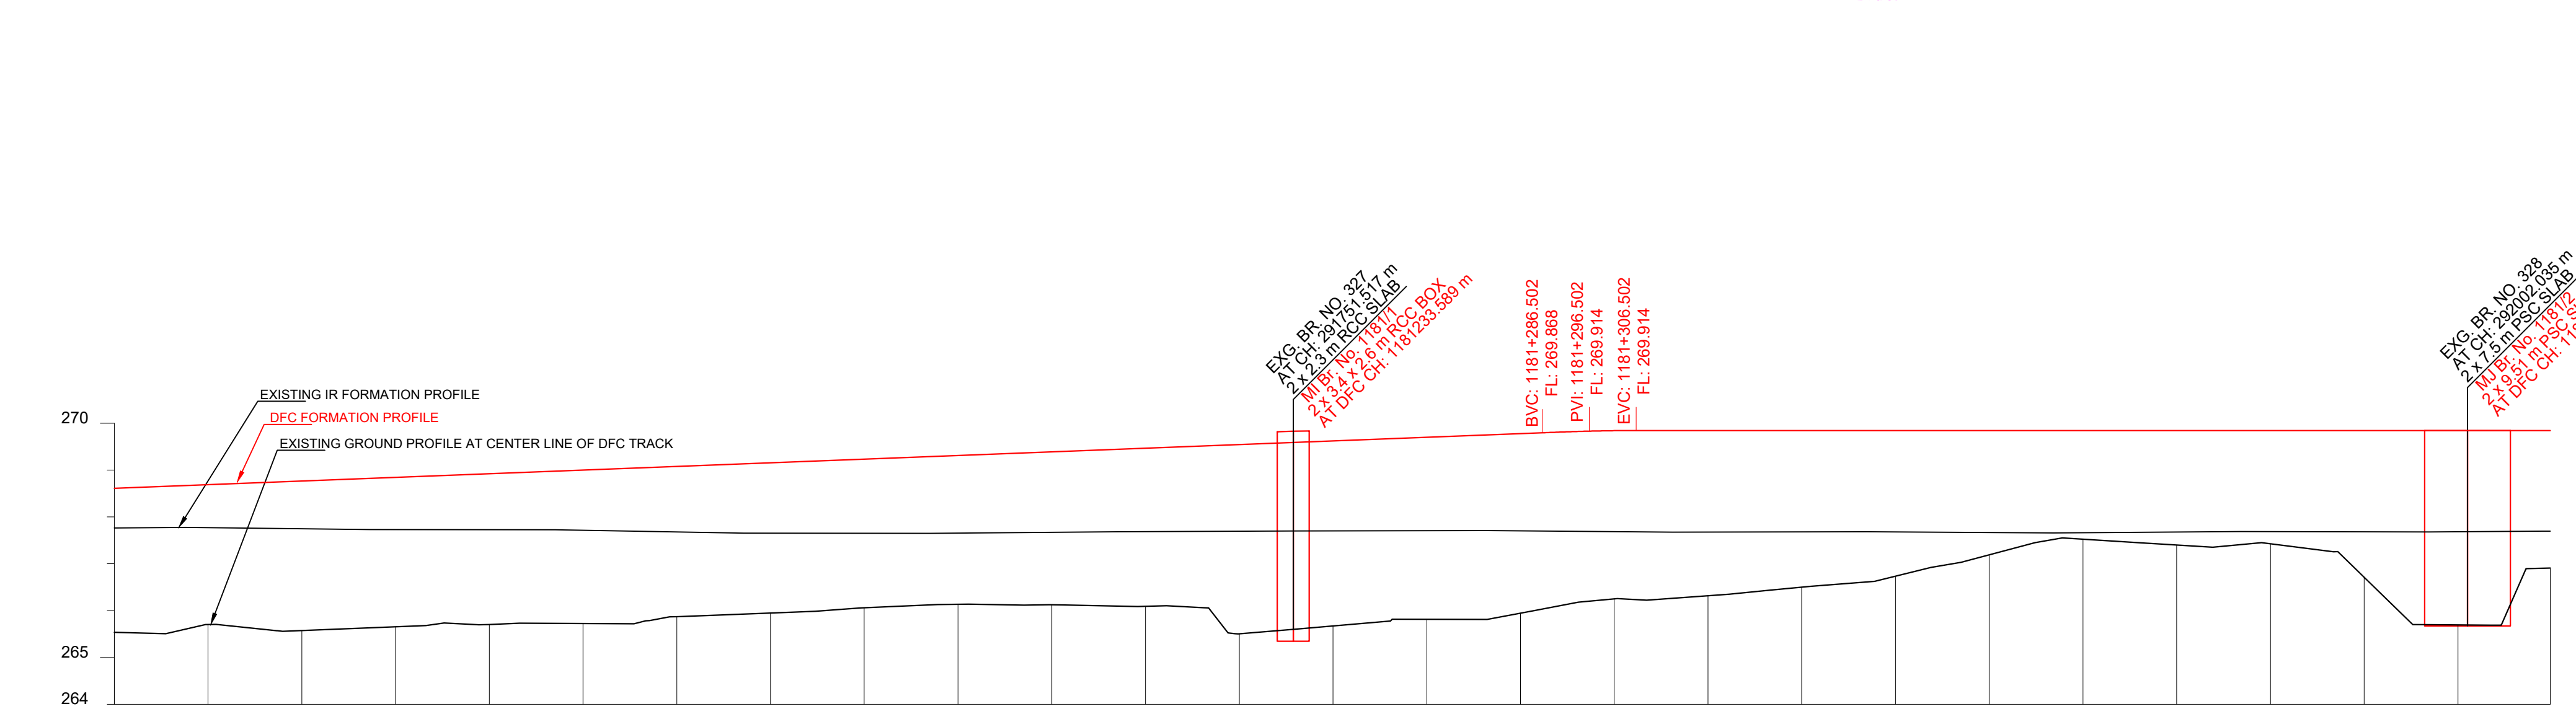

AS BUILT DRAWING		
TITLE AS-BUILT PLAN AND PROFILE FROM IR KM: 291.500 TO 292.000 DFC KM: 1180.982 TO 1181.501	DFC APPR. NO. - ENGG. APPR. NO. - DRG. NO. -301-2/AL/A/1209	STATUS A
	SHEET NO. : 1 OF 1	
	DATE : 27.08.2024	

TR.
