
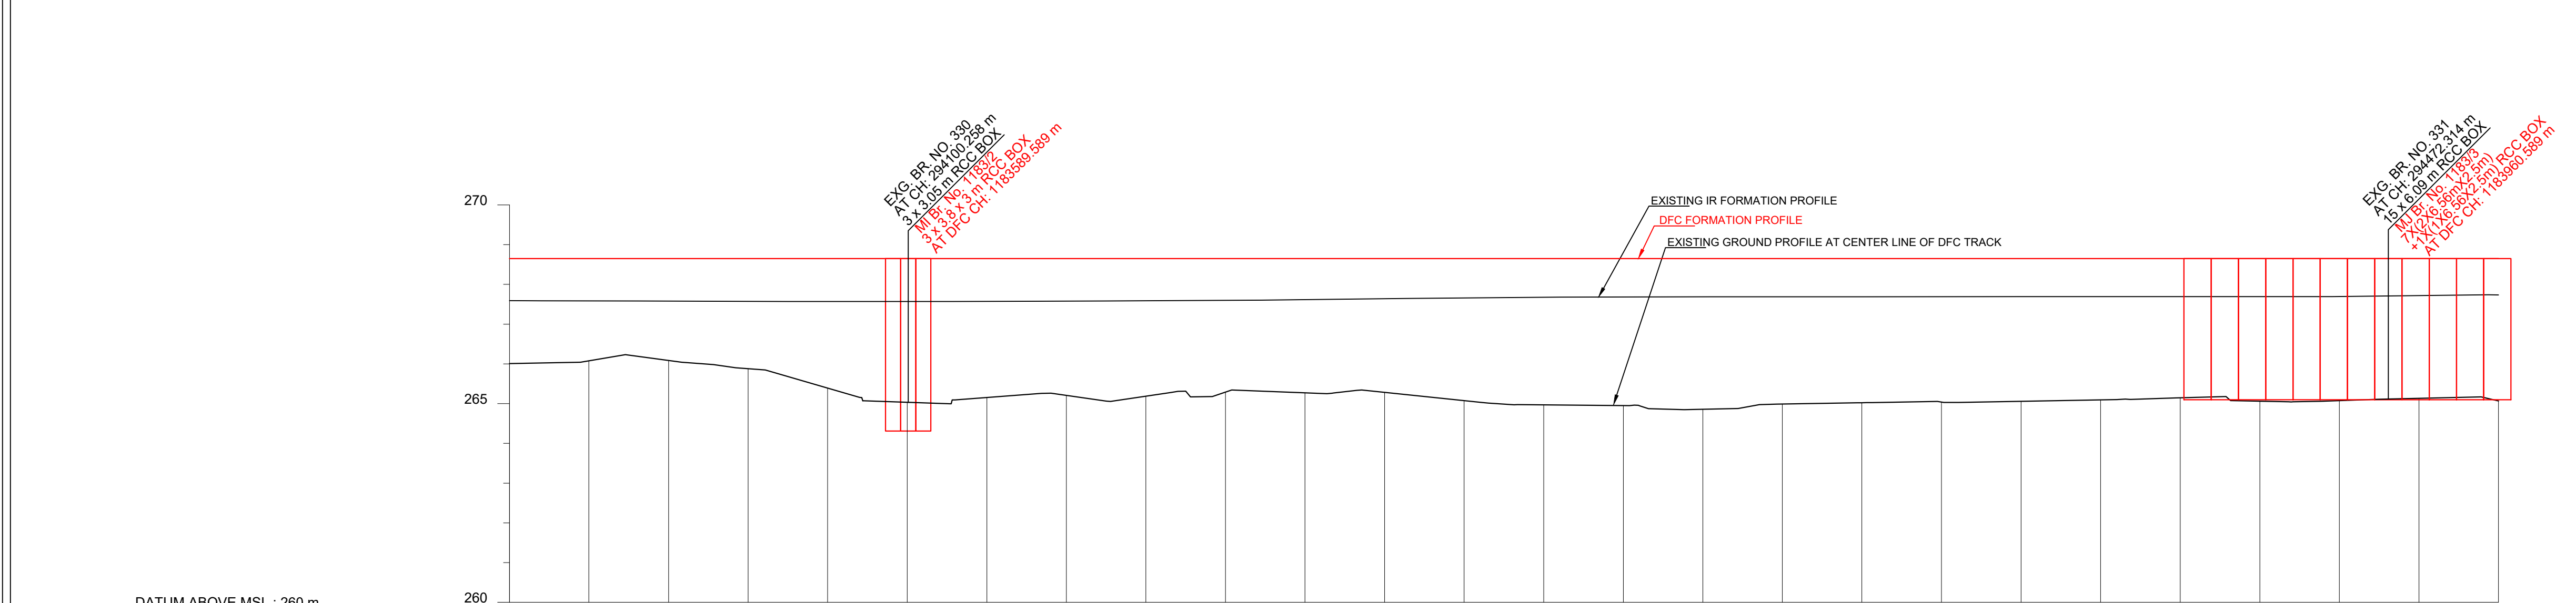


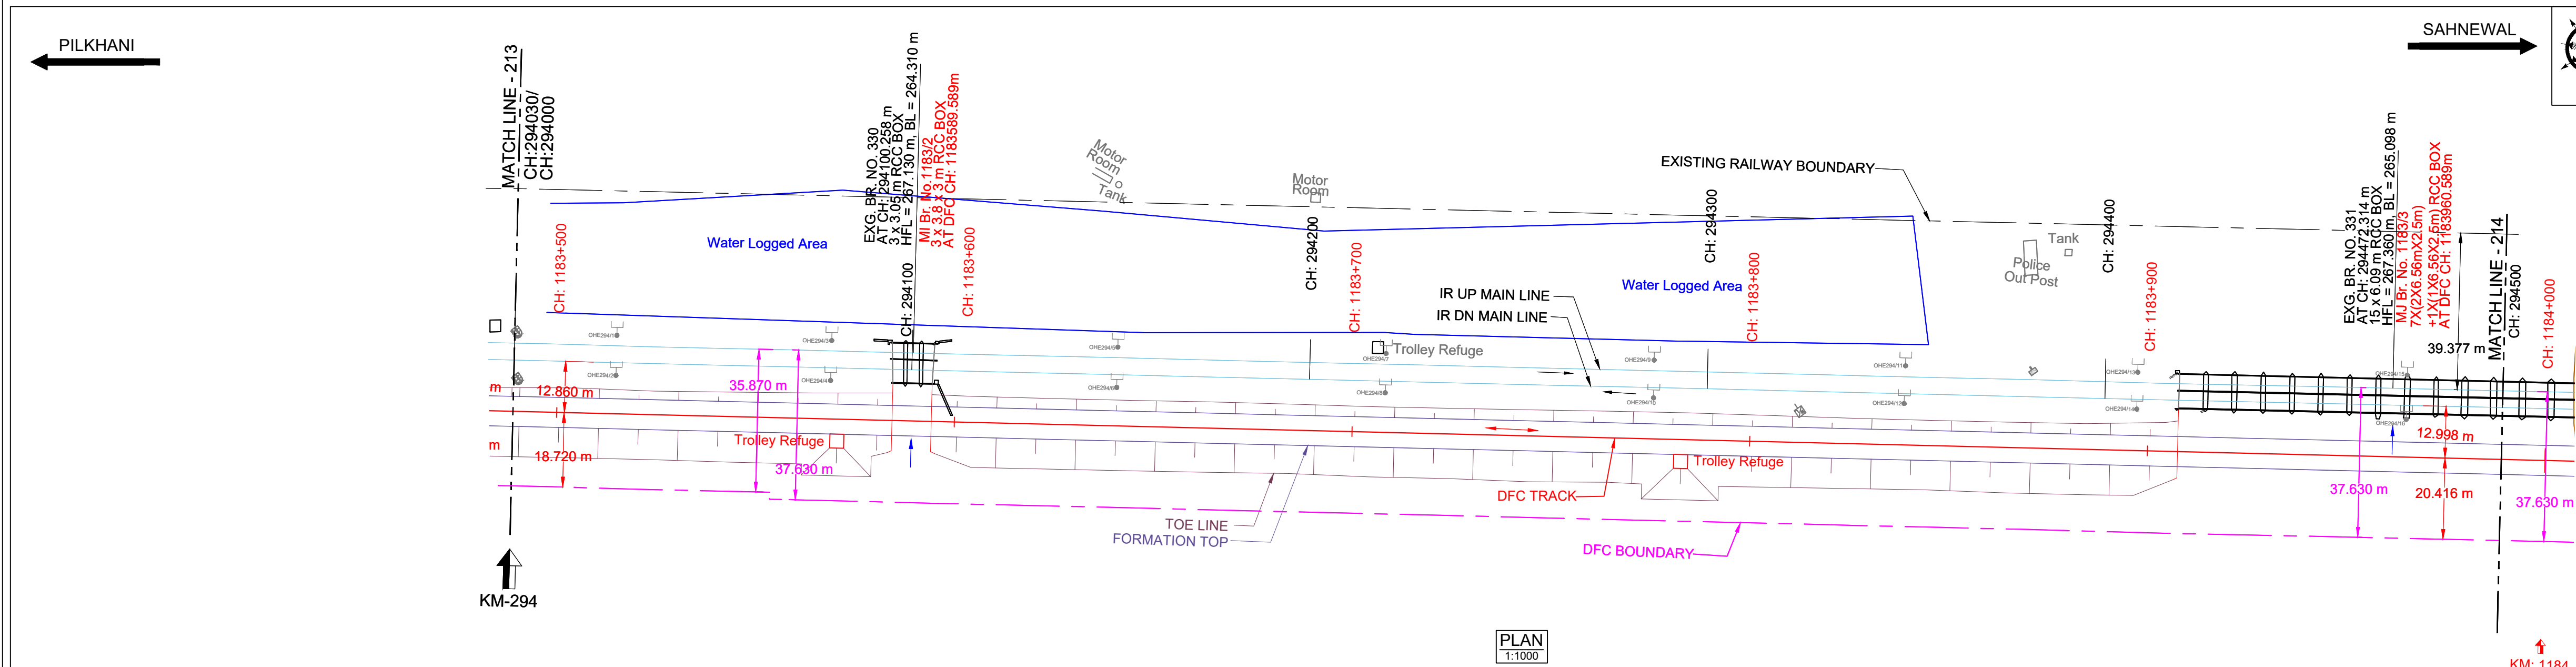


DATUM ABOVE MSL : 260 m

HORIZONTAL ALIGNMENT		L = 5898.430m																							
VERTICAL ALIGNMENT		L=1883.2 m LEVEL																							
TRACK DISTANCE FROM EXISTING NEAREST IR DN MAIN LINE TO DFC MAIN LINE		12.877 - 12.860 - 12.843 - 12.856 - 12.856 - 12.843 - 12.844 - 12.864 - 12.871 - 12.866 - 12.852 - 12.848 - 12.846 - 12.881 - 12.925 - 12.906 - 12.879 - 12.880 - 12.882 - 12.877 - 12.881 - 12.928 - 12.973 - 12.998 - 13.021																							
HEIGHT OF BANKING(+) / DEPTH OF CUTTING(-) (PFL-GL)		+2.639 - +2.569 - +2.561 - +2.767 - +3.258 - 12.843 - +3.494 - +3.440 - +3.460 - +3.359 - +3.378 - +3.366 - +3.573 - +3.680 - +3.696 - +3.790 - 12.925 - +3.658 - +3.626 - +3.608 - +3.588 - +3.552 - 12.877 - 12.881 - 12.928 - 12.973 - 12.998 - 13.021																							
EXG GROUND LEVEL AT CENTER LINE OF DFC TRACK (GL)		264.734 - 264.771 - 264.759 - 264.703 - 264.706 - 264.733 - 264.765 - 264.801 - 264.839 - 264.893 - 264.795 - 264.781 - 264.702 - 264.968 - 264.774 - 264.952 - 264.619 - 264.858 - 264.729 - 264.990 - 264.796 - 265.022 - 264.814 - 265.040 - 264.715 - 265.060 - 264.746 - 265.096 - 264.848 - 265.147 - 264.918 - 265.061 - 264.934 - 265.075 - 264.974 - 265.135 - 265.013 - 265.088																							
EXG GROUND LEVEL AT TOE LOCATION OF DFC TRACK		264.734 - 264.771 - 264.759 - 264.703 - 264.706 - 264.733 - 264.765 - 264.801 - 264.839 - 264.893 - 264.795 - 264.781 - 264.702 - 264.968 - 264.774 - 264.952 - 264.619 - 264.858 - 264.729 - 264.990 - 264.796 - 265.022 - 264.814 - 265.040 - 264.715 - 265.060 - 264.746 - 265.096 - 264.848 - 265.147 - 264.918 - 265.061 - 264.934 - 265.075 - 264.974 - 265.135 - 265.013 - 265.088																							
DIFFERENCE BETWEEN DFC FORMATION LEVEL AND EXG.FORMATION LEVEL (PFL-EFL)		1.059 - 1.062 - 1.067 - 1.074 - 1.077 - 1.076 - 1.073 - 1.067 - 1.059 - 1.050 - 1.009 - 0.989 - 0.971 - 0.963 - 0.959 - 0.959 - 0.958 - 0.957 - 0.955 - 0.955 - 0.954 - 0.955 - 0.954 - 0.929 - 0.913																							
DFC FORMATION LEVEL (PFL)		268.648 - 268.648																							
EXG. FORMATION LEVEL OF EXG IR DN MAIN LINE (EFL)		267.590 - 267.598 - 267.581 - 267.574 - 267.571 - 267.572 - 267.575 - 267.581 - 267.589 - 267.598 - 267.639 - 267.659 - 267.677 - 267.685 - 267.689 - 267.690 - 267.690 - 267.691 - 267.692 - 267.693 - 267.694 - 267.693 - 267.694 - 267.719 - 267.735																							
DIFFERENCE BETWEEN DFC RAIL LEVEL AND EXG. RAIL LEVEL (PRL - ERL)		1.082 - 1.087 - 1.092 - 1.099 - 1.102 - 1.101 - 1.098 - 1.092 - 1.084 - 1.075 - 1.034 - 1.014 - 0.996 - 0.988 - 0.984 - 0.983 - 0.983 - 0.982 - 0.981 - 0.980 - 0.979 - 0.980 - 0.979 - 0.954 - 0.938																							
DFC RAIL LEVEL (PRL)		269.361 - 269.361																							
EXG.RAIL LEVEL OF NEAREST IR DN MAIN LINE(ERL)		268.278 - 268.274 - 268.269 - 268.262 - 268.259 - 268.260 - 268.263 - 268.269 - 268.277 - 268.286 - 268.327 - 268.347 - 268.373 - 268.377 - 268.378 - 268.378 - 268.379 - 268.380 - 268.381 - 268.382 - 268.381 - 268.382 - 268.407 - 268.423																							
EQUIVALENT CHAINAGE ON DFC TRACK		294030.2 - 294000.0 - 294020.0 - 294040.0 - 294060.0 - 294080.0 - 294100.0 - 294120.0 - 294140.0 - 294160.0 - 294180.0 - 294200.0 - 294220.0 - 294240.0 - 294260.0 - 294280.0 - 294300.0 - 294320.0 - 294340.0 - 294360.0 - 294380.0 - 294400.0 - 294420.0 - 294440.0 - 294460.0 - 294480.0 - 294500.0																							
EXISTING IR CHAINAGE		294030.2 - 294000.0 - 294020.0 - 294040.0 - 294060.0 - 294080.0 - 294100.0 - 294120.0 - 294140.0 - 294160.0 - 294180.0 - 294200.0 - 294220.0 - 294240.0 - 294260.0 - 294280.0 - 294300.0 - 294320.0 - 294340.0 - 294360.0 - 294380.0 - 294400.0 - 294420.0 - 294440.0 - 294460.0 - 294480.0 - 294500.0																							

L - SECTION

SAHNEWAL

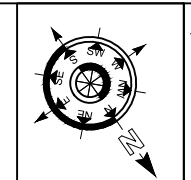

- NOTE:-
1. DFC WORKS ARE SHOWN IN RED.
 2. IR NEW WORKS ARE SHOWN IN VIOLET.
 3. ALL DIMENSIONS ARE SHOWN IN METRES.
 4. THIS DRAWING IS PREPARED BASED ON LATEST SURVEY DATA HELD ON APRIL-2022. GTS BENCH MARK OF 261.850M CONSIDERED ON TOP OF CANAL BRIDGE ABUTMENT AT DORAH VILLAGE ALONG THE NH1.
 5. DFC NEW CHAINAGE OF 1075.950M IS WITH REFERENCE TO THE IR KM OF 187.500KM END OF KM OF CP-303(SECTION P-3 PILKHANI END) AGAINST THE EXISTING DFC CHAINAGE. 116277.742M ISSUED VIDE LETTER NO. COM/DFCC/MB/SURVEY/2021-301-230116-011173 DT. 17.01.2023.
 6. BALLAST PROFILE HAS BEEN PROVIDED ACCORDING TO THE CLAUSE 1.11.3 OF STANDARD SCHEDULE OF DIMENSION(EASTERN CORRIDOR) & THE BALLAST CUSHION DIMENSION SHOWN IN 35CM ON GE-14 PARA 17. SPECIFICATIONS & RECOMMENDATIONS 2. TWO LAYER SYSTEM FIG.10.

- REFERENCE DRAWINGS :-
1. FOR KEY PLAN REFER DRAWING NO. 301-2/AL/0001
 2. FOR LEGEND AND ABBREVIATIONS REFER DRAWING NO. 301-2/AL/1000
 3. FOR TYPICAL SECTION OF BALLAST PROFILE (FL-RL) REFER DRG. NO. 301-2/TK/TFD/004 (TR.1952)

0	27.08.2024	SUBMISSION OF AS-BUILT DRAWING	FOR APPROVAL
REV.	DATE	REVISION DETAILS	PURPOSE OF ISSUE

LEGEND:


SCALE

HOR - 1:1000

VER - 1:100

SHEET SIZE : A1

IR TRACK
DFCC TRACK
LINK LINE (SMUN-RP-J)
DFCC FUTURE PROPOSALS
STRUCTURE / BUILDING
DFCC TOE LINE
DFCC FORMATION
RETAINING WALL
ROAD
STREAM, DRAIN, NALA, CANAL.
FENCE
POWER LINES
TBM
ELECTRIC POLE/OHE MAST
IR RAILWAY BOUNDARY
DFCC BOUNDARY

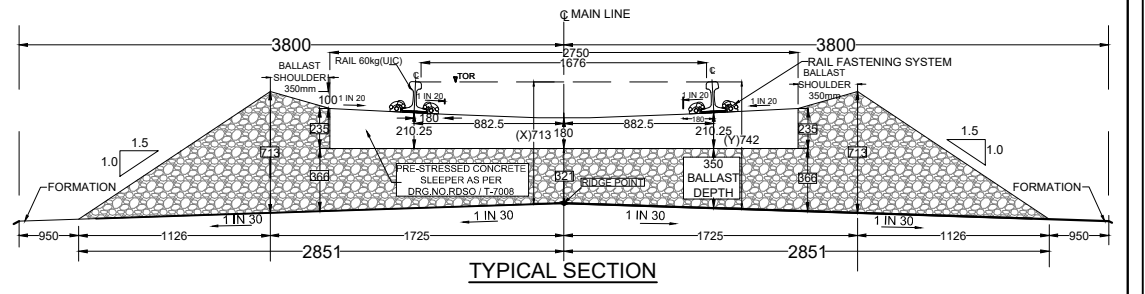

TRACK STRUCTURE		
RAIL SECTION: 60Kg/m (UIC 60Kg/m) DFC LINE: 60Kg/m (UIC 60Kg/m) IR MAIN LINE: 52Kg/m	Difference between FL- RL (Below Rail Seat)	
	IR Line	DFC
RUBBER PAD	172mm	172mm
SLEEPER DEPTH	6mm	10mm
SLEEPER DEPTH	210mm	210mm
BALLAST CUSHION	300mm	350mm
Total Depth (FL TO RL)	688mm	742mm

OWNER

DEDICATED FREIGHT CORRIDOR CORPORATION OF INDIA LTD.

(A GOVERNMENT OF INDIA ENTERPRISE)

PROJECT OFFICE(AMBALA UNIT): OLD RAILWAY COLONY (NEAR ANAND MARKET),AMBALA CANTT.-133001.

CORPORATE IDENTITY NO. : U60232DL2006GGI155068

ENGINEER:

DB Engineering & Consulting GmbH

Deutsche Bahn Engineering & Consulting GmbH

CONTRACTOR:

GIL - TPL JV

GAR TATA

SUBMITTED BY	GIL - TPL JV		
	DATED	NAME	SIGNATURE
PREPARED BY			
CHECKED BY	27.08.2024	VIJAY PRATAP	
APPROVED BY	27.08.2024	PARASURAM KOTYADA	

APPROVED BY	DEUTSCHE BAHN ENGINEERING & CONSULTING GMBH		
	DATED	NAME	SIGNATURE
Sr. DE./CHIEF ENGINEER		SURESH K.YALANGI	
CHIEF TRACK ENGINEER		RAJ PAL SINGH	
T.L.		H.D. VIDJAK	

STAMP

A AS-BUILT DRAWING
TR. Ref.:.....
ENGINEER Sign.:.....

EMPLOYER (DFCCIL): DEDICATED FREIGHT CORRIDOR CORPORATION OF INDIA LTD.

AS BUILT DRAWING		
TITLE	AS-BUILT PLAN AND PROFILE	DFCC APPR. NO. -
		ENGG. APPR. NO. -
FROM IR KM: 294.000 TO 294.500 DFC KM: 1183.489 TO 1183.989		DRG. NO. - 301-2/AL/A/1214
	SHEET NO. : 1 OF 1	STATUS
	DATE : 27.08.2024	A

TR.