


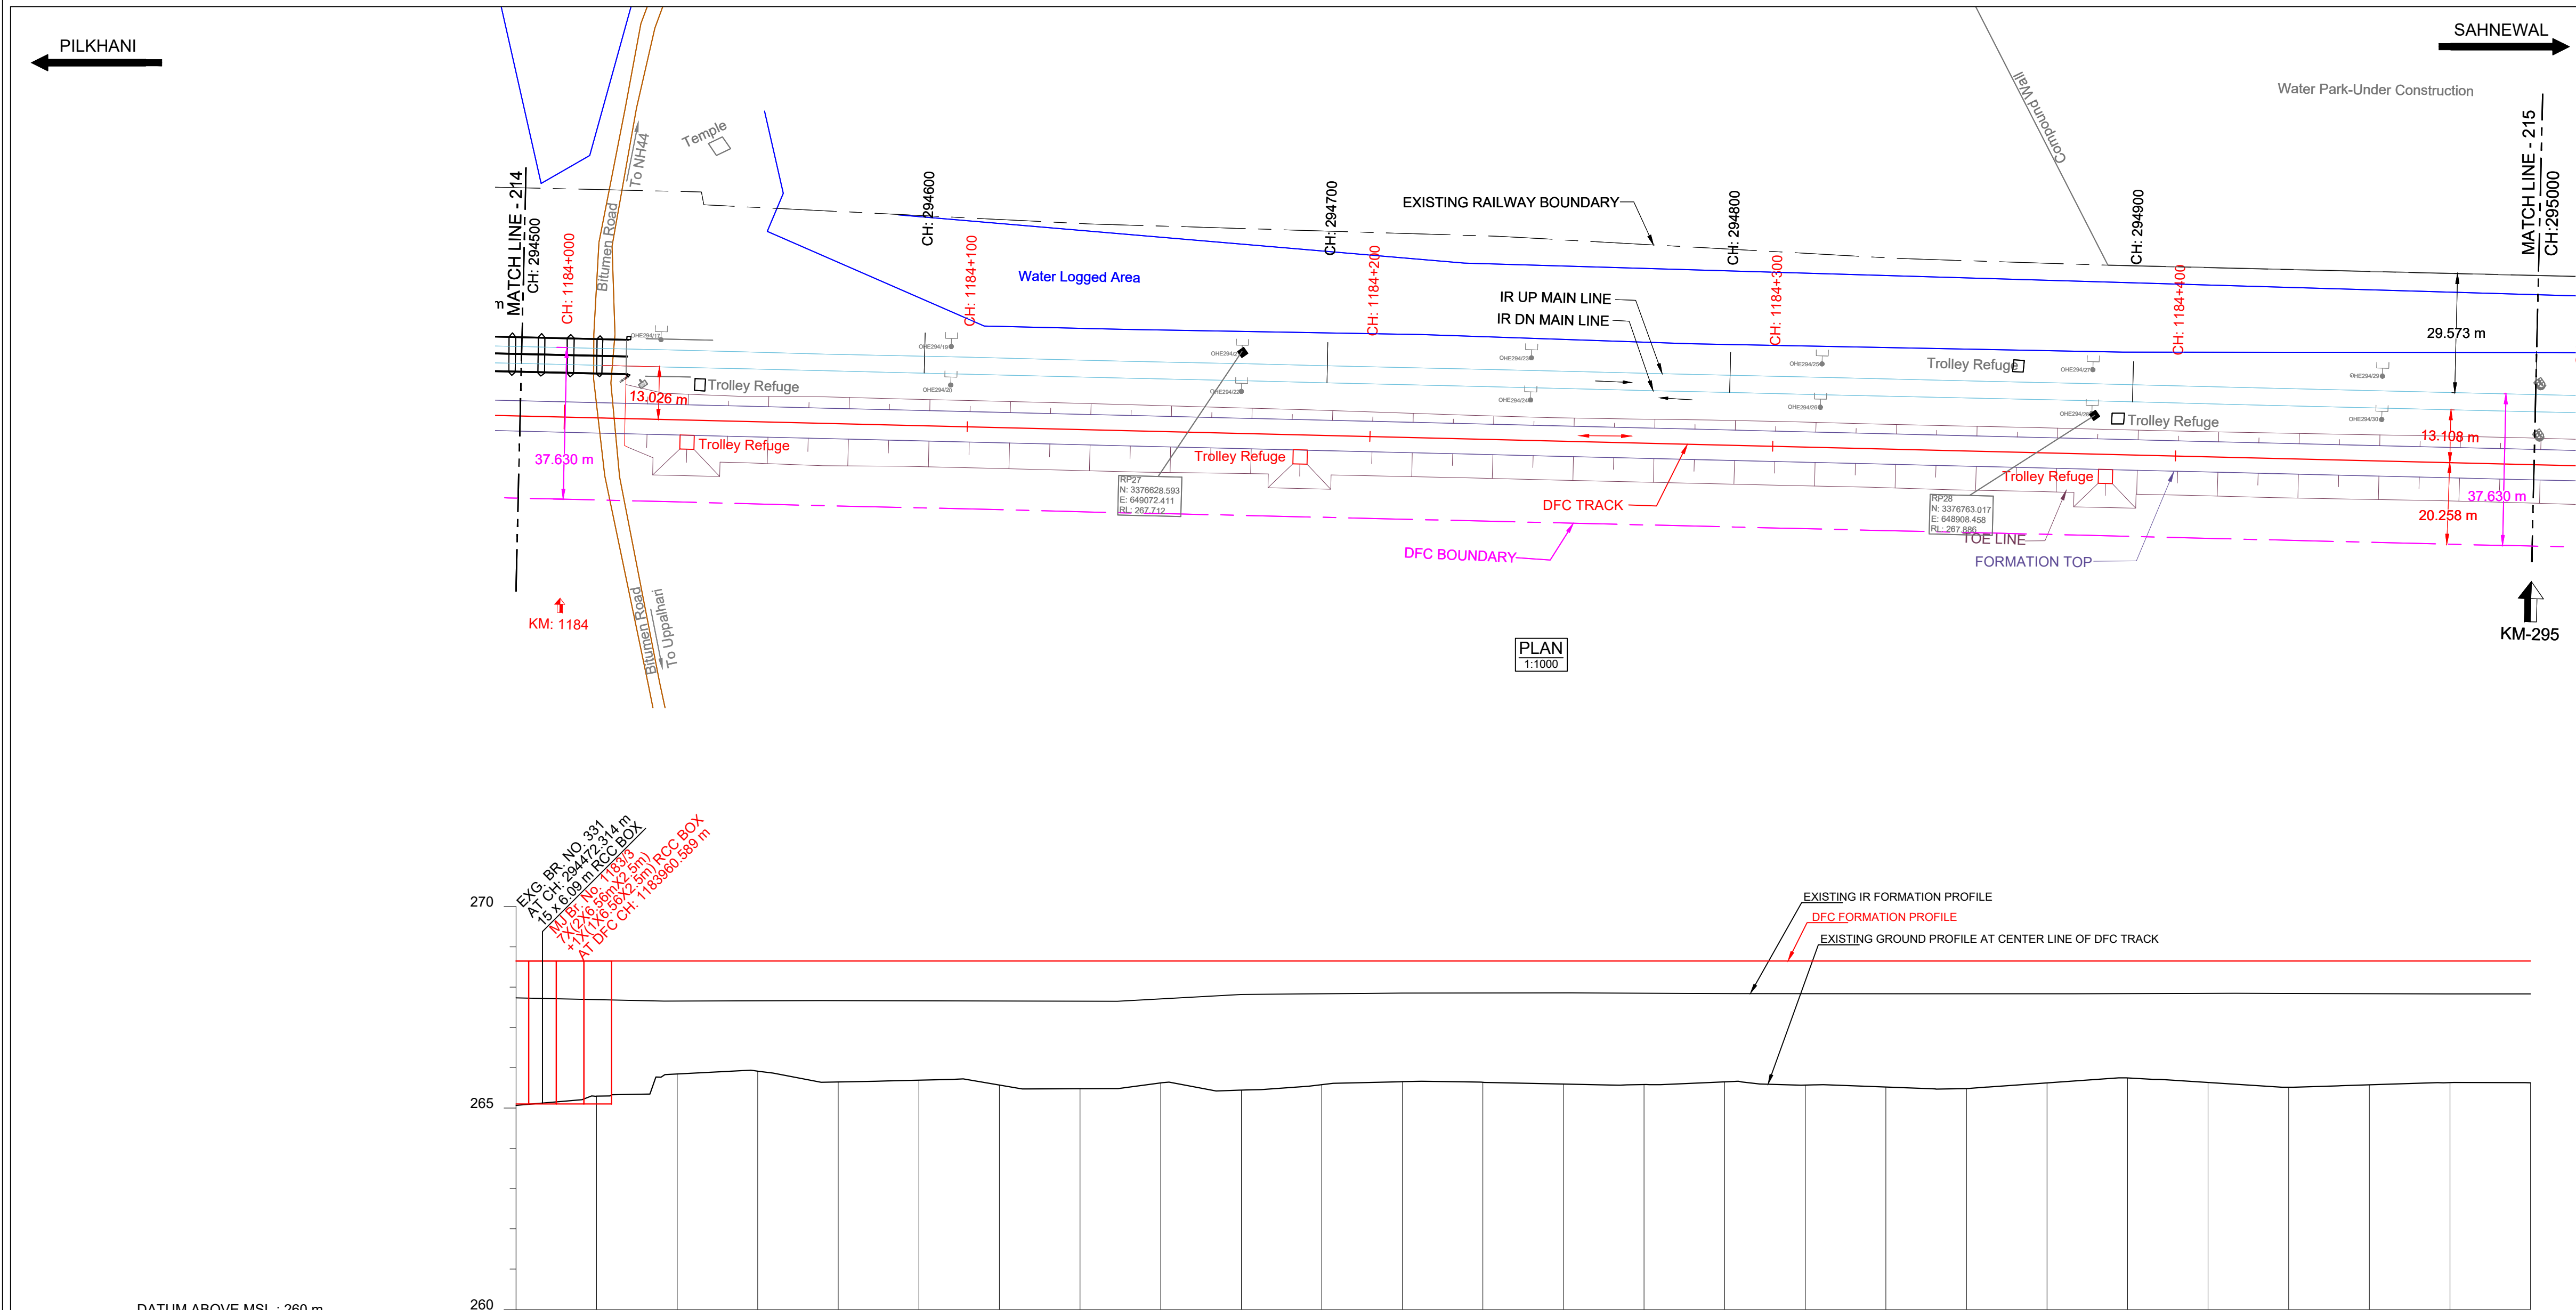

DATUM ABOVE MSL : 260 m

HORIZONTAL ALIGNMENT	L = 5898.430m																			
VERTICAL ALIGNMENT	L=1883.2 m LEVEL																			
TRACK DISTANCE FROM EXISTING NEAREST IR DN MAIN LINE TO DFC MAIN LINE	13.021	13.026	13.033	13.051	13.060	13.039	13.022	13.009	13.029	13.077	13.074	13.072	13.074	13.075	13.075	13.089	13.105	13.137	13.174	13.174
HEIGHT OF BANKING(+) / DEPTH OF CUTTING(-) (PFL-GL)	-	-	+2.805	+2.733	+3.003	+2.957	+3.079	+3.170	+3.027	+3.205	+3.070	+2.996	+3.011	+3.066	+3.001	+3.080	+3.128	+3.167	+3.025	+3.015
EXG GROUND LEVEL AT CENTER LINE OF DFC TRACK (GL)	265.068	265.294	265.843	265.915	265.645	265.691	265.569	265.478	265.621	265.443	265.578	265.652	265.637	265.582	265.603	265.568	265.520	265.481	265.623	265.633
EXG GROUND LEVEL AT TOE LOCATION OF DFC TRACK	265.013	265.164	265.244	265.273	265.196	265.330	265.339	265.324	265.346	265.451	265.529	265.572	265.585	265.588	265.603	265.578	265.610	265.567	265.589	265.571
DIFFERENCE BETWEEN DFC FORMATION LEVEL AND EXG.FORMATION LEVEL (PFL-EFL)	0.913	0.957	0.993	0.987	0.983	0.989	0.994	0.997	0.940	0.831	0.813	0.797	0.796	0.802	0.810	0.811	0.812	0.812	0.808	0.802
DFC FORMATION LEVEL (PFL)	266.648	266.648	266.648	266.648	266.648	266.648	266.648	266.648	266.648	266.648	266.648	266.648	266.648	266.648	266.648	266.648	266.648	266.648	266.648	266.648
EXG. FORMATION LEVEL OF EXG IR DN MAIN LINE (EFL)	267.735	267.691	267.655	267.661	267.665	267.659	267.654	267.651	267.708	267.817	267.835	267.851	267.852	267.845	267.838	267.837	267.836	267.836	267.836	267.840
DIFFERENCE BETWEEN DFC RAIL LEVEL AND EXG. RAIL LEVEL (PRL - ERL)	0.938	0.982	1.018	1.012	1.008	1.014	1.019	1.022	0.965	0.856	0.838	0.822	0.821	0.827	0.835	0.836	0.837	0.837	0.837	0.833
DFC RAIL LEVEL (PRL)	269.361	269.361	269.361	269.361	269.361	269.361	269.361	269.361	269.361	269.361	269.361	269.361	269.361	269.361	269.361	269.361	269.361	269.361	269.361	269.361
EXG.RAIL LEVEL OF NEAREST IR DN MAIN LINE(ERL)	268.423	268.379	268.343	268.349	268.353	268.347	268.342	268.339	268.396	268.505	268.523	268.539	268.540	268.534	268.526	268.525	268.524	268.524	268.524	268.534
EQUIVALENT CHAINAGE ON DFC TRACK	294500.0	294520.0	294540.0	294560.0	294580.0	294600.0	294620.0	294640.0	294660.0	294680.0	294700.0	294720.0	294740.0	294760.0	294780.0	294800.0	294820.0	294840.0	294860.0	294880.0
EXISTING IR CHAINAGE	294500.0	294520.0	294540.0	294560.0	294580.0	294600.0	294620.0	294640.0	294660.0	294680.0	294700.0	294720.0	294740.0	294760.0	294780.0	294800.0	294820.0	294840.0	294860.0	294880.0

L - SECTION

NOTE:-

- DFCC WORKS ARE SHOWN IN RED.
- IR NEW WORKS ARE SHOWN IN VIOLET.
- ALL DIMENSIONS ARE SHOWN IN METRES.
- THIS DRAWING IS PREPARED BASED ON LATEST SURVEY DATA HELD ON APRIL-2022. GTS BENCH MARK OF 261.850M CONSIDERED ON TOP OF CANAL BRIDGE ABUTMENT AT DORAHA VILLAGE ALONG THE NH1.
- DFC NEW CHAINAGE OF 1075.950M IS WITH REFERENCE TO THE IR KM OF 187.500KM END OF KM OF CP-303(SECTION P-3 PILKHANI END) AGAINST THE EXISTING DFC CHAINAGE. 116277.742M ISSUED VIDE LETTER NO. COM/DFCC/UMS/SURVEY/2021-301-230116-011173 DT. 17.01.2023.
- BALLAST PROFILE HAS BEEN PROVIDED ACCORDING TO THE CLAUSE 1.11.3 OF STANDARD SCHEDULE OF DIMENSION(EASTERN CORRIDOR) & THE BALLAST CUSHION DIMENSION SHOWN IN 35CM ON GE-14 PARA 17. SPECIFICATIONS & RECOMMENDATIONS 2. TWO LAYER SYSTEM FIG.10.

REFERENCE DRAWINGS :-

- FOR KEY PLAN REFER DRAWING NO. 301-2/AL/0001
- FOR LEGEND AND ABBREVIATIONS REFER DRAWING NO. 301-2/AL/1000
- FOR TYPICAL SECTION OF BALLAST PROFILE (FL-RL) REFER DRG. NO. 301-2/TK/TFD/-004 (TR.1952)

0	27.08.2024	SUBMISSION OF AS-BUILT DRAWING	FOR APPROVAL
REV.	DATE	REVISION DETAILS	PURPOSE OF ISSUE

SCALE
HOR - 1:1000
VER - 1:100
SHEET SIZE : A1

LEGEND:

- IR TRACK
- DFCC TRACK
- LINK LINE (SMUN-RP-J)
- DFCC FUTURE PROPOSALS
- STRUCTURE / BUILDING
- DFCC TOE LINE
- DFCC FORMATION
- RETAINING WALL
- ROAD
- STREAM, DRAIN, NALA, CANAL.
- FENCE
- POWER LINES
- TBM
- ELECTRIC POLE/OHE MAST
- IR RAILWAY BOUNDARY
- DFCC BOUNDARY

TYPICAL SECTION

TRACK STRUCTURE

RAIL SECTION: 60Kg/m (UIC 60Kg/m)	Difference between FL- RL (Below Rail Seat)	
DFC LINE: 60Kg/m (UIC 60Kg/m)	IR Line	DFC
IR MAIN LINE: 52Kg/m	172mm	172mm
RUBBER PAD	6mm	10mm
SLEEPER DEPTH	210mm	210mm
BALLAST CUSHION	300mm	350mm
Total Depth (FL TO RL)	688mm	742mm

OWNER
DEDICATED FREIGHT CORRIDOR CORPORATION OF INDIA LTD.
(A GOVERNMENT OF INDIA ENTERPRISE)
PROJECT OFFICE(AMBALA UNIT): OLD RAILWAY COLONY (NEAR ANAND MARKET),AMBALA CANTT-133001.
CORPORATE IDENTITY NO. : U60232DL20060G0155068

ENGINEER:
DB Engineering & Consulting GmbH
Deutsche Bahn Engineering & Consulting GmbH

CONTRACTOR:
GIL - TPL JV
GAR TATA

SUBMITTED BY	GIL - TPL JV		
	DATED	NAME	SIGNATURE
PREPARED BY			
CHECKED BY	27.08.2024	VIJAY PRATAP	
APPROVED BY	27.08.2024	PARASURAM KOTYADA	
APPROVED BY	DEUTSCHE BAHN ENGINEERING & CONSULTING GMBH		
	DATED	NAME	SIGNATURE
Sr. DE./CHIEF ENGINEER		SURESH K.YALANGI	
CHIEF TRACK ENGINEER		RAJ PAL SINGH	
T.L.		H.D. VIDJAK	

STAMP
A AS-BUILT DRAWING
TR. Ref.....
ENGINEER Sign.:

EMPLOYER (DFCCIL): DEDICATED FREIGHT CORRIDOR CORPORATION OF INDIA LTD.

AS BUILT DRAWING

TITLE AS-BUILT PLAN AND PROFILE	DFCC APPR. NO. -
FROM IR KM: 294.500 TO 295.000 DFC KM: 1183.989 TO 1184.489	ENGG. APPR. NO. -
	DRG. NO. -301-2/AL/A/1215
	SHEET NO. : 1 OF 1
	DATE : 27.08.2024
	STATUS A

TR.