



HORIZONTAL ALIGNMENT	L = 5898.430m																											
VERTICAL ALIGNMENT	L=1883.2 m LEVEL																											
TRACK DISTANCE FROM EXISTING NEAREST IR DN MAIN LINE TO DFC MAIN LINE	13.124	13.124	13.140	13.147	13.154	13.165	13.177	13.177	13.162	13.092	12.978	13.072	13.026	12.918	12.896	12.893	12.938	12.932	12.914	12.905	12.900	12.896	12.886	12.870	12.853	12.820	12.756	
HEIGHT OF BANKING(+)/ DEPTH OF CUTTING(-) (PFL-GL)	+3.024	+3.054	+3.057	+3.052	+3.050	+3.005	+2.986	+2.989	+2.985	+2.989	+2.984	+2.866	+2.878	+2.937	+3.034	+3.042	+3.071	+2.989	+2.997	+2.854	+2.734	+2.806	+2.958	+2.886	+2.895	+2.689	+2.618	+2.551
EXG GROUND LEVEL AT CENTER LINE OF DFC TRACK (GL)	265.624	265.594	265.591	265.596	265.598	265.613	265.643	265.609	265.662	265.663	265.749	265.790	265.778	265.711	265.614	265.606	265.577	265.691	265.651	265.794	265.914	265.842	265.690	265.950	265.864	266.030	266.097	
EXG GROUND LEVEL AT TOE LOCATION OF DFC TRACK	265.660	265.587	265.591	265.596	265.598	265.613	265.643	265.609	265.662	265.663	265.749	265.790	265.778	265.711	265.614	265.606	265.577	265.691	265.651	265.794	265.914	265.842	265.690	265.950	265.864	266.030	266.097	
DIFFERENCE BETWEEN DFC FORMATION LEVEL AND EXG.FORMATION LEVEL (PFL-EFL)	0.817	0.815	0.790	0.765	0.784	0.807	0.784	0.789	0.789	0.790	0.787	0.759	0.712	0.655	0.657	0.643	0.586	0.597	0.624	0.631	0.630	0.635	0.651	0.693	0.713	0.694		
DFC FORMATION LEVEL (PFL)	266.648	266.648	EXG. FORMATION LEVEL OF EXG IR DN MAIN LINE (EFL)	267.831	267.833	267.858	267.883	267.864	267.841	267.864	267.859	267.861	267.858	267.889	267.936	267.993	267.991	268.005	268.062	268.051	268.024	268.017	268.018	268.013	267.997	267.955	267.935	267.954			
DIFFERENCE BETWEEN DFC RAIL LEVEL AND EXG. RAIL LEVEL (PRL - ERL)	0.842	0.840	0.815	0.790	0.809	0.832	0.809	0.814	0.812	0.815	0.784	0.737	0.680	0.668	0.611	0.622	0.649	0.656	0.655	0.660	0.676	0.718	0.738	0.719				
DFC RAIL LEVEL (PRL)	269.361	269.361	EXG.RAIL LEVEL OF NEAREST IR DN MAIN LINE(ERL)	268.519	268.521	268.546	268.571	268.552	268.529	268.552	268.547	268.549	268.546	268.577	268.624	268.681	268.679	268.693	268.750	268.739	268.712	268.705	268.706	268.701	268.685	268.682	268.642				
EQUIVALENT CHAINAGE ON DFC TRACK	1184489.2	1184509.2	1184529.2	1184549.2	1184569.2	1184589.2	1184609.2	1184629.2	1184649.1	1184669.2	1184689.2	1184709.1	1184729.2	1184749.2	1184769.2	1184789.2	1184809.2	1184829.2	1184849.2	1184869.2	1184889.2	1184909.2	1184929.2	1184949.2				
EXISTING IR CHAINAGE	295000.0	295020.0	295040.0	295060.0	295080.0	295100.0	295120.0	295140.0	295160.0	295180.0	295200.0	295220.0	295240.0	295260.0	295280.0	295300.0	295320.0	295340.0	295360.0	295380.0	295400.0	295420.0	295440.0	295460.0	295480.0	295500.0		

L - SECTION

- | | |
|---|---------------------------|
| NOTE:- | DRG NO. - 301-2/AL/A/1216 |
| <p>1. DFOC WORKS ARE SHOWN IN RED.</p> <p>2. IR NEW WORKS ARE SHOWN IN VIOLET.</p> <p>3. ALL DIMENSIONS ARE SHOWN IN METRES.</p> <p>4. THIS DRAWING IS PREPARED BASED ON LATEST SURVEY DATA HELD ON APRIL-2022. GETS BENCH MARK OF 261.850M CONSIDERED ON TOP OF CANAL BRIDGE ABUTMENT AT DORAKA VILLAGE ALONG THE NH-1.</p> <p>5. DFOC NEW CHAINAGE OF 1075.950M IS WITH REFERENCE TO THE IR KM OF 187.500KM AND KM OF CP-303(SECTION 3 PILLUKNH) AND AGAINST THE EXISTING DFOC CHAINAGE. 116277.742M ISSUED VIDE LETTER NO. CM/GMDC/CIUMB/SURVEY/2021-301-2301-16101173 DT. 17.01.2023</p> <p>6. BALLAST PROFILE HAS BEEN PROVIDED ACCORDING TO THE CLAUSE 11.1.3 OF STANDARD SCHEDULE FOR NORTH-EASTERN CORRIDOR & THE BALLAST CUSHION DIMENSION SHOWN IN 35CM ON GE-14 PALLA 17. SPECIFICATIONS & RECOMMENDATIONS 2. TWO LAYER SYSTEM FIG.10.</p> | |

- REFERENCE DRAWINGS :-
1. FOR KEY PLAN REFER DRAWING NO. 301-2/AL/0001
 2. FOR LEGEND AND ABBREVIATIONS REFER DRAWING NO. 301-2/AL/1000
 3. FOR TYPICAL SECTION OF BALLAST PROFILE (FL-RL) REFER DRG. NO. 301-2/TK/TFD/-004 (TR.1952)

0	27.08.2024	SUBMISSION OF AS-BUILT DRAWING	FOR APPROVAL
REV.	DATE	REVISION DETAILS	PURPOSE OF ISSUE

SCALE

HOR - 1:1000

0 10 20 30 40m

VER - 1:100

0 1 2 3 4m

SHEET SIZE : A1

LEGEND

IR TRACK

DFFC TRACK

LINK LINE (SMUN-RPJ)

DFFC FUTURE PROPOSALS

STRUCTURE / BUILDING

DFFC TOE LINE

DFFC FORMATION

RETAINING WALL

ROAD

STREAM, DRAIN, NALA, CANAL

FENCE


POWER LINES

TBM

ELECTRIC POLE/OHE MAST

IR RAILWAY BOUNDARY

DFFC BOUNDARY

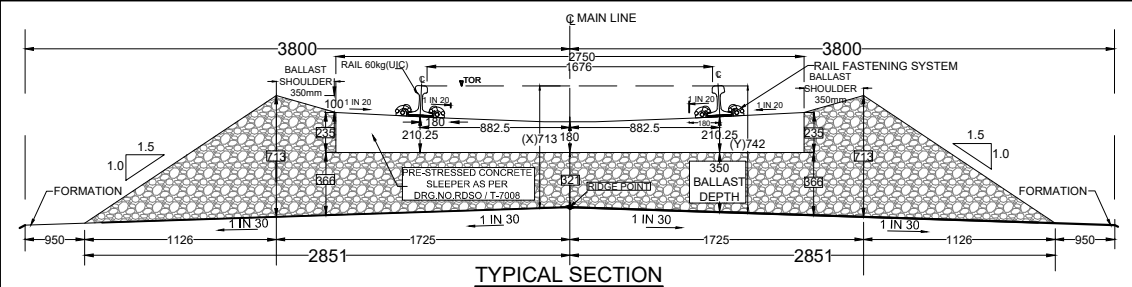

TRACK STRUCTURE		
RAIL SECTION: 60Kg/m (UIC 60Kg/m) DFC LINE: 60kg/m (UIC 60Kg/m) IR MAIN LINE: 52Kg/m	Difference between FL- RL (Below Rail Seat)	
	IR Line	DFC
	172mm	172mm
RUBBER PAD	6mm	10mm
SLEEPER DEPTH	210mm	210mm
BALLAST CUSHION	300mm	350mm
Total Depth (FL TO RL)	688mm	742mm

OWNER



डेडीकेटेड फ्रीट कोरिडोर

DEDICATED FREIGHT CORRIDOR CORPORATION OF INDIA LTD.
(A GOVERNMENT OF INDIA ENTERPRISE)
PROJECT OFFICE (AMBALA UNIT): OLD RAILWAY COLONY (NEAR
ANAND MARKET), AMBALA CANTT-133001.
CORPORATE IDENTITY NO. : U60232DL2006GOI155068

ENGINEER:

 DB Engineering & Consulting GmbH
Deutsche Bahn Engineering & Consulting GmbH

CONTRACTOR: GIL - TPL JV

SUBMITTED BY	GIL - TPL JV		
	DATED	NAME	SIGNATURE
PREPARED BY			
CHECKED BY	27.08.2024	VIJAY PRATAP	
APPROVED BY	27.08.2024	PARASURAM KOTYADA	

APPROVED BY	DEUTSCHE BAHN ENGINEERING & CONSULTING GMBH		
	DATED	NAME	SIGNATURE
Sr. DE./CHIEF ENGINEER		SURESH K.YALANGI	
CHIEF TRACK ENGINEER		RAJ PAL SINGH	
T.L.		H.D. VIDJAK	

STAMP		AS-BUILT DRAWING
		TR. Ref..... ENGINEER Sign..:

EMPLOYER (DFCCIL): DEDICATED FREIGHT CORRIDOR CORPORATION OF INDIA LTD.

--	--	--	--

AS BUILT DRAWING	
TITLE AS-BUILT PLAN AND PROFILE FROM IR KM: 295.000 TO 295.500 DFC KM: 1184.489 TO 1184.989	DFCC APPR. NO. -
	ENGG. APPR. NO. -
	DRG. NO. -301-2/AL/A/1216
	SHEET NO. : 1 OF 1
	DATE : 27.08.2024
	STATUS A