
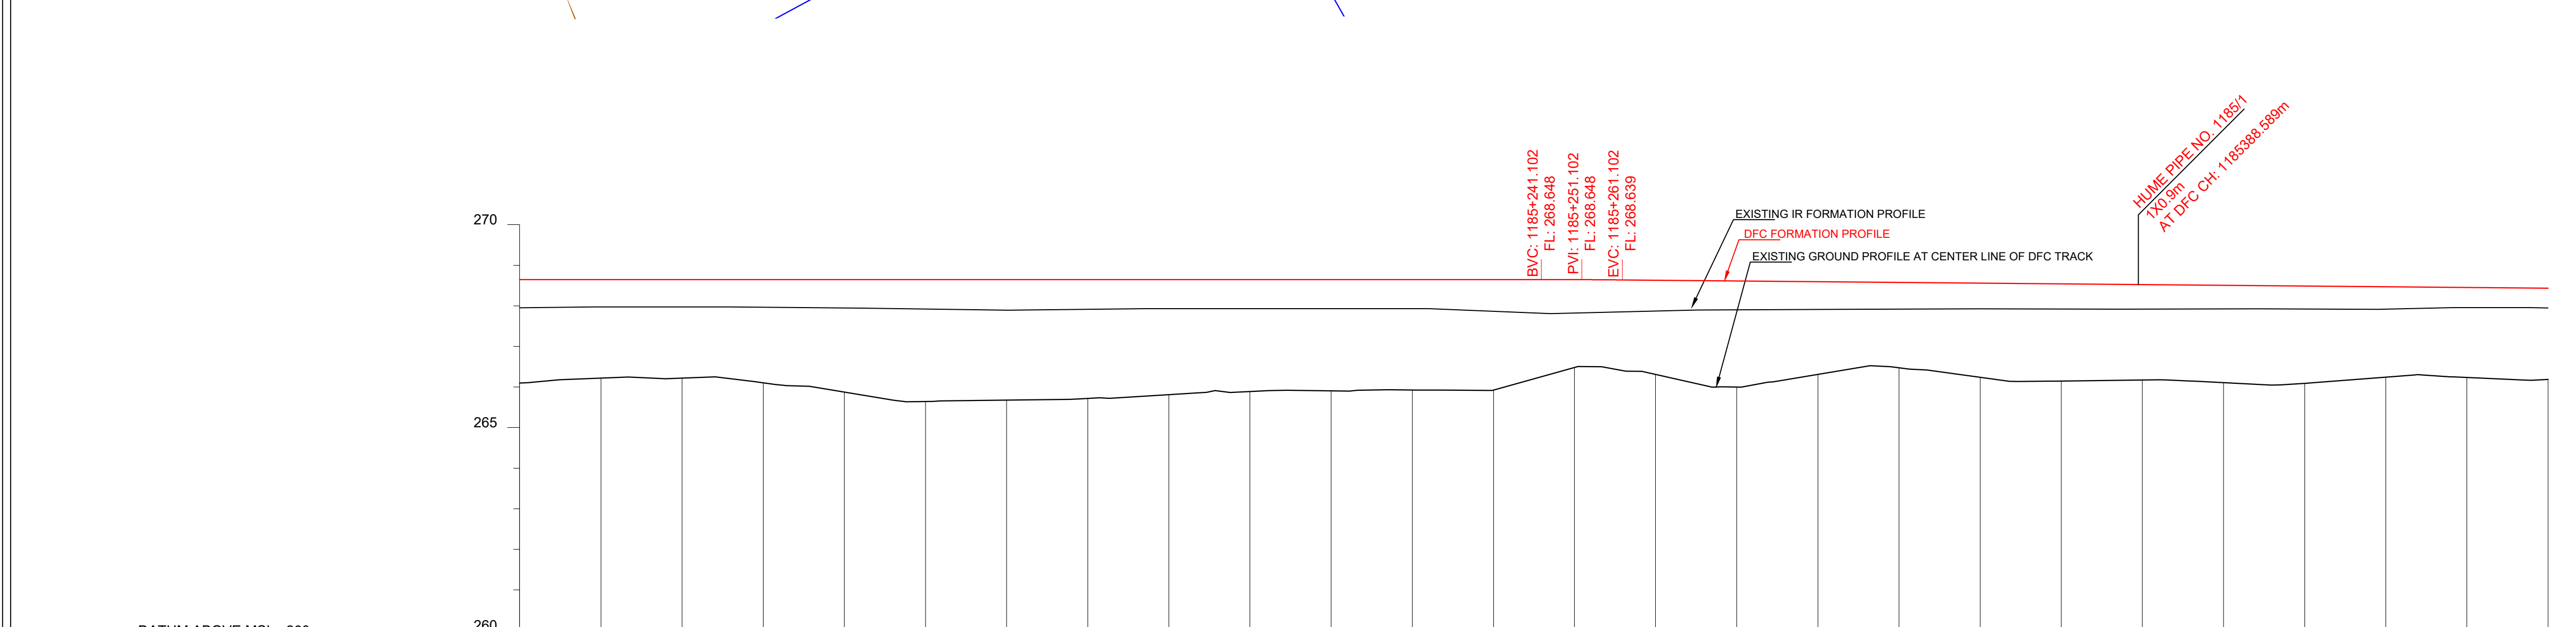


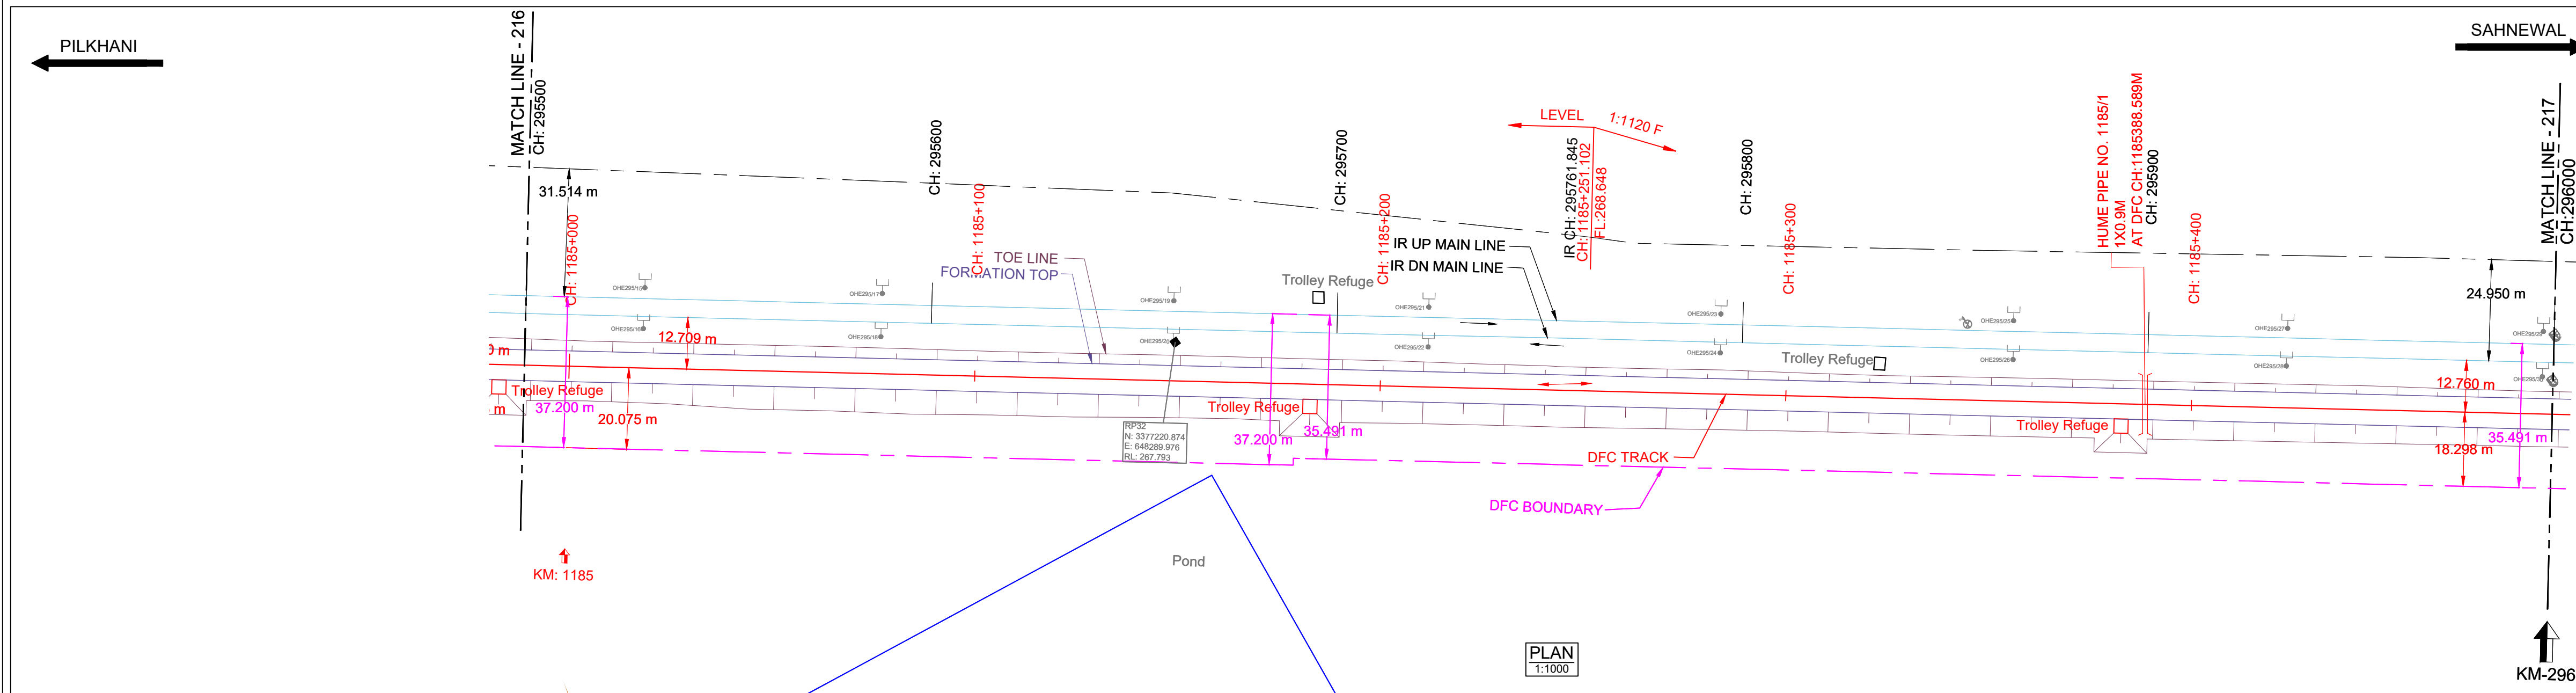

DATUM ABOVE MSL : 260 m

HORIZONTAL ALIGNMENT	L = 5898.430m																			
VERTICAL ALIGNMENT	L=1883.2 m LEVEL										L=20.0 m R=22395 m					L=1122.714 m 1 IN 1119.746 F				
TRACK DISTANCE FROM EXISTING NEAREST IR DN MAIN LINE TO DFC MAIN LINE	12.756	12.697	12.638	12.579	12.520	12.461	12.402	12.343	12.284	12.225	12.166	12.107	12.048	11.989	11.930	11.871	11.812	11.753	11.694	11.635
HEIGHT OF BANKING(+) / DEPTH OF CUTTING(-) (PFL-GL)	+2.551	+2.428	+2.305	+2.182	+2.059	+1.936	+1.813	+1.690	+1.567	+1.444	+1.321	+1.198	+1.075	+0.952	+0.829	+0.706	+0.583	+0.460	+0.337	+0.214
EXG GROUND LEVEL AT CENTER LINE OF DFC TRACK (GL)	266.097	266.220	266.343	266.466	266.589	266.712	266.835	266.958	267.081	267.204	267.327	267.450	267.573	267.696	267.819	267.942	268.065	268.188	268.311	268.434
EXG GROUND LEVEL AT TOE LOCATION OF DFC TRACK	266.041	266.179	266.317	266.455	266.593	266.731	266.869	267.007	267.145	267.283	267.421	267.559	267.697	267.835	267.973	268.111	268.249	268.387	268.525	268.663
DIFFERENCE BETWEEN DFC FORMATION LEVEL AND EXG.FORMATION LEVEL (PFL-EFL)	0.694	0.674	0.654	0.634	0.614	0.594	0.574	0.554	0.534	0.514	0.494	0.474	0.454	0.434	0.414	0.394	0.374	0.354	0.334	0.314
DFC FORMATION LEVEL (PFL)	266.648	266.648	266.648	266.648	266.648	266.648	266.648	266.648	266.648	266.648	266.648	266.648	266.648	266.648	266.648	266.648	266.648	266.648	266.648	266.648
EXG. FORMATION LEVEL OF EXG IR DN MAIN LINE (EFL)	267.954	267.974	267.994	268.014	268.034	268.054	268.074	268.094	268.114	268.134	268.154	268.174	268.194	268.214	268.234	268.254	268.274	268.294	268.314	268.334
DIFFERENCE BETWEEN DFC RAIL LEVEL AND EXG. RAIL LEVEL (PRL - ERL)	0.719	0.699	0.679	0.659	0.639	0.619	0.599	0.579	0.559	0.539	0.519	0.499	0.479	0.459	0.439	0.419	0.399	0.379	0.359	0.339
DFC RAIL LEVEL (PRL)	269.361	269.361	269.361	269.361	269.361	269.361	269.361	269.361	269.361	269.361	269.361	269.361	269.361	269.361	269.361	269.361	269.361	269.361	269.361	269.361
EXG.RAIL LEVEL OF NEAREST IR DN MAIN LINE(ERL)	268.642	268.662	268.682	268.702	268.722	268.742	268.762	268.782	268.802	268.822	268.842	268.862	268.882	268.902	268.922	268.942	268.962	268.982	269.002	269.022
EQUIVALENT CHAINAGE ON DFC TRACK	295500.0	295520.0	295540.0	295560.0	295580.0	295600.0	295620.0	295640.0	295660.0	295680.0	295700.0	295720.0	295740.0	295760.0	295780.0	295800.0	295820.0	295840.0	295860.0	295880.0
EXISTING IR CHAINAGE	295500.0	295520.0	295540.0	295560.0	295580.0	295600.0	295620.0	295640.0	295660.0	295680.0	295700.0	295720.0	295740.0	295760.0	295780.0	295800.0	295820.0	295840.0	295860.0	295880.0

L - SECTION

NOTE:

- DFCC WORKS ARE SHOWN IN RED.
- IR NEW WORKS ARE SHOWN IN VIOLET.
- ALL DIMENSIONS ARE SHOWN IN METRES.
- THIS DRAWING IS PREPARED BASED ON LATEST SURVEY DATA HELD ON APRIL-2022. GTS BENCH MARK OF 261.850M CONSIDERED ON TOP OF CANAL BRIDGE ABUTMENT AT DORANA VILLAGE ALONG THE NH1.
- DFC NEW CHAINAGE OF 1075.950M IS WITH REFERENCE TO THE IR KM OF 187.500KM END OF KM OF CP-303(SECTION P-3 PILKHANI END) AGAINST THE EXISTING DFC CHAINAGE. 116277.742M ISSUED VIDE LETTER NO. COM/DFCC/UMS/SURVEY/2021-301-2301/16-011173.DT. 17.01.2023.
- BALLAST PROFILE HAS BEEN PROVIDED ACCORDING TO THE CLAUSE 1.11.3 OF STANDARD SCHEDULE OF DIMENSION(EASTERN CORRIDOR) & THE BALLAST CUSHION DIMENSION SHOWN IN 35CM ON GE-14 PARA 17. SPECIFICATIONS & RECOMMENDATIONS 2. TWO LAYER SYSTEM FIG.10.

REFERENCE DRAWINGS :-

- FOR KEY PLAN REFER DRAWING NO. 301-2/AL/0001
- FOR LEGEND AND ABBREVIATIONS REFER DRAWING NO. 301-2/AL/1000
- FOR TYPICAL SECTION OF BALLAST PROFILE (FL-RL) REFER DRG. NO. 301-2/TK/TFD/-004 (TR.1952)

027.08.2024SUBMISSION OF AS-BUILT DRAWINGFOR APPROVAL

REV. DATE REVISION DETAILS PURPOSE OF ISSUE

SCALE
HOR - 1:1000
VER - 1:100
SHEET SIZE : A1

LEGEND:

- IR TRACK
- DFCC TRACK
- LINK LINE (SMUN-RP-J)
- DFCC FUTURE PROPOSALS
- STRUCTURE / BUILDING
- DFCC TOE LINE
- DFCC FORMATION
- RETAINING WALL
- ROAD
- STREAM, DRAIN, NALA, CANAL.
- FENCE
- POWER LINES
- TBM
- ELECTRIC POLE/OHE MAST
- IR RAILWAY BOUNDARY
- DFCC BOUNDARY

TRACK STRUCTURE

RAIL SECTION: 60Kg/m (UIC 60Kg/m)	Difference between FL- RL (Below Rail Seat)	
DFC LINE: 60Kg/m (UIC 60Kg/m)	IR Line	DFC
IR MAIN LINE: 52Kg/m	172mm	172mm
RUBBER PAD	6mm	10mm
SLEEPER DEPTH	210mm	210mm
BALLAST CUSHION	300mm	350mm
Total Depth (FL TO RL)	688mm	742mm

OWNER

DEDICATED FREIGHT CORRIDOR CORPORATION OF INDIA LTD.
(A GOVERNMENT OF INDIA ENTERPRISE)
PROJECT OFFICE(AMBALA UNIT): OLD RAILWAY COLONY (NEAR ANAND MARKET),AMBALA CANTT-133001.
CORPORATE IDENTITY NO. : U60232DL20060G01155068

ENGINEER:

DB Engineering & Consulting GmbH
Deutsche Bahn Engineering & Consulting GmbH

CONTRACTOR:

GIL - TPL JV
GAR TATA

SUBMITTED BY	GIL - TPL JV		
	DATED	NAME	SIGNATURE
PREPARED BY			
CHECKED BY	27.08.2024	VIJAY PRATAP	
APPROVED BY	27.08.2024	PARASURAM KOTYADA	
APPROVED BY	DEUTSCHE BAHN ENGINEERING & CONSULTING GMBH		
	DATED	NAME	SIGNATURE
Sr. DE./CHIEF ENGINEER		SURESH K.YALANGI	
CHIEF TRACK ENGINEER		RAJ PAL SINGH	
T.L.		H.D. VIDJAK	

STAMP

AAS-BUILT DRAWING
TR. Ref.....
ENGINEER Sign.:

EMPLOYER (DFCCIL):

DEDICATED FREIGHT CORRIDOR CORPORATION OF INDIA LTD.

TITLE

AS-BUILT PLAN AND PROFILE

FROM IR KM: 295.500 TO 296.000
DFC KM: 1184.989 TO 1185.489

DFCC APPR. NO. -
ENGG. APPR. NO. -
DRG. NO. -301-2/AL/A/1217
SHEET NO. :1 OF 1
DATE : 27.08.2024

STATUS
A

TR.