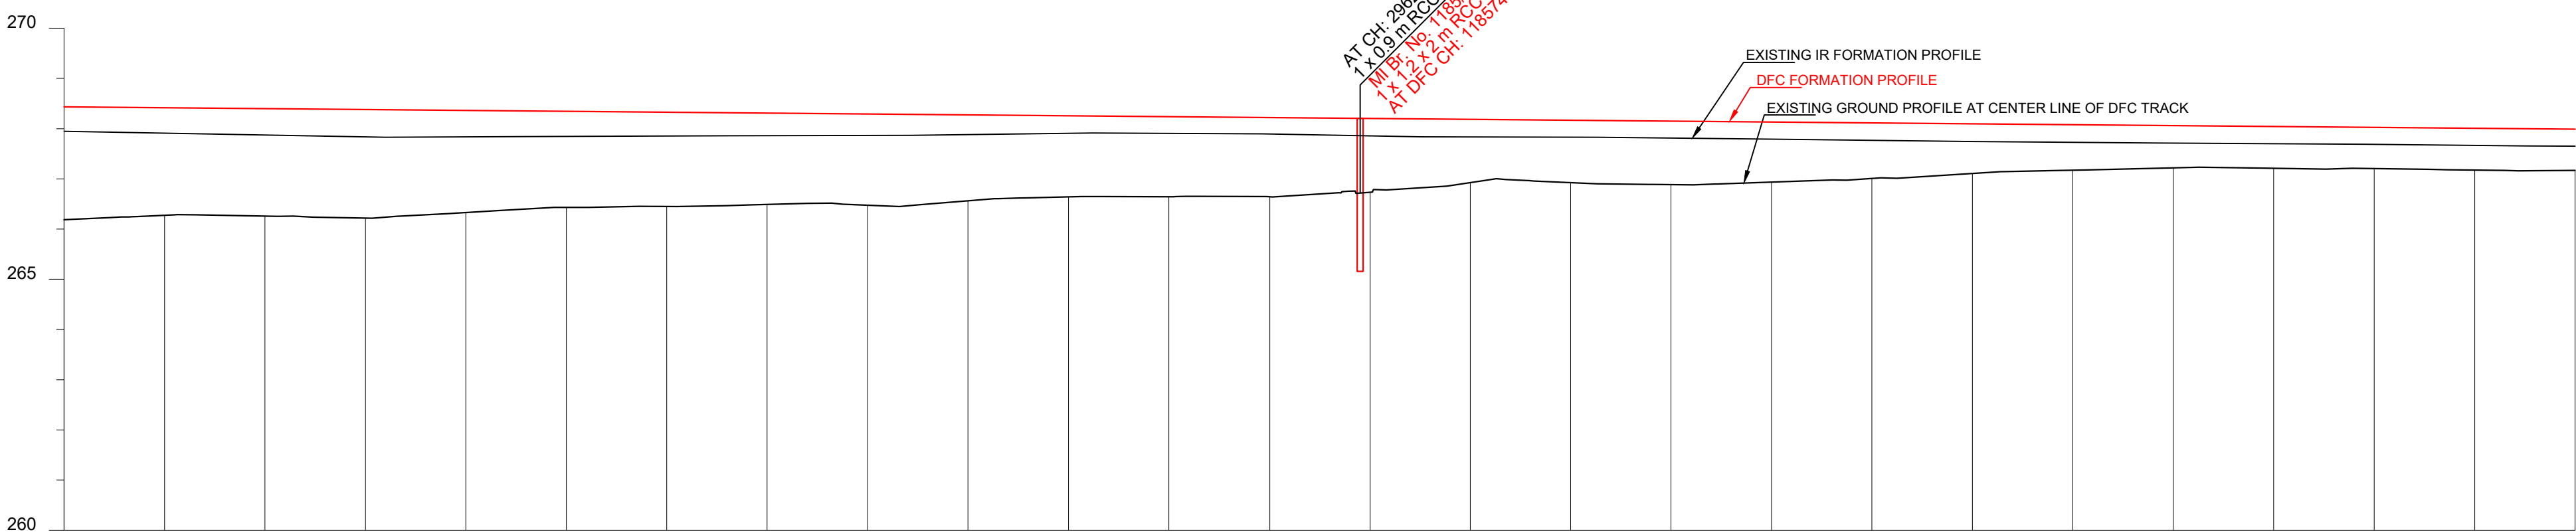


[illegible]

A diagram of a cyclotron. It shows two semi-circular electrodes called dees, labeled 'D1' and 'D2'. A central vertical axis is shown. A particle path is indicated by a line with arrows, starting from the center and spiraling outwards, crossing the gap between the dees multiple times. A north arrow is shown pointing towards the top right.

AS BUILT DRAWING	
TITLE AS-BUILT PLAN AND PROFILE FROM IR KM: 296.000 TO 296.500 DFC KM: 1185.489 TO 1185.989	DFCC APPR. NO. -
	ENGG. APPR. NO. -
	DRG. NO. -301-2/AL/A/1218
	SHEET NO. : 1 OF 1
	DATE : 27.08.2024
	STATUS A

TR.