
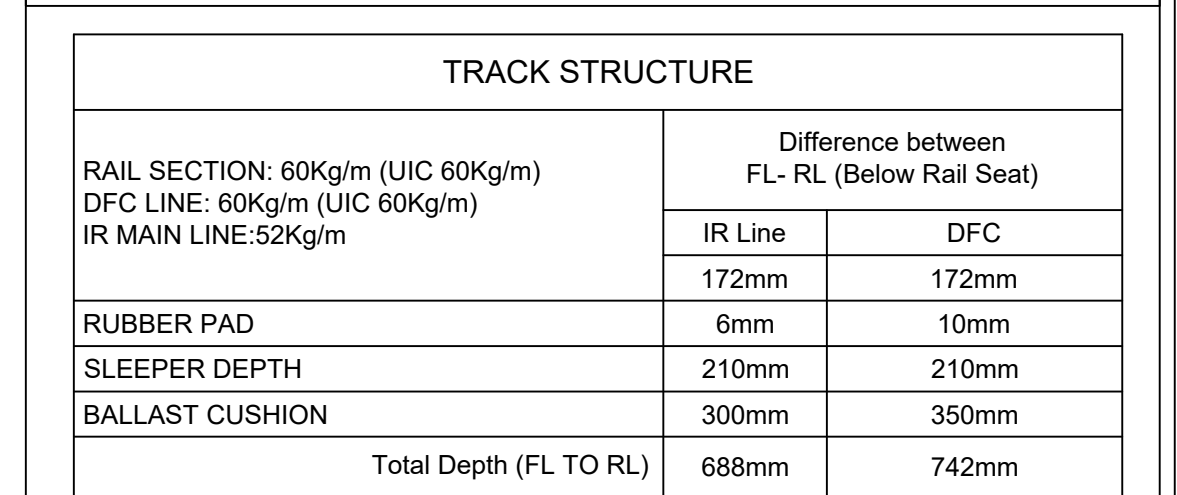


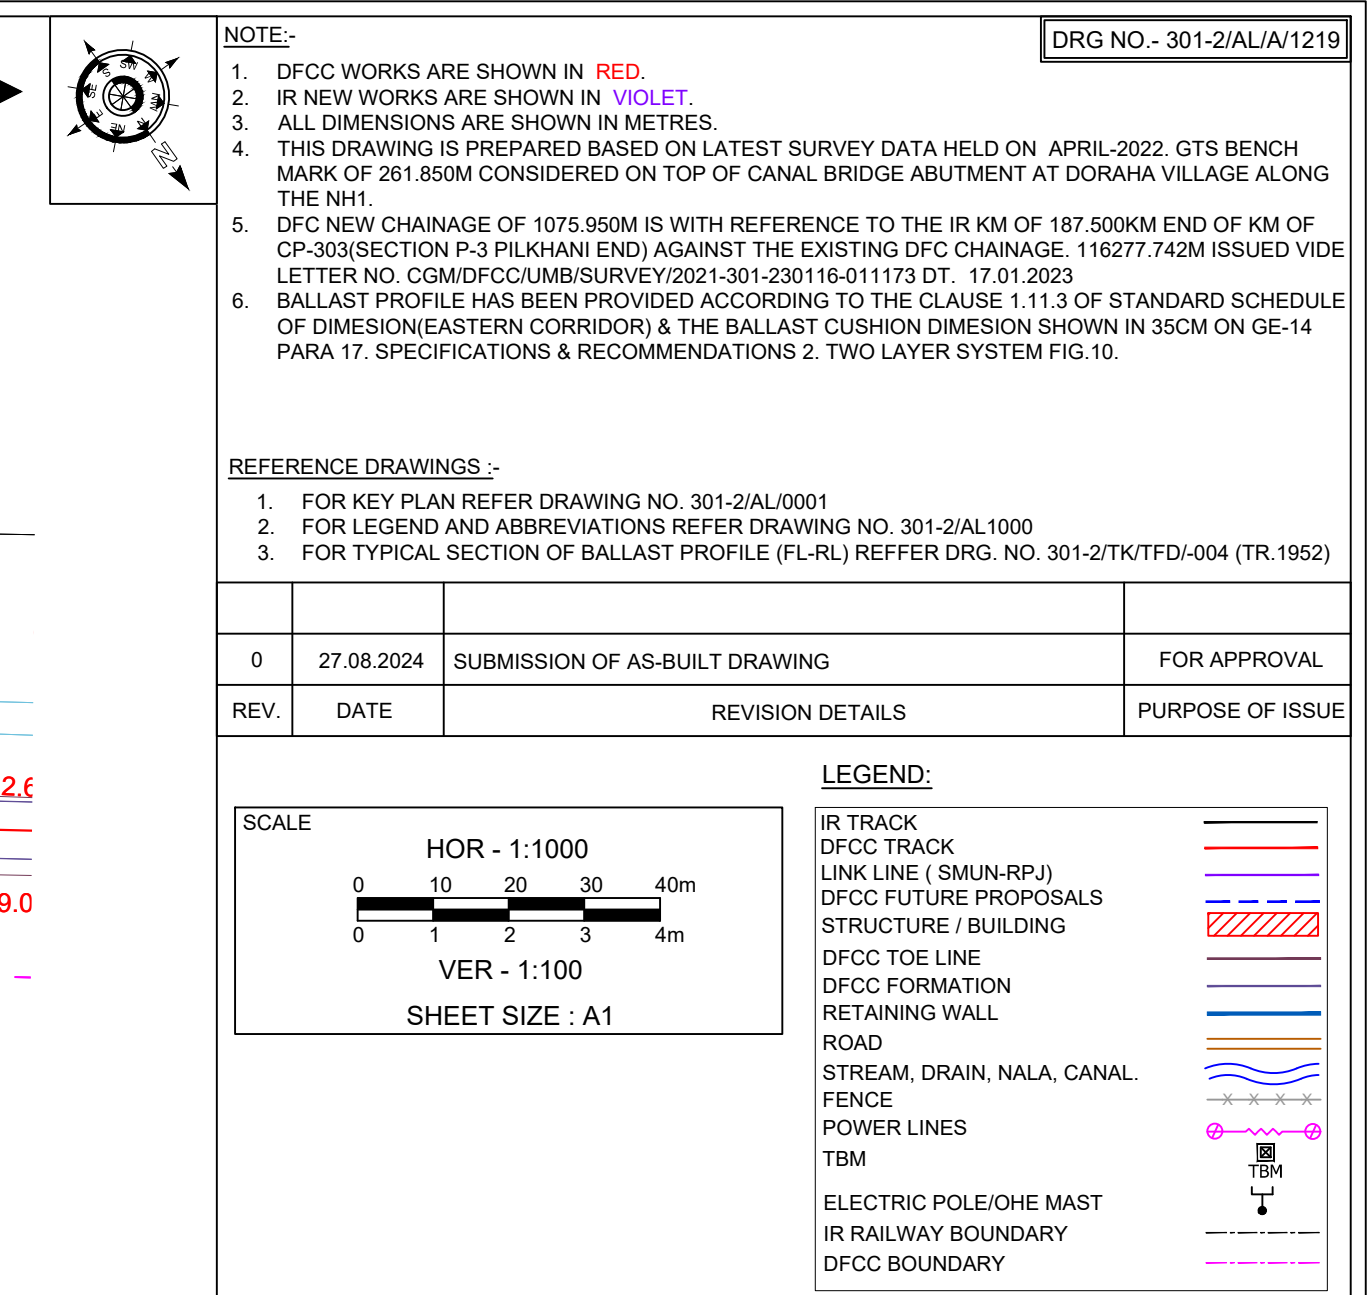

OWNER	DEDICATED FREIGHT CORRIDOR CORPORATION OF INDIA LTD. (A GOVERNMENT OF INDIA ENTERPRISE) PROJECT OFFICE (AMBALA UNIT): OLD RAILWAY COLONY (NEAR ANAND MARKET), AMBALA CANTT-133001. CORPORATE IDENTITY NO. : U60232D.2006GO155068
-------	---

ENGINEER:

 DB Engineering & Consulting GmbH
Deutsche Bahn Engineering & Consulting GmbH

CONTRACTOR:	GIL - TPL JV
	 

SUBMITTED BY		GIL - TPL JV	
	DATED	NAME	SIGNATURE
PREPARED BY			
CHECKED BY	27.08.2024	VIJAY PRATAP	
APPROVED BY	27.08.2024	PARASURAM KOTYADA	

APPROVED BY	DEUTSCHE BAHN ENGINEERING & CONSULTING GMBH		
	DATED	NAME	SIGNATURE
Sr. DE./CHIEF ENGINEER		SURESH K.YALANGI	
CHIEF TRACK ENGINEER		RAJ PAL SINGH	
T.L.		H.D. VIDJAK	

STAMP	A AS-BUILT DRAWING TR. Ref.:..... ENGINEER Sign.:		
	EMPLOYER (DFCCIL): DEDICATED FREIGHT CORRIDOR CORPORATION OF INDIA LTD.		

AS BUILT DRAWING

TITLE AS-BUILT PLAN AND PROFILE FROM IR KM: 296.500 TO 297.000 DFC KM: 1185.989 TO 1186.489	DFCC APPR. NO. -	
	ENGG. APPR. NO. -	
	DRG. NO. - 301-2/AL/A/1219	
	SHEET NO. : 1 OF 1	STATUS
DATE : 27.08.2024	A	

DATUM ABOVE MSL : 265 m		265																												
HORIZONTAL ALIGNMENT																														
VERTICAL ALIGNMENT																														
TRACK DISTANCE FROM EXISTING NEAREST IR DN MAIN LINE TO DFC MAIN LINE			-12.792	-12.792	-12.776	-12.771	-12.768	-12.757	-12.746	-12.734	-12.723	-12.714	-12.715	-12.701	-12.676	-12.668	-12.659	-12.643	-12.632	-12.626	-12.620	-12.611	-12.562	-12.538	-12.536	-12.531	-12.548	-12.632	-12.644	
HEIGHT OF BANKING(+) / DEPTH OF CUTTING(-) (PFL-GL)			+0.821	+0.821	+0.824	+0.868	+0.868	+0.910	+1.058	+1.052	+1.109	+1.290	+1.223	+1.109	+1.124	+1.211	+1.084	+0.808	+0.211	+0.370	+0.962	+1.284	+1.183	+1.122	+1.179	+1.288	+1.250	+1.217	+1.187	+1.102
EXG GROUND LEVEL AT CENTER LINE OF DFC TRACK (GL)			-267.188	-267.188	-267.147	-267.085	-267.085	-267.025	-266.859	-266.847	-266.773	-266.574	-266.623	-266.719	-266.686	-266.581	-266.690	-266.949	-267.528	-267.351	-266.841	-266.401	-266.484	-266.527	-266.453	-266.332	-266.356	-266.377	-266.395	-266.488
EXG GROUND LEVEL AT TOE LOCATION OF DFC TRACK			-267.023	-267.023	-266.968	-266.919	-266.919	-266.847	-266.854	-266.769	-266.631	-266.614	-266.645	-266.652	-266.627	-266.625	-266.661	-266.798	-266.994	-266.773	-266.773	-266.666	-266.419	-266.421	-266.381	-266.381	-266.332	-266.357	-266.370	-266.350
DIFFERENCE BETWEEN DFC FORMATION LEVEL AND EXG.FORMATION LEVEL.(PFL-EFL)			0.337	0.337	0.325	0.314	0.314	0.292	0.287	0.285	0.289	0.276	0.258	0.239	0.224	0.212	0.178	0.145	0.119	0.129	0.181	0.235	0.287	0.298	0.311	0.327	0.341	0.357	0.385	0.385
DFC FORMATION LEVEL (PFL)			-267.989	-267.989	-267.971	-267.953	-267.953	-267.935	-267.917	-267.899	-267.882	-267.864	-267.846	-267.828	-267.810	-267.792	-267.774	-267.757	-267.739	-267.721	-267.703	-267.685	-267.667	-267.649	-267.632	-267.618	-267.600	-267.582	-267.564	-267.546
EXG. FORMATION LEVEL OF EXG IR DN MAIN LINE (EFL)			-267.652	-267.652	-267.646	-267.639	-267.639	-267.643	-267.630	-267.614	-267.593	-267.588	-267.588	-267.589	-267.586	-267.580	-267.586	-267.612	-267.620	-267.592	-267.522	-267.450	-267.380	-267.351	-267.321	-267.291	-267.265	-267.237	-267.197	-267.165
DIFFERENCE BETWEEN DFC RAIL LEVEL AND EXG. RAIL LEVEL (PRL - ERL)			0.362	0.362	0.350	0.339	0.339	0.317	0.312	0.311	0.314	0.301	0.283	0.264	0.249	0.238	0.203	0.170	0.144	0.154	0.206	0.260	0.312	0.324	0.336	0.352	0.366	0.382	0.409	0.410
DFC RAIL LEVEL (PRL)			-268.340	-268.340	-268.334	-268.327	-268.327	-268.331	-268.318	-268.302	-268.281	-268.276	-268.257	-268.237	-268.214	-268.208	-268.248	-268.470	-268.452	-268.434	-268.416	-268.388	-268.360	-268.339	-268.319	-268.299	-268.279	-268.259	-268.239	-268.223
EXG.RAIL LEVEL OF NEAREST IR DN MAIN LINE(ERL)			-268.702	-268.702	-268.684	-268.666	-268.666	-268.648	-268.630	-268.613	-268.595	-268.577	-268.559	-268.539	-268.514	-268.492	-268.468	-268.440	-268.414	-268.388	-268.360	-268.332	-268.304	-268.276	-268.248	-268.220	-268.192	-268.164	-268.136	-268.108
EQUIVALENT CHAINAGE ON DFC TRACK			296500.0	296500.0	296520.0	296540.0	296540.0	296560.0	296580.0	296600.0	296620.0	296640.0	296660.0	296680.0	296700.0	296720.0	296740.0	296760.0	296780.0	296800.0	296820.0	296840.0	296860.0	296880.0	296900.0	296920.0	296940.0	296960.0	296980.0	297000.0
EXISTING IR CHAINAGE			296500.0	296500.0	296520.0	296540.0	296540.0	296560.0	296580.0	296600.0	296620.0	296640.0	296660.0	296680.0	296700.0	296720.0	296740.0	296760.0	296780.0	296800.0	296820.0	296840.0	296860.0	296880.0	296900.0	296920.0	296940.0	296960.0	296980.0	297000.0

L - SECTION

TR.
