
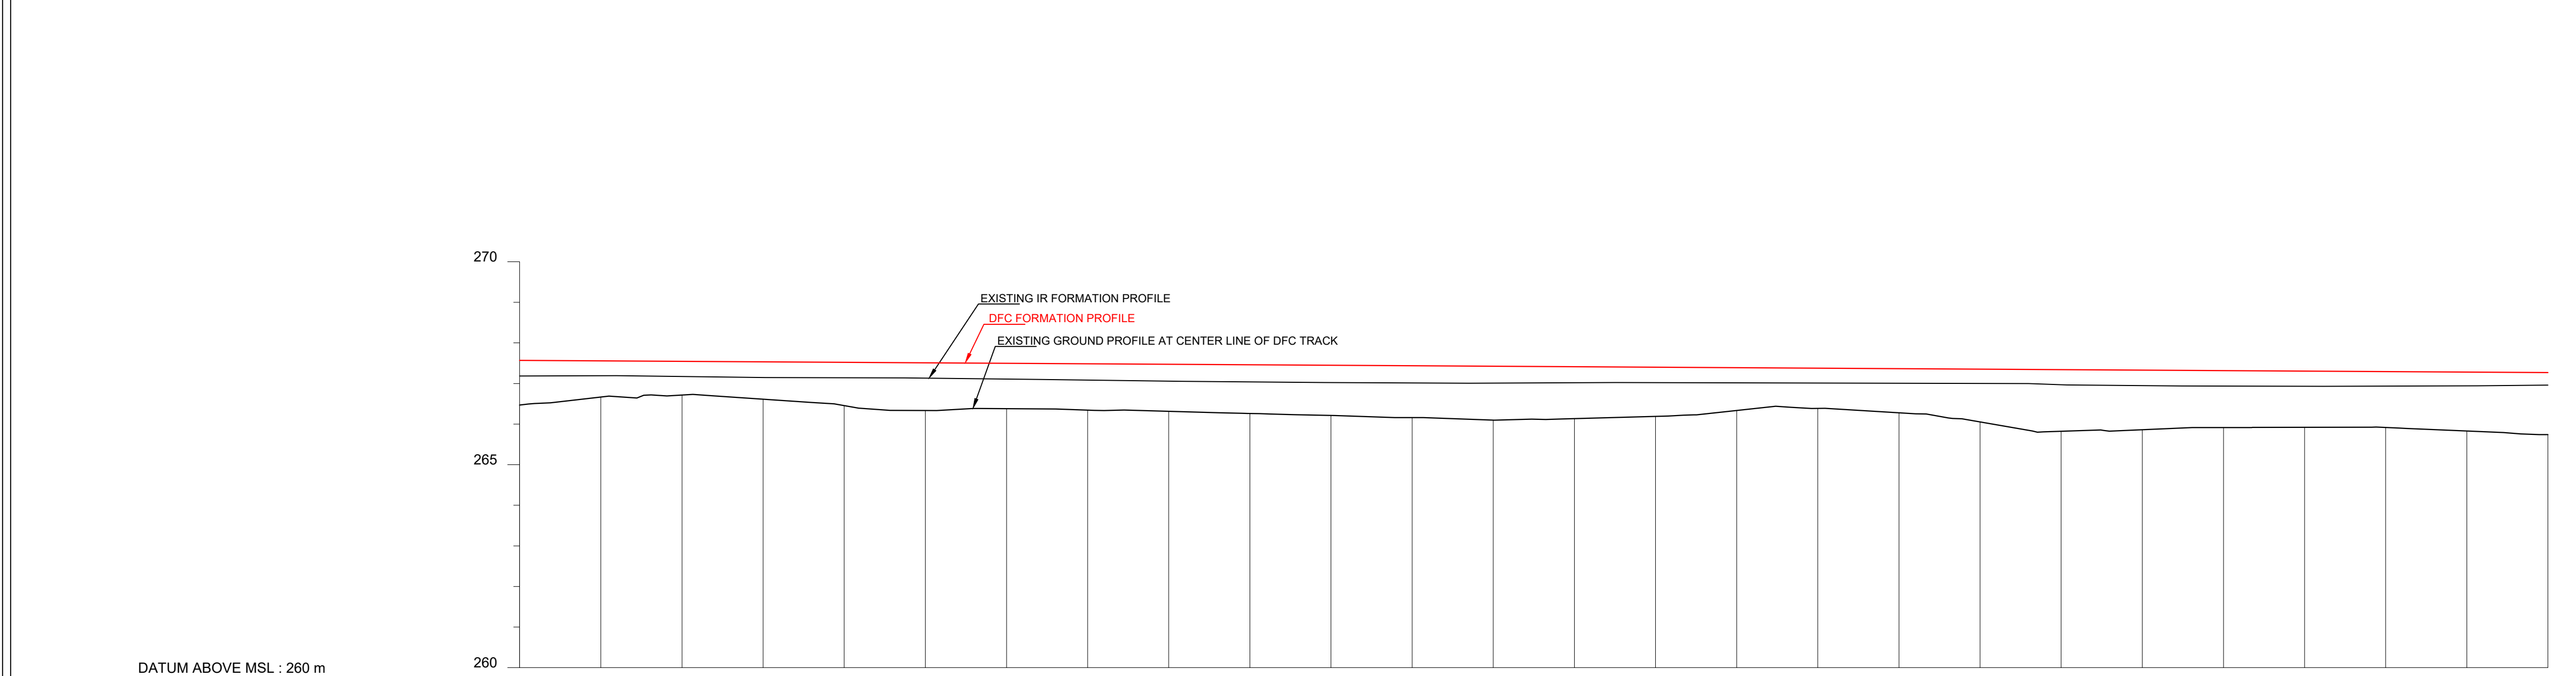


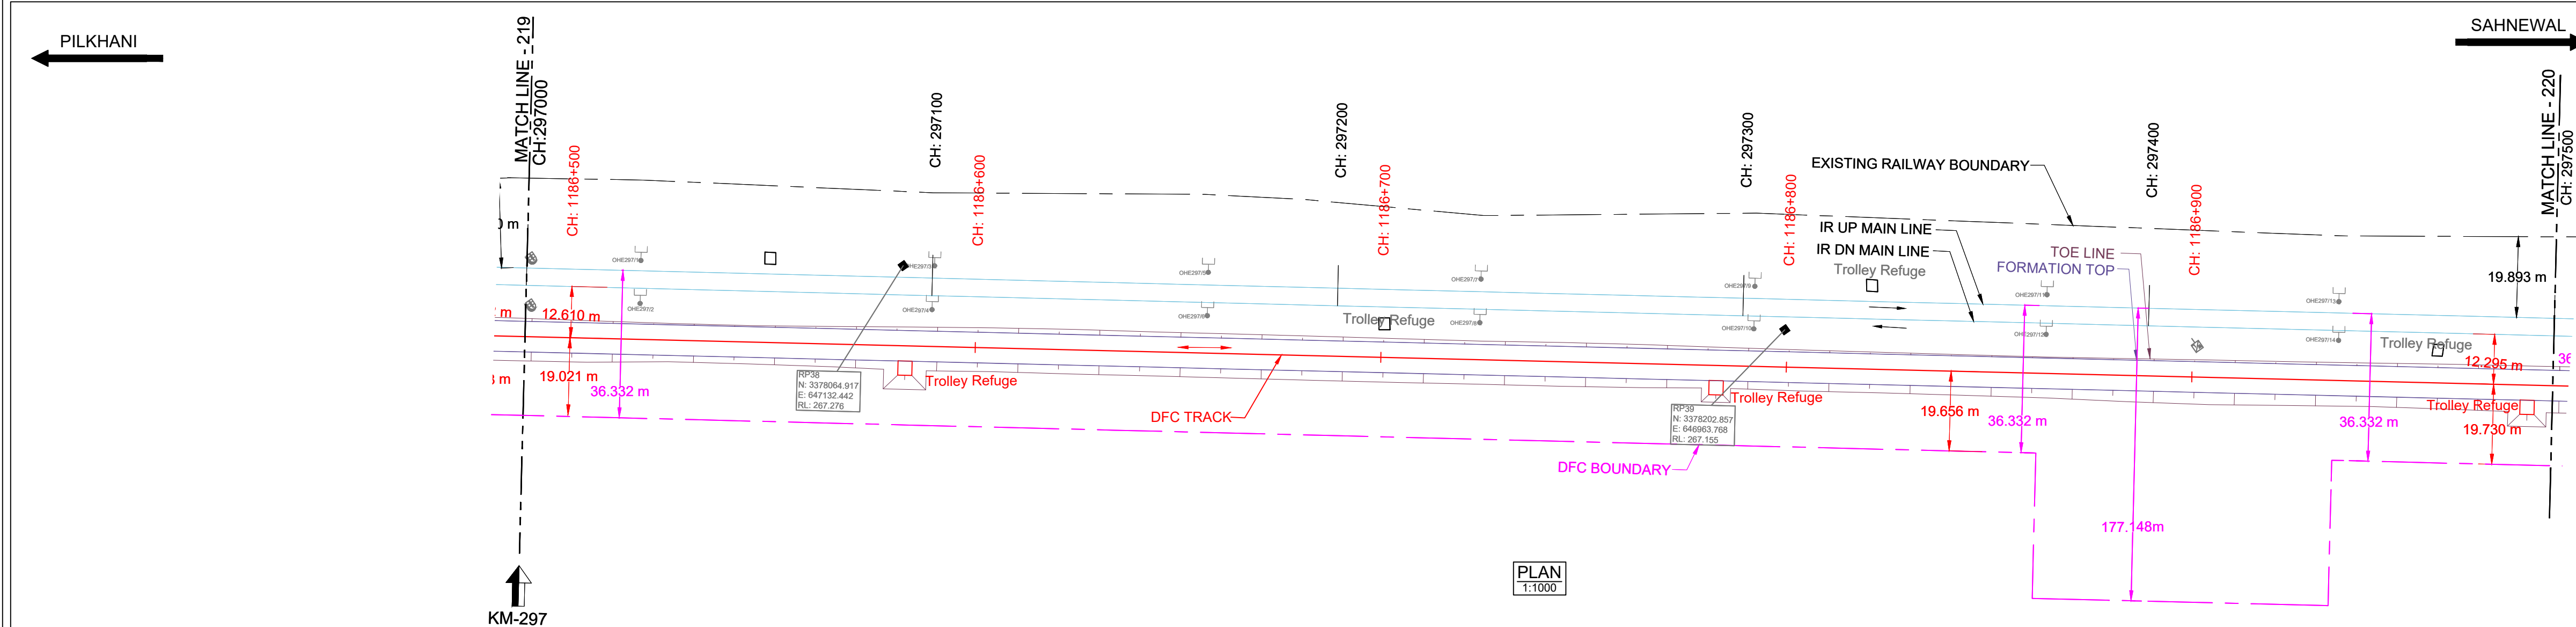

DATUM ABOVE MSL : 260 m

HORIZONTAL ALIGNMENT	L = 5898.430m																			
VERTICAL ALIGNMENT	L=1575.274 m 1 IN 1668 F																			
TRACK DISTANCE FROM EXISTING NEAREST IR DN MAIN LINE TO DFC MAIN LINE	12.644																			
HEIGHT OF BANKING(+) / DEPTH OF CUTTING(-) (PFL-GL)	+1.102																			
EXG GROUND LEVEL AT CENTER LINE OF DFC TRACK (GL)	266.468																			
EXG GROUND LEVEL AT TOE LOCATION OF DFC TRACK	266.350																			
DIFFERENCE BETWEEN DFC FORMATION LEVEL AND EXG.FORMATION LEVEL (PFL-EFL)	0.385																			
DFC FORMATION LEVEL (PFL)	267.570																			
EXG. FORMATION LEVEL OF EXG IR DN MAIN LINE (EFL)	267.185																			
DIFFERENCE BETWEEN DFC RAIL LEVEL AND EXG. RAIL LEVEL (PRL - ERL)	0.410																			
DFC RAIL LEVEL (PRL)	268.283																			
EXG.RAIL LEVEL OF NEAREST IR DN MAIN LINE(ERL)	267.873																			
EQUIVALENT CHAINAGE ON DFC TRACK	297000.0	-1186489.1	267.873																	
EXISTING IR CHAINAGE	297020.0	-1186509.1	267.878	268.271	268.259	268.259	268.259	268.259	268.259	268.259	268.259	268.259	268.259	268.259	268.259	268.259	268.259	268.259	268.259	268.259

L - SECTION

NOTE:-

- DFCC WORKS ARE SHOWN IN RED.
- IR NEW WORKS ARE SHOWN IN VIOLET.
- ALL DIMENSIONS ARE SHOWN IN METRES.
- THIS DRAWING IS PREPARED BASED ON LATEST SURVEY DATA HELD ON APRIL-2022. GTS BENCH MARK OF 261.850M CONSIDERED ON TOP OF CANAL BRIDGE ABUTMENT AT DORAH VILLAGE ALONG THE NH1.
- DFC NEW CHAINAGE OF 1075.950M IS WITH REFERENCE TO THE IR KM OF 187.500KM END OF KM OF CP-303(SECTION P-3 PILKHANI END) AGAINST THE EXISTING DFC CHAINAGE. 116277.742M ISSUED VIDE LETTER NO. COM/DFCC/UMS/SURVEY/2021-301-230116-011173.DT. 17.01.2023.
- BALLAST PROFILE HAS BEEN PROVIDED ACCORDING TO THE CLAUSE 1.11.3 OF STANDARD SCHEDULE OF DIMENSION(EASTERN CORRIDOR) & THE BALLAST CUSHION DIMENSION SHOWN IN 35CM ON GE-14 PARA 17. SPECIFICATIONS & RECOMMENDATIONS 2. TWO LAYER SYSTEM FIG.10.

DRG NO.- 301-2/AL/A/1220

REFERENCE DRAWINGS :-

- FOR KEY PLAN REFER DRAWING NO. 301-2/AL/0001
- FOR LEGEND AND ABBREVIATIONS REFER DRAWING NO. 301-2/AL/1000
- FOR TYPICAL SECTION OF BALLAST PROFILE (FL-RL) REFER DRG. NO. 301-2/TK/TFD/004 (TR.1952)

0	27.08.2024	SUBMISSION OF AS-BUILT DRAWING	FOR APPROVAL
REV.	DATE	REVISION DETAILS	PURPOSE OF ISSUE

LEGEND:

IR TRACK	DFCC TRACK	LINK LINE (SMUN-RP-J)	DFCC FUTURE PROPOSALS	STRUCTURE / BUILDING	DFCC TOE LINE	DFCC FORMATION	RETAINING WALL	ROAD	STREAM, DRAIN, NALA, CANAL.	FENCE	POWER LINES	TBM	ELECTRIC POLE/OHE MAST	IR RAILWAY BOUNDARY	DFCC BOUNDARY
----------	------------	-----------------------	-----------------------	----------------------	---------------	----------------	----------------	------	-----------------------------	-------	-------------	-----	------------------------	---------------------	---------------

SCALE

HOR - 1:1000

VER - 1:100

SHEET SIZE : A1

TYPICAL SECTION

TRACK STRUCTURE		
RAIL SECTION: 60Kg/m (UIC 60Kg/m)	Difference between FL- RL (Below Rail Seat)	
DFC LINE: 60Kg/m (UIC 60Kg/m)	IR Line	DFC
IR MAIN LINE: 52Kg/m	172mm	172mm
RUBBER PAD	6mm	10mm
SLEEPER DEPTH	210mm	210mm
BALLAST CUSHION	300mm	350mm
Total Depth (FL TO RL)	688mm	742mm

OWNER

DEDICATED FREIGHT CORRIDOR CORPORATION OF INDIA LTD.

(A GOVERNMENT OF INDIA ENTERPRISE)

PROJECT OFFICE (AMBALA UNIT): OLD RAILWAY COLONY (NEAR ANAND MARKET), AMBALA CANTT-133001.

CORPORATE IDENTITY NO. : U60232DL2006GGI155068

ENGINEER:

DB Engineering & Consulting GmbH

Deutsche Bahn Engineering & Consulting GmbH

CONTRACTOR:

GIL - TPL JV

GAR TATA

SUBMITTED BY	GIL - TPL JV		
	DATED	NAME	SIGNATURE
PREPARED BY			
CHECKED BY	27.08.2024	VIJAY PRATAP	
APPROVED BY	27.08.2024	PARASURAM KOTYADA	

APPROVED BY

DEUTSCHE BAHN ENGINEERING & CONSULTING GMBH

	DATED	NAME	SIGNATURE
Sr. DE./CHIEF ENGINEER		SURESH K.YALANGI	
CHIEF TRACK ENGINEER		RAJ PAL SINGH	
T.L.		H.D. VIDJAK	

STAMP

AS-BUILT DRAWING

TR. Ref.....

ENGINEER Sign.:

EMPLOYER (DFCCIL):

DEDICATED FREIGHT CORRIDOR CORPORATION OF INDIA LTD.

AS BUILT DRAWING

TITLE

AS-BUILT PLAN AND PROFILE

FROM IR KM: 297.000 TO 297.500

DFC KM: 1186.489 TO 1186.989

DFCC APPR. NO. -

ENGG. APPR. NO. -

DRG. NO. - 301-2/AL/A/1220

SHEET NO. : 1 OF 1

DATE : 27.08.2024

STATUS

A

TR.