


PILKHANI

SAHNEWAL

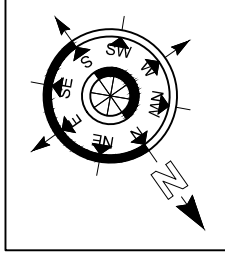

NOTE:-

- DFCC WORKS ARE SHOWN IN RED.
- IR NEW WORKS ARE SHOWN IN VIOLET.
- ALL DIMENSIONS ARE SHOWN IN METRES.
- THIS DRAWING IS PREPARED BASED ON LATEST SURVEY DATA HELD ON APRIL-2022. GTS BENCH MARK OF 261.850M CONSIDERED ON TOP OF CANAL BRIDGE ABUTMENT AT DORAHA VILLAGE ALONG THE NH1.
- DFCC NEW CHAINAGE OF 1075.950M IS WITH REFERENCE TO THE IR KM OF 187.500KM END OF KM OF CP-303/SECTION P-3 PILKHANI END) AGAINST THE EXISTING DFC CHAINAGE. 116277.742M ISSUED VIDE LETTER NO. CGM/DFCC/JMB/SURVEY/2021-301-230116-011173 DT. 17.01.2023
- BALLAST PROFILE HAS BEEN PROVIDED ACCORDING TO THE CLAUSE 1.11.3 OF STANDARD SCHEDULE OF DIMENSION(EASTERN CORRIDOR) & THE BALLAST CUSHION DIMENSION SHOWN IN 35CM ON GE-14 PARA 17. SPECIFICATIONS & RECOMMENDATIONS 2. TWO LAYER SYSTEM FIG.10.

REFERENCE DRAWINGS :-

- FOR KEY PLAN REFER DRAWING NO. 301-2/AL/0001
- FOR LEGEND AND ABBREVIATIONS REFER DRAWING NO. 301-2/AL/1000
- FOR TYPICAL SECTION OF BALLAST PROFILE (FL-RL) REFER DRG. NO. 301-2/TK/TFD/004 (TR.1952)

0	27.08.2024	SUBMISSION OF AS-BUILT DRAWING	FOR APPROVAL
REV.	DATE	REVISION DETAILS	PURPOSE OF ISSUE

SCALE


HOR - 1:1000

VER - 1:100

SHEET SIZE : A0

LEGEND:

IR TRACK
DFCC TRACK
LINK LINE (SHUN-RPJ)
DFCC FUTURE PROPOSALS
STRUCTURE / BUILDING
DFCC TOE LINE
DFCC FORMATION
RETAINING WALL
ROAD
STREAM, DRAIN, NALA, CANAL.
FENCE
POWER LINES
TBM
ELECTRIC POLE/OHE MAST
IR RAILWAY BOUNDARY
DFCC BOUNDARY

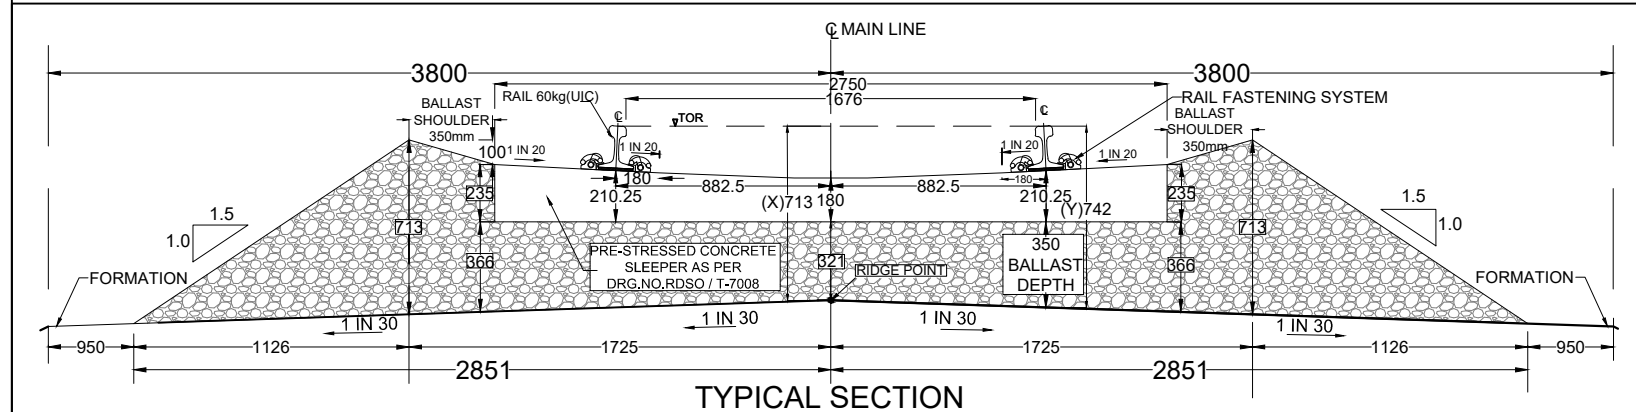

TRACK STRUCTURE		
RAIL SECTION: 60Kg/m (UIC 60Kg/m) DFC LINE: 60Kg/m (UIC 60Kg/m) IR MAIN LINE: 52Kg/m	Difference between FL- RL (Below Rail Seat)	
	IR Line	DFC
RUBBER PAD	172mm	172mm
SLEEPER DEPTH	6mm	10mm
BALLAST CUSHION	210mm	210mm
	300mm	350mm
Total Depth (FL TO RL)	688mm	742mm

OWNER
dfcc
DEDICATED FREIGHT CORRIDOR CORPORATION OF INDIA LTD.
(A GOVERNMENT OF INDIA ENTERPRISE)
PROJECT OFFICE: AMBALA UNIT, OLD RAILWAY COLONY (NEAR ANAND MARKET), AMBALA CANTT-133001.
CORPORATE IDENTITY NO.: U60232DL200600155068

ENGINEER:
DB DB Engineering & Consulting GmbH
Deutsche Bahn Engineering & Consulting GmbH

CONTRACTOR:
GIL - TPL JV
GAR **TATA**

SUBMITTED BY	GIL - TPL JV		
	DATED	NAME	SIGNATURE
PREPARED BY			
CHECKED BY	27.08.2024	VIJAY PRATAP	
APPROVED BY	27.08.2024	PARASURAM KOTYADA	

APPROVED BY	DEUTSCHE BAHN ENGINEERING & CONSULTING GMBH		
	DATED	NAME	SIGNATURE
Sr. DE./CHIEF ENGINEER		SURESH K.YALANGI	
CHIEF TRACK ENGINEER		RAJ PAL SINGH	
T.L.		H.D. VIDJAK	



STAMP
A AS-BUILT DRAWING
TR. Ref.....
ENGINEER Sign..:

EMPLOYER (DFCCIL): DEDICATED FREIGHT CORRIDOR CORPORATION OF INDIA LTD.

--	--	--	--

AS BUILT DRAWING			
TITLE AS-BUILT PLAN AND PROFILE		DFCC APPR. NO. - ENGG. APPR. NO. -	
FROM IR KM: 286.000 TO 286.500 DFC KM: 1175.419 TO 1175.949		DRG. NO. - 301-2/AL/A/1198 SHEET NO. : 1 OF 1 DATE : 27.08.2024	
			STATUS A

TR.

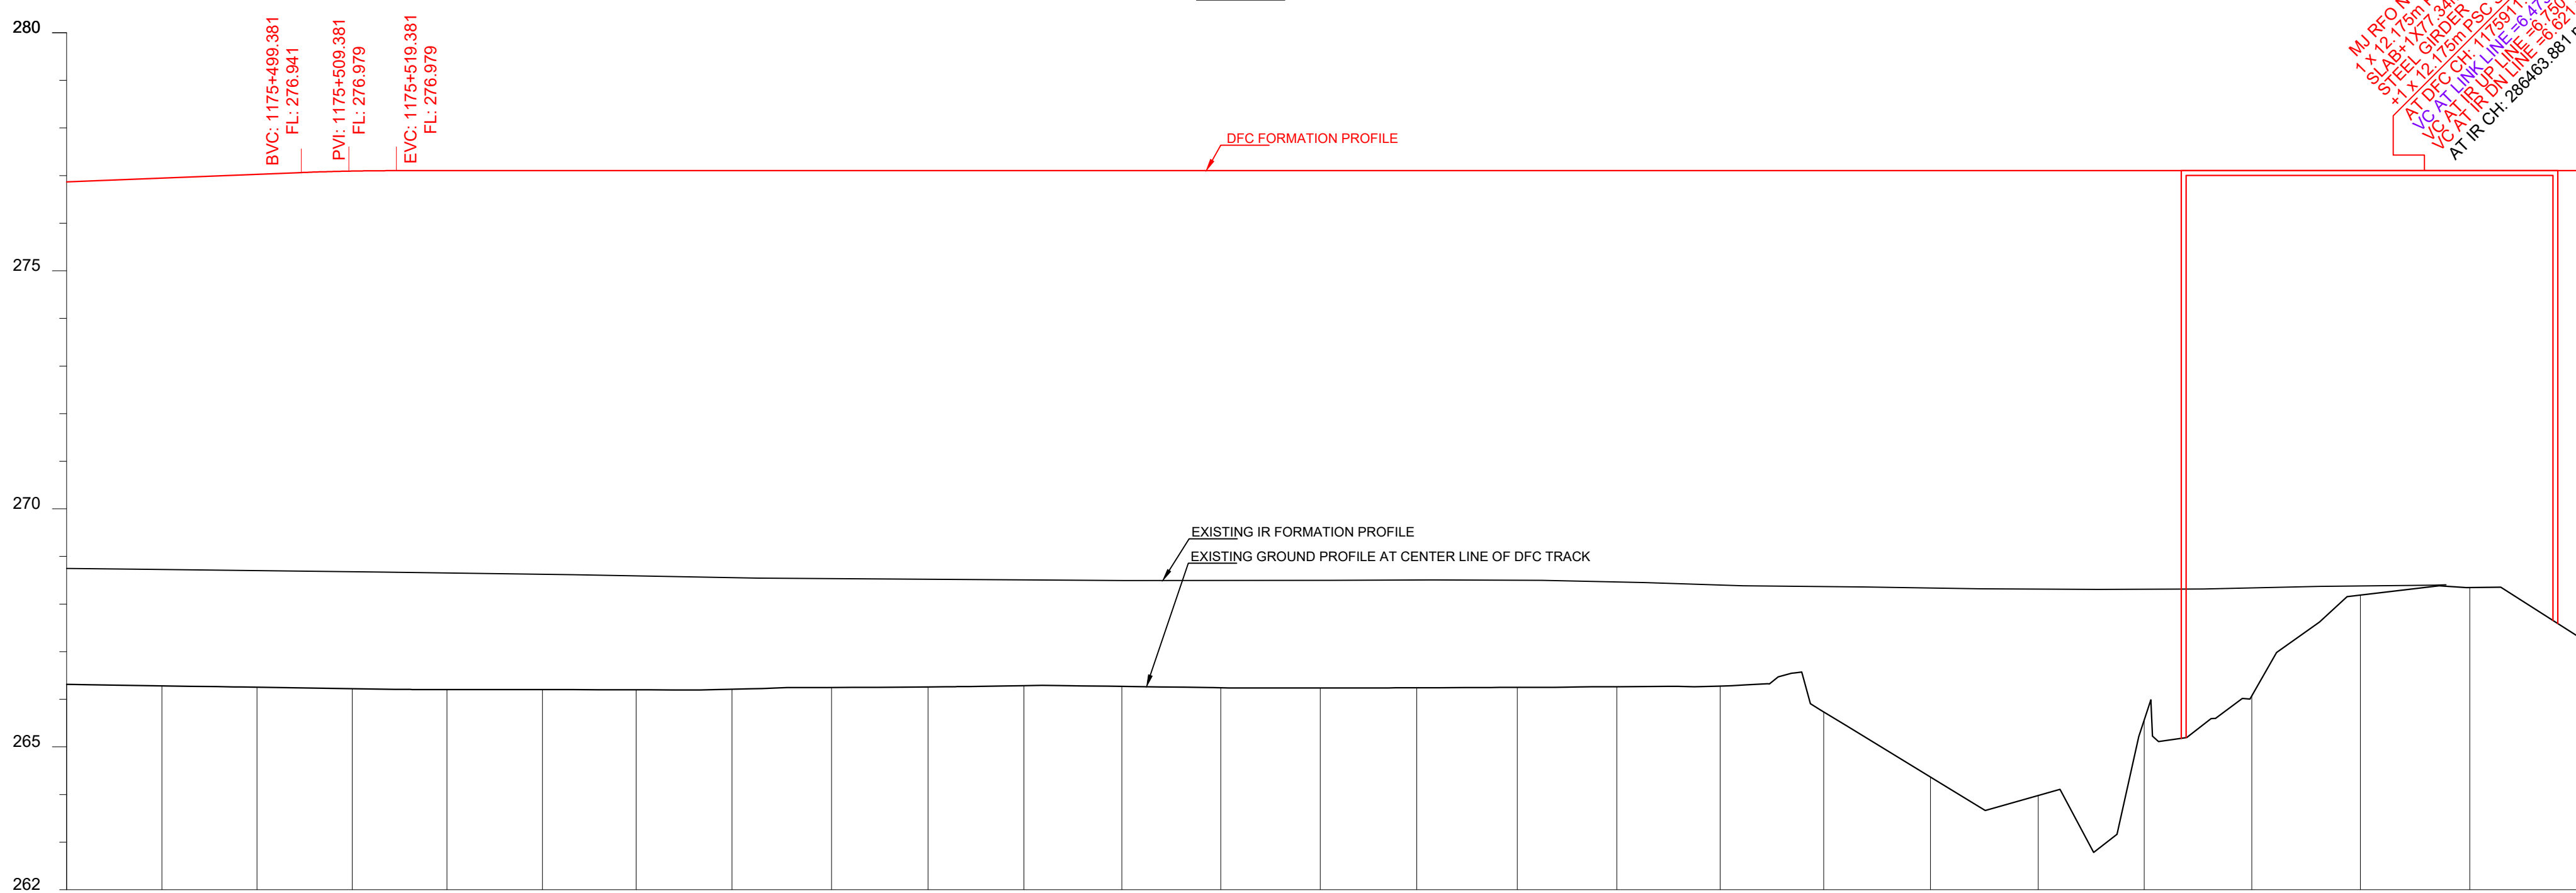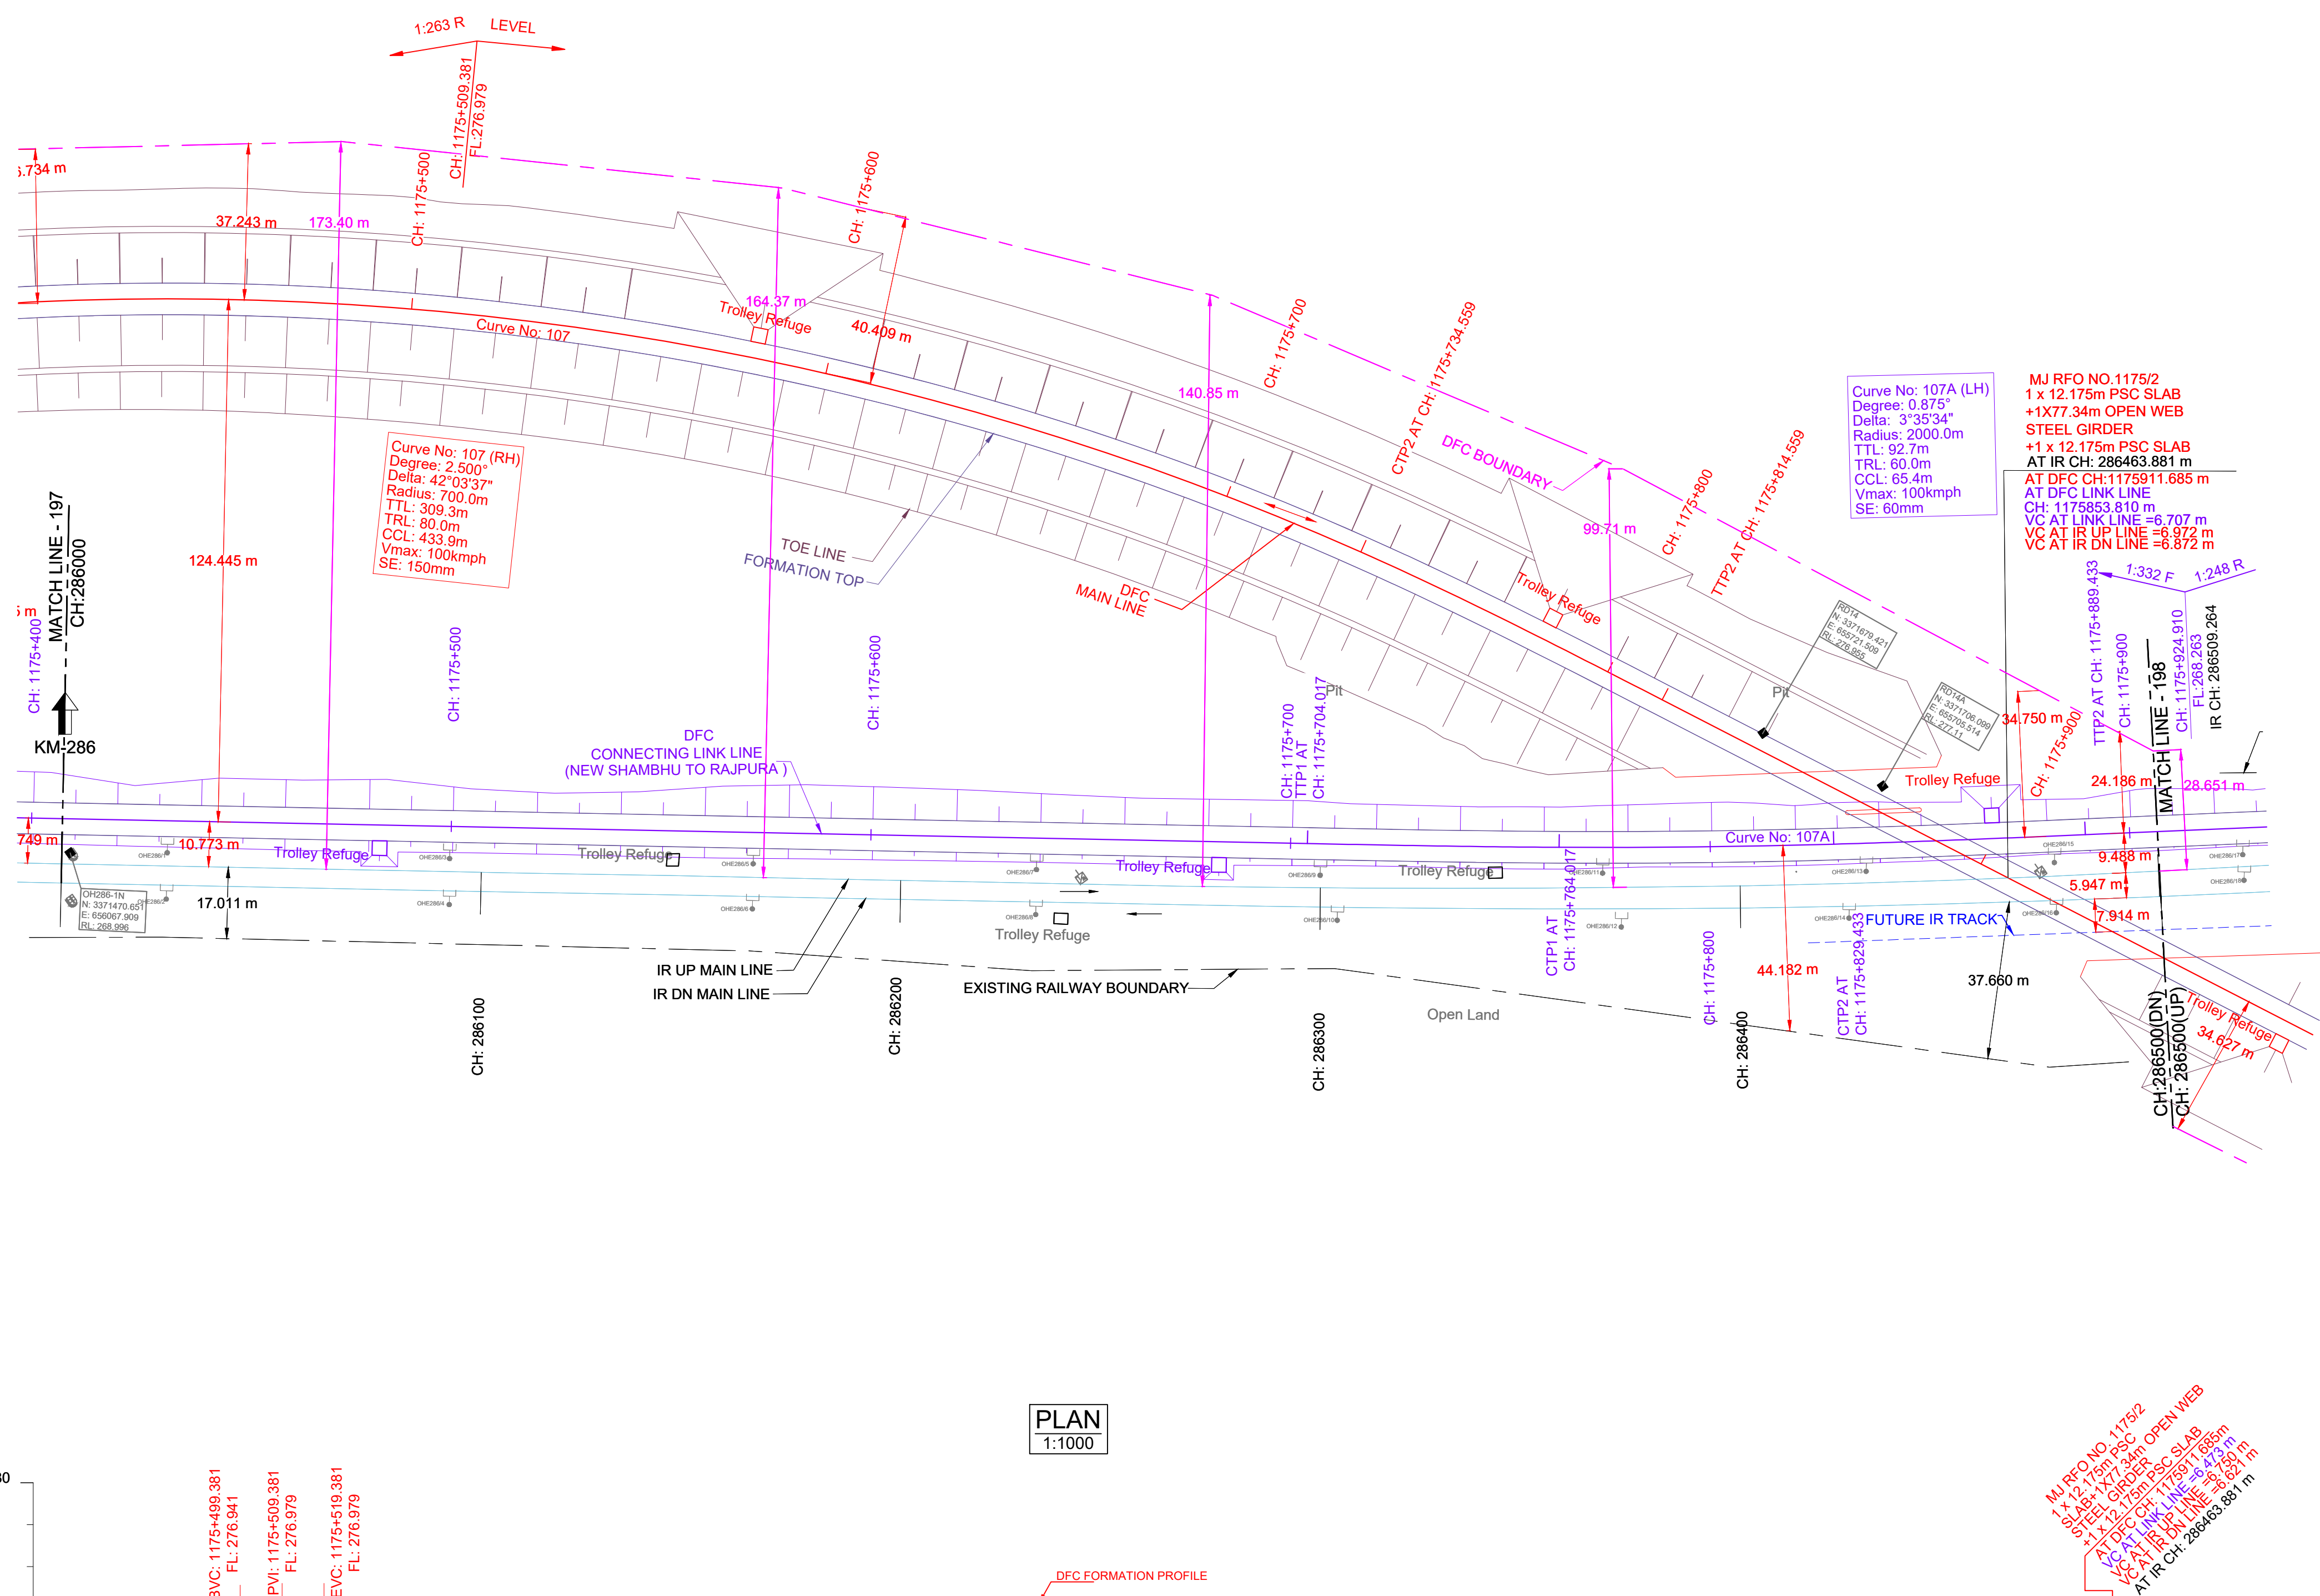

HORIZONTAL ALIGNMENT		R=700m		TL= 80m		L= 179.487m	
VERTICAL ALIGNMENT		L=1004 m T.W. 202.973 R		L=20.0 m H=50.57 m		L=606.84 m H=12.61 m	
TRACK DISTANCE FROM EXISTING NEAREST IR UP MAIN LINE TO DFC MAIN LINE		286000.0 - 1175419.5	134.233	286000.0 - 1175419.5	134.233	286000.0 - 1175419.5	134.233
HEIGHT OF BANKING(+) / DEPTH OF CUTTING(-) (PFL-GL)		286000.0 - 1175419.5	-10.536	286000.0 - 1175419.5	-10.536	286000.0 - 1175419.5	-10.536
EXG GROUND LEVEL AT CENTER LINE OF DFC TRACK (GL)		286000.0 - 1175419.5	-266.081	286000.0 - 1175419.5	-266.081	286000.0 - 1175419.5	-266.081
EXG GROUND LEVEL AT TOE LOCATION OF DFC TRACK		286000.0 - 1175419.5	-266.103	286000.0 - 1175419.5	-266.103	286000.0 - 1175419.5	-266.103
DIFFERENCE BETWEEN DFC FORMATION LEVEL AND EXG FORMATION LEVEL (PFL-EFL)		286000.0 - 1175419.5	8.105	286000.0 - 1175419.5	8.105	286000.0 - 1175419.5	8.105
DFC FORMATION LEVEL (PFL)		286000.0 - 1175419.5	-276.637	286000.0 - 1175419.5	-276.637	286000.0 - 1175419.5	-276.637
EXG FORMATION LEVEL OF EXG IR UP MAIN LINE (EFL)		286000.0 - 1175419.5	-268.532	286000.0 - 1175419.5	-268.532	286000.0 - 1175419.5	-268.532
DIFFERENCE BETWEEN DFC RAIL LEVEL AND EXG RAIL LEVEL (PRL - ERL)		286000.0 - 1175419.5	8.146	286000.0 - 1175419.5	8.146	286000.0 - 1175419.5	8.146
DFC RAIL LEVEL (PRL)		286000.0 - 1175419.5	-277.330	286000.0 - 1175419.5	-277.330	286000.0 - 1175419.5	-277.330
EXG RAIL LEVEL OF NEAREST IR UP MAIN LINE (ERL)		286000.0 - 1175419.5	-269.204	286000.0 - 1175419.5	-269.204	286000.0 - 1175419.5	-269.204
EQUIVALENT CHAINAGE ON DFC TRACK		286000.0 - 1175419.5	286.000	286000.0 - 1175419.5	286.000	286000.0 - 1175419.5	286.000
EXISTING IR CHAINAGE		286000.0 - 1175419.5	286.000	286000.0 - 1175419.5	286.000	286000.0 - 1175419.5	286.000

L - SECTION