


PILKHANI

SAHNEWAL

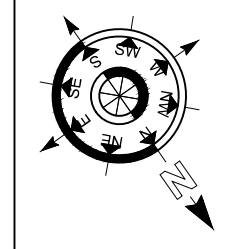

DRG NO.301-2/AL/A/1200

NOTE:-

1. DFC WORKS ARE SHOWN IN **RED**.
2. IR NEW WORKS ARE SHOWN IN **VIOLET**.
3. ALL DIMENSIONS ARE SHOWN IN METRES.
4. THIS DRAWING IS PREPARED BASED ON LATEST SURVEY DATA HELD ON APRIL-2022. GTS BENCH MARK OF 261.850M CONSIDERED ON TOP OF CANAL BRIDGE ABUTMENT AT DORAHA VILLAGE ALONG THE NH-1.
5. DFC NEW CHAINAGE OF 1075.950M IS WITH REFERENCE TO THE IR KM OF 187.500KM END OF KM OF CP-303/SECTION P-3 PILKHANI END) AGAINST THE EXISTING DFC CHAINAGE. 116277.742M ISSUED VIDE LETTER NO. CGM/DFCC/JMB/SURVEY/2021-301-230/116-01/1173 DT. 17.01.2023
6. BALLAST PROFILE HAS BEEN PROVIDED ACCORDING TO THE CLAUSE 1.11.3 OF STANDARD SCHEDULE OF DIMENSION(EASTERN CORRIDOR) & THE BALLAST CUSHION DIMENSION SHOWN IN 35CM ON GE-14 PARA 17. SPECIFICATIONS & RECOMMENDATIONS 2. TWO LAYER SYSTEM FIG.10.

REFERENCE DRAWINGS :-

1. FOR KEY PLAN REFER DRAWING NO. 301-2/AL/0001
2. FOR LEGEND AND ABBREVIATIONS REFER DRAWING NO. 301-2/AL/1000
3. FOR TYPICAL SECTION OF BALLAST PROFILE (FL-RL) REFER DRG. NO. 301-2/TK/TFD/004 (TR.1952)

0	27.08.2024	SUBMISSION OF AS-BUILT DRAWING	FOR APPROVAL
REV.	DATE	REVISION DETAILS	PURPOSE OF ISSUE

SCALE


HOR - 1:1000

VER - 1:100

SHEET SIZE : A0

LEGEND:

- IR TRACK
- DFCC TRACK
- LINK LINE (S/MUN-RPJ)
- DFCC FUTURE PROPOSALS
- STRUCTURE / BUILDING
- DFCC TOE LINE
- DFCC FORMATION
- RETAINING WALL
- ROAD
- STREAM, DRAIN, NALA, CANAL.
- FENCE
- POWER LINES
- TBM
- ELECTRIC POLE/OHE MAST
- IR RAILWAY BOUNDARY
- DFCC BOUNDARY

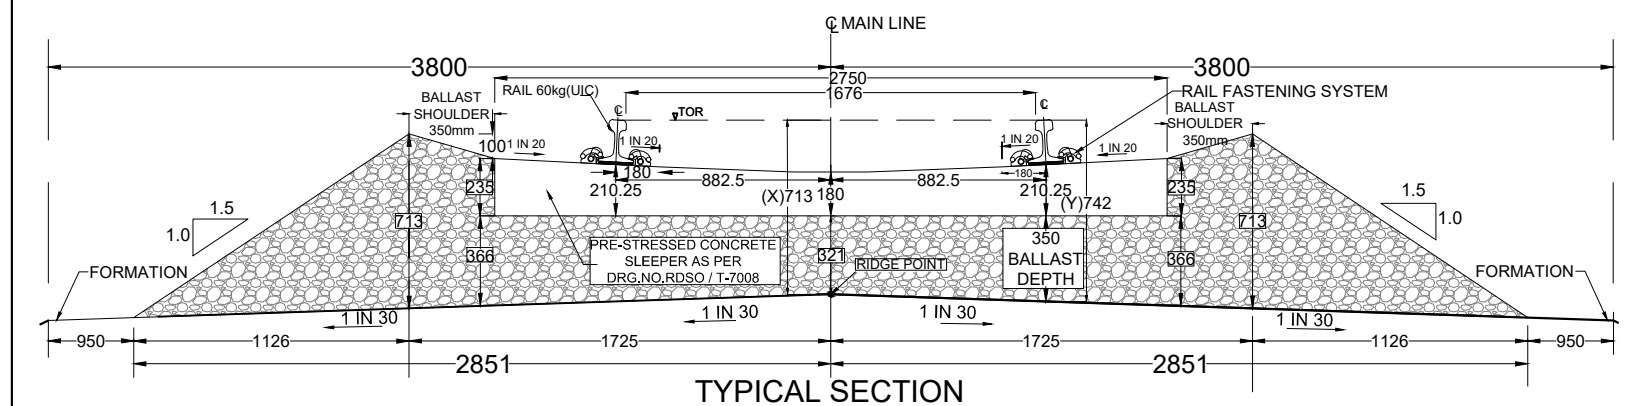

TRACK STRUCTURE		
RAIL SECTION: 60Kg/m (UIC 60Kg/m) DFC LINE: 60Kg/m (UIC 60Kg/m) IR MAIN LINE: 52Kg/m	Difference between FL- RL (Below Rail Seat)	
	IR Line	DFC
RUBBER PAD	172mm	172mm
SLEEPER DEPTH	6mm	10mm
BALLAST CUSHION	210mm	210mm
	300mm	350mm
Total Depth (FL TO RL)	688mm	742mm

OWNER
dedicated freight corridor corporation of india ltd.
(A GOVERNMENT OF INDIA ENTERPRISE)
PROJECT OFFICE: AMBALA UNIT, OLD RAILWAY COLONY (NEAR ANAND MARKET), AMBALA CANTT-133001.
CORPORATE IDENTITY NO.: U60232DL2006GOI155068

ENGINEER:
DB Engineering & Consulting GmbH
Deutsche Bahn Engineering & Consulting GmbH

CONTRACTOR:
GIL - TPL JV
GAR TATA

SUBMITTED BY	GIL - TPL JV		
	DATED	NAME	SIGNATURE
PREPARED BY			
CHECKED BY	27.08.2024	VIJAY PRATAP	
APPROVED BY	27.08.2024	PARASURAM KOTYADA	



APPROVED BY	DEUTSCHE BAHN ENGINEERING & CONSULTING GMBH		
	DATED	NAME	SIGNATURE
Sr. DE./CHIEF ENGINEER		SURESH K.YALANGI	
CHIEF TRACK ENGINEER		RAJ PAL SINGH	
T.L.		H.D. VIDJAK	

STAMP
A
AS-BUILT DRAWING
TR. Ref.....
ENGINEER Sign:..

EMPLOYER (DFCCIL): DEDICATED FREIGHT CORRIDOR CORPORATION OF INDIA LTD.

AS BUILT DRAWING		
TITLE AS-BUILT PLAN AND PROFILE FROM IR KM: 287.000 TO 287.500 DFC KM: 1176.467 TO 1177.970	DFCC APPR. NO. -	
	ENGG. APPR. NO. -	
	DRG. NO. - 301-2/AL/A/1200	
	SHEET NO. : 1 OF 1	STATUS A
DATE: 27.08.2024		

TR.

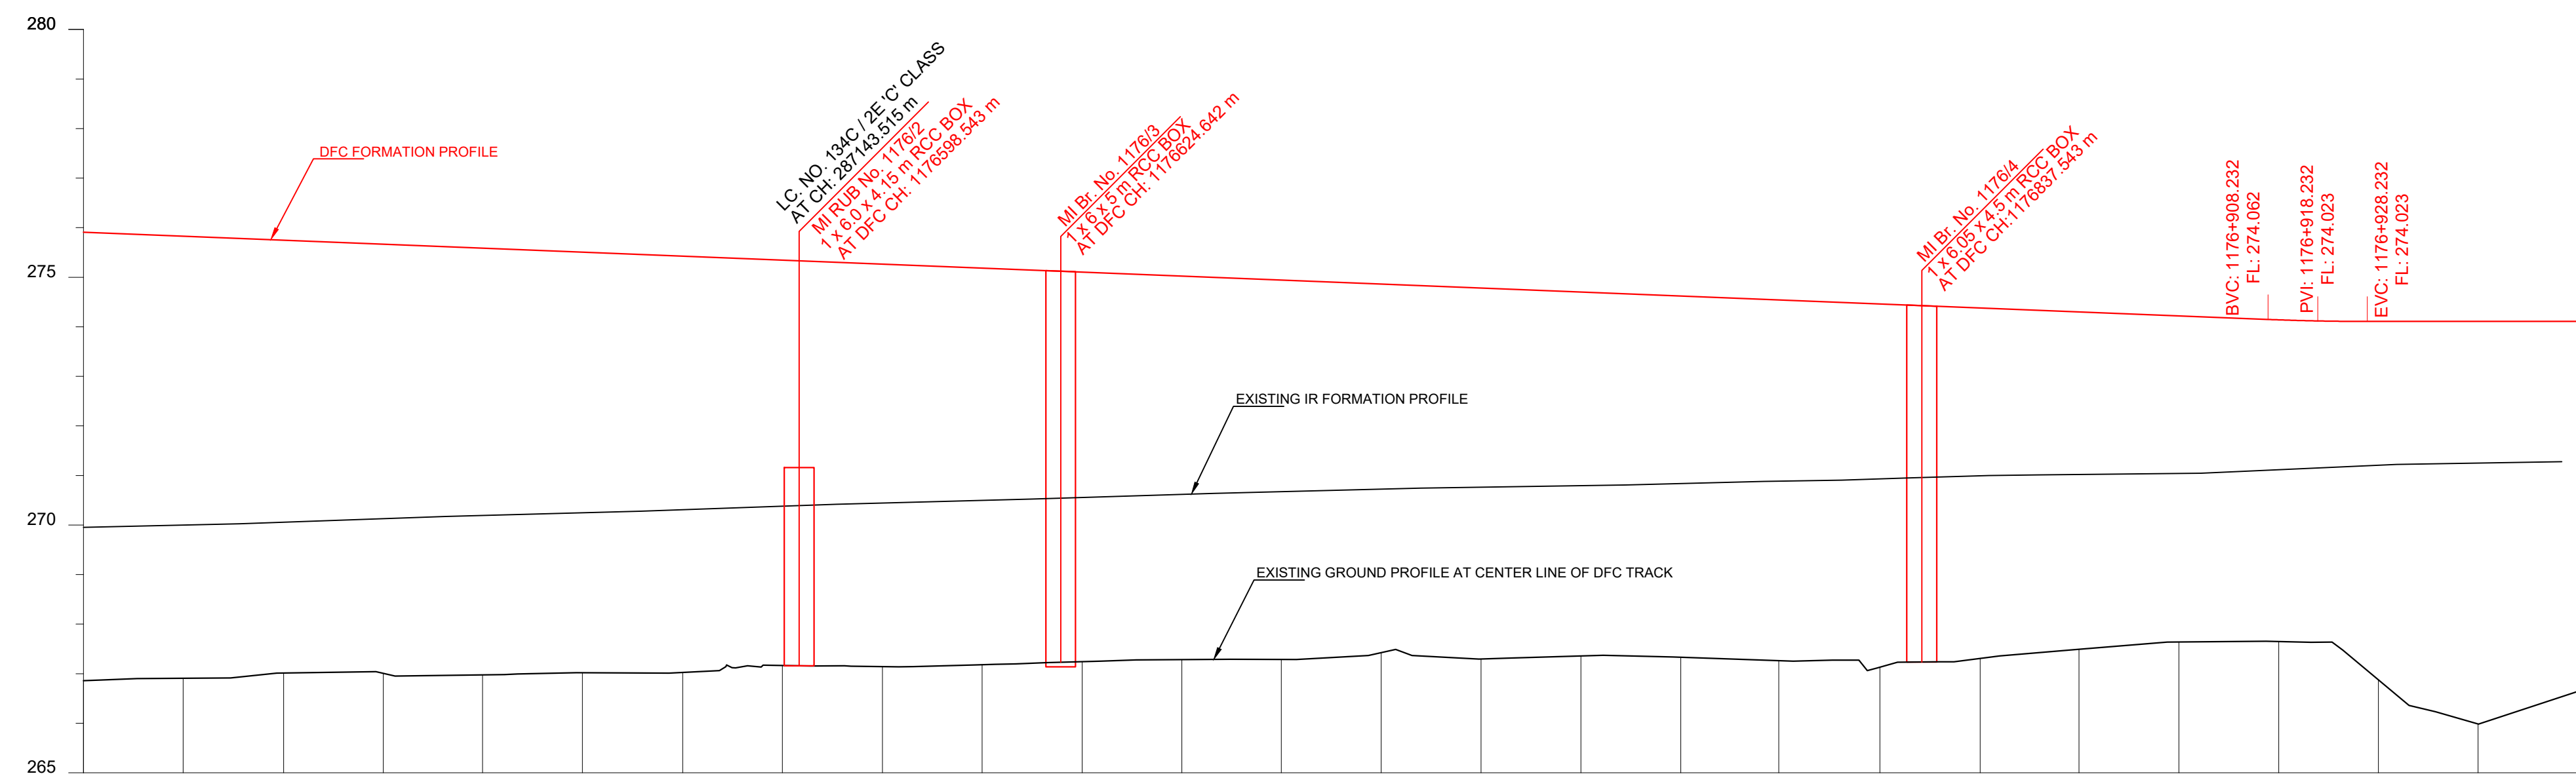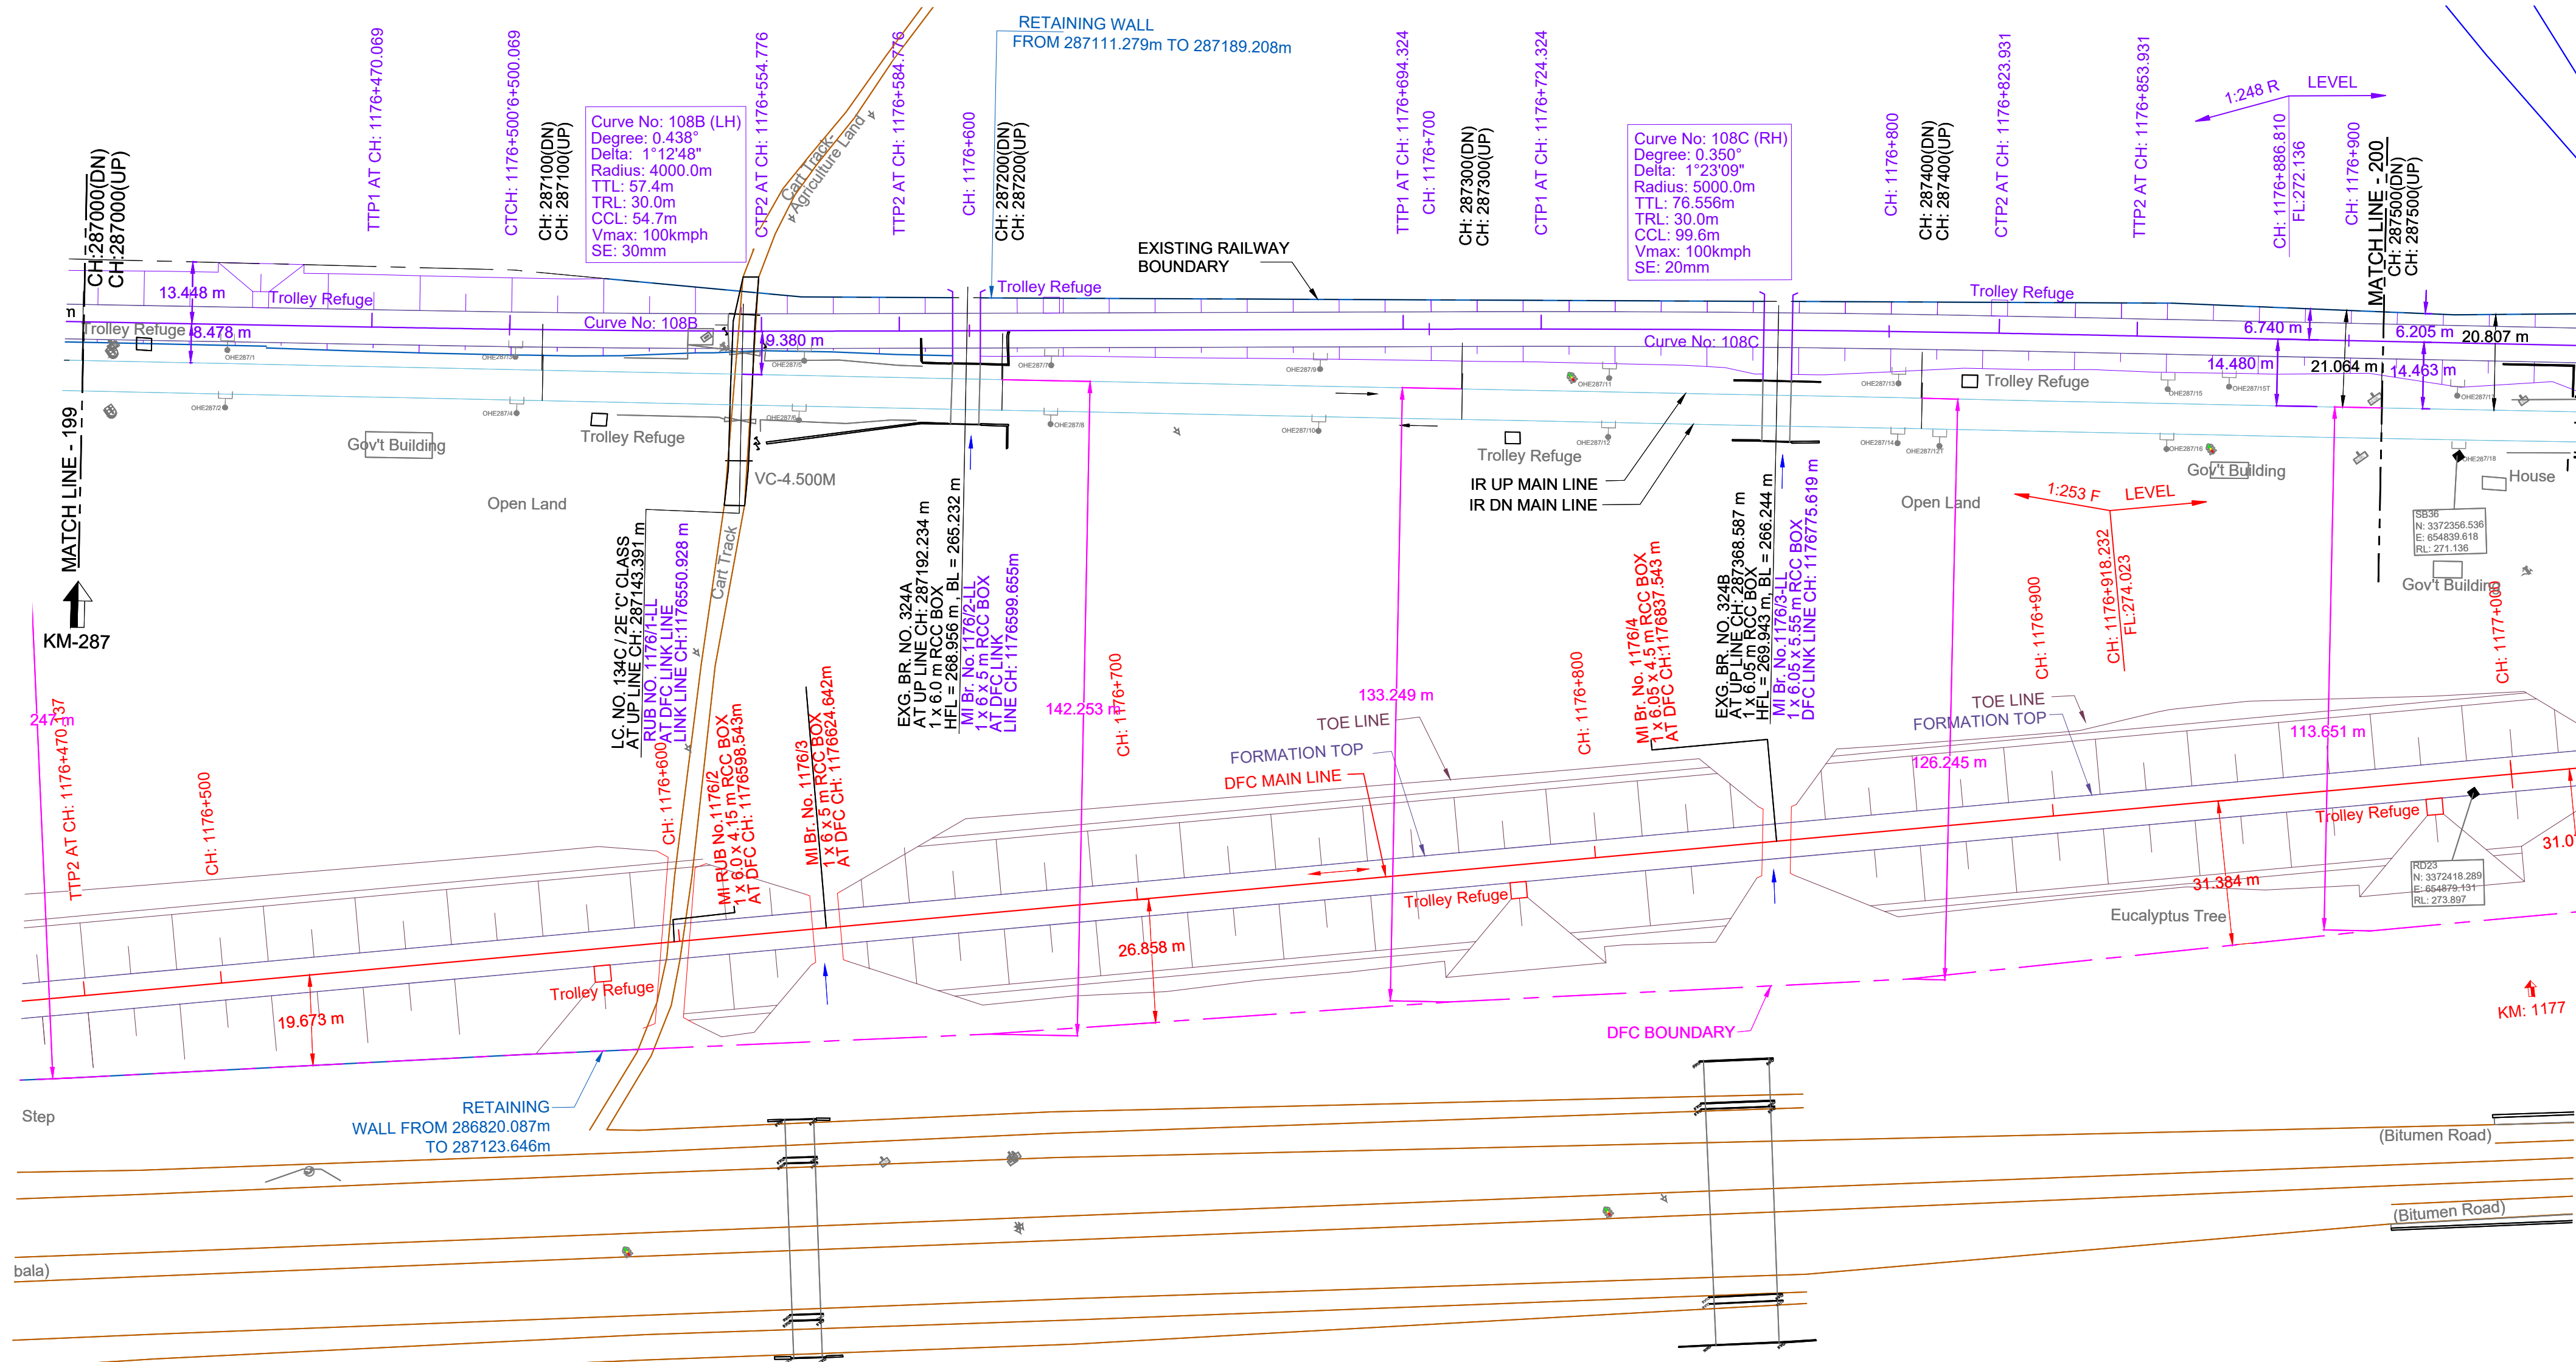

HORIZONTAL ALIGNMENT	TL= 80m															L= 784.179m															L=20.0 m R=500.0 m					L=278.240 m LEVEL				
VERTICAL ALIGNMENT	L=729.210 m 1 IN 253.454 F																																							
TRACK DISTANCE FROM EXISTING NEAREST IR DN MAIN LINE TO DFC MAIN LINE	-43.025 -131.720																																							
HEIGHT OF BANKING(+) / DEPTH OF CUTTING(-) (PFL-GL)	-8.924 -129.455																																							
EXG GROUND LEVEL AT CENTER LINE OF DFC TRACK (GL)	266.854 266.762																																							
EXG GROUND LEVEL AT TOE LOCATION OF DFC TRACK	266.854 266.801																																							
DIFFERENCE BETWEEN DFC FORMATION LEVEL AND EXG FORMATION LEVEL (PFL-EFL)	5.943 5.943																																							
DFC FORMATION LEVEL (PFL)	266.861 266.807																																							
EXG FORMATION LEVEL OF EXG IR DN MAIN LINE (EFL)	266.861 266.807																																							
DIFFERENCE BETWEEN DFC RAIL LEVEL AND EXG. RAIL LEVEL (PRL-ERL)	5.884 5.884																																							
DFC RAIL LEVEL (PRL)	276.517 276.517																																							
EXG RAIL LEVEL OF NEAREST IR DN MAIN LINE (ERL)	276.517 276.517																																							
EQUIVALENT CHAINAGE ON DFC TRACK	287000.0 287000.0																																							
EXISTING IR CHAINAGE	287000.0 287000.0																																							

L - SECTION