


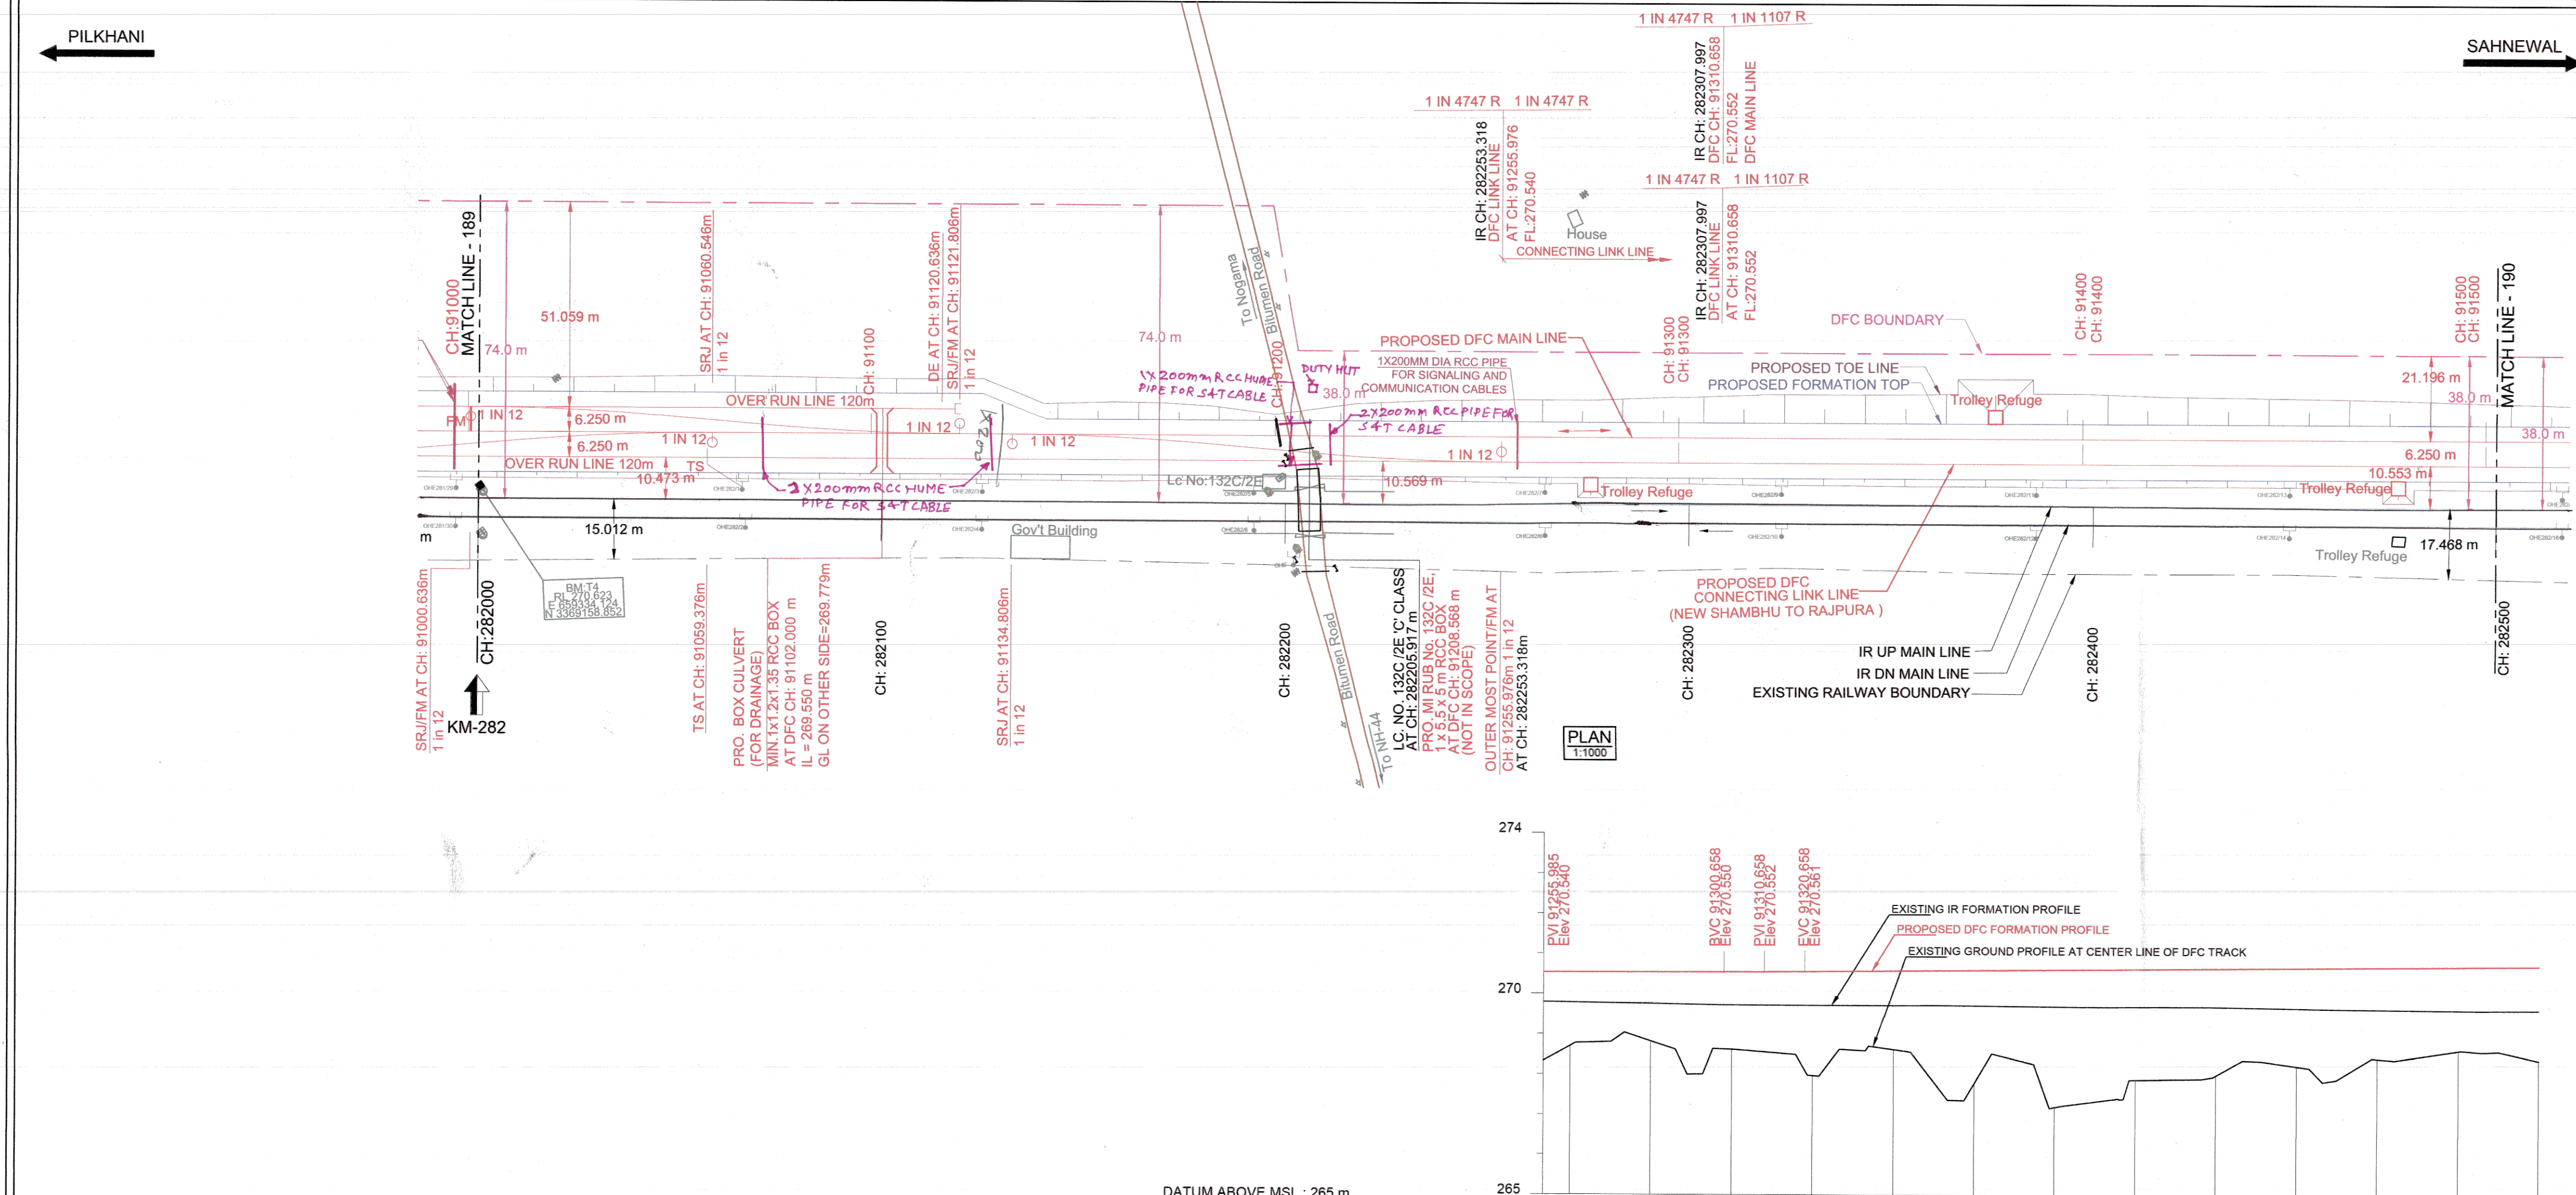

 
- WITH NEW GTS VALUE**
- NOTE:-**
1. PROPOSED WORKS ARE SHOWN IN RED.
 2. IR PROPOSALS ARE SHOWN IN VIOLET.
 3. ALL DIMENSIONS ARE SHOWN IN METRES.
 4. THIS DRAWING IS PREPARED BASED ON LATEST SURVEY DATA HELD ON AUG-2016. GTS BENCH MARK OF 261.850 m CONSIDERED ON TOP OF CANAL BRIDGE ABUTMENT AT DORAHA VILLAGE ALONG THE NH1.
 5. MINIMUM OF 6m TRACK CENTER MAINTAINED BETWEEN ADJACENT TRACK TO EXISTING IR TRACK IN STATION YARD PORTION.
 6. DFC CHAINAGE OF 0.000 m IS WITH REFERENCE TO THE IR KM POST OF 192.000.
 7. PUBLIC UTILITIES, HT, LT LINES AND OFC CABLES, WATER LINES etc., INTERFERING DFC LINES SHALL BE RELOCATED.
 8. PLAN OF LONGITUDINAL AS WELL AS CROSS DRAINAGE WORKS BETWEEN IR & DFC BANKS SHALL BE SUBMITTED SEPARATELY FOR APPROVAL.
 9. ALL CANAL BRIDGES REQUIRED TO BE APPROVED BY CANAL AUTHORITIES.
 10. NECESSARY EMBANKMENT/SLOPE PROTECTION WORK DESIGN & DRAWING WILL BE SUBMITTED SEPARATELY.
 11. UNDERTAKING OF NO EXTRA CLAIM FOR DESIGN & EXECUTION OF WORK DUE TO CHANGE IN TURNOUT LENGTH AND DRAINAGE DESIGN HAS BEEN GIVEN BY GIL-TPL JV/EDFC/301/2017-18/DESIGN/0424 DATED 26.07.2017.
 12. DURING CENTER LINE STAKING IF GROUND LEVEL SHOWN, FOUND TO BE MAJOR VARIATION, DESIGNER TO BE INFORMED.
 13. THE LAND BOUNDARY SHOWN IN THE ALIGNMENT DRAWING IS TENTATIVE ONLY. FOR ACTUAL ACQUISITION REFER LAND PLANS OF THAT CORRESPONDING SECTION.
 14. FOR DETAILS OF DFC MAIN LINE FROM NEW SHAMBHU TO RAJPURA REFER SEPARATE DRAWINGS.
 15. RUB 1 x 5.5 x 5 m RCC BOX SHOWN AS PER IR APPROVED GAD NO.
 16. LOCATIONS PRONE TO FLOODING IN THE SECTION. NO
 17. WATER LOGGED AREA/ MARSHY LAND WHERE GROUND IMPROVEMENT REQUIRED: NO
 18. LOCATION OF TROLLEY REFUGE SHOWN ARE INDICATIVE. WILL BE FINALISED SEPARATELY.

- REFERENCE DRAWINGS :-**
1. FOR KEY PLAN REFER DRAWING NO. 301-2/AL/0001.
 2. FOR LEGEND AND ABBREVIATIONS REFER DRAWING NO. 301-2/AL/1000.

THIS CONSTRUCTION DRAWING OF PLAN & PROFILE IS PREPARED BASED ON PRELIMINARY DRAWING APPROVAL BY DFCCIL COMMUNICATED UNDER LETTER NO. EDFC 3/PMC/CON/11/2017/0715 DATED : 20.11.2017

DATUM ABOVE MSL : 265 m											
HORIZONTAL ALIGNMENT			L = 634.819m								
VERTICAL ALIGNMENT			L=44.7 m 1 IN:1.4747 R								
TRACK DISTANCE FROM EXISTING NEAREST IR UP MAIN LINE TO PROPOSED DFC LINKED LINE			L=20.0 m R=28882 m								
HEIGHT OF BANKING(+) / DEPTH OF CUTTING(-) (PFL-GL)			L=536.8 m 1 IN:1.1107 R								
EXG GROUND LEVEL AT CENTER LINE OF PRO. DFC TRACK (GL)			10.564	10.563	10.566	10.570	10.572	10.597	10.597	10.597	10.564
EXG GROUND LEVEL AT TOE LOCATION OF PRO. DFC TRACK			10.563	10.563	10.566	10.570	10.572	10.597	10.597	10.597	10.564
DIFFERENCE BETWEEN PRO FORMATION LEVEL AND EXG. FORMATION LEVEL (PFL-EFL)			0.741	0.752	0.788	0.822	0.841	0.858	0.882	0.938	1.094
PRO. DFC FORMATION LEVEL (PFL)			270.540	270.542	270.546	270.550	270.563	270.581	270.599	270.635	270.725
EXG. FORMATION LEVEL OF EXG IR UP MAIN LINE (EFL)			269.799	269.790	269.758	269.728	269.722	269.723	269.717	269.699	269.631
DIFFERENCE BETWEEN PRO. DFC RAIL LEVEL AND EXG. RAIL LEVEL (PRL - ERL)			0.795	0.806	0.842	0.878	0.895	0.912	0.936	1.008	1.148
PRO. DFC RAIL LEVEL (PRL)			271.282	271.284	271.288	271.292	271.305	271.323	271.341	271.395	271.467
EXG. RAIL LEVEL OF NEAREST IR UP MAIN LINE (ERL)			270.487	270.478	270.446	270.416	270.410	270.411	270.405	270.387	270.319
EQUIVALENT CHAINAGE ON PROPOSED DFC TRACK			91266.0	91262.7	91262.7	91302.7	91322.7	91342.7	91362.6	91422.7	91502.7
EXISTING IR CHAINAGE			282253.3	282260.0	282280.0	282300.0	282320.0	282340.0	282360.0	282380.0	282400.0

L - SECTION (CONNECTING LINK LINE)

				SCALE		DESIGN CONSULTANT		CONTRACTOR		ENGINEER		CONTRACTOR		ENGINEER		TITLE		DFCC APPR. NO. -														
2	26.03.18	UPDATED AS PER PMC COMMENTS		FOR APPROVAL																				DFCC APPR. NO. -								
1	16.03.18	COMPLIANCE TO PMC COMMENTS, Dt. 30.12.17		FOR APPROVAL																				CONTRACTOR			ENGINEER			ENG. APPR. NO. -		
0	13.12.17	INITIAL SUBMISSION		FOR APPROVAL																				CONTRACTOR			ENGINEER			DRG. NO. - 301-2/AL/1190A		
REV.	DATE	REVISION DETAILS		PURPOSE OF ISSUE		SHEET SIZE : A1		GIL - TPL JV		DB Engineering & Consulting GmbH		B. RAMAKRISHNA DESIGNED		H.B. PANDA CHECKED		DINESH PANDAY APPROVED		BABULAL SAHU REVIEWED		H.D. VIDJAK NONO		FROM IR KM: 282.200 TO 282.500 FROM DFC KM: 91.263 TO 91.503 (CONNECTING LINK LINE)		REV. No. 2 STATUS D								
																								DATE : 26.03.2018								