


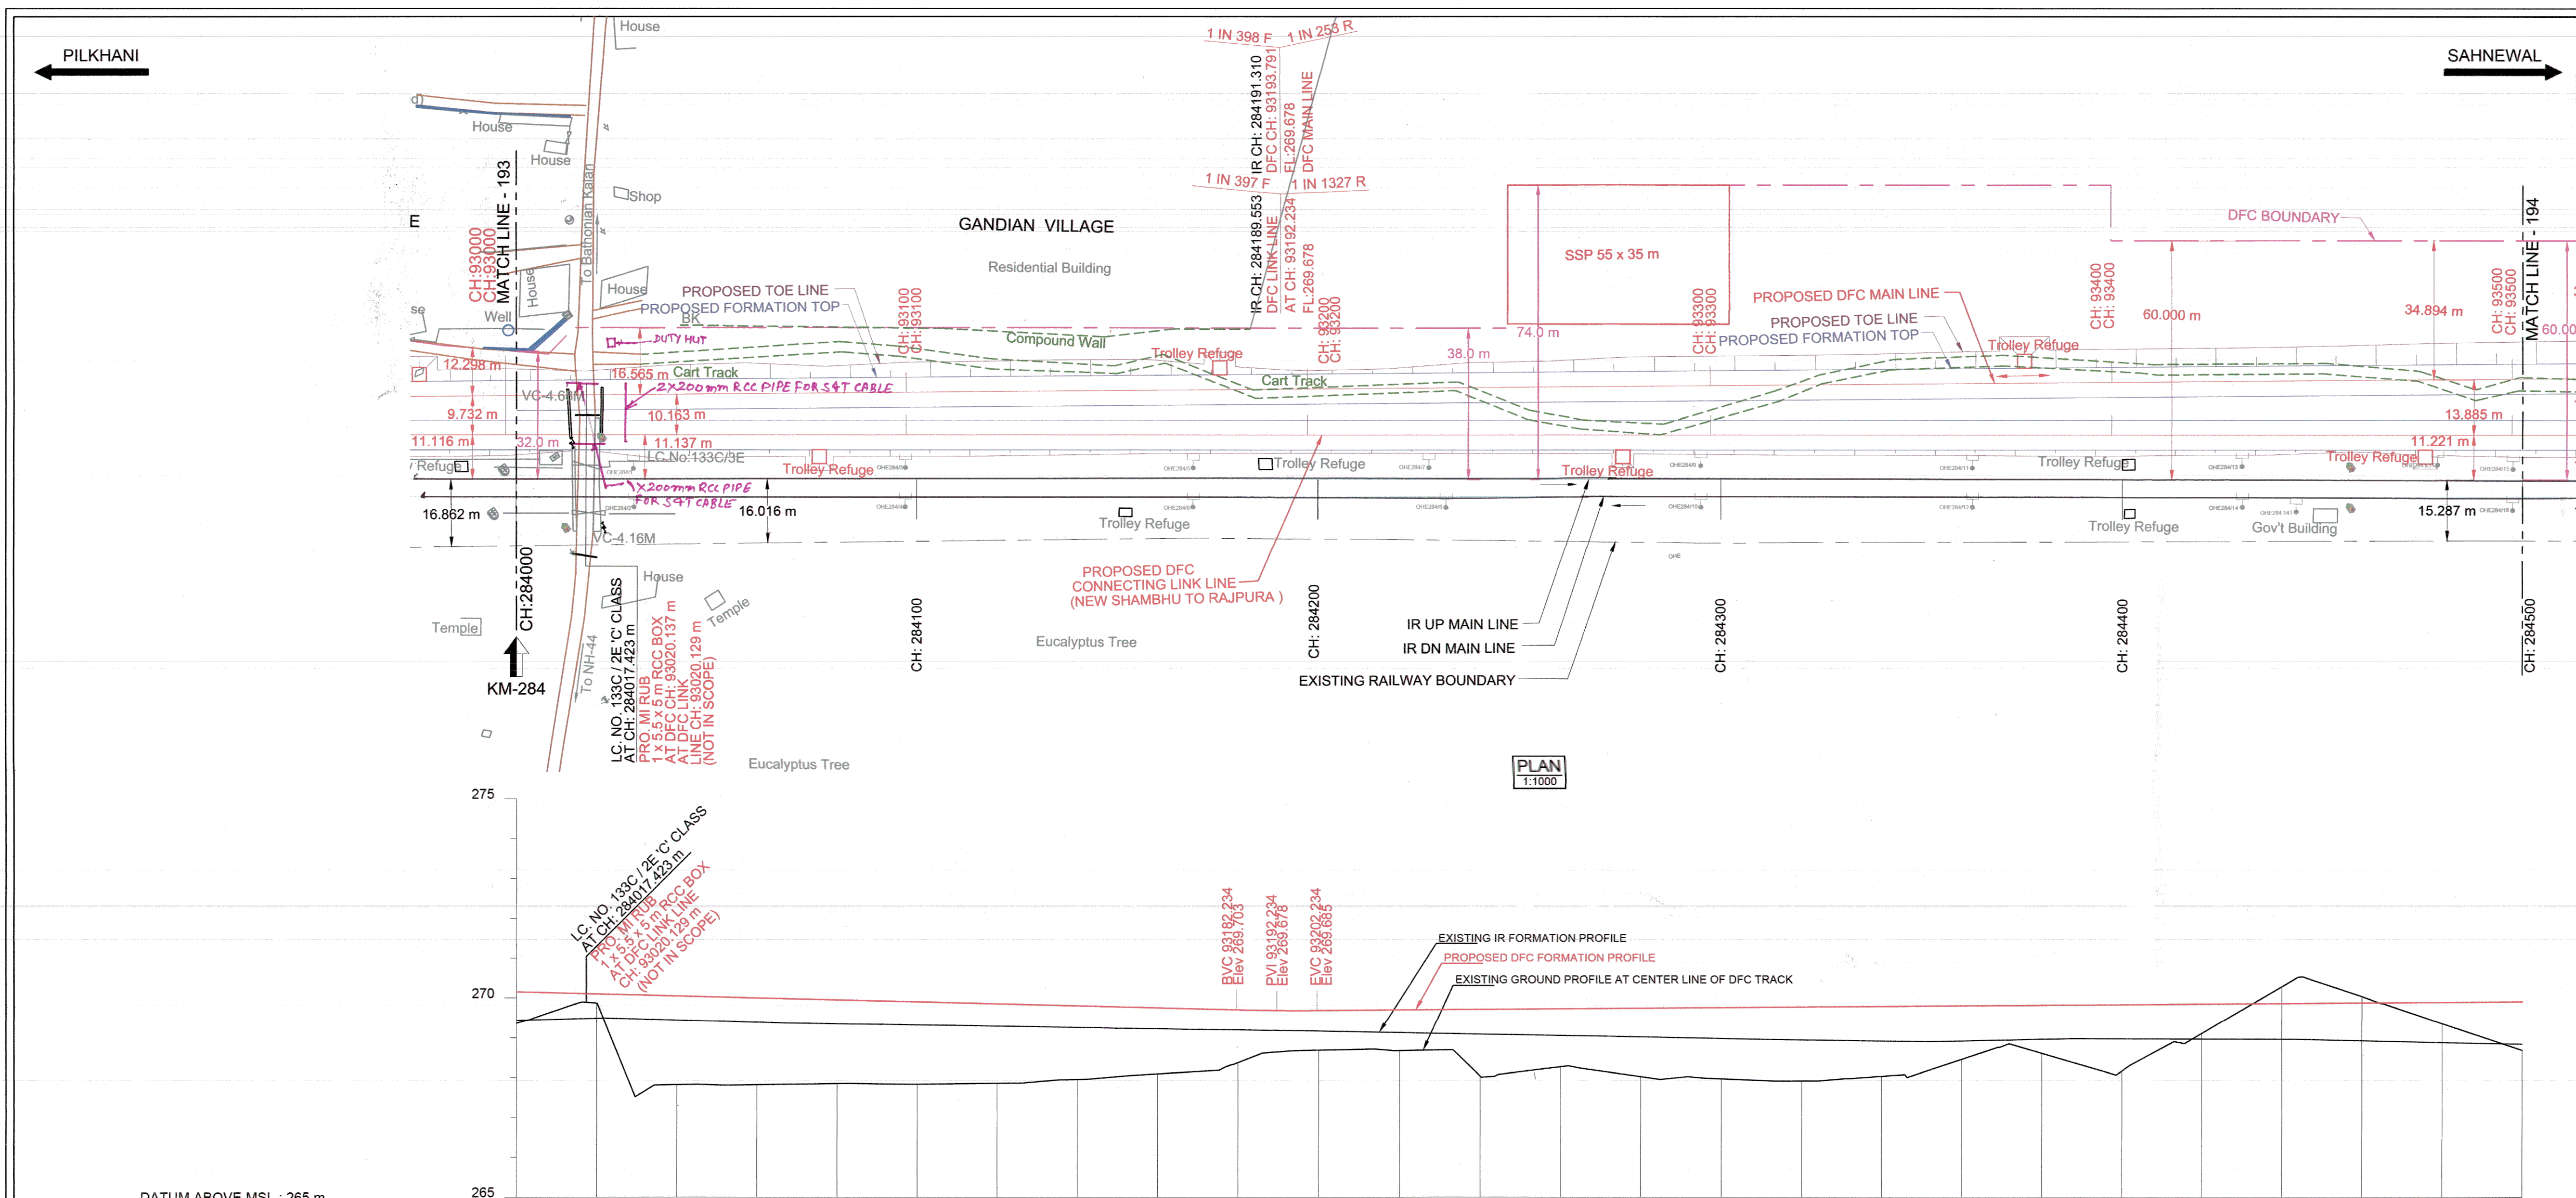

HORIZONTAL ALIGNMENT	L = 1540.038m																									
VERTICAL ALIGNMENT	L=526.6 m 1 IN 397 F L=20.0 m R=6111 m L=1490.5 m 1 IN 1327 R																									
TRACK DISTANCE FROM EXISTING NEAREST IR UP MAIN LINE TO PROPOSED DFC LINKED LINE	11.103																									
HEIGHT OF BANKING(+) / DEPTH OF CUTTING(-) (PFL-GL)	+0.788																									
EXG GROUND LEVEL AT CENTER LINE OF PRO. DFC TRACK (GL)	269.367																									
EXG GROUND LEVEL AT TOE LOCATION OF PRO. DFC TRACK	269.385																									
DIFFERENCE BETWEEN PRO FORMATION LEVEL AND EXG.FORMATION LEVEL.(PFL-EFL)	0.716																									
PRO. DFC FORMATION LEVEL (PFL)	270.155																									
EXG. FORMATION LEVEL OF EXG IR UP MAIN LINE (EFL)	269.439																									
DIFFERENCE BETWEEN PRO. DFC RAIL LEVEL AND EXG. RAIL LEVEL (PRL - ERL)	0.770																									
PRO. DFC RAIL LEVEL (PRL)	270.897																									
EXG.RAIL LEVEL OF NEAREST IR UP MAIN LINE(ERL)	270.127																									
EQUIVALENT CHAINAGE ON PROPOSED DFC TRACK	93002.7																									
EXISTING IR CHAINAGE	284000.0																									
		284020.0																								
			284040.0																							
				284060.0																						
226.03.18UPDATED AS PER PMC COMMENTSFOR APPROVAL

116.03.18COMPLIANCE TO PMC COMMENTS, Dt. 30.12.17FOR APPROVAL

013.12.17INITIAL SUBMISSIONFOR APPROVAL

SCALE
HOR - 1:1000
VER - 1:100
SHEET SIZE : A1

DESIGN CONSULTANT
aarvee associates
architects engineers & consultants pvt.ltd.

CONTRACTOR
GIL - TPL JV

ENGINEER
DB Engineering & Consulting GmbH

CONTRACTOR
B.RAMAKRISHNA
DESIGNED

ENGINEER
H.B.PANDA
CHECKED

ENGINEER
DINESH PANDAY
APPROVED

ENGINEER
BABULAL SAHU
REVIEWED

ENGINEER
H.D.VIDJAK
NONO

TITLE
PLAN & PROFILE
FROM IR KM: 284.000 TO 284.500
FROM DFC KM: 93.003 TO 93.503
(CONNECTING LINK LINE)

DFCC APPR. NO. -
ENGG. APPR. NO. -
DRG. NO. - 301-2/AL/1194A
SHEET NO. : 194A OF 346
DATE : 26.03.2018

REV. No. 2
STATUS D

WITH NEW GTS VALUE

SHEET NO. :194A OF 346

NOTE:
1. PROPOSED WORKS ARE SHOWN IN RED.
2. IR PROPOSALS ARE SHOWN IN VIOLET.
3. ALL DIMENSIONS ARE SHOWN IN METRES.
4. THIS DRAWING IS PREPARED BASED ON LATEST SURVEY DATA HELD ON AUG-2016. GTS BENCH MARK OF 261.850 m CONSIDERED ON TOP OF CANAL BRIDGE ABUTMENT AT DORAH VILLAGE ALONG THE NH-1.
5. MINIMUM OF 8m TRACK CENTER MAINTAINED BETWEEN ADJACENT TRACK TO EXISTING IR TRACK IN STATION YARD PORTION.
6. DFC CHAINAGE OF 0.000 m IS WITH REFERENCE TO THE IR KM POST OF 182.000.
7. PUBLIC UTILITIES, HT, LT LINES AND DFC CABLES, WATER LINES etc., INTERFERING DFC LINES SHALL BE RELOCATED.
8. PLAN OF LONGITUDINAL AS WELL AS CROSS DRAINAGE WORKS BETWEEN IR & DFC BANKS SHALL BE SUBMITTED SEPARATELY FOR APPROVAL.
9. ALL CANAL BRIDGES REQUIRED TO BE APPROVED BY CANAL AUTHORITIES.
10. NECESSARY EMBANKMENT/SLOPE PROTECTION WORK DESIGN & DRAWING WILL BE SUBMITTED SEPARATELY.
11. UNDERTAKING OF NO EXTRA CLAIM FOR DESIGN & EXECUTION OF WORK DUE TO CHANGE IN TURNOUT LENGTH AND DRAINAGE DESIGN HAS BEEN GIVEN BY GIL-TPL
J/EDFC/301/2017-18/DESIGN/0424 DATED 26.07.2017
12. DURING CENTER LINE STAKING IF GROUND LEVEL SHOWN, FOUND TO BE MAJOR VARIATION, DESIGNER TO BE INFORMED.
13. THE LAND BOUNDARY SHOWN IN THE ALIGNMENT DRAWING IS TENTATIVE ONLY. FOR ACTUAL ACQUISITION REFER LAND PLANS OF THAT CORRESPONDING SECTION.
14. FOR DETAILS OF DFC MAIN LINE FROM NEW SHAMBHU TO RAJPURA REFER SEPARATE DRAWINGS.
15. LOCATIONS PRONE TO FLOODING IN THE SECTION: NO
16. WATER LOGGED AREA/MARSHY LAND WHERE GROUND IMPROVEMENT REQUIRED: NO
17. LOCATION OF TROLLEY REFUGE SHOWN ARE INDICATIVE, WILL BE FINALISED SEPARATELY.

REFERENCE DRAWINGS:-
1. FOR KEY PLAN REFER DRAWING NO. 301-2/AL/0001.
2. FOR LEGEND AND ABBREVIATIONS REFER DRAWING NO. 301-2/AL/1000.

THIS CONSTRUCTION DRAWING OF PLAN & PROFILE IS PREPARED BASED ON PRELIMINARY DRAWING APPROVAL BY DFCCIL COMMUNICATED UNDER LETTER NO. EDFC 3/PMC/CON/11/2017/0715 DATED : 20.11.2017

TRACK STRUCTURE

RAIL SECTION: 60Kg/m (UIC 60Kg/m) DFC LINE: 60Kg/m (UIC 60Kg/m) IR MAIN LINE: 52Kg/m	Difference between FL and RL	
	IR Line	DFC
	172mm	172mm
	6mm	10mm
RUBBER PAD	210mm	210mm
SLEEPER DEPTH	300mm	350mm
BALLAST CUSHION	688mm	742mm
Total Depth (FL TO RL)		

PROJECT OFFICE / DFCCIL

SURINDER PAL
CPM

PARDEEP PURI
DY. CPM / ENGG. / LDH

P.KATHPALIA
ACPM / ELECT. / UMB

CHANKY GARG
PM / ELECT. / UMB

ABHINAV SINGH
PM / S&T

SURENDRA SINGH
DPM / ENGG. / UMB

S.P.SHARMA
DPM / ELECT. / UMB

DEBASISH NAYAK
APM / S&T-II / UMB

OWNER
DEDICATED FREIGHT CORRIDOR CORPORATION OF INDIA LTD.
(A GOVERNMENT OF INDIA ENTERPRISE)
PROJECT OFFICE/AMBALA UNIT: OLD RAILWAY COLONY (NEAR ANAND MARKET), AMBALA CANTT-133001.
CORPORATE IDENTITY NO. : U60232DL200600155068

PROJECT
EASTERN DEDICATED FREIGHT CORRIDOR
SAHNEWAL TO PILKHANI
CONTRACT PACKAGE - 301

TITLE
PLAN & PROFILE
FROM IR KM: 284.000 TO 284.500
FROM DFC KM: 93.003 TO 93.503
(CONNECTING LINK LINE)

DFCC APPR. NO. -
ENGG. APPR. NO. -
DRG. NO. - 301-2/AL/1194A
SHEET NO. : 194A OF 346
DATE : 26.03.2018

REV. No. 2
STATUS D