


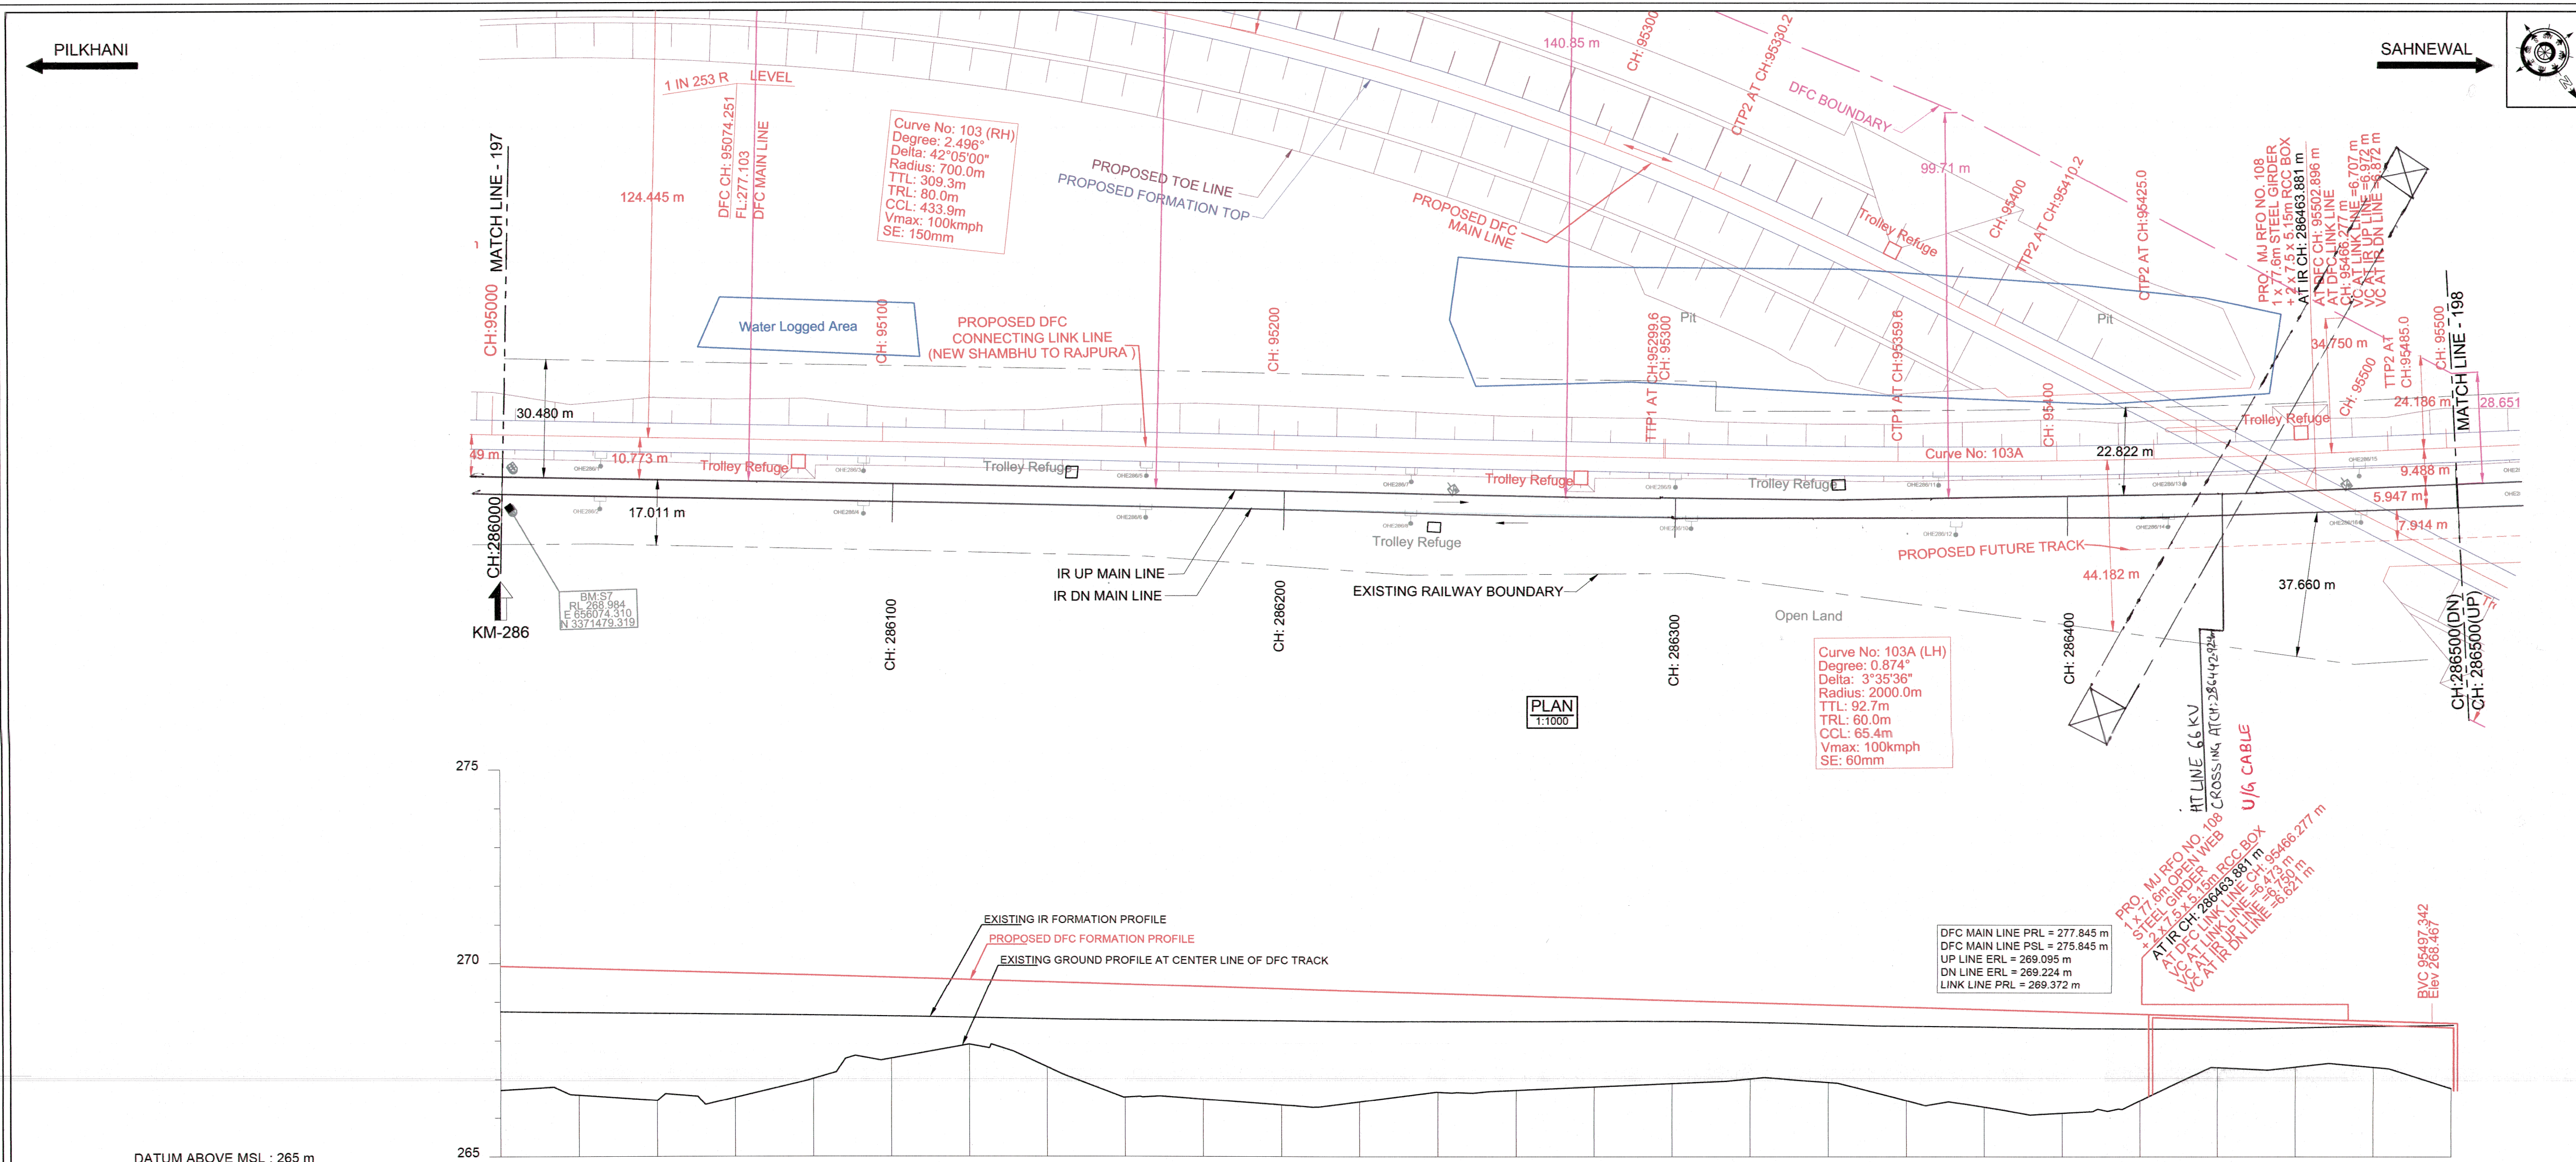

- WITH NEW GTS VALUE**
- NOTE:-**
1. PROPOSED WORKS ARE SHOWN IN RED.
 2. IR PROPOSALS ARE SHOWN IN VIOLET.
 3. ALL DIMENSIONS ARE SHOWN IN METRES.
 4. THIS DRAWING IS PREPARED BASED ON LATEST SURVEY DATA HELD ON AUG-2016. GTS BENCH MARK OF 261.850 m CONSIDERED ON TOP OF CANAL BRIDGE ABUTMENT AT DORAH VILLAGE ALONG THE NH-1.
 5. MINIMUM OF 6m TRACK CENTER MAINTAINED BETWEEN ADJACENT TRACK TO EXISTING IR TRACK IN STATION YARD PORTION.
 6. DFC CHANGE OF 0.000 m IS WITH REFERENCE TO THE IR KM POST OF 192.000
 7. PUBLIC UTILITIES, HT, LT LINES AND OFC CABLES, WATER LINES etc., INTERFERING DFC LINES SHALL BE RELOCATED.
 8. PLAN OF LONGITUDINAL AS WELL AS CROSS DRAINAGE WORKS BETWEEN IR & DFC BANKS SHALL BE SUBMITTED SEPARATELY FOR APPROVAL.
 9. ALL CANAL BRIDGES REQUIRED TO BE APPROVED BY CANAL AUTHORITIES.
 10. NECESSARY EMBANKMENT/SLOPE PROTECTION WORK DESIGN & DRAWING WILL BE SUBMITTED SEPARATELY.
 11. UNDERTAKING OF NO EXTRA CLAIM FOR DESIGN & EXECUTION OF WORK DUE TO CHANGE IN TURNOUT LENGTH AND DRAINAGE DESIGN HAS BEEN GIVEN BY GIL-TPL JV/EDFC-301/2017-18 (DESIGN/424) DATED-26.07.2017.
 12. DURING CENTER LINE STAKING IF GROUND LEVEL SHOWN, FOUND TO BE MAJOR VARIATION, DESIGNER TO BE INFORMED.
 13. THE LAND BOUNDARY SHOWN IN THE ALIGNMENT DRAWING IS TENTATIVE ONLY. FOR ACTUAL ACQUISITION REFER LAND PLANS OF THAT CORRESPONDING SECTION.
 14. FOR DETAILS OF DFC MAIN LINE FROM NEW SHAMBU TO RAJPURA REFER SEPARATE DRAWINGS.
 15. LOCATIONS PRONE TO FLOODING IN THE SECTION. NO
 16. WATER LOGGED AREA MARSHY LAND WHERE GROUND IMPROVEMENT REQUIRED. NO
 17. LOCATION OF TROLLEY REFUGE SHOWN ARE INDICATIVE. WILL BE FINALISED SEPARATELY.

- REFERENCE DRAWINGS:-**
1. FOR KEY PLAN REFER DRAWING NO. 301-2/AL/0001.
 2. FOR LEGEND AND ABBREVIATIONS REFER DRAWING NO. 301-2/AL/1000.

THIS CONSTRUCTION DRAWING OF PLAN & PROFILE IS PREPARED BASED ON PRELIMINARY DRAWING APPROVAL BY DFCCIL COMMUNICATED UNDER LETTER NO. EDFC 3/PMC/CON/11/2017/0715 DATED : 20.11.2017

HORIZONTAL ALIGNMENT		L = 719.667m																				TL = 60m		R = 2000m		TL = 60m		L = 156.546m	
VERTICAL ALIGNMENT		L=784.6 m																				1 IN 538 F		L=27.9 m		R=4000 m			
TRACK DISTANCE FROM EXISTING NEAREST IR UP MAIN LINE TO PROPOSED DFC LINKED LINE		10.755	10.755	HEIGHT OF BANKING(+) / DEPTH OF CUTTING(-) (PFL-GL)		+3.210	+3.210	EXG GROUND LEVEL AT CENTER LINE OF PRO. DFC TRACK (GL)		266.719	266.719	EXG GROUND LEVEL AT TOE LOCATION OF PRO. DFC TRACK		266.424	266.424	DIFFERENCE BETWEEN PRO FORMATION LEVEL AND EXG.FORMATION LEVEL (PFL-EFL)		1.182	1.182	PRO. DFC FORMATION LEVEL (PFL)		269.929	269.929	EXG. FORMATION LEVEL OF EXG IR UP MAIN LINE (EFL)		268.747	268.747	DIFFERENCE BETWEEN PRO. DFC RAIL LEVEL AND EXG. RAIL LEVEL (PRL - ERL)		1.238	1.238	PRO. DFC RAIL LEVEL (PRL)		270.671	270.671	EXG.RAIL LEVEL OF NEAREST IR UP MAIN LINE(ERL)		269.435	269.435	EQUIVALENT CHAINAGE ON PROPOSED DFC TRACK		95002.9	95002.9	EXISTING IR CHAINAGE		286000.0	286000.0	
REV.	DATE	REVISION DETAILS	PURPOSE OF ISSUE
2	26.03.18	UPDATED AS PER PMC COMMENTS	FOR APPROVAL
1	16.03.18	COMPLIANCE TO PMC COMMENTS, Dt. 30.12.17	FOR APPROVAL
0	13.12.17	INITIAL SUBMISSION	FOR APPROVAL

SCALE

HOR - 1:1000

VER - 1:100

SHEET SIZE : A1

DESIGN CONSULTANT

CONTRACTOR

ENGINEER

CONTRACTOR

ENGINEER

26.03.18

16.03.18

13.12.17

OWNER

DEDICATED FREIGHT CORRIDOR CORPORATION OF INDIA LTD.

(A GOVERNMENT OF INDIA ENTERPRISE)

PROJECT OFFICE/AMBALA UNIT: OLD RAILWAY COLONY (NEAR ANAND MARKET), AMBALA CANTT-133001.

CORPORATE IDENTITY NO. : U60232DL2006050155008

PROJECT

EASTERN DEDICATED FREIGHT CORRIDOR

SAHNEWAL TO PILKHANI

CONTRACT PACKAGE - 301

TITLE

PLAN & PROFILE

FROM IR KM: 286.000 TO 286.500

FROM DFC KM: 95.003 TO 95.002

(CONNECTING LINK LINE)

DFCC APPR. NO. -

ENG. APPR. NO. -

DRG. NO. - 301-2/AL/1198A

SHEET NO. : 198A OF 346

DATE : 26.03.2018

REV. No. : 2

STATUS : D