


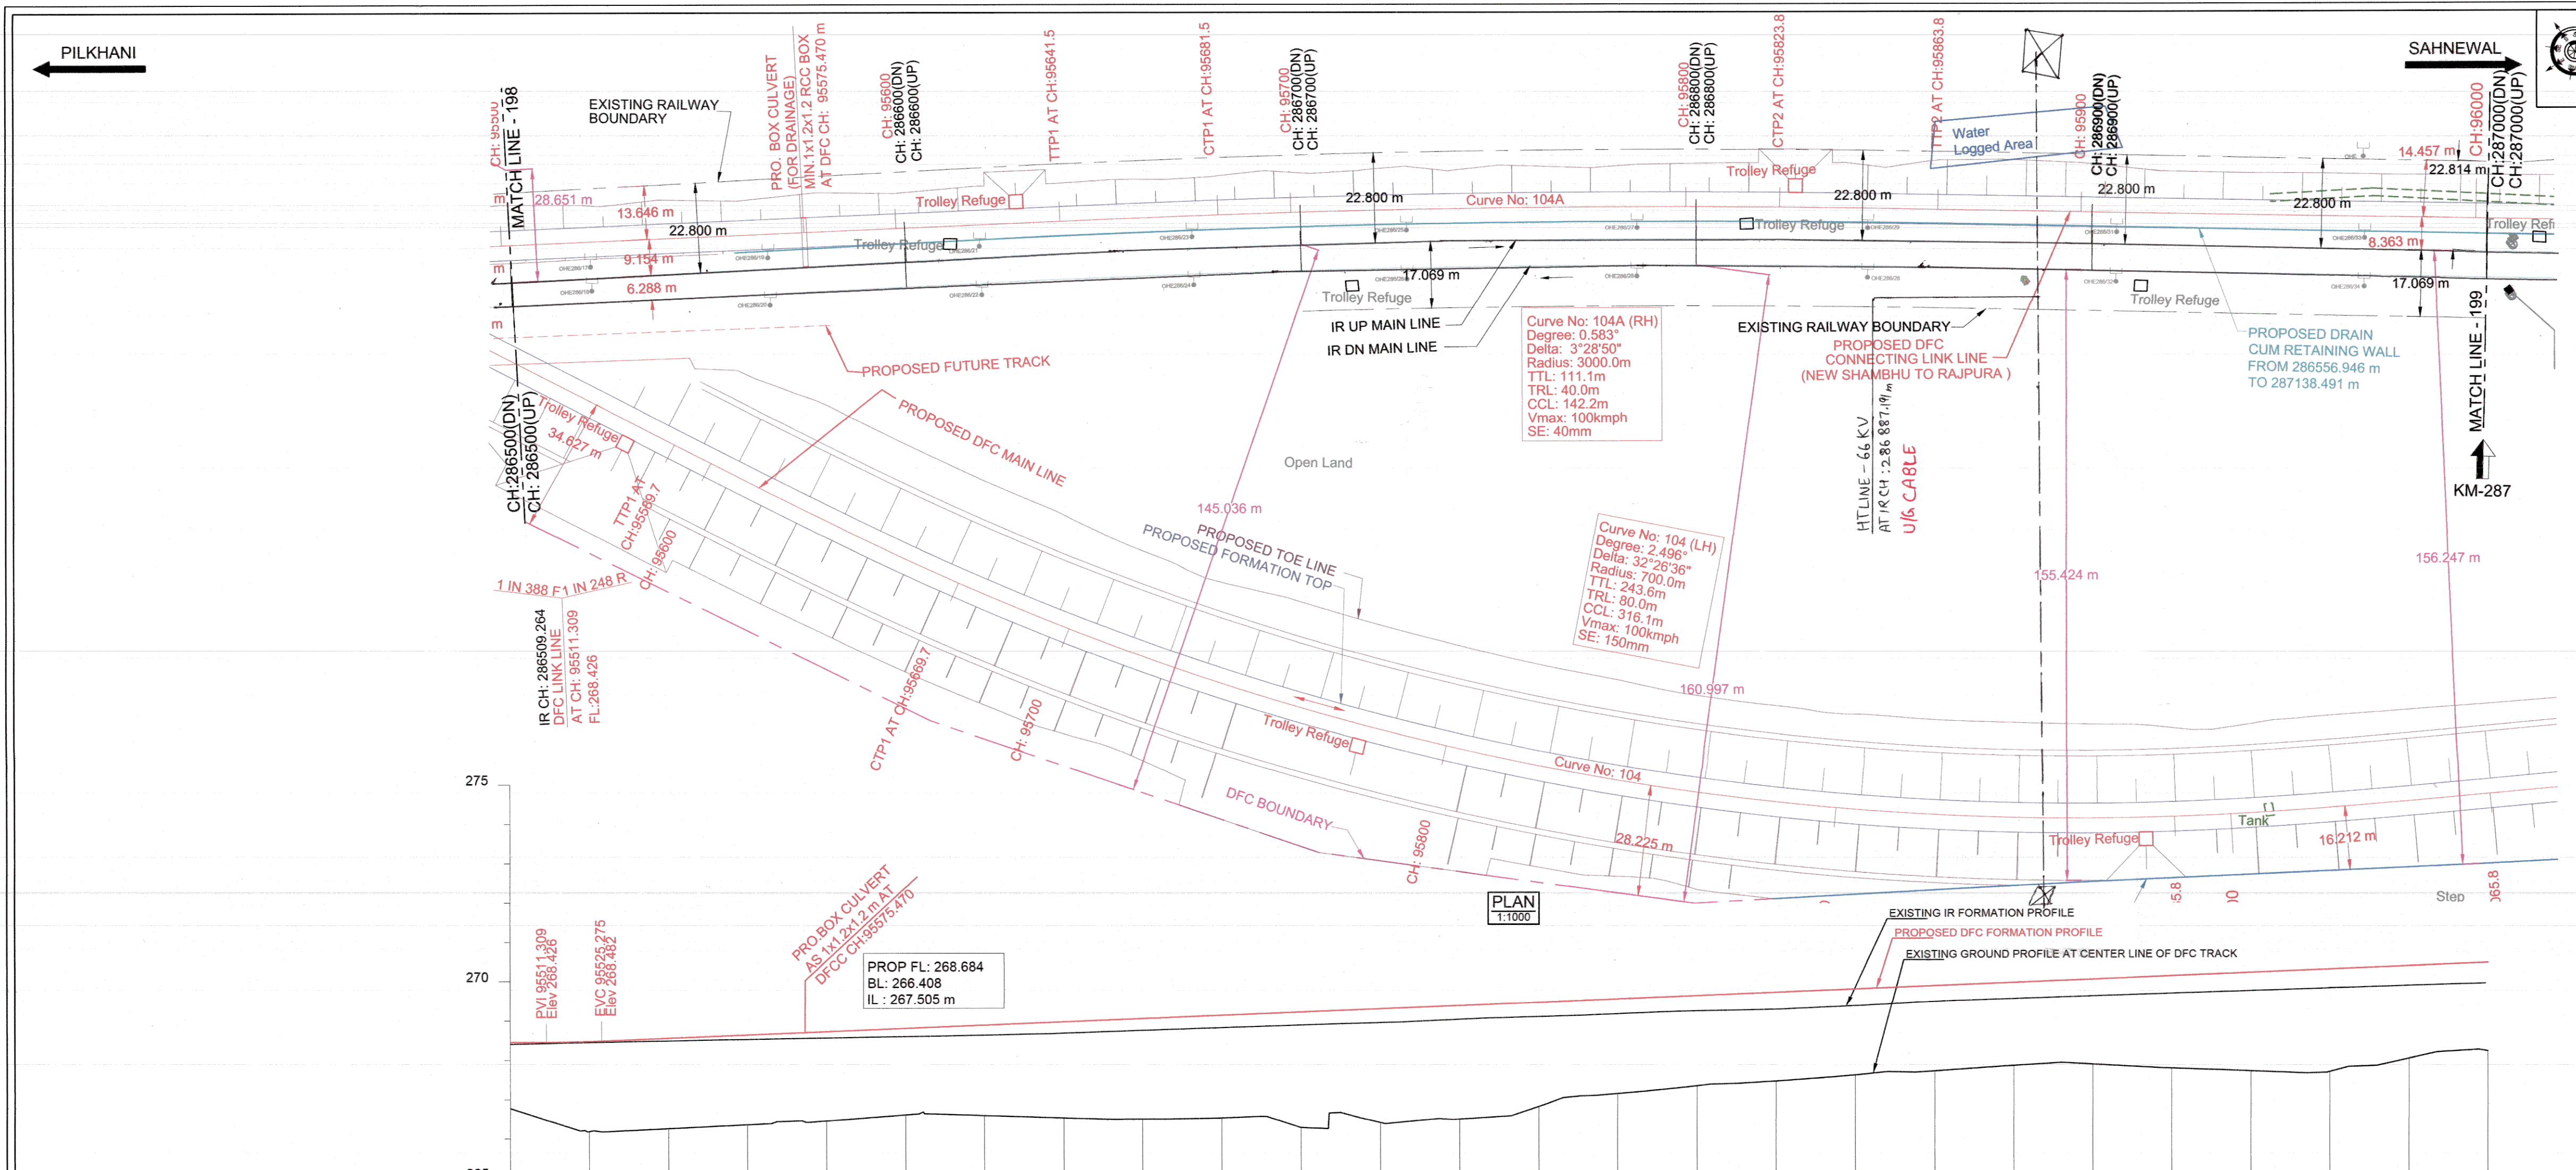

- WITH NEW GTS VALUE**
- SHEET NO. :199A OF 346**
- NOTE:**
1. PROPOSED WORKS ARE SHOWN IN RED.
 2. IR PROPOSALS ARE SHOWN IN VIOLET.
 3. ALL DIMENSIONS ARE SHOWN IN METRES.
 4. THIS DRAWING IS PREPARED BASED ON LATEST SURVEY DATA HELD ON AUG-2016. GTS BENCH MARK OF 261.850 m CONSIDERED ON TOP OF CANAL BRIDGE ABUTMENT AT DORAH VILLAGE ALONG THE NH1.
 5. MINIMUM OF 8m TRACK CENTER MAINTAINED BETWEEN ADJACENT TRACK TO EXISTING IR TRACK IN STATION YARD PORTION.
 6. DFC CHAINAGE OF 0.000 m IS WITH REFERENCE TO THE IR KM POST OF 192.000
 7. PUBLIC UTILITIES, HT, LT LINES AND OFC CABLES, WATER LINES etc., INTERFERING DFC LINES SHALL BE RELOCATED.
 8. PLAN OF LONGITUDINAL, AS WELL AS CROSS DRAINAGE WORKS BETWEEN IR & DFC BANKS SHALL BE SUBMITTED SEPARATELY FOR APPROVAL.
 9. ALL CANAL BRIDGES REQUIRED TO BE APPROVED BY CANAL AUTHORITIES.
 10. NECESSARY EMBANKMENT/SLOPE PROTECTION WORK DESIGN & DRAWING WILL BE SUBMITTED SEPARATELY.
 11. UNDERTAKING OF NO EXTRA CLAIM FOR DESIGN & EXECUTION OF WORK DUE TO CHANGE IN TURNOUT LENGTH AND DRAINAGE DESIGN HAS BEEN GIVEN BY GIL-TPL JV/EDFC/301/2017-18/DESIGN/0424 DATED 26.07.2017
 12. DURING CENTER LINE STAKING IF GROUND LEVEL SHOWN, FOUND TO BE MAJOR VARIATION, DESIGNER TO BE INFORMED.
 13. THE LAND BOUNDARY SHOWN IN THE ALIGNMENT DRAWING IS TENTATIVE ONLY. FOR ACTUAL ACQUISITION REFER LAND PLANS OF THAT CORRESPONDING SECTION.
 14. FOR DETAILS OF DFC MAIN LINE FROM NEW SHAMBUH TO RAJPURA REFER SEPARATE DRAWINGS.
 15. LOCATIONS PRONE TO FLOODING IN THE SECTION: NO
 16. WATER LOGGED AREA/ MARSHY LAND WHERE GROUND IMPROVEMENT REQUIRED: NO
 17. LOCATION OF TROLLEY REFUGE SHOWN ARE INDICATIVE, WILL BE FINALISED SEPARATELY.

REFERENCE DRAWINGS:-

1. FOR KEY PLAN REFER DRAWING NO. 301-2/AL/0001.
2. FOR LEGEND AND ABBREVIATIONS REFER DRAWING NO. 301-2/AL/1000.

THIS CONSTRUCTION DRAWING OF PLAN & PROFILE IS PREPARED BASED ON PRELIMINARY DRAWING APPROVAL BY DFCIL COMMUNICATED UNDER LETTER NO. EDFC 3/PMC/CON/11/2017/0715 DATED : 20.11.2017

DATUM ABOVE MSL : 265 m	
HORIZONTAL ALIGNMENT	L = 156.546m TL= 40m R=3000m TL= 40m L = 201.853m
VERTICAL ALIGNMENT	L=27.9 m R=4000 m L=327.8 m R=1 IN 248 R
TRACK DISTANCE FROM EXISTING NEAREST IR UP MAIN LINE TO PROPOSED DFC LINKED LINE	9.429 9.238 9.020 8.816 8.621 8.443 8.275 8.145 8.181 8.203 8.223 8.214 8.234 8.250 8.239 8.198 8.137 8.068 8.011 8.034 8.070 8.136 8.213 8.273 8.331 8.396
HEIGHT OF BANKING(+) / DEPTH OF CUTTING(-) (PFL-GL)	+1.884 +2.291 +2.300 +2.285 +2.271 +2.202 +2.269 +2.443 +2.559 +2.612 +2.637 +2.601 +2.684 +2.657 +2.610 +2.585 +2.560 +0.010 +0.000
EXG GROUND LEVEL AT CENTER LINE OF PRO. DFC TRACK (GL)	266.772 266.119 266.180 266.250 266.346 266.440 266.590 266.573 266.510 266.475 266.503 266.574 266.637 266.682 266.718 266.744 266.760 266.776 266.792 266.808 266.824 266.840 266.856 266.872 266.888 266.904 266.920 266.936 266.952 266.968 266.984 266.999 267.015 267.031 286.855 2