



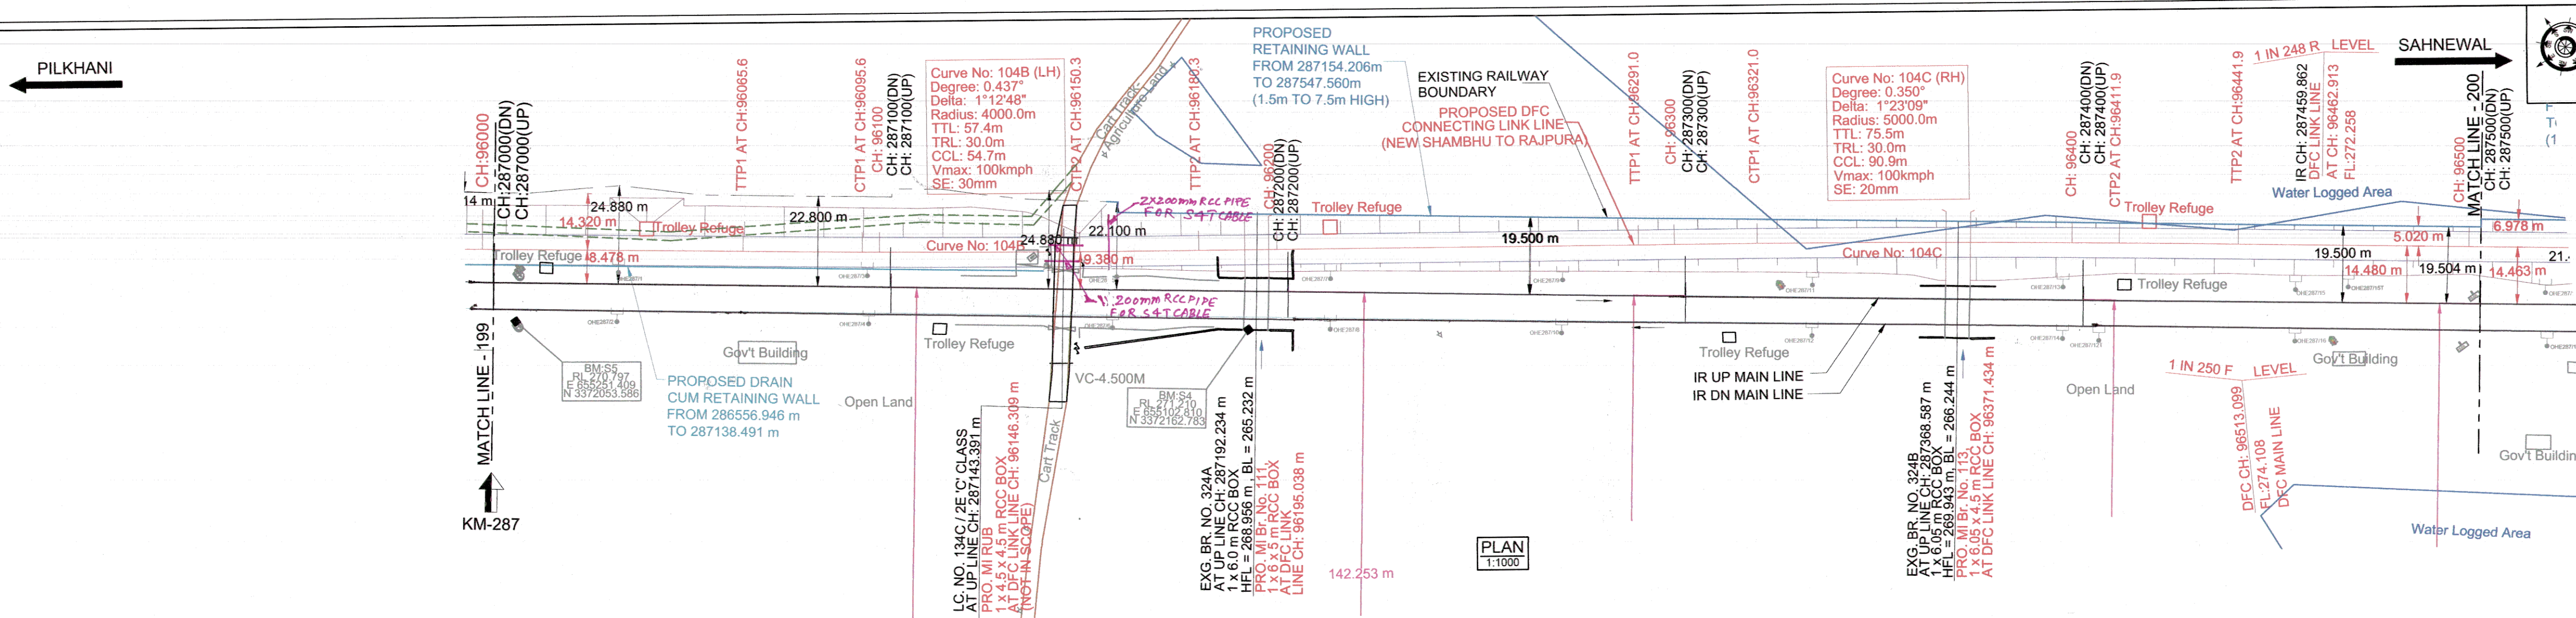

- WITH NEW GTS VALUE**
- NOTE:-**
1. PROPOSED WORKS ARE SHOWN IN RED.
 2. IR PROPOSALS ARE SHOWN IN VIOLET.
 3. ALL DIMENSIONS ARE SHOWN IN METRES.
 4. THIS DRAWING IS PREPARED BASED ON LATEST SURVEY DATA HELD ON AUG-2016. GTS BENCH MARK OF 261.850 m CONSIDERED ON TOP OF CANAL BRIDGE ABUTMENT AT DORAH VILLAGE ALONG THE NH1.
 5. MINIMUM OF 6m TRACK CENTER MAINTAINED BETWEEN ADJACENT TRACK TO EXISTING IR TRACK IN STATION YARD PORTION.
 6. DFC CHAINAGE OF 0.000 m IS WITH REFERENCE TO THE IR KM POST OF 192.000.
 7. PUBLIC UTILITIES, HT, LT LINES AND OFC CABLES, WATER LINES etc., INTERFERING DFC LINES SHALL BE RELOCATED.
 8. PLAN OF LONGITUDINAL AS WELL AS CROSS DRAINAGE WORKS BETWEEN IR & DFC BANKS SHALL BE SUBMITTED SEPARATELY FOR APPROVAL.
 9. ALL CANAL BRIDGES REQUIRED TO BE APPROVED BY CANAL AUTHORITIES.
 10. NECESSARY EMBANKMENT/SLOPE PROTECTION WORK DESIGN & DRAWING WILL BE SUBMITTED SEPARATELY.
 11. UNDERTAKING OF NO EXTRA CLAIM FOR DESIGN & EXECUTION OF WORK DUE TO CHANGE IN TURNOUT LENGTH AND DRAINAGE DESIGN HAS BEEN GIVEN BY GIL-TPL.
 12. DURING CENTER LINE STAKING IF GROUND LEVEL SHOWN, FOUND TO BE MAJOR VARIATION, DESIGNER TO BE INFORMED.
 13. THE LAND BOUNDARY SHOWN IN THE ALIGNMENT DRAWING IS TENTATIVE ONLY. FOR ACTUAL ACQUISITION REFER LAND PLANS OF THAT CORRESPONDING SECTION.
 14. FOR DETAILS OF DFC MAIN LINE FROM NEW SHAMBHU TO RAJAPURA REFER SEPARATE DRAWINGS.
 15. BR. NO. 324A/111 & 324B/113 DATA PROVIDED AS PER PRELIMINARY DRAWING NO. 301-1/RB/1696 & 301-1/RB/1697 AND 301-1/RB/1706 & 301-1/RB/1707.
 16. LOCATIONS PRONE TO FLOODING IN THE SECTION: NO
 17. WATER LOGGED AREA MARSHY LAND WHERE GROUND IMPROVEMENT REQUIRED: NO
 18. LOCATION OF TROLLEY REFUGE SHOWN ARE INDICATIVE, WILL BE FINALISED SEPARATELY.
- REFERENCE DRAWINGS :-**
1. FOR KEY PLAN REFER DRAWING NO. 301-2/AL/0001.
 2. FOR LEGEND AND ABBREVIATIONS REFER DRAWING NO. 301-2/AL/1000.

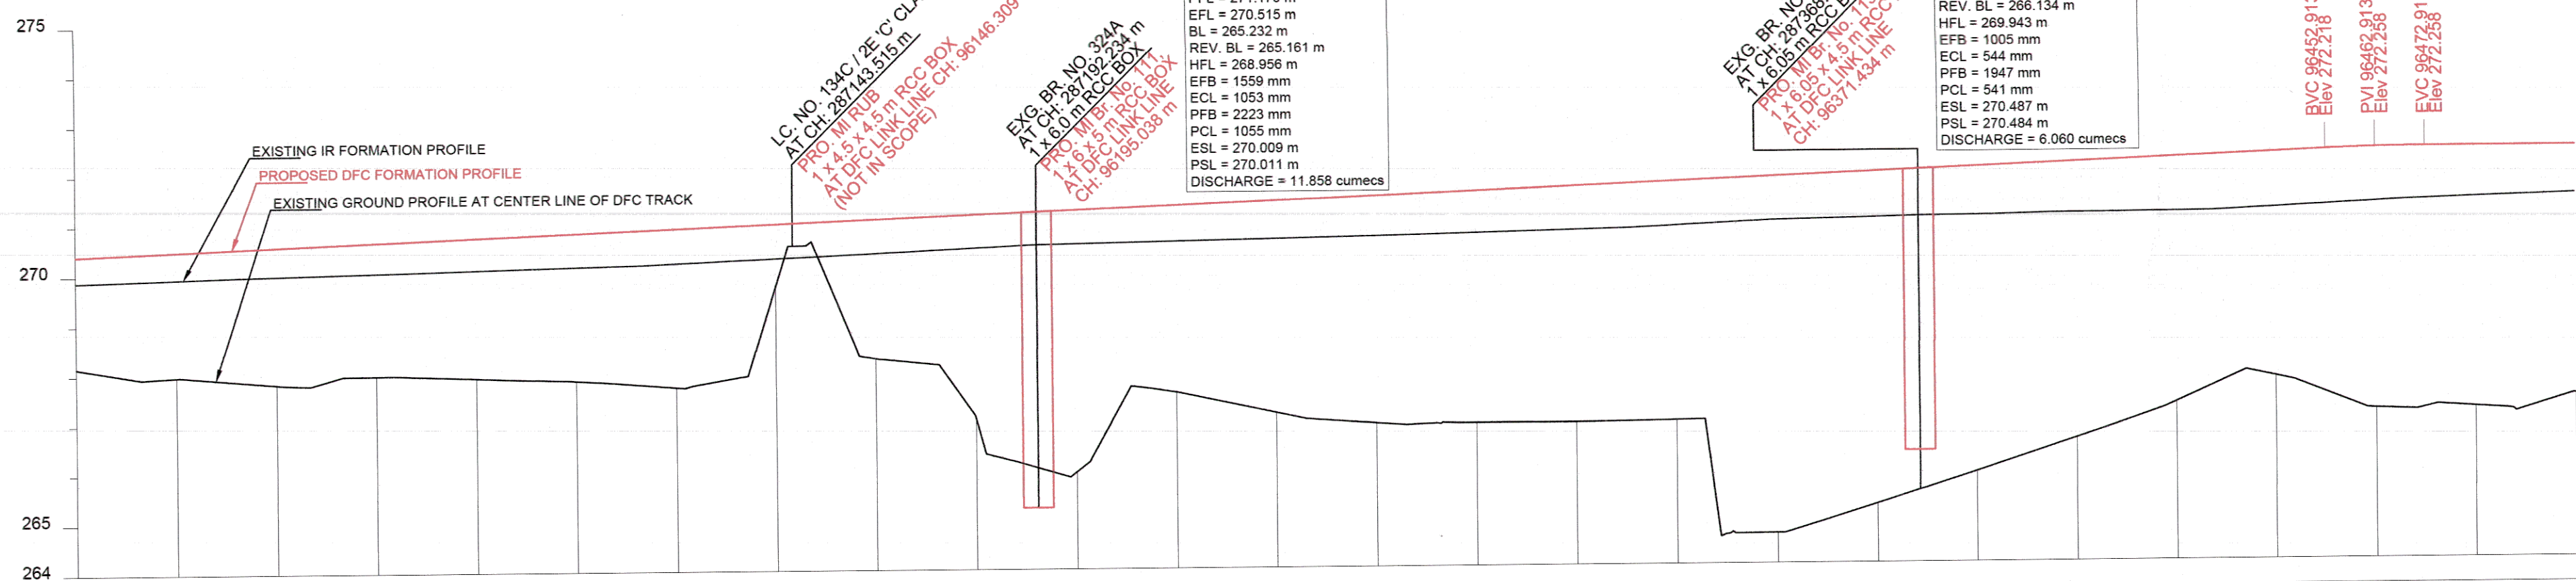

THIS CONSTRUCTION DRAWING OF PLAN & PROFILE IS PREPARED BASED ON PRELIMINARY DRAWING APPROVAL BY DFCCL COMMUNICATED UNDER LETTER NO. EDFC 3/PMC/CON/11/2017/0715 DATED : 20.11.2017

DATUM ABOVE MSL : 264 m

HORIZONTAL ALIGNMENT	L = 201.853m	TL= 30m	R = 4000m	TL= 30m	L = 110.632m	TL= 30m	R = 5000m	TL= 30m	L = 318.749m
VERTICAL ALIGNMENT	L=20.0 m R=4966 m	L=927.6 m 1 IN 248 R	L=20.0 m R=4966 m	L=339.7 m LEVEL	L=20.0 m R=4966 m	L=339.7 m LEVEL	L=20.0 m R=4966 m	L=339.7 m LEVEL	L=20.0 m R=4966 m
TRACK DISTANCE FROM EXISTING NEAREST IR UP MAIN LINE TO PROPOSED DFC LINKED LINE	8.396	8.465	8.532	8.598	8.672	8.746	8.820	8.894	8.968
HEIGHT OF BANKING(+) / DEPTH OF CUTTING(-) (PFL-GL)	+2.254	+2.519	+2.756	+2.677	+2.814	+2.960	+3.185	+3.481	+3.859
EXG GROUND LEVEL AT CENTER LINE OF PRO. DFC TRACK (GL)	268.151	267.967	267.810	267.970	267.913	267.848	267.703	267.518	267.289
EXG GROUND LEVEL AT TOE LOCATION OF PRO. DFC TRACK	266.614	266.613	266.676	266.707	266.659	266.589	266.465	266.286	266.052
DIFFERENCE BETWEEN PRO FORMATION LEVEL AND EXG. FORMATION LEVEL (PFL-EFL)	0.527	0.553	0.581	0.616	0.648	0.678	0.696	0.692	0.665
PRO. DFC FORMATION LEVEL (PFL)	270.405	270.486	270.566	270.647	270.727	270.808	270.888	270.969	271.050
EXG. FORMATION LEVEL OF EXG IR UP MAIN LINE (EFL)	268.878	269.933	269.985	270.031	270.079	270.130	270.182	270.234	270.286
DIFFERENCE BETWEEN PRO. DFC RAIL LEVEL AND EXG. RAIL LEVEL (PRL - ERL)	0.581	0.607	0.635	0.670	0.702	0.732	0.750	0.746	0.764
PRO. DFC RAIL LEVEL (PRL)	271.147	271.228	271.309	271.389	271.469	271.550	271.630	271.711	271.791
EXG. RAIL LEVEL OF NEAREST IR UP MAIN LINE (ERL)	270.566	270.621	270.673	270.719	270.767	270.818	270.860	270.905	270.951
EQUIVALENT CHAINAGE ON PROPOSED DFC TRACK	96002.8	96022.8	96042.8	96062.8	96082.8	96102.8	96122.8	96142.8	96162.8
EXISTING IR CHAINAGE	287000.0	287020.0	287040.0	287060.0	287080.0	287100.0	287120.0	287140.0	287160.0

L - SECTION (CONNECTING LINK LINE)

REV	DATE	REVISION DETAILS	PURPOSE OF ISSUE	SCALE	DESIGN CONSULTANT	CONTRACTOR	ENGINEER	CONTRACTOR	ENGINEER
2	26.03.18	UPDATED AS PER PMC COMMENTS	FOR APPROVAL	HOR - 1:1000 VER - 1:100	carvee associates	GIL - TPL JV	DB Engineering & Consulting GmbH	B RAMAKRISHNA DESIGNED	H.B. SANGA CHECKED
1	16.03.18	COMPLIANCE TO PMC COMMENTS, Dt. 30.12.17	FOR APPROVAL					DINESH PANDAY APPROVED	BABUL SAHU REVIEWED
0	13.12.17	INITIAL SUBMISSION	FOR APPROVAL						H.D. VIDJAK NONO

TRACK STRUCTURE		
RAIL SECTION: 60Kg/m (UIC 60Kg/m)	Difference between FL and RL	
DFC LINE: 60Kg/m (UIC 60Kg/m)	IR Line	DFC
IR MAIN LINE: 52Kg/m	172mm	172mm
RUBBER PAD	6mm	10mm
SLEEPER DEPTH	210mm	210mm
BALLAST CUSHION	300mm	350mm
Total Depth (FL TO RL)	688mm	742mm

PROJECT OFFICE / DFCCL		
SUNINDER PAL CPM		
PARDEEP PURI DY. CPM / ENGG. / LDH	P. KATHPALIA ACPM / ELECT. / UMB	
CHANKY GARG PM / ELECT. / UMB	ABHINAV SINGH PM / S&T	
SURENDRA SINGH DPM / ENGG. / UMB	S.P. SHARMA DPM / ELECT. / UMB	DEBASISH NAYAK APM / S&T-II / UMB

OWNER: DEDICATED FREIGHT CORRIDOR CORPORATION OF INDIA LTD.
(A GOVERNMENT OF INDIA ENTERPRISE)
PROJECT OFFICE (AMBALA UNIT): OLD RAILWAY COLONY (NEAR ANAND MARKET), AMBALA CANTT-133001.
CORPORATE IDENTITY NO.: U60232DL2006G01155068

PROJECT: EASTERN DEDICATED FREIGHT CORRIDOR
SAHNEWAL TO PILKHANI
CONTRACT PACKAGE - 301

TITLE	PLAN & PROFILE FROM IR KM: 287.000 TO 287.500 FROM DFC KM: 96.003 TO 96.503 (CONNECTING LINK LINE)	DFCC APPR. NO. - ENGG. APPR. NO. - DRG. NO. - 301-2/AL/1200A SHEET NO.: 200A OF 346 DATE: 26.03.2018	REV. No. 2 STATUS D
-------	---	--	------------------------