


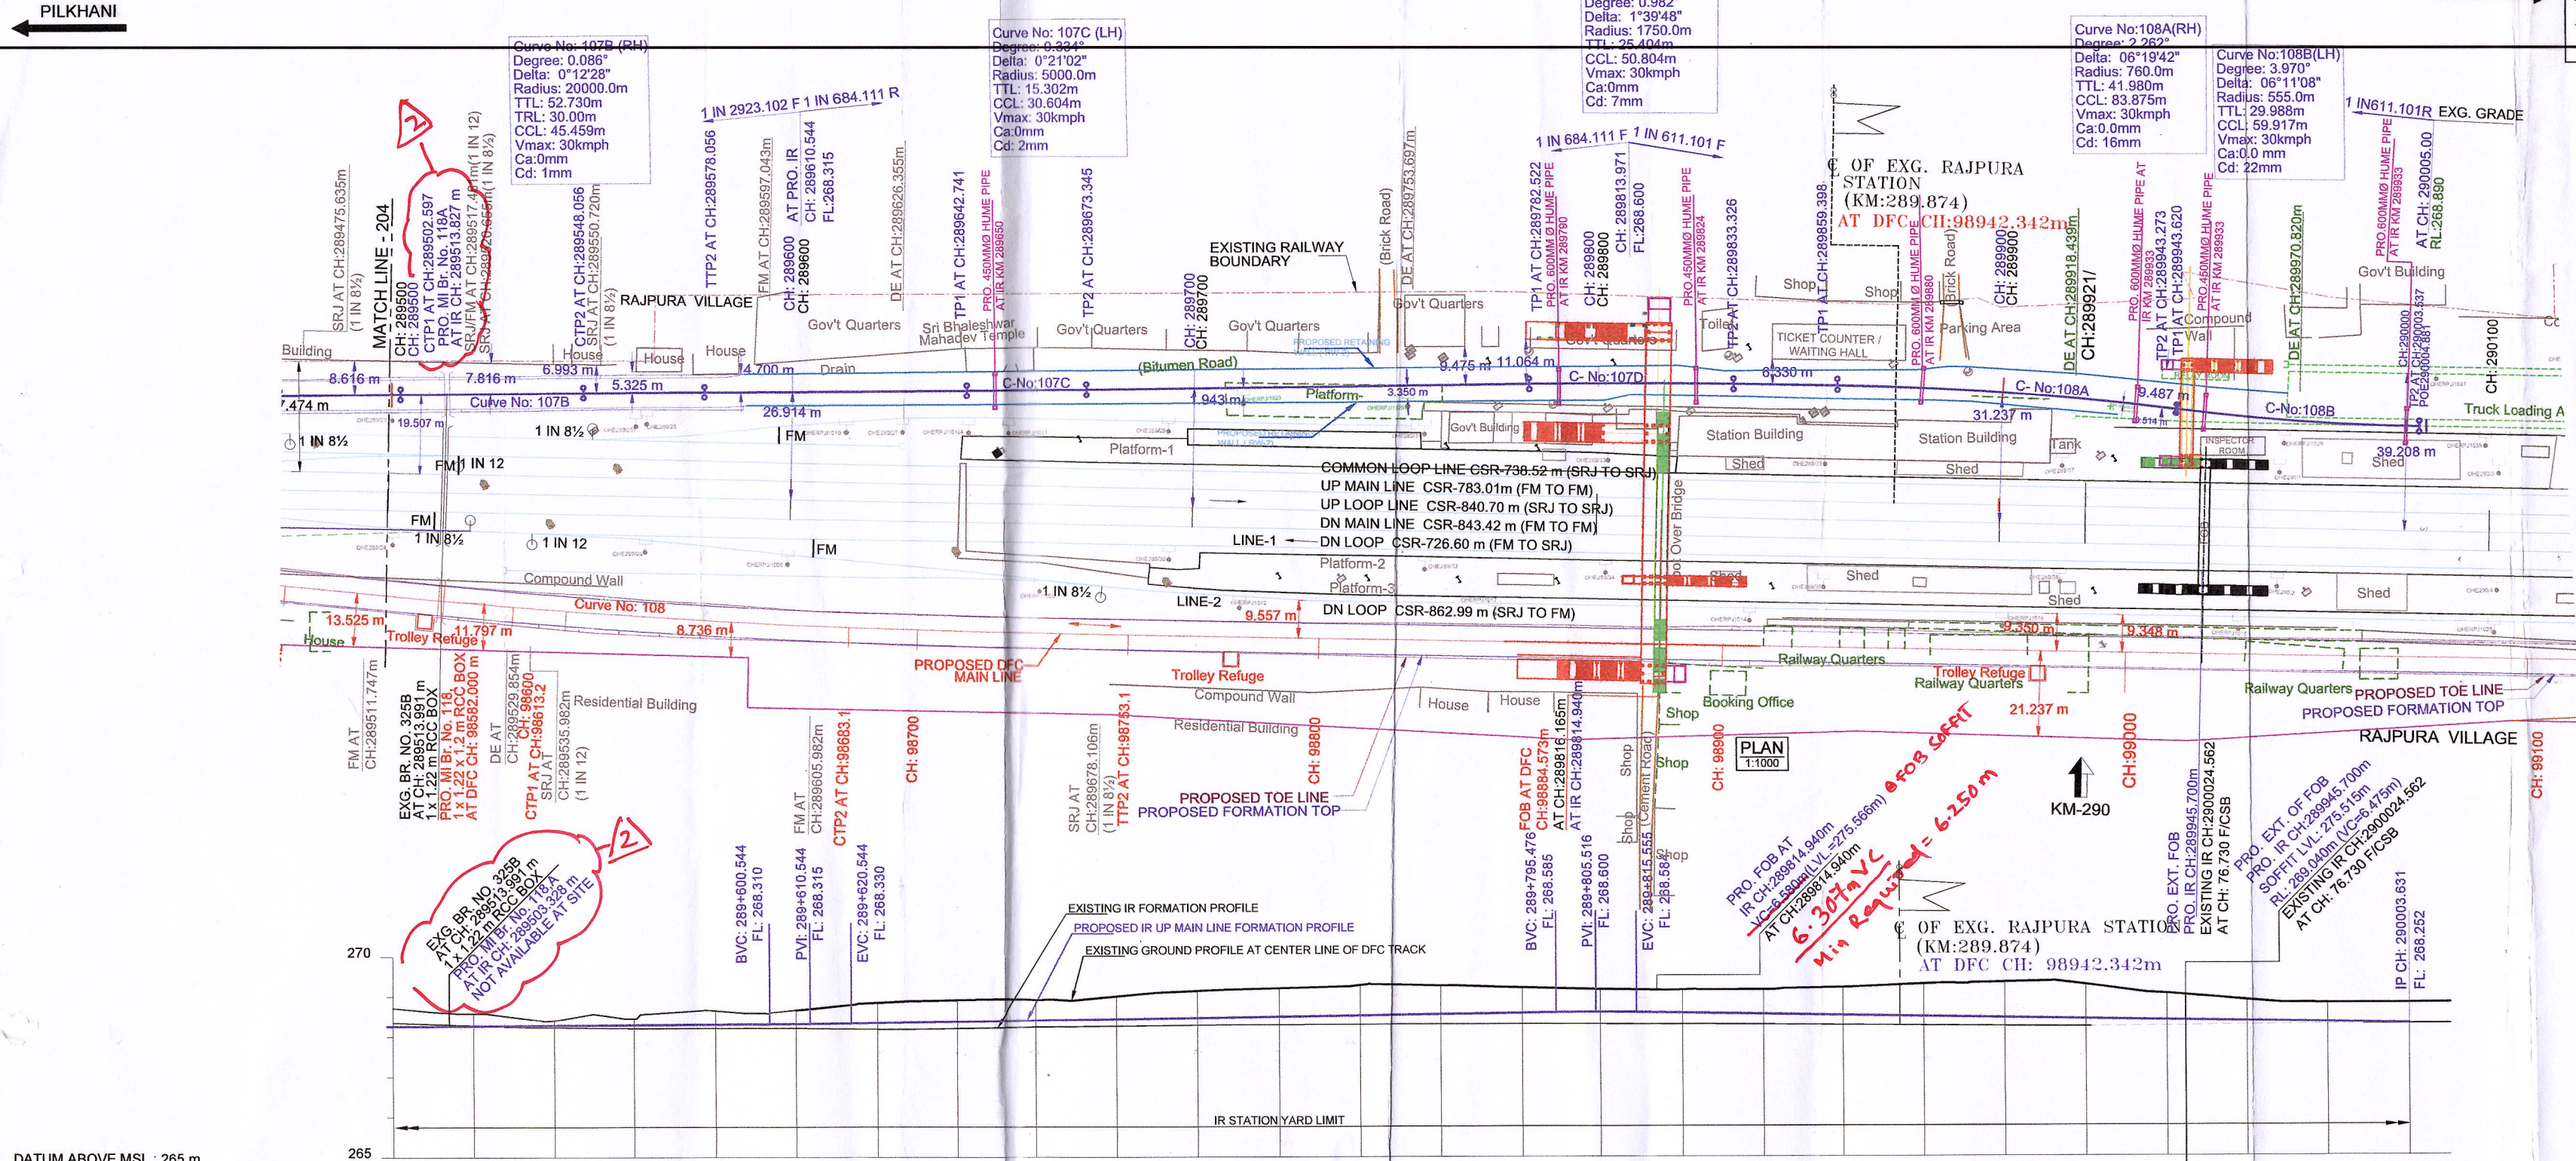

- WITH NEW GTS VALUE
- NOTE:-
1. PROPOSED WORKS ARE SHOWN IN RED.

2. IR PROPOSALS ARE SHOWN IN VIOLET.

3. EXISTING RAILWAY BOUNDARY ARE SHOWN IN BROWN.

4. ALL DIMENSIONS ARE SHOWN IN METRES.

5. THIS DRAWING IS PREPARED BASED ON LATEST SURVEY DATA HELD ON AUG-2016. GTS BENCH MARK OF 261.850 m CONSIDERED ON TOP OF CANAL BRIDGE ABUTMENT AT DORAH VILLAGE ALONG THE NH.

6. PUBLIC UTILITIES, HT, LT LINES AND OFC CABLES WATER LINES ETC., INTERFERING DFC LINES SHALL BE RELOCATED.

7. PLAN OF LONGITUDINAL AS WELL AS CROSS DRAINAGE WORKS BETWEEN IR & DFC BANKS SHALL BE SUBMITTED SEPARATELY FOR APPROVAL.

8. ALL CANAL BRIDGES REQUIRED TO BE APPROVED BY CANAL AUTHORITIES.

9. NECESSARY EMBANKMENT/SLOPE PROTECTION WORK DESIGN & DRAWING WILL BE SUBMITTED SEPARATELY.

10. DURING CENTER LINE STAKING IF GROUND LEVEL SHOWN, FOUND TO BE MAJOR VARIATION, DESIGNER TO BE INFORMED.

11. THE LAND BOUNDARY SHOWN IN THE ALIGNMENT DRAWING IS TENTATIVE ONLY. FOR ACTUAL ACQUISITION REFER LAND PLANS OF THAT CORRESPONDING SECTION.

12. FOR DETAILS OF DFC MAIN LINE FROM NEW SHAMBUH TO RAJPURA REFER SEPARATE DRAWINGS.

13. LOCATIONS PRONE TO FLOODING IN THE SECTION: NO.

14. WATER LOGGED AREA MARSHY LAND WHERE GROUND IMPROVEMENT REQUIRED: NO.

15. LOCATION OF TROLLEY REFUGE SHOWN ARE INDICATIVE, WILL BE FINALISED SEPARATELY.

16. THE MAGENTA-COLOR WORK SHOWN IN PLAN (HUME PIPES) IT WILL BE EXECUTED BY DFCCL.

17. SURVEY BENCHMARK FOR THE CONSTRUCTION OF FORMATION WORK, BENCHMARK (TBM) OF TRAVERS REPORT- 2017 TO BE USED.

- REFERENCE DRAWINGS :-
1. FOR KEY PLAN REFER DRAWING NO. 301-2/AL/0001.

2. FOR LEGEND AND ABBREVIATIONS REFER DRAWING NO. 301-2/AL/1000.

3. FOR ESP. REF. TR. NO. 2764 Rev 3A, DRG. NO. 301-2/AL/2023 (NR, H.Q.E PLAN NO:- UMB/08/12-2021)

4. FORMATION TYPICAL CROSS SECTION TR. NO. 1227

5. DRAINAGE TR. NO. 4054

6. RETAINING WALL TR. NO. 4687

NOTE:

1. BR. NO. 118A (KM 289.513) ON IR LOOP LINE, AS SHOWN ON DRAWING IS NOT REQUIRED TO BE CONSTRUCTED, AS THERE IS NO IR BRIDGE AVAILABLE AT SITE AT THIS LOCATION.

ENGINEER'S NOTES

1. LEVEL VALUE SHOWN ARE BASED ON TBM VALUES OF 2017

2. BRG NO 118A (AT KM 289+513) ON IR LOOP LINE, AS SHOWN ON DRAWING, IS NOT REQUIRED TO BE CONSTRUCTED. AT THIS LOCATION, THERE IS NO IR BRIDGE AT SITE.

THIS CONSTRUCTION DRAWING OF PLAN & PROFILE IS PREPARED BASED ON PRELIMINARY DRAWING APPROVAL BY DFCCL COMMUNICATED UNDER LETTER NO. EDCFC 3/PMC/CON/11/2017/0715 DATED : 20.11.2017

HORIZONTAL ALIGNMENT		TRL=30.0m	CCL=45.459 R=20000	TRL=30.0m	SL=64.685m	CCL=30.604 R=5000	SL=109.177m	CCL=50.804 R=1750	SL=28.065	CCL=83.875 R=760	SL=0.347	CCL=59.917R=555	SL=1.694
VERTICAL ALIGNMENT		G=1:2923.102 L=545.654m		L=20.000m R=21383.92		G=1:684.111 L=174.932m		L=20.080m R=6481.21		G=1:611.101 L=196.512m			
TRACK DISTANCE FROM EXISTING NEAREST IR UP MAIN LINE TO PROPOSED IR UP MAIN LINE		19.478	20.049	20.820	21.204	21.770	22.333	22.897	23.387	23.854	24.375	24.895	25.441
HEIGHT OF BANKING(+) / DEPTH OF CUTTING(-) (PFL-GL)		-0.440	-0.302	-0.114	-0.156	-0.339	-0.344	-0.515	-0.552	-0.528	-0.579	-0.687	-0.723
EXG GROUND LEVEL AT CENTER LINE OF PRO. IR TRACK (GL)		268.717	268.596	268.405	268.454	268.644	268.655	268.844	268.891	268.915	268.906	268.895	268.881
EXG GROUND LEVEL AT TOE LOCATION OF PRO. IR TRACK		268.674	268.528	268.651	268.779	268.701	268.622	268.766	268.881	268.906	268.906	268.895	268.881
DIFFERENCE BETWEEN PRO IR FORMATION LEVEL AND EXG. IR FORMATION LEVEL (PFL-EFL)		-0.076	-0.001	0.059	0.091	0.098	0.103	0.143	0.154	0.150	0.159	0.168	0.168
PRO. IR FORMATION LEVEL (PFL)		268.277	268.284	268.291	268.298	268.305	268.311	268.329	268.336	268.387	268.416	268.533	268.504
EXG. FORMATION LEVEL OF EXG IR UP MAIN LINE (EFL)		268.353	268.285	268.232	268.207	268.207	268.208	268.257	268.277	268.289	268.285	268.280	268.268
DIFFERENCE BETWEEN PRO. IR RAIL LEVEL AND EXG. RAIL LEVEL (PRL - ERL)		-0.097	-0.022	0.038	0.070	0.077	0.082	0.122	0.133	0.129	0.138	0.222	0.254
PRO. IR RAIL LEVEL (PRL)		268.944	268.951	268.958	268.965	268.972	268.978	268.998	269.025	269.054	269.077	269.143	269.177
EXG. RAIL LEVEL OF NEAREST IR UP MAIN LINE (ERL)		268.941	268.973	268.920	268.895	268.895	268.896	268.874	268.892	268.925	268.973	268.978	268.977
EQUIVALENT CHAINAGE ON PROPOSED IR UP TRACK		289500.0	289519.8	289539.8	289559.8	289579.8	289599.8	289619.8	289639.8	289659.8	289679.8	289699.8	289719.8
EXISTING IR CHAINAGE		289500.0	289520.0	289540.0	289560.0	289580.0	289600.0	289620.0	289640.0	289660.0	289680.0	289700.0	289720.0

5 28.01.24 REVISED AS PER REQUIREMENT

4 25.11.23 DRAWING REVISED AS PER PMO LETTER NO.9863

3 17.08.23 MODIFICATION OF TRACK ALIGNMENT OF LOOP LINE AS PER PMO TR NO. EDCFC/DEC/301/PMC/CON/07/2023/0407

2 26.03.18 UPDATED AS PER PMO COMMENTS

1 16.03.18 COMPLIANCE TO PMO COMMENTS DT. 30.12.2017

0 13.12.17 INITIAL SUBMISSION

FOR APPROVAL

FOR APPROVAL

SCALE

HOR - 1:1000

VER - 1:100

SHEET SIZE : A1

DESIGN CONSULTANT

CONTRACTOR

ENGINEER

CONTRACTOR

ENGINEER

darvee associates

GIL - TPL JV

DB Engineering & Consulting GmbH

B.K. SHARMA

SANJAY PRASAD SINGH

ABULAL SAHU

H.D. VIJAY

GOOD FOR CONSTRUCTION

OWNER

DEDICATED FREIGHT CORRIDOR CORPORATION OF INDIA LTD.

(A GOVERNMENT OF INDIA ENTERPRISE)

PROJECT OFFICE (AMBALA UNIT), OLD RAILWAY COLONY (NEAR ANAND MARKET), AMBALA CANTT-133001.

CORPORATE IDENTITY NO. : U60232DL2006050155068

PROJECT

EASTERN DEDICATED FREIGHT CORRIDOR

SAHNEWAL TO PILKHANI

CONTRACT PACKAGE - 301

TITLE

PLAN & PROFILE

FROM IR KM: 289.500 TO 290.083.70

FROM PRO. IR KM: 289499.8 TO 290005.0

(CONNECTING LINE)

DFCC APPR. NO. -

ENGG. APPR. NO. -

SHEET NO. : 205A OF 346

DATE : 28.01.2024

REV. No. 5

STATUS GC