




DEDICATED FREIGHT CORRIDOR CORPORATION OF INDIA LTD.
(A GOVERNMENT OF INDIA ENTERPRISE)

EASTERN DEDICATED FREIGHT CORRIDOR
SAHNEWAL TO PILKHANI SECTION
CONTRACT PACKAGE - 301

PLAN & PROFILE OF AS BUILT DRAWINGS OF IR CONNECTING LINE

IR CHAINAGE FROM KM 289.037 TO KM 290.082
IR DESIGN CHAINAGE KM 289.037 TO KM 290.003 (CONNECTING LINE)

DESIGN CONSULTANT


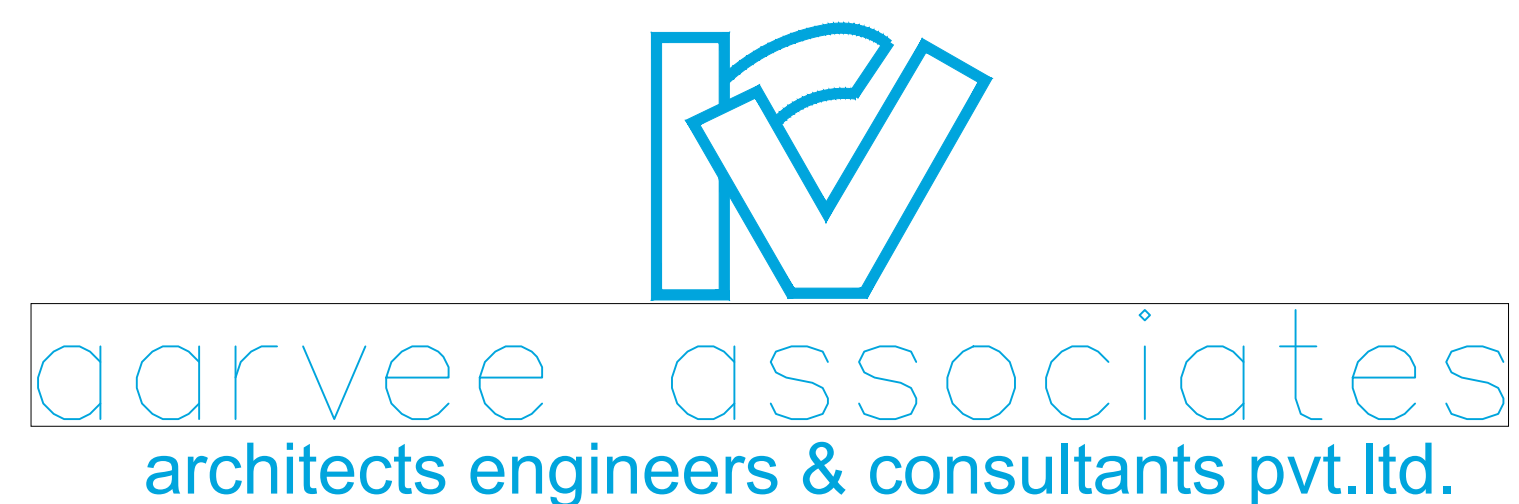


ENGINEER



CONTRACTOR CLIENT
GIL - TPL JV



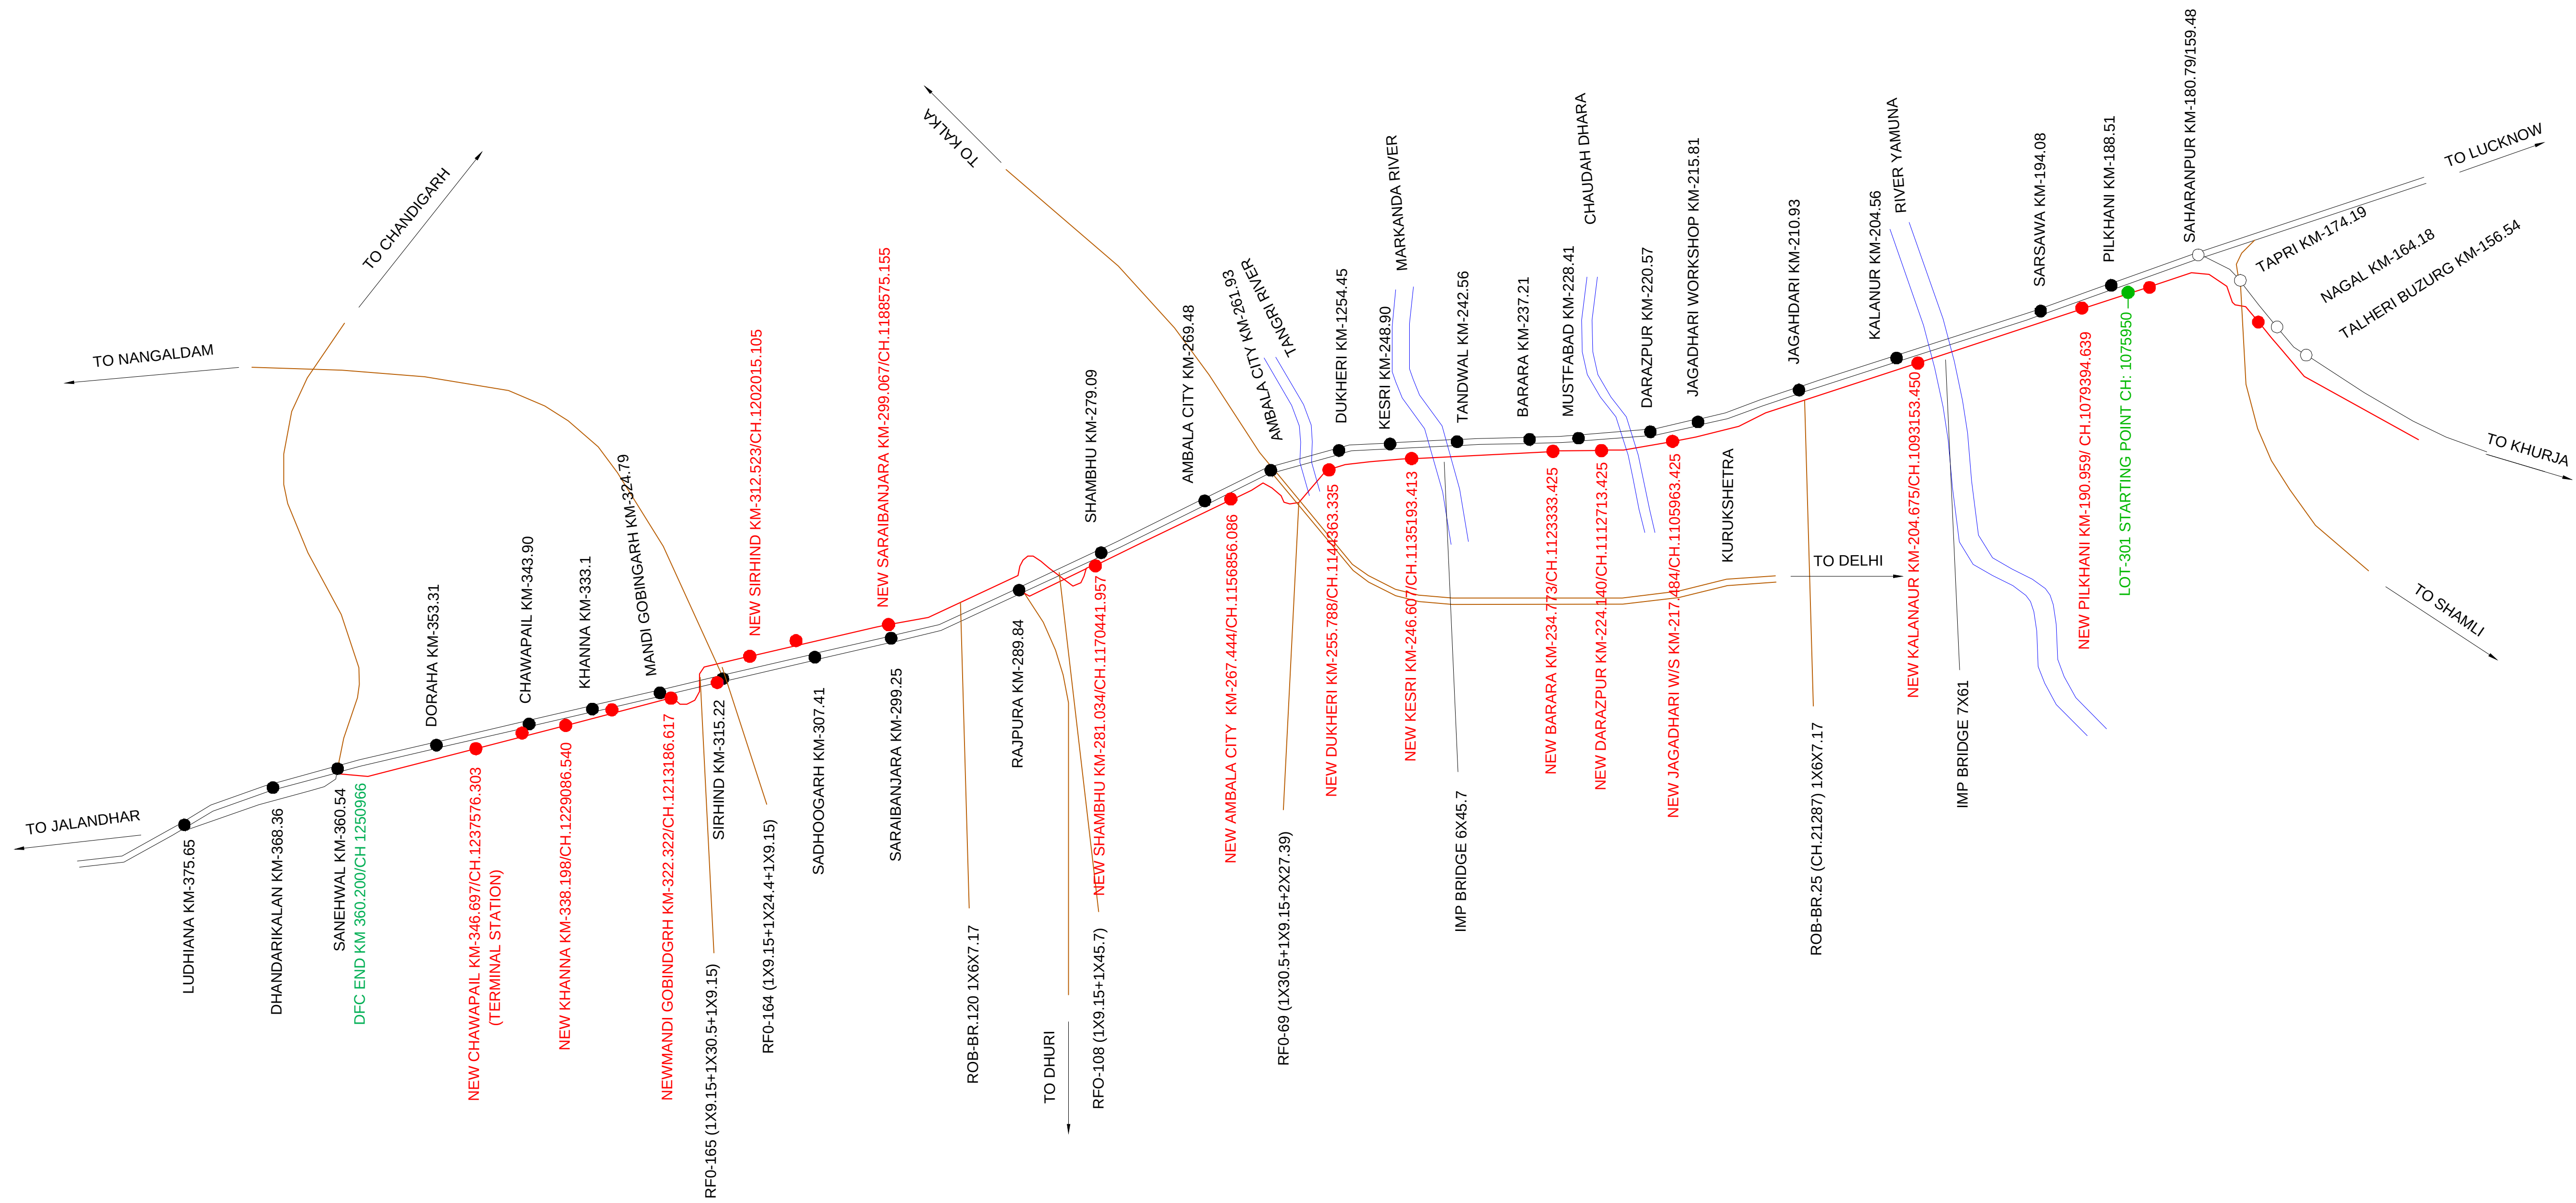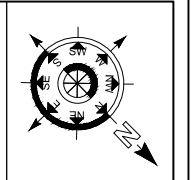

--	--	
DESIGN CONSULTANT

aarvee associates
architects engineers & consultants Pvt.Ltd.

CONTRACTOR

GIL - TPL JV

ENGINEER

DB Engineering & Consulting GmbH

OWNER

उत्तर प्रदेश रेलवे कं. लि.

DEDICATED FREIGHT CORRIDOR CORPORATION OF INDIA LTD.
(A GOVERNMENT OF INDIA ENTERPRISE)
PROJECT OFFICE(AMBALA UNIT): OLD RAILWAY COLONY (NEAR ANAND MARKET),AMBALA CANTT-133001.
CORPORATE IDENTITY NO. : U60232DL2006GOI155068



PROJECT
EASTERN DEDICATED FREIGHT CORRIDOR
SAHNEWAL TO PILKHANI
CONTRACT PACKAGE - 301

TITLE
ALIGNMENT DRAWINGS
KEY PLAN

DFCC APPR. NO. -
ENGG. APPR. NO. -
DRG. NO. - 301-2/AL/0001
SHEET NO. : 1 OF 1
DATE : 15-06-2024
REV. No. 0
STATUS A

LEGEND	
EXISTING IR TRACK	
DFC TRACK	
DFC FUTURE PROPOSALS	
IR PROPOSALS	
TOE LINE	
FORMATION CESS	
RETAINING WALL	
DRAIN CUM RETAINING WALL	
ROAD	
STREAM, DRAIN, NALA, CANAL.	
FENCE	
POWER LINES	
GPS POINTS	
ELECTRIC POLE/OHE MAST	
EXISTING RAILWAY BOUNDARY	
DFC BOUNDARY	
DISMANTLED WORKS	
IOCL PIPE LINE	
IOCL ROW	
SIGNALLING CABLE PIPE	

ABBREVIATIONS		
1.	BL	- BED LEVEL
2.	BVC	- BEGIN OF VERTICAL CURVE
3.	Ca	- APPLIED CANT
4.	CCL	- CIRCULAR CURVE LENGTH
5.	CTP1	- COMMON TANGENT POINT
6.	CTP2	- COMMON TANGENT POINT
7.	DEGREE	- DEGREE OF CURVE
8.	DE	- DEAD END
9.	ECL	- EXISTING CLEARANCE
10.	EFB	- EXISTING FREE BOARD
11.	EFL	- EXISTING FORMATION LEVEL
12.	ERL	- EXISTING RAIL LEVEL
13.	ESL	- EXISTING SOFFIT LEVEL
14.	EVC	- END OF VERTICAL CURVE
15.	EVCL	- EXISTING VERTICAL CLEARANCE
16.	F/CSB	- FROM CENTER LINE OF STN BLDG
17.	FM	- FOULING MARK
18.	FSL	- FULL SUPPLY LEVEL
19.	HFL	- HIGH FLOOD LEVEL
20.	L	- STRAIGHT LENGTH
21.	LH	- LEFT HANDED
22.	LHS	- LIMITED HEIGHT SUBWAY
23.	PCL	- PROPOSED CLEARANCE
24.	PFB	- PROPOSED FREE BOARD
25.	PFL	- PROPOSED FORMATION LEVEL
26.	PRL	- PROPOSED RAIL LEVEL
27.	PSL	- PROPOSED SOFFIT LEVEL
28.	PVCL	- PROPOSED VERTICAL CLEARANCE
29.	PVI	- POINT OF VERTICAL INTERSECTION
30.	R	- RADIUS
31.	REV.BL	- REVISED BED LEVEL
32.	RH	- RIGHT HANDED
33.	Rr	- RESULTANT RADIUS
34.	SE	- SUPER ELEVATION
35.	SRJ	- STOCK RAIL JOINT
36.	TS	- TRAP SWITCH
37.	TTL	- TOTAL TANGENT LENGTH
38.	TTP1	- TRANSITION TANGENT POINT
39.	TTP2	- TRANSITION TANGENT POINT
40.	TL	- TRANSITION LENGTH
41.	DELTA	- DEFLECTION ANGLE

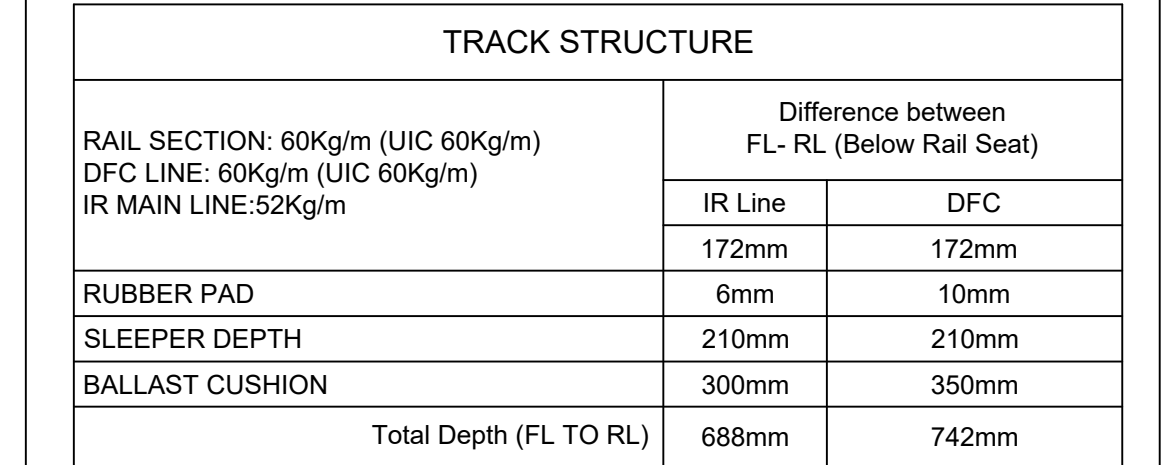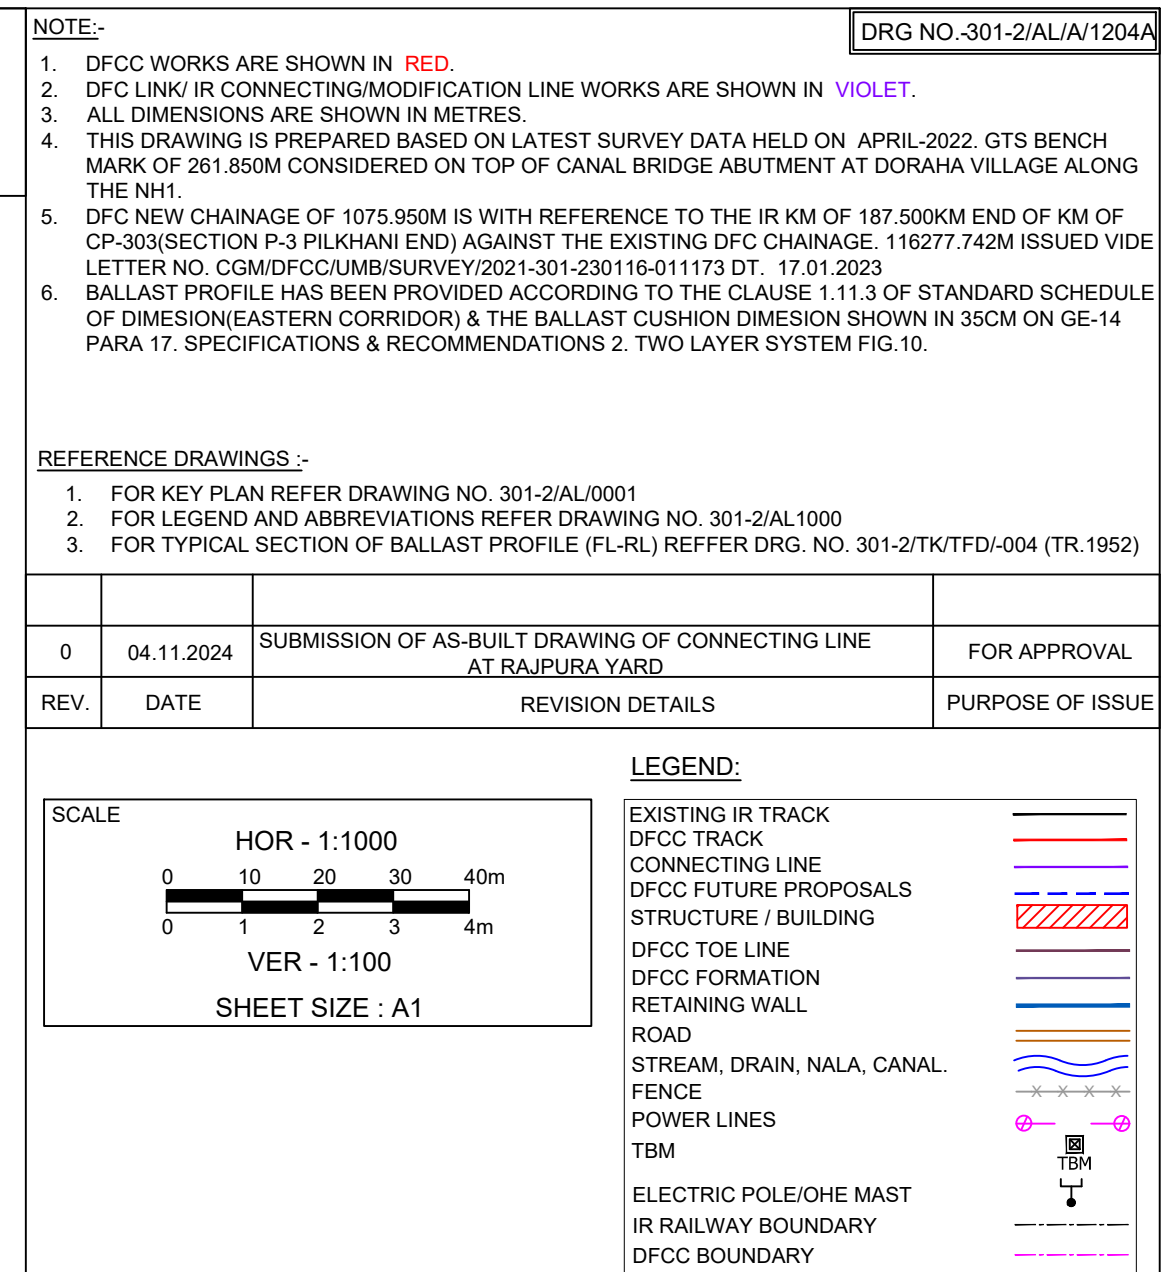

OWNER	DEDICATED FREIGHT CORRIDOR CORPORATION OF INDIA LTD. (A GOVERNMENT OF INDIA ENTERPRISE) PROJECT OFFICE(AMBALA UNIT): OLD RAILWAY COLONY (NEAR ANAND MARKET), AMBALA CANTT-133001. CORPORATE IDENTITY No. : U62322DL2006GG01155068
-------	--

ENGINEER:

 **DB Engineering & Consulting GmbH**
Deutsche Bahn Engineering & Consulting GmbH

CONTRACTOR: GIL - TPL JV

SUBMITTED BY	GIL - TPL JV		
	DATED	NAME	SIGNATURE
PREPARED BY			
CHECKED BY	04.11.2024	VIJAY PRATAP	
APPROVED BY	04.11.2024	PARASURAM KOTYADA	

APPROVED BY	DEUTSCHE BAHN ENGINEERING & CONSULTING GMBH		
	DATED	NAME	SIGNATURE
Sr. DE./CHIEF ENGINEER		SURESH K.YALANGI	
CHIEF TRACK ENGINEER		RAJ PAL SINGH	
T.L.		H.D. VIDJAK	


STAMP	A AS-BUILT DRAWING TR. Ref..... ENGINEER Sign.:

EMPLOYER (DFCCIL):	DEDICATED FREIGHT CORRIDOR CORPORATION OF INDIA LTD.
--------------------	--

--	--	--	--

TITLE AS-BUILT PLAN AND PROFILE FROM IR KM: 289037.9 TO 289500 IR DESIGN KM: 289037.6 TO 289499.8 (CONNECTING LINE)	DFCC APPR. NO. -	
	ENGG. APPR. NO. -	
	DRG. NO. - 301-2/AL/A/1204A	
	SHEET NO. : 1 OF 1	STATUS A
DATE : 04.11.2024		

TR.

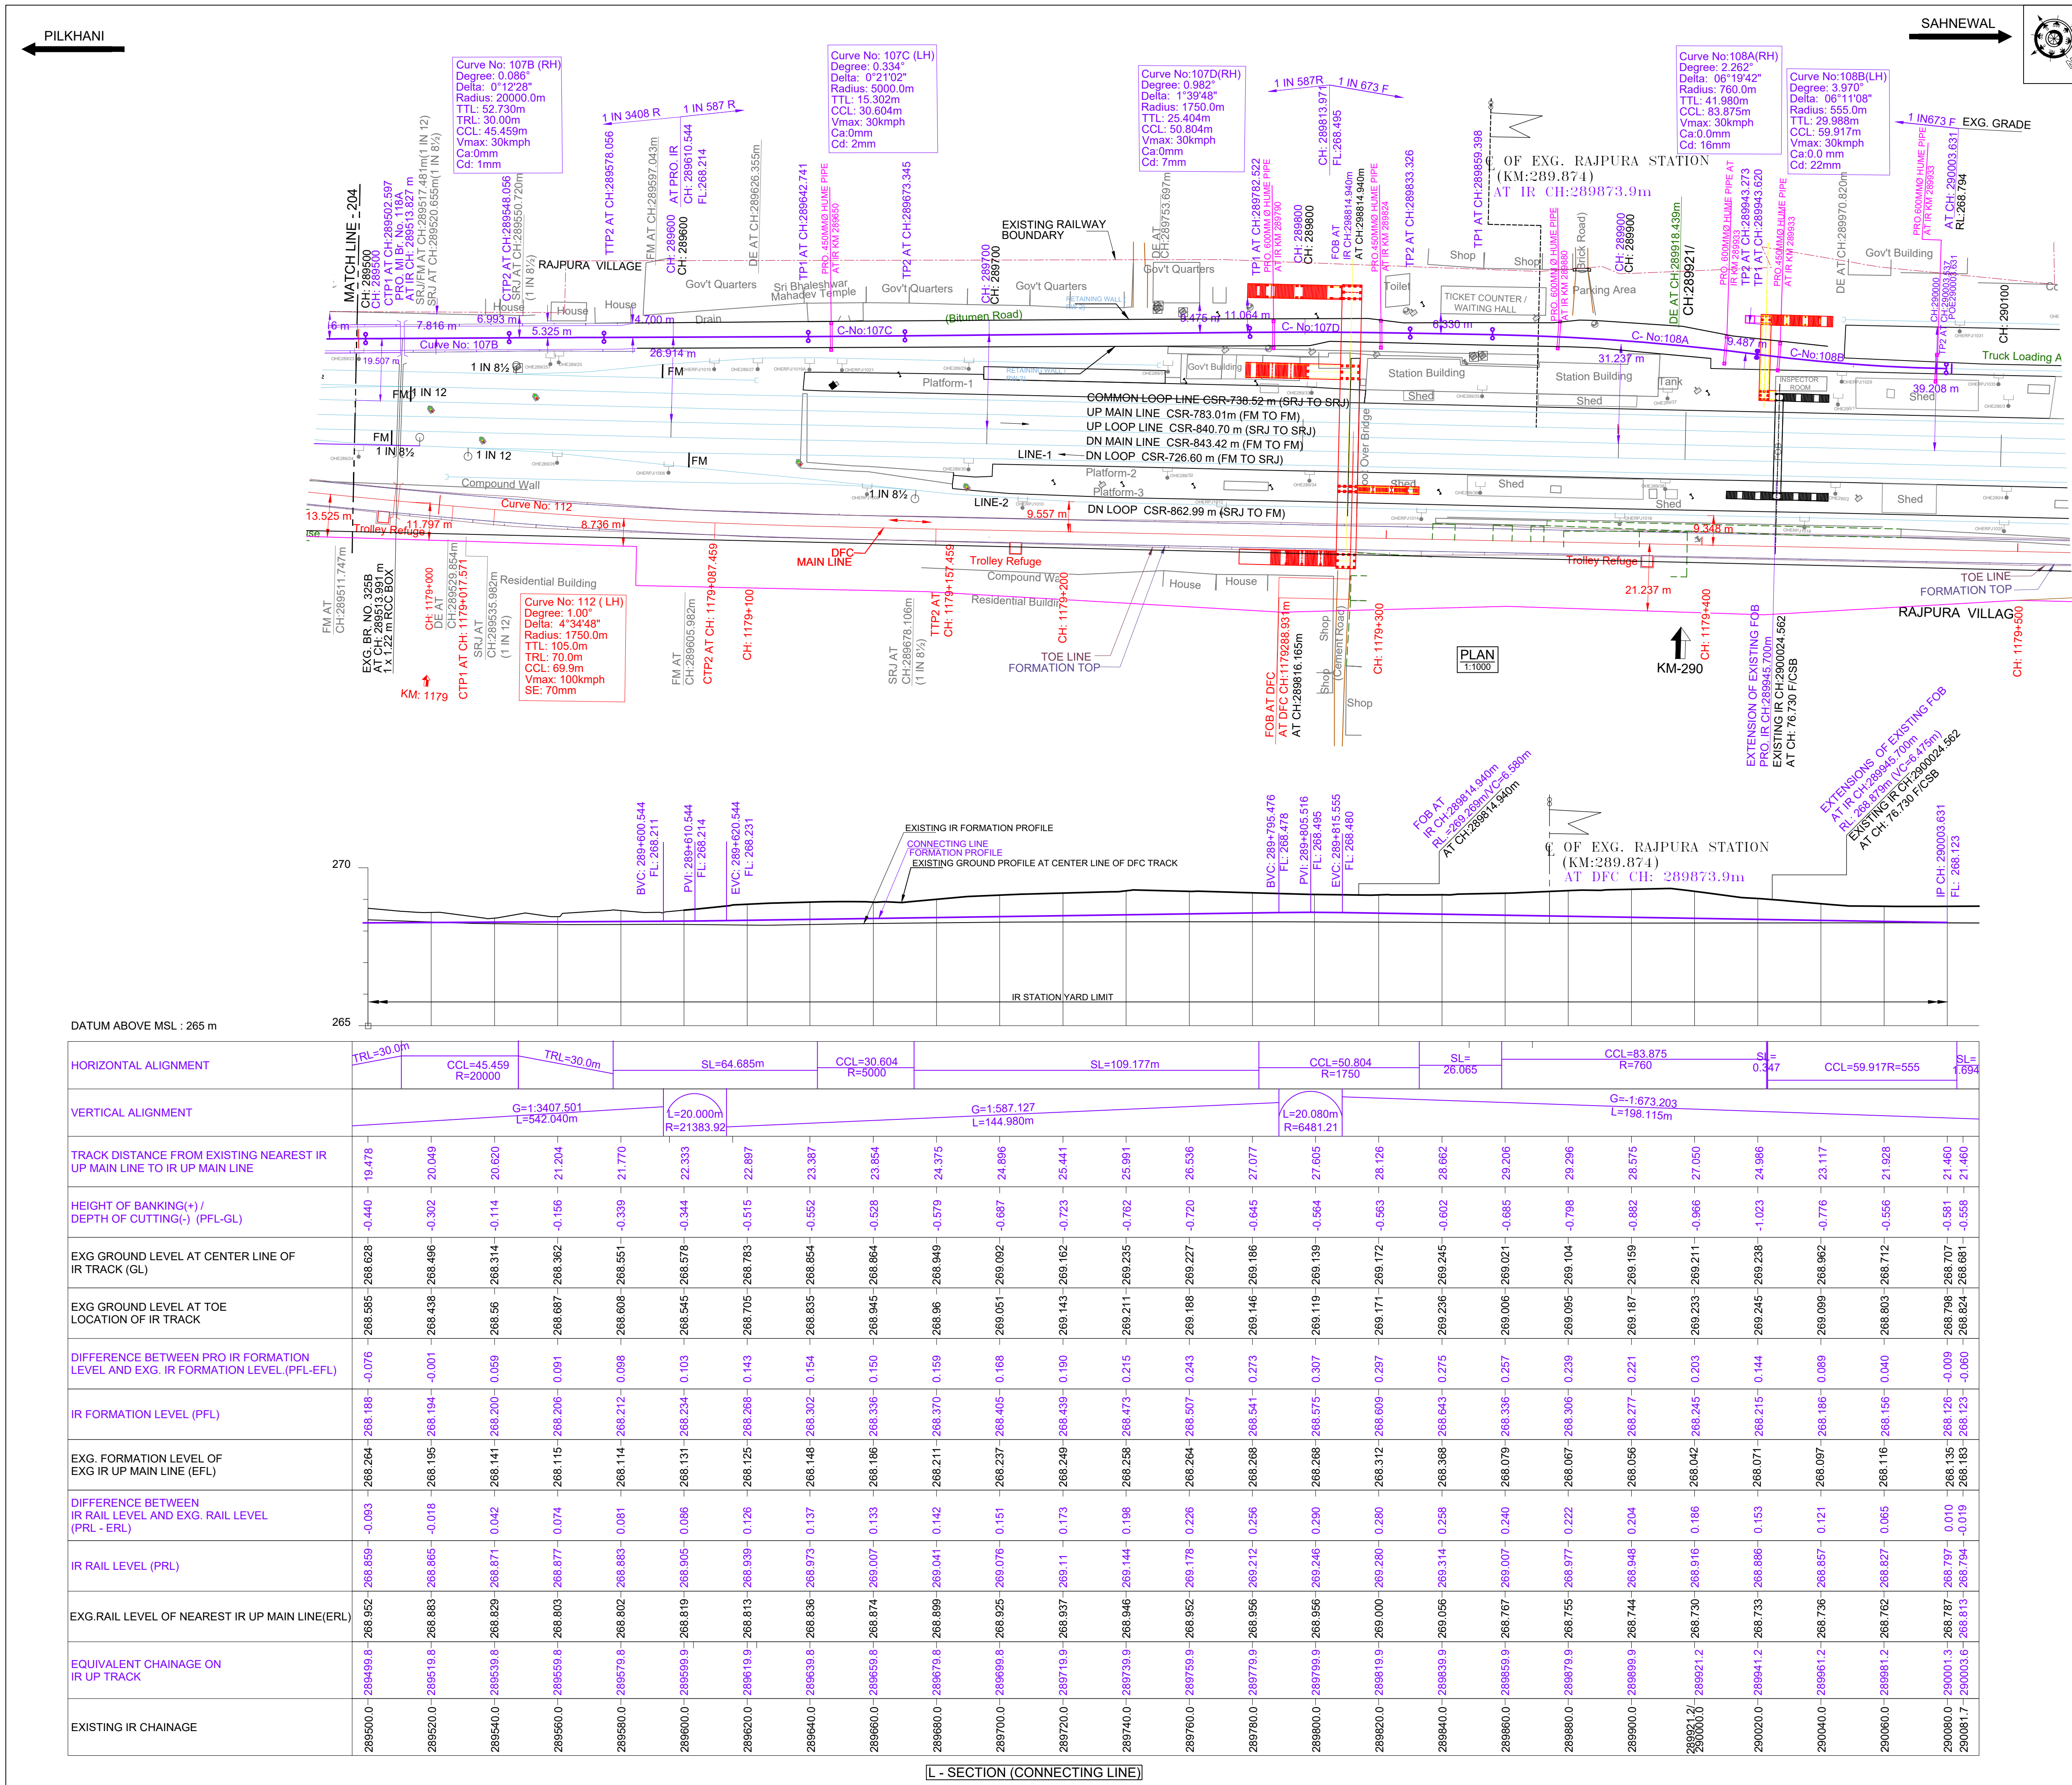

Engineering drawing showing the L-SECTION (CONNECTING LINE) for the AS-BUILT PLAN AND PROFILE. The drawing includes a plan view (PLAN 1:1000) and a vertical section view (L-SECTION) showing the horizontal alignment, vertical alignment, and track structure details. The plan view shows the existing railway boundary, station buildings, and various tracks (C-No. 107B, 107C, 107D, 108A, 108B). The vertical section view shows the ground profile, track formation, and various levels (e.g., 265, 270, 275). The drawing also includes a table of data for the track structure, showing various levels and dimensions.

NOTE:-

- DFCC WORKS ARE SHOWN IN RED.
- DFC LINK/IR CONNECTING/MODIFICATION LINE WORKS ARE SHOWN IN VIOLET.
- ALL DIMENSIONS ARE SHOWN IN METRES.
- THIS DRAWING IS PREPARED BASED ON LATEST SURVEY DATA HELD ON APRIL-2022. GTS BENCH MARK OF 261.850M CONSIDERED ON TOP OF CANAL BRIDGE ABUTMENT AT DORANA VILLAGE ALONG THE NH1.
- DFC NEW CHAINAGE OF 1075.950M IS WITH REFERENCE TO THE IR KM OF 187.500KM END OF KM OF CP-303(SECTION P-3 PILKHANI END) AGAINST THE EXISTING DFC CHAINAGE. 116277.742M ISSUED VIDE LETTER NO. COM/DFCC/CLUB/SURVEY/2021-301-29016-011173.DT. 17.01.2023.
- BALLAST PROFILE HAS BEEN PROVIDED ACCORDING TO THE CLAUSE 1.11.3 OF STANDARD SCHEDULE OF DIMENSION (EASTERN CORRIDOR) & THE BALLAST CUSHION DIMENSION SHOWN IN 35CM ON GE-14 PARA 17. SPECIFICATIONS & RECOMMENDATIONS 2. TWO LAYER SYSTEM FIG.10.

REFERENCE DRAWINGS:-

- FOR KEY PLAN REFER DRAWING NO. 301-2/AL/0001
- FOR LEGEND AND ABBREVIATIONS REFER DRAWING NO. 301-2/AL/1000
- FOR TYPICAL SECTION OF BALLAST PROFILE (FL-RL) REFER DRG. NO. 301-2/TK/TFD/004 (TR.1952)

LEGEND:

SCALE: HOR - 1:1000, VER - 1:100, SHEET SIZE - A1

TRACK STRUCTURE

RAIL SECTION: 60Kg/m (UIC 60Kg/m) DFC LINE: 60Kg/m (UIC 60Kg/m) IR MAIN LINE: 52Kg/m	Difference between FL-RL (Below Rail Seat)	
	IR Line	DFC
RUBBER PAD	172mm	172mm
SLEEPER DEPTH	6mm	10mm
BALLAST CUSHION	210mm	210mm
Total Depth (FL TO RL)	300mm	350mm

OWNER: DEDICATED FREIGHT CORRIDOR CORPORATION OF INDIA LTD. (A GOVERNMENT OF INDIA ENTERPRISE)
PROJECT OFFICE (AMBALA UNIT): OLD RAILWAY COLONY (NEAR ANAND MARKET), AMBALA CANTT-133001.
CORPORATE IDENTITY NO.: U60232DL2006001155068

ENGINEER: DB Engineering & Consulting GmbH
Deutsche Bahn Engineering & Consulting GmbH

CONTRACTOR: GIL - TPL JV
GAR TATA

SUBMITTED BY: GIL - TPL JV

DATED	NAME	SIGNATURE
04.11.2024	VIJAY PRATAP	
04.11.2024	PARASURAM KOTYADA	

APPROVED BY: DEUTSCHE BAHN ENGINEERING & CONSULTING GMBH

DATED	NAME	SIGNATURE
	SURESH K.YALANGI	
	RAJ PAL SINGH	
	H.D. VIDJAK	

STAMP: AS-BUILT DRAWING TR. Ref.: ENGINEER Sign.:

EMPLOYER (DFCCIL): DEDICATED FREIGHT CORRIDOR CORPORATION OF INDIA LTD.

AS BUILT DRAWING

TITLE: AS-BUILT PLAN AND PROFILE
FROM IR KM: 289500 TO 290081.7
IR DESIGN KM: 289499.8 TO 290003.6 (CONNECTING LINE)

DFCC APPR. NO.:
ENGG. APPR. NO.:
DRG. NO.: 301-2/AL/A/1205A
SHEET NO.: 1 OF 1
DATE: 04.11.2024

STATUS: A

TR.