




DEDICATED FREIGHT CORRIDOR CORPORATION OF INDIA LTD.
(A GOVERNMENT OF INDIA ENTERPRISE)

EASTERN DEDICATED FREIGHT CORRIDOR
SAHNEWAL TO PILKHANI SECTION
CONTRACT PACKAGE - 301

PLAN & PROFILE OF AS BUILT DRAWINGS FOR DFC MAIN LINE

IR CHAINAGE FROM 297.500 KM TO 300.500 KM
DFCC CHAINAGE FROM KM 1186.989 TO KM 1189.990

DESIGN CONSULTANT


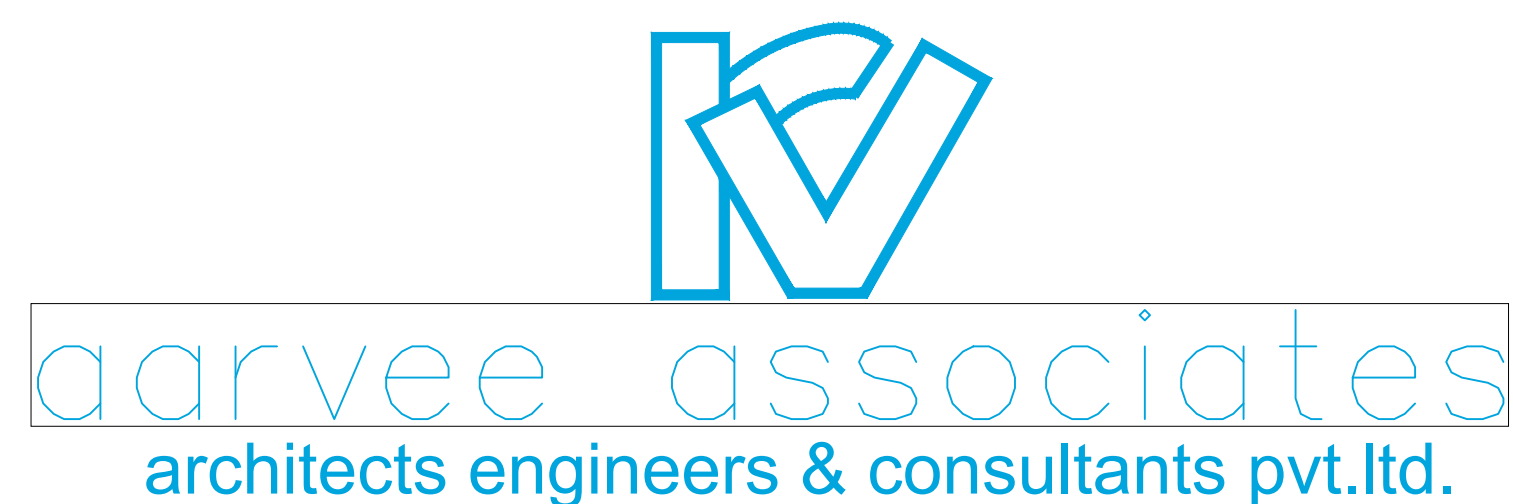


ENGINEER



CONTRACTOR CLIENT
GIL - TPL JV



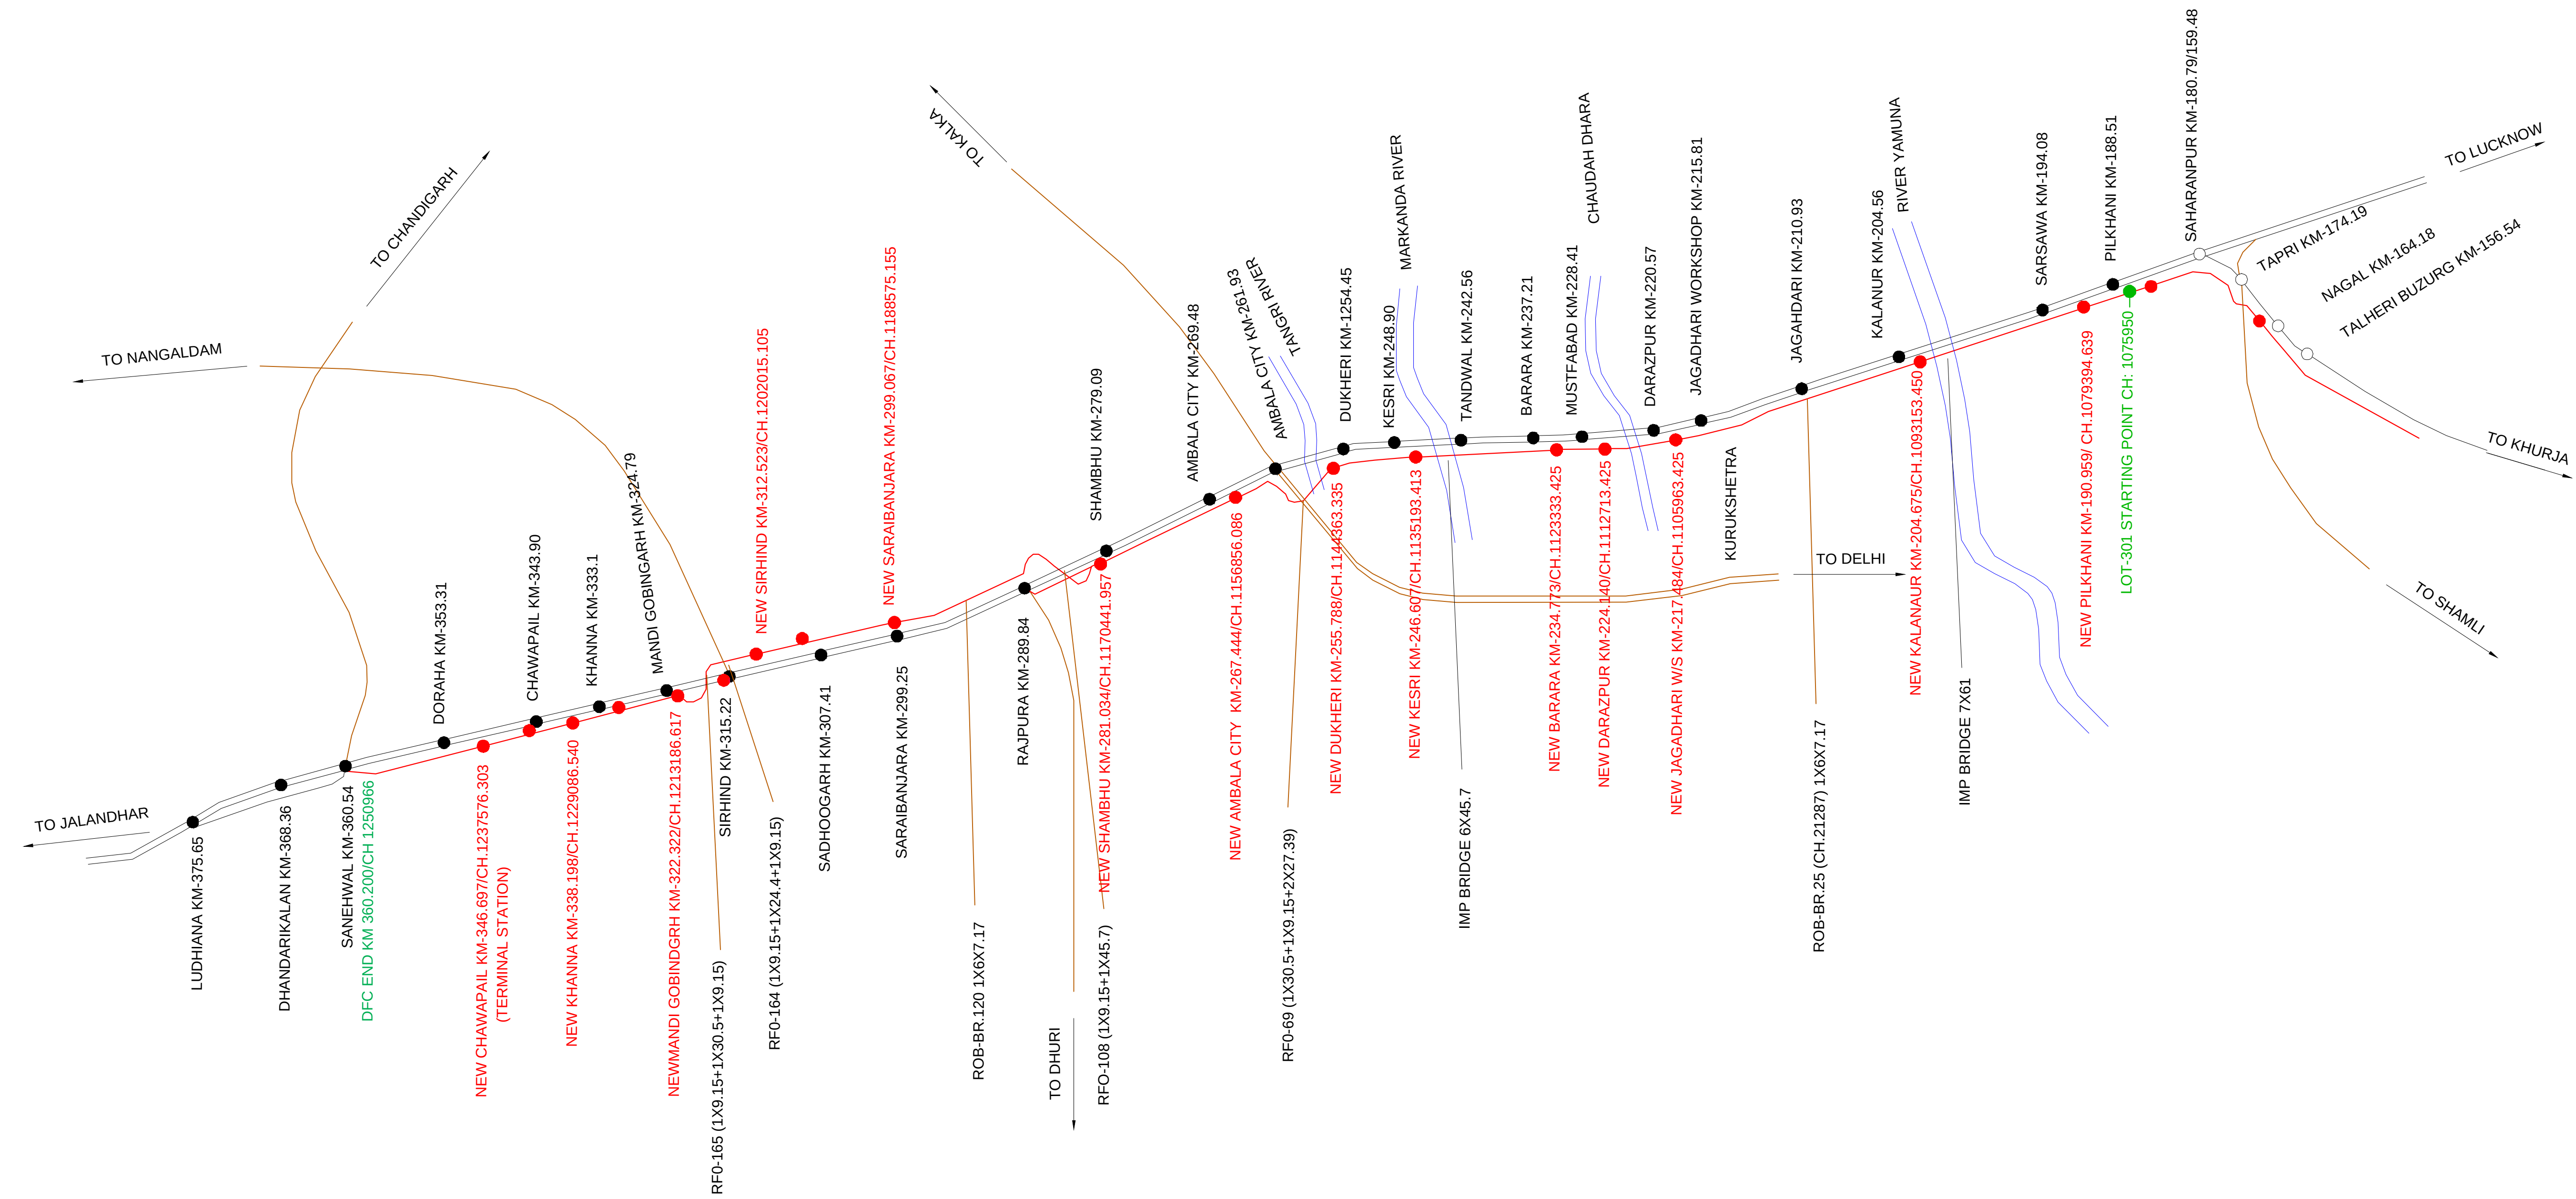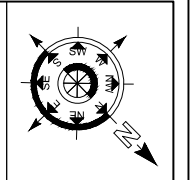


				SCALE	DESIGN CONSULTANT	CONTRACTOR	ENGINEER	OWNER	PROJECT	TITLE	DFCC APPR. NO. -			
				NOT TO SCALE	 aarvee associates architects engineers & consultants Pvt.Ltd.	 GIL - TPL JV	 DB Engineering & Consulting GmbH	 महामार्ग विकास निगम	DEDICATED FREIGHT CORRIDOR CORPORATION OF INDIA LTD. (A GOVERNMENT OF INDIA ENTERPRISE) PROJECT OFFICE(AMBALA UNIT): OLD RAILWAY COLONY (NEAR ANAND MARKET),AMBALA CANTT-133001. CORPORATE IDENTITY NO. : U60232DL2006GOI155068	EASTERN DEDICATED FREIGHT CORRIDOR SAHNEWAL TO PILKHANI CONTRACT PACKAGE - 301	ALIGNMENT DRAWINGS KEY PLAN	ENGG. APPR. NO. -		
												DRG. NO. - 301-2/AL/0001		
												SHEET NO.: 1 OF 1		
REV.	DATE	REVISION DETAILS		PURPOSE OF ISSUE								DATE: 15-06-2024	REV. NO. 0	STATUS A

LEGEND	
EXISTING IR TRACK	
DFC TRACK	
DFC FUTURE PROPOSALS	
IR PROPOSALS	
TOE LINE	
FORMATION CESS	
RETAINING WALL	
DRAIN CUM RETAINING WALL	
ROAD	
STREAM, DRAIN, NALA, CANAL.	
FENCE	
POWER LINES	
GPS POINTS	
ELECTRIC POLE/OHE MAST	
EXISTING RAILWAY BOUNDARY	
DFC BOUNDARY	
DISMANTLED WORKS	
IOCL PIPE LINE	
IOCL ROW	
SIGNALLING CABLE PIPE	

ABBREVIATIONS		
1.	BL	- BED LEVEL
2.	BVC	- BEGIN OF VERTICAL CURVE
3.	Ca	- APPLIED CANT
4.	CCL	- CIRCULAR CURVE LENGTH
5.	CTP1	- COMMON TANGENT POINT
6.	CTP2	- COMMON TANGENT POINT
7.	DEGREE	- DEGREE OF CURVE
8.	DE	- DEAD END
9.	ECL	- EXISTING CLEARANCE
10.	EFB	- EXISTING FREE BOARD
11.	EFL	- EXISTING FORMATION LEVEL
12.	ERL	- EXISTING RAIL LEVEL
13.	ESL	- EXISTING SOFFIT LEVEL
14.	EVC	- END OF VERTICAL CURVE
15.	EVCL	- EXISTING VERTICAL CLEARANCE
16.	F/CSB	- FROM CENTER LINE OF STN BLDG
17.	FM	- FOULING MARK
18.	FSL	- FULL SUPPLY LEVEL
19.	HFL	- HIGH FLOOD LEVEL
20.	L	- STRAIGHT LENGTH
21.	LH	- LEFT HANDED
22.	LHS	- LIMITED HEIGHT SUBWAY
23.	PCL	- PROPOSED CLEARANCE
24.	PFB	- PROPOSED FREE BOARD
25.	PFL	- PROPOSED FORMATION LEVEL
26.	PRL	- PROPOSED RAIL LEVEL
27.	PSL	- PROPOSED SOFFIT LEVEL
28.	PVCL	- PROPOSED VERTICAL CLEARANCE
29.	PVI	- POINT OF VERTICAL INTERSECTION
30.	R	- RADIUS
31.	REV.BL	- REVISED BED LEVEL
32.	RH	- RIGHT HANDED
33.	Rr	- RESULTANT RADIUS
34.	SE	- SUPER ELEVATION
35.	SRJ	- STOCK RAIL JOINT
36.	TS	- TRAP SWITCH
37.	TTL	- TOTAL TANGENT LENGTH
38.	TTP1	- TRANSITION TANGENT POINT
39.	TTP2	- TRANSITION TANGENT POINT
40.	TL	- TRANSITION LENGTH
41.	DELTA	- DEFLECTION ANGLE

				SCALE	DESIGN CONSULTANT	CONTRACTOR	ENGINEER	OWNER	PROJECT	TITLE	DFCC APPR. NO. -					
				NOT TO SCALE	 aarvee associates architects engineers & consultants pvt.ltd.	  GIL - TPL JV	 DB Engineering & Consulting GmbH	 मेडीकेटर फ्रेट कॉर्पोरेश	DEDICATED FREIGHT CORRIDOR CORPORATION OF INDIA LTD. (A GOVERNMENT OF INDIA ENTERPRISE) PROJECT OFFICE(AMBALA UNIT): OLD RAILWAY COLONY (NEAR ANAND MARKET),AMBALA CANTT-133001. CORPORATE IDENTITY NO. : U60232DL2006GOI155068	EASTERN DEDICATED FREIGHT CORRIDOR SAHNEWAL TO PILKHANI CONTRACT PACKAGE - 301	ALIGNMENT DRAWINGS LEGEND AND ABBREVIATIONS	ENG. APPR. NO. -				
																DRG. NO. - 301-2/AL/1000
REV.	DATE	REVISION DETAILS	PURPOSE OF ISSUE								SHEET NO. : 1 OF 1	REV. No.	STATUS			
											DATE : 15-06-2024	0	A			

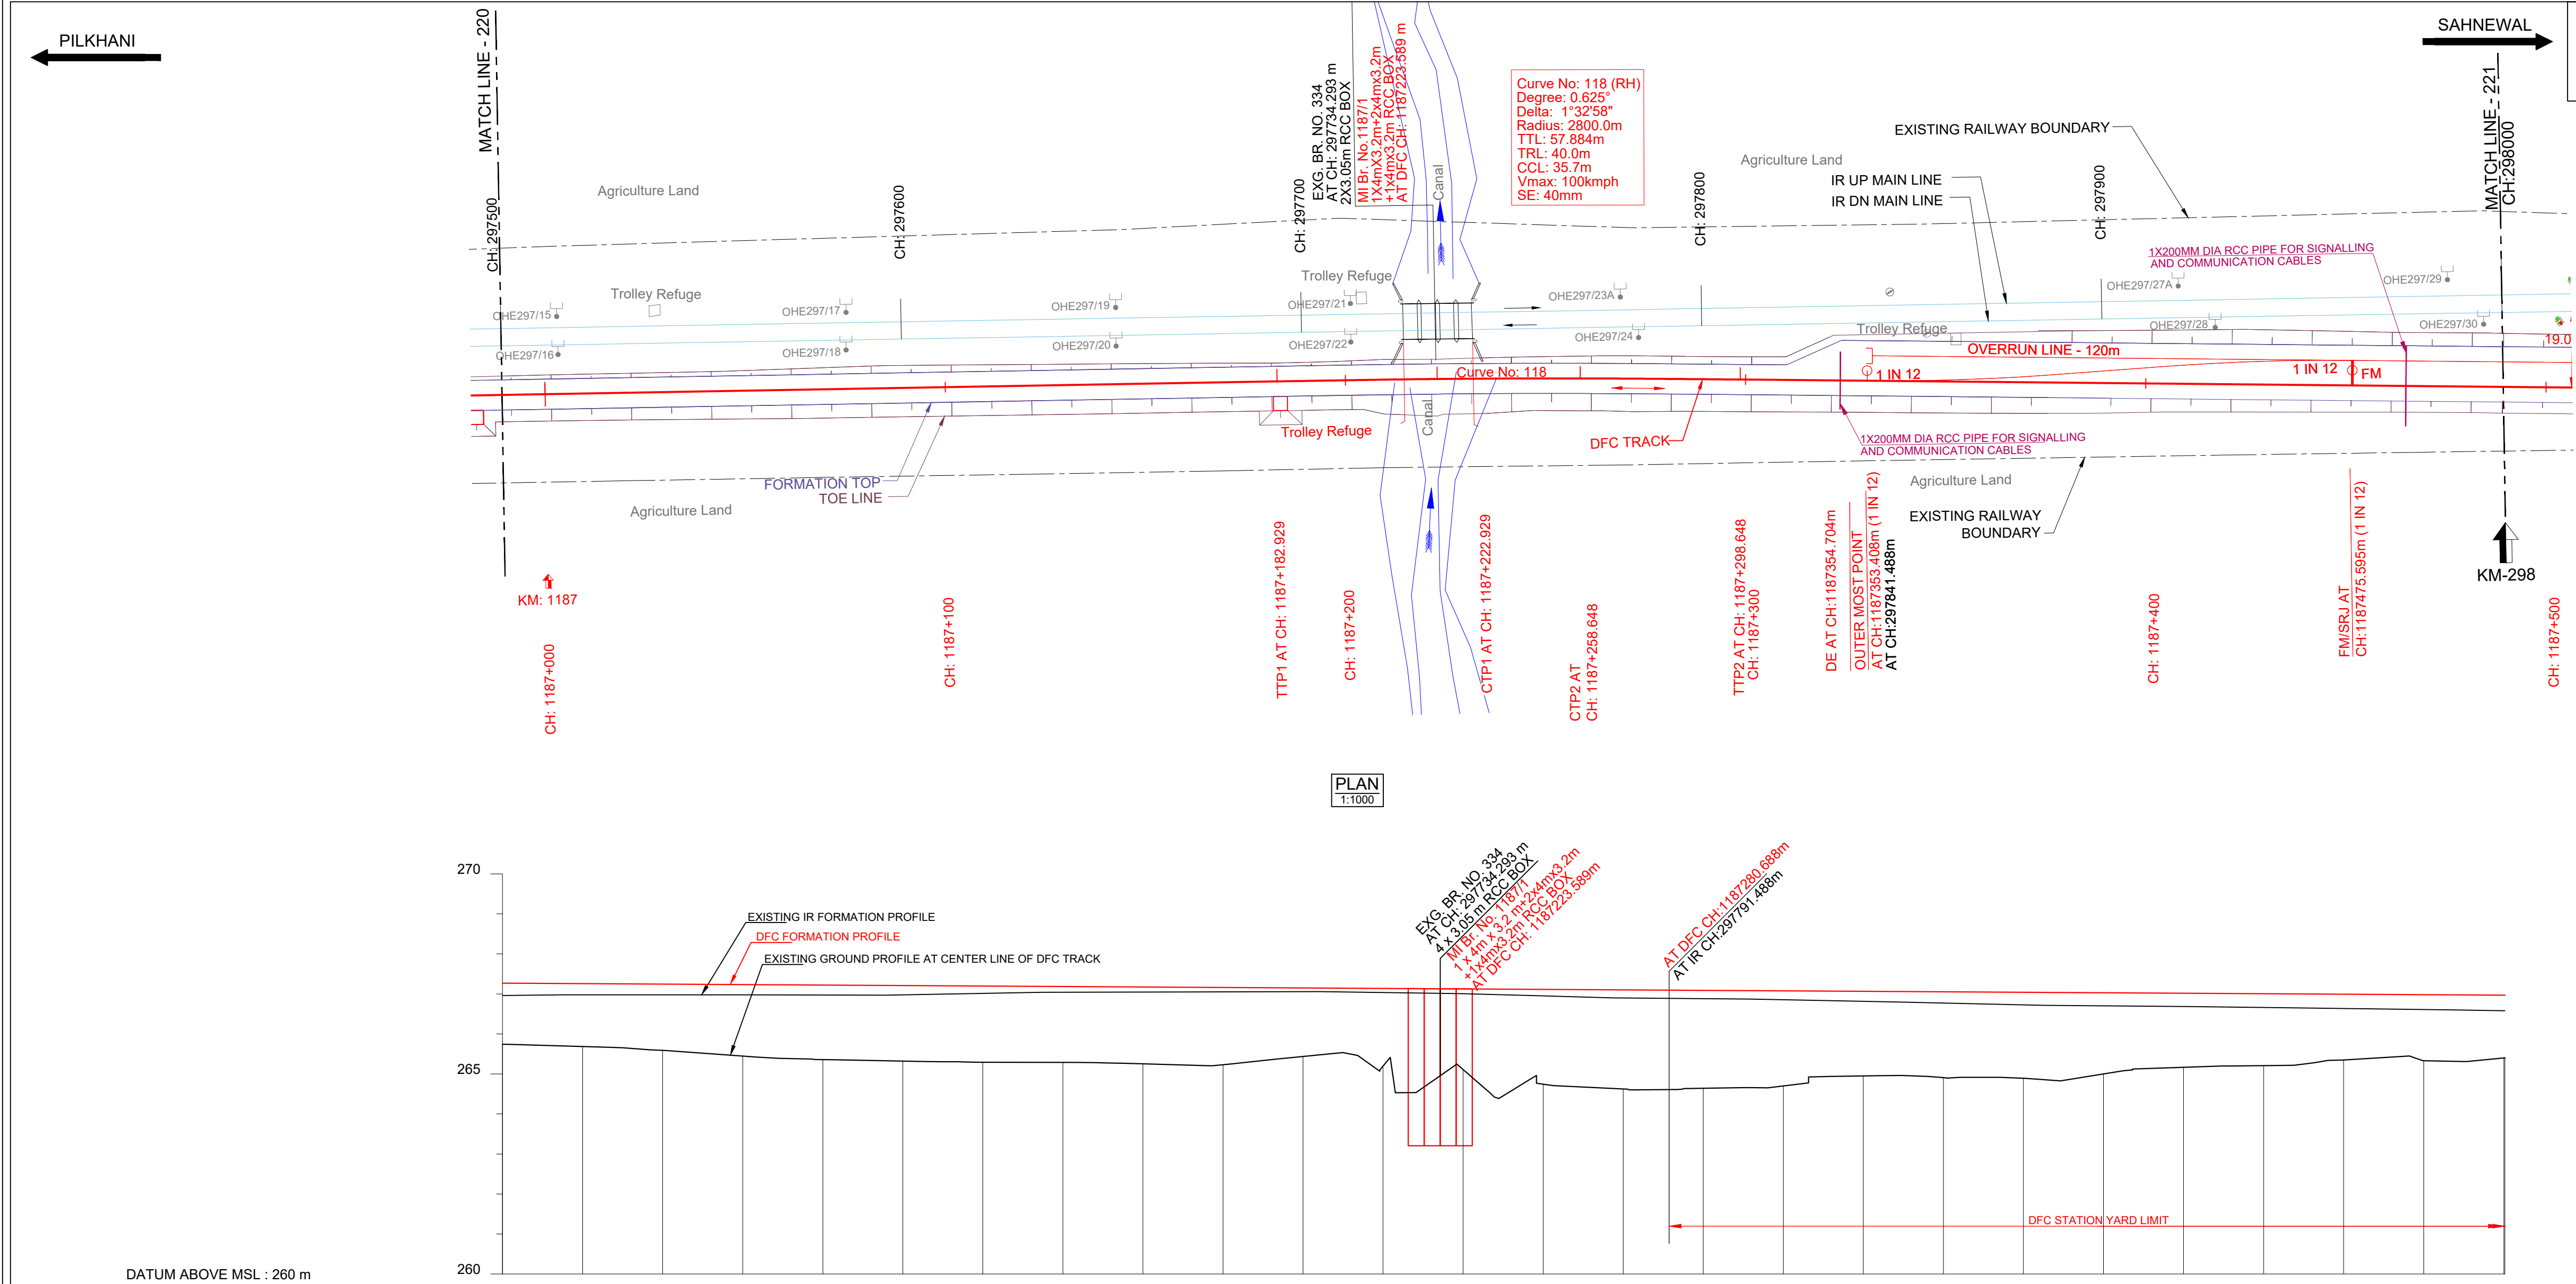

HORIZONTAL ALIGNMENT	L = 5898.430m TL= 40m R=2800m TL= 40m L = 818.516m																			
VERTICAL ALIGNMENT	L=1575.274 m 1 IN 1668.051 F																			
TRACK DISTANCE FROM EXISTING NEAREST IR DN MAIN LINE TO DFC MAIN LINE	12.279	12.264	12.254	12.244	12.243	12.239	12.216	12.195	12.183	12.173	12.165	12.163	12.250	12.504	12.894	13.361	13.876	14.408	15.462	15.982
HEIGHT OF BANKING(+)/ DEPTH OF CUTTING(-) (PFL-GL)	+1.528	+1.574	+1.658	+1.730	+1.863	+1.889	+1.907	+1.899	+1.921	+1.931	+1.713	+1.943	+2.017	+2.369	+2.479	+2.448	+2.379	+2.116	+2.150	+2.031
EXG GROUND LEVEL AT CENTER LINE OF DFC TRACK (GL)	265.743	265.685	265.589	265.445	265.360	265.322	265.292	265.288	265.254	265.232	265.438	265.196	265.110	264.746	264.624	264.643	264.700	264.951	264.893	265.000
EXG GROUND LEVEL AT TOE LOCATION OF DFC TRACK	265.682	265.658	265.586	265.494	265.404	265.380	265.347	265.300	265.278	265.262	265.245	264.892	264.506	264.889	264.788	264.832	264.862	264.895	264.916	265.032
DIFFERENCE BETWEEN DFC FORMATION LEVEL AND EXG.FORMATION LEVEL(PFL-EFL)	0.309	0.282	0.270	0.258	0.249	0.232	0.184	0.144	0.126	0.110	0.094	0.103	0.121	0.165	0.205	0.210	0.225	0.253	0.317	0.329
DFC FORMATION LEVEL (PFL)	267.271	267.259	267.247	267.235	267.223	267.211	267.199	267.187	267.175	267.163	267.151	267.139	267.127	267.115	267.103	267.091	267.079	267.067	267.043	267.031
EXG. FORMATION LEVEL OF EXG IR DN MAIN LINE (EFL)	266.978	266.993	266.993	266.993	266.990	266.995	267.031	267.059	267.065	267.069	267.073	267.052	267.022	266.966	266.914	266.897	266.870	266.830	266.742	266.718
DIFFERENCE BETWEEN DFC RAIL LEVEL AND EXG. RAIL LEVEL (PRL - ERL)	0.333	0.306	0.294	0.282	0.273	0.256	0.208	0.168	0.151	0.134	0.118	0.128	0.145	0.189	0.229	0.234	0.249	0.277	0.342	0.353
DFC RAIL LEVEL (PRL)	267.983	267.971	267.959	267.947	267.935	267.923	267.911	267.899	267.887	267.875	267.883	267.851	267.839	267.827	267.815	267.803	267.791	267.779	267.755	267.743
EXG.RAIL LEVEL OF NEAREST IR DN MAIN LINE(ERL)	267.650	267.665	267.665	267.665	267.662	267.667	267.703	267.731	267.737	267.741	267.745	267.724	267.694	267.638	267.586	267.569	267.542	267.502	267.414	267.390
EQUIVALENT CHAINAGE ON DFC TRACK	1186989.2	1187009.2	1187029.2	1187049.2	1187069.2	1187089.2	1187109.2	1187129.2	1187149.2	1187169.2	1187189.2	1187209.2	1187229.2	1187249.2	1187269.2	1187289.2	1187309.2	1187329.2	1187349.2	1187369.2
EXISTING IR CHAINAGE	297500.0	297520.0	297540.0	297560.0	297580.0	297600.0	297620.0	297640.0	297660.0	297680.0	297700.0	297720.0	297740.0	297760.0	297780.0	297800.0	297820.0	297840.0	297860.0	297880.0

NOTE:-

- DFCC WORKS ARE SHOWN IN RED.
- IR NEW WORKS ARE SHOWN IN VIOLET.
- ALL DIMENSIONS ARE SHOWN IN METRES.
- THIS DRAWING IS PREPARED BASED ON LATEST SURVEY DATA HELD ON APRIL-2022. GTS BENCH MARK OF 261.850M CONSIDERED ON TOP OF CANAL BRIDGE ABUTMENT AT DORAHA VILLAGE ALONG THE NH1.
- DFC NEW CHAINAGE OF 1075.950M IS WITH REFERENCE TO THE IR KM OF 187.500KM END OF KM OF CP-303(SECTION P-3 PILKHANI END) AGAINST THE EXISTING DFC CHAINAGE. 116277.742M ISSUED VIDE LETTER NO. COM/DFCC/MB/SURVEY/2021-301-230116-011173.DT. 17.01.2023.
- BALLAST PROFILE HAS BEEN PROVIDED ACCORDING TO THE CLAUSE 1.11.3 OF STANDARD SCHEDULE OF DIMENSION(EASTERN CORRIDOR) & THE BALLAST CUSHION DIMENSION SHOWN IN 35CM ON GE-14 PARA 17. SPECIFICATIONS & RECOMMENDATIONS 2. TWO LAYER SYSTEM FIG.10.

REFERENCE DRAWINGS :-

- FOR KEY PLAN REFER DRAWING NO. 301-2/AL/0001
- FOR LEGEND AND ABBREVIATIONS REFER DRAWING NO. 301-2/AL/1000
- FOR TYPICAL SECTION OF BALLAST PROFILE (FL-RL) REFER DRG. NO. 301-2/TK/TFD/-004 (TR.1952)

0	09.09.2024	SUBMISSION OF AS-BUILT DRAWING	FOR APPROVAL
REV.	DATE	REVISION DETAILS	PURPOSE OF ISSUE

LEGEND:

IR TRACK
DFCC TRACK
DFCC FUTURE PROPOSALS
STRUCTURE / BUILDING
DFCC TOE LINE
DFCC FORMATION
RETAINING WALL
ROAD
STREAM, DRAIN, NALA, CANAL.
FENCE
POWER LINES
TBM
ELECTRIC POLE/OHE MAST
IR RAILWAY BOUNDARY
DFCC BOUNDARY

SCALE

HOR - 1:1000
VER - 1:100
SHEET SIZE : A1

TYPICAL SECTION

TRACK STRUCTURE		
RAIL SECTION: 60Kg/m (UIC 60Kg/m) DFC LINE: 60Kg/m (UIC 60Kg/m) IR MAIN LINE: 52Kg/m	Difference between FL- RL (Below Rail Seat)	
	IR Line	DFC
RUBBER PAD	172mm	172mm
SLEEPER DEPTH	210mm	210mm
BALLAST CUSHION	300mm	350mm
Total Depth (FL TO RL)	688mm	742mm

OWNER

DEDICATED FREIGHT CORRIDOR CORPORATION OF INDIA LTD.
(A GOVERNMENT OF INDIA ENTERPRISE)
PROJECT OFFICE(AMBALA UNIT): OLD RAILWAY COLONY (NEAR ANAND MARKET),AMBALA CANTT-133001.
CORPORATE IDENTITY NO. : U60232DL2006GGI155068

ENGINEER:

DB Engineering & Consulting GmbH
Deutsche Bahn Engineering & Consulting GmbH

CONTRACTOR:

GIL - TPL JV
GAR TATA

SUBMITTED BY	GIL - TPL JV		
	DATED	NAME	SIGNATURE
PREPARED BY			
CHECKED BY	09.09.2024	VIJAY PRATAP	
APPROVED BY	09.09.2024	PARASURAM KOTYADA	

APPROVED BY	DEUTSCHE BAHN ENGINEERING & CONSULTING GMBH		
	DATED	NAME	SIGNATURE
Sr. DE./CHIEF ENGINEER		SURESH K.YALANGI	
CHIEF TRACK ENGINEER		RAJ PAL SINGH	
T.L.		H.D. VIDJAK	

STAMP

A AS-BUILT DRAWING
TR. Ref.:.....
ENGINEER Sign.:.....

EMPLOYER (DFCCIL): DEDICATED FREIGHT CORRIDOR CORPORATION OF INDIA LTD.

AS BUILT DRAWING



TITLE AS-BUILT PLAN AND PROFILE

DFCC APPR. NO. -
ENGG. APPR. NO. -
DRG. NO. -301-2/AL/A/1221
SHEET NO.: 1 OF 1
DATE: 09.09.2024


STATUS A

FROM IR KM: 297.500 TO 298.000
DFC KM: 1186.989 TO 1187.489

TR.

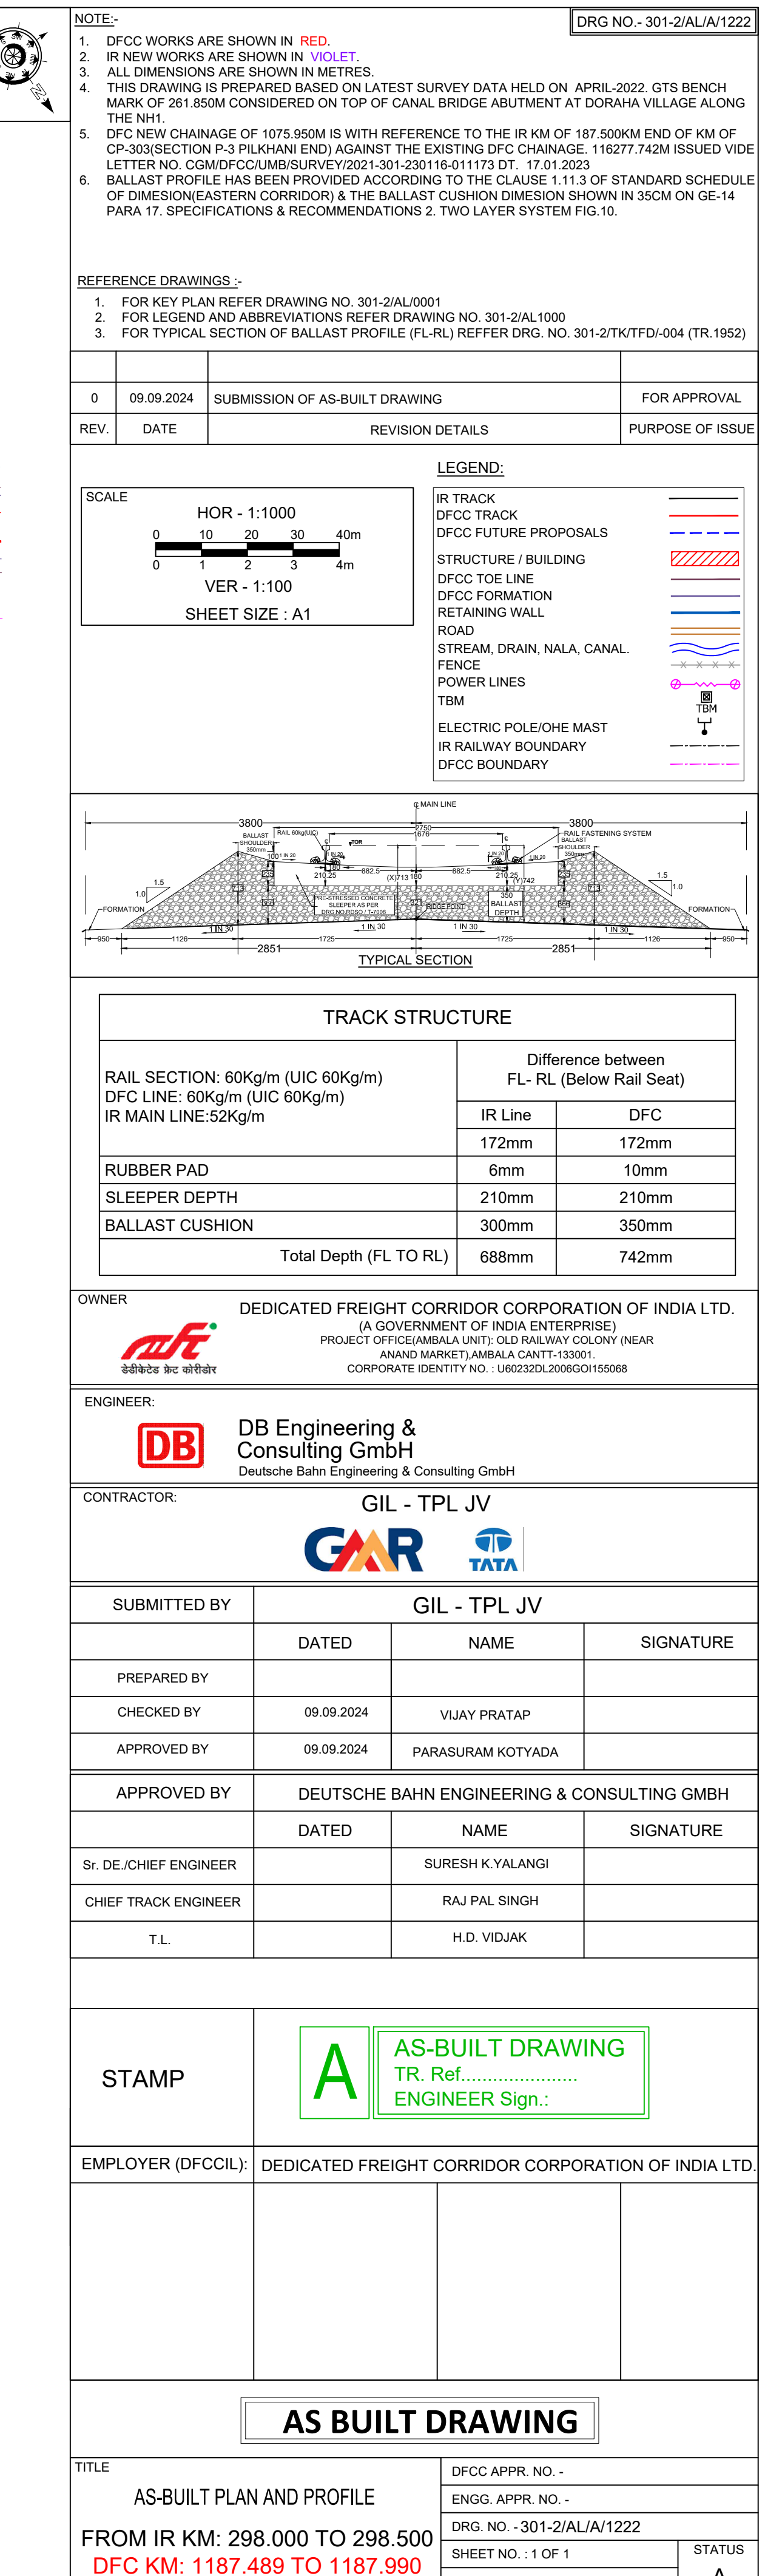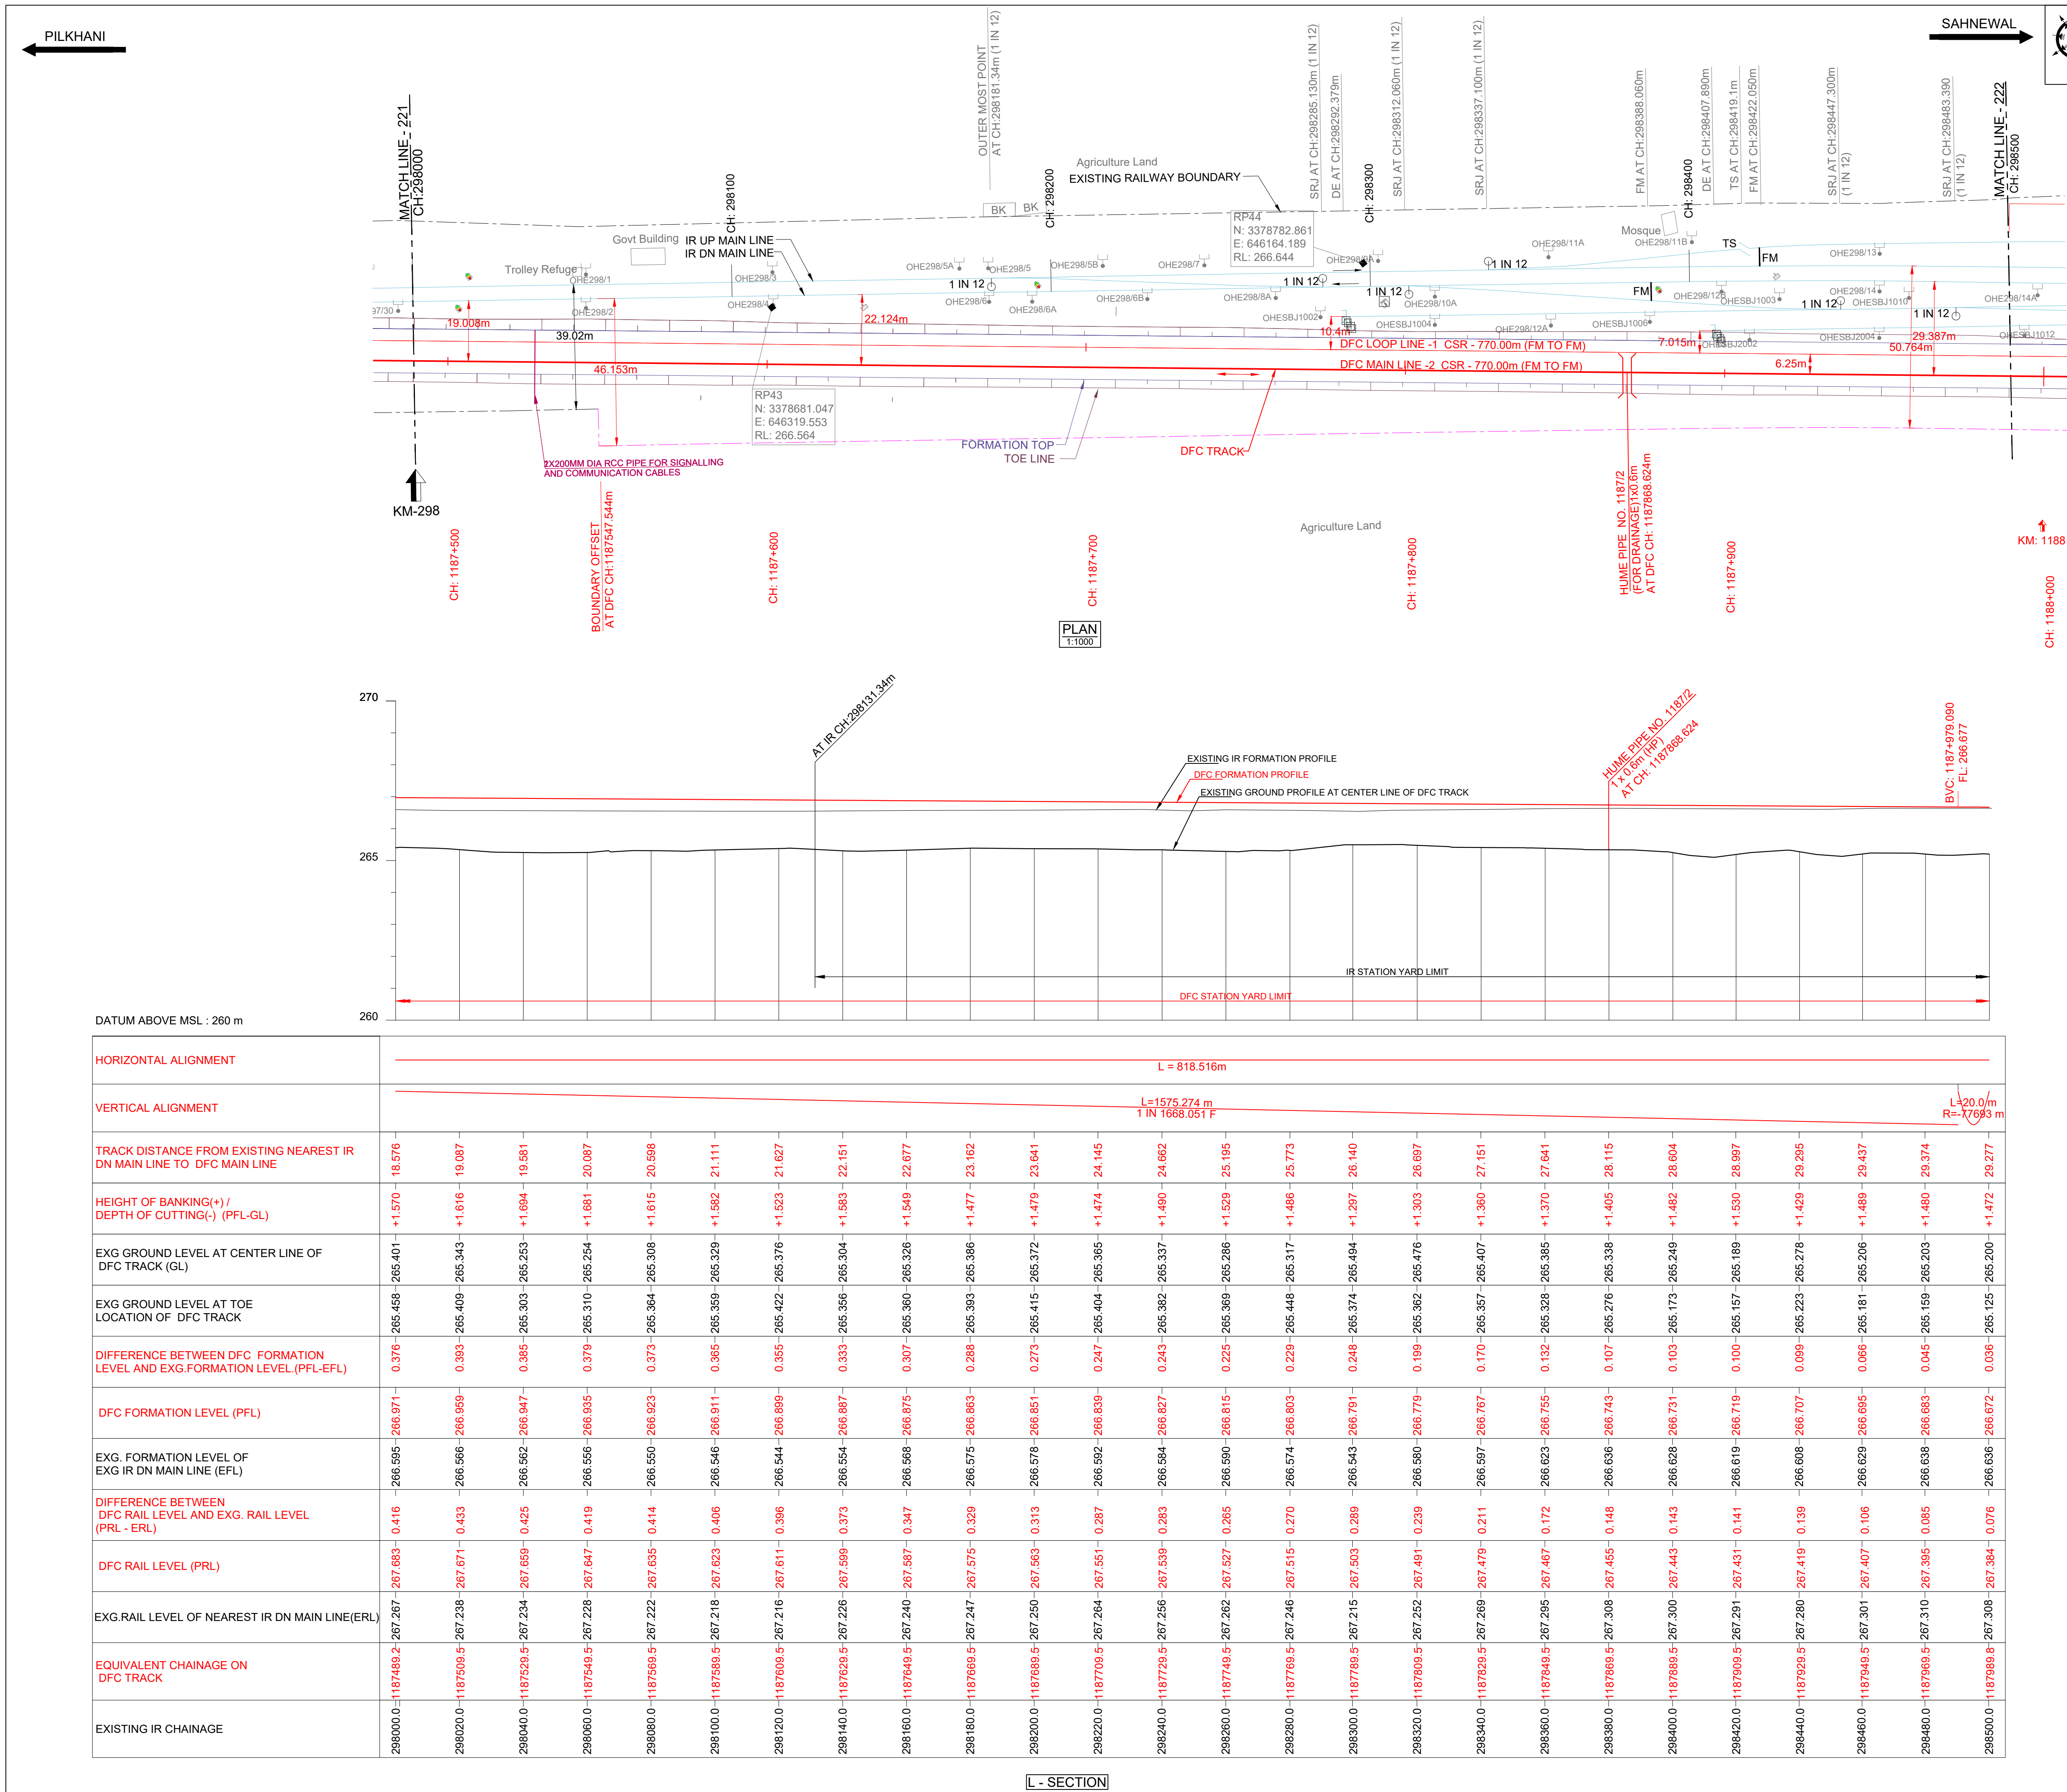

PILKHANI

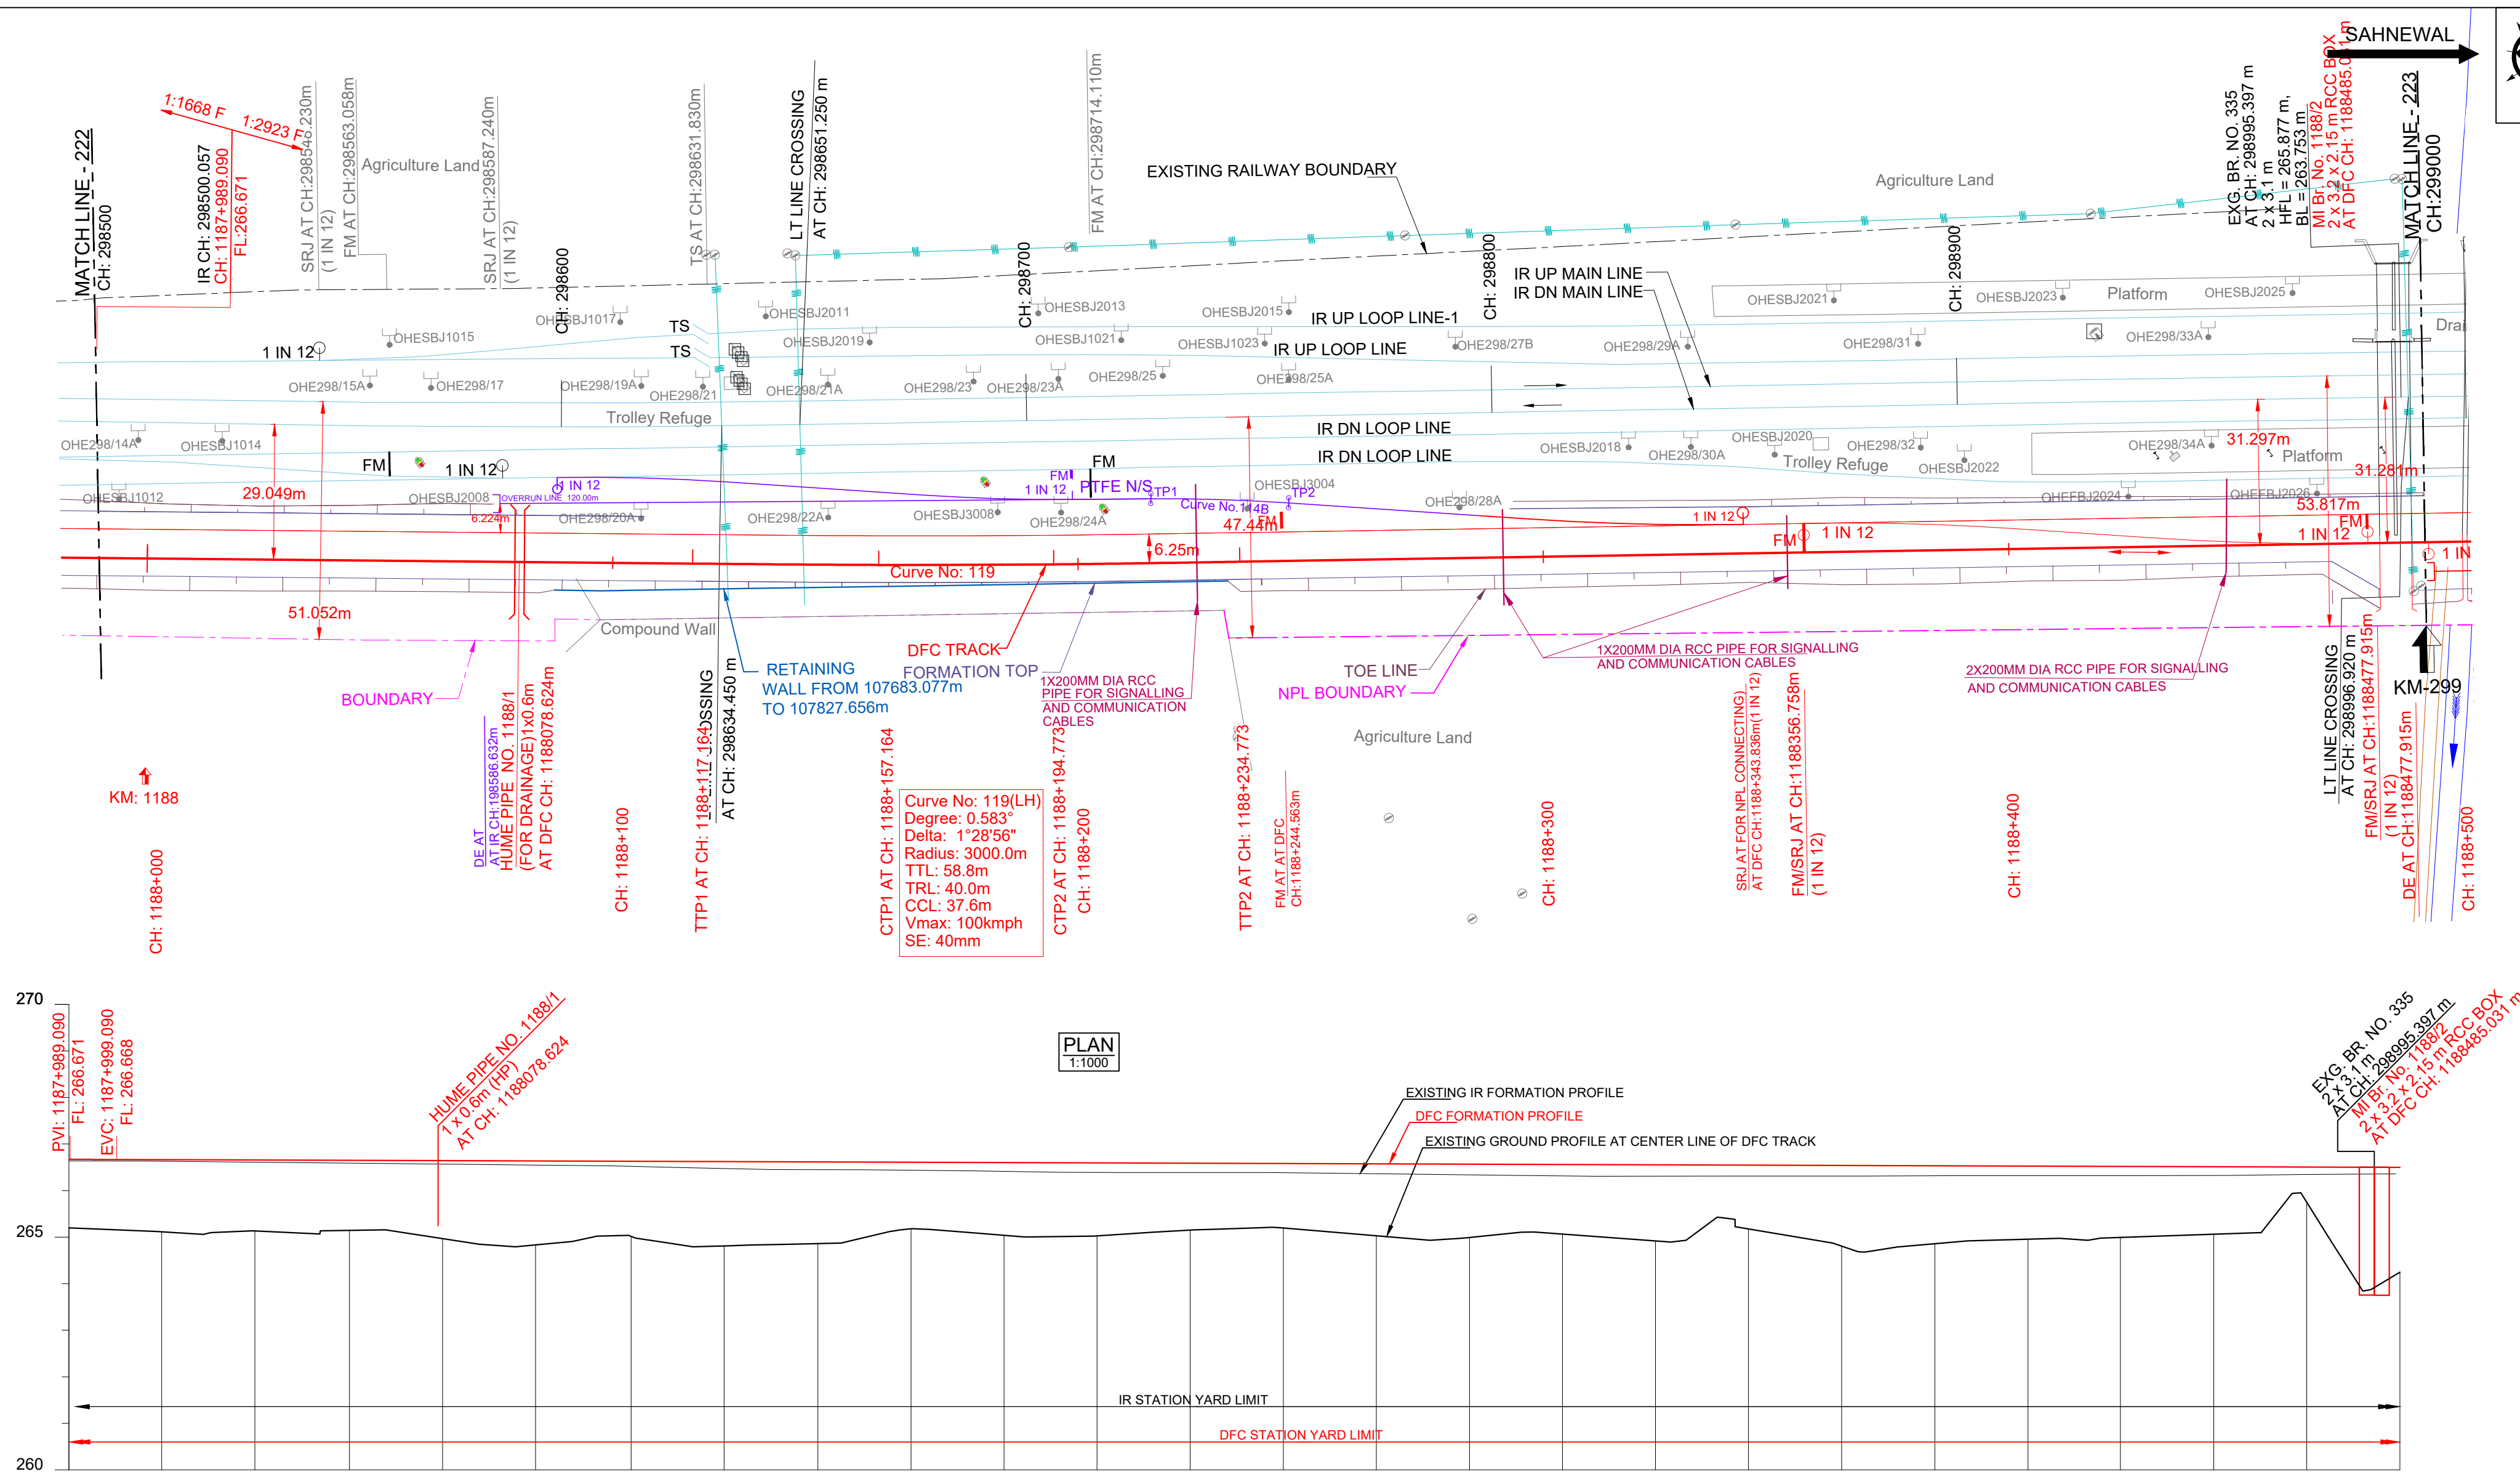

PLAN
1:1000

EXISTING IR FORMATION PROFILE
DFC FORMATION PROFILE
EXISTING GROUND PROFILE AT CENTER LINE OF DFC TRACK

IR STATION YARD LIMIT
DFC STATION YARD LIMIT

L - SECTION

DATUM ABOVE MSL : 260 m

HORIZONTAL ALIGNMENT	L = 818.516m TL= 40m R = -3000m TL= 40m L = 1484.776m																			
VERTICAL ALIGNMENT	L=20.0 m R=-X7693 m L=1002.957 m 1 IN 2923 294 F																			
TRACK DISTANCE FROM EXISTING NEAREST IR DN MAIN LINE TO DFC MAIN LINE	29.277	29.173	29.032	28.912	28.813	28.715	28.618	28.521	28.424	28.327	28.230	28.133	28.036	27.939	27.842	27.745	27.648	27.551	27.454	27.357
HEIGHT OF BANKING(+) / DEPTH OF CUTTING(-) (PFL-GL)	+1.472	+1.549	+1.525	+1.507	+1.675	+1.675	+1.804	+1.613	+1.811	+1.755	+1.430	+1.562	+1.567	+1.386	+1.545	+1.575	+1.497	+1.571	+1.452	+0.761
EXG GROUND LEVEL AT CENTER LINE OF DFC TRACK (GL)	265.200	265.115	265.133	265.144	264.969	264.833	264.833	264.959	264.812	264.861	265.045	265.040	265.029	265.196	265.030	264.993	265.055	264.956	265.062	265.746
EXG GROUND LEVEL AT TOE LOCATION OF DFC TRACK	265.125	265.024	265.058	265.139	265.156	265.106	265.106	264.959	264.800	264.916	265.045	265.002	264.957	265.122	264.985	264.976	265.055	264.827	264.980	264.980
DIFFERENCE BETWEEN DFC FORMATION LEVEL AND EXG FORMATION LEVEL (PFL-EFL)	0.036	0.034	0.049	0.062	0.076	0.090	0.090	0.109	0.147	0.168	0.173	0.189	0.205	0.198	0.213	0.228	0.243	0.207	0.190	0.163
DFC FORMATION LEVEL (PFL)	266.672	266.664	266.658	266.651	266.644	266.637	266.637	266.630	266.623	266.616	266.609	266.602	266.596	266.582	266.575	266.568	266.561	266.527	266.520	266.507
EXG. FORMATION LEVEL OF EXG IR DN MAIN LINE (EFL)	266.636	266.630	266.609	266.589	266.568	266.547	266.547	266.521	266.476	266.448	266.436	266.413	266.391	266.384	266.362	266.340	266.318	266.320	266.322	266.344
DIFFERENCE BETWEEN DFC RAIL LEVEL AND EXG. RAIL LEVEL (PRL - ERL)	0.076	0.075	0.089	0.102	0.117	0.131	0.131	0.150	0.188	0.209	0.214	0.230	0.246	0.239	0.254	0.269	0.285	0.248	0.231	0.204
DFC RAIL LEVEL (PRL)	267.384	267.377	267.370	267.363	267.356	267.350	267.350	267.343	267.336	267.320	267.322	267.315	267.309	267.295	267.288	267.281	267.274	267.240	267.233	267.227
EXG. RAIL LEVEL OF NEAREST IR DN MAIN LINE (ERL)	267.308	267.302	267.281	267.261	267.240	267.219	267.219	267.193	267.148	267.120	267.108	267.085	267.063	267.056	267.034	267.012	266.990	266.992	266.994	266.996
EQUIVALENT CHAINAGE ON DFC TRACK	298500.0	298520.0	298540.0	298560.0	298580.0	298600.0	298620.0	298640.0	298660.0	298680.0	298700.0	298720.0	298740.0	298760.0	298780.0	298800.0	298820.0	298840.0	298860.0	298880.0
EXISTING IR CHAINAGE	298500.0	298520.0	298540.0	298560.0	298580.0	298600.0	298620.0	298640.0	298660.0	298680.0	298700.0	298720.0	298740.0	298760.0	298780.0	298800.0	298820.0	298840.0	298860.0	298880.0

NOTE:-

- DFCC WORKS ARE SHOWN IN RED.
- IR NEW WORKS ARE SHOWN IN VIOLET.
- ALL DIMENSIONS ARE SHOWN IN METRES.
- THIS DRAWING IS PREPARED BASED ON LATEST SURVEY DATA HELD ON APRIL-2022. GTS BENCH MARK OF 261.850M CONSIDERED ON TOP OF CANAL BRIDGE ABUTMENT AT DORANA VILLAGE ALONG THE NH1.
- DFC NEW CHAINAGE OF 1075.950M IS WITH REFERENCE TO THE IR KM OF 187.500KM END OF KM OF CP-303 (SECTION P-3 PILKHANI END) AGAINST THE EXISTING DFC CHAINAGE. 116277.742M ISSUED VIDE LETTER NO. COM/DFCC/UMS/SURVEY/2021-301-2301/16-01/173 DT. 17.01.2023.
- BALLAST PROFILE HAS BEEN PROVIDED ACCORDING TO THE CLAUSE 1.11.3 OF STANDARD SCHEDULE OF DIMENSION (EASTERN CORRIDOR) & THE BALLAST CUSHION DIMENSION SHOWN IN 35CM ON GE-14 PARA 17. SPECIFICATIONS & RECOMMENDATIONS 2. TWO LAYER SYSTEM FIG.10.

REFERENCE DRAWINGS :-

- FOR KEY PLAN REFER DRAWING NO. 301-2/AL/0001
- FOR LEGEND AND ABBREVIATIONS REFER DRAWING NO. 301-2/AL/1000
- FOR TYPICAL SECTION OF BALLAST PROFILE (FL-RL) REFER DRG. NO. 301-2/TK/TFDI-004 (TR.1952)

09.09.2024SUBMISSION OF AS-BUILT DRAWINGFOR APPROVAL

REV. DATE REVISION DETAILS PURPOSE OF ISSUE

SCALE
HOR - 1:1000
VER - 1:100
SHEET SIZE : A1

LEGEND:
IR TRACK
DFCC TRACK
DFCC FUTURE PROPOSALS
STRUCTURE / BUILDING
DFCC TOE LINE
DFCC FORMATION
RETAINING WALL
ROAD
STREAM, DRAIN, NALA, CANAL.
FENCE
POWER LINES
TBM
ELECTRIC POLE/OHE MAST
IR RAILWAY BOUNDARY
DFCC BOUNDARY

TRACK STRUCTURE

RAIL SECTION: 60Kg/m (UIC 60Kg/m)	Difference between FL- RL (Below Rail Seat)	
DFC LINE: 60Kg/m (UIC 60Kg/m)	IR Line	DFC
IR MAIN LINE: 52Kg/m	172mm	172mm
	6mm	10mm
	210mm	210mm
	300mm	350mm
Total Depth (FL TO RL)	688mm	742mm

OWNER

DEDICATED FREIGHT CORRIDOR CORPORATION OF INDIA LTD.
(A GOVERNMENT OF INDIA ENTERPRISE)
PROJECT OFFICE (AMBALA UNIT): OLD RAILWAY COLONY (NEAR ANAND MARKET), AMBALA CANTT-133001.
CORPORATE IDENTITY NO. : U60232DL2006GGI155068

ENGINEER:

DB Engineering & Consulting GmbH
Deutsche Bahn Engineering & Consulting GmbH

CONTRACTOR:

GIL - TPL JV
GAR TATA

SUBMITTED BY	GIL - TPL JV		
	DATED	NAME	SIGNATURE
PREPARED BY			
CHECKED BY	09.09.2024	VIJAY PRATAP	
APPROVED BY	09.09.2024	PARASURAM KOTYADA	
APPROVED BY	DEUTSCHE BAHN ENGINEERING & CONSULTING GMBH		
	DATED	NAME	SIGNATURE
Sr. DE./CHIEF ENGINEER		SURESH K.YALANGI	
CHIEF TRACK ENGINEER		RAJ PAL SINGH	
T.L.		H.D. VIDJAK	

STAMP

A AS-BUILT DRAWING
TR. Ref.:.....
ENGINEER Sign.:.....

EMPLOYER (DFCCIL):

DEDICATED FREIGHT CORRIDOR CORPORATION OF INDIA LTD.

AS BUILT DRAWING


AS-BUILT PLAN AND PROFILE

FROM IR KM: 298.500 TO 299.000
DFC KM: 1187.990 TO 1188.490

DFCC APPR. NO. -
ENGG. APPR. NO. -
DRG. NO. - 301-2/AL/A/1223
SHEET NO. : 1 OF 1
DATE : 09.09.2024

STATUS
A

TR.

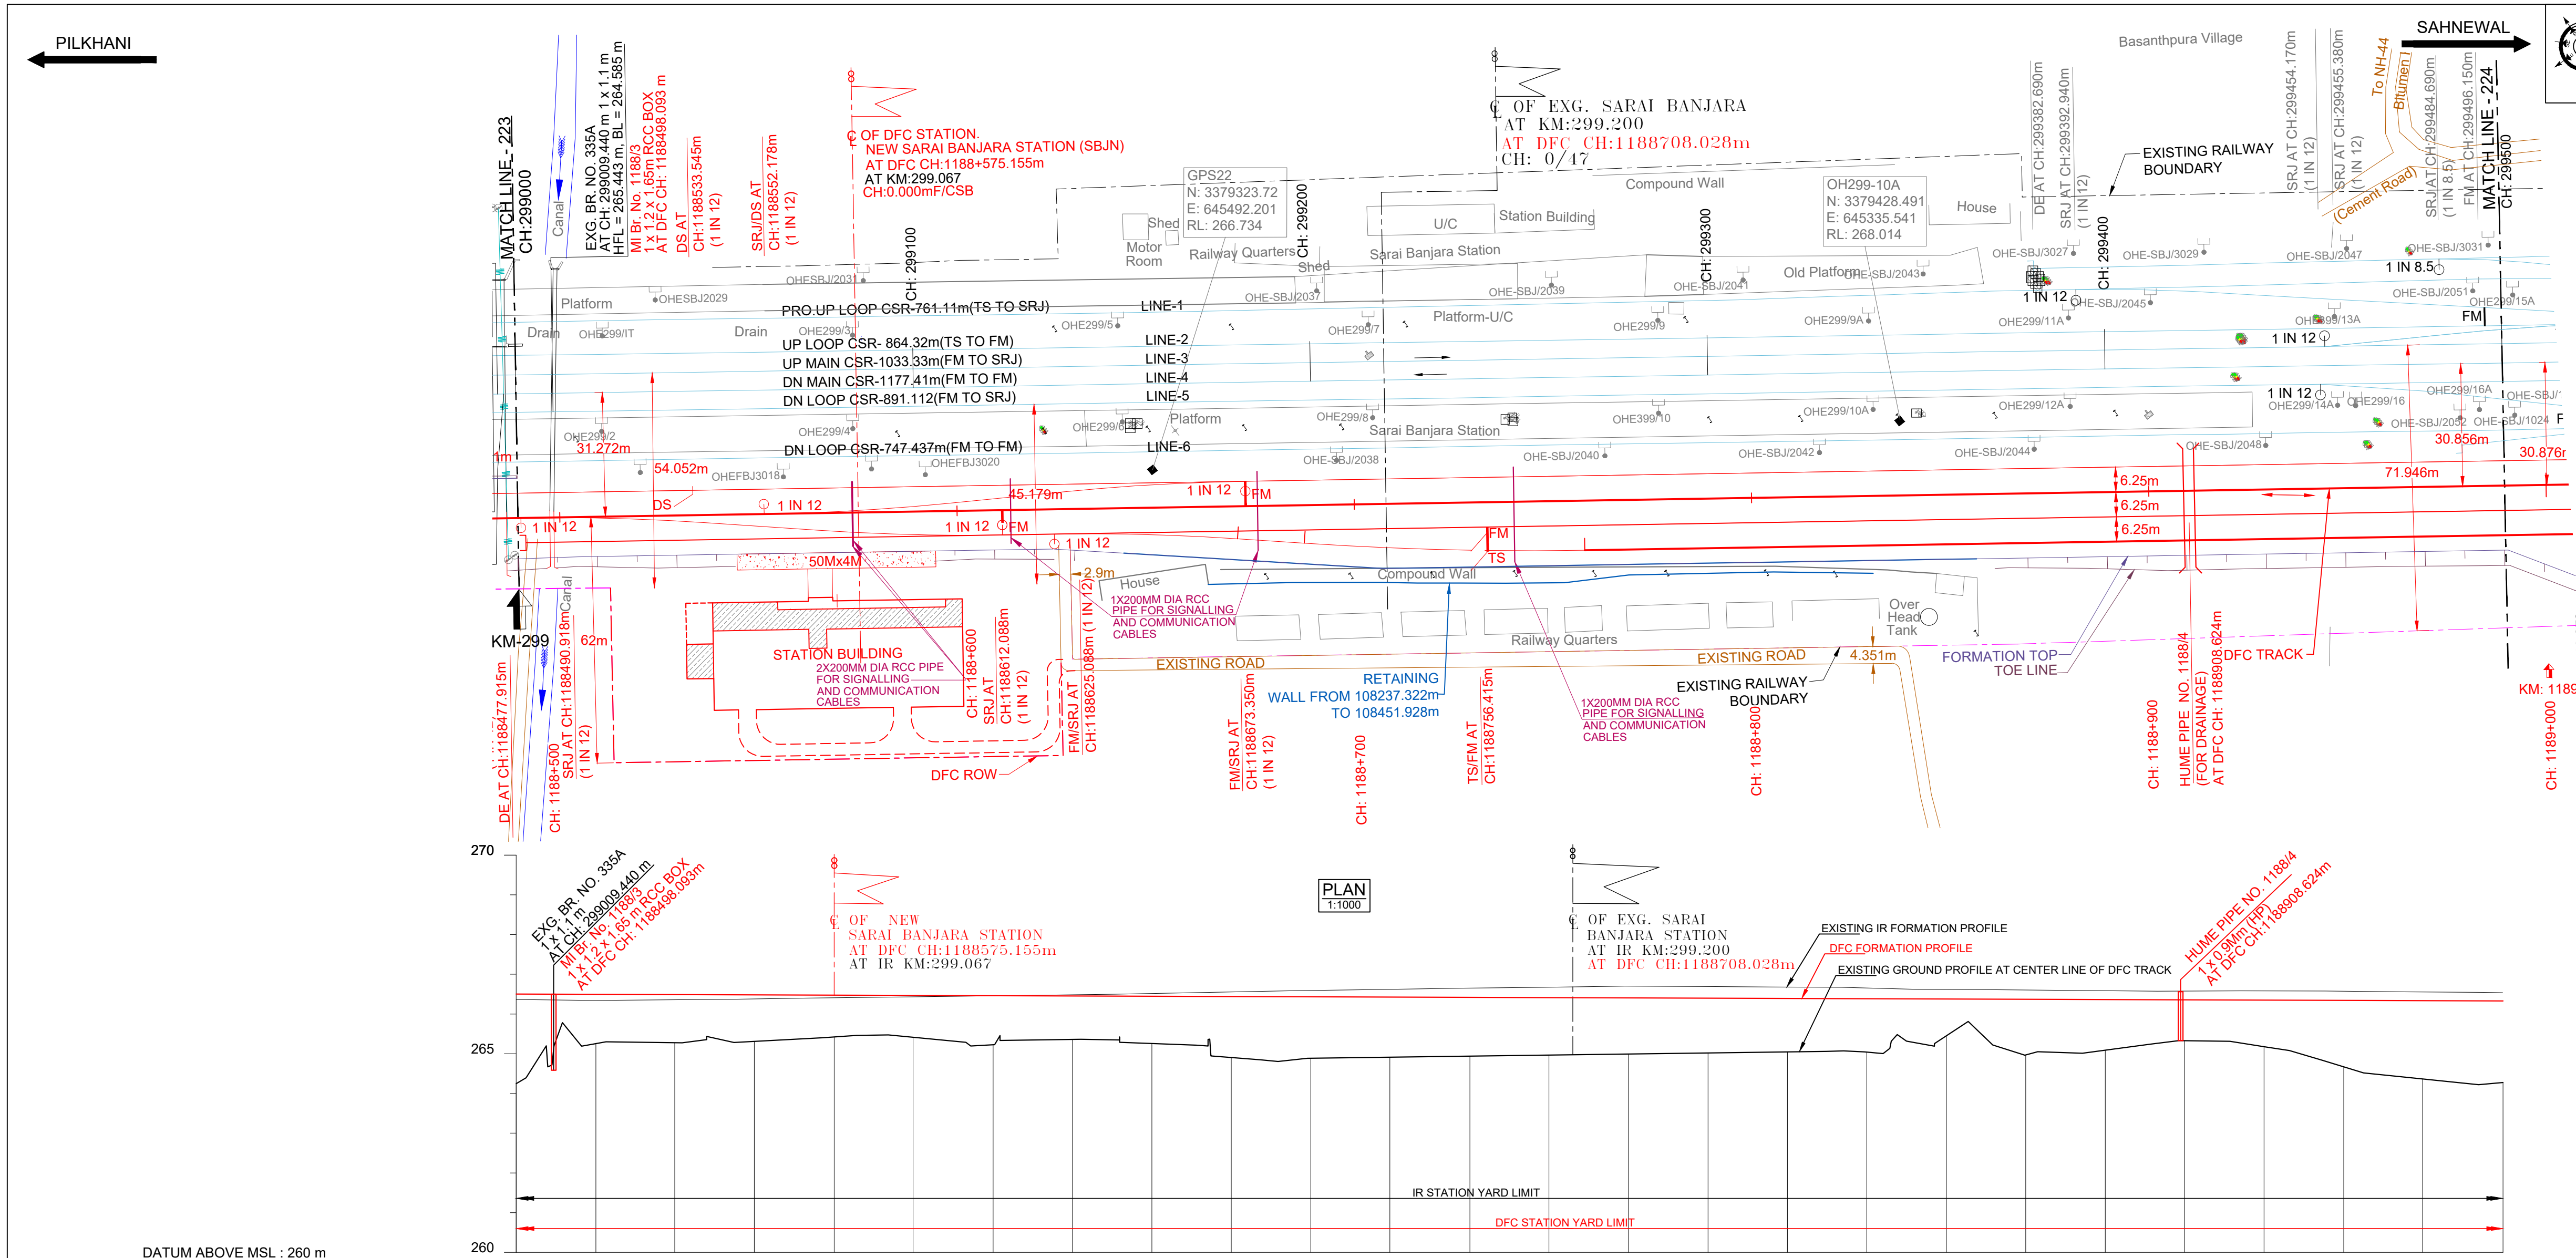

DATUM ABOVE MSL : 260 m

HORIZONTAL ALIGNMENT	L = 1484.776m																									
VERTICAL ALIGNMENT	L=1002.957 m 1 IN 2923.294 F																									
TRACK DISTANCE FROM EXISTING NEAREST IR DN MAIN LINE TO DFC MAIN LINE	31.280	31.231	31.260	31.216	31.201	31.203	31.171	31.199	31.212	31.207	31.197	31.186	31.143	31.168	31.135	31.114	31.108	31.084	31.056	31.039	31.016	30.987	30.951	30.928	30.904	30.848
HEIGHT OF BANKING(+) / DEPTH OF CUTTING(-) (PFL-GL)	+2.255	+1.239	+1.211	+1.169	+1.051	+1.053	+1.235	+1.091	+1.188	+1.532	+1.546	+1.513	+1.479	+1.445	+1.411	+1.377	+1.343	+1.344	+0.927	+1.401	+1.274	+1.029	+1.172	+1.671	+1.970	+2.055
EXG GROUND LEVEL AT CENTER LINE OF DFC TRACK (GL)	-264.245	-265.254	-265.275	-265.310	-265.421	-265.413	-265.224	-265.361	-265.257	-264.906	-264.885	-264.912	-264.939	-264.966	-264.993	-265.020	-265.047	-265.040	-265.450	-264.969	-265.089	-265.327	-265.177	-264.671	-264.366	-264.274
EXG GROUND LEVEL AT TOE LOCATION OF DFC TRACK	-264.840	-265.087	-264.820	-264.823	-264.779	-264.985	-265.215	-265.042	-265.008	-264.804	-264.465	-264.535	-264.375	-264.434	-264.493	-264.552	-264.613	-264.689	-264.835	-265.011	-264.732	-264.392	-264.427	-264.408	-264.384	-264.303
DIFFERENCE BETWEEN DFC FORMATION LEVEL AND EXG.FORMATION LEVEL (PFL-EFL)	0.139	0.153	0.128	0.101	0.064	0.035	0.002	-0.032	-0.070	-0.116	-0.161	-0.194	-0.234	-0.261	-0.295	-0.293	-0.286	-0.269	-0.240	-0.234	-0.222	-0.220	-0.233	-0.230	-0.217	-0.206
DFC FORMATION LEVEL (PFL)	-266.500	-266.493	-266.486	-266.479	-266.472	-266.466	-266.459	-266.452	-266.445	-266.438	-266.431	-266.425	-266.418	-266.411	-266.404	-266.397	-266.390	-266.384	-266.377	-266.370	-266.363	-266.356	-266.349	-266.342	-266.336	-266.329
EXG. FORMATION LEVEL OF EXG IR DN MAIN LINE (EFL)	-266.361	-266.340	-266.358	-266.378	-266.408	-266.431	-266.457	-266.484	-266.515	-266.554	-266.592	-266.619	-266.652	-266.672	-266.699	-266.690	-266.676	-266.653	-266.617	-266.604	-266.585	-266.576	-266.582	-266.572	-266.553	-266.535
DIFFERENCE BETWEEN DFC RAIL LEVEL AND EXG. RAIL LEVEL (PRL - ERL)	0.180	0.194	0.169	0.142	0.105	0.076	0.043	0.009	-0.029	-0.075	-0.120	-0.154	-0.193	-0.220	-0.254	-0.252	-0.245	-0.229	-0.199	-0.194	-0.181	-0.179	-0.191	-0.188	-0.176	-0.165
DFC RAIL LEVEL (PRL)	-267.213	-267.206	-267.199	-267.192	-267.185	-267.179	-267.172	-267.165	-267.158	-267.151	-267.144	-267.138	-267.131	-267.124	-267.117	-267.111	-267.103	-267.096	-267.09	-267.083	-267.076	-267.069	-267.062	-267.055	-267.049	-267.042
EXG.RAIL LEVEL OF NEAREST IR DN MAIN LINE(ERL)	-267.033	-267.012	-267.030	-267.050	-267.080	-267.103	-267.129	-267.156	-267.187	-267.226	-267.264	-267.291	-267.324	-267.344	-267.371	-267.397	-267.362	-267.348	-267.325	-267.289	-267.276	-267.248	-267.254	-267.244	-267.225	-267.207
EQUIVALENT CHAINAGE ON DFC TRACK	-1188489.7	-1188509.7	-1188529.6	-1188549.6	-1188569.7	-1188589.5	-1188609.7	-1188629.7	-1188649.6	-1188669.6	-1188689.6	-1188709.6	-1188729.7	-1188749.6	-1188769.6	-1188789.6	-1188809.6	-1188829.6	-1188849.6	-1188869.6	-1188889.6	-1188909.6	-1188929.6	-1188949.6	-1188969.5	-1188989.7
EXISTING IR CHAINAGE	299000.0	299020.0	299040.0	299060.0	299080.0	299100.0	299120.0	299140.0	299160.0	299180.0	299200.0	299220.0	299240.0	299260.0	299280.0	299300.0	299320.0	299340.0	299360.0	299380.0	299400.0	299420.0	299440.0	299460.0	299480.0	299500.0

L - SECTION

NOTE:-

- DFCC WORKS ARE SHOWN IN RED.
- IR NEW WORKS ARE SHOWN IN VIOLET.
- ALL DIMENSIONS ARE SHOWN IN METRES.
- THIS DRAWING IS PREPARED BASED ON LATEST SURVEY DATA HELD ON APRIL-2022. GTS BENCH MARK OF 261.850M CONSIDERED ON TOP OF CANAL BRIDGE ABUTMENT AT DORANA VILLAGE ALONG THE NH1.
- DFC NEW CHAINAGE OF 1075.950M IS WITH REFERENCE TO THE IR KM OF 187.500KM END OF KM OF CP-303(SECTION P-3 PILKHANI END) AGAINST THE EXISTING DFC CHAINAGE. 116277.742M ISSUED VIDE LETTER NO. COM/DFCC/UM/SURVEY/2021-301-230116-011173 DT. 17.01.2023.
- BALLAST PROFILE HAS BEEN PROVIDED ACCORDING TO THE CLAUSE 1.11.3 OF STANDARD SCHEDULE OF DIMENSION(EASTERN CORRIDOR) & THE BALLAST CUSHION DIMENSION SHOWN IN 35CM ON GE-14 PARA 17. SPECIFICATIONS & RECOMMENDATIONS 2. TWO LAYER SYSTEM FIG.10.

REFERENCE DRAWINGS :-

- FOR KEY PLAN REFER DRAWING NO. 301-2/AL/0001
- FOR LEGEND AND ABBREVIATIONS REFER DRAWING NO. 301-2/AL/1000
- FOR TYPICAL SECTION OF BALLAST PROFILE (FL-RL) REFER DRG. NO. 301-2/TK/TFD/004 (TR.1952)

09.09.2024

SUBMISSION OF AS-BUILT DRAWING

FOR APPROVAL

REV.

DATE

REVISION DETAILS

PURPOSE OF ISSUE

LEGEND:

IR TRACK

DFCC TRACK

DFCC FUTURE PROPOSALS

STRUCTURE / BUILDING

DFCC TOE LINE

DFCC FORMATION

RETAINING WALL

ROAD

STREAM, DRAIN, NALA, CANAL.

FENCE

POWER LINES

TBM

ELECTRIC POLE/OHE MAST

IR RAILWAY BOUNDARY

DFCC BOUNDARY

SCALE

HOR - 1:1000

VER - 1:100

SHEET SIZE : A1

TYPICAL SECTION

TRACK STRUCTURE

RAIL SECTION: 60Kg/m (UIC 60Kg/m)

DFC LINE: 60Kg/m (UIC 60Kg/m)

IR MAIN LINE: 52Kg/m

Difference between FL- RL (Below Rail Seat)

IR Line

DFC

172mm

172mm

6mm

10mm

210mm

210mm

300mm

350mm

Total Depth (FL TO RL)

688mm

742mm

OWNER

DEDICATED FREIGHT CORRIDOR CORPORATION OF INDIA LTD.

(A GOVERNMENT OF INDIA ENTERPRISE)

PROJECT OFFICE(AMBALA UNIT): OLD RAILWAY COLONY (NEAR ANAND MARKET),AMBALA CANTT.-133001.

CORPORATE IDENTITY NO. : U60232DL2006GGI155068

ENGINEER:

DB Engineering & Consulting GmbH

Deutsche Bahn Engineering & Consulting GmbH

CONTRACTOR:

GIL - TPL JV

GAR

TATA

SUBMITTED BY

GIL - TPL JV

DATED

NAME

SIGNATURE

PREPARED BY

CHECKED BY

APPROVED BY

09.09.2024

VIJAY PRATAP

PARASURAM KOTYADA

APPROVED BY

DEUTSCHE BAHN ENGINEERING & CONSULTING GMBH

DATED

NAME

SIGNATURE

Sr. DE./CHIEF ENGINEER

SURESH K.YALANGI

CHIEF TRACK ENGINEER

RAJ PAL SINGH

T.L.

H.D. VIDJAK

STAMP

A

AS-BUILT DRAWING

TR. Ref:.....

ENGINEER Sign.:.....

EMPLOYER (DFCCIL):

DEDICATED FREIGHT CORRIDOR CORPORATION OF INDIA LTD.

TITLE

AS-BUILT PLAN AND PROFILE

DFCC APPR. NO. -

ENGG. APPR. NO. -

DRG. NO. -301-2/AL/A/1224

SHEET NO.: 1 OF 1

DATE : 09.09.2024

STATUS

A


FROM IR KM: 299.000 TO 299.500

DFC KM: 1188.490 TO 1188.990

TR.



AS BUILT DRAWING			
TITLE AS-BUILT PLAN AND PROFILE FROM IR KM: 299.500 TO 300.000 DFC KM: 1188.990 TO 1189.490	DFCC APPR. NO. -		STATUS A
	ENGG. APPR. NO. -		
	DRG. NO. - 301-2/AL/A/1225		
	SHEET NO. : 1 OF 1		
	DATE : 08.09.2024		

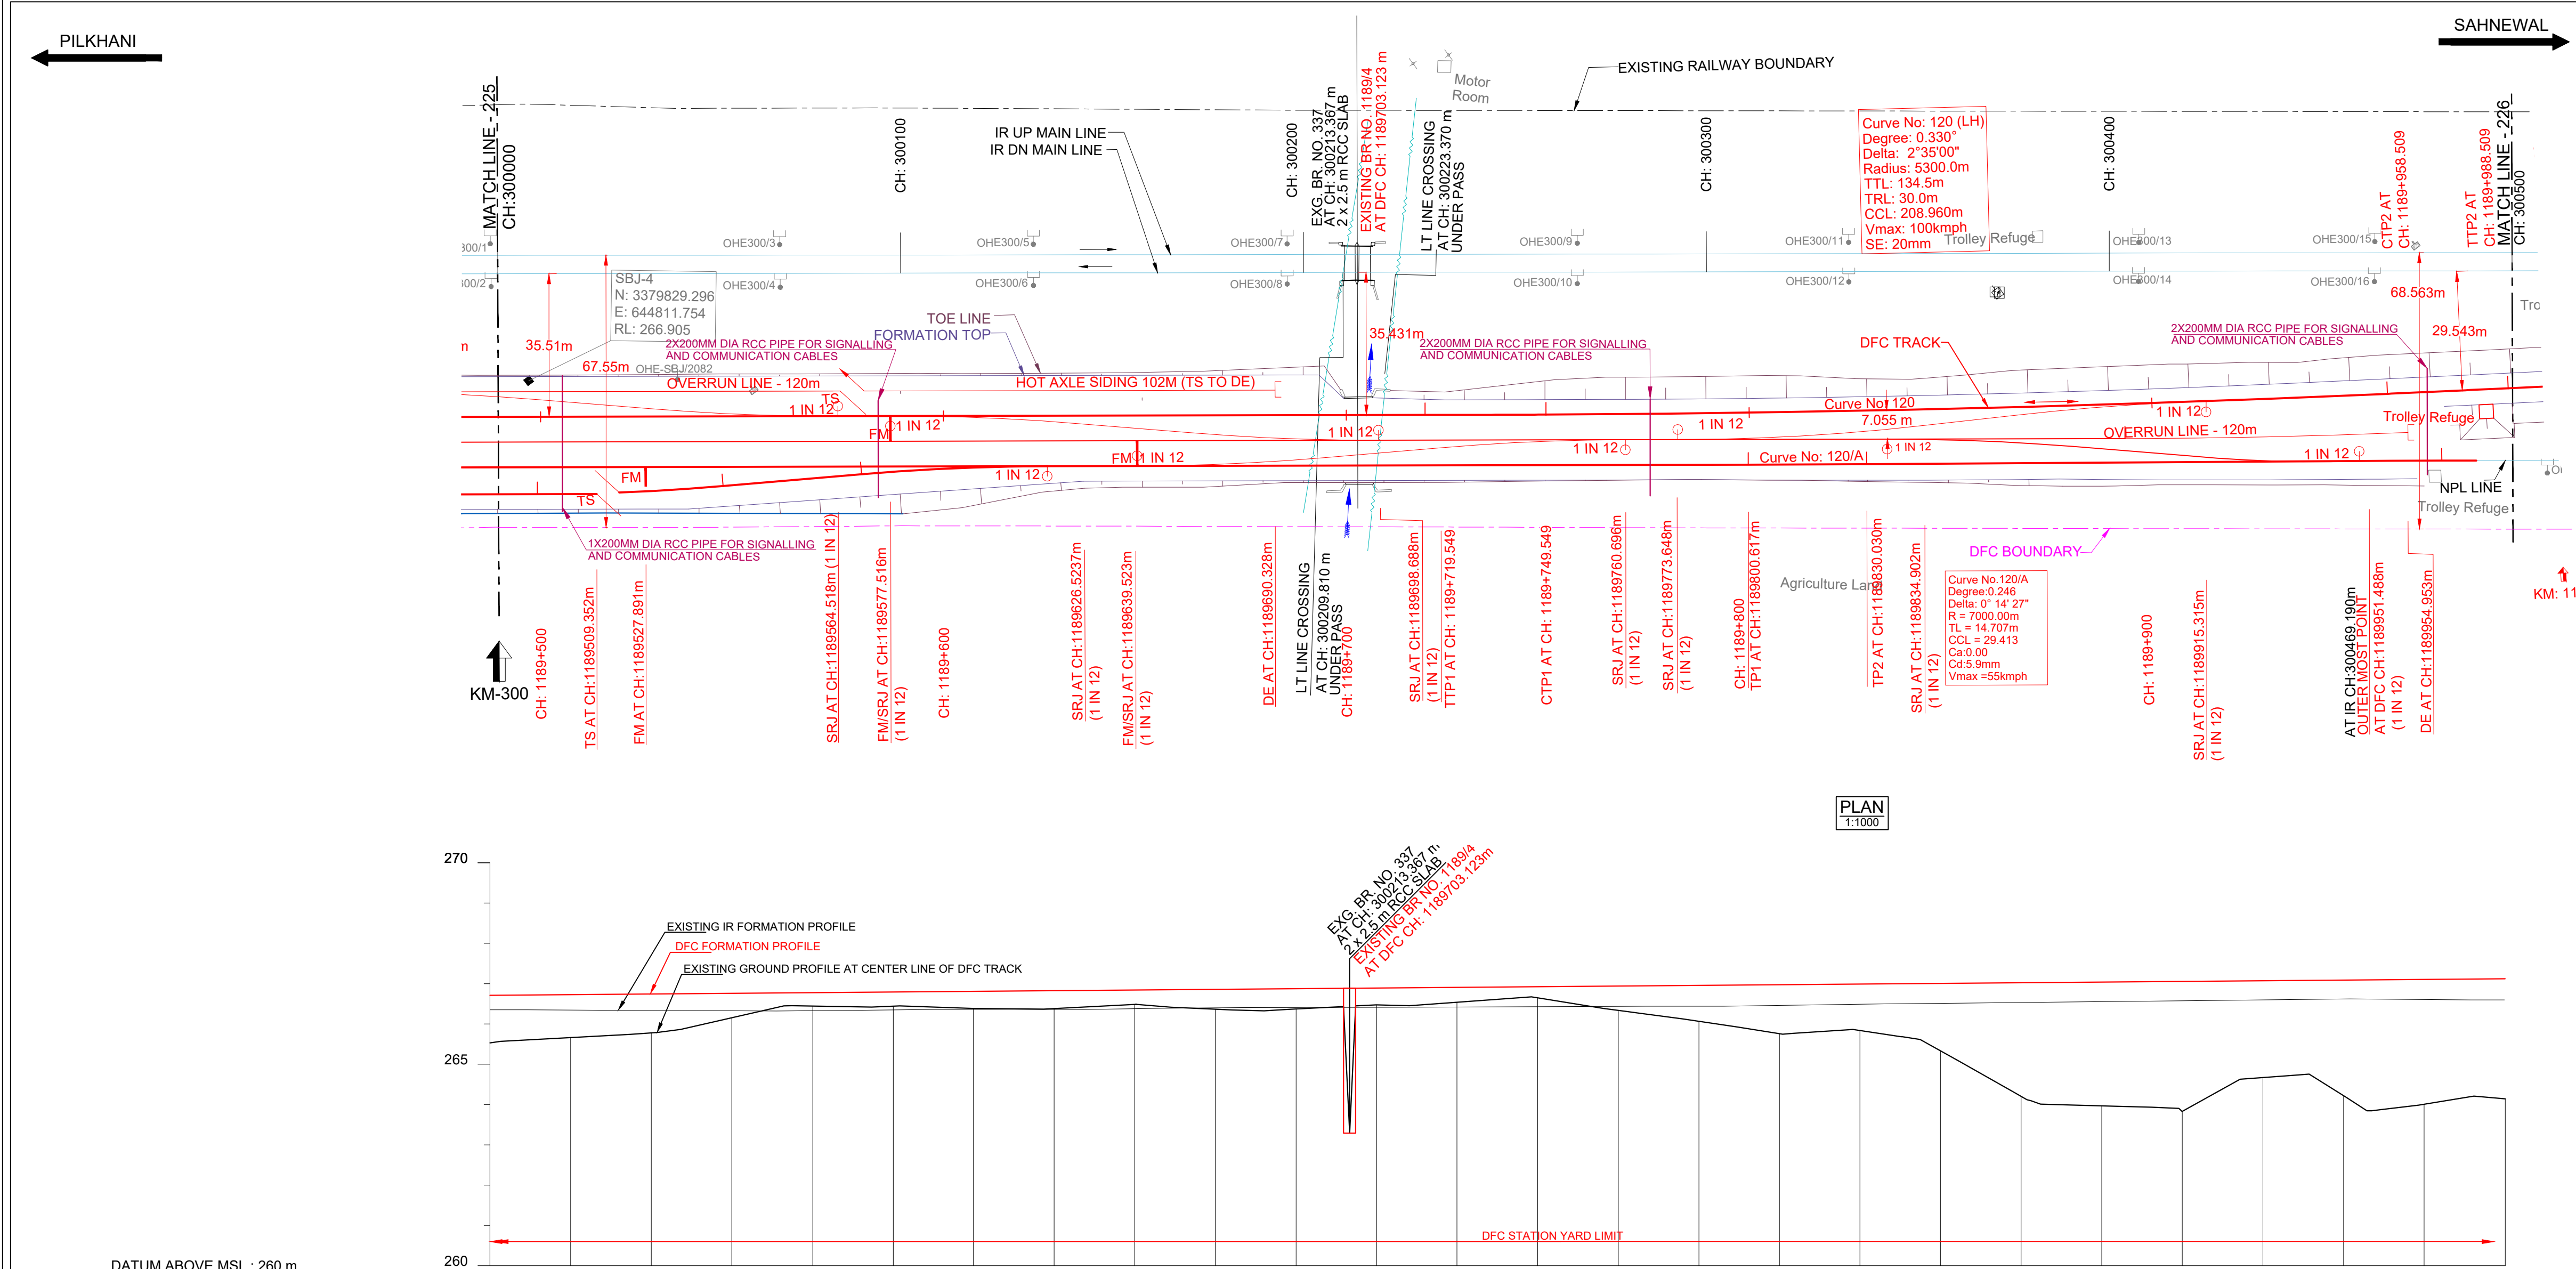


DATUM ABOVE MSL : 260 m

HORIZONTAL ALIGNMENT	L = 1484.776m TL= 30m R = 5300m TL= 30m L = 291.884m																			
VERTICAL ALIGNMENT	L=1107.832 m 1 IN 1219.493 R																			
TRACK DISTANCE FROM EXISTING NEAREST IR DN MAIN LINE TO DFC MAIN LINE	35.536	35.501	35.468	35.454	35.459	35.488	35.488	35.458	35.437	35.422	35.424	35.435	35.421	35.373	35.289	35.099	34.852	34.528	34.121	33.633
HEIGHT OF BANKING(+) / DEPTH OF CUTTING(-) (PFL-GL)	+1.183	+1.067	+0.969	+0.606	+0.335	+0.352	+0.427	+0.448	+0.357	+0.496	+0.504	+0.420	+0.372	+0.288	+0.046	+0.967	+1.312	+1.229	+1.770	+2.916
EXG GROUND LEVEL AT CENTER LINE OF DFC TRACK (GL)	263.831	263.776	263.785	263.845	266.443	264.220	264.786	265.781	265.976	266.107	266.533	266.538	266.585	266.715	266.815	266.873	266.874	266.729	266.562	266.238
EXG GROUND LEVEL AT TOE LOCATION OF DFC TRACK	263.831	263.776	263.785	263.845	266.443	264.220	264.786	265.781	265.976	266.107	266.533	266.538	266.585	266.715	266.815	266.873	266.874	266.729	266.562	266.238
DIFFERENCE BETWEEN DFC FORMATION LEVEL AND EXG FORMATION LEVEL (PFL-EFL)	0.363	0.385	0.412	0.436	0.448	0.447	0.451	0.467	0.466	0.460	0.468	0.481	0.492	0.498	0.504	0.518	0.514	0.504	0.496	0.496
DFC FORMATION LEVEL (PFL)	266.713	266.729	266.746	266.762	266.778	266.795	266.811	266.828	266.844	266.860	266.877	266.893	266.910	266.926	266.942	266.959	266.975	266.992	267.008	267.024
EXG. FORMATION LEVEL OF EXG IR DN MAIN LINE (EFL)	266.350	266.344	266.334	266.326	266.330	266.348	266.360	266.361	266.378	266.400	266.409	266.412	266.418	266.428	266.438	266.441	266.461	266.488	266.512	266.533
DIFFERENCE BETWEEN DFC RAIL LEVEL AND EXG. RAIL LEVEL (PRL - ERL)	0.404	0.426	0.453	0.477	0.490	0.488	0.492	0.507	0.506	0.501	0.509	0.522	0.532	0.539	0.545	0.558	0.555	0.544	0.537	0.532
DFC RAIL LEVEL (PRL)	267.426	267.442	267.458	267.475	267.491	267.508	267.524	267.540	267.557	267.573	267.590	267.606	267.622	267.639	267.655	267.672	267.688	267.704	267.721	267.737
EXG. RAIL LEVEL OF NEAREST IR DN MAIN LINE (ERL)	267.022	267.016	267.006	266.998	267.002	267.020	267.032	267.033	267.050	267.072	267.081	267.084	267.090	267.100	267.110	267.113	267.133	267.160	267.184	267.205
EQUIVALENT CHAINAGE ON DFC TRACK	300000.0	300020.0	300040.0	300060.0	300080.0	300100.0	300120.0	300140.0	300160.0	300180.0	300200.0	300220.0	300240.0	300260.0	300280.0	300300.0	300320.0	300340.0	300360.0	300380.0
EXISTING IR CHAINAGE	300000.0	300020.0	300040.0	300060.0	300080.0	300100.0	300120.0	300140.0	300160.0	300180.0	300200.0	300220.0	300240.0	300260.0	300280.0	300300.0	300320.0	300340.0	300360.0	300380.0

L - SECTION

SAHNEWAL

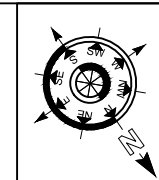

- NOTE:-
1. DFC WORKS ARE SHOWN IN RED.
 2. IR NEW WORKS ARE SHOWN IN VIOLET.
 3. ALL DIMENSIONS ARE SHOWN IN METRES.
 4. THIS DRAWING IS PREPARED BASED ON LATEST SURVEY DATA HELD ON APRIL-2022. GTS BENCH MARK OF 261.850M CONSIDERED ON TOP OF CANAL BRIDGE ABUTMENT AT DORANA VILLAGE ALONG THE NH1.
 5. DFC NEW CHAINAGE OF 1075.950M IS WITH REFERENCE TO THE IR KM OF 187.500KM END OF KM OF CP-303 (SECTION P-3 PILKHANI END) AGAINST THE EXISTING DFC CHAINAGE. 116277.742M ISSUED VIDE LETTER NO. COM/DFCC/MB/SURVEY/2021-301-230116-011173 DT. 17.01.2023.
 6. BALLAST PROFILE HAS BEEN PROVIDED ACCORDING TO THE CLAUSE 1.11.3 OF STANDARD SCHEDULE OF DIMENSION (EASTERN CORRIDOR) & THE BALLAST CUSHION DIMENSION SHOWN IN 35CM ON GE-14 PARA 17. SPECIFICATIONS & RECOMMENDATIONS 2. TWO LAYER SYSTEM FIG. 10.

REFERENCE DRAWINGS:-


1. FOR KEY PLAN REFER DRAWING NO. 301-2/AL/0001
2. FOR LEGEND AND ABBREVIATIONS REFER DRAWING NO. 301-2/AL/1000
3. FOR TYPICAL SECTION OF BALLAST PROFILE (FL-RL) REFER DRG. NO. 301-2/TK/TFD/004 (TR. 1952)

0	09.09.2024	SUBMISSION OF AS-BUILT DRAWING	FOR APPROVAL
REV.	DATE	REVISION DETAILS	PURPOSE OF ISSUE

LEGEND:

IR TRACK
DFCC TRACK
DFCC FUTURE PROPOSALS
STRUCTURE / BUILDING
DFCC TOE LINE
DFCC FORMATION
RETAINING WALL
ROAD
STREAM, DRAIN, NALA, CANAL
FENCE
POWER LINES
TBM
ELECTRIC POLE/OHE MAST
IR RAILWAY DIVISION
DFCC BOUNDARY

SCALE
HOR - 1:1000
VER - 1:100
SHEET SIZE : A1

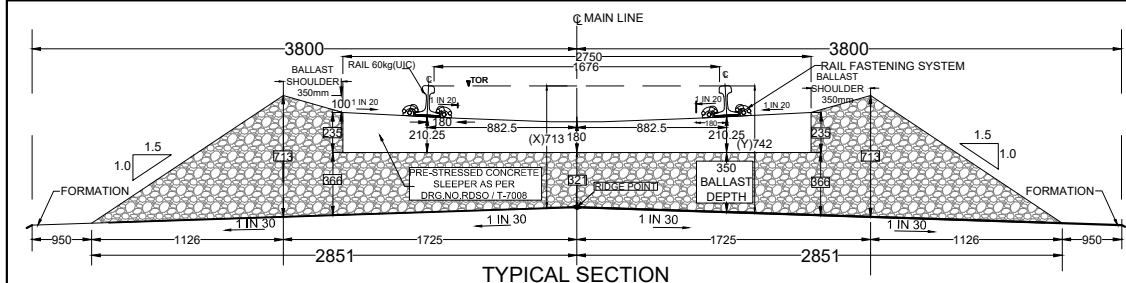

TRACK STRUCTURE		
RAIL SECTION: 60Kg/m (UIC 60Kg/m) DFC LINE: 60Kg/m (UIC 60Kg/m) IR MAIN LINE: 52Kg/m	Difference between FL- RL (Below Rail Seat)	
	IR Line	DFC
RUBBER PAD	172mm	172mm
SLEEPER DEPTH	210mm	210mm
BALLAST CUSHION	300mm	350mm
Total Depth (FL TO RL)	688mm	742mm

OWNER
DEDICATED FREIGHT CORRIDOR CORPORATION OF INDIA LTD.
(A GOVERNMENT OF INDIA ENTERPRISE)
PROJECT OFFICE (AMBALA UNIT): OLD RAILWAY COLONY (NEAR ANAND MARKET), AMBALA CANTT-133001.
CORPORATE IDENTITY NO. : U60232DL2006GGI155068

ENGINEER:
DB Engineering & Consulting GmbH
Deutsche Bahn Engineering & Consulting GmbH

CONTRACTOR:
GIL - TPL JV
GAR TATA

SUBMITTED BY	GIL - TPL JV		
	DATED	NAME	SIGNATURE
PREPARED BY			
CHECKED BY	09.09.2024	VIJAY PRATAP	
APPROVED BY	09.09.2024	PARASURAM KOTYADA	

APPROVED BY	DEUTSCHE BAHN ENGINEERING & CONSULTING GMBH		
	DATED	NAME	SIGNATURE
Sr. DE./CHIEF ENGINEER		SURESH K.YALANGI	
CHIEF TRACK ENGINEER		RAJ PAL SINGH	
T.L.		H.D. VIDJAK	

STAMP	A AS-BUILT DRAWING TR. Ref.:..... ENGINEER Sign.:.....		
EMPLOYER (DFCCIL):	DEDICATED FREIGHT CORRIDOR CORPORATION OF INDIA LTD.		

AS BUILT DRAWING			
TITLE	AS-BUILT PLAN AND PROFILE		
	DFCC APPR. NO. -		
	ENGG. APPR. NO. -		
	DRG. NO. - 301-2/AL/A/1226		
	SHEET NO. : 1 OF 1	STATUS	
	DATE : 09.09.2024	A	

FROM IR KM: 300.000 TO 300.500
DFC KM: 1189.490 TO 1189.990

TR.