


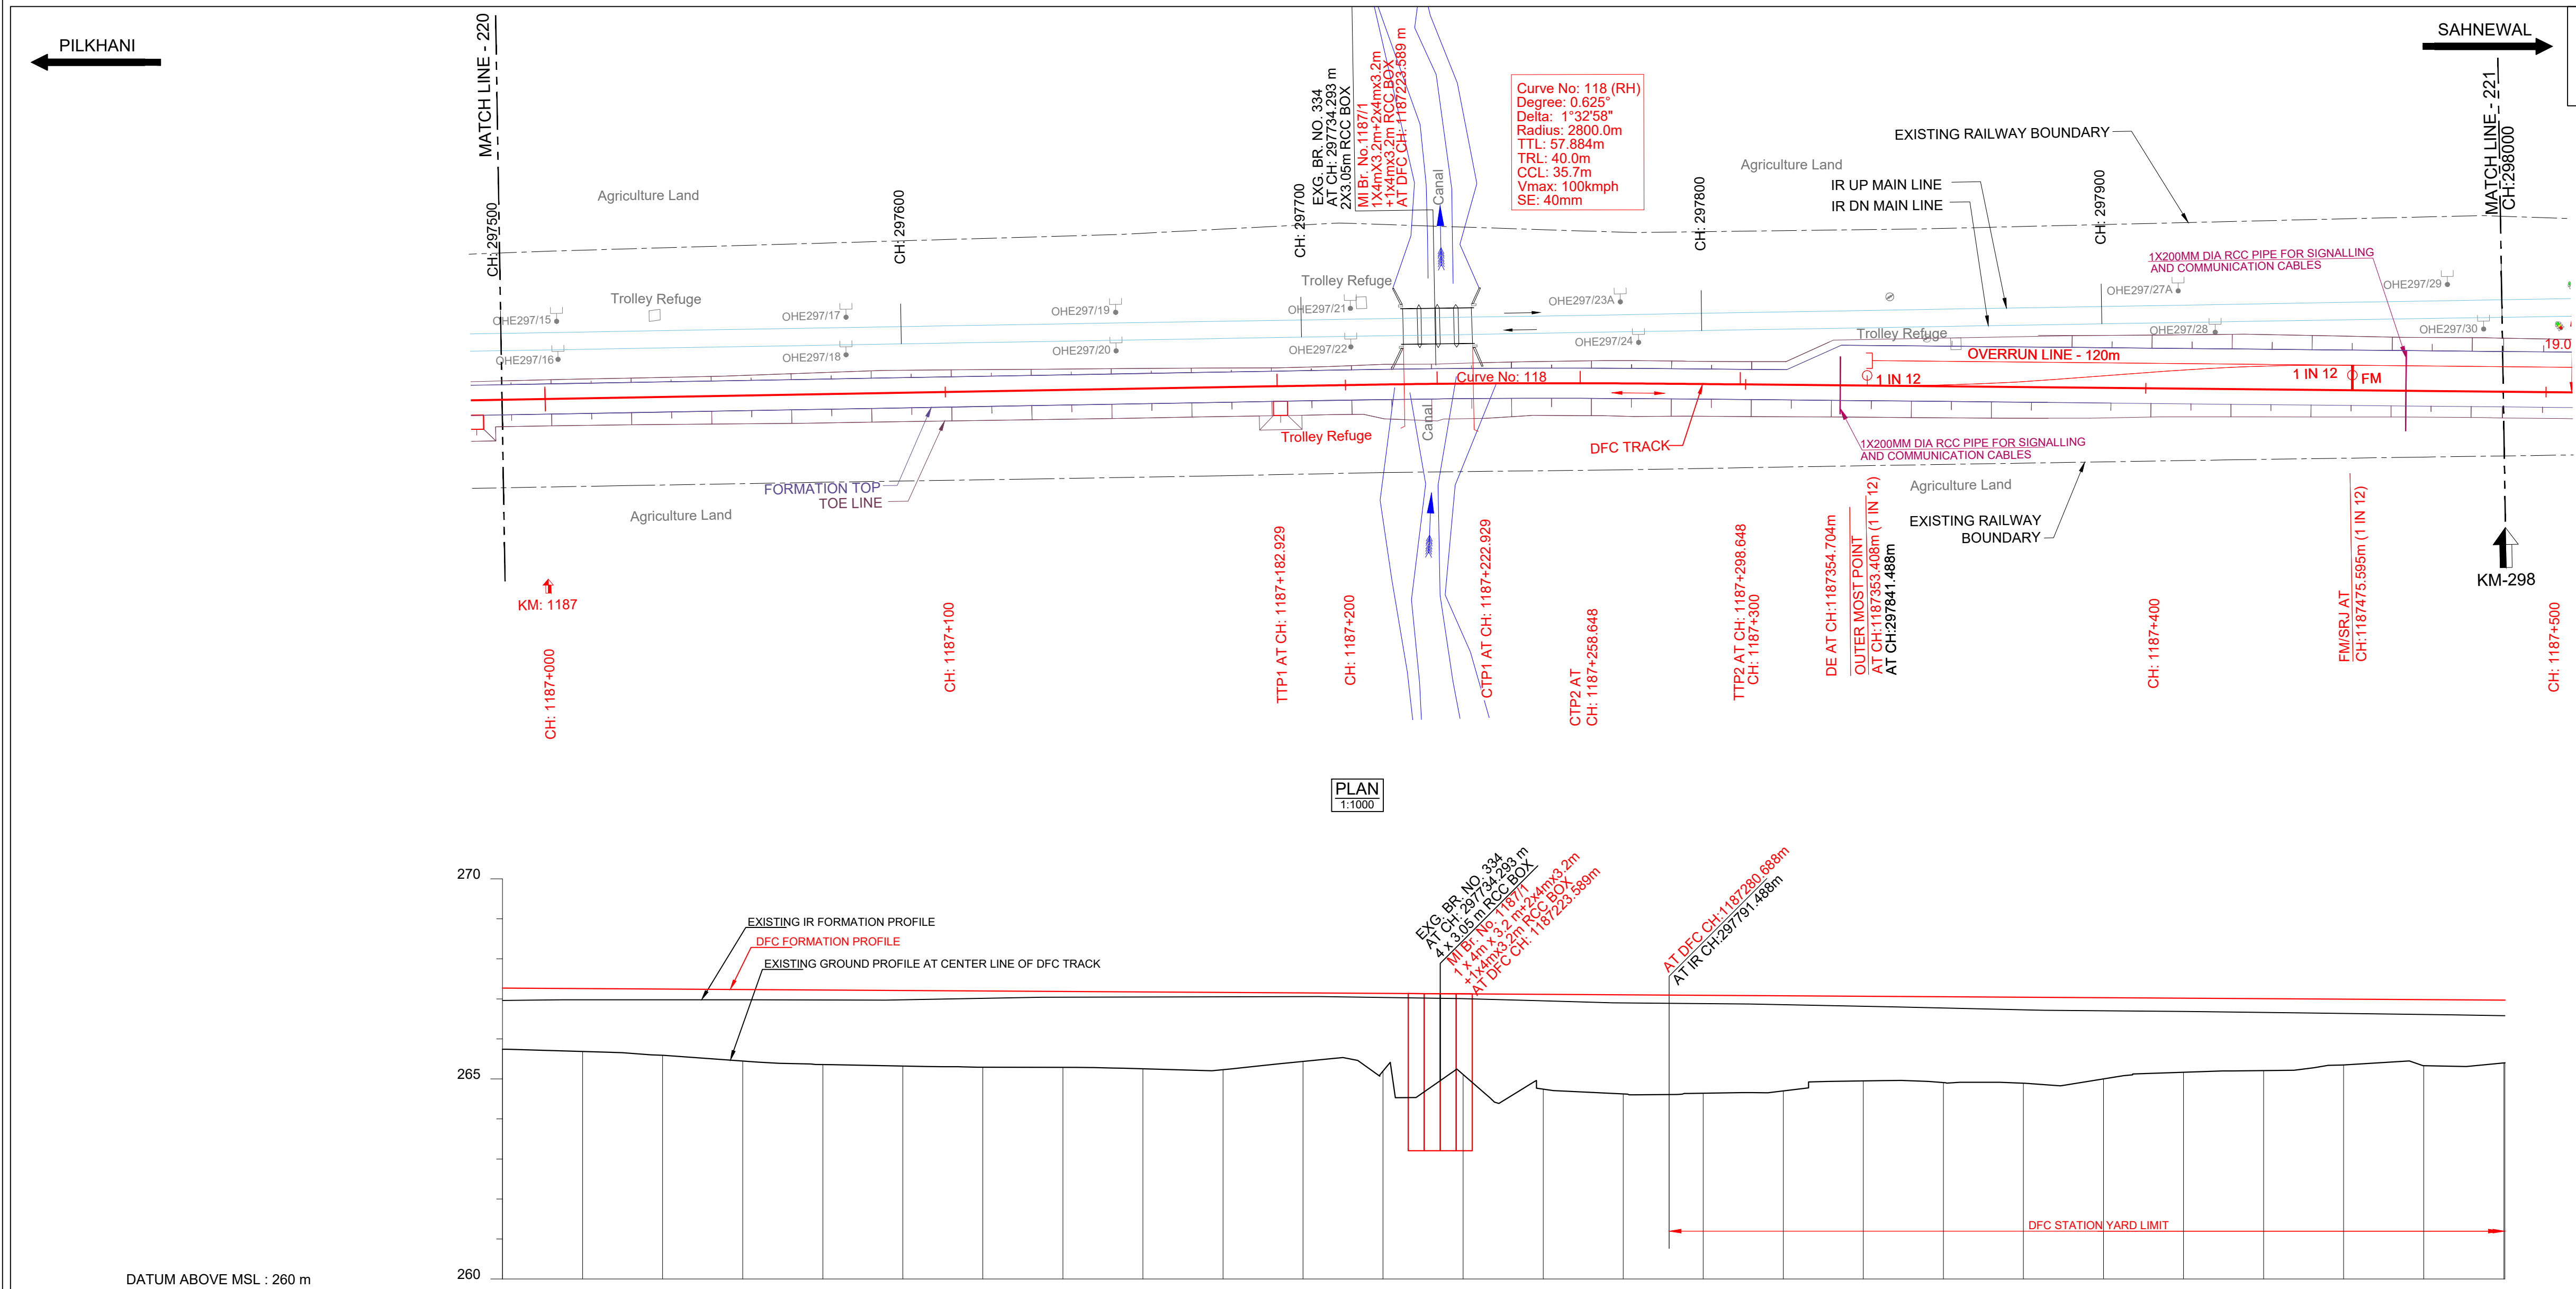

HORIZONTAL ALIGNMENT	L = 5898.430m TL= 40m R=2800m TL= 40m L = 818.516m																			
VERTICAL ALIGNMENT	L=1575.274 m 1 IN 1668.051 F																			
TRACK DISTANCE FROM EXISTING NEAREST IR DN MAIN LINE TO DFC MAIN LINE	12.279	12.264	12.254	12.244	12.243	12.239	12.216	12.195	12.183	12.173	12.165	12.163	12.250	12.504	12.894	13.361	13.876	14.408	15.462	15.982
HEIGHT OF BANKING(+) / DEPTH OF CUTTING(-) (PFL-GL)	+1.528	+1.574	+1.658	+1.730	+1.863	+1.889	+1.907	+1.899	+1.921	+1.931	+1.713	+1.943	+2.017	+2.369	+2.479	+2.448	+2.379	+2.116	+2.150	+2.031
EXG GROUND LEVEL AT CENTER LINE OF DFC TRACK (GL)	265.743	265.682	265.685	265.589	265.404	265.322	265.292	265.300	265.254	265.232	265.438	265.196	265.110	264.746	264.624	264.643	264.700	264.951	264.893	265.000
EXG GROUND LEVEL AT TOE LOCATION OF DFC TRACK	265.682	265.658	265.586	265.445	265.404	265.380	265.347	265.347	265.278	265.262	265.245	264.892	264.506	264.889	264.788	264.832	264.862	264.895	264.916	265.032
DIFFERENCE BETWEEN DFC FORMATION LEVEL AND EXG.FORMATION LEVEL(PFL-EFL)	0.309	0.282	0.270	0.258	0.249	0.232	0.184	0.144	0.126	0.110	0.094	0.103	0.121	0.165	0.205	0.210	0.225	0.253	0.317	0.329
DFC FORMATION LEVEL (PFL)	267.271	267.259	267.247	267.235	267.223	267.211	267.199	267.187	267.175	267.163	267.151	267.139	267.127	267.115	267.103	267.091	267.079	267.067	267.043	267.031
EXG. FORMATION LEVEL OF EXG IR DN MAIN LINE (EFL)	266.978	266.993	266.993	266.993	266.990	266.995	267.031	267.059	267.065	267.069	267.073	267.052	267.022	266.966	266.914	266.897	266.870	266.830	266.742	266.718
DIFFERENCE BETWEEN DFC RAIL LEVEL AND EXG. RAIL LEVEL (PRL - ERL)	0.333	0.306	0.294	0.282	0.273	0.256	0.208	0.168	0.151	0.134	0.118	0.128	0.145	0.189	0.229	0.234	0.249	0.277	0.342	0.353
DFC RAIL LEVEL (PRL)	267.983	267.971	267.959	267.947	267.935	267.923	267.911	267.899	267.887	267.875	267.863	267.851	267.839	267.827	267.815	267.803	267.791	267.779	267.755	267.743
EXG.RAIL LEVEL OF NEAREST IR DN MAIN LINE(ERL)	267.650	267.665	267.665	267.665	267.662	267.667	267.703	267.731	267.737	267.741	267.745	267.724	267.694	267.638	267.586	267.569	267.542	267.502	267.414	267.390
EQUIVALENT CHAINAGE ON DFC TRACK	1186989.2	1187009.2	1187029.2	1187049.2	1187069.2	1187089.2	1187109.2	1187129.2	1187149.2	1187169.2	1187189.2	1187209.2	1187229.2	1187249.2	1187269.2	1187289.2	1187309.2	1187329.2	1187349.2	1187369.2
EXISTING IR CHAINAGE	297500.0	297520.0	297540.0	297560.0	297580.0	297600.0	297620.0	297640.0	297660.0	297680.0	297700.0	297720.0	297740.0	297760.0	297780.0	297800.0	297820.0	297840.0	297860.0	297880.0

NOTE:-

- DFCC WORKS ARE SHOWN IN RED.
- IR NEW WORKS ARE SHOWN IN VIOLET.
- ALL DIMENSIONS ARE SHOWN IN METRES.
- THIS DRAWING IS PREPARED BASED ON LATEST SURVEY DATA HELD ON APRIL-2022. GTS BENCH MARK OF 261.850M CONSIDERED ON TOP OF CANAL BRIDGE ABUTMENT AT DORAH VILLAGE ALONG THE NH1.
- DFC NEW CHAINAGE OF 1075.950M IS WITH REFERENCE TO THE IR KM OF 187.500KM END OF KM OF CP-303(SECTION P-3 PILKHANI END) AGAINST THE EXISTING DFC CHAINAGE. 116277.742M ISSUED VIDE LETTER NO. COM/DFCC/MB/SURVEY/2021-301-230116-011173.DT. 17.01.2023.
- BALLAST PROFILE HAS BEEN PROVIDED ACCORDING TO THE CLAUSE 1.11.3 OF STANDARD SCHEDULE OF DIMENSION(EASTERN CORRIDOR) & THE BALLAST CUSHION DIMENSION SHOWN IN 35CM ON GE-14 PARA 17. SPECIFICATIONS & RECOMMENDATIONS 2. TWO LAYER SYSTEM FIG.10.

REFERENCE DRAWINGS :-

- FOR KEY PLAN REFER DRAWING NO. 301-2/AL/0001
- FOR LEGEND AND ABBREVIATIONS REFER DRAWING NO. 301-2/AL/1000
- FOR TYPICAL SECTION OF BALLAST PROFILE (FL-RL) REFER DRG. NO. 301-2/TK/TFD/-004 (TR.1952)

LEGEND:

IR TRACK
DFCC TRACK
DFCC FUTURE PROPOSALS
STRUCTURE / BUILDING
DFCC TOE LINE
DFCC FORMATION
RETAINING WALL
ROAD
STREAM, DRAIN, NALA, CANAL.
FENCE
POWER LINES
TBM
ELECTRIC POLE/OHE MAST
IR RAILWAY BOUNDARY
DFCC BOUNDARY

SCALE

HOR - 1:1000
VER - 1:100
SHEET SIZE : A1

TYPICAL SECTION

TRACK STRUCTURE		Difference between FL- RL (Below Rail Seat)	
RAIL SECTION: 60Kg/m (UIC 60Kg/m)		IR Line	DFC
DFC LINE: 60Kg/m (UIC 60Kg/m)		172mm	172mm
IR MAIN LINE: 52Kg/m		6mm	10mm
RUBBER PAD		210mm	210mm
SLEEPER DEPTH		300mm	350mm
BALLAST CUSHION		688mm	742mm
Total Depth (FL TO RL)		688mm	742mm

OWNER

DEDICATED FREIGHT CORRIDOR CORPORATION OF INDIA LTD.
(A GOVERNMENT OF INDIA ENTERPRISE)
PROJECT OFFICE(AMBALA UNIT): OLD RAILWAY COLONY (NEAR ANAND MARKET),AMBALA CANTT-133001.
CORPORATE IDENTITY NO. : U60232DL2006GCI155068

ENGINEER:

DB Engineering & Consulting GmbH
Deutsche Bahn Engineering & Consulting GmbH

CONTRACTOR:

GIL - TPL JV
GAR TATA

SUBMITTED BY	GIL - TPL JV		
	DATED	NAME	SIGNATURE
PREPARED BY			
CHECKED BY	09.09.2024	VIJAY PRATAP	
APPROVED BY	09.09.2024	PARASURAM KOTYADA	

APPROVED BY

DEUTSCHE BAHN ENGINEERING & CONSULTING GMBH

DATED	NAME	SIGNATURE
	SURESH K.YALANGI	
	RAJ PAL SINGH	
T.L.	H.D. VIDJAK	

STAMP

A AS-BUILT DRAWING
TR. Ref.:.....
ENGINEER Sign.:.....

EMPLOYER (DFCCIL):

DEDICATED FREIGHT CORRIDOR CORPORATION OF INDIA LTD.

AS BUILT DRAWING

TITLE

AS-BUILT PLAN AND PROFILE

DFCC APPR. NO. -
ENGG. APPR. NO. -
DRG. NO. -301-2/AL/A/1221
SHEET NO.: 1 OF 1
DATE: 09.09.2024

STATUS

A

FROM IR KM: 297.500 TO 298.000
DFC KM: 1186.989 TO 1187.489

TR.