


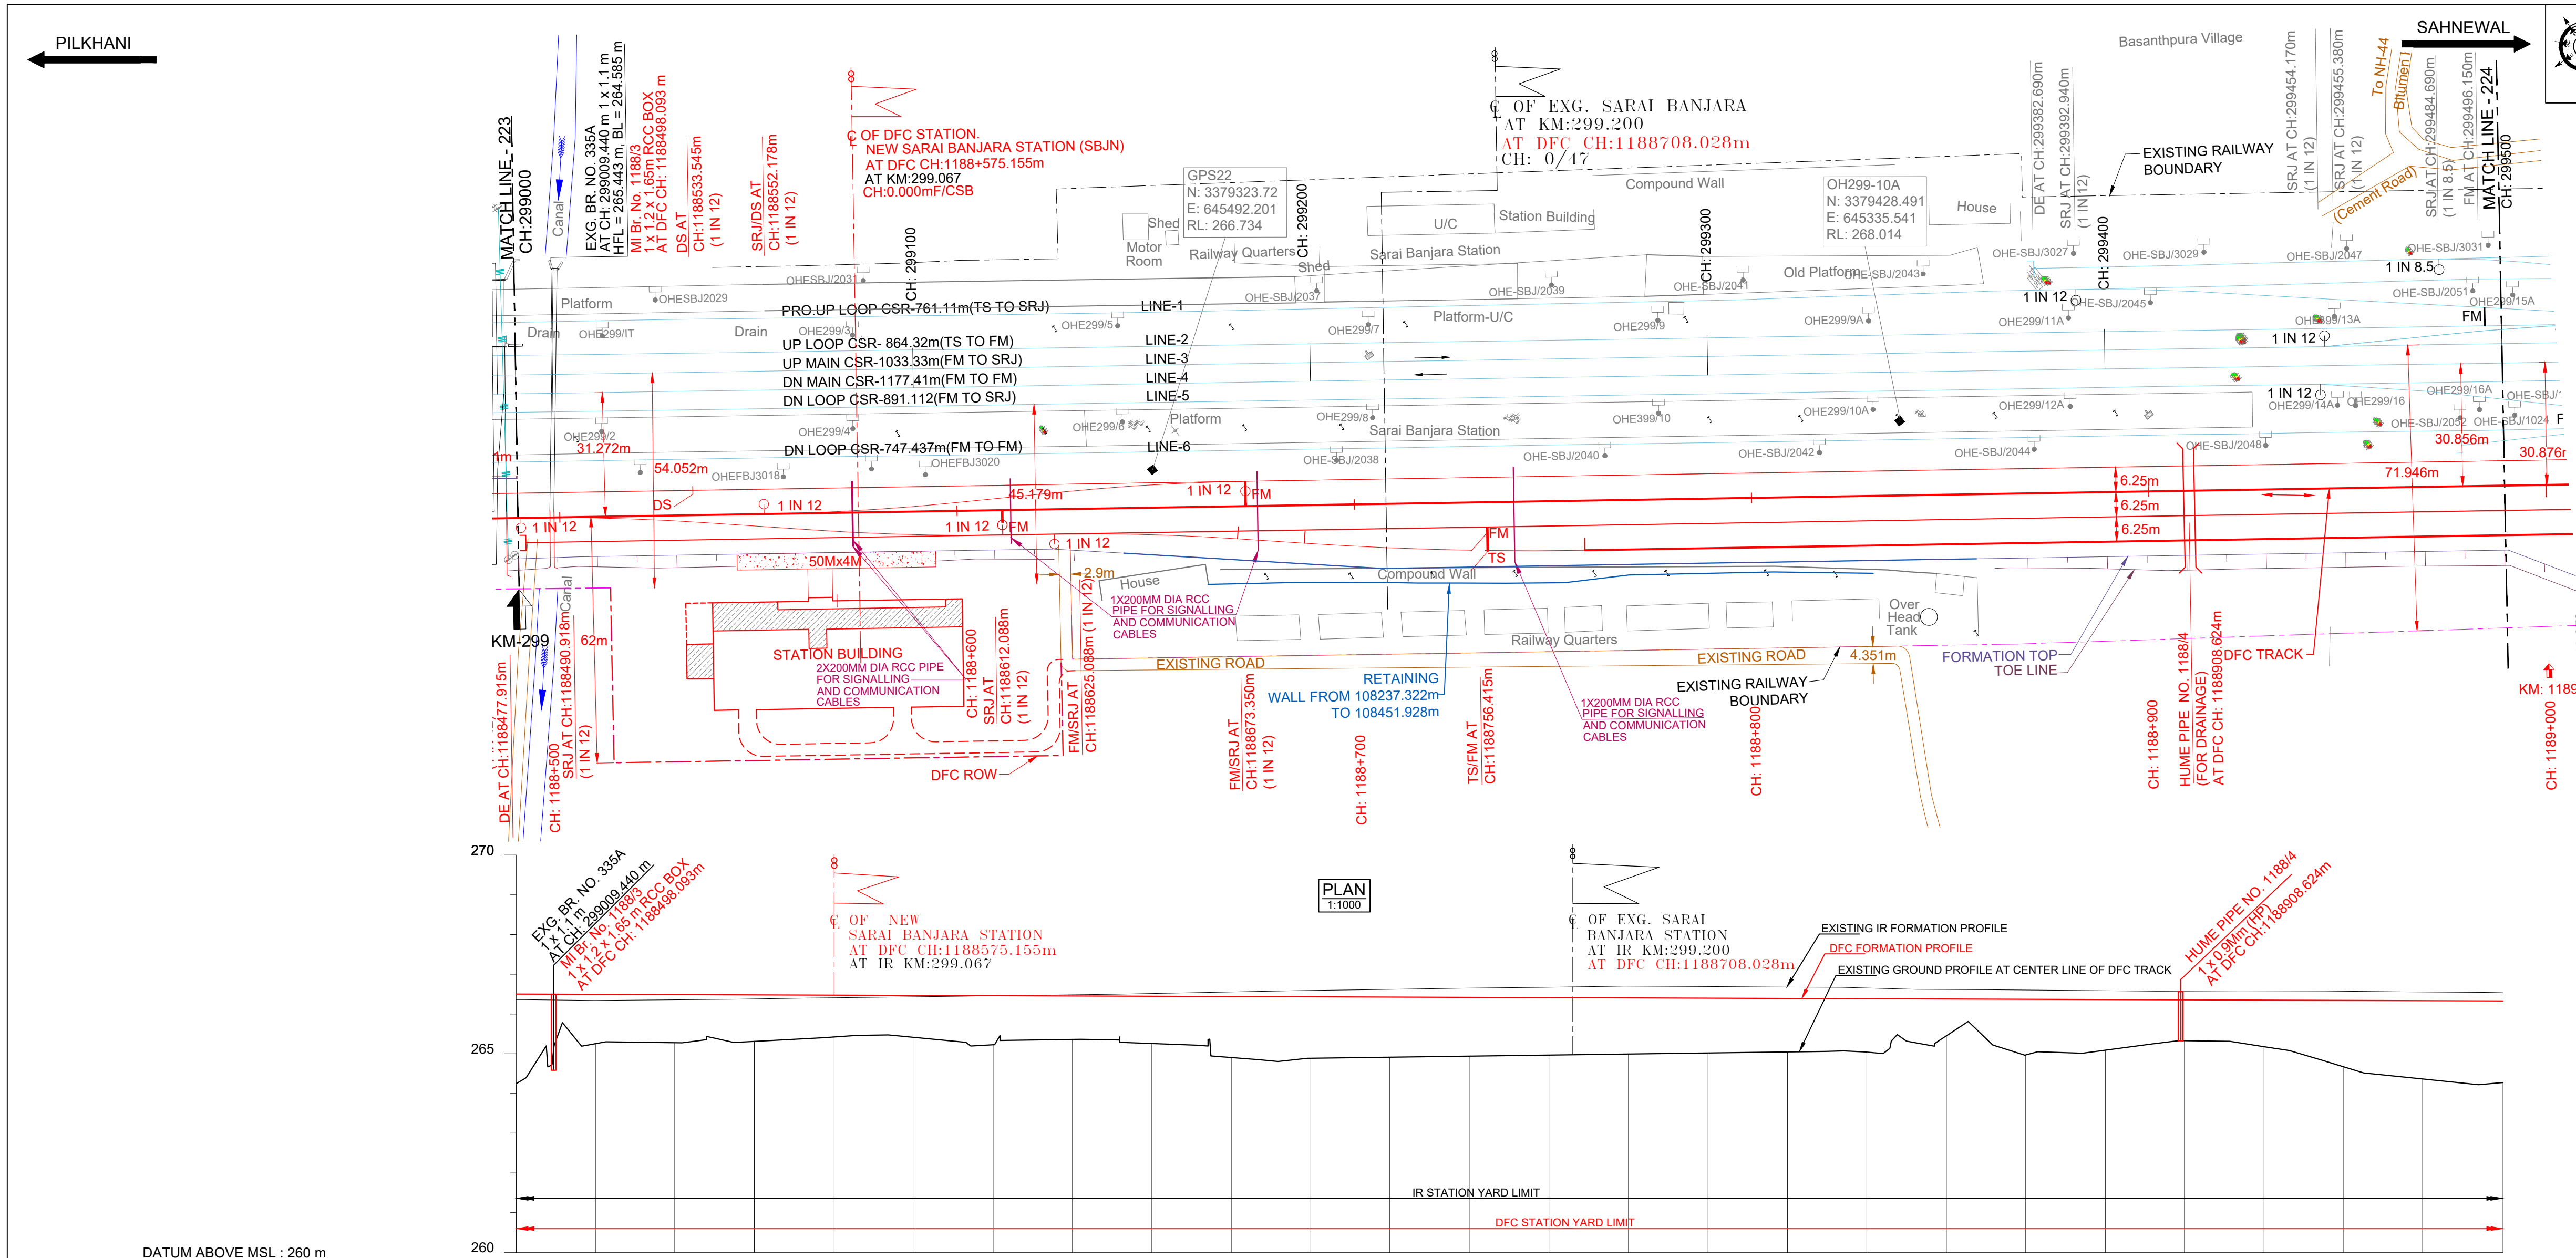

DATUM ABOVE MSL : 260 m

HORIZONTAL ALIGNMENT	L = 1484.776m																			
VERTICAL ALIGNMENT	L=1002.957 m 1 IN 2923.294 F																			
TRACK DISTANCE FROM EXISTING NEAREST IR DN MAIN LINE TO DFC MAIN LINE	31.280	31.231	31.260	31.216	31.201	31.203	31.171	31.199	31.212	31.207	31.197	31.186	31.143	31.168	31.135	31.114	31.108	31.084	31.056	31.039
HEIGHT OF BANKING(+) / DEPTH OF CUTTING(-) (PFL-GL)	+2.255	+1.239	+1.211	+1.169	+1.051	+1.053	+1.235	+1.091	+1.188	+1.532	+1.546	+1.513	+1.479	+1.445	+1.411	+1.377	+1.343	+1.344	+0.927	+1.401
EXG GROUND LEVEL AT CENTER LINE OF DFC TRACK (GL)	-264.245	-265.254	-265.275	-265.310	-265.421	-265.413	-265.224	-265.361	-265.257	-264.906	-264.885	-264.912	-264.939	-264.966	-264.993	-265.020	-265.047	-265.040	-265.450	-264.969
EXG GROUND LEVEL AT TOE LOCATION OF DFC TRACK	-264.840	-265.087	-264.820	-264.823	-264.779	-264.985	-265.215	-265.042	-265.008	-264.804	-264.485	-264.535	-264.375	-264.434	-264.493	-264.552	-264.613	-264.689	-264.835	-265.011
DIFFERENCE BETWEEN DFC FORMATION LEVEL AND EXG.FORMATION LEVEL.(PFL-EFL)	0.139	0.153	0.128	0.101	0.064	0.035	0.002	-0.032	-0.070	-0.116	-0.161	-0.194	-0.234	-0.261	-0.295	-0.293	-0.286	-0.269	-0.240	-0.234
DFC FORMATION LEVEL (PFL)	-266.500	-266.493	-266.486	-266.479	-266.472	-266.466	-266.459	-266.452	-266.445	-266.438	-266.431	-266.425	-266.418	-266.411	-266.404	-266.397	-266.390	-266.384	-266.377	-266.370
EXG. FORMATION LEVEL OF EXG IR DN MAIN LINE (EFL)	-266.361	-266.340	-266.358	-266.378	-266.408	-266.431	-266.457	-266.484	-266.515	-266.554	-266.592	-266.619	-266.652	-266.672	-266.699	-266.690	-266.676	-266.653	-266.617	-266.604
DIFFERENCE BETWEEN DFC RAIL LEVEL AND EXG. RAIL LEVEL (PRL - ERL)	0.180	0.194	0.169	0.142	0.105	0.076	0.043	0.009	-0.029	-0.075	-0.120	-0.154	-0.193	-0.220	-0.254	-0.252	-0.245	-0.229	-0.199	-0.194
DFC RAIL LEVEL (PRL)	-267.213	-267.206	-267.199	-267.192	-267.185	-267.179	-267.172	-267.165	-267.158	-267.151	-267.144	-267.138	-267.131	-267.124	-267.117	-267.111	-267.103	-267.096	-267.09	-267.083
EXG.RAIL LEVEL OF NEAREST IR DN MAIN LINE(ERL)	-267.033	-267.012	-267.030	-267.050	-267.080	-267.103	-267.129	-267.156	-267.187	-267.226	-267.264	-267.291	-267.324	-267.344	-267.371	-267.362	-267.348	-267.325	-267.289	-267.276
EQUIVALENT CHAINAGE ON DFC TRACK	-1188489.7	-1188509.7	-1188529.6	-1188549.6	-1188569.7	-1188589.5	-1188609.7	-1188629.7	-1188649.6	-1188669.6	-1188689.6	-1188709.6	-1188729.7	-1188749.6	-1188769.6	-1188789.6	-1188809.6	-1188829.6	-1188849.6	-1188869.6
EXISTING IR CHAINAGE	299000.0	299020.0	299040.0	299060.0	299080.0	299100.0	299120.0	299140.0	299160.0	299180.0	299200.0	299220.0	299240.0	299260.0	299280.0	299300.0	299320.0	299340.0	299360.0	299380.0

L - SECTION

- NOTE:-
- DFCC WORKS ARE SHOWN IN RED.
 - IR NEW WORKS ARE SHOWN IN VIOLET.
 - ALL DIMENSIONS ARE SHOWN IN METRES.
 - THIS DRAWING IS PREPARED BASED ON LATEST SURVEY DATA HELD ON APRIL-2022. GTS BENCH MARK OF 261.850M CONSIDERED ON TOP OF CANAL BRIDGE ABUTMENT AT DORANA VILLAGE ALONG THE NH1.
 - DFC NEW CHAINAGE OF 1075.950M IS WITH REFERENCE TO THE IR KM OF 187.500KM END OF KM OF CP-303(SECTION P-3 PILKHANI END) AGAINST THE EXISTING DFC CHAINAGE. 116277.742M ISSUED VIDE LETTER NO. COM/DFCC/UM/SURVEY/2021-301-230116-011173 DT. 17.01.2023.
 - BALLAST PROFILE HAS BEEN PROVIDED ACCORDING TO THE CLAUSE 1.11.3 OF STANDARD SCHEDULE OF DIMENSION(EASTERN CORRIDOR) & THE BALLAST CUSHION DIMENSION SHOWN IN 35CM ON GE-14 PARA 17. SPECIFICATIONS & RECOMMENDATIONS 2. TWO LAYER SYSTEM FIG.10.


- REFERENCE DRAWINGS :-
- FOR KEY PLAN REFER DRAWING NO. 301-2/AL/0001
 - FOR LEGEND AND ABBREVIATIONS REFER DRAWING NO. 301-2/AL/1000
 - FOR TYPICAL SECTION OF BALLAST PROFILE (FL-RL) REFER DRG. NO. 301-2/TK/TFD/004 (TR.1952)

REV.	DATE	REVISION DETAILS	PURPOSE OF ISSUE
0	09.09.2024	SUBMISSION OF AS-BUILT DRAWING	FOR APPROVAL

LEGEND:

IR TRACK
DFCC TRACK
DFCC FUTURE PROPOSALS
STRUCTURE / BUILDING
DFCC TOE LINE
DFCC FORMATION
RETAINING WALL
ROAD
STREAM, DRAIN, NALA, CANAL.
FENCE
POWER LINES
TBM
ELECTRIC POLE/OHE MAST
IR RAILWAY BOUNDARY
DFCC BOUNDARY

SCALE
HOR - 1:1000
VER - 1:100
SHEET SIZE : A1

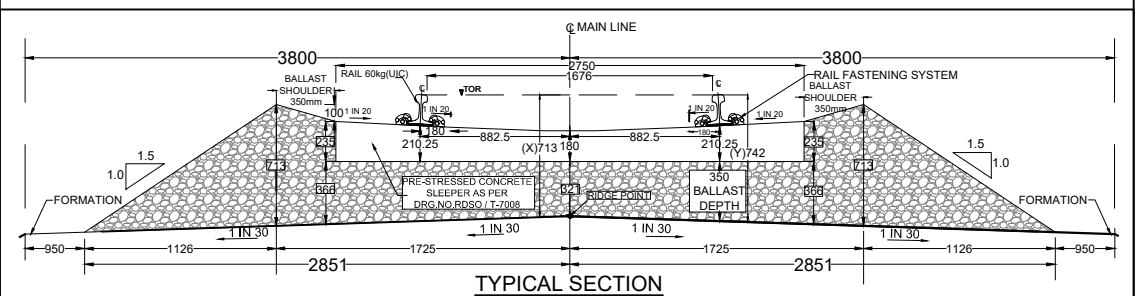

TRACK STRUCTURE		
RAIL SECTION: 60Kg/m (UIC 60Kg/m) DFC LINE: 60Kg/m (UIC 60Kg/m) IR MAIN LINE: 52Kg/m	Difference between FL- RL (Below Rail Seat)	
	IR Line	DFC
RUBBER PAD	172mm	172mm
SLEEPER DEPTH	6mm	10mm
BALLAST CUSHION	210mm	210mm
	300mm	350mm
Total Depth (FL TO RL)	688mm	742mm

OWNER
DEDICATED FREIGHT CORRIDOR CORPORATION OF INDIA LTD.
(A GOVERNMENT OF INDIA ENTERPRISE)
PROJECT OFFICE(AMBALA UNIT): OLD RAILWAY COLONY (NEAR ANAND MARKET),AMBALA CANTT-133001.
CORPORATE IDENTITY NO. : U60232DL2006GGI155068

ENGINEER:
DB Engineering & Consulting GmbH
Deutsche Bahn Engineering & Consulting GmbH

CONTRACTOR:
GIL - TPL JV
GAR TATA

SUBMITTED BY	GIL - TPL JV		
	DATED	NAME	SIGNATURE
PREPARED BY			
CHECKED BY	09.09.2024	VIJAY PRATAP	
APPROVED BY	09.09.2024	PARASURAM KOTYADA	

APPROVED BY	DEUTSCHE BAHN ENGINEERING & CONSULTING GMBH		
	DATED	NAME	SIGNATURE
Sr. DE./CHIEF ENGINEER		SURESH K.YALANGI	
CHIEF TRACK ENGINEER		RAJ PAL SINGH	
T.L.		H.D. VIDJAK	

STAMP	A AS-BUILT DRAWING TR. Ref:..... ENGINEER Sign.:		
EMPLOYER (DFCCIL):	DEDICATED FREIGHT CORRIDOR CORPORATION OF INDIA LTD.		

AS BUILT DRAWING			
TITLE	AS-BUILT PLAN AND PROFILE		
	DFCC APPR. NO. -		
	ENGG. APPR. NO. -		
FROM IR KM: 299.000 TO 299.500 DFC KM: 1188.490 TO 1188.990			STATUS
			A
			DATE : 09.09.2024

TR.