



DEDICATED FREIGHT CORRIDOR CORPORATION OF INDIA LTD.
(A GOVERNMENT OF INDIA ENTERPRISE)

EASTERN DEDICATED FREIGHT CORRIDOR
SAHNEWAL TO PILKHANI SECTION
CONTRACT PACKAGE - 301

PLAN & PROFILE OF AS BUILT DRAWINGS FOR DFC MAIN LINE

IR CHAINAGE FROM 300.500 KM TO 308.000 KM
DFCC CHAINAGE FROM KM 1189.990 TO KM 1197.490

DESIGN CONSULTANT





ENGINEER



CONTRACTOR CLIENT
GIL - TPL JV



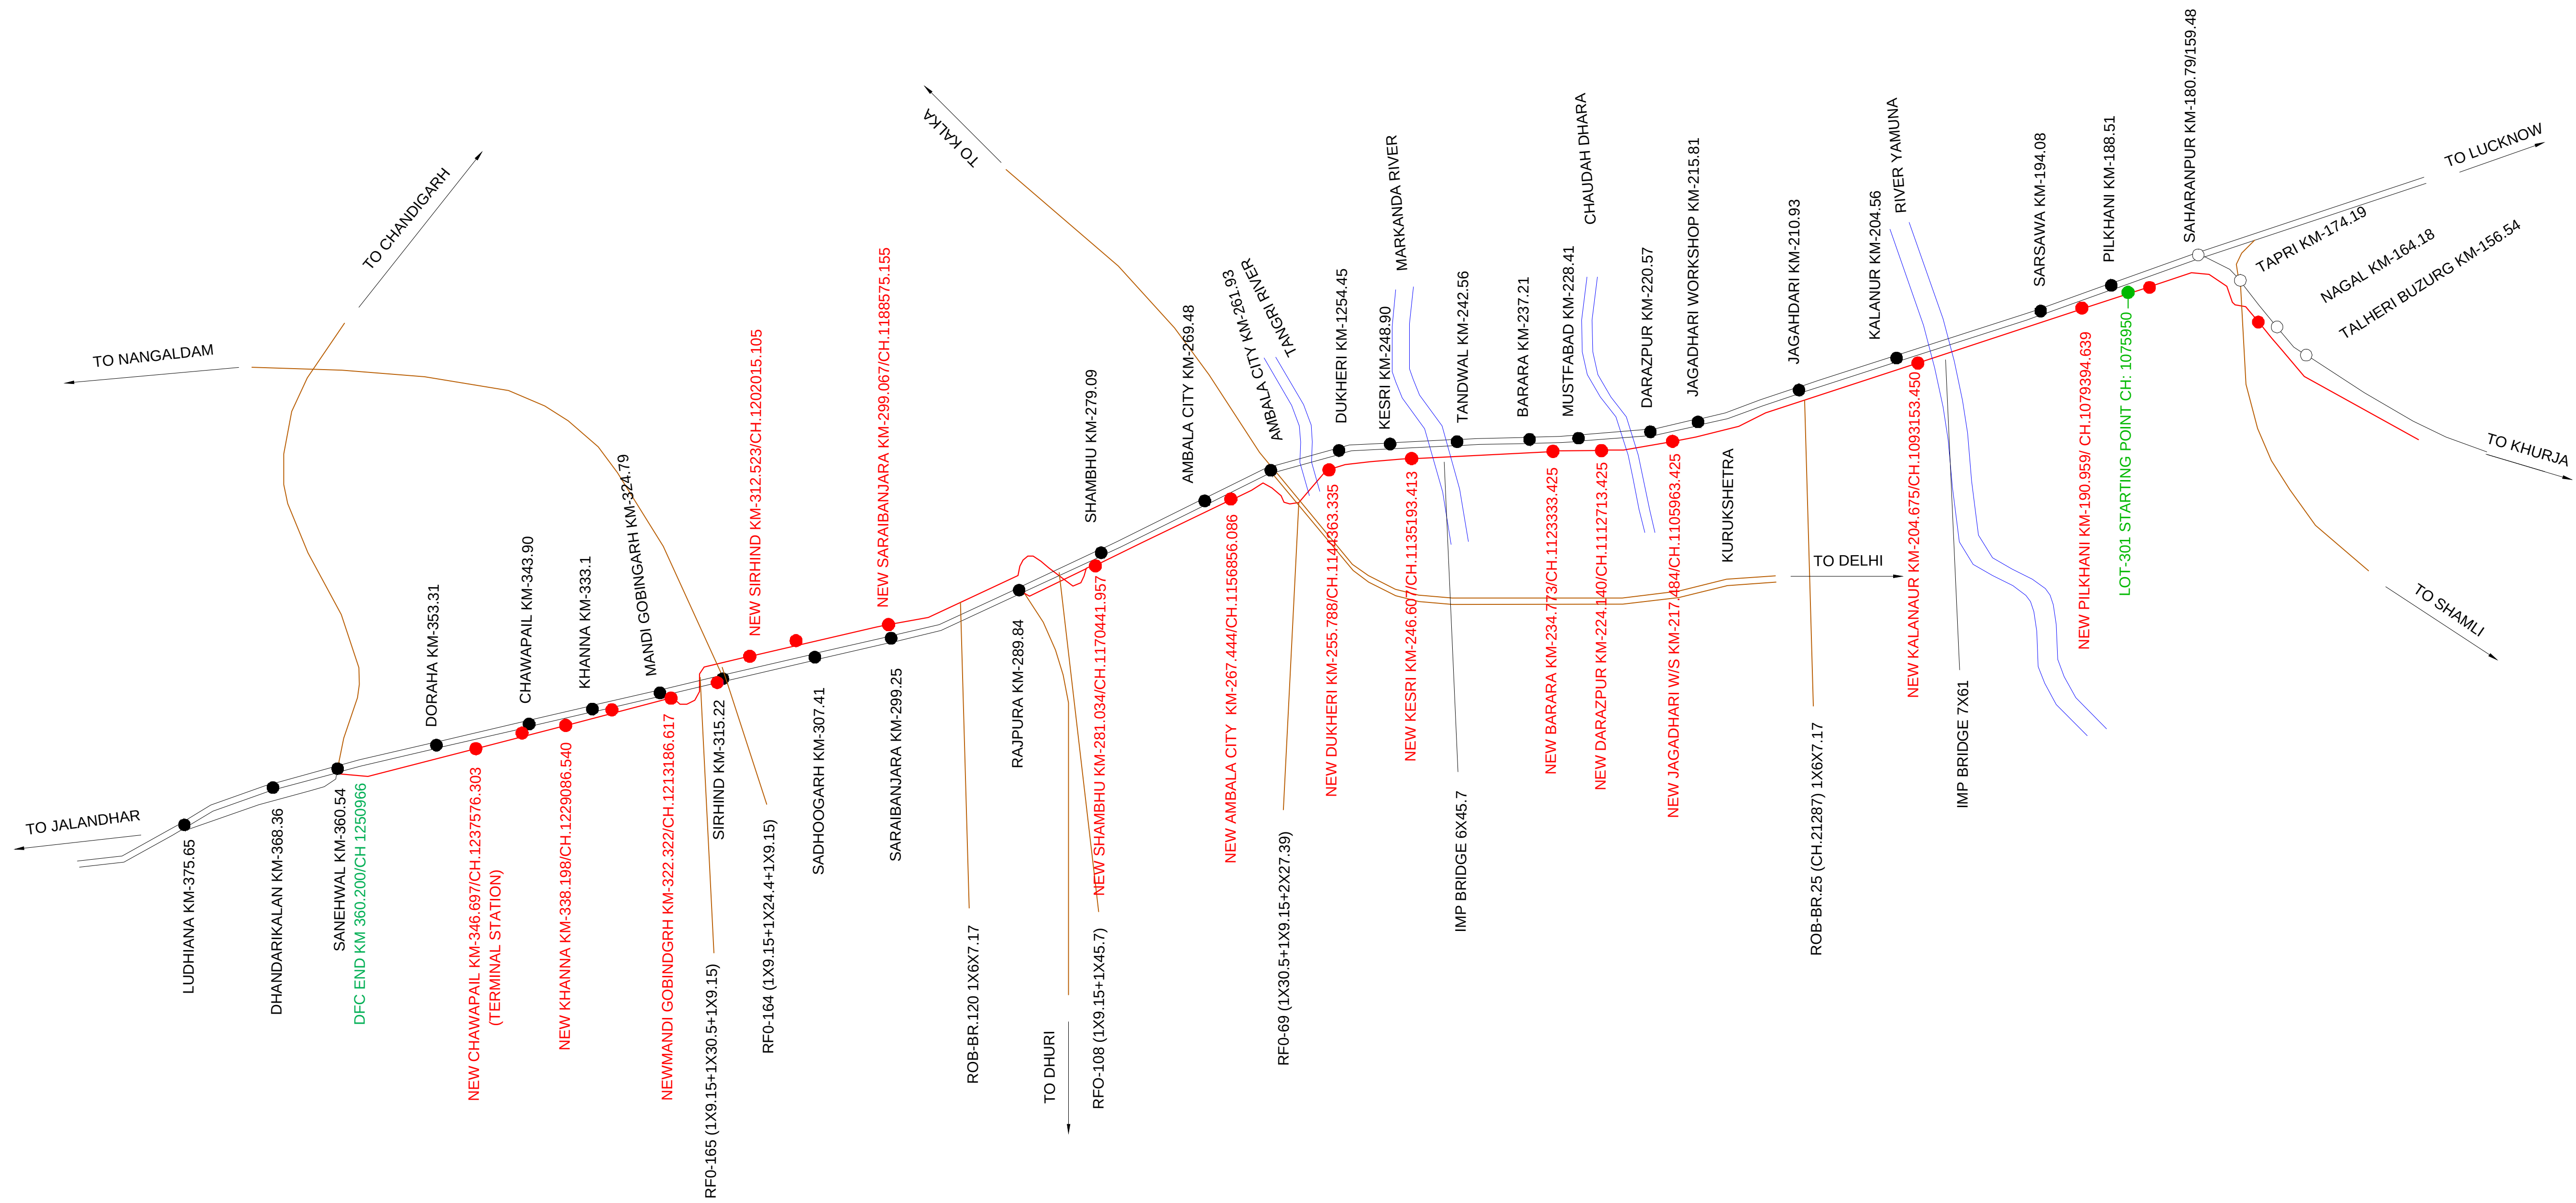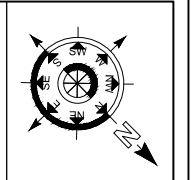

--	--	
DESIGN CONSULTANT

aarvee associates
architects engineers & consultants Pvt.Ltd.

CONTRACTOR

GIL - TPL JV

ENGINEER

DB Engineering & Consulting GmbH

OWNER

उत्तर प्रदेश रेलवे कोरपोरेशन लिमिटेड

DEDICATED FREIGHT CORRIDOR CORPORATION OF INDIA LTD.
(A GOVERNMENT OF INDIA ENTERPRISE)
PROJECT OFFICE(AMBALA UNIT): OLD RAILWAY COLONY (NEAR ANAND MARKET),AMBALA CANTT-133001.
CORPORATE IDENTITY NO. : U60232DL2006GOI155068

PROJECT
EASTERN DEDICATED FREIGHT CORRIDOR
SAHNEWAL TO PILKHANI
CONTRACT PACKAGE - 301


TITLE
ALIGNMENT DRAWINGS
KEY PLAN

DFCC APPR. NO. -
ENGG. APPR. NO. -
DRG. NO. - 301-2/AL/0001
SHEET NO. : 1 OF 1
DATE : 15-06-2024
REV. No. 0
STATUS A

LEGEND	
EXISTING IR TRACK	
DFC TRACK	
DFC FUTURE PROPOSALS	
IR PROPOSALS	
TOE LINE	
FORMATION CESS	
RETAINING WALL	
DRAIN CUM RETAINING WALL	
ROAD	
STREAM, DRAIN, NALA, CANAL.	
FENCE	
POWER LINES	
GPS POINTS	
ELECTRIC POLE/OHE MAST	
EXISTING RAILWAY BOUNDARY	
DFC BOUNDARY	
DISMANTLED WORKS	
IOCL PIPE LINE	
IOCL ROW	
SIGNALLING CABLE PIPE	

ABBREVIATIONS		
1.	BL	- BED LEVEL
2.	BVC	- BEGIN OF VERTICAL CURVE
3.	Ca	- APPLIED CANT
4.	CCL	- CIRCULAR CURVE LENGTH
5.	CTP1	- COMMON TANGENT POINT
6.	CTP2	- COMMON TANGENT POINT
7.	DEGREE	- DEGREE OF CURVE
8.	DE	- DEAD END
9.	ECL	- EXISTING CLEARANCE
10.	EFB	- EXISTING FREE BOARD
11.	EFL	- EXISTING FORMATION LEVEL
12.	ERL	- EXISTING RAIL LEVEL
13.	ESL	- EXISTING SOFFIT LEVEL
14.	EVC	- END OF VERTICAL CURVE
15.	EVCL	- EXISTING VERTICAL CLEARANCE
16.	F/CSB	- FROM CENTER LINE OF STN BLDG
17.	FM	- FOULING MARK
18.	FSL	- FULL SUPPLY LEVEL
19.	HFL	- HIGH FLOOD LEVEL
20.	L	- STRAIGHT LENGTH
21.	LH	- LEFT HANDED
22.	LHS	- LIMITED HEIGHT SUBWAY
23.	PCL	- PROPOSED CLEARANCE
24.	PFB	- PROPOSED FREE BOARD
25.	PFL	- PROPOSED FORMATION LEVEL
26.	PRL	- PROPOSED RAIL LEVEL
27.	PSL	- PROPOSED SOFFIT LEVEL
28.	PVCL	- PROPOSED VERTICAL CLEARANCE
29.	PVI	- POINT OF VERTICAL INTERSECTION
30.	R	- RADIUS
31.	REV.BL	- REVISED BED LEVEL
32.	RH	- RIGHT HANDED
33.	Rr	- RESULTANT RADIUS
34.	SE	- SUPER ELEVATION
35.	SRJ	- STOCK RAIL JOINT
36.	TS	- TRAP SWITCH
37.	TTL	- TOTAL TANGENT LENGTH
38.	TTP1	- TRANSITION TANGENT POINT
39.	TTP2	- TRANSITION TANGENT POINT
40.	TL	- TRANSITION LENGTH
41.	DELTA	- DEFLECTION ANGLE

				SCALE	DESIGN CONSULTANT	CONTRACTOR	ENGINEER	OWNER	PROJECT	TITLE	DFCC APPR. NO. -					
				NOT TO SCALE	 aarvee associates architects engineers & consultants pvt.ltd.	  GIL - TPL JV	 DB Engineering & Consulting GmbH	 मेडीकेटर फ्रेट कॉर्पोरेश	DEDICATED FREIGHT CORRIDOR CORPORATION OF INDIA LTD. (A GOVERNMENT OF INDIA ENTERPRISE) PROJECT OFFICE(AMBALA UNIT): OLD RAILWAY COLONY (NEAR ANAND MARKET),AMBALA CANTT-133001. CORPORATE IDENTITY NO. : U60232DL2006GOI155068	EASTERN DEDICATED FREIGHT CORRIDOR SAHNEWAL TO PILKHANI CONTRACT PACKAGE - 301	ALIGNMENT DRAWINGS LEGEND AND ABBREVIATIONS	ENG. APPR. NO. -				
																DRG. NO. - 301-2/AL/1000
REV.	DATE	REVISION DETAILS	PURPOSE OF ISSUE								SHEET NO. : 1 OF 1	REV. No.	STATUS			
											DATE : 15-06-2024	0	A			

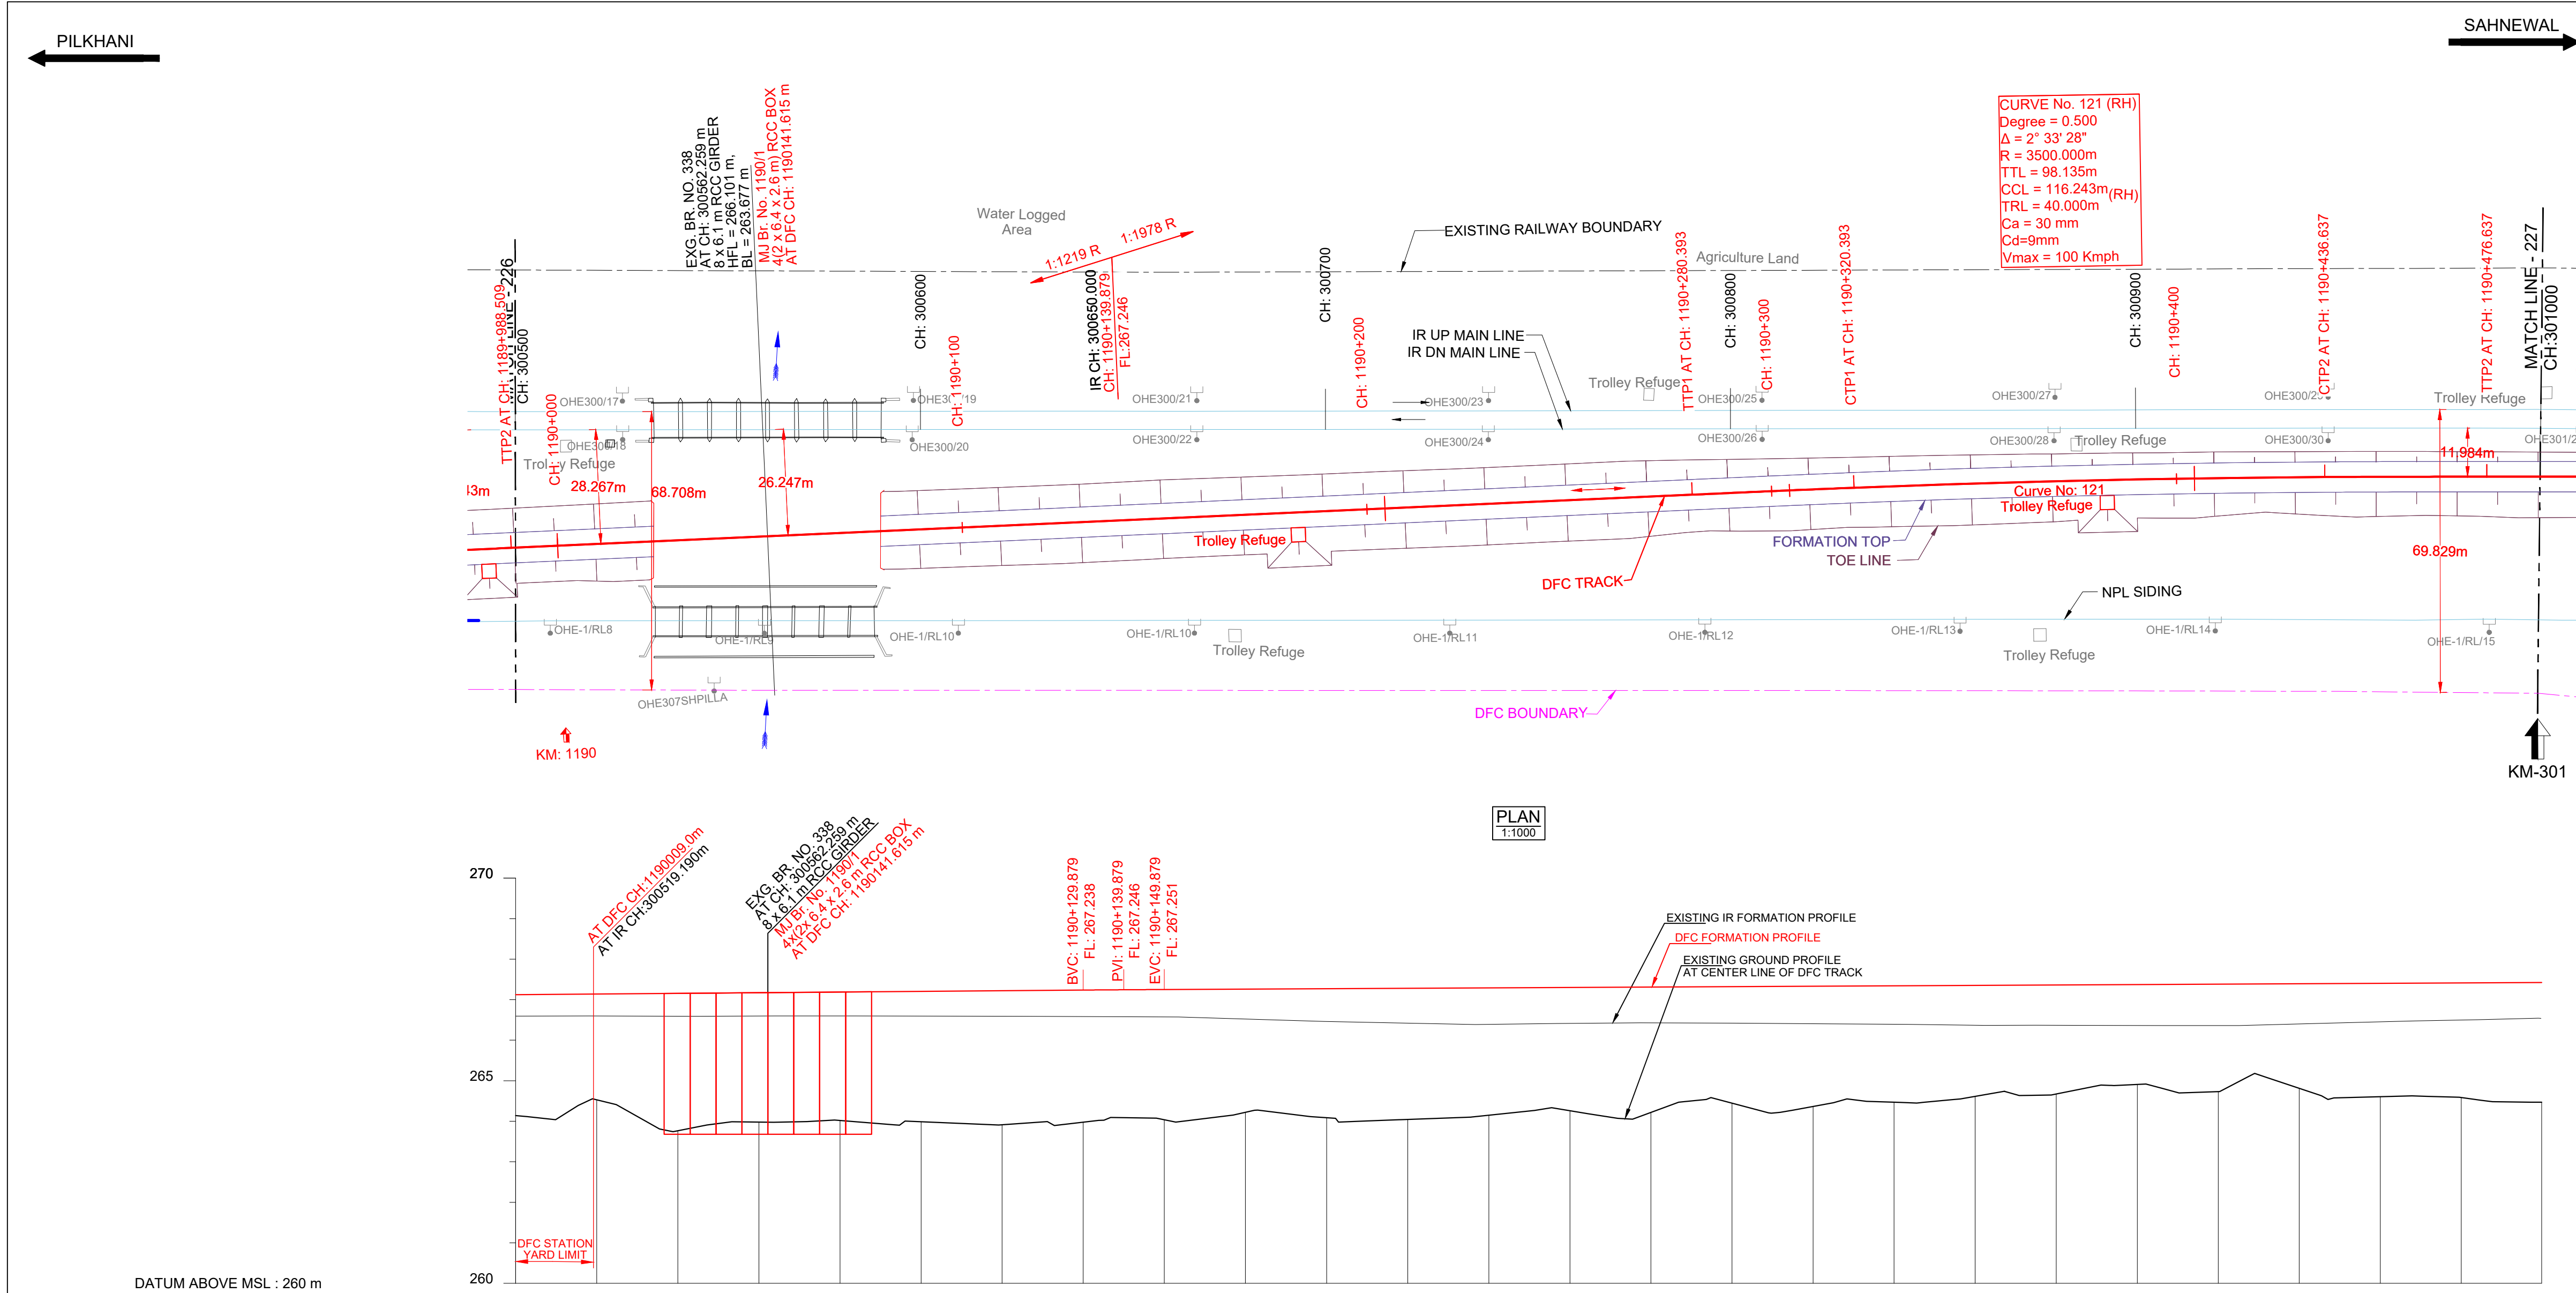

HORIZONTAL ALIGNMENT	L = 291.844m TL= 40m CCL=116.243 R=3500m TL= 40m L = 1896.657m																			
VERTICAL ALIGNMENT	L=1107.832 m 1 IN 1219.493R L=20.0 m R=63580m L=1099.758 m 1 IN 1978.448 R																			
TRACK DISTANCE FROM EXISTING NEAREST IR DN MAIN LINE TO DFC MAIN LINE	29.088	29.212	27.339	26.453	25.562	24.672	23.782	22.884	21.983	21.077	20.170	19.301	18.435	17.582	16.728	15.854	15.008	14.223	13.545	13.016
HEIGHT OF BANKING(+) / DEPTH OF CUTTING(-) (PFL-GL)	+2.982	+2.612	27.339	26.453	25.562	24.672	+3.309	+3.260	+3.213	+3.042	+3.187	+3.237	+3.145	+3.043	+3.093	+2.878	+2.966	+2.873	+2.739	+2.690
EXG GROUND LEVEL AT CENTER LINE OF DFC TRACK (GL)	264.141	264.327	263.765	263.978	264.019	263.987	263.912	263.978	264.038	264.219	264.085	264.045	264.147	264.259	264.219	264.445	264.367	264.470	264.614	264.673
EXG GROUND LEVEL AT TOE LOCATION OF DFC TRACK	264.498	264.328	264.020	264.613	264.454	264.169	264.089	264.021	264.088	264.095	264.076	264.039	264.000	264.032	264.196	264.380	264.168	264.137	264.041	264.151
DIFFERENCE BETWEEN DFC FORMATION LEVEL AND EXG.FORMATION LEVEL (PFL-EFL)	0.527	0.541	0.564	0.574	0.589	0.610	0.630	0.655	0.676	0.739	0.811	0.861	0.901	0.888	0.884	0.903	0.928	0.950	0.985	0.996
DFC FORMATION LEVEL (PFL)	267.123	267.139	267.156	267.172	267.189	267.205	267.221	267.238	267.251	267.261	267.272	267.282	267.292	267.302	267.312	267.323	267.333	267.343	267.353	267.363
EXG. FORMATION LEVEL OF EXG IR DN MAIN LINE (EFL)	266.596	266.598	266.592	266.598	266.600	266.595	266.591	266.583	266.575	266.522	266.461	266.421	266.391	266.414	266.428	266.420	266.405	266.393	266.368	266.367
DIFFERENCE BETWEEN DFC RAIL LEVEL AND EXG. RAIL LEVEL (PRL - ERL)	0.588	0.582	0.605	0.615	0.630	0.650	0.672	0.695	0.717	0.780	0.852	0.901	0.941	0.929	0.924	0.943	0.968	0.991	1.025	1.036
DFC RAIL LEVEL (PRL)	267.636	267.852	267.869	267.885	267.901	267.918	267.934	267.951	267.964	267.974	267.984	267.994	268.005	268.015	268.025	268.035	268.045	268.055	268.065	268.075
EXG.RAIL LEVEL OF NEAREST IR DN MAIN LINE(ERL)	267.268	267.270	267.264	267.270	267.272	267.267	267.263	267.255	267.247	267.194	267.133	267.093	267.063	267.068	267.100	267.092	267.077	267.065	267.040	267.039
EQUIVALENT CHAINAGE ON DFC TRACK	1189989.7	1190009.8	1190029.8	1190049.8	1190069.8	1190089.8	1190109.8	1190129.9	1190149.9	1190169.9	1190189.9	1190210.0	1190230.0	1190250.0	1190270.0	1190290.0	1190310.1	1190330.0	1190350.1	1190370.1
EXISTING IR CHAINAGE	300500.0	300520.0	300540.0	300560.0	300580.0	300600.0	300620.0	300640.0	300660.0	300680.0	300700.0	300720.0	300740.0	300760.0	300780.0	300800.0	300820.0	300840.0	300860.0	300880.0

L - SECTION

SAHNEWAL

PILKHANI

DRG NO. - 301-2/AL/A/1227

NOTE:-
1. DFC WORKS ARE SHOWN IN RED.
2. IR NEW WORKS ARE SHOWN IN VIOLET.
3. ALL DIMENSIONS ARE SHOWN IN METRES.
4. THIS DRAWING IS PREPARED BASED ON LATEST SURVEY DATA HELD ON APRIL-2022. GTS BENCH MARK OF 261.850M CONSIDERED ON TOP OF CANAL BRIDGE ABUTMENT AT DORAHA VILLAGE ALONG THE NH1.
5. DFC NEW CHAINAGE OF 1075.950M IS WITH REFERENCE TO THE IR KM OF 187.500KM END OF KM OF CP-303(SECTION P-3 PILKHANI END) AGAINST THE EXISTING DFC CHAINAGE. 116277.742M ISSUED VIDE LETTER NO. COM/DFCC/UM/SURVEY/2021-301-230116-011173 DT. 17.01.2023.
6. BALLAST PROFILE HAS BEEN PROVIDED ACCORDING TO THE CLAUSE 1.11.3 OF STANDARD SCHEDULE OF DIMENSION(EASTERN CORRIDOR) & THE BALLAST CUSHION DIMENSION SHOWN IN 35CM ON GE-14 PARA 17. SPECIFICATIONS & RECOMMENDATIONS 2. TWO LAYER SYSTEM FIG.10.

REFERENCE DRAWINGS :-
1. FOR KEY PLAN REFER DRAWING NO. 301-2/AL/0001
2. FOR LEGEND AND ABBREVIATIONS REFER DRAWING NO. 301-2/AL/1000
3. FOR TYPICAL SECTION OF BALLAST PROFILE (FL-RL) REFER DRG. NO. 301-2/TK/TFDI-004 (TR.1952)

07.09.2024

SUBMISSION OF AS-BUILT DRAWING

FOR APPROVAL

REV.

DATE

REVISION DETAILS

PURPOSE OF ISSUE

SCALE
HOR - 1:1000
VER - 1:100
SHEET SIZE : A1

LEGEND:
IR TRACK
DFCC TRACK
DFCC FUTURE PROPOSALS
STRUCTURE / BUILDING
DFCC TOE LINE
DFCC FORMATION
RETAINING WALL
ROAD
STREAM, DRAIN, NALA, CANAL.
FENCE
POWER LINES
TBM
ELECTRIC POLE/OHE MAST
IR RAILWAY BOUNDARY
DFCC BOUNDARY

TYPICAL SECTION

TRACK STRUCTURE

RAIL SECTION: 60Kg/m (UIC 60Kg/m) DFC LINE: 60Kg/m (UIC 60Kg/m) IR MAIN LINE: 52Kg/m	Difference between FL- RL (Below Rail Seat)	
	IR Line	DFC
RUBBER PAD	172mm	172mm
SLEEPER DEPTH	6mm	10mm
BALLAST CUSHION	210mm	210mm
Total Depth (FL TO RL)	300mm	350mm

OWNER

DEDICATED FREIGHT CORRIDOR CORPORATION OF INDIA LTD.
(A GOVERNMENT OF INDIA ENTERPRISE)
PROJECT OFFICE/AMBALA UNIT: OLD RAILWAY COLONY (NEAR ANAND MARKET),AMBALA CANTT-133001.
CORPORATE IDENTITY NO. : U60232DL2006G01155068

ENGINEER:

DB Engineering & Consulting GmbH
Deutsche Bahn Engineering & Consulting GmbH

CONTRACTOR:

GIL - TPL JV
TATA

SUBMITTED BY	GIL - TPL JV		
	DATED	NAME	SIGNATURE
PREPARED BY			
CHECKED BY	07.09.2024	VIJAY PRATAP	
APPROVED BY	07.09.2024	PARASURAM KOTYADA	

APPROVED BY
DEUTSCHE BAHN ENGINEERING & CONSULTING GMBH

DATED	NAME	SIGNATURE
Sr. DE./CHIEF ENGINEER	SURESH K.YALANGI	
CHIEF TRACK ENGINEER	RAJ PAL SINGH	
T.L.	H.D. VIDJAK	

STAMP

A AS-BUILT DRAWING
TR. Ref.:.....
ENGINEER Sign.:.....

EMPLOYER (DFCCIL):

DEDICATED FREIGHT CORRIDOR CORPORATION OF INDIA LTD.

TITLE



AS-BUILT PLAN AND PROFILE

DFCC APPR. NO. -
ENGG. APPR. NO. -
DRG. NO. - 301-2/AL/A/1227
SHEET NO. : 1 OF 1
DATE : 07.09.2024

STATUS
A

FROM IR KM: 300.500 TO 301.000
DFC KM: 1189.990 TO 1190.490

TR.

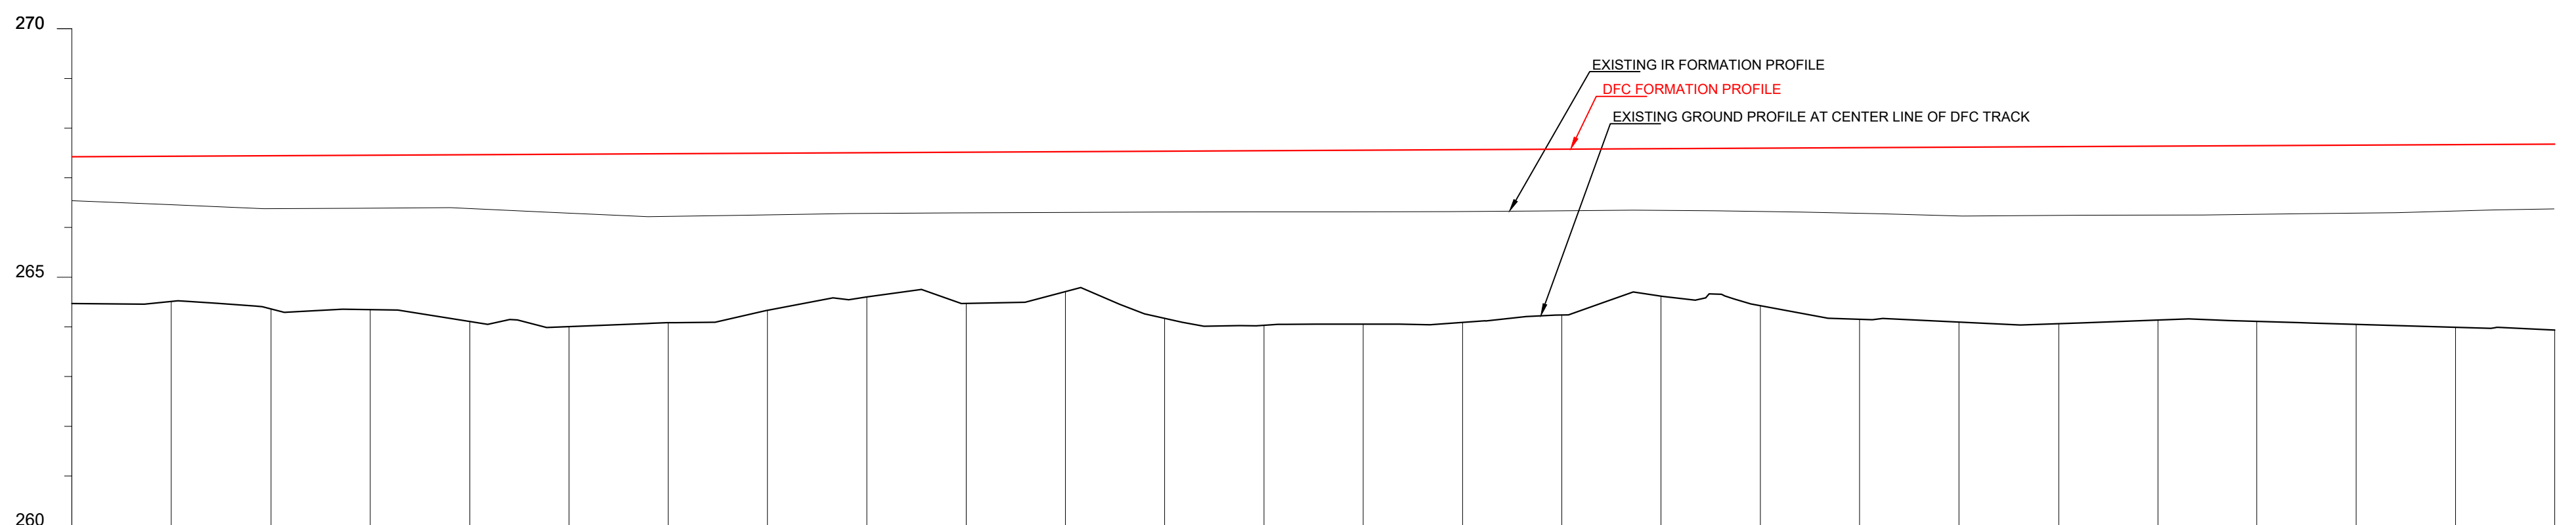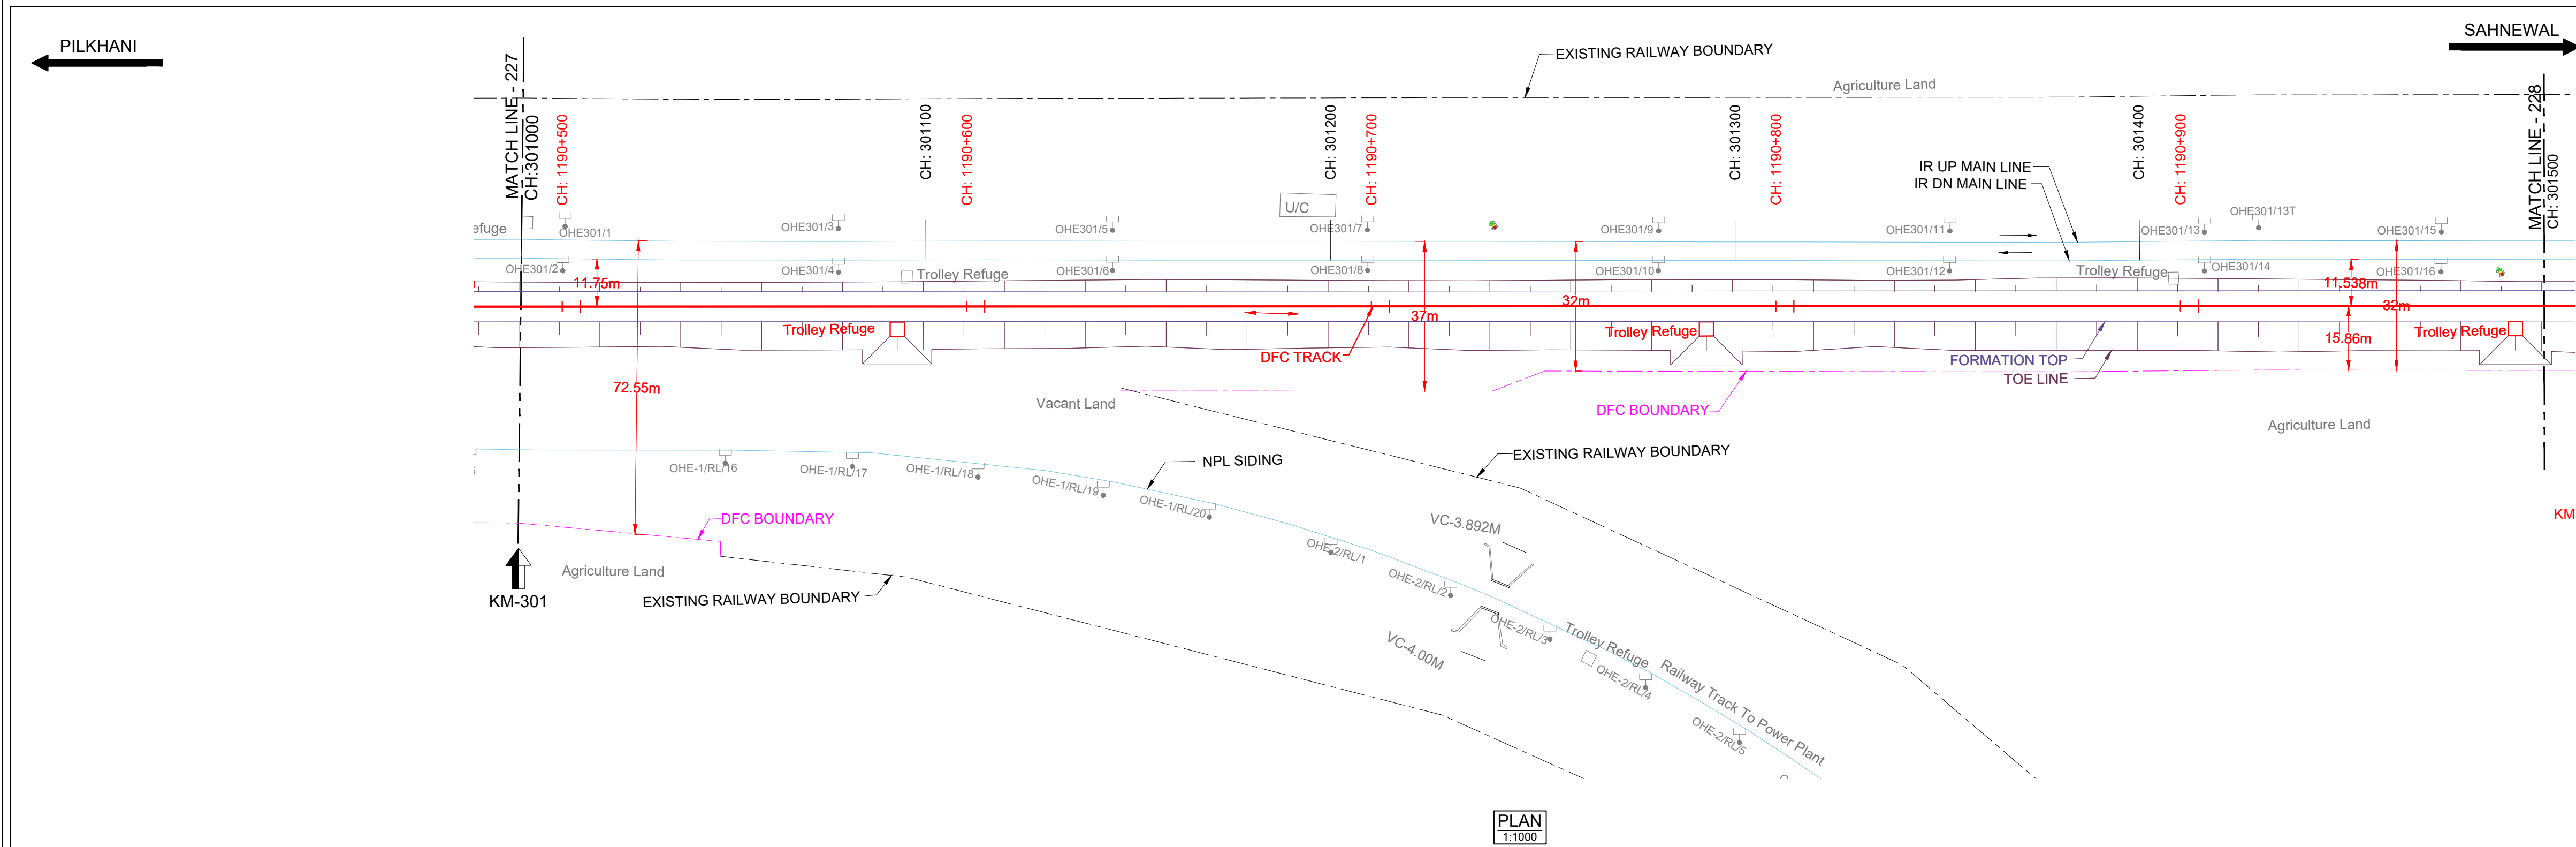

DATUM ABOVE MSL : 260 m

HORIZONTAL ALIGNMENT	L = 1896.657m																			
VERTICAL ALIGNMENT	L=1099.758 m 1 IN 1978.448 R																			
TRACK DISTANCE FROM EXISTING NEAREST IR DN MAIN LINE TO DFC MAIN LINE	11.952	11.952	11.952	11.952	11.952	11.952	11.952	11.952	11.952	11.952	11.952	11.952	11.952	11.952	11.952	11.952	11.952	11.952	11.952	11.952
HEIGHT OF BANKING(+) / DEPTH OF CUTTING(-) (PFL-GL)	+2.953	+2.953	+2.953	+2.953	+2.953	+2.953	+2.953	+2.953	+2.953	+2.953	+2.953	+2.953	+2.953	+2.953	+2.953	+2.953	+2.953	+2.953	+2.953	+2.953
EXG GROUND LEVEL AT CENTER LINE OF DFC TRACK (GL)	264.471	264.471	264.471	264.471	264.471	264.471	264.471	264.471	264.471	264.471	264.471	264.471	264.471	264.471	264.471	264.471	264.471	264.471	264.471	264.471
EXG GROUND LEVEL AT TOE LOCATION OF DFC TRACK	264.184	264.184	264.184	264.184	264.184	264.184	264.184	264.184	264.184	264.184	264.184	264.184	264.184	264.184	264.184	264.184	264.184	264.184	264.184	264.184
DIFFERENCE BETWEEN DFC FORMATION LEVEL AND EXG.FORMATION LEVEL (PFL-EFL)	0.882	0.882	0.882	0.882	0.882	0.882	0.882	0.882	0.882	0.882	0.882	0.882	0.882	0.882	0.882	0.882	0.882	0.882	0.882	0.882
DFC FORMATION LEVEL (PFL)	267.424	267.424	267.424	267.424	267.424	267.424	267.424	267.424	267.424	267.424	267.424	267.424	267.424	267.424	267.424	267.424	267.424	267.424	267.424	267.424
EXG. FORMATION LEVEL OF EXG IR DN MAIN LINE (EFL)	266.542	266.542	266.542	266.542	266.542	266.542	266.542	266.542	266.542	266.542	266.542	266.542	266.542	266.542	266.542	266.542	266.542	266.542	266.542	266.542
DIFFERENCE BETWEEN DFC RAIL LEVEL AND EXG. RAIL LEVEL (PRL - ERL)	0.922	0.922	0.922	0.922	0.922	0.922	0.922	0.922	0.922	0.922	0.922	0.922	0.922	0.922	0.922	0.922	0.922	0.922	0.922	0.922
L - SECTION

NOTE:-

- DFCC WORKS ARE SHOWN IN RED.
- IR NEW WORKS ARE SHOWN IN VIOLET.
- ALL DIMENSIONS ARE SHOWN IN METRES.
- THIS DRAWING IS PREPARED BASED ON LATEST SURVEY DATA HELD ON APRIL-2022. GTS BENCH MARK OF 261.850M CONSIDERED ON TOP OF CANAL BRIDGE ABUTMENT AT DORANA VILLAGE ALONG THE NH1.
- DFC NEW CHAINAGE OF 1075.950M IS WITH REFERENCE TO THE IR KM OF 187.500KM END OF KM OF CP-303(SECTION P-3 PILKHANI END) AGAINST THE EXISTING DFC CHAINAGE. 116277.742M ISSUED VIDE LETTER NO. COM/DFCC/UMS/SURVEY/2021-301-2301/16-011173 DT. 17.01.2023.
- BALLAST PROFILE HAS BEEN PROVIDED ACCORDING TO THE CLAUSE 1.11.3 OF STANDARD SCHEDULE OF DIMENSION(EASTERN CORRIDOR) & THE BALLAST CUSHION DIMENSION SHOWN IN 35CM ON GE-14 PARA 17. SPECIFICATIONS & RECOMMENDATIONS 2. TWO LAYER SYSTEM FIG.10.

REFERENCE DRAWINGS :-

- FOR KEY PLAN REFER DRAWING NO. 301-2/AL/0001
- FOR LEGEND AND ABBREVIATIONS REFER DRAWING NO. 301-2/AL/1000
- FOR TYPICAL SECTION OF BALLAST PROFILE (FL-RL) REFER DRG. NO. 301-2/TK/TFD/-004 (TR.1952)

07.09.2024SUBMISSION OF AS-BUILT DRAWINGFOR APPROVAL

REV. DATE REVISION DETAILS PURPOSE OF ISSUE

SCALE
HOR - 1:1000
VER - 1:100
SHEET SIZE : A1

LEGEND:

- IR TRACK
- DFCC TRACK
- DFCC FUTURE PROPOSALS
- STRUCTURE / BUILDING
- DFCC TOE LINE
- DFCC FORMATION
- RETAINING WALL
- ROAD
- STREAM, DRAIN, NALA, CANAL.
- FENCE
- POWER LINES
- TBM
- ELECTRIC POLE/OHE MAST
- IR RAILWAY BOUNDARY
- DFCC BOUNDARY

TRACK STRUCTURE

RAIL SECTION: 60Kg/m (UIC 60Kg/m)	Difference between FL- RL (Below Rail Seat)	
DFC LINE: 60Kg/m (UIC 60Kg/m)	IR Line	DFC
IR MAIN LINE: 52Kg/m	172mm	172mm
RUBBER PAD	6mm	10mm
SLEEPER DEPTH	210mm	210mm
BALLAST CUSHION	300mm	350mm
Total Depth (FL TO RL)	688mm	742mm

OWNER

DEDICATED FREIGHT CORRIDOR CORPORATION OF INDIA LTD.
(A GOVERNMENT OF INDIA ENTERPRISE)
PROJECT OFFICE(AMBALA UNIT): OLD RAILWAY COLONY (NEAR ANAND MARKET),AMBALA CANTT-133001.
CORPORATE IDENTITY NO. : U60232DL2006GGI155068

ENGINEER:

DB Engineering & Consulting GmbH
Deutsche Bahn Engineering & Consulting GmbH

CONTRACTOR:

GIL - TPL JV
GAR TATA

SUBMITTED BY	GIL - TPL JV		
PREPARED BY	DATED	NAME	SIGNATURE
CHECKED BY	07.09.2024	VIJAY PRATAP	
APPROVED BY	07.09.2024	PARASURAM KOTYADA	

APPROVED BY

DEUTSCHE BAHN ENGINEERING & CONSULTING GMBH

DATED	NAME	SIGNATURE
Sr. DE./CHIEF ENGINEER	SURESH K.YALANGI	
CHIEF TRACK ENGINEER	RAJ PAL SINGH	
T.L.	H.D. VIDJAK	

STAMP

A AS-BUILT DRAWING
TR. Ref.....
ENGINEER Sign.:

EMPLOYER (DFCCIL):

DEDICATED FREIGHT CORRIDOR CORPORATION OF INDIA LTD.



AS BUILT DRAWING

TITLE
AS-BUILT PLAN AND PROFILE
FROM IR KM: 301.000 TO 301.500
DFC KM: 1190.490 TO 1190.990



DFCC APPR. NO. -
ENGG. APPR. NO. -
DRG. NO. - 301-2/AL/A/1228
SHEET NO. : 1 OF 1
DATE : 07.09.2024

STATUS
A

TR.

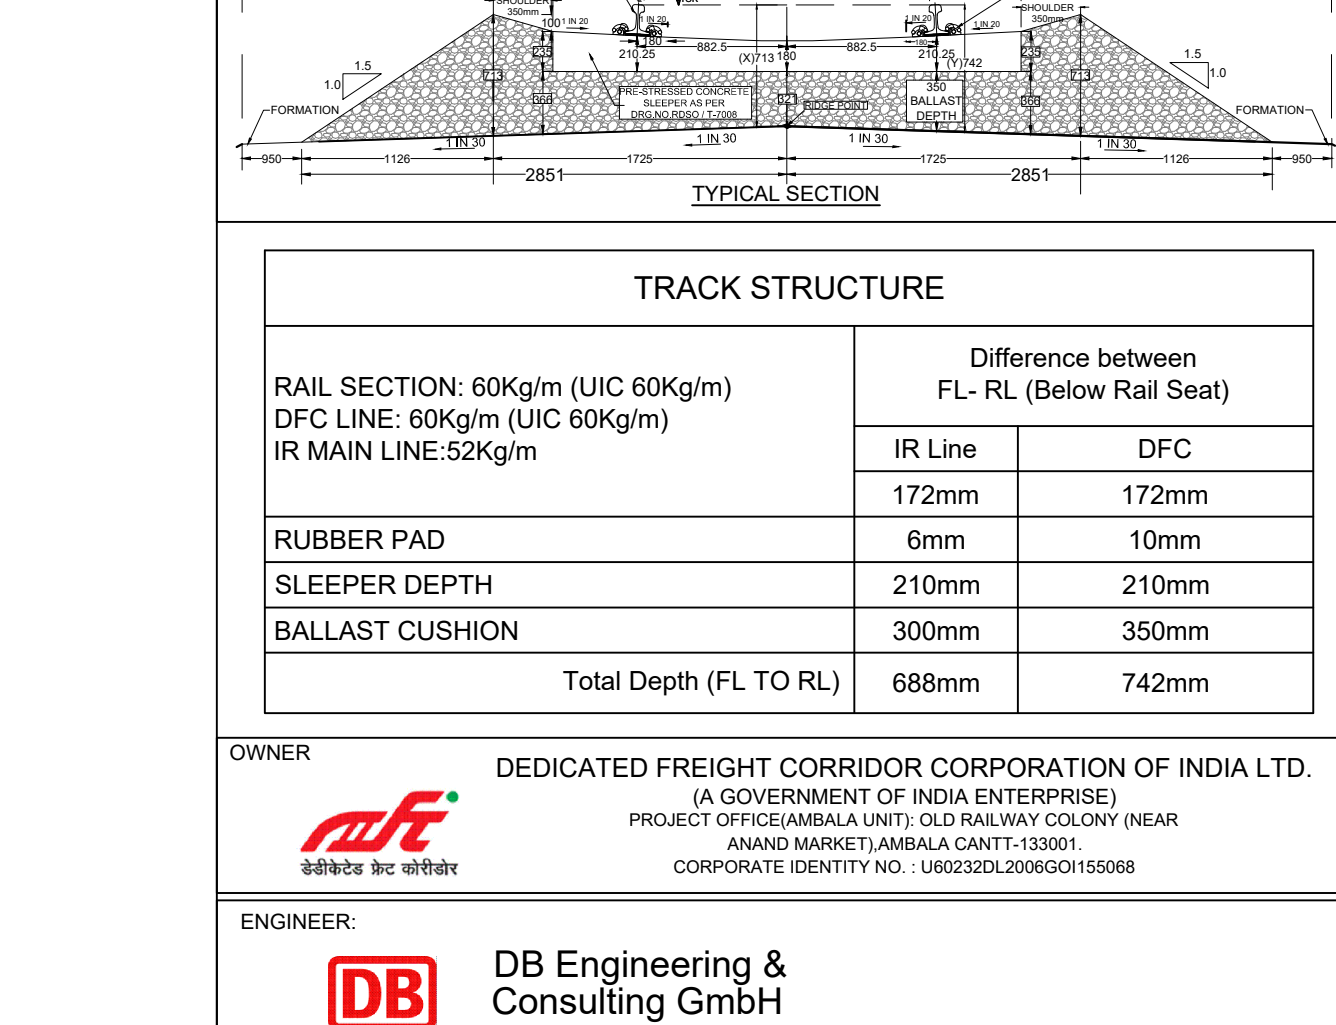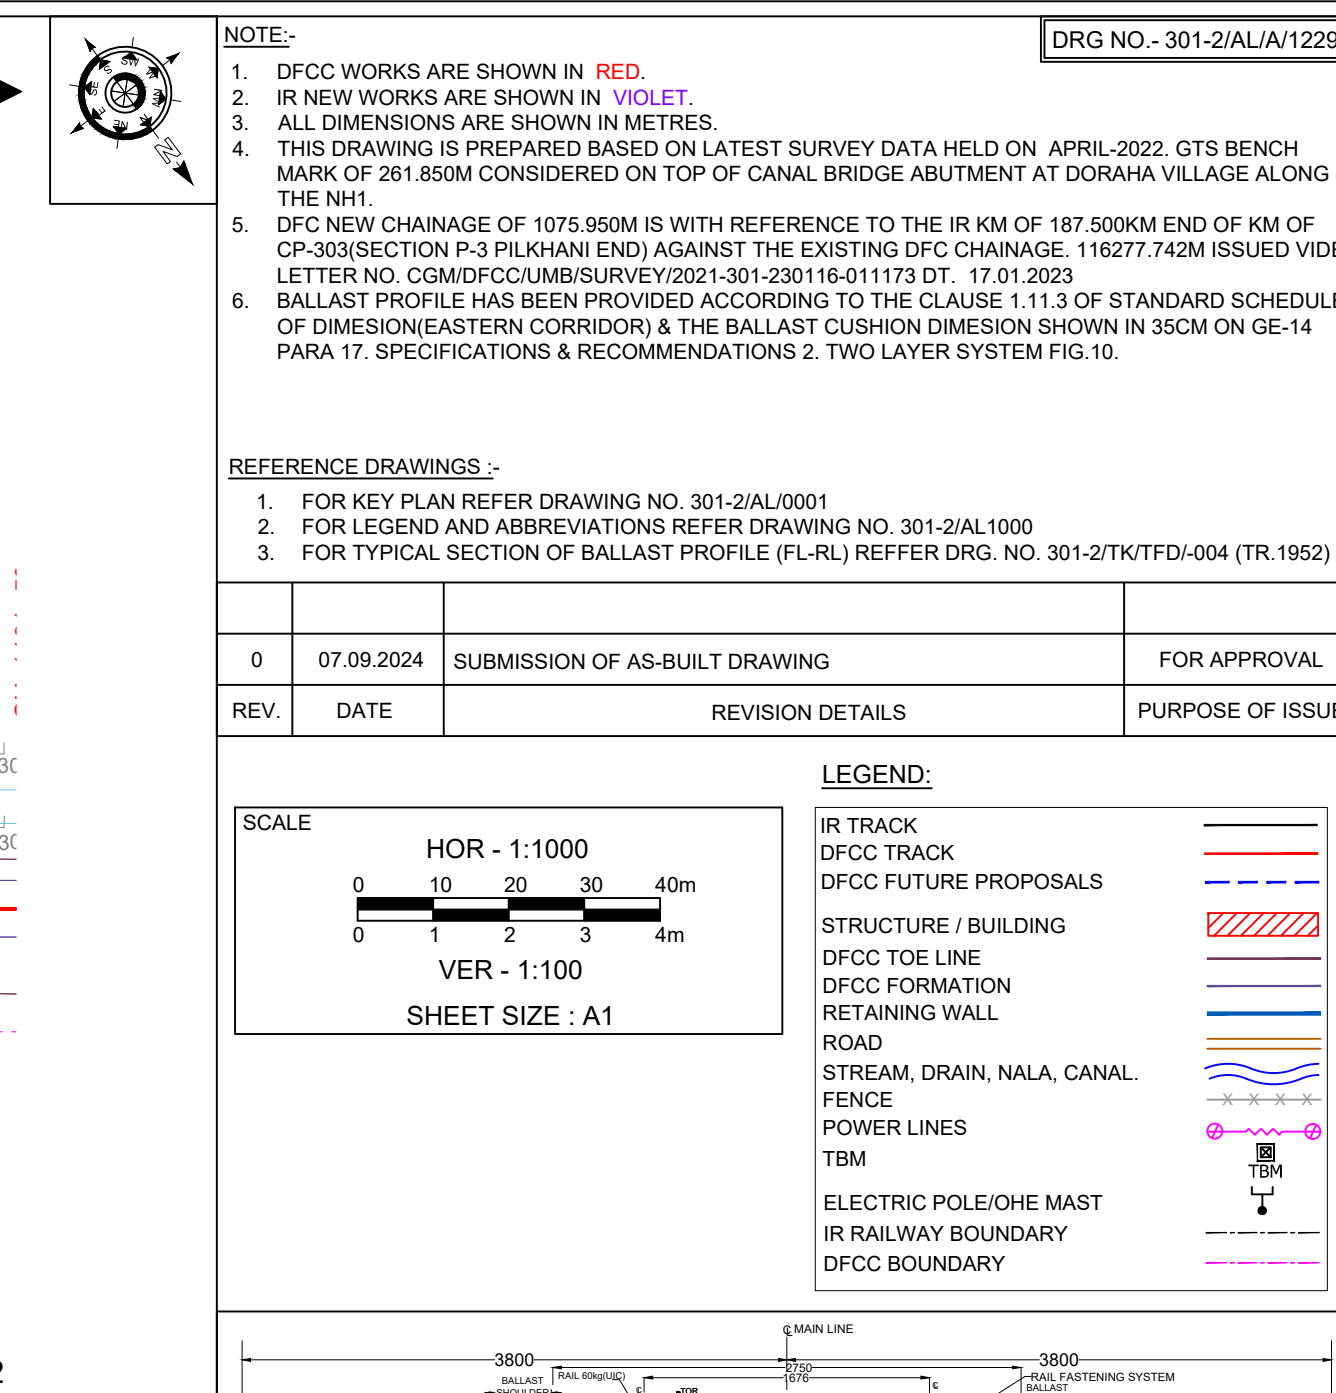

Deutsche Bahn Engineering & Consulting GmbH GIL - TPL JV  			
CONTRACTOR:			
SUBMITTED BY	GIL - TPL JV		
	DATED	NAME	SIGNATURE
PREPARED BY			
CHECKED BY	07.09.2024	VIJAY PRATAP	
APPROVED BY	07.09.2024	PARASURAM KOTYADA	
APPROVED BY	DEUTSCHE BAHN ENGINEERING & CONSULTING GMBH		
	DATED	NAME	SIGNATURE
Sr. DE./CHIEF ENGINEER		SURESH K.YALANGI	
CHIEF TRACK ENGINEER		RAJ PAL SINGH	
T.L.		H.D. VIDJAK	
STAMP	A AS-BUILT DRAWING TR. Ref..... ENGINEER Sign.:		
EMPLOYER (DFCCIL):	DEDICATED FREIGHT CORRIDOR CORPORATION OF INDIA LTD		
AS BUILT DRAWING			
TITLE AS-BUILT PLAN AND PROFILE FROM IR KM: 301.500 TO 302.000 DFC KM: 1190.990 TO 1191.490		DFCC APPR. NO. -	
		ENGG. APPR. NO. -	
		DRG. NO. -301-2/AL/A/1229	
		SHEET NO. : 1 OF 1	
		DATE : 07.09.2024	
		STATUS	
		A	

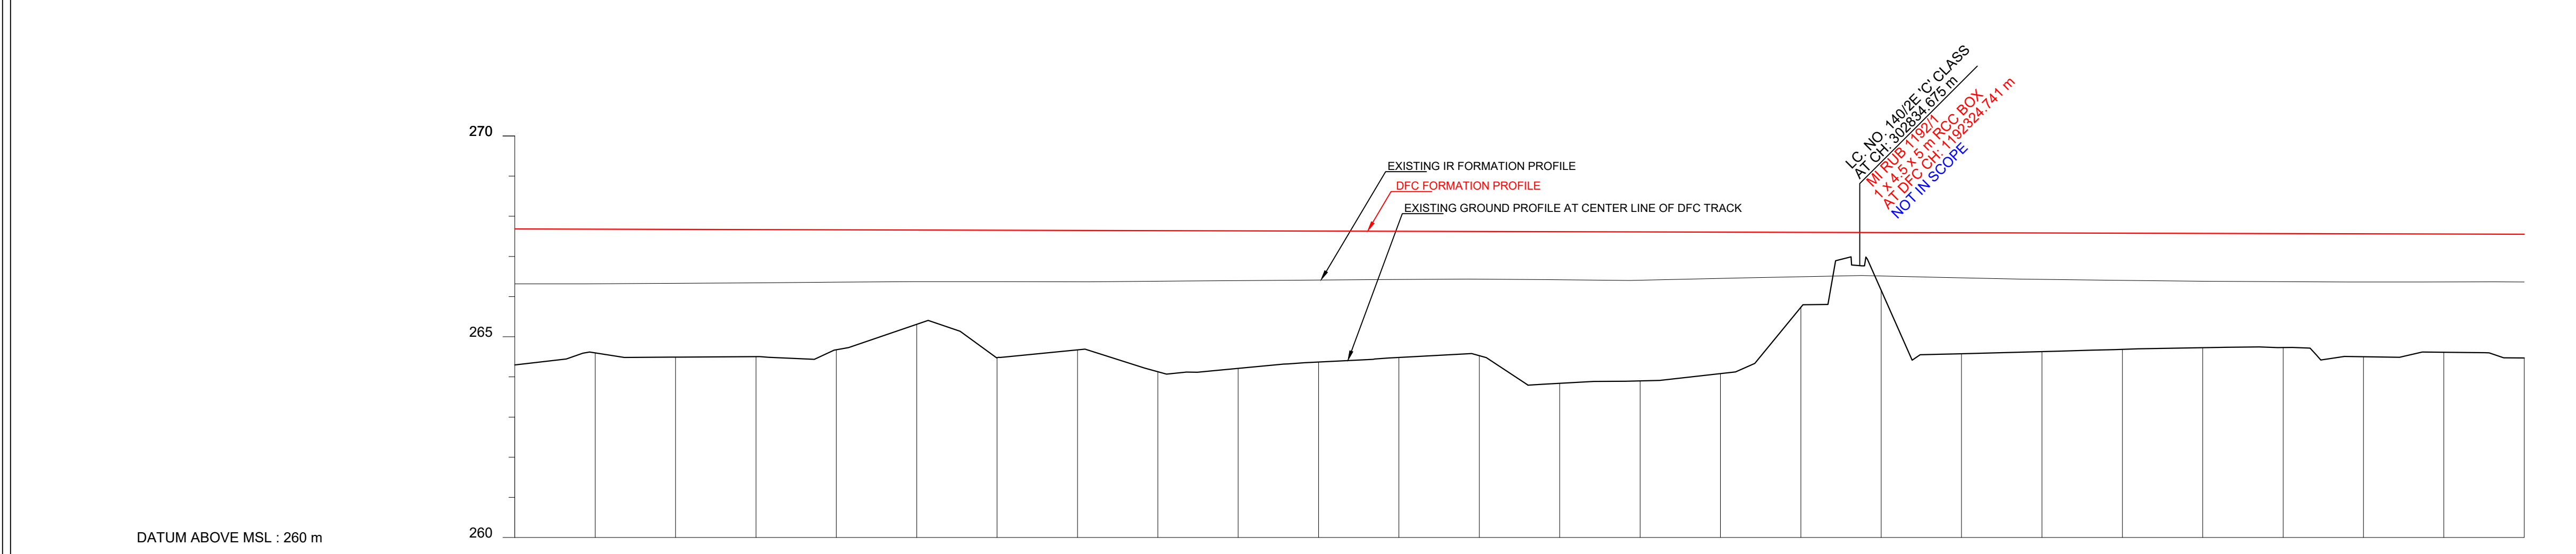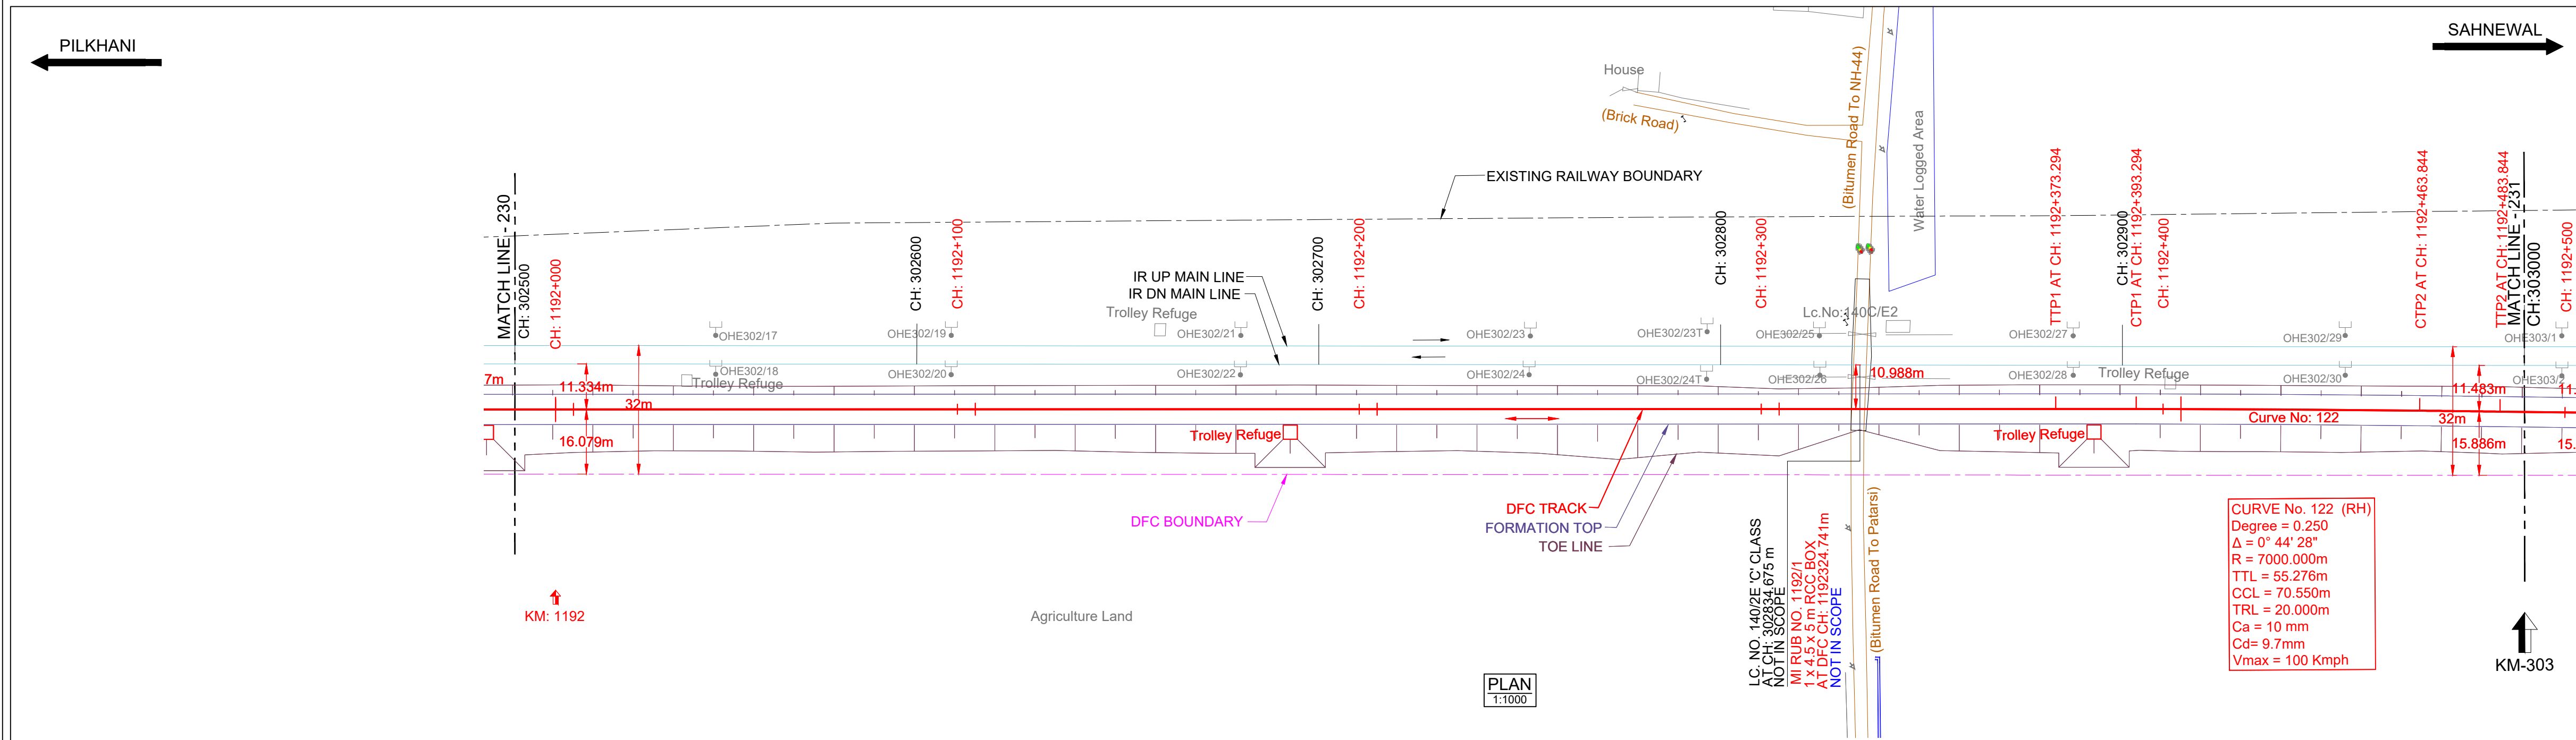

HORIZONTAL ALIGNMENT	L = 1896.657m																			
VERTICAL ALIGNMENT	L=1820.969 m 1 IN 3834.074 F																			
TRACK DISTANCE FROM EXISTING NEAREST IR DN MAIN LINE TO DFC MAIN LINE	11.350	11.330	11.312	11.294	11.284	11.273	11.249	11.226	11.149	11.109	11.073	11.053	11.034	11.018	11.001	10.976	10.924	10.884	10.927	11.594
HEIGHT OF BANKING(+) / DEPTH OF CUTTING(-) (PFL-GL)	+3.388	+3.082	+3.182	+3.166	+2.987	+2.347	+3.174	+2.977	+3.263	+3.142	+3.094	+3.777	+3.711	+3.524	+1.866	+1.438	+3.017	+2.893	+2.845	+3.083
EXG GROUND LEVEL AT CENTER LINE OF DFC TRACK (GL)	264.296	264.597	264.492	264.503	264.677	265.311	264.479	264.671	264.369	264.485	264.528	263.840	263.900	264.082	265.735	266.159	264.574	264.687	264.730	264.471
EXG GROUND LEVEL AT TOE LOCATION OF DFC TRACK	263.842	264.260	264.397	264.331	264.238	264.322	264.362	264.343	264.073	264.252	264.265	263.810	263.471	263.992	264.536	266.199	264.249	264.173	264.191	264.260
DIFFERENCE BETWEEN DFC FORMATION LEVEL AND EXG.FORMATION LEVEL.(PFL-EFL)	1.368	1.361	1.342	1.326	1.303	1.286	1.281	1.278	1.220	1.203	1.191	1.200	1.204	1.155	1.108	1.082	1.124	1.178	1.195	1.190
DFC FORMATION LEVEL (PFL)	267.684	267.679	267.674	267.669	267.664	267.658	267.653	267.648	267.632	267.627	267.622	267.617	267.611	267.606	267.601	267.596	267.591	267.580	267.575	267.554
EXG. FORMATION LEVEL OF EXG IR DN MAIN LINE (EFL)	266.316	266.318	266.332	266.343	266.361	266.372	266.372	266.370	266.412	266.424	266.431	266.417	266.407	266.451	266.493	266.514	266.467	266.402	266.380	266.384
DIFFERENCE BETWEEN DFC RAIL LEVEL AND EXG. RAIL LEVEL (PRL - ERL)	1.410	1.402	1.383	1.367	1.344	1.327	1.322	1.319	1.300	1.244	1.231	1.241	1.245	1.196	1.149	1.123	1.164	1.219	1.236	1.231
DFC RAIL LEVEL (PRL)	268.397	268.392	268.397	268.382	268.377	268.371	268.366	268.361	268.356	268.340	268.335	268.330	268.324	268.319	268.314	268.309	268.304	268.293	268.288	268.287
EXG.RAIL LEVEL OF NEAREST IR DN MAIN LINE(ERL)	266.988	266.990	267.004	267.015	267.033	267.044	267.044	267.042	267.055	267.066	267.073	267.089	267.079	267.123	267.165	267.186	267.139	267.074	267.062	267.036
EQUIVALENT CHAINAGE ON DFC TRACK	1191990.0	1192010.1	1192030.1	1192050.1	1192070.1	1192090.1	1192110.1	1192130.1	1192150.1	1192170.1	1192190.1	1192210.1	1192230.1	1192250.1	1192270.1	1192290.1	1192310.1	1192330.1	1192350.1	1192370.1
EXISTING IR CHAINAGE	302500.0	302520.0	302540.0	302560.0	302580.0	302600.0	302620.0	302640.0	302660.0	302680.0	302700.0	302720.0	302740.0	302760.0	302780.0	302800.0	302820.0	302840.0	302860.0	303000.0

NOTE:-

- DFCC WORKS ARE SHOWN IN RED.
- IR NEW WORKS ARE SHOWN IN VIOLET.
- ALL DIMENSIONS ARE SHOWN IN METRES.
- THIS DRAWING IS PREPARED BASED ON LATEST SURVEY DATA HELD ON APRIL-2022. GTS BENCH MARK OF 261.850M CONSIDERED ON TOP OF CANAL BRIDGE ABUTMENT AT DORAHA VILLAGE ALONG THE NH1.
- DFC NEW CHAINAGE OF 1075.950M IS WITH REFERENCE TO THE IR KM OF 187.500KM END OF KM OF CP-303(SECTION P-3 PILKHANI END) AGAINST THE EXISTING DFC CHAINAGE. 116277.742M ISSUED VIDE LETTER NO. COM/DFCC/UMS/SURVEY/2021-301-2301/16-01/173 DT. 17.01.2023.
- BALLAST PROFILE HAS BEEN PROVIDED ACCORDING TO THE CLAUSE 1.11.3 OF STANDARD SCHEDULE OF DIMENSION(EASTERN CORRIDOR) & THE BALLAST CUSHION DIMENSION SHOWN IN 35CM ON GE-14 PARA 17. SPECIFICATIONS & RECOMMENDATIONS 2. TWO LAYER SYSTEM FIG.10.

REFERENCE DRAWINGS :-

- FOR KEY PLAN REFER DRAWING NO. 301-2/AL/0001
- FOR LEGEND AND ABBREVIATIONS REFER DRAWING NO. 301-2/AL/1000
- FOR TYPICAL SECTION OF BALLAST PROFILE (FL-RL) REFER DRG. NO. 301-2/TK/TFD/-004 (TR.1952)

LEGEND:

IR TRACK
DFCC TRACK
DFCC FUTURE PROPOSALS
STRUCTURE / BUILDING
DFCC TOE LINE
DFCC FORMATION
RETAINING WALL
ROAD
STREAM, DRAIN, NALA, CANAL.
FENCE
POWER LINES
TBM
ELECTRIC POLE/OHE MAST
IR RAILWAY BOUNDARY
DFCC BOUNDARY

SCALE

HOR - 1:1000
VER - 1:100
SHEET SIZE : A1

TYPICAL SECTION

TRACK STRUCTURE		Difference between FL- RL (Below Rail Seat)	
RAIL SECTION: 60Kg/m (UIC 60Kg/m)		IR Line	DFC
DFC LINE: 60Kg/m (UIC 60Kg/m)		172mm	172mm
IR MAIN LINE: 52Kg/m		6mm	10mm
RUBBER PAD		210mm	210mm
SLEEPER DEPTH		300mm	350mm
BALLAST CUSHION		688mm	742mm

OWNER

DEDICATED FREIGHT CORRIDOR CORPORATION OF INDIA LTD.
(A GOVERNMENT OF INDIA ENTERPRISE)
PROJECT OFFICE(AMBALA UNIT): OLD RAILWAY COLONY (NEAR ANAND MARKET),AMBALA CANTT-133001.
CORPORATE IDENTITY NO. : U60232DL2006GGI155068

ENGINEER:

DB Engineering & Consulting GmbH
Deutsche Bahn Engineering & Consulting GmbH

CONTRACTOR:

GIL - TPL JV
GAR TATA

SUBMITTED BY	GIL - TPL JV		
	DATED	NAME	SIGNATURE
PREPARED BY			
CHECKED BY	07.09.2024	VIJAY PRATAP	
APPROVED BY	07.09.2024	PARASURAM KOTYADA	
APPROVED BY	DEUTSCHE BAHN ENGINEERING & CONSULTING GMBH		
	DATED	NAME	SIGNATURE
Sr. DE./CHIEF ENGINEER		SURESH K.YALANGI	
CHIEF TRACK ENGINEER		RAJ PAL SINGH	
T.L.		H.D. VIDJAK	

STAMP

AS-BUILT DRAWING
TR. Ref.:.....
ENGINEER Sign.:.....

EMPLOYER (DFCCIL):

DEDICATED FREIGHT CORRIDOR CORPORATION OF INDIA LTD.

TITLE



AS-BUILT PLAN AND PROFILE

FROM IR KM: 302.500 TO 303.000
DFC KM: 1191.990 TO 1192.490

DFCC APPR. NO. -
ENGG. APPR. NO. -
DRG. NO. - 301-2/AL/A/1231
SHEET NO. : 1 OF 1
DATE : 07.09.2024


STATUS
A

TR.

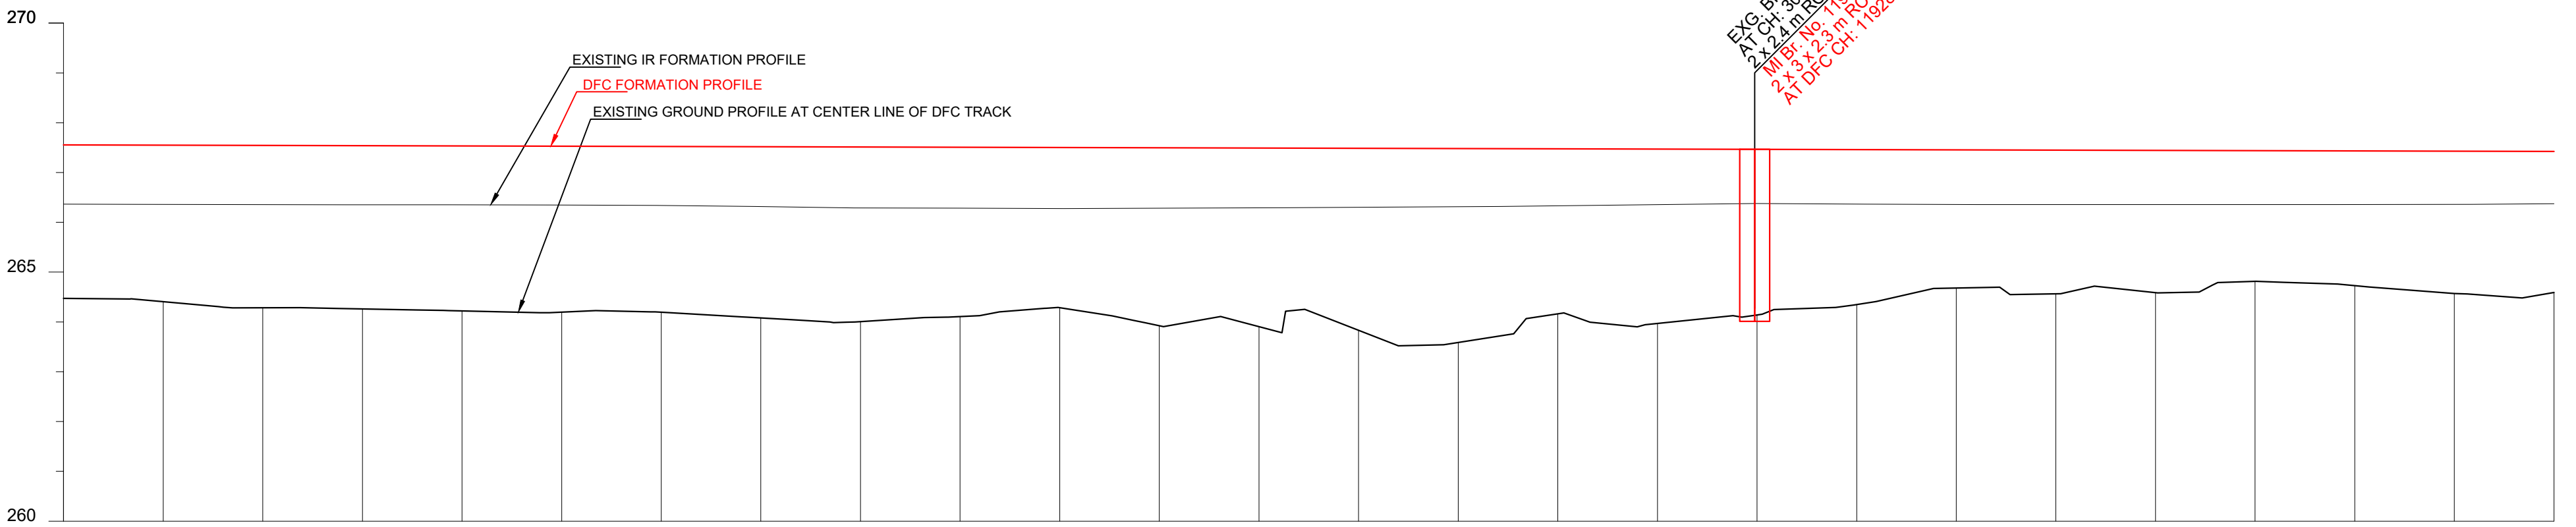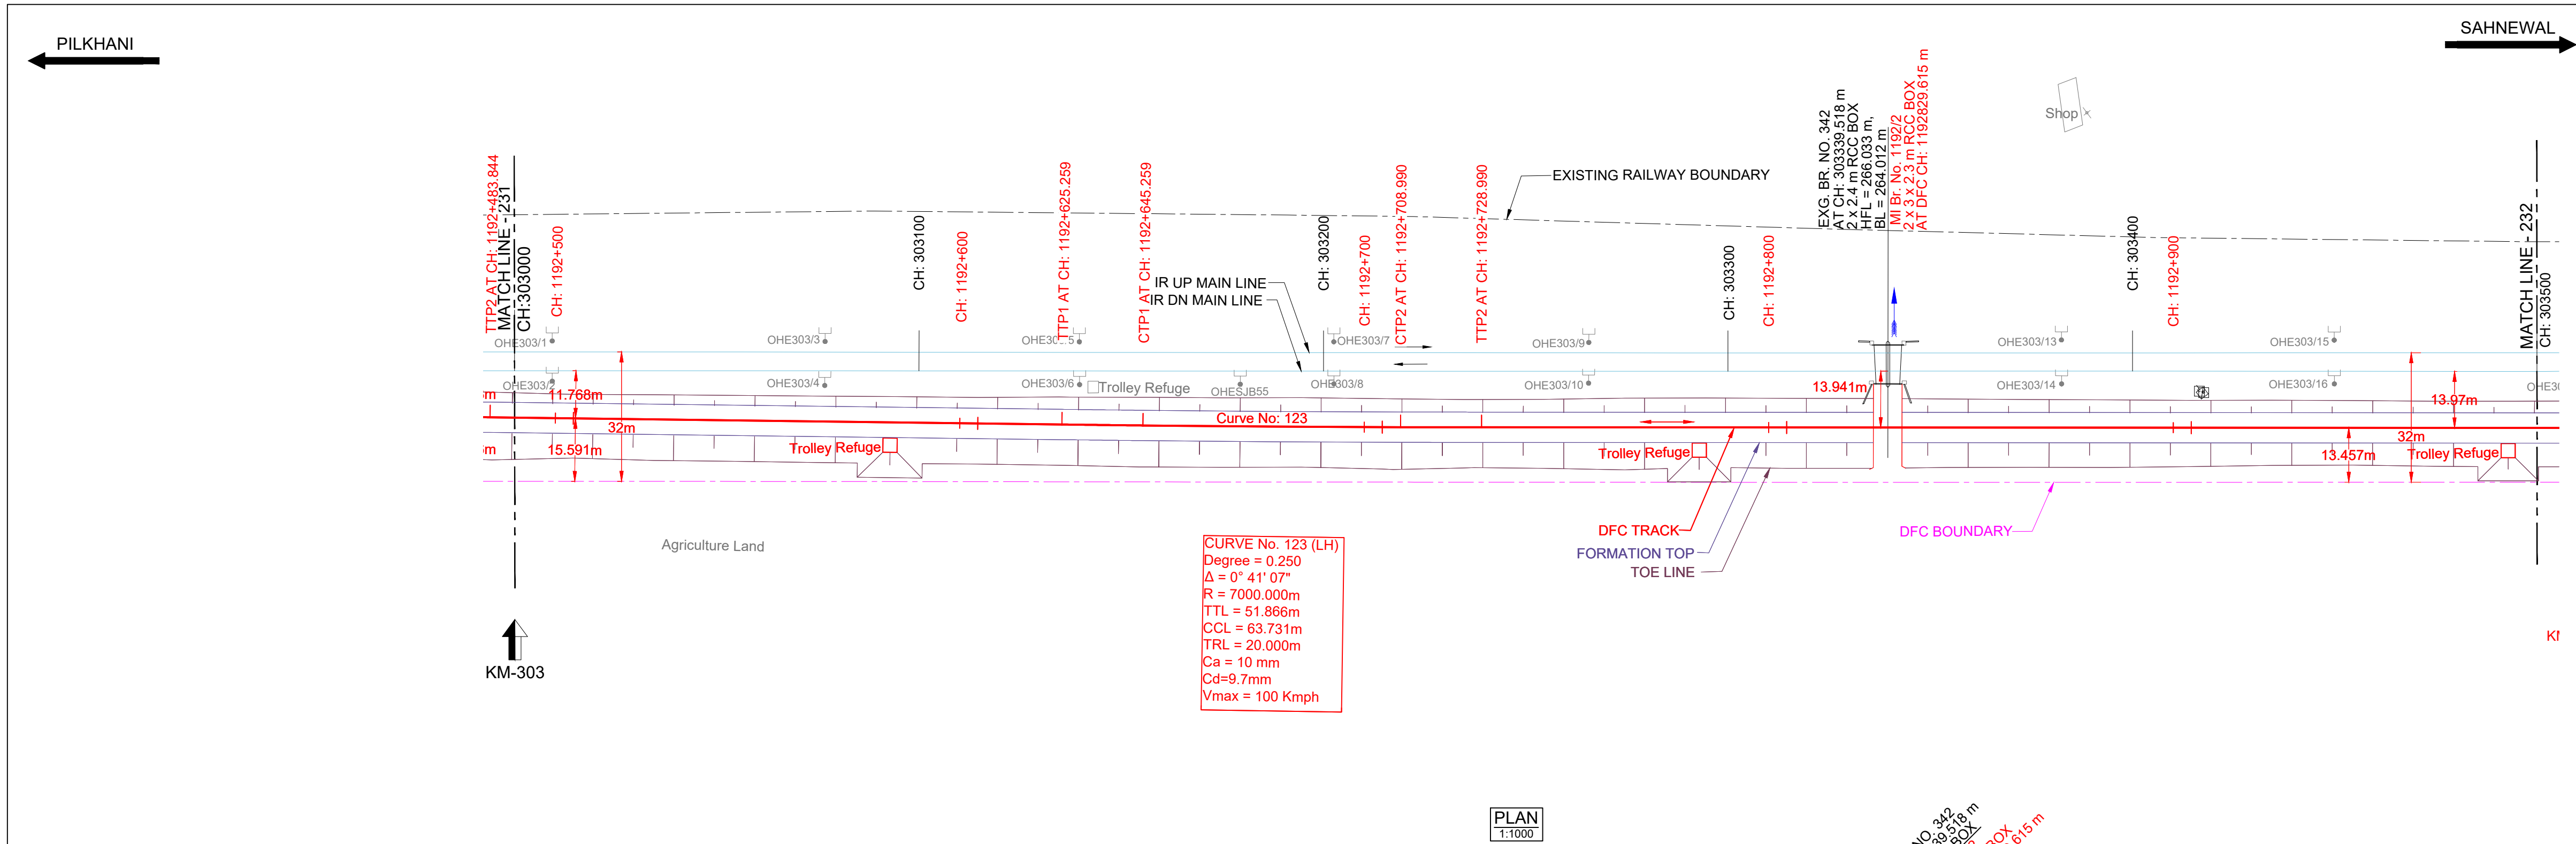

HORIZONTAL ALIGNMENT	L=141.415m TL= 20m CCL=63.731 R=7000 TL= 20m L=3511.712m																			
VERTICAL ALIGNMENT	L=1820.969 m 1 IN 3834.074 F																			
TRACK DISTANCE FROM EXISTING NEAREST IR DN MAIN LINE TO DFC MAIN LINE	11.594	11.594	11.594	11.594	11.594	11.594	11.594	11.594	11.594	11.594	11.594	11.594	11.594	11.594	11.594	11.594	11.594	11.594	11.594	11.594
HEIGHT OF BANKING(+) / DEPTH OF CUTTING(-) (PFL-GL)	+3.083	+3.083	+3.083	+3.083	+3.083	+3.083	+3.083	+3.083	+3.083	+3.083	+3.083	+3.083	+3.083	+3.083	+3.083	+3.083	+3.083	+3.083	+3.083	+3.083
EXG GROUND LEVEL AT CENTER LINE OF DFC TRACK (GL)	264.471	264.471	264.471	264.471	264.471	264.471	264.471	264.471	264.471	264.471	264.471	264.471	264.471	264.471	264.471	264.471	264.471	264.471	264.471	264.471
EXG GROUND LEVEL AT TOE LOCATION OF DFC TRACK	264.260	264.260	264.260	264.260	264.260	264.260	264.260	264.260	264.260	264.260	264.260	264.260	264.260	264.260	264.260	264.260	264.260	264.260	264.260	264.260
DIFFERENCE BETWEEN DFC FORMATION LEVEL AND EXG.FORMATION LEVEL.(PFL-EFL)	1.190	1.190	1.190	1.190	1.190	1.190	1.190	1.190	1.190	1.190	1.190	1.190	1.190	1.190	1.190	1.190	1.190	1.190	1.190	1.190
DFC FORMATION LEVEL (PFL)	267.554	267.554	267.554	267.554	267.554	267.554	267.554	267.554	267.554	267.554	267.554	267.554	267.554	267.554	267.554	267.554	267.554	267.554	267.554	267.554
EXG. FORMATION LEVEL OF EXG IR DN MAIN LINE (EFL)	266.364	266.364	266.364	266.364	266.364	266.364	266.364	266.364	266.364	266.364	266.364	266.364	266.364	266.364	266.364	266.364	266.364	266.364	266.364	266.364
DIFFERENCE BETWEEN DFC RAIL LEVEL AND EXG. RAIL LEVEL (PRL - ERL)	1.231	1.231	1.231	1.231	1.231	1.231	1.231	1.231	1.231	1.231	1.231	1.231	1.231	1.231	1.231	1.231	1.231	1.231	1.231	1.231
L - SECTION

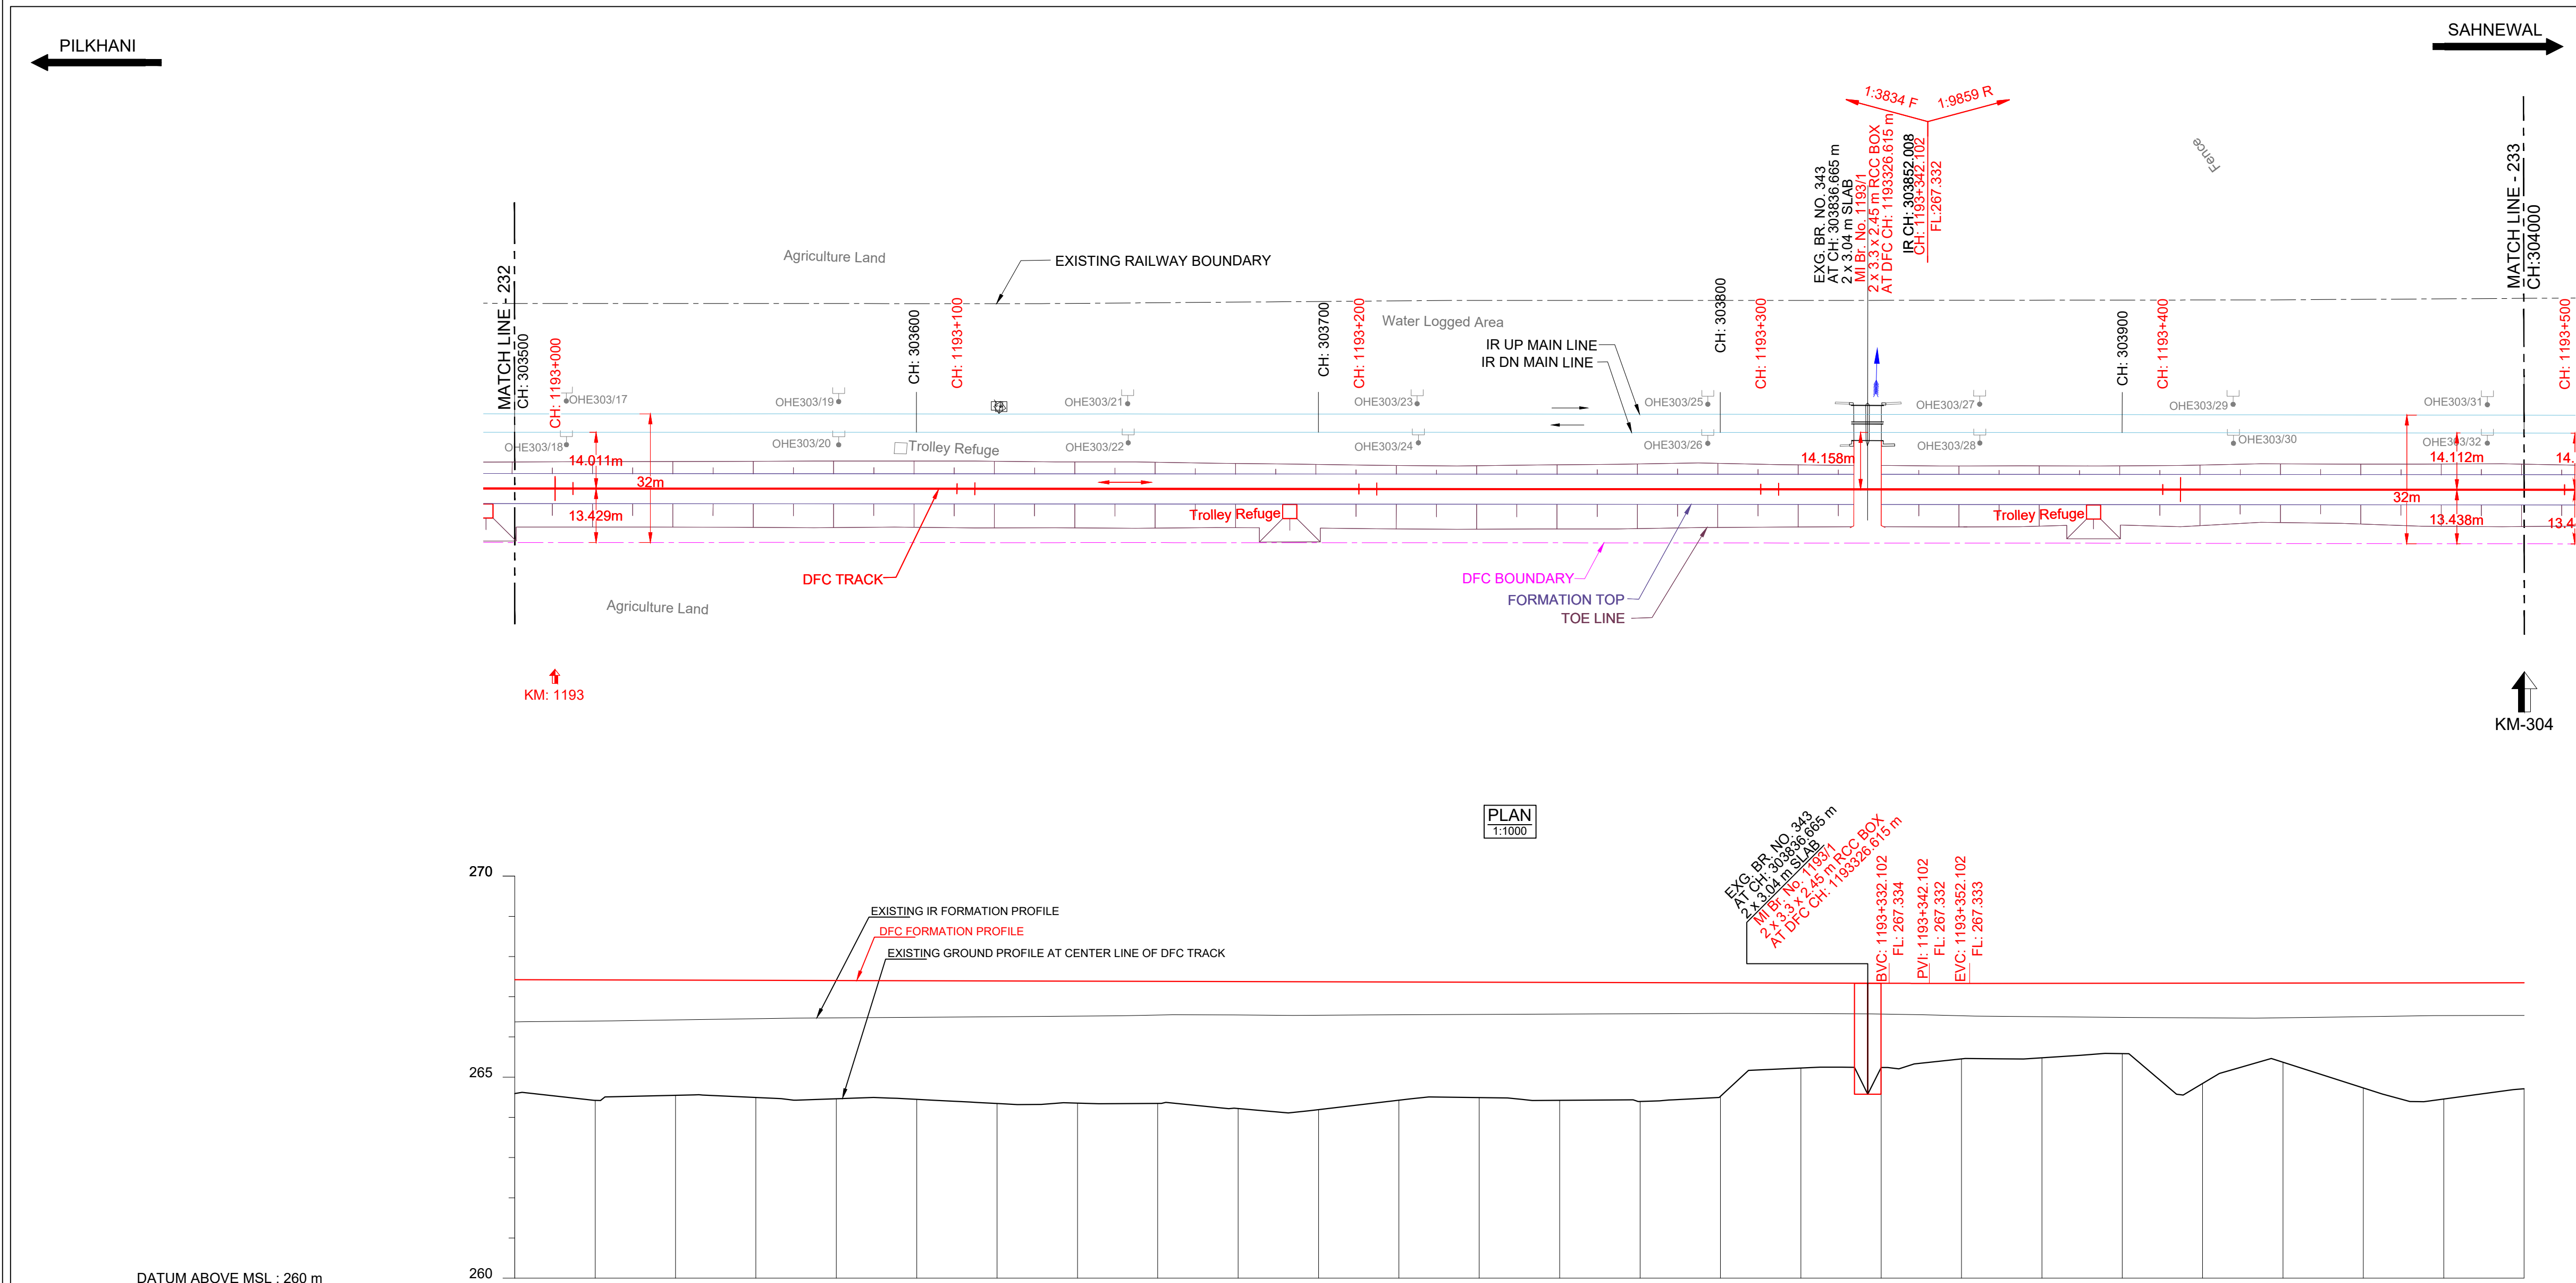

HORIZONTAL ALIGNMENT	L=3511.712m																			
VERTICAL ALIGNMENT	L=1820.969 m 1 IN 3834.074 F																			
TRACK DISTANCE FROM EXISTING NEAREST IR DN MAIN LINE TO DFC MAIN LINE	13.989	13.989	13.989	13.989	13.989	13.989	13.989	13.989	13.989	13.989	13.989	13.989	13.989	13.989	13.989	13.989	13.989	13.989	13.989	13.989
HEIGHT OF BANKING(+) / DEPTH OF CUTTING(-) (PFL-GL)	+2.831	+2.831	+2.831	+2.831	+2.831	+2.831	+2.831	+2.831	+2.831	+2.831	+2.831	+2.831	+2.831	+2.831	+2.831	+2.831	+2.831	+2.831	+2.831	+2.831
EXG GROUND LEVEL AT CENTER LINE OF DFC TRACK (GL)	264.593	264.593	264.593	264.593	264.593	264.593	264.593	264.593	264.593	264.593	264.593	264.593	264.593	264.593	264.593	264.593	264.593	264.593	264.593	264.593
EXG GROUND LEVEL AT TOE LOCATION OF DFC TRACK	264.449	264.449	264.449	264.449	264.449	264.449	264.449	264.449	264.449	264.449	264.449	264.449	264.449	264.449	264.449	264.449	264.449	264.449	264.449	264.449
DIFFERENCE BETWEEN DFC FORMATION LEVEL AND EXG.FORMATION LEVEL (PFL-EFL)	1.049	1.049	1.049	1.049	1.049	1.049	1.049	1.049	1.049	1.049	1.049	1.049	1.049	1.049	1.049	1.049	1.049	1.049	1.049	1.049
DFC FORMATION LEVEL (PFL)	267.424	267.424	267.424	267.424	267.424	267.424	267.424	267.424	267.424	267.424	267.424	267.424	267.424	267.424	267.424	267.424	267.424	267.424	267.424	267.424
EXG. FORMATION LEVEL OF EXG IR DN MAIN LINE (EFL)	266.375	266.375	266.375	266.375	266.375	266.375	266.375	266.375	266.375	266.375	266.375	266.375	266.375	266.375	266.375	266.375	266.375	266.375	266.375	266.375
DIFFERENCE BETWEEN DFC RAIL LEVEL AND EXG. RAIL LEVEL (PRL - ERL)	1.089	1.089	1.089	1.089	1.089	1.089	1.089	1.089	1.089	1.089	1.089	1.089	1.089	1.089	1.089	1.089	1.089	1.089	1.089	1.089
DFC RAIL LEVEL (PRL)	268.137	268.137	268.137	268.137	268.137	268.137	268.137	268.137	268.137	268.137	268.137	268.137	268.137	268.137	268.137	268.137	268.137	268.137	268.137	268.137
EXG.RAIL LEVEL OF NEAREST IR DN MAIN LINE(ERL)	267.047	267.047	267.047	267.047	267.047	267.047	267.047	267.047	267.047	267.047	267.047	267.047	267.047	267.047	267.047	267.047	267.047	267.047	267.047	267.047
EQUIVALENT CHAINAGE ON DFC TRACK	1193990.0	1193990.0	1193990.0	1193990.0	1193990.0	1193990.0	1193990.0	1193990.0	1193990.0	1193990.0	1193990.0	1193990.0	1193990.0	1193990.0	1193990.0	1193990.0	1193990.0	1193990.0	1193990.0	1193990.0
EXISTING IR CHAINAGE	303500.0	303500.0	303500.0	303500.0	303500.0	303500.0	303500.0	303500.0	303500.0	303500.0	303500.0	303500.0	303500.0	303500.0	303500.0	303500.0	303500.0	303500.0	303500.0	303500.0

NOTE:-

- DFCC WORKS ARE SHOWN IN RED.
- IR NEW WORKS ARE SHOWN IN VIOLET.
- ALL DIMENSIONS ARE SHOWN IN METRES.
- THIS DRAWING IS PREPARED BASED ON LATEST SURVEY DATA HELD ON APRIL-2022. GTS BENCH MARK OF 261.850M CONSIDERED ON TOP OF CANAL BRIDGE ABUTMENT AT DORAH VILLAGE ALONG THE NH1.
- DFC NEW CHAINAGE OF 1075.950M IS WITH REFERENCE TO THE IR KM OF 187.500KM END OF KM OF CP-303(SECTION P-3 PILKHANI END) AGAINST THE EXISTING DFC CHAINAGE. 116277.742M ISSUED VIDE LETTER NO. COM/DFCC/UMS/SURVEY/2021-301-230116-011173 DT. 17.01.2023.
- BALLAST PROFILE HAS BEEN PROVIDED ACCORDING TO THE CLAUSE 1.11.3 OF STANDARD SCHEDULE OF DIMENSION(EASTERN CORRIDOR) & THE BALLAST CUSHION DIMENSION SHOWN IN 35CM ON GE-14 PARA 17. SPECIFICATIONS & RECOMMENDATIONS 2. TWO LAYER SYSTEM FIG.10.

REFERENCE DRAWINGS :-

- FOR KEY PLAN REFER DRAWING NO. 301-2/AL/0001
- FOR LEGEND AND ABBREVIATIONS REFER DRAWING NO. 301-2/AL/1000
- FOR TYPICAL SECTION OF BALLAST PROFILE (FL-RL) REFER DRG. NO. 301-2/TK/TFD/004 (TR.1952)

SCALE

HOR - 1:1000

VER - 1:100

SHEET SIZE : A1

LEGEND:

IR TRACK

DFCC TRACK

DFCC FUTURE PROPOSALS

STRUCTURE / BUILDING

DFCC TOE LINE

DFCC FORMATION

RETAINING WALL

ROAD

STREAM, DRAIN, NALA, CANAL.

FENCE

POWER LINES

TBM

ELECTRIC POLE/OHE MAST

IR RAILWAY BOUNDARY

DFCC BOUNDARY

TRACK STRUCTURE

RAIL SECTION: 60Kg/m (UIC 60Kg/m)	Difference between FL- RL (Below Rail Seat)	
DFC LINE: 60Kg/m (UIC 60Kg/m)	IR Line	DFC
IR MAIN LINE: 52Kg/m	172mm	172mm
RUBBER PAD	6mm	10mm
SLEEPER DEPTH	210mm	210mm
BALLAST CUSHION	300mm	350mm
Total Depth (FL TO RL)	688mm	742mm

OWNER

DEDICATED FREIGHT CORRIDOR CORPORATION OF INDIA LTD.

(A GOVERNMENT OF INDIA ENTERPRISE)

PROJECT OFFICE(AMBALA UNIT): OLD RAILWAY COLONY (NEAR ANAND MARKET),AMBALA CANTT.-133001.

CORPORATE IDENTITY NO. : U60232DL2006GGI155068

ENGINEER:

DB Engineering & Consulting GmbH

Deutsche Bahn Engineering & Consulting GmbH

CONTRACTOR:

GIL - TPL JV

GAR TATA

SUBMITTED BY	GIL - TPL JV		
PREPARED BY	DATED	NAME	SIGNATURE
CHECKED BY	07.09.2024	VIJAY PRATAP	
APPROVED BY	07.09.2024	PARASURAM KOTYADA	
APPROVED BY	DEUTSCHE BAHN ENGINEERING & CONSULTING GMBH		
	DATED	NAME	SIGNATURE
Sr. DE./CHIEF ENGINEER		SURESH K.YALANGI	
CHIEF TRACK ENGINEER		RAJ PAL SINGH	
T.L.		H.D. VIDJAK	

STAMP

A AS-BUILT DRAWING

TR. Ref.....

ENGINEER Sign.:

EMPLOYER (DFCCIL):

DEDICATED FREIGHT CORRIDOR CORPORATION OF INDIA LTD.

TITLE

AS-BUILT PLAN AND PROFILE

DFCC APPR. NO. -

ENGG. APPR. NO. -

DRG. NO. - 301-2/AL/A/1233

SHEET NO. : 1 OF 1

DATE : 07.09.2024



STATUS

A

FROM IR KM: 303.500 TO 304.000

DFC KM: 1192.990 TO 1193.490

TR.

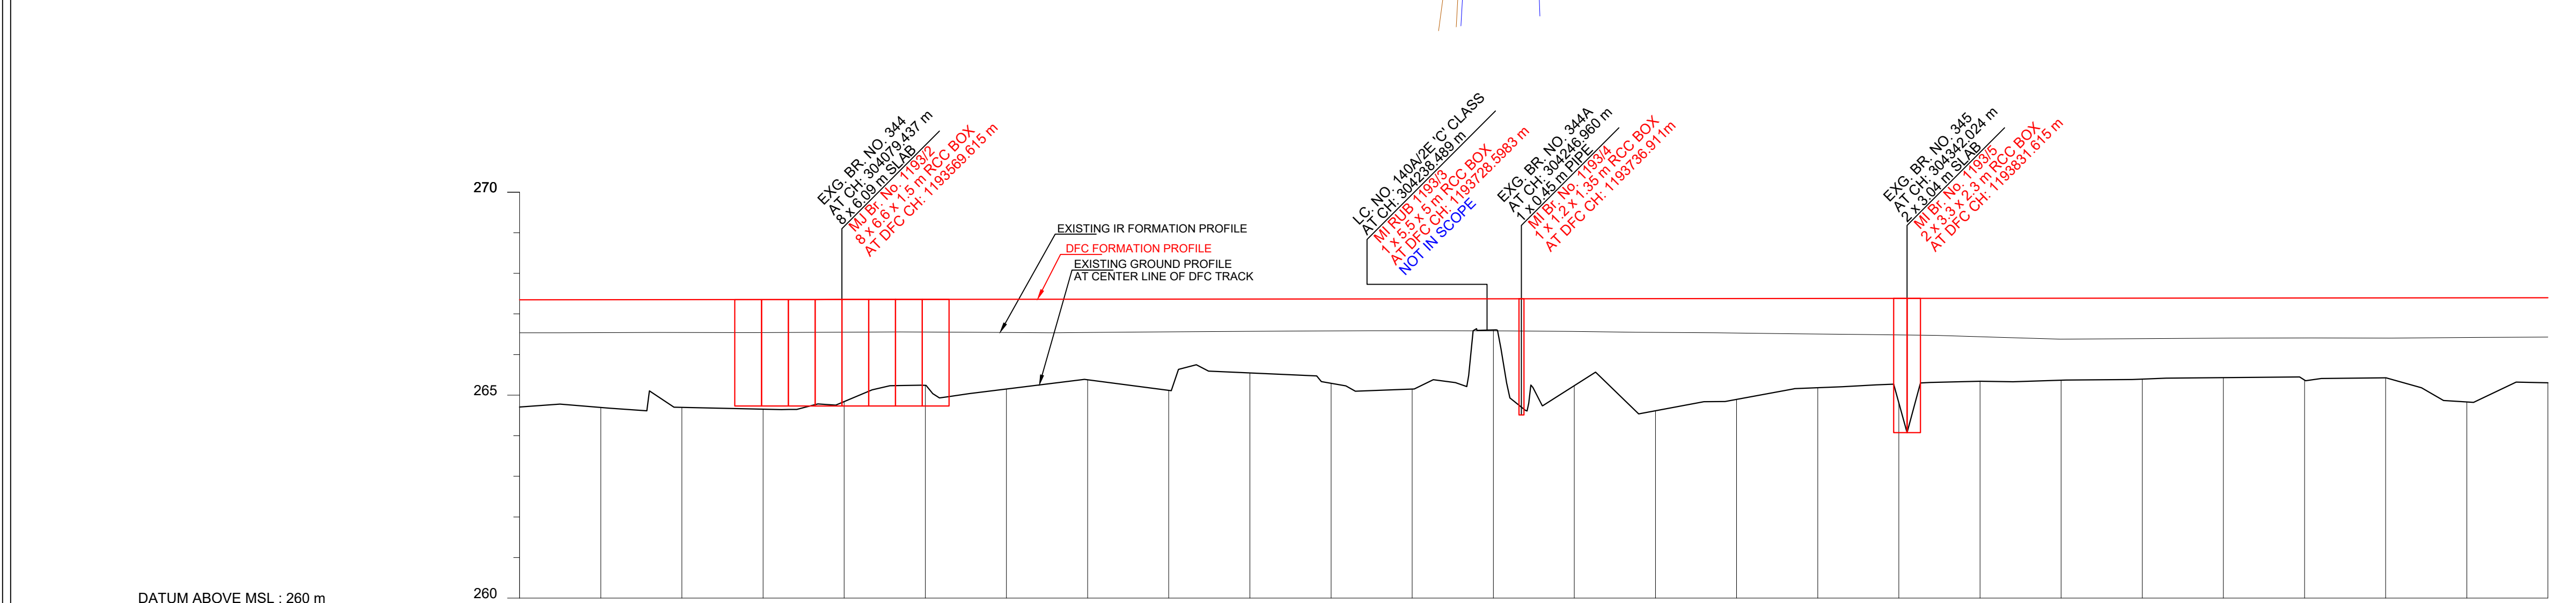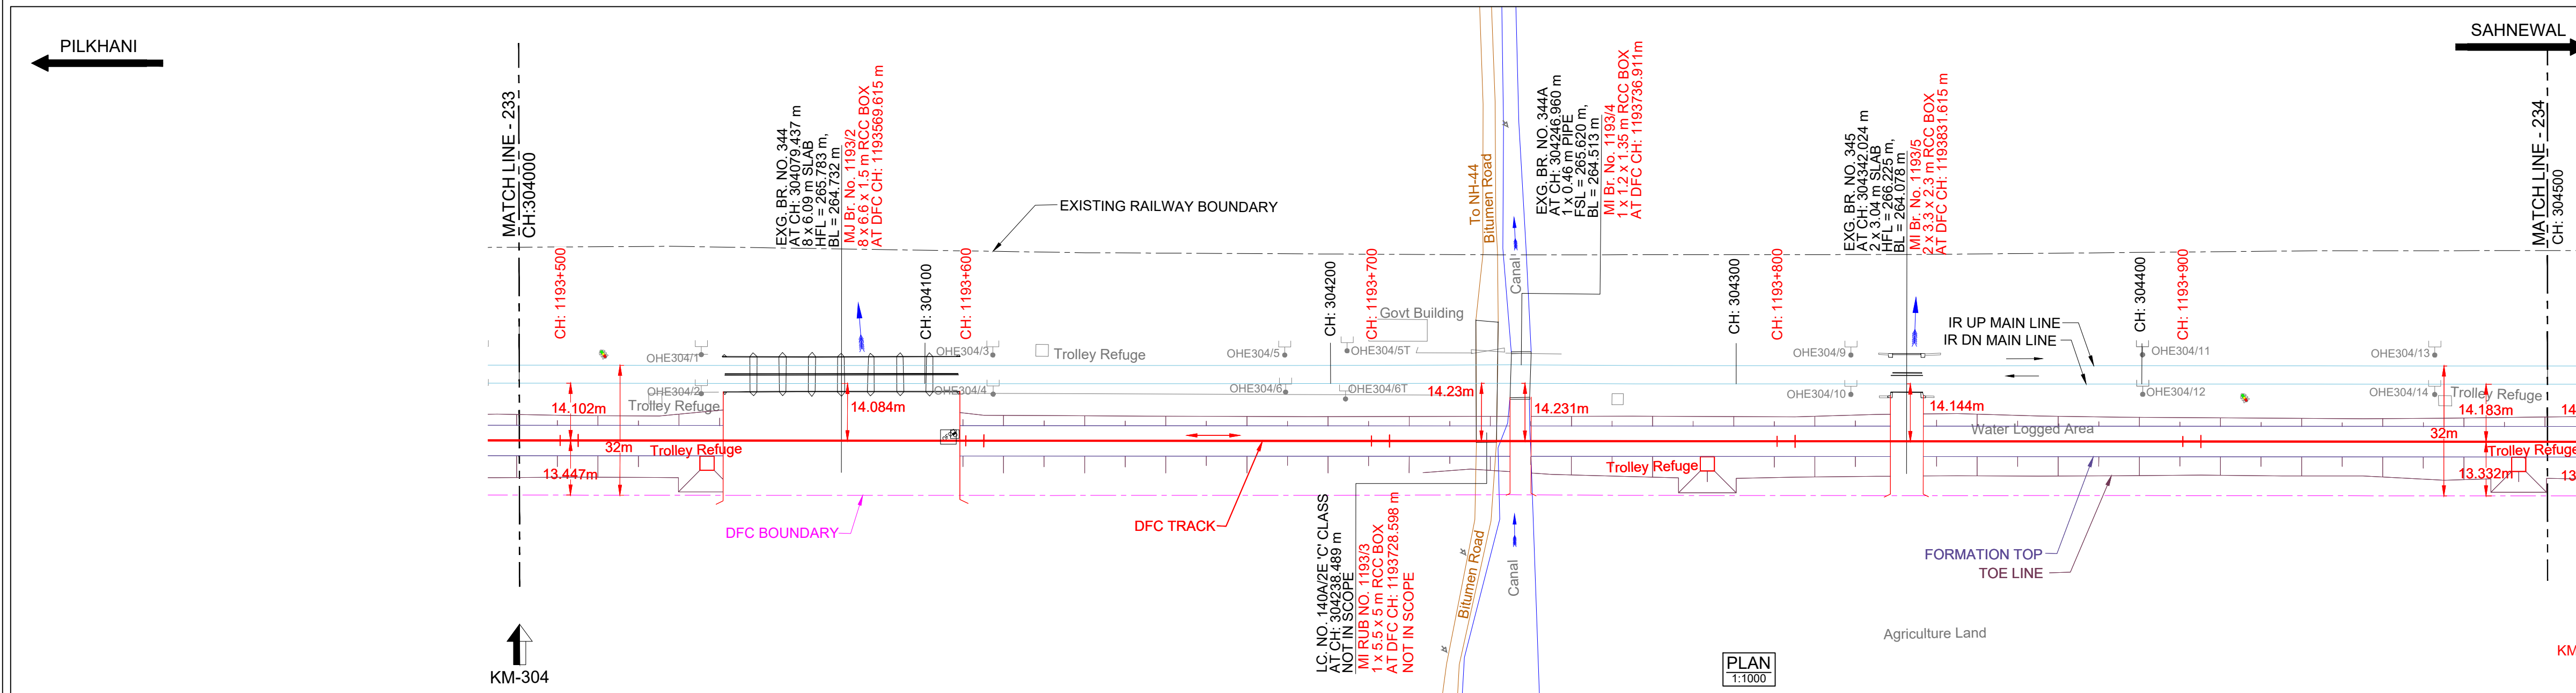

HORIZONTAL ALIGNMENT	L=3511.712m																										
VERTICAL ALIGNMENT	L=1628.0 m 1 IN 9858.854R																										
TRACK DISTANCE FROM EXISTING NEAREST IR DN MAIN LINE TO DFC MAIN LINE	14.106	14.098	14.099	14.091	14.084	14.084	14.081	14.069	14.069	14.083	14.110	14.149	14.190	14.234	14.189	14.141	14.141	14.142	14.143	14.152	14.165	14.163	14.160	14.163	14.165	14.179	14.193
HEIGHT OF BANKING(+) / DEPTH OF CUTTING(-) (PFL-GL)	+2.638	+2.653	+2.653	+2.652	-	-	+2.207	-	+2.246	+1.981	+1.981	+2.076	+2.219	+0.767	+2.140	+2.759	+2.482	+2.196	-	+2.040	+2.018	+1.992	+1.958	+2.022	+2.563	+2.093	
EXG GROUND LEVEL AT CENTER LINE OF DFC TRACK (GL)	264.592	264.709	264.696	264.699	264.653	264.841	265.242	265.380	265.117	265.545	265.291	265.150	266.604	265.233	264.616	264.895	265.183	265.343	265.367	265.395	265.431	265.369	265.426	264.833	265.305		
EXG GROUND LEVEL AT TOE LOCATION OF DFC TRACK	264.592	264.642	264.642	264.604	264.652	264.851	264.887	264.677	264.741	265.089	265.016	265.172	265.555	265.019	264.753	264.624	264.793	264.953	264.939	264.902	265.278	264.998	265.032	264.825	264.538	264.704	
DIFFERENCE BETWEEN DFC FORMATION LEVEL AND EXG.FORMATION LEVEL (PFL-EFL)	0.810	0.809	0.809	0.807	0.811	0.803	0.802	0.817	0.818	0.805	0.793	0.784	0.781	0.787	0.806	0.830	0.848	0.945	1.005	0.999	0.995	0.986	0.984	0.988	0.978	0.968	
DFC FORMATION LEVEL (PFL)	267.347	267.347	267.349	267.351	267.353	267.355	267.357	267.361	267.363	267.365	267.367	267.369	267.371	267.373	267.375	267.377	267.379	267.383	267.381	267.387	267.385	267.391	267.389	267.394	267.396	267.399	
EXG. FORMATION LEVEL OF EXG IR DN MAIN LINE (EFL)	266.537	266.537	266.540	266.544	266.542	266.552	266.555	266.543	266.558	266.572	266.583	266.588	266.584	266.567	266.545	266.529	266.505	266.438	266.482	266.380	266.392	266.403	266.406	266.418	266.430		
DIFFERENCE BETWEEN DFC RAIL LEVEL AND EXG. RAIL LEVEL (PRL - ERL)	0.851	0.850	0.850	0.848	0.852	0.845	0.843	0.859	0.846	0.835	0.825	0.823	0.828	0.848	0.871	0.890	0.916	0.986	1.047	1.037	1.027	1.025	1.029	1.019	1.008		
DFC RAIL LEVEL (PRL)	268.060	268.060	268.062	268.064	268.066	268.068	268.070	268.074	268.076	268.078	268.080	268.082	268.084	268.086	268.088	268.090	268.092	268.097	268.094	268.099	268.101	268.103	268.105	268.107	268.109	268.111	
EXG.RAIL LEVEL OF NEAREST IR DN MAIN LINE(ERL)	267.209	267.209	267.212	267.216	267.214	267.224	267.227	267.215	267.230	267.244	267.255	267.260	267.256	267.239	267.217	267.201	267.177	267.110	267.052	267.064	267.075	267.079	267.078	267.090	267.102		
EQUIVALENT CHAINAGE ON DFC TRACK	1193490.1	1193510.1	1193510.1	1193530.1	1193550.1	1193570.1	1193590.1	1193630.1	1193650.1	1193670.1	1193690.1	1193710.1	1193730.1	1193750.1	1193770.1	1193790.1	1193810.1	1193830.1	1193850.1	1193870.1	1193890.1	1193910.1	1193930.1	1193950.1	1193970.1		
EXISTING IR CHAINAGE	304000.0	304020.0	304040.0	304060.0	304080.0	304100.0	304120.0	304140.0	304160.0	304180.0	304200.0	304220.0	304240.0	304260.0	304280.0	304300.0	304320.0	304340.0	304360.0	304380.0	304400.0	304420.0	304440.0	304460.0	304480.0	304500.0	

L - SECTION

NOTE:-

- DFCC WORKS ARE SHOWN IN RED.
- IR NEW WORKS ARE SHOWN IN VIOLET.
- ALL DIMENSIONS ARE SHOWN IN METRES.
- THIS DRAWING IS PREPARED BASED ON LATEST SURVEY DATA HELD ON APRIL-2022. GTS BENCH MARK OF 261.850M CONSIDERED ON TOP OF CANAL BRIDGE ABUTMENT AT DORAHA VILLAGE ALONG THE NH1.
- DFC NEW CHAINAGE OF 1075.950M IS WITH REFERENCE TO THE IR KM OF 187.500KM END OF KM OF CP-303(SECTION P-3 PILKHANI END) AGAINST THE EXISTING DFC CHAINAGE. 116277.742M ISSUED VIDE LETTER NO. COM/DFCC/UM/SURVEY/2021-301-230116-011173 DT. 17.01.2023.
- BALLAST PROFILE HAS BEEN PROVIDED ACCORDING TO THE CLAUSE 1.11.3 OF STANDARD SCHEDULE OF DIMENSION(EASTERN CORRIDOR) & THE BALLAST CUSHION DIMENSION SHOWN IN 35CM ON GE-14 PARA 17. SPECIFICATIONS & RECOMMENDATIONS 2. TWO LAYER SYSTEM FIG.10.

REFERENCE DRAWINGS :-

- FOR KEY PLAN REFER DRAWING NO. 301-2/AL/0001
- FOR LEGEND AND ABBREVIATIONS REFER DRAWING NO. 301-2/AL/1000
- FOR TYPICAL SECTION OF BALLAST PROFILE (FL-RL) REFER DRG. NO. 301-2/TK/TFDI-004 (TR.1952)

07.09.2024SUBMISSION OF AS-BUILT DRAWINGFOR APPROVAL

REV. DATE REVISION DETAILS PURPOSE OF ISSUE

SCALE
HOR - 1:1000
VER - 1:100
SHEET SIZE : A1

LEGEND:
IR TRACK
DFCC TRACK
DFCC FUTURE PROPOSALS
STRUCTURE / BUILDING
DFCC TOE LINE
DFCC FORMATION
RETAINING WALL
ROAD
STREAM, DRAIN, NALA, CANAL.
FENCE
POWER LINES
TBM
ELECTRIC POLE/OHE MAST
IR RAILWAY BOUNDARY
DFCC BOUNDARY

TYPICAL SECTION

TRACK STRUCTURE

RAIL SECTION: 60Kg/m (UIC 60Kg/m) DFC LINE: 60Kg/m (UIC 60Kg/m) IR MAIN LINE: 52Kg/m	Difference between FL- RL (Below Rail Seat)	
	IR Line	DFC
RUBBER PAD	172mm	172mm
SLEEPER DEPTH	6mm	10mm
BALLAST CUSHION	210mm	210mm
	300mm	350mm
Total Depth (FL TO RL)	688mm	742mm

OWNER
DEDICATED FREIGHT CORRIDOR CORPORATION OF INDIA LTD.
(A GOVERNMENT OF INDIA ENTERPRISE)
PROJECT OFFICE(AMBALA UNIT): OLD RAILWAY COLONY (NEAR ANAND MARKET),AMBALA CANTT.-133001.
CORPORATE IDENTITY NO. : U60232DL2006GGI155068

ENGINEER:
DB Engineering & Consulting GmbH
Deutsche Bahn Engineering & Consulting GmbH

CONTRACTOR:
GIL - TPL JV
GAR TATA

SUBMITTED BY	GIL - TPL JV		
	DATED	NAME	SIGNATURE
PREPARED BY			
CHECKED BY	07.09.2024	VIJAY PRATAP	
APPROVED BY	07.09.2024	PARASURAM KOTYADA	
APPROVED BY	DEUTSCHE BAHN ENGINEERING & CONSULTING GMBH		
	DATED	NAME	SIGNATURE
Sr. DE./CHIEF ENGINEER		SURESH K.YALANGI	
CHIEF TRACK ENGINEER		RAJ PAL SINGH	
T.L.		H.D. VIDJAK	



STAMP
A AS-BUILT DRAWING
TR. Ref.:.....
ENGINEER Sign.:.

EMPLOYER (DFCCIL): DEDICATED FREIGHT CORRIDOR CORPORATION OF INDIA LTD.

AS BUILT DRAWING

TITLE AS-BUILT PLAN AND PROFILE	DFCC APPR. NO. - ENGG. APPR. NO. -
FROM IR KM: 304.000 TO 304.500 DFC KM: 1193.490 TO 1193.990	DRG. NO. -301-2/AL/A/1234 SHEET NO. : 1 OF 1 DATE : 07.09.2024
	STATUS A

TR.

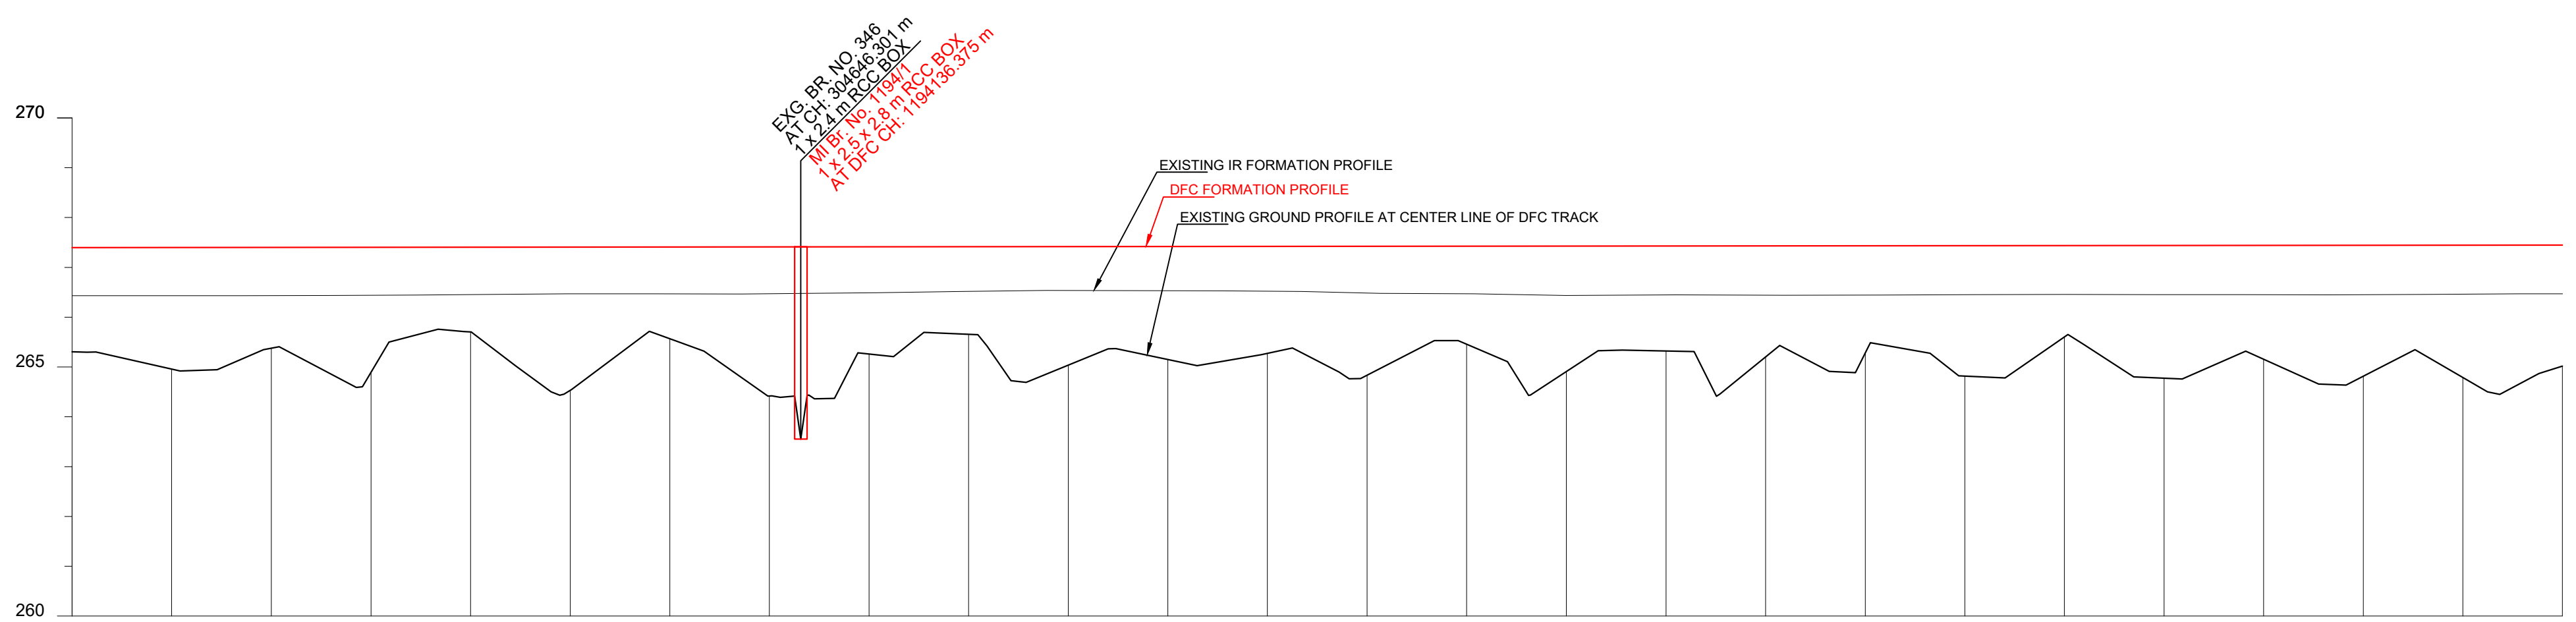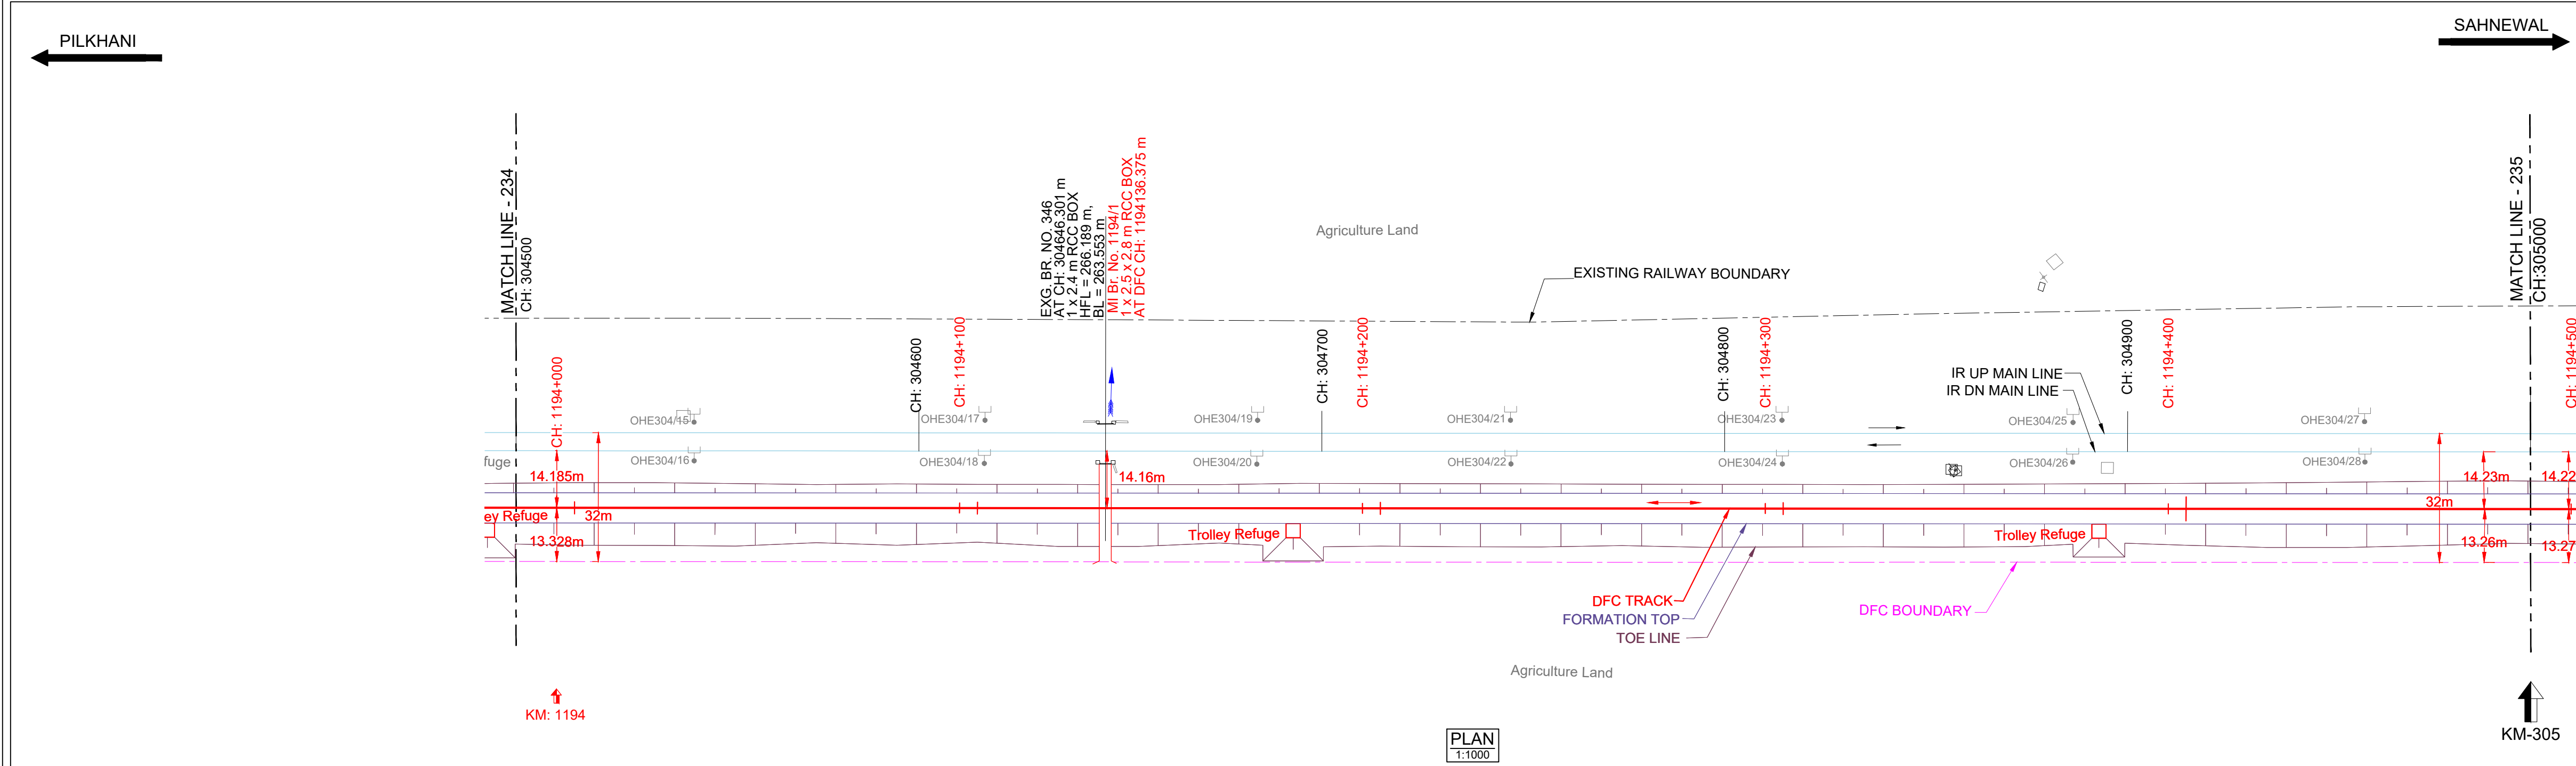

DATUM ABOVE MSL : 260 m

HORIZONTAL ALIGNMENT	L=3511.712m																			
VERTICAL ALIGNMENT	L=1628.0 m 1 IN 9858.554R																			
TRACK DISTANCE FROM EXISTING NEAREST IR DN MAIN LINE TO DFC MAIN LINE	14.193																			
HEIGHT OF BANKING(+) / DEPTH OF CUTTING(-) (PFL-GL)	+2.093																			
EXG GROUND LEVEL AT CENTER LINE OF DFC TRACK (GL)	265.305	265.305	264.959	264.959	264.959	264.959	264.959	264.959	264.959	264.959	264.959	264.959	264.959	264.959	264.959	264.959	264.959	264.959	264.959	264.959
EXG GROUND LEVEL AT TOE LOCATION OF DFC TRACK	264.704	264.559	264.524	264.524	264.524	264.524	264.524	264.524	264.524	264.524	264.524	264.524	264.524	264.524	264.524	264.524	264.524	264.524	264.524	264.524
DIFFERENCE BETWEEN DFC FORMATION LEVEL AND EXG.FORMATION LEVEL (PFL-EFL)	0.968	0.967	0.968	0.968	0.968	0.968	0.968	0.968	0.968	0.968	0.968	0.968	0.968	0.968	0.968	0.968	0.968	0.968	0.968	0.968
DFC FORMATION LEVEL (PFL)	267.398	267.400	267.402	267.402	267.402	267.402	267.402	267.402	267.402	267.402	267.402	267.402	267.402	267.402	267.402	267.402	267.402	267.402	267.402	267.402
EXG. FORMATION LEVEL OF EXG IR DN MAIN LINE (EFL)	266.430	266.433	266.434	266.434	266.434	266.434	266.434	266.434	266.434	266.434	266.434	266.434	266.434	266.434	266.434	266.434	266.434	266.434	266.434	266.434
DIFFERENCE BETWEEN DFC RAIL LEVEL AND EXG. RAIL LEVEL (PRL - ERL)	1.008	1.007	1.008	1.008	1.008	1.008	1.008	1.008	1.008	1.008	1.008	1.008	1.008	1.008	1.008	1.008	1.008	1.008	1.008	1.008
DFC RAIL LEVEL (PRL)	268.111	267.105	267.106	267.106	267.106	267.106	267.106	267.106	267.106	267.106	267.106	267.106	267.106	267.106	267.106	267.106	267.106	267.106	267.106	267.106
EXG.RAIL LEVEL OF NEAREST IR DN MAIN LINE(ERL)	267.102	267.105	267.106	267.106	267.106	267.106	267.106	267.106	267.106	267.106	267.106	267.106	267.106	267.106	267.106	267.106	267.106	267.106	267.106	267.106
EQUIVALENT CHAINAGE ON DFC TRACK	1193990.1	1194010.1	1194030.1	1194050.1	1194070.1	1194090.1	1194110.1	1194130.1	1194150.1	1194170.1	1194190.1	1194210.1	1194230.1	1194250.1	1194270.1	1194290.1	1194310.1	1194330.1	1194350.1	1194370.1
EXISTING IR CHAINAGE	304500.0	304520.0	304540.0	304560.0	304580.0	304600.0	304620.0	304640.0	304660.0	304680.0	304700.0	304720.0	304740.0	304760.0	304780.0	304800.0	304820.0	304840.0	304860.0	304880.0

L - SECTION

DRG NO.- 301-2/AL/1235

NOTE:-

1. DFC WORKS ARE SHOWN IN RED.

2. IR NEW WORKS ARE SHOWN IN VIOLET.

3. ALL DIMENSIONS ARE SHOWN IN METRES.

4. THIS DRAWING IS PREPARED BASED ON LATEST SURVEY DATA HELD ON APRIL-2022. GTS BENCH MARK OF 261.850M CONSIDERED ON TOP OF CANAL BRIDGE ABUTMENT AT DORAHA VILLAGE ALONG THE NH1.

5. DFC NEW CHAINAGE OF 1075.950M IS WITH REFERENCE TO THE IR KM OF 187.500KM END OF KM OF CP-303(SECTION P-3 PILKHANI END) AGAINST THE EXISTING DFC CHAINAGE. 116277.742M ISSUED VIDE LETTER NO. COM/DFCC/UM/SURVEY/2021-301-230116-011173 DT. 17.01.2023.

6. BALLAST PROFILE HAS BEEN PROVIDED ACCORDING TO THE CLAUSE 1.11.3 OF STANDARD SCHEDULE OF DIMENSION(EASTERN CORRIDOR) & THE BALLAST CUSHION DIMENSION SHOWN IN 35CM ON GE-14 PARA 17. SPECIFICATIONS & RECOMMENDATIONS 2. TWO LAYER SYSTEM FIG.10.

REFERENCE DRAWINGS :-

1. FOR KEY PLAN REFER DRAWING NO. 301-2/AL/0001

2. FOR LEGEND AND ABBREVIATIONS REFER DRAWING NO. 301-2/AL/1000

3. FOR TYPICAL SECTION OF BALLAST PROFILE (FL-RL) REFER DRG. NO. 301-2/TK/TFD/004 (TR.1952)

07.09.2024

SUBMISSION OF AS-BUILT DRAWING

FOR APPROVAL

REV.

DATE

REVISION DETAILS

PURPOSE OF ISSUE

SCALE

HOR - 1:1000

VER - 1:100

SHEET SIZE : A1

IR TRACK

DFCC TRACK

DFCC FUTURE PROPOSALS

STRUCTURE / BUILDING

DFCC TOE LINE

DFCC FORMATION

RETAINING WALL

ROAD

STREAM, DRAIN, NALA, CANAL.

FENCE

POWER LINES

TBM

ELECTRIC POLE/OHE MAST

IR RAILWAY BOUNDARY

DFCC BOUNDARY

TYPICAL SECTION

TRACK STRUCTURE

RAIL SECTION: 60Kg/m (UIC 60Kg/m)

DFC LINE: 60Kg/m (UIC 60Kg/m)

IR MAIN LINE: 52Kg/m

DIFFERENCE BETWEEN FL- RL (Below Rail Seat)

IR Line

DFC

RUBBER PAD

SLEEPER DEPTH

BALLAST CUSHION

Total Depth (FL TO RL)

OWNER

DEDICATED FREIGHT CORRIDOR CORPORATION OF INDIA LTD.

(A GOVERNMENT OF INDIA ENTERPRISE)

PROJECT OFFICE(AMBALA UNIT): OLD RAILWAY COLONY (NEAR ANAND MARKET),AMBALA CANTT-133001.

CORPORATE IDENTITY NO. : U60232DL2006GGI155068

ENGINEER:

DB Engineering & Consulting GmbH

Deutsche Bahn Engineering & Consulting GmbH

CONTRACTOR:

GIL - TPL JV

GAR

TATA

SUBMITTED BY

GIL - TPL JV

DATED

NAME

SIGNATURE

PREPARED BY

CHECKED BY

APPROVED BY

07.09.2024

VIJAY PRATAP

PARASURAM KOTYADA

APPROVED BY

DEUTSCHE BAHN ENGINEERING & CONSULTING GMBH

DATED

NAME

SIGNATURE

Sr. DE./CHIEF ENGINEER

SURESH K.YALANGI

CHIEF TRACK ENGINEER

RAJ PAL SINGH

T.L.

H.D. VIDJAK

STAMP

A

AS-BUILT DRAWING

TR. Ref.....

ENGINEER Sign.:

EMPLOYER (DFCCIL):

DEDICATED FREIGHT CORRIDOR CORPORATION OF INDIA LTD.

AS BUILT DRAWING

TITLE

AS-BUILT PLAN AND PROFILE

DFCC APPR. NO. -

ENGG. APPR. NO. -

DRG. NO. - 301-2/AL/A/1235

SHEET NO. : 1 OF 1

DATE : 07.09.2024


STATUS

A

FROM IR KM: 304.500 TO 305.000

DFC KM: 1193.990 TO 1194.490

TR.

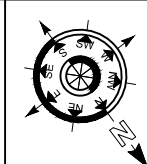

NOTE

DRG NO.- 301-2/AL/A/1236

1. DFCW WORKS ARE SHOWN IN RED.
2. ALL DIMENSIONS ARE SHOWN IN METERS.
3. NEW WORKS ARE SHOWN IN VIOLET.
4. THE DRAWING IS PREPARED BASED ON LATEST SURVEY DATA HELD ON APRIL-2024. GTS BEACH MARK 281.850M CONSIDERED ON TOP OF CANAL BRIDGE ABUTMENT AT DORAJA VILLAGE ALONG THE NH11.
5. NEW CHAINAGE OF 1075.950M IS WITH REFERENCE TO THE IR KM OF 117.500K END OF KM OF 117.500K ON P-3. THE CHAINAGE OF 1075.950M IS EQUIVALENT TO THE CHAINAGE OF 118227.742M ISSUED VILDFC NO. CGM/DFC/CUM/99/950M (1:301-230116-011173.DT) 17.01.2023.
6. BALLAST PROFILE HAS BEEN PROVIDED ACCORDING TO THE CLAUSE 1.11.3 OF STANDARD SCHEDULE FOR THE MAINTENANCE OF ROAD AND RAILWAYS. THE BALLAST SPECIFICATION IS 35CM ON GE-1 BALLAST 17. SPECIFICATIONS & RECOMMENDATIONS 2. TWO LAYER SYSTEM FIG. 10.

REFERENCE DRAWINGS :


1. FOR KEY PLAN REFER DRAWING NO. 301-2/AL/0001
2. FOR LEGEND AND ABBREVIATIONS REFER DRAWING NO. 301-2/AL1000
3. FOR TYPICAL SECTION OF BALLAST PROFILE (FL-RL) REFFER DRG. NO. 301-2/TK/TFD/-004 (TR.1952)

0	07.09.2024	SUBMISSION OF AS-BUILT DRAWING	FOR APPROVAL
REV.	DATE	REVISION DETAILS	PURPOSE OF ISSUE

LEGEND

SCALE

HOR - 1:1000

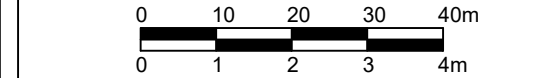


VER - 1:100

SHEET SIZE : A1

_____ SHEET SIZE : A1

IR TRACK	
DFCC TRACK	
DFCC FUTURE PROPOSALS	
STRUCTURE / BUILDING	
DFCC TOE LINE	
DFCC FORMATION	
RETAINING WALL	
ROAD	
STREAM, DRAIN, NALA, CANAL.	
FENCE	
POWER LINES	
TBM	
ELECTRIC POLE/OHE MAST	
IR RAILWAY BOUNDARY	
DFCC BOUNDARY	

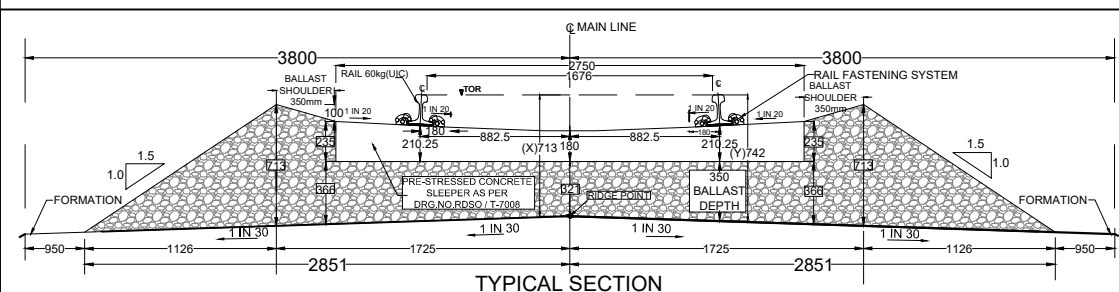

TRACK STRUCTURE		
RAIL SECTION: 60Kg/m (UIC 60Kg/m) DFC LINE: 60kg/m (UIC 60kg/m) IR MAIN LINE: 52kg/m	Difference between FL- RL (Below Rail Seat)	
	IR Line	DFC
	172mm	172mm
RUBBER PAD	6mm	10mm
SLEEPER DEPTH	210mm	210mm
BALLAST CUSHION	300mm	350mm
Total Depth (FL TO RL)	688mm	742mm

OWNER

DEDICATED FREIGHT CORRIDOR CORPORATION OF INDIA LTD.

(A GOVERNMENT OF INDIA ENTERPRISE)
PROJECT OFFICE (AMBALA UNIT), OLD RAILWAY COLONY,

PROJECT OFFICE(AMBALA UNIT): OLD RAILWAY COLONY
ANAND MARKET),AMBALA CANTT-133001.

CORPORATE IDENTITY NO. : U60232DL2006GOI1550

ENGINEER

DB Engineering &
Consulting GmbH

Deutsche Bahn Engineering & Consulting GmbH

CONTRACTOR

CULTURAL IV



SUBMITTED BY	GIL - TPL JV		
	DATED	NAME	SIGNATURE
PREPARED BY			
CHECKED BY	07.09.2024	VIJAY PRATAP	
APPROVED BY	07.09.2024	PARASURAM KOTYADA	
APPROVED BY	DEUTSCHE BAHN ENGINEERING & CONSULTING GMBH		
	DATED	NAME	SIGNATURE
Sr. DE./CHIEF ENGINEER		SURESH K.YALANGI	
CHIEF TRACK ENGINEER		RAJ PAL SINGH	
T.L.		H.D. VIDJAK	

STAMP

A AS-BUILT DRAWING
TR. Ref.....
ENGINEER Sign.:

EMPLOYER (DFCCIL):

DEDICATED FREIGHT CORRIDOR CORPORATION OF INDIA LTD

AS BUILT DRAWING

TITLE

AS-BUILT PLAN AND PROFILE

FROM IR KM: 305 000 TO 305 500

DFC KM: 1194.490 TO 1194.990

DECC APPR NO. -


ENGG. APPR. NO. -

DRG. NO. - 301-2/

SHEET NO. : 1 OF 1

STATUS



ED

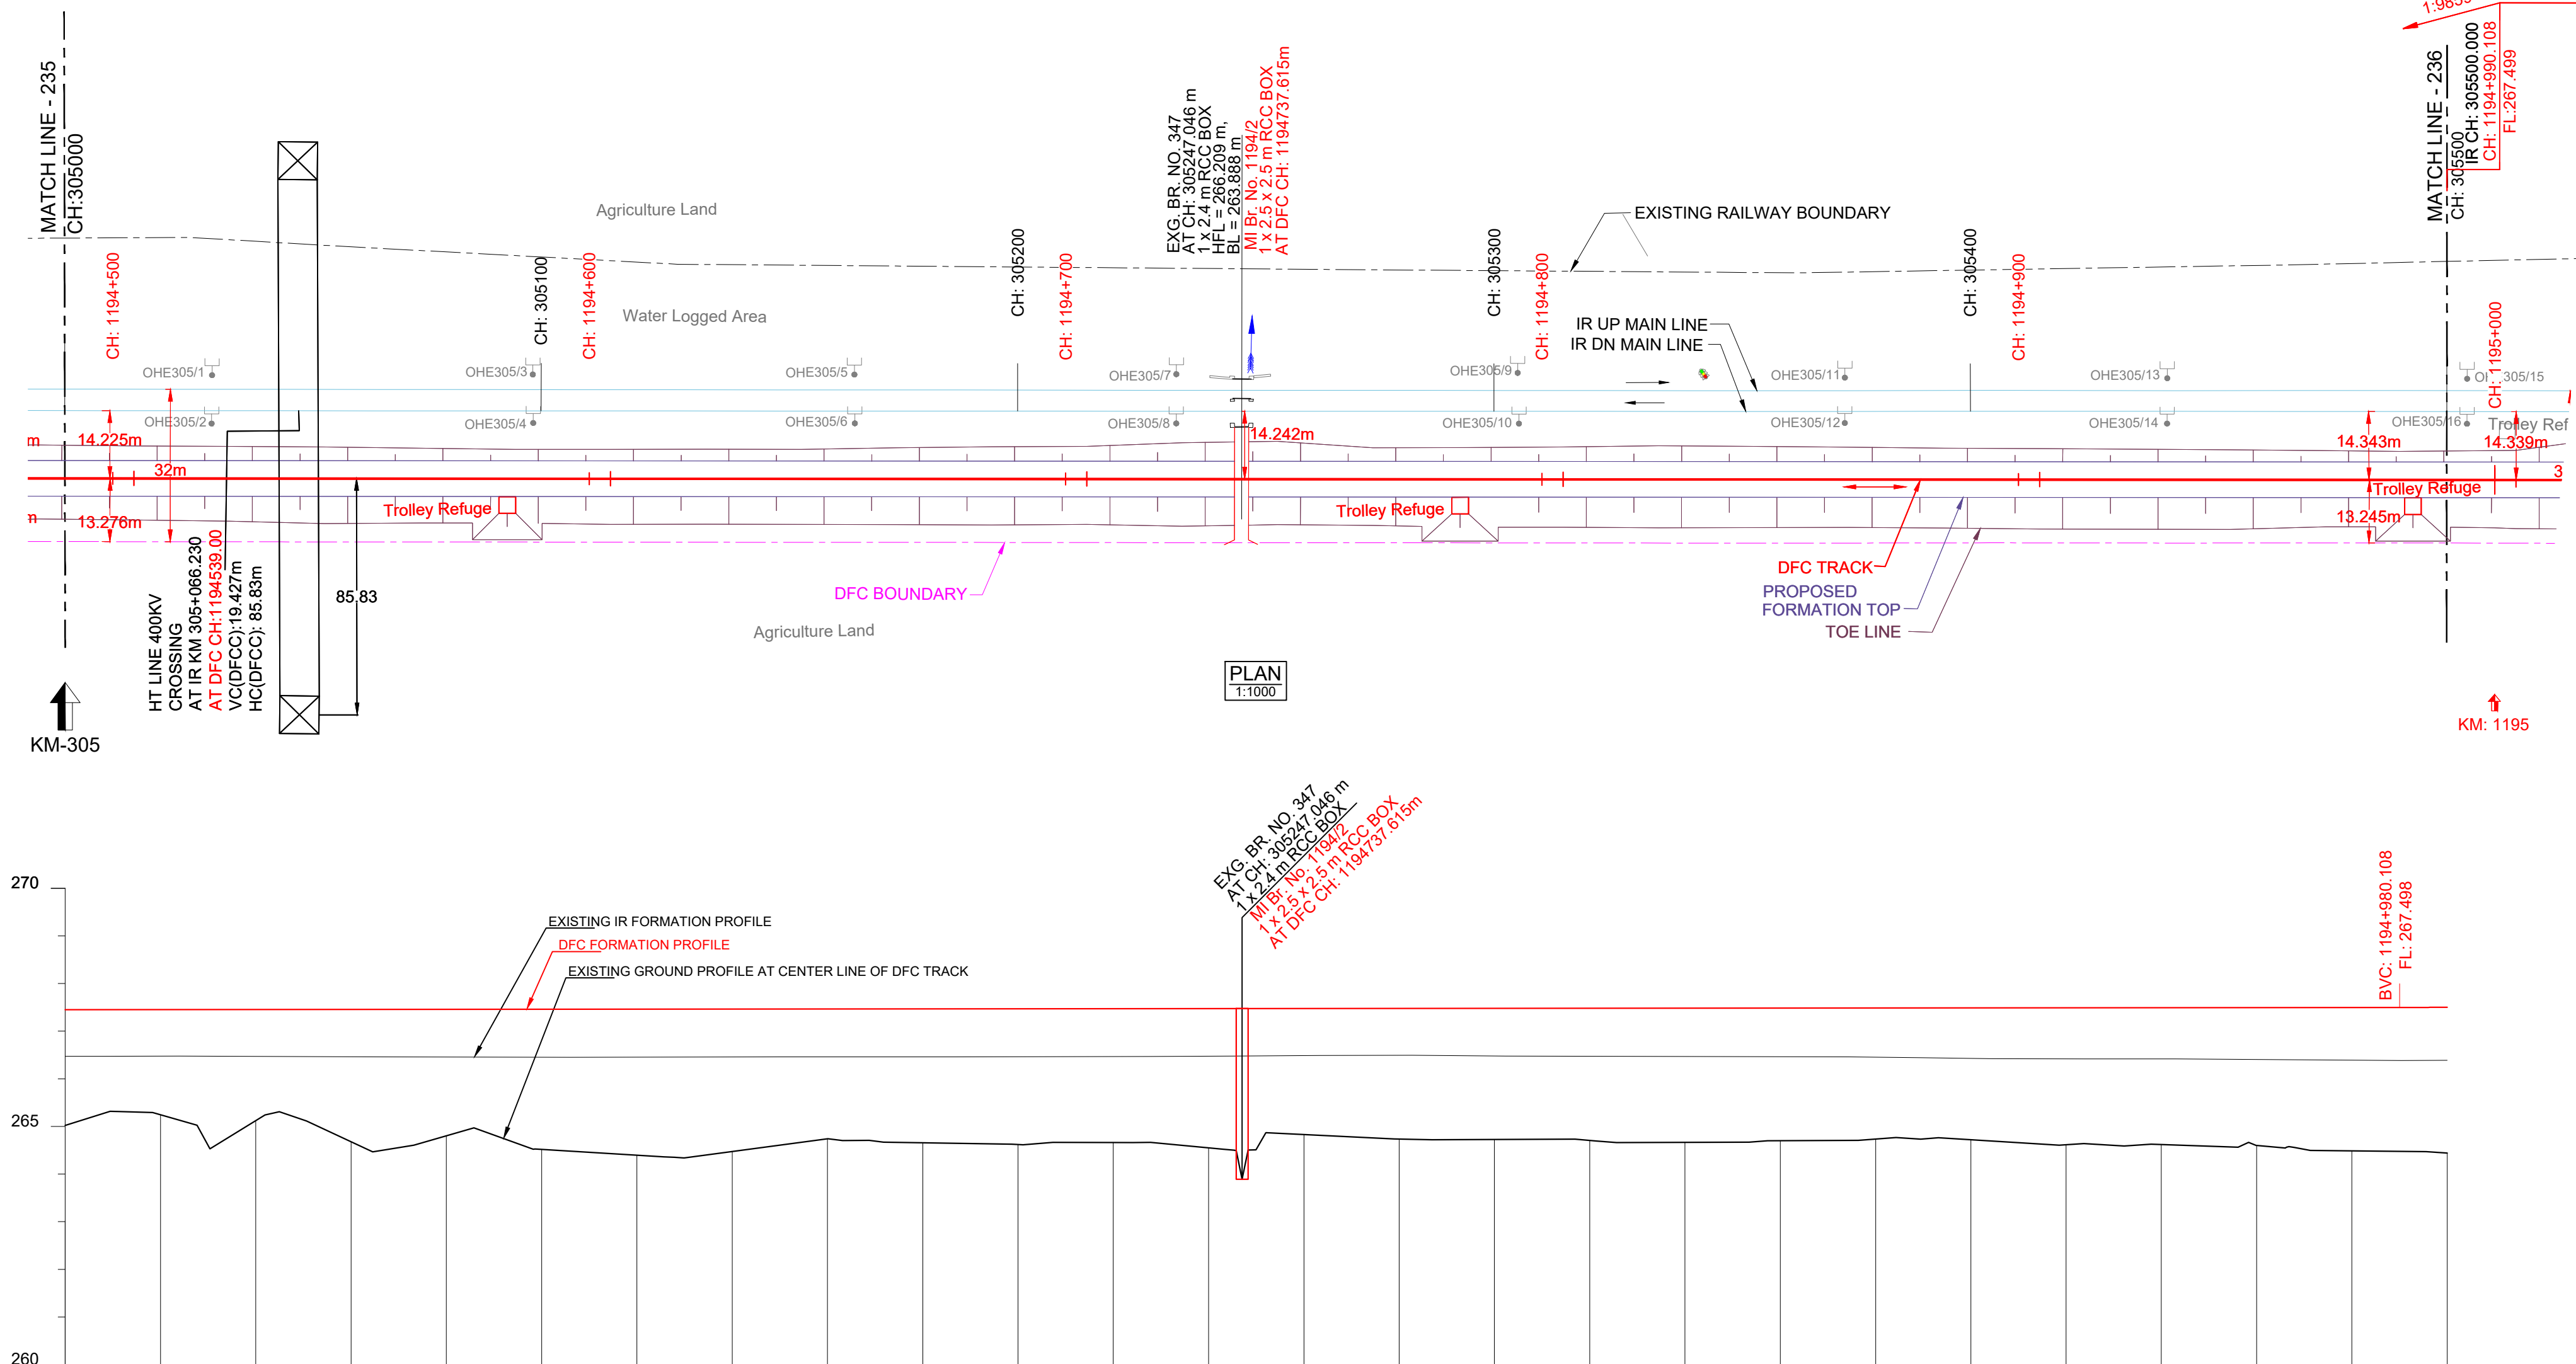

DATUM ABOVE MSL : 260 m



HORIZONTAL ALIGNMENT	L=3511.712m									
VERTICAL ALIGNMENT	L=1628.0 m 1 IN 9858.854R									
TRACK DISTANCE FROM EXISTING NEAREST IR DN MAIN LINE TO DFC MAIN LINE	L=20.0 m R=19717.7 m									
HEIGHT OF BANKING(+)/ DEPTH OF CUTTING(-) (PFL-GL)	+2.429	-14.227								
EXG GROUND LEVEL AT CENTER LINE OF DFC TRACK (GL)	264.951	265.019								
EXG GROUND LEVEL AT TOE LOCATION OF DFC TRACK	264.854	265.242								
DIFFERENCE BETWEEN DFC FORMATION LEVEL AND EXG.FORMATION LEVEL (PFL-EFL)	0.978	0.975	0.983	0.999	1.005	1.003	1.007	1.007	1.007	1.001
DFC FORMATION LEVEL (PFL)	267.448	267.450	267.452	267.456	267.458	267.462	267.467	267.467	267.467	267.479
EXG. FORMATION LEVEL OF EXG IR DN MAIN LINE (EFL)	266.470	266.475	266.469	266.461	266.453	266.459	266.460	266.460	266.462	266.478
DIFFERENCE BETWEEN DFC RAIL LEVEL AND EXG. RAIL LEVEL (PRL - ERL)	1.019	1.017	1.024	1.034	1.046	1.045	1.047	1.047	1.046	1.042
DFC RAIL LEVEL (PRL)	268.161	268.163	268.165	268.168	268.172	268.176	268.180	268.180	268.182	268.192
EXG.RAIL LEVEL OF NEAREST IR DN MAIN LINE(ERL)	267.142	267.147	267.141	267.133	267.125	267.131	267.132	267.132	267.134	267.150
EQUIVALENT CHAINEAG ON DFC TRACK	305000.0	305020.0	305040.0	305060.0	305080.0	305100.0	305120.0	305140.0	305160.0	305180.0
EXISTING IR CHAINEAG	305000.0	305020.0	305040.0	305060.0	305080.0	305100.0	305120.0	305140.0	305160.0	305180.0

L - SECTION

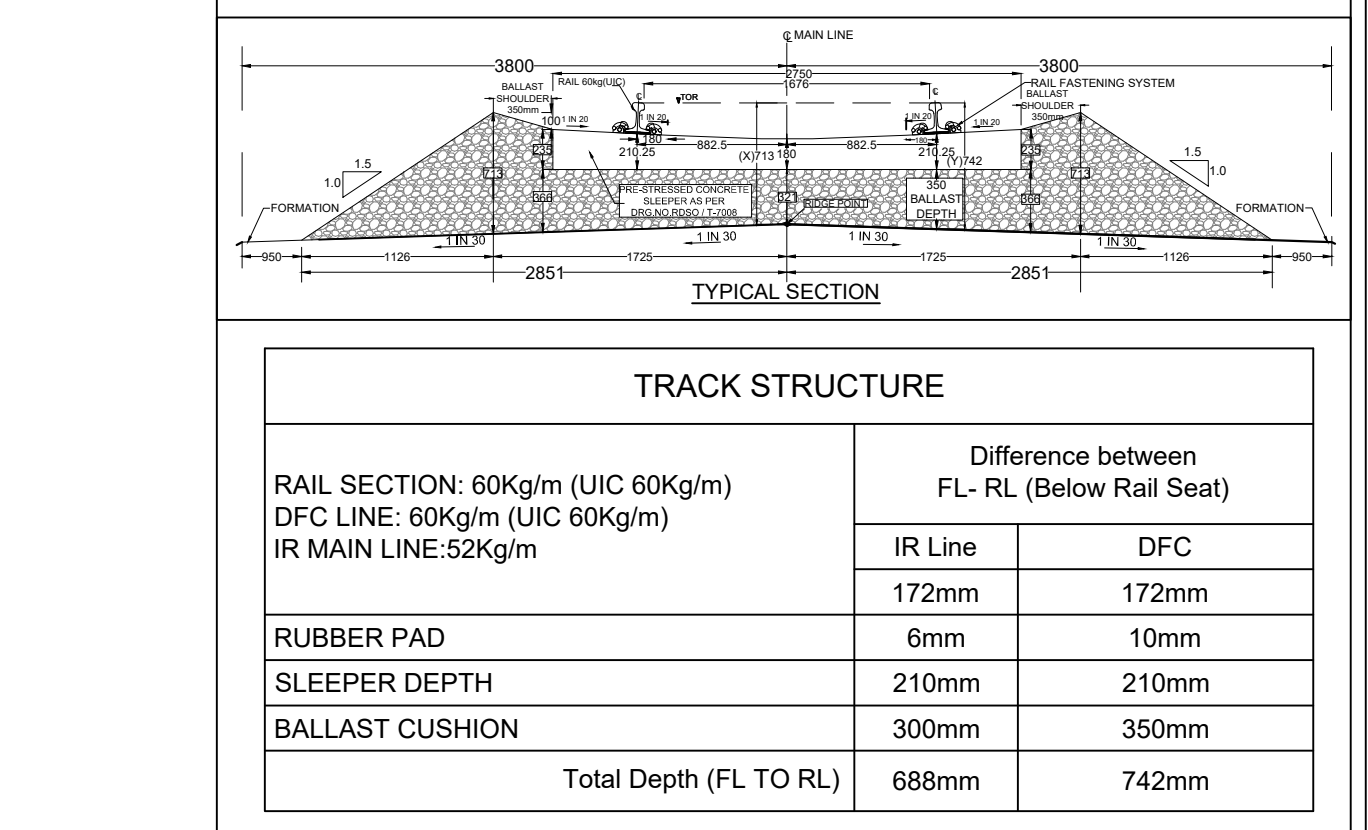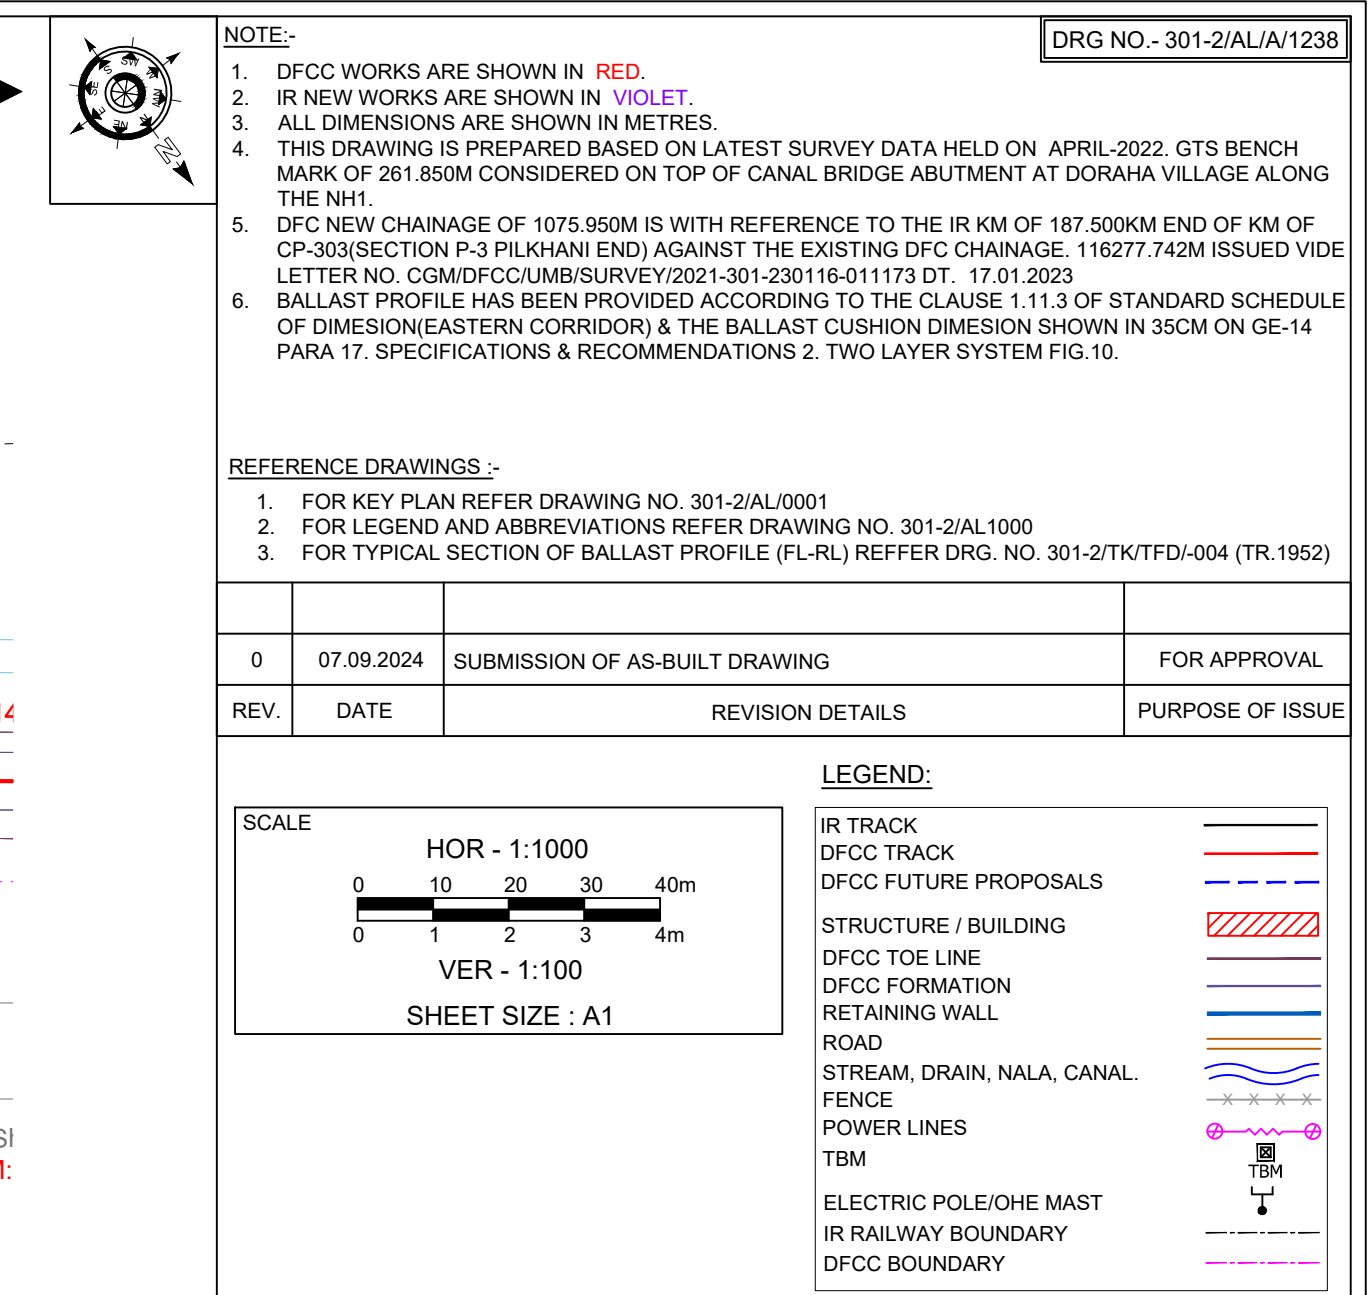

OWNER		DEDICATED FREIGHT CORRIDOR CORPORATION OF INDIA LTD. (A GOVERNMENT OF INDIA ENTERPRISE) PROJECT OFFICE/AMBALA UNIT, OLD RAILWAY COLONY (NEAR ANAND MARKET),AMBALA CANTT-133001. CORPORATE IDENTITY NO. : U60232DL2006GOI155068	
			
ENGINEER:		 DB Engineering & Consulting GmbH Deutsche Bahn Engineering & Consulting GmbH	
CONTRACTOR:		GIL - TPL JV  	
SUBMITTED BY	GIL - TPL JV		
	DATED	NAME	SIGNATURE
PREPARED BY			
CHECKED BY	07.09.2024	VIJAY PRATAP	
APPROVED BY	07.09.2024	PARASURAM KOTYADA	
APPROVED BY	DEUTSCHE BAHN ENGINEERING & CONSULTING GMBH		
	DATED	NAME	SIGNATURE
Sr. DE./CHIEF ENGINEER		SURESH K.YALANGI	
CHIEF TRACK ENGINEER		RAJ PAL SINGH	
T.L.		H.D. VIDJAK	

STAMP	A AS-BUILT DRAWING TR. Ref..... ENGINEER Sign.:		
	EMPLOYER (DFCCIL): DEDICATED FREIGHT CORRIDOR CORPORATION OF INDIA LTD.		
AS BUILT DRAWING			
TITLE AS-BUILT PLAN AND PROFILE FROM IR KM: 306.000 TO 306.500 DFC KM: 1195.490 TO 1195.990	DFCC APPR. NO. -		
	ENGG. APPR. NO. -		
	DRG. NO. - 301-2/AL/A/1238		
	SHEET NO. : 1 OF 1		STATUS A
	DATE : 07.09.2024		

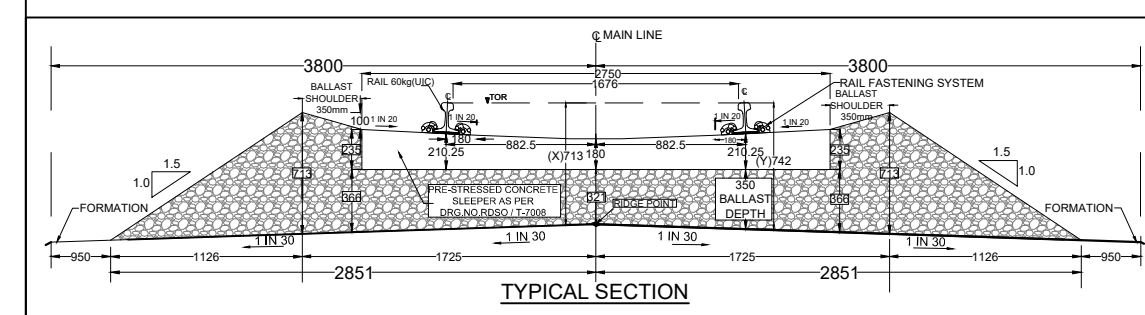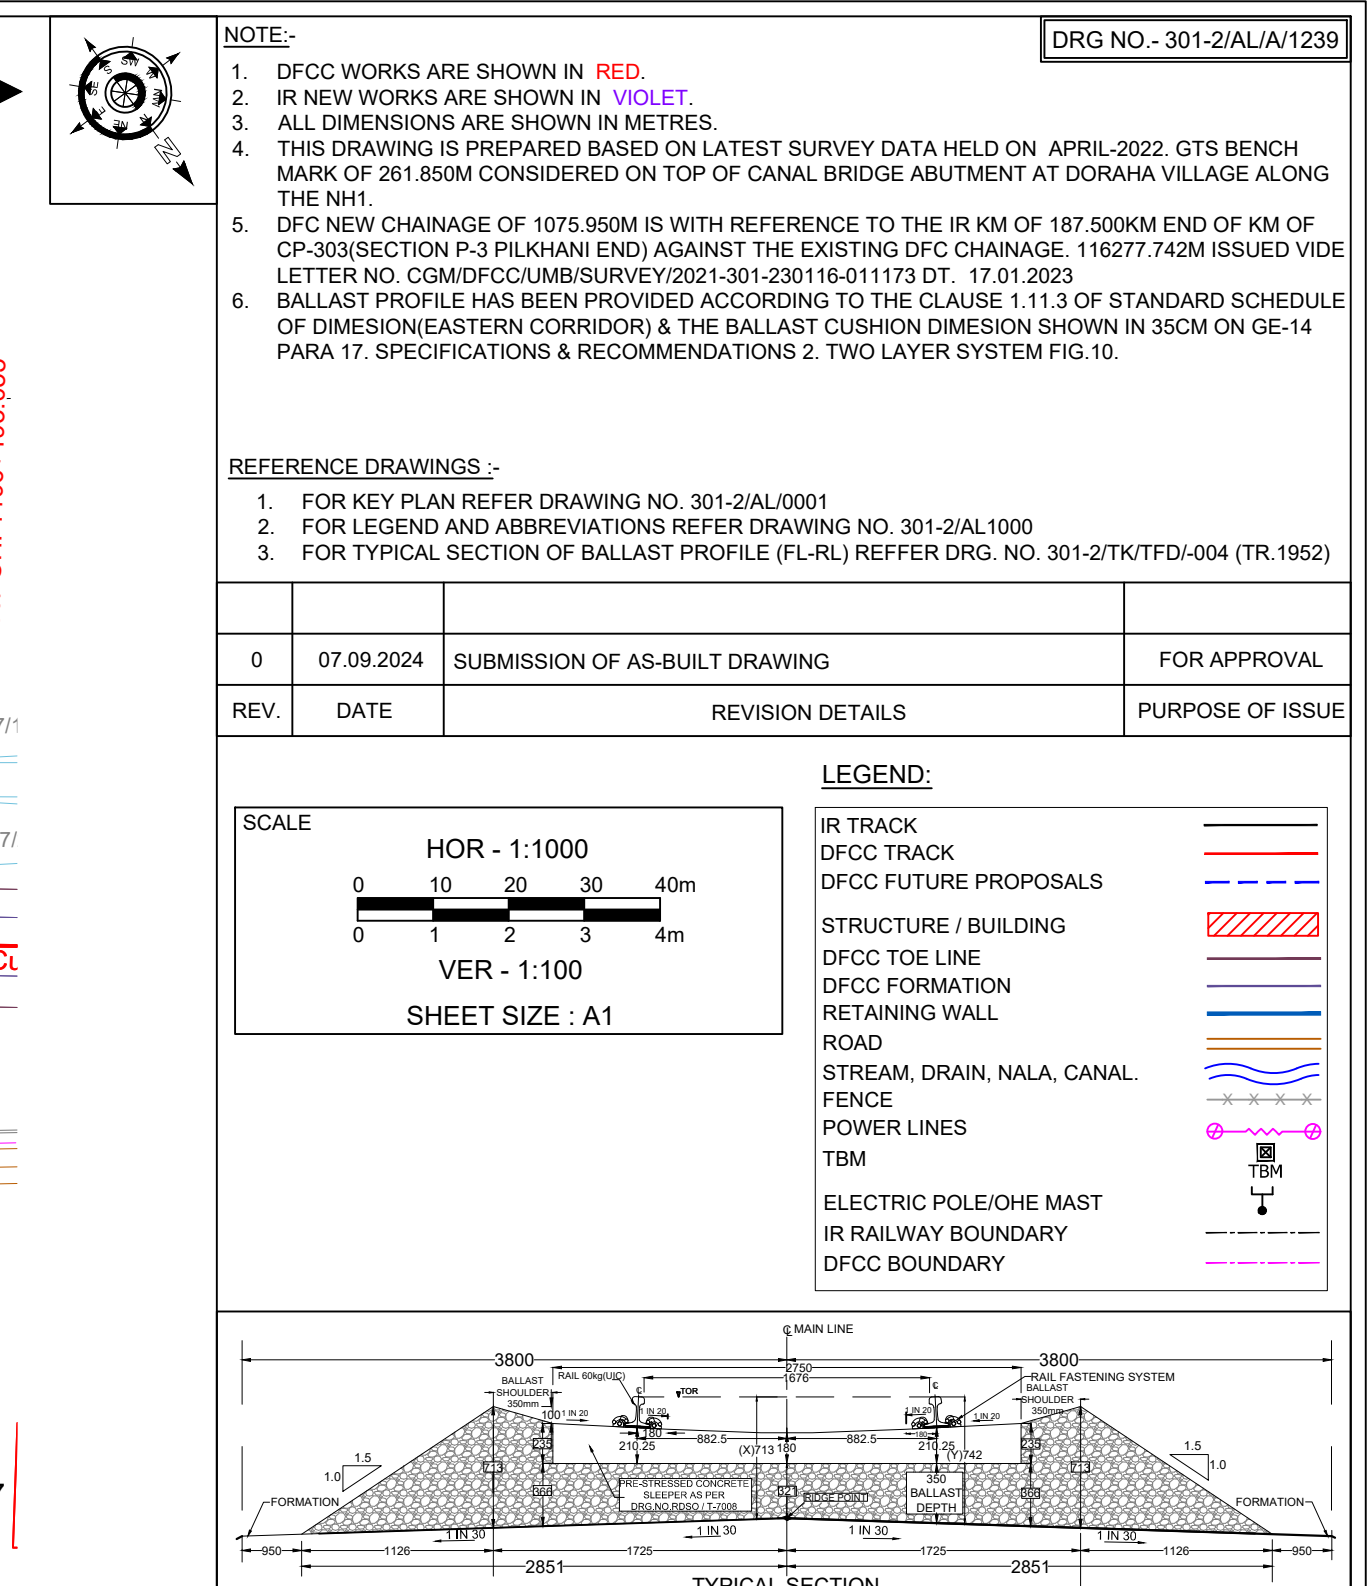

OWNER	DEDICATED FREIGHT CORRIDOR CORPORATION OF INDIA LTD. (A GOVERNMENT OF INDIA ENTERPRISE) PROJECT OFFICE/AMBALA UNIT: OLD RAILWAY COLONY (NEAR ANAND MARKET),AMBALA CANTT-133001. CORPORATE IDENTITY NO. : U60232DL2006GOI155068
-------	--


CONTRACTOR: GIL - TPL JV



 

[illegible]

AS BUILT DRAWING		
TITLE AS-BUILT PLAN AND PROFILE FROM IR KM: 306.500 TO 307.000 DFC KM: 1195.990 TO 1196.490	DFCC APPR. NO. -	STATUS A
	ENGG. APPR. NO. -	
	DRG. NO. - 301-2/A/A/1239	
	SHEET NO. : 1 OF 1	
	DATE : 07.09.2024	

	TR.
--	-----

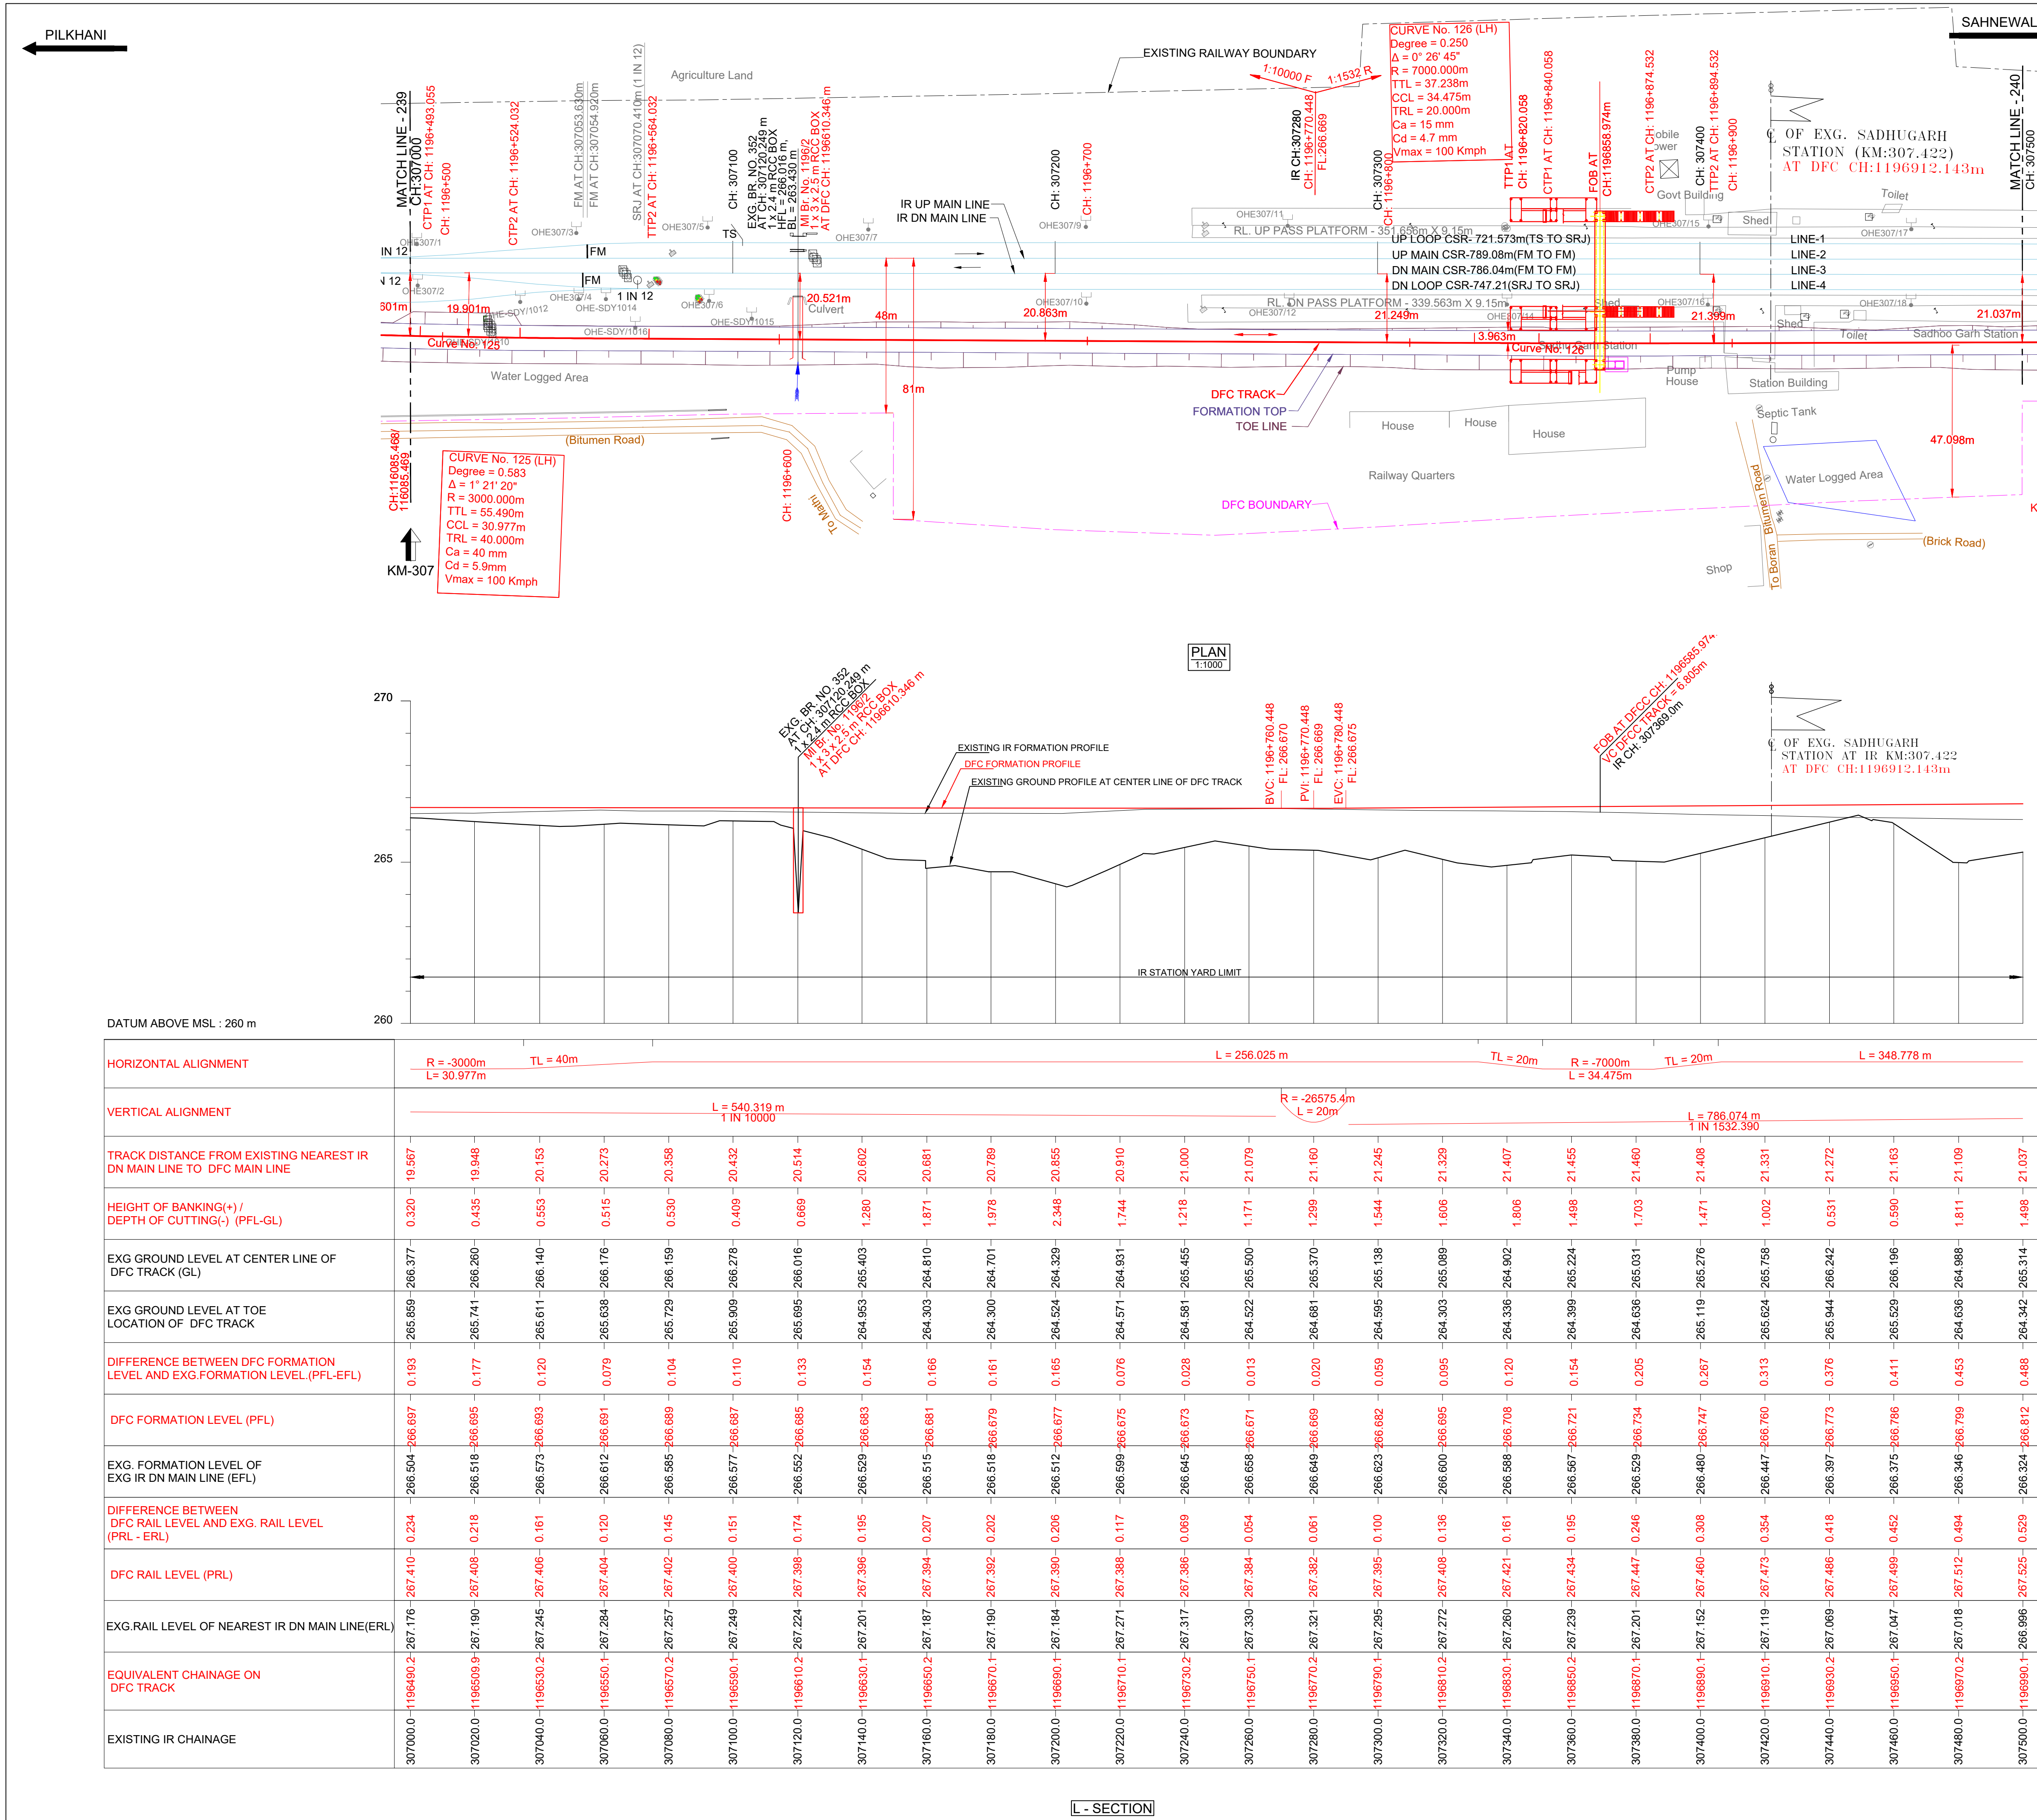

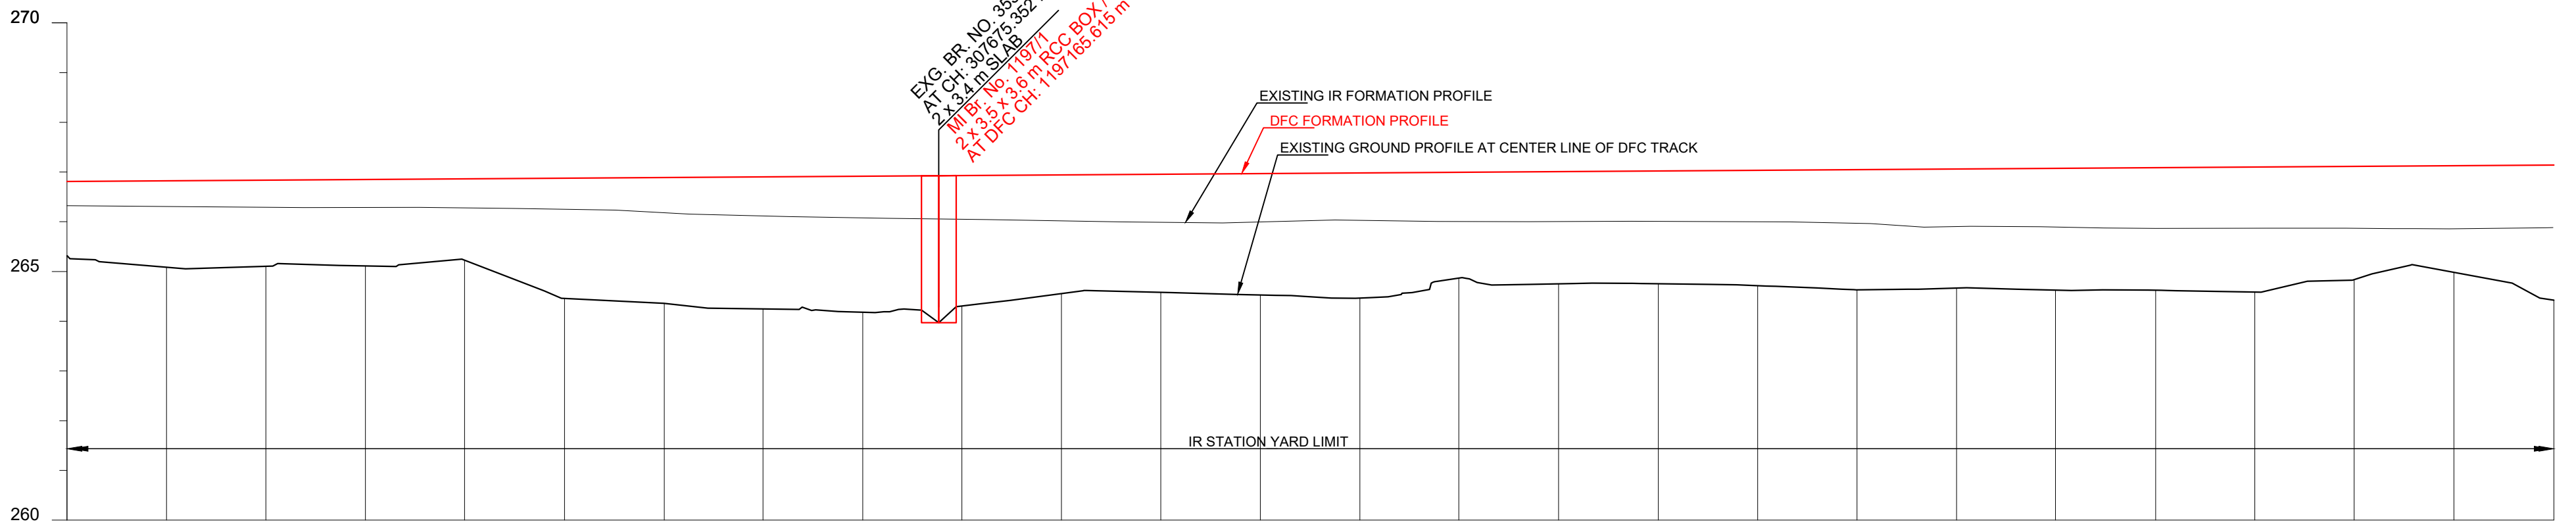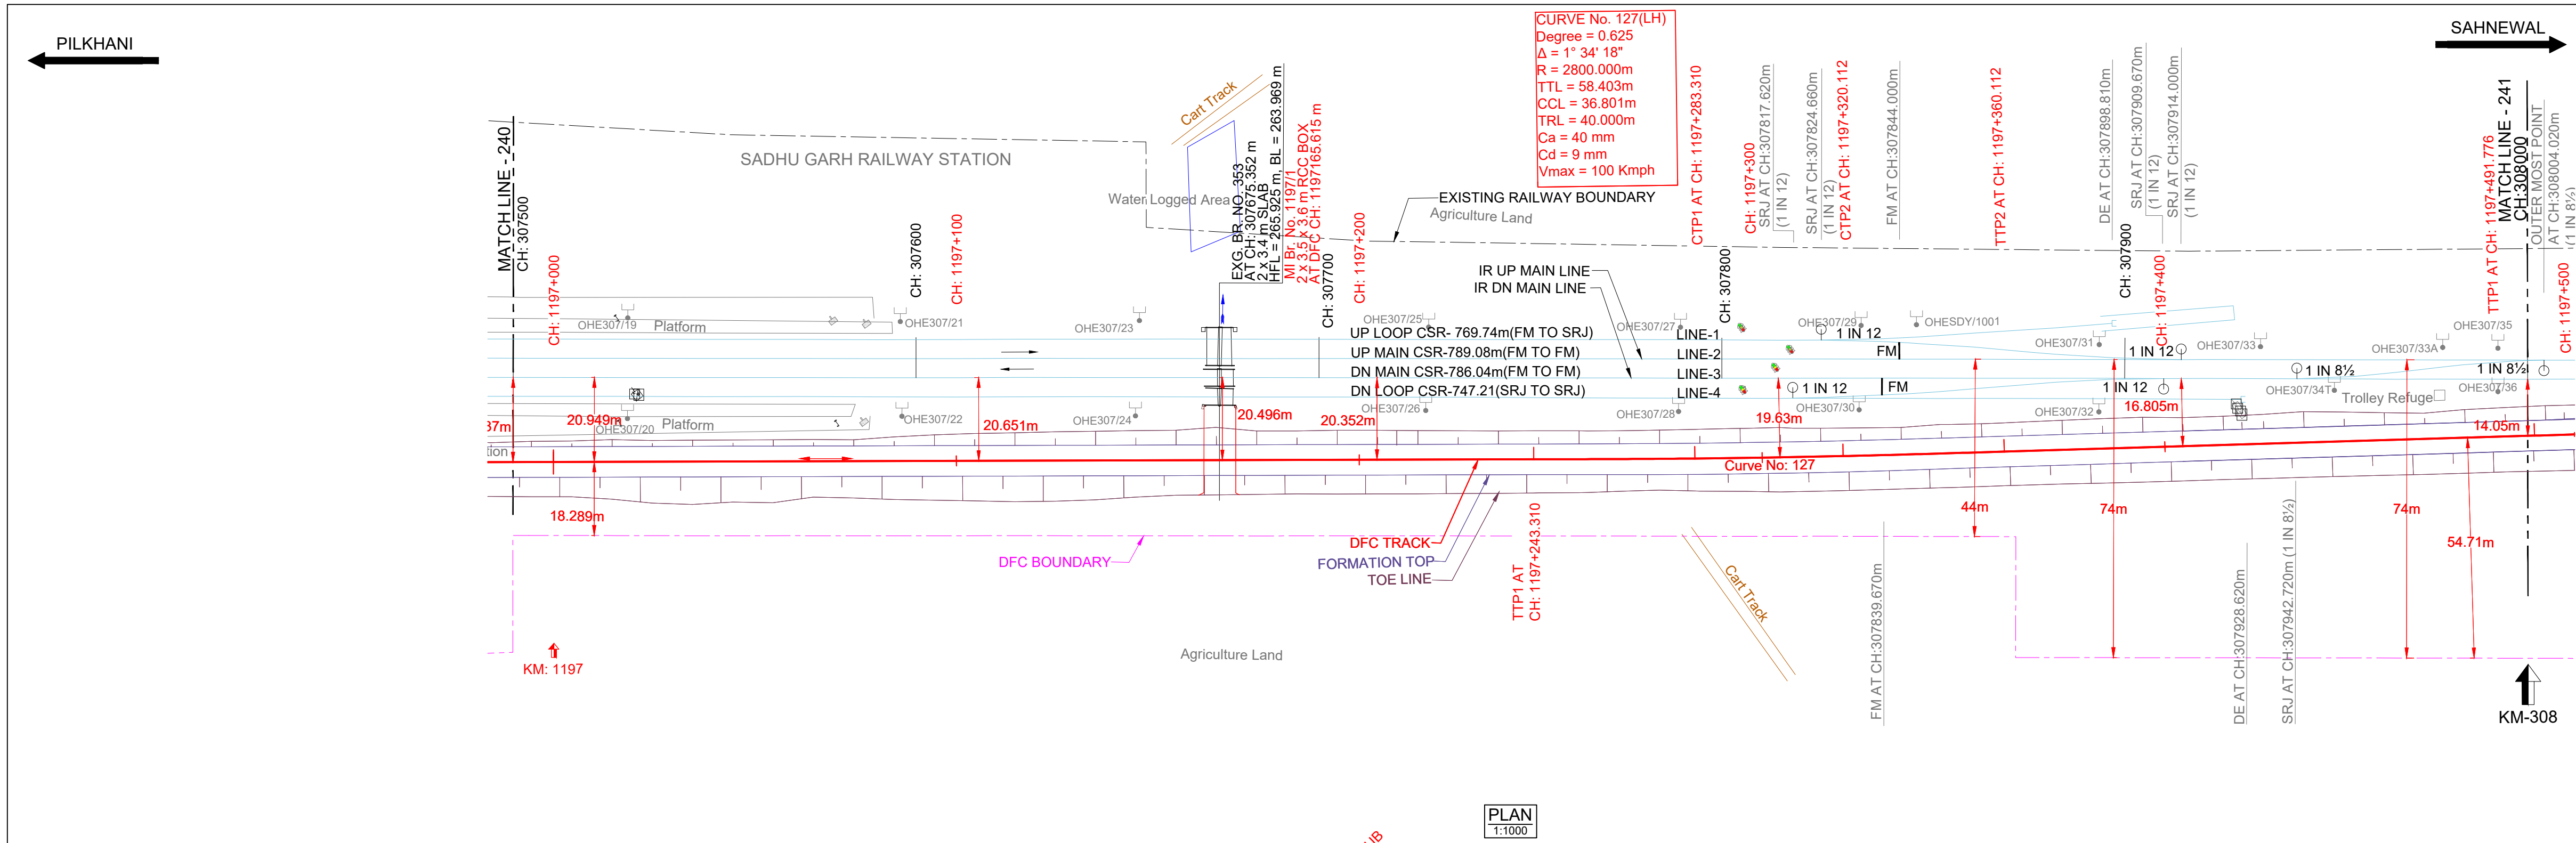

DATUM ABOVE MSL : 260 m

HORIZONTAL ALIGNMENT	L = 348.778 m																			
VERTICAL ALIGNMENT	L = 786.074 m 1 IN 1532.390																			
TRACK DISTANCE FROM EXISTING NEAREST IR DN MAIN LINE TO DFC MAIN LINE	21.037	21.498	20.955	20.879	20.820	20.732	20.666	20.678	20.603	20.553	20.480	20.408	20.328	20.252	20.192	20.080	19.848	19.520	19.078	14.050
HEIGHT OF BANKING(+) / DEPTH OF CUTTING(-) (PFL-GL)	+1.498	+1.738	+1.733	+1.740	+1.638	+2.419	+2.533	+2.657	+2.735	+2.625	+2.387	+2.377	+2.441	+2.517	+2.428	+2.255	+2.391	+2.448	+2.514	+2.717
EXG GROUND LEVEL AT CENTER LINE OF DFC TRACK (GL)	265.314	265.087	265.105	265.112	265.227	264.459	264.358	264.247	264.182	264.305	264.566	264.579	264.528	264.753	264.465	264.867	264.753	264.625	264.586	264.835
EXG GROUND LEVEL AT TOE LOCATION OF DFC TRACK	264.342	264.237	263.854	263.787	264.154	263.853	263.690	263.776	264.205	264.430	264.497	264.490	264.535	264.576	264.611	264.838	264.755	264.562	264.560	264.529
DIFFERENCE BETWEEN DFC FORMATION LEVEL AND EXG FORMATION LEVEL (PFL-EFL)	0.488	0.519	0.548	0.564	0.584	0.626	0.709	0.786	0.837	0.880	0.925	0.966	0.972	0.952	0.990	1.003	1.013	1.179	1.229	1.244
DFC FORMATION LEVEL (PFL)	266.812	266.825	266.838	266.852	266.865	266.878	266.891	266.904	266.917	266.930	266.943	266.956	266.969	266.982	266.995	267.008	267.017	267.073	267.100	267.113
EXG FORMATION LEVEL OF EXG IR DN MAIN LINE (EFL)	266.324	266.306	266.290	266.288	266.281	266.252	266.182	266.118	266.080	266.050	266.018	265.990	265.997	266.030	266.005	266.999	266.984	266.894	266.871	266.869
DIFFERENCE BETWEEN DFC RAIL LEVEL AND EXG. RAIL LEVEL (PRL - ERL)	0.529	0.560	0.590	0.604	0.624	0.666	0.750	0.827	0.878	0.921	0.965	1.007	1.013	0.993	1.031	1.044	1.054	1.220	1.269	1.285
DFC RAIL LEVEL (PRL)	267.525	267.538	267.551	267.565	267.578	267.591	267.604	267.617	267.630	267.643	267.656	267.669	267.677	267.690	267.708	267.721	267.734	267.786	267.812	267.826
EXG RAIL LEVEL OF NEAREST IR DN MAIN LINE (ERL)	266.996	266.978	266.962	266.960	266.953	266.924	266.854	266.790	266.752	266.722	266.680	266.662	266.669	266.680	266.677	266.641	266.575	266.566	266.543	266.541
EQUIVALENT CHAINAGE ON DFC TRACK	1196990.1	1197010.1	1197030.1	1197050.2	1197070.1	1197090.2	1197110.3	1197130.1	1197150.2	1197170.1	1197190.2	1197210.1	1197230.2	1197250.2	1197270.1	1197290.2	1197310.2	1197330.2	1197350.1	1197370.2
EXISTING IR CHAINAGE	307500.0	307520.0	307540.0	307560.0	307580.0	307600.0	307620.0	307640.0	307660.0	307680.0	307700.0	307720.0	307740.0	307760.0	307780.0	307800.0	307820.0	307840.0	307860.0	307880.0

L - SECTION

NOTE:-

- DFCC WORKS ARE SHOWN IN RED.
- IR NEW WORKS ARE SHOWN IN VIOLET.
- ALL DIMENSIONS ARE SHOWN IN METRES.
- THIS DRAWING IS PREPARED BASED ON LATEST SURVEY DATA HELD ON APRIL-2022. GTS BENCH MARK OF 261.850M CONSIDERED ON TOP OF CANAL BRIDGE ABUTMENT AT DORANA VILLAGE ALONG THE NH1.
- DFC NEW CHAINAGE OF 1075.950M IS WITH REFERENCE TO THE IR KM OF 187.500KM END OF KM OF CP-303(SECTION P-3 PILKHANI END) AGAINST THE EXISTING DFC CHAINAGE. 116277.742M ISSUED VIDE LETTER NO. COM/DFCC/MB/SURVEY/2021-301-230116-011173 DT. 17.01.2023
- BALLAST PROFILE HAS BEEN PROVIDED ACCORDING TO THE CLAUSE 1.11.3 OF STANDARD SCHEDULE OF DIMENSION (EASTERN CORRIDOR) & THE BALLAST CUSHION DIMENSION SHOWN IN 35CM ON GE-14 PARA 17. SPECIFICATIONS & RECOMMENDATIONS 2. TWO LAYER SYSTEM FIG.10.

REFERENCE DRAWINGS:-

- FOR KEY PLAN REFER DRAWING NO. 301-2/AL/0001
- FOR LEGEND AND ABBREVIATIONS REFER DRAWING NO. 301-2/AL/1000
- FOR TYPICAL SECTION OF BALLAST PROFILE (FL-RL) REFER DRG. NO. 301-2/TK/TFDI-004 (TR.1952)

07.09.2024SUBMISSION OF AS-BUILT DRAWINGFOR APPROVAL

REV. DATE REVISION DETAILS PURPOSE OF ISSUE

SCALE
HOR - 1:1000
VER - 1:100
SHEET SIZE : A1

LEGEND:

- IR TRACK
- DFCC TRACK
- DFCC FUTURE PROPOSALS
- STRUCTURE / BUILDING
- DFCC TOE LINE
- DFCC FORMATION
- RETAINING WALL
- ROAD
- STREAM, DRAIN, NALA, CANAL
- FENCE
- POWER LINES
- TBM
- ELECTRIC POLE/OHE MAST
- IR RAILWAY BOUNDARY
- DFCC BOUNDARY

TYPICAL SECTION

TRACK STRUCTURE

RAIL SECTION: 60Kg/m (UIC 60Kg/m)	Difference between FL- RL (Below Rail Seat)	
DFC LINE: 60Kg/m (UIC 60Kg/m)	IR Line	DFC
IR MAIN LINE: 52Kg/m	172mm	172mm
RUBBER PAD	6mm	10mm
SLEEPER DEPTH	210mm	210mm
BALLAST CUSHION	300mm	350mm
Total Depth (FL TO RL)	688mm	742mm

OWNER
DEDICATED FREIGHT CORRIDOR CORPORATION OF INDIA LTD.
(A GOVERNMENT OF INDIA ENTERPRISE)
PROJECT OFFICE (AMBALA UNIT): OLD RAILWAY COLONY (NEAR ANAND MARKET), AMBALA CANTT-133001.
CORPORATE IDENTITY NO. : U60232DL2006GGI155068

ENGINEER:
DB Engineering & Consulting GmbH
Deutsche Bahn Engineering & Consulting GmbH

CONTRACTOR:
GIL - TPL JV
GAR TATA

SUBMITTED BY	GIL - TPL JV		
PREPARED BY	DATED	NAME	SIGNATURE
CHECKED BY	07.09.2024	VIJAY PRATAP	
APPROVED BY	07.09.2024	PARASURAM KOTYADA	
APPROVED BY	DEUTSCHE BAHN ENGINEERING & CONSULTING GMBH		
	DATED	NAME	SIGNATURE
Sr. DE./CHIEF ENGINEER		SURESH K.YALANGI	
CHIEF TRACK ENGINEER		RAJ PAL SINGH	
T.L.		H.D. VIDJAK	

STAMP
A AS-BUILT DRAWING
TR. Ref.:.....
ENGINEER Sign.:.....

EMPLOYER (DFCCIL): DEDICATED FREIGHT CORRIDOR CORPORATION OF INDIA LTD.

AS BUILT DRAWING

AS-BUILT PLAN AND PROFILE

DFCC APPR. NO. -
ENGG. APPR. NO. -
DRG. NO. - 301-2/AL/A/1241
SHEET NO. : 1 OF 1
DATE : 07.09.2024

STATUS
A

FROM IR KM: 307.500 TO 308.000
DFC KM: 1196.990 TO 1197.490

TR.