
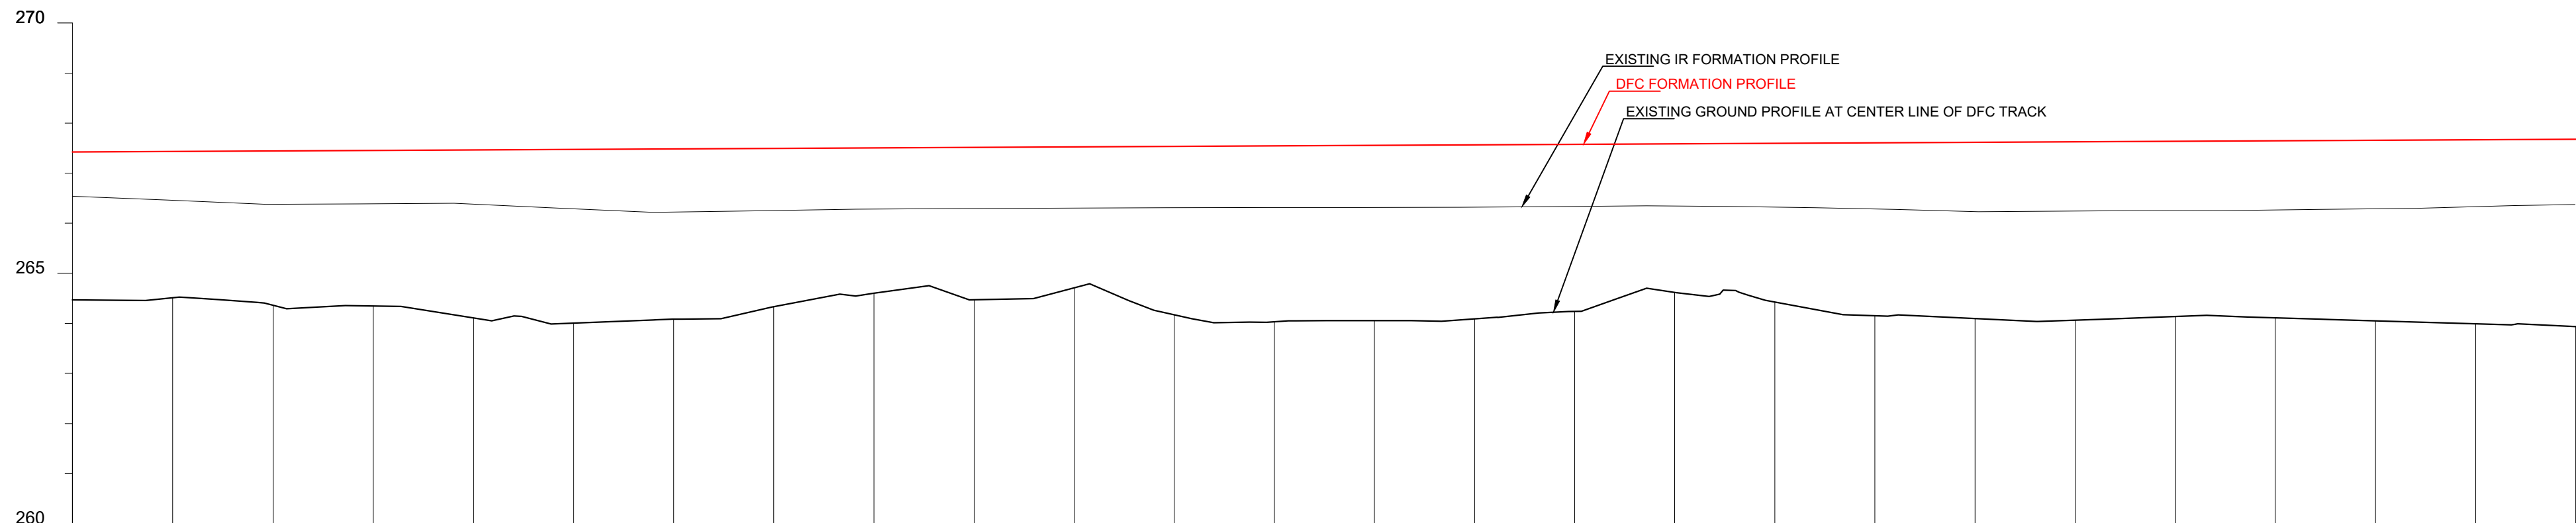


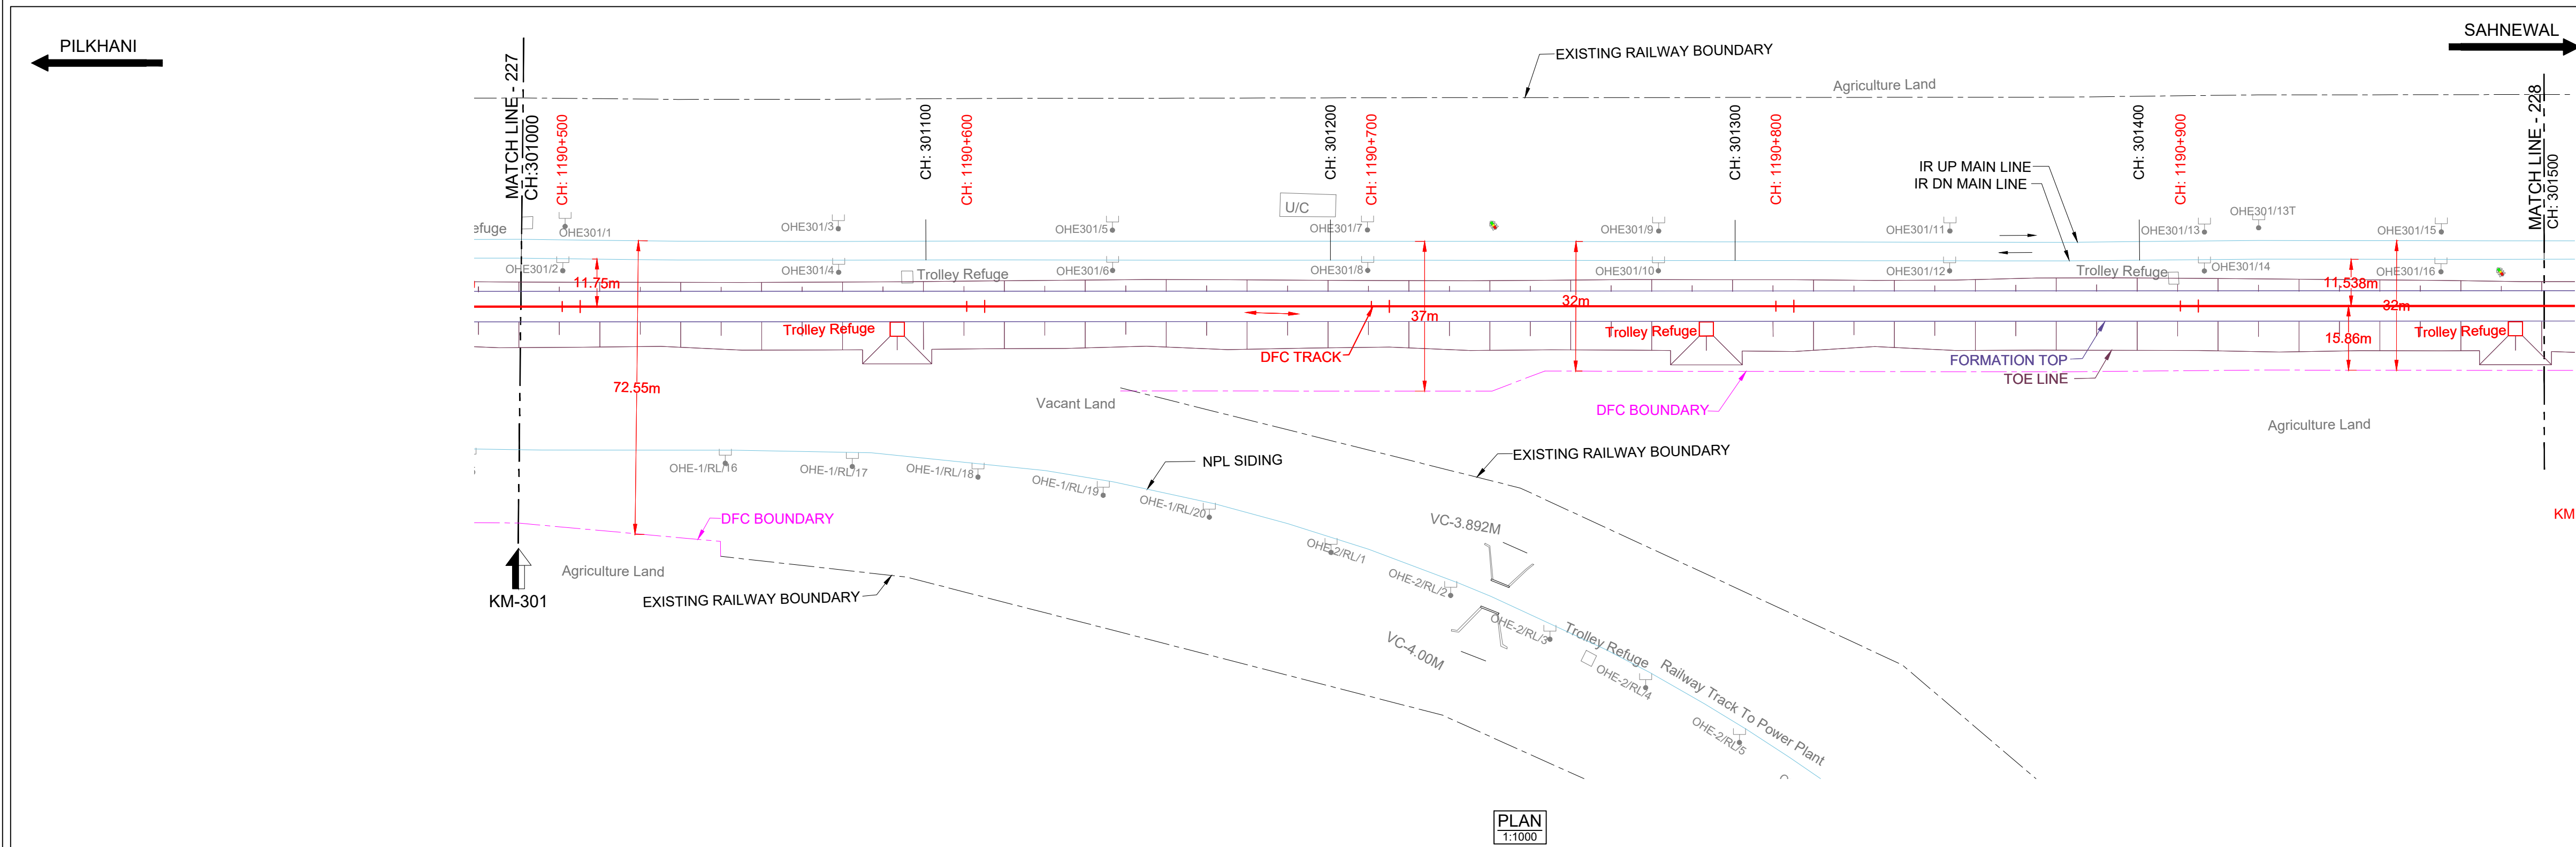

DATUM ABOVE MSL : 260 m

HORIZONTAL ALIGNMENT	L = 1896.657m																			
VERTICAL ALIGNMENT	L=1099.758 m 1 IN 1978.448 R																			
TRACK DISTANCE FROM EXISTING NEAREST IR DN MAIN LINE TO DFC MAIN LINE	11.952	11.952	11.952	11.952	11.952	11.952	11.952	11.952	11.952	11.952	11.952	11.952	11.952	11.952	11.952	11.952	11.952	11.952	11.952	11.952
HEIGHT OF BANKING(+) / DEPTH OF CUTTING(-) (PFL-GL)	+2.953	+2.953	+2.953	+2.953	+2.953	+2.953	+2.953	+2.953	+2.953	+2.953	+2.953	+2.953	+2.953	+2.953	+2.953	+2.953	+2.953	+2.953	+2.953	+2.953
EXG GROUND LEVEL AT CENTER LINE OF DFC TRACK (GL)	264.471	264.471	264.471	264.471	264.471	264.471	264.471	264.471	264.471	264.471	264.471	264.471	264.471	264.471	264.471	264.471	264.471	264.471	264.471	264.471
EXG GROUND LEVEL AT TOE LOCATION OF DFC TRACK	264.184	264.184	264.184	264.184	264.184	264.184	264.184	264.184	264.184	264.184	264.184	264.184	264.184	264.184	264.184	264.184	264.184	264.184	264.184	264.184
DIFFERENCE BETWEEN DFC FORMATION LEVEL AND EXG.FORMATION LEVEL (PFL-EFL)	0.882	0.882	0.882	0.882	0.882	0.882	0.882	0.882	0.882	0.882	0.882	0.882	0.882	0.882	0.882	0.882	0.882	0.882	0.882	0.882
DFC FORMATION LEVEL (PFL)	267.424	267.424	267.424	267.424	267.424	267.424	267.424	267.424	267.424	267.424	267.424	267.424	267.424	267.424	267.424	267.424	267.424	267.424	267.424	267.424
EXG. FORMATION LEVEL OF EXG IR DN MAIN LINE (EFL)	266.542	266.542	266.542	266.542	266.542	266.542	266.542	266.542	266.542	266.542	266.542	266.542	266.542	266.542	266.542	266.542	266.542	266.542	266.542	266.542
DIFFERENCE BETWEEN DFC RAIL LEVEL AND EXG. RAIL LEVEL (PRL - ERL)	0.922	0.922	0.922	0.922	0.922	0.922	0.922	0.922	0.922	0.922	0.922	0.922	0.922	0.922	0.922	0.922	0.922	0.922	0.922	0.922
DFC RAIL LEVEL (PRL)	268.136	268.136	268.136	268.136	268.136	268.136	268.136	268.136	268.136	268.136	268.136	268.136	268.136	268.136	268.136	268.136	268.136	268.136	268.136	268.136
EXG.RAIL LEVEL OF NEAREST IR DN MAIN LINE(ERL)	267.214	267.214	267.214	267.214	267.214	267.214	267.214	267.214	267.214	267.214	267.214	267.214	267.214	267.214	267.214	267.214	267.214	267.214	267.214	267.214
EQUIVALENT CHAINAGE ON DFC TRACK	1190489.9	1190489.9	1190489.9	1190489.9	1190489.9	1190489.9	1190489.9	1190489.9	1190489.9	1190489.9	1190489.9	1190489.9	1190489.9	1190489.9	1190489.9	1190489.9	1190489.9	1190489.9	1190489.9	1190489.9
EXISTING IR CHAINAGE	301000.0	301000.0	301000.0	301000.0	301000.0	301000.0	301000.0	301000.0	301000.0	301000.0	301000.0	301000.0	301000.0	301000.0	301000.0	301000.0	301000.0	301000.0	301000.0	301000.0

L - SECTION

NOTE:-

- DFCC WORKS ARE SHOWN IN RED.
- IR NEW WORKS ARE SHOWN IN VIOLET.
- ALL DIMENSIONS ARE SHOWN IN METRES.
- THIS DRAWING IS PREPARED BASED ON LATEST SURVEY DATA HELD ON APRIL-2022. GTS BENCH MARK OF 261.850M CONSIDERED ON TOP OF CANAL BRIDGE ABUTMENT AT DORANA VILLAGE ALONG THE NH1.
- DFC NEW CHAINAGE OF 1075.950M IS WITH REFERENCE TO THE IR KM OF 187.500KM END OF KM OF CP-303(SECTION P-3 PILKHANI END) AGAINST THE EXISTING DFC CHAINAGE. 116277.742M ISSUED VIDE LETTER NO. COM/DFCC/UMS/SURVEY/2021-301-2301/16-011173 DT. 17.01.2023.
- BALLAST PROFILE HAS BEEN PROVIDED ACCORDING TO THE CLAUSE 1.11.3 OF STANDARD SCHEDULE OF DIMENSION(EASTERN CORRIDOR) & THE BALLAST CUSHION DIMENSION SHOWN IN 35CM ON GE-14 PARA 17. SPECIFICATIONS & RECOMMENDATIONS 2. TWO LAYER SYSTEM FIG.10.

REFERENCE DRAWINGS :-

- FOR KEY PLAN REFER DRAWING NO. 301-2/AL/0001
- FOR LEGEND AND ABBREVIATIONS REFER DRAWING NO. 301-2/AL/1000
- FOR TYPICAL SECTION OF BALLAST PROFILE (FL-RL) REFER DRG. NO. 301-2/TK/TFD/-004 (TR.1952)

07.09.2024SUBMISSION OF AS-BUILT DRAWINGFOR APPROVAL

REV. DATE REVISION DETAILS PURPOSE OF ISSUE

SCALE
HOR - 1:1000
VER - 1:100
SHEET SIZE : A1

LEGEND:

- IR TRACK
- DFCC TRACK
- DFCC FUTURE PROPOSALS
- STRUCTURE / BUILDING
- DFCC TOE LINE
- DFCC FORMATION
- RETAINING WALL
- ROAD
- STREAM, DRAIN, NALA, CANAL.
- FENCE
- POWER LINES
- TBM
- ELECTRIC POLE/OHE MAST
- IR RAILWAY BOUNDARY
- DFCC BOUNDARY

TRACK STRUCTURE

RAIL SECTION: 60Kg/m (UIC 60Kg/m)	Difference between FL- RL (Below Rail Seat)	
DFC LINE: 60Kg/m (UIC 60Kg/m)	IR Line	DFC
IR MAIN LINE: 52Kg/m	172mm	172mm
RUBBER PAD	6mm	10mm
SLEEPER DEPTH	210mm	210mm
BALLAST CUSHION	300mm	350mm
Total Depth (FL TO RL)	688mm	742mm

OWNER

DEDICATED FREIGHT CORRIDOR CORPORATION OF INDIA LTD.
(A GOVERNMENT OF INDIA ENTERPRISE)
PROJECT OFFICE (AMBALA UNIT): OLD RAILWAY COLONY (NEAR ANAND MARKET), AMBALA CANTT-133001.
CORPORATE IDENTITY NO. : U60232DL2006GGI155068

ENGINEER:

DB Engineering & Consulting GmbH
Deutsche Bahn Engineering & Consulting GmbH

CONTRACTOR:

GIL - TPL JV
GAR TATA

SUBMITTED BY	GIL - TPL JV		
PREPARED BY	DATED	NAME	SIGNATURE
CHECKED BY	07.09.2024	VIJAY PRATAP	
APPROVED BY	07.09.2024	PARASURAM KOTYADA	

APPROVED BY

DEUTSCHE BAHN ENGINEERING & CONSULTING GMBH

DATED	NAME	SIGNATURE
Sr. DE./CHIEF ENGINEER	SURESH K.YALANGI	
CHIEF TRACK ENGINEER	RAJ PAL SINGH	
T.L.	H.D. VIDJAK	

STAMP

A AS-BUILT DRAWING
TR. Ref.:.....
ENGINEER Sign.:.....

EMPLOYER (DFCCIL):

DEDICATED FREIGHT CORRIDOR CORPORATION OF INDIA LTD.

AS BUILT DRAWING

TITLE
AS-BUILT PLAN AND PROFILE
FROM IR KM: 301.000 TO 301.500
DFC KM: 1190.490 TO 1190.990

DFCC APPR. NO. -
ENGG. APPR. NO. -
DRG. NO. - 301-2/AL/A/1228
SHEET NO. : 1 OF 1
DATE : 07.09.2024

STATUS
A

TR.