
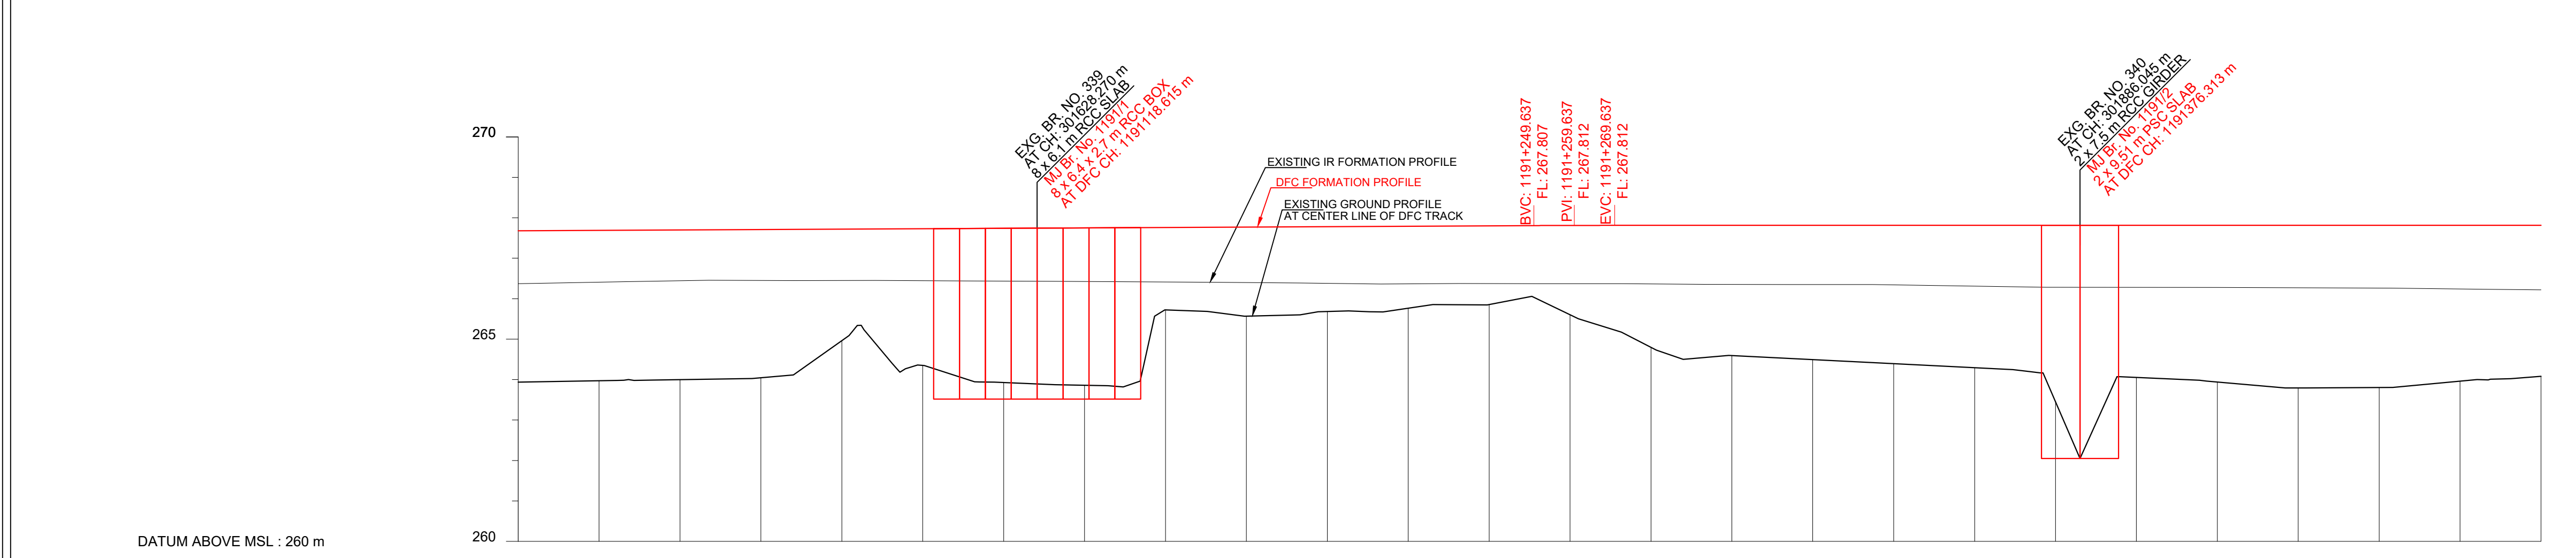


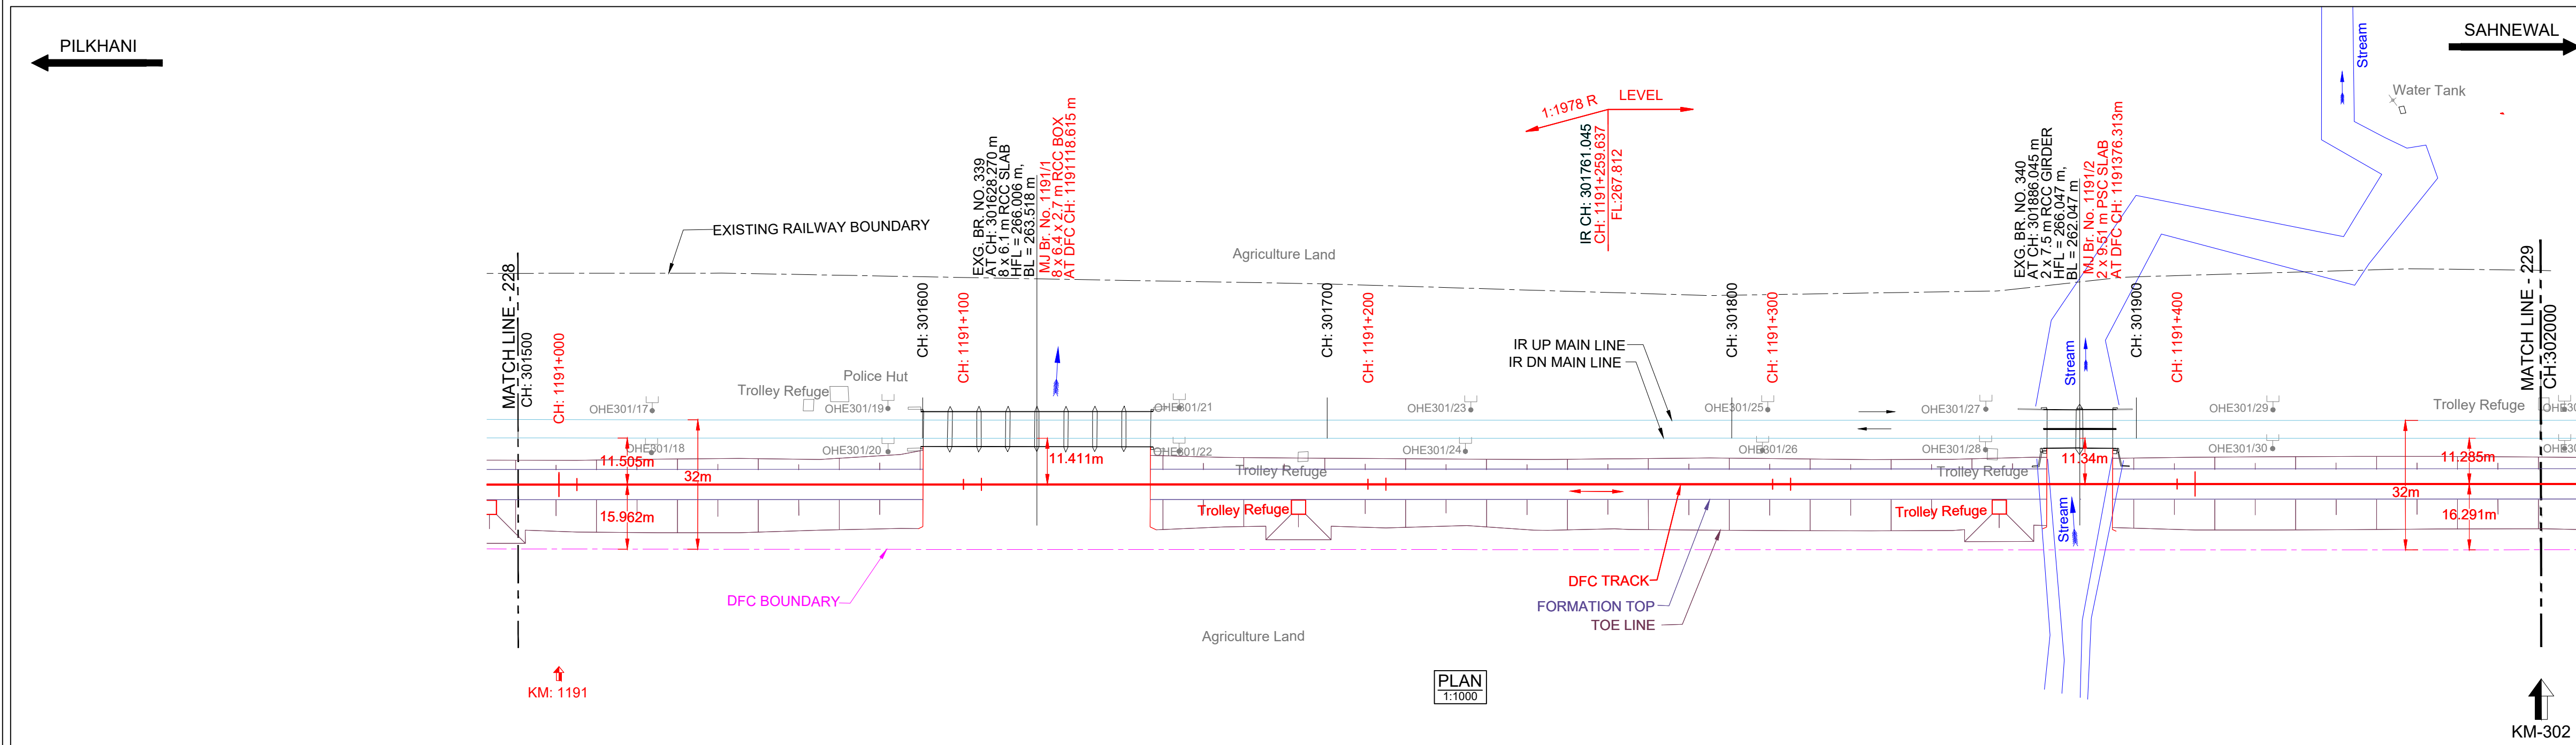

HORIZONTAL ALIGNMENT	L = 1896.657m																			
VERTICAL ALIGNMENT	L=1099.758 m 1 IN 1978.446 R																			
TRACK DISTANCE FROM EXISTING NEAREST IR DN MAIN LINE TO DFC MAIN LINE	11.528	11.528	11.512	11.482	11.463	11.449	11.433	11.417	11.409	11.410	11.408	11.400	11.393	11.387	11.384	11.385	11.376	11.346	11.327	11.280
HEIGHT OF BANKING(+) / DEPTH OF CUTTING(-) (PFL-GL)	+3.744	+3.717	+3.701	+3.664	+3.664	+2.759	+3.380	11.417	11.409	11.410	11.408	11.400	11.393	11.387	11.384	11.385	11.376	11.346	11.327	11.280
EXG GROUND LEVEL AT CENTER LINE OF DFC TRACK (GL)	263.935	263.972	263.998	264.046	264.046	264.961	264.350	263.926	263.859	265.723	265.567	265.684	265.764	265.852	265.604	264.796	264.593	264.493	264.393	264.287
EXG GROUND LEVEL AT TOE LOCATION OF DFC TRACK	263.910	263.629	263.584	263.674	264.046	263.969	264.092	263.961	263.927	264.025	264.402	264.455	264.321	264.357	264.017	264.044	263.956	263.898	263.793	264.120
DIFFERENCE BETWEEN DFC FORMATION LEVEL AND EXG.FORMATION LEVEL (PFL-EFL)	1.306	1.282	1.256	1.260	1.260	1.272	1.285	1.304	1.325	1.348	1.372	1.402	1.424	1.428	1.439	1.447	1.459	1.462	1.473	1.595
DFC FORMATION LEVEL (PFL)	267.679	267.680	267.699	267.710	267.710	267.720	267.730	267.740	267.750	267.761	267.771	267.781	267.791	267.801	267.810	267.812	267.812	267.812	267.812	267.812
EXG. FORMATION LEVEL OF EXG IR DN MAIN LINE (EFL)	266.373	266.407	266.443	266.450	266.449	266.448	266.445	266.436	266.425	266.413	266.399	266.379	266.367	266.373	266.371	266.365	266.353	266.350	266.339	266.217
DIFFERENCE BETWEEN DFC RAIL LEVEL AND EXG. RAIL LEVEL (PRL - ERL)	1.344	1.320	1.293	1.297	1.297	1.309	1.322	1.342	1.363	1.385	1.409	1.439	1.461	1.465	1.477	1.488	1.500	1.503	1.514	1.636
DFC RAIL LEVEL (PRL)	268.389	268.399	268.409	268.419	268.419	268.429	268.439	268.449	268.459	268.470	268.480	268.490	268.500	268.510	268.520	268.525	268.525	268.525	268.525	268.525
EXG.RAIL LEVEL OF NEAREST IR DN MAIN LINE(ERL)	267.045	267.079	267.115	267.122	267.122	267.120	267.117	267.108	267.097	267.085	267.071	267.051	267.039	267.045	267.043	267.037	267.025	267.022	267.011	266.889
EQUIVALENT CHAINAGE ON DFC TRACK	1190990.0	1191010.0	1191030.0	1191050.0	1191070.0	1191090.0	1191110.0	1191130.0	1191150.0	1191170.0	1191190.0	1191210.0	1191230.0	1191250.0	1191270.0	1191290.0	1191310.0	1191330.0	1191350.0	1191370.0
EXISTING IR CHAINAGE	301500.0	301520.0	301540.0	301560.0	301580.0	301600.0	301620.0	301640.0	301660.0	301680.0	301700.0	301720.0	301740.0	301760.0	301780.0	301800.0	301820.0	301840.0	301860.0	301880.0

L - SECTION

NOTE:-

- DFCC WORKS ARE SHOWN IN RED.
- IR NEW WORKS ARE SHOWN IN VIOLET.
- ALL DIMENSIONS ARE SHOWN IN METRES.
- THIS DRAWING IS PREPARED BASED ON LATEST SURVEY DATA HELD ON APRIL-2022. GTS BENCH MARK OF 261.850M CONSIDERED ON TOP OF CANAL BRIDGE ABUTMENT AT DORHA VILLAGE ALONG THE NH1.
- DFC NEW CHAINAGE OF 1075.950M IS WITH REFERENCE TO THE IR KM OF 187.500KM END OF KM OF CP-303(SECTION P-3 PILKHANI END) AGAINST THE EXISTING DFC CHAINAGE. 116277.742M ISSUED VIDE LETTER NO. COM/DFCC/UMS/SURVEY/2021-301-2301/16-011173 DT. 17.01.2023.
- BALLAST PROFILE HAS BEEN PROVIDED ACCORDING TO THE CLAUSE 1.11.3 OF STANDARD SCHEDULE OF DIMENSION(EASTERN CORRIDOR) & THE BALLAST CUSHION DIMENSION SHOWN IN 35CM ON GE-14 PARA 17. SPECIFICATIONS & RECOMMENDATIONS 2. TWO LAYER SYSTEM FIG.10.

REFERENCE DRAWINGS :-

- FOR KEY PLAN REFER DRAWING NO. 301-2/AL/0001
- FOR LEGEND AND ABBREVIATIONS REFER DRAWING NO. 301-2/AL/1000
- FOR TYPICAL SECTION OF BALLAST PROFILE (FL-RL) REFER DRG. NO. 301-2/TK/TFDI-004 (TR.1952)

07.09.2024SUBMISSION OF AS-BUILT DRAWINGFOR APPROVAL

REV. DATE REVISION DETAILS PURPOSE OF ISSUE

SCALE
HOR - 1:1000
VER - 1:100
SHEET SIZE : A1

LEGEND:
IR TRACK
DFCC TRACK
DFCC FUTURE PROPOSALS
STRUCTURE / BUILDING
DFCC TOE LINE
DFCC FORMATION
RETAINING WALL
ROAD
STREAM, DRAIN, NALA, CANAL.
FENCE
POWER LINES
TBM
ELECTRIC POLE/OHE MAST
IR RAILWAY BOUNDARY
DFCC BOUNDARY

TRACK STRUCTURE

RAIL SECTION: 60Kg/m (UIC 60Kg/m)	Difference between FL- RL (Below Rail Seat)	
DFC LINE: 60Kg/m (UIC 60Kg/m)	IR Line	DFC
BALLAST CUSHION	172mm	172mm
	6mm	10mm
	210mm	210mm
	300mm	350mm
Total Depth (FL TO RL)	688mm	742mm

OWNER
DEDICATED FREIGHT CORRIDOR CORPORATION OF INDIA LTD.
(A GOVERNMENT OF INDIA ENTERPRISE)
PROJECT OFFICE(AMBALA UNIT): OLD RAILWAY COLONY (NEAR ANAND MARKET),AMBALA CANTT-133001.
CORPORATE IDENTITY NO. : U60232DL2006GGI155068

ENGINEER:
DB Engineering & Consulting GmbH
Deutsche Bahn Engineering & Consulting GmbH

CONTRACTOR:
GIL - TPL JV
GAR TATA

SUBMITTED BY	GIL - TPL JV		
	DATED	NAME	SIGNATURE
PREPARED BY			
CHECKED BY	07.09.2024	VIJAY PRATAP	
APPROVED BY	07.09.2024	PARASURAM KOTYADA	
APPROVED BY	DEUTSCHE BAHN ENGINEERING & CONSULTING GMBH		
	DATED	NAME	SIGNATURE
Sr. DE./CHIEF ENGINEER		SURESH K.YALANGI	
CHIEF TRACK ENGINEER		RAJ PAL SINGH	
T.L.		H.D. VIDJAK	

STAMP
A AS-BUILT DRAWING
TR. Ref.....
ENGINEER Sign.:

EMPLOYER (DFCCIL): DEDICATED FREIGHT CORRIDOR CORPORATION OF INDIA LTD.

AS BUILT DRAWING

TITLE
AS-BUILT PLAN AND PROFILE
FROM IR KM: 301.500 TO 302.000
DFC KM: 1190.990 TO 1191.490

DFCC APPR. NO. -
ENGG. APPR. NO. -
DRG. NO. - 301-2/AL/A/1229
SHEET NO. : 1 OF 1
DATE : 07.09.2024

STATUS
A

TR.