
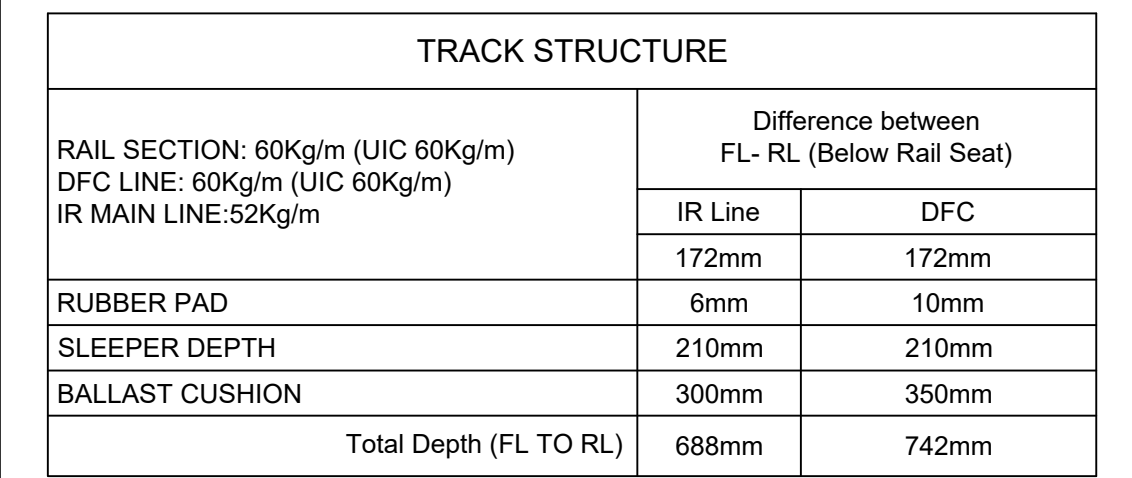


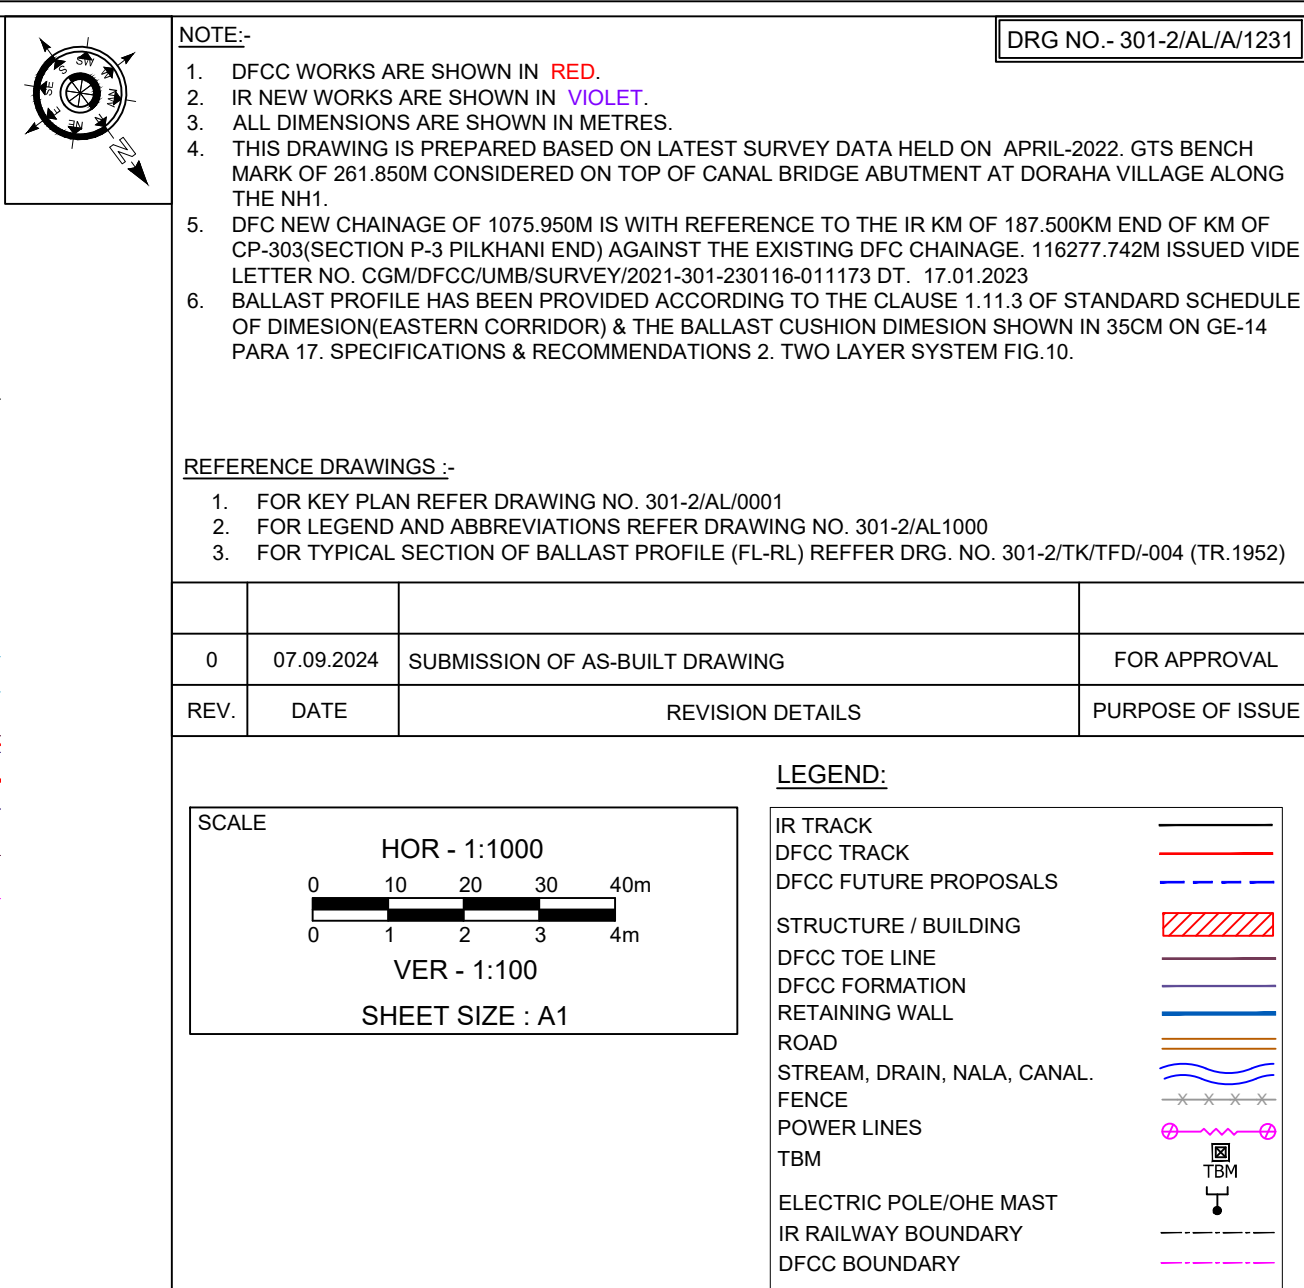

ENGINEER:

 DB Engineering &
Consulting GmbH
Deutsche Bahn Engineering & Consulting GmbH

SUBMITTED BY	GIL - TPL JV		
	DATED	NAME	SIGNATURE
PREPARED BY			
CHECKED BY	07.09.2024	VIJAY PRATAP	
APPROVED BY	07.09.2024	PARASURAM KOTYADA	

APPROVED BY	DEUTSCHE BAHN ENGINEERING & CONSULTING GMBH		
	DATED	NAME	SIGNATURE
Sr. DE./CHIEF ENGINEER		SURESH K.YALANGI	
CHIEF TRACK ENGINEER		RAJ PAL SINGH	
T.L.		H.D. VIDJAK	

	AS BUILT DRAWING
--	------------------

STAMP	A AS-BUILT DRAWING TR. Ref..... ENGINEER Sign.:
-------	--

EMPLOYER (DECO):	REDIATED FREIGHT CORRIDOR CORPORATION OF INDIA LTD.
------------------	---

EMPLOYER (DFCCIL):	DEDICATED FREIGHT CORRIDOR CORPORATION OF INDIA LTD.		

--	--	--	--

--	--	--	--

--	--	--	--

--	--	--	--

AS BUILT DRAWING

AS BUILT DRAWING	
TITLE	DATE

TITLE	DFCC APPR. NO. -
AS-BUILT PLAN AND PROFILE	ENGG. APPR. NO. -

FROM IR KM: 302.500 TO 303.000	DRG. NO. - 301-2/AL/A/1231	
	SHEET NO. : 1 OF 1	STATUS

DFC KM: 1191.990 TO 1192.490	SHEET NO.: 1 OF 1	A
	DATE : 07.09.2024	

	TR.
--	-----



L - SECTION

 TD |