

- REFERENCE DRAWINGS :-

- | | | | |
|------|------------|--------------------------------|------------------|
| 0 | 07.09.2024 | SUBMISSION OF AS-BUILT DRAWING | FOR APPROVAL |
| REV. | DATE | REVISION DETAILS | PURPOSE OF ISSUE |

SCALE

HOR - 1:1000

0 10 20 30 40m

0 1 2 3 4m

VER - 1:100

SHEET SIZE : A1

-

RAIL SECTION: 60Kg/m (UIC 60Kg/m) DFC LINE: 60Kg/m (UIC 60Kg/m) IR MAIN LINE :52Kg/m	Difference between FL- RL (Below Rail Seat)	
	IR Line	DFC
	172mm	172mm
RUBBER PAD	6mm	10mm
SLEEPER DEPTH	210mm	210mm
BALLAST CUSHION	300mm	350mm
Total Depth (FL TO RL)	688mm	742mm

ENGINEER:  DB Engineering & Consulting GmbH
Deutsche Bahn Engineering & Consulting GmbH

CONTRACTOR: GIL - TPL JV


SUBMITTED BY	GIL - TPL JV		
	DATED	NAME	SIGNATURE
PREPARED BY			
CHECKED BY	07.09.2024	VIJAY PRATAP	
APPROVED BY	07.09.2024	PARASURAM KOTYADA	

APPROVED BY	DEUTSCHE BAHN ENGINEERING & CONSULTING GMBH		
	DATED	NAME	SIGNATURE
Sr. DE./CHIEF ENGINEER		SURESH K.YALANGI	
CHIEF TRACK ENGINEER		RAJ PAL SINGH	
T.L.		H.D. VIDJAK	


STAMP		

EMPLOYER (DFCCIL):	DEDICATED FREIGHT CORRIDOR CORPORATION OF INDIA LT
--------------------	--

TITLE AS-BUILT PLAN AND PROFILE FROM IR KM: 303.000 TO 303.500 DFC KM: 1192.490 TO 1192.990	DFCC APPR. NO. -	STATUS A
	ENGG. APPR. NO. -	
	DRG. NO. - 301-2/AL/A/1232	
	SHEET NO. : 1 OF 1	
	DATE : 07.09.2024	

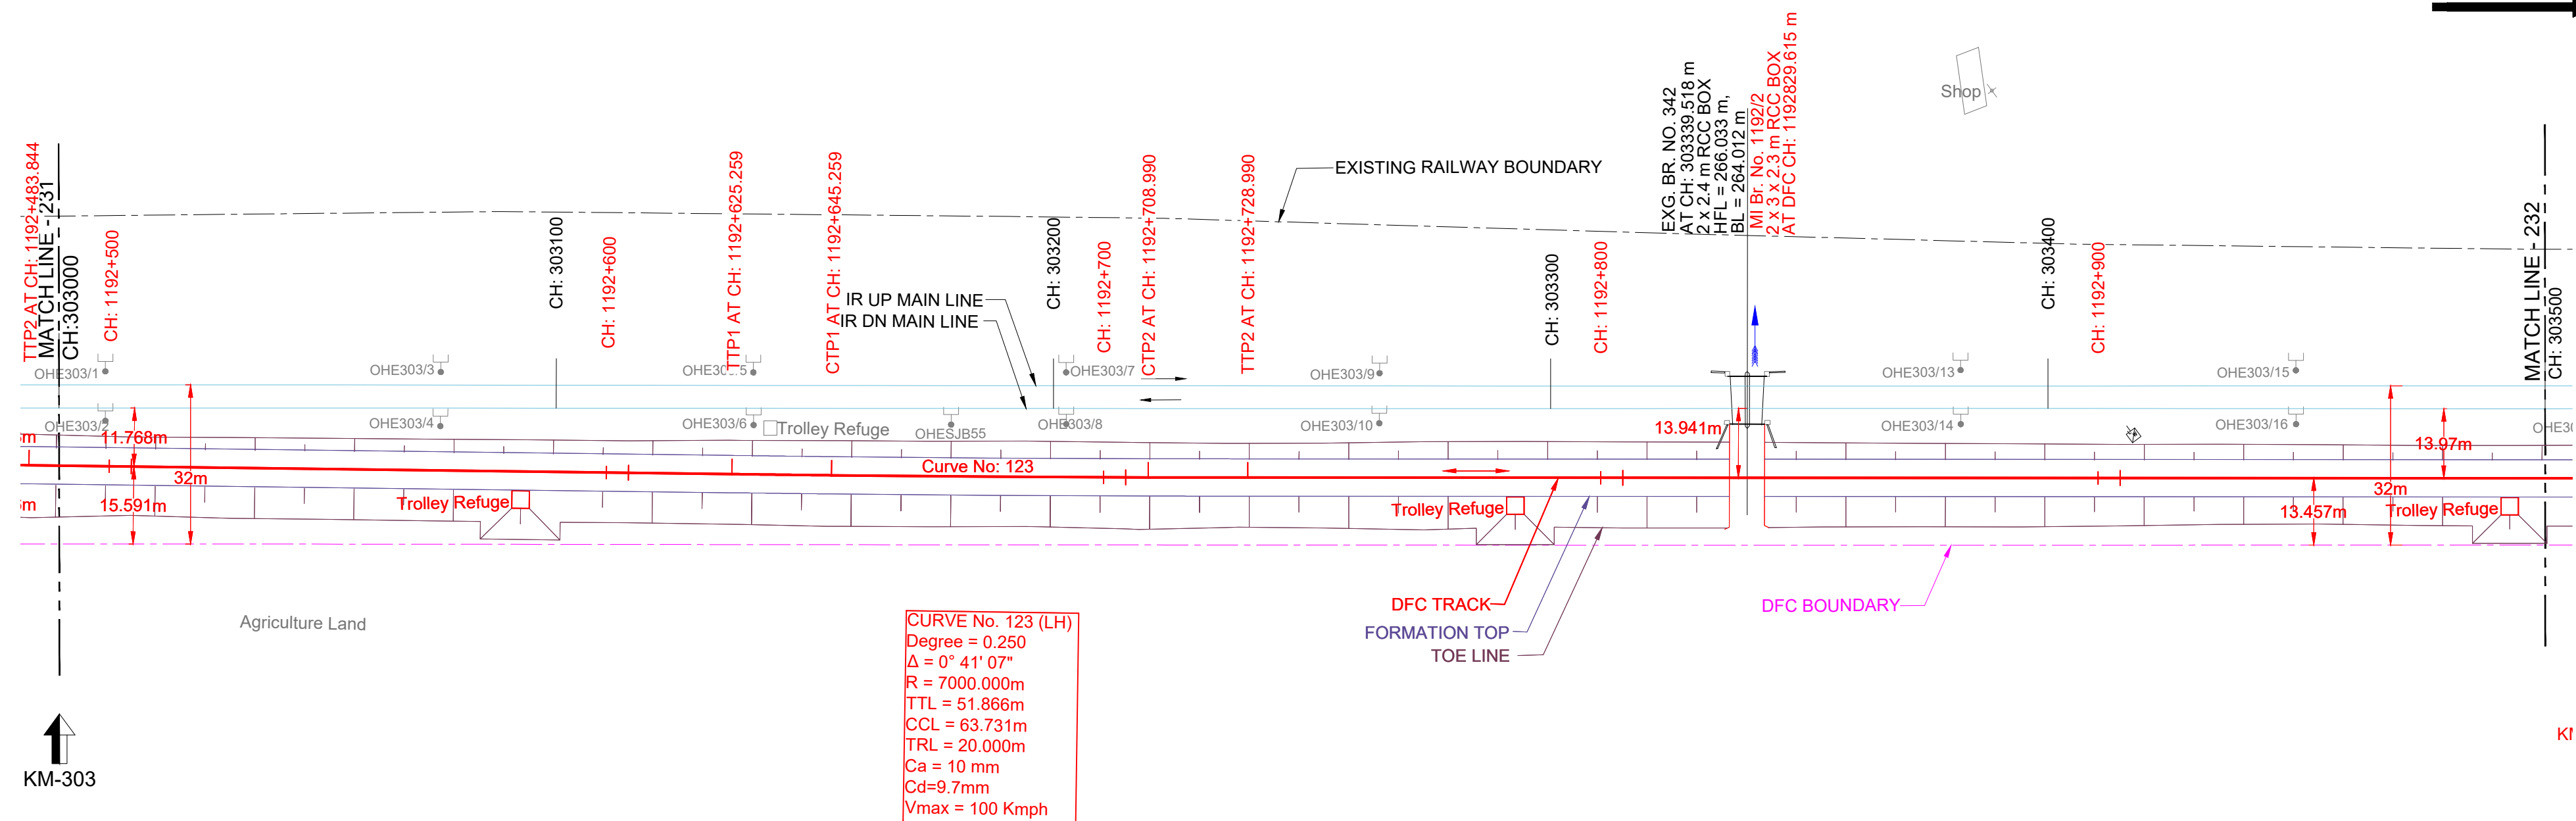

PLAN
1:1000

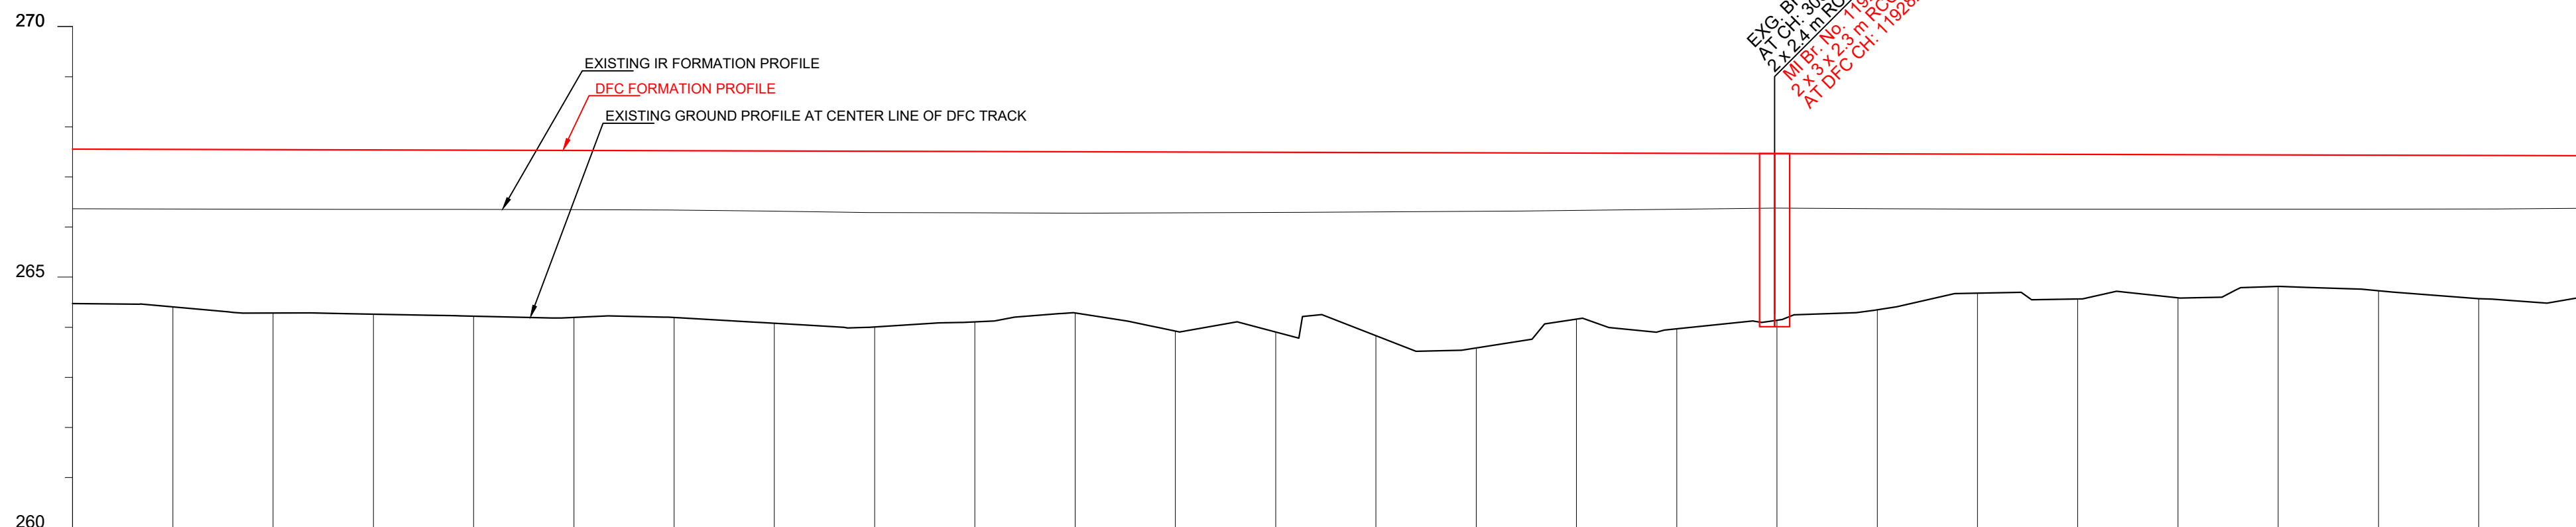

DATUM ABOVE MSL : 260 m

HORIZONTAL ALIGNMENT	L=141.415m TL= 20m CCl=63.731 R=7000 TL= 20m L=3511.712m														
VERTICAL ALIGNMENT	L=1820.969 m 1 IN 3834.074 F														
TRACK DISTANCE FROM EXISTING NEAREST IR DN MAIN LINE TO DFC MAIN LINE	-	-	-	-	-	-	-	-	-	-	-	-	-	-	-
HEIGHT OF BANKING(+)/ DEPTH OF CUTTING(-) (PFL-GL)	+3.083	-	-	-	-	-	-	-	-	-	-	-	-	-	-
EXG GROUND LEVEL AT CENTER LINE OF DFC TRACK (GL)	-264.260	-264.471	-	-	-	-	-	-	-	-	-	-	-	-	-
EXG GROUND LEVEL AT TOE LOCATION OF DFC TRACK	-264.350	-264.263	-	-	-	-	-	-	-	-	-	-	-	-	-
DIFFERENCE BETWEEN DFC FORMATION LEVEL AND EXG.FORMATION LEVEL (PFL-EFL)	1.190	-	-	-	-	-	-	-	-	-	-	-	-	-	-
DFC FORMATION LEVEL (PFL)	-267.554	-	-	-	-	-	-	-	-	-	-	-	-	-	-
EXG. FORMATION LEVEL OF EXG IR DN MAIN LINE (EFL)	-266.364	-	-	-	-	-	-	-	-	-	-	-	-	-	-
DIFFERENCE BETWEEN DFC RAIL LEVEL AND EXG. RAIL LEVEL (PRL - ERL)	1.231	-	-	-	-	-	-	-	-	-	-	-	-	-	-
DFC RAIL LEVEL (PRL)	-268.267	-	-	-	-	-	-	-	-	-	-	-	-	-	-
EXG.RAIL LEVEL OF NEAREST IR DN MAIN LINE(ERL)	-267.036	-	-	-	-	-	-	-	-	-	-	-	-	-	-
EQUIVALENT CHAINAGE ON DFC TRACK	+1192490.1	+1192530.1	+1192550.1	+1192590.1	+1192630.1	+1192670.1	+1192710.1	+1192750.1	+1192790.1	+1192830.1	+1192870.1	+1192910.1	+1192950.1	+1192990.1	+1193030.1
EXISTING IR CHAINAGE	303000.0	303020.0	303040.0	303060.0	303080.0	303100.0	303120.0	303140.0	303160.0	303180.0	303200.0	303220.0	303240.0	303260.0	303280.0

L - SECTION